


**EPSC - FINAL CONDITIONS**

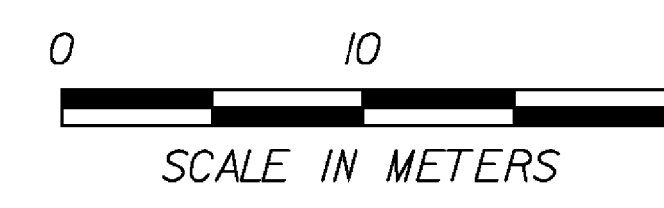

PROJECT NAME:	RIPTON	PLOT DATE:	02-OCT-2009
PROJECT NUMBER:	FH 010-1(2)	DRAWN BY:	Weeber
FILE NAME:	z89e039border.dgn	CHECKED BY:	Farnsworth
PROJECT LEADER:	Farnsworth	SHEET	15d OF 26
DESIGNED BY:	Farnsworth		
z89e039epsfin.l			