




ABUTMENT 1 ELEVATION
 SCALE: 1:50
 SCALE IN METERS

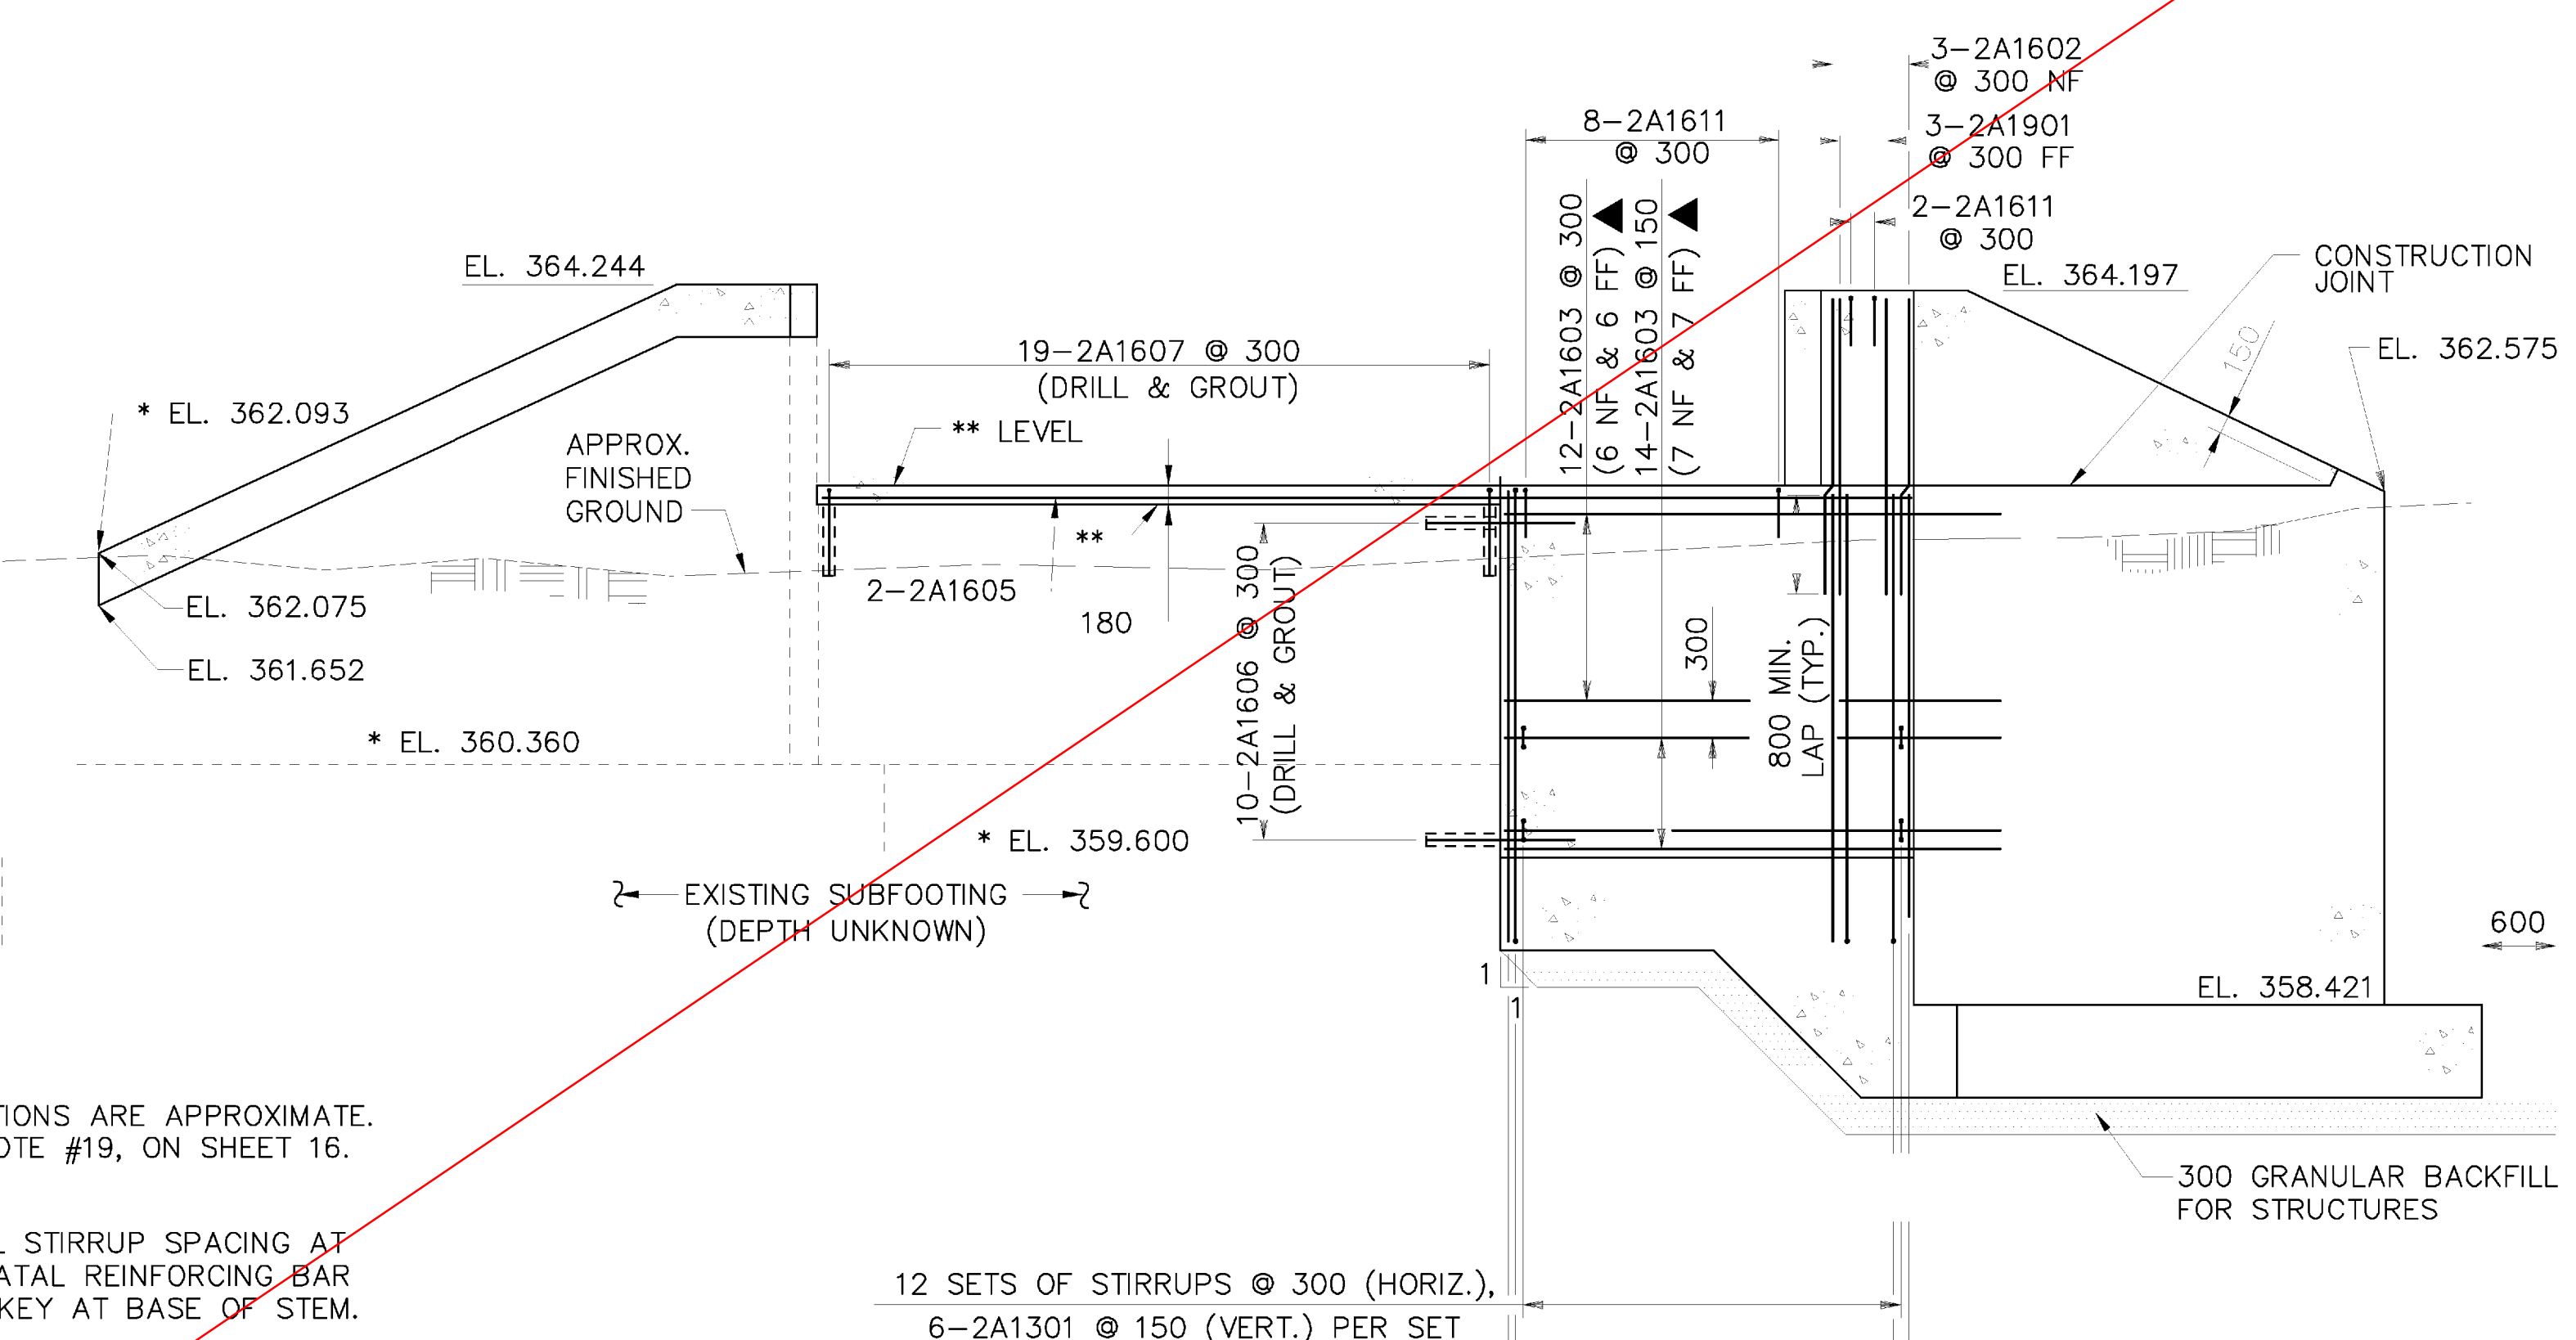


ABUTMENT 2 ELEVATION
 SCALE: 1:50
 SCALE IN METERS

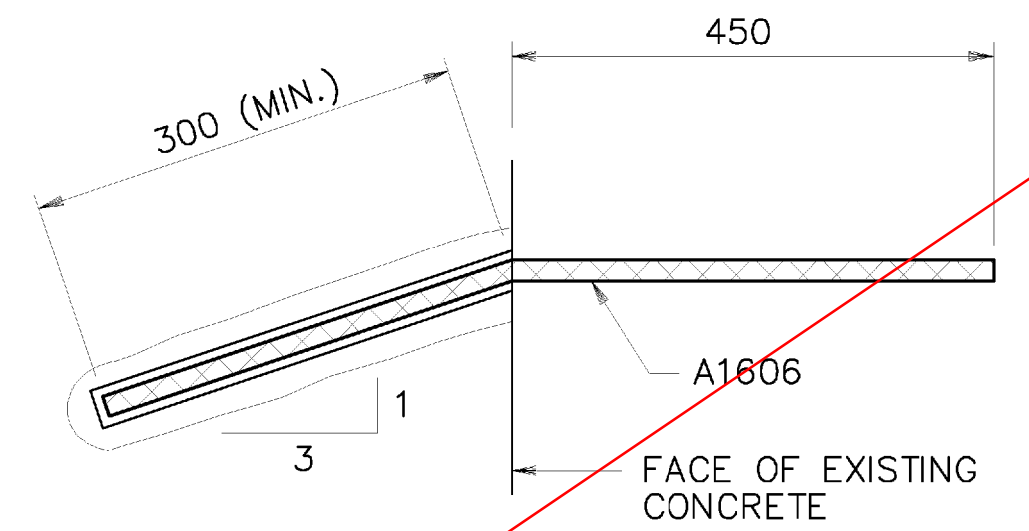

DRILL AND GROUT DETAIL
 N.T.S.

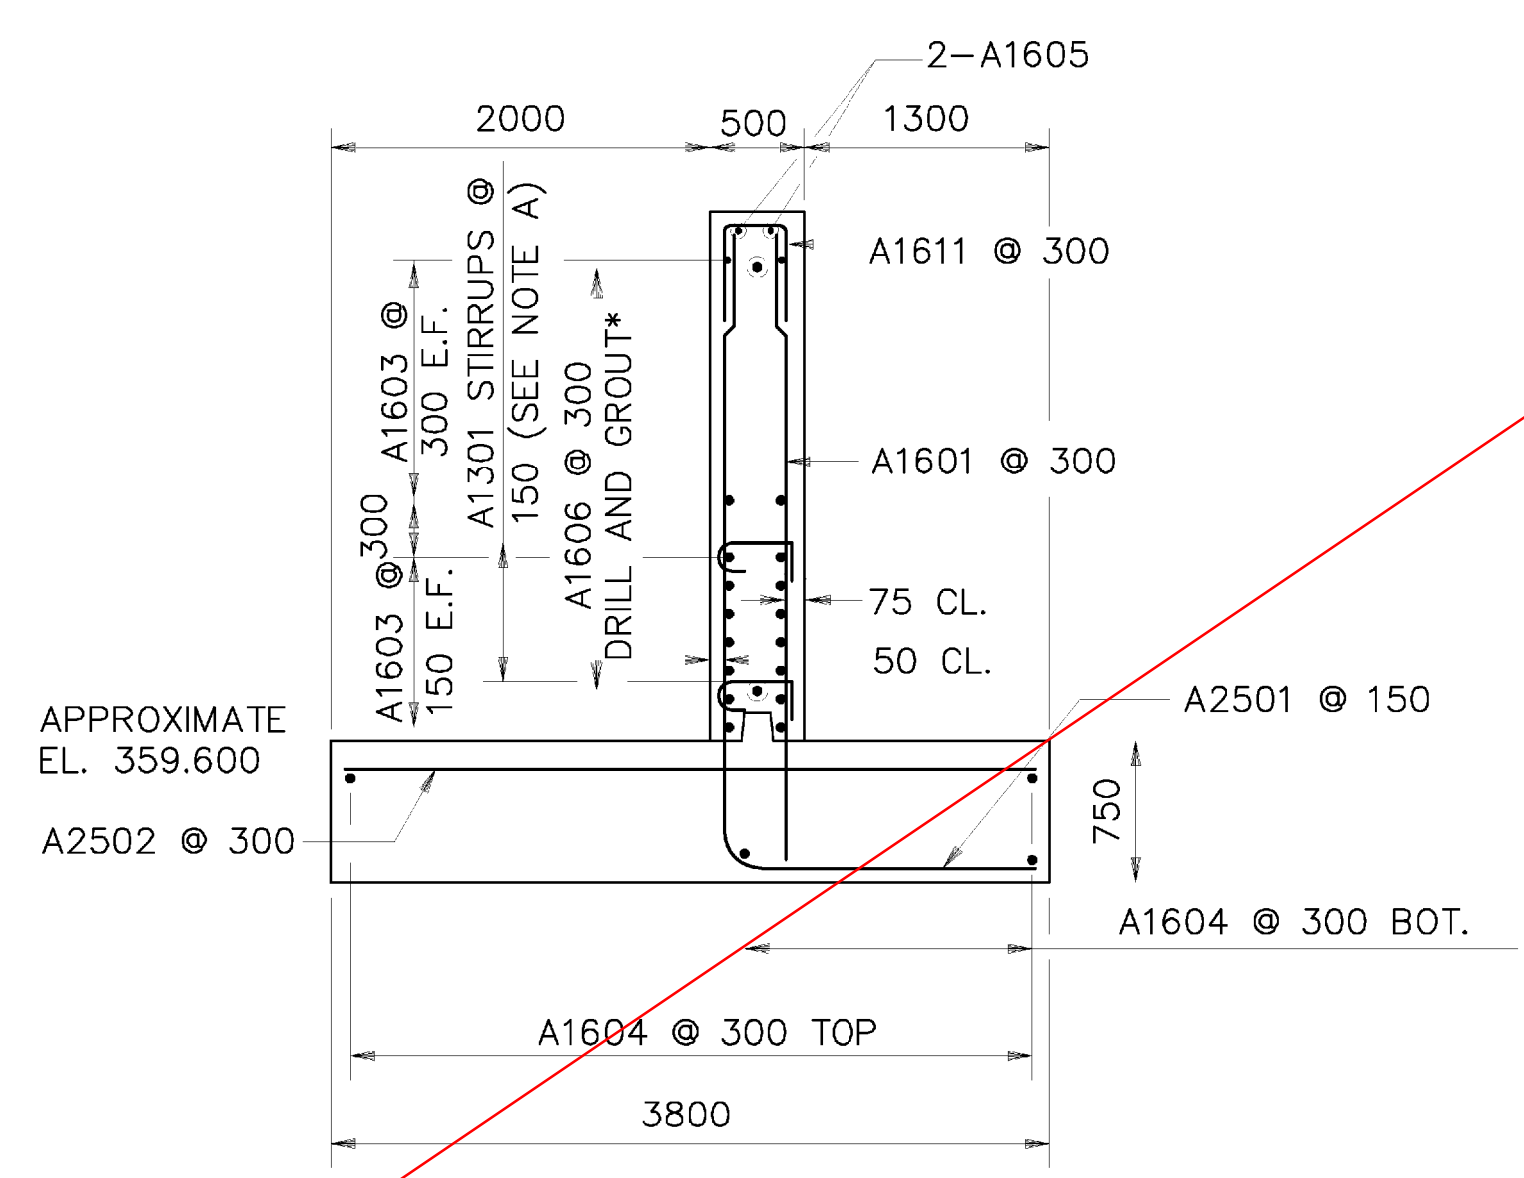

TYPICAL ABUTMENT SECTION
 SCALE: 1:40
 SCALE IN METERS

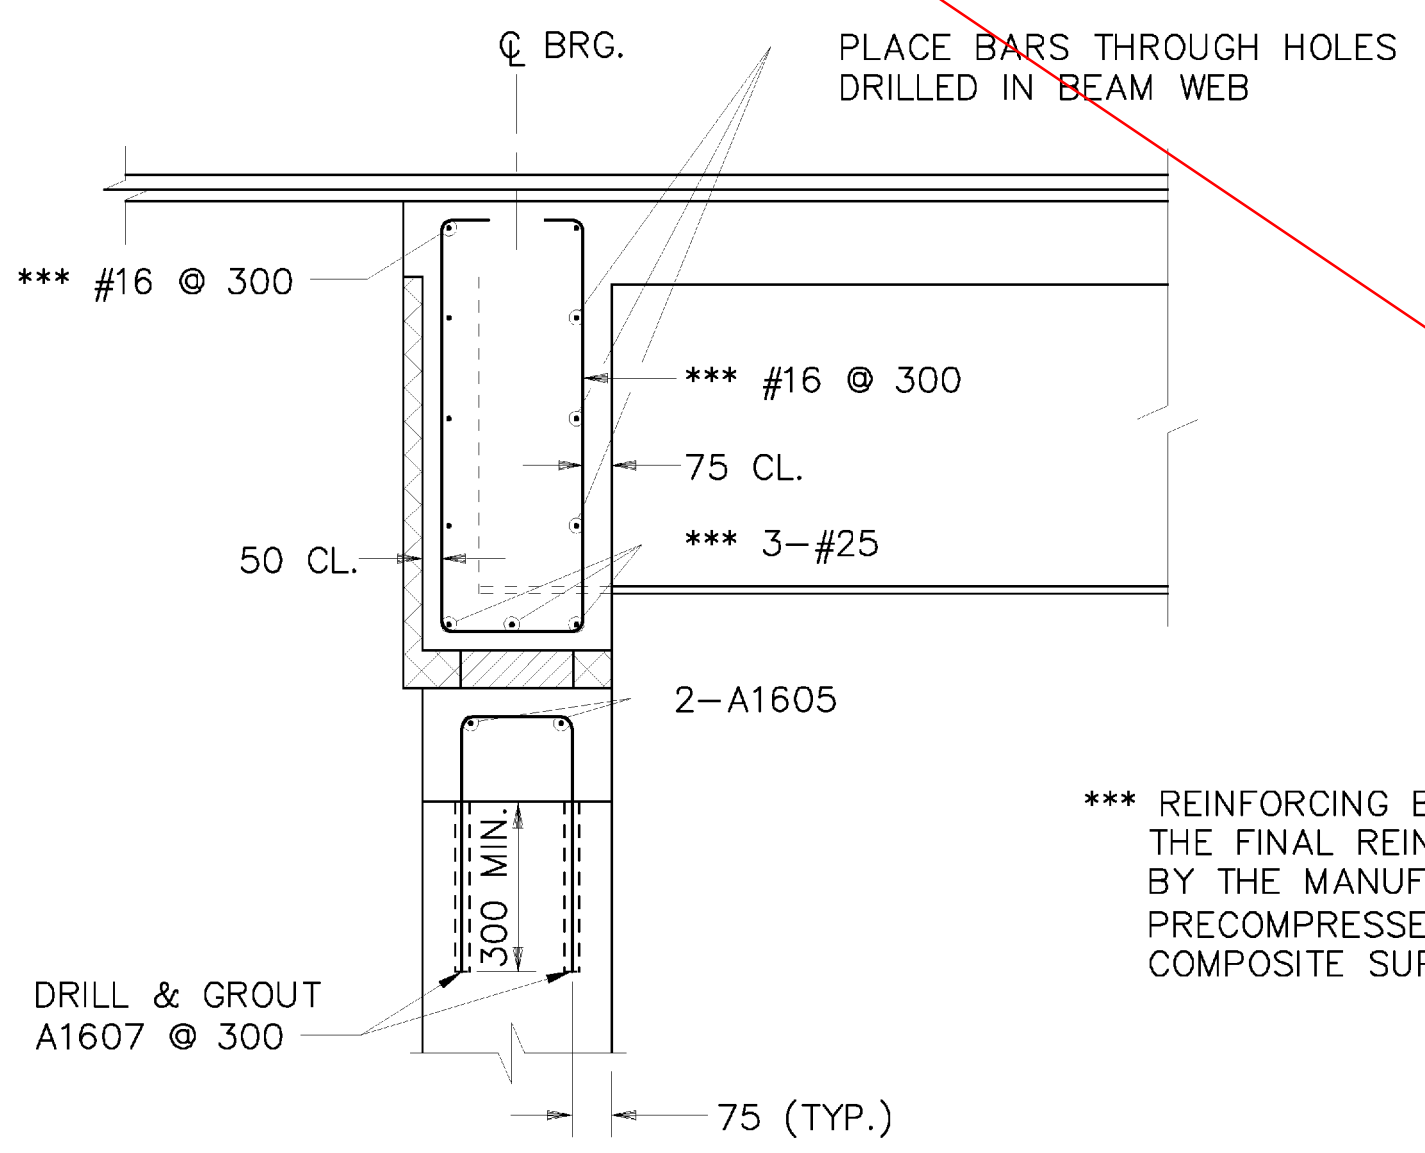

TYPICAL DECK END REINFORCING
 SCALE: 1:20
 SCALE IN METERS

* EXISTING ELEVATIONS ARE APPROXIMATE.
 ** SEE GENERAL NOTE #19, ON SHEET 16.
 NOTE A:
 BEGIN VERTICAL STIRRUP SPACING AT FIRST HORIZONTAL REINFORCING BAR ABOVE SHEAR KEY AT BASE OF STEM.

*** REINFORCING BARS SHOWN ARE APPROXIMATE, THE FINAL REINFORCING SHALL BE DESIGNED BY THE MANUFACTURER OF THE PRECAST PRECOMPRESSED CONCRETE/STEEL COMPOSITE SUPERSTRUCTURE.

- ▲ = CUT TO FIT IN FIELD
- E = EPOXY COATED
- EE = EACH END
- EF = EACH FACE
- FF = FAR FACE
- NF = NEAR FACE

SEE REVISED SHEET

STATE OF VERMONT AGENCY OF TRANSPORTATION	
Town Of RIPTON	Bridge No. BRIDGE #17
Highway No. TH 18	Log Sta. Surv. Sta.
TH 18 OVER SOUTH BRANCH MIDDLEBURY RIVER ABUTMENT REINFORCING	
Designed By Y I LIU	Drawn By W J GAYNOR
Checked By B P GUZAS	Bridge Design Supervisor R L JOY
Date 8/09	Date 10/09
PROJECT RIPTON	PROJECT NO. FH 010-1(2)
I.G.C. Info.	
Bridge Sheet No.	Sheet 20 of 26

