


STA 2+020.000
END APPROACH
BEGIN PROJECT

STA 2+000.000
BEGIN APPROACH
MATCH EXISTING

SEE REVISED SHEET

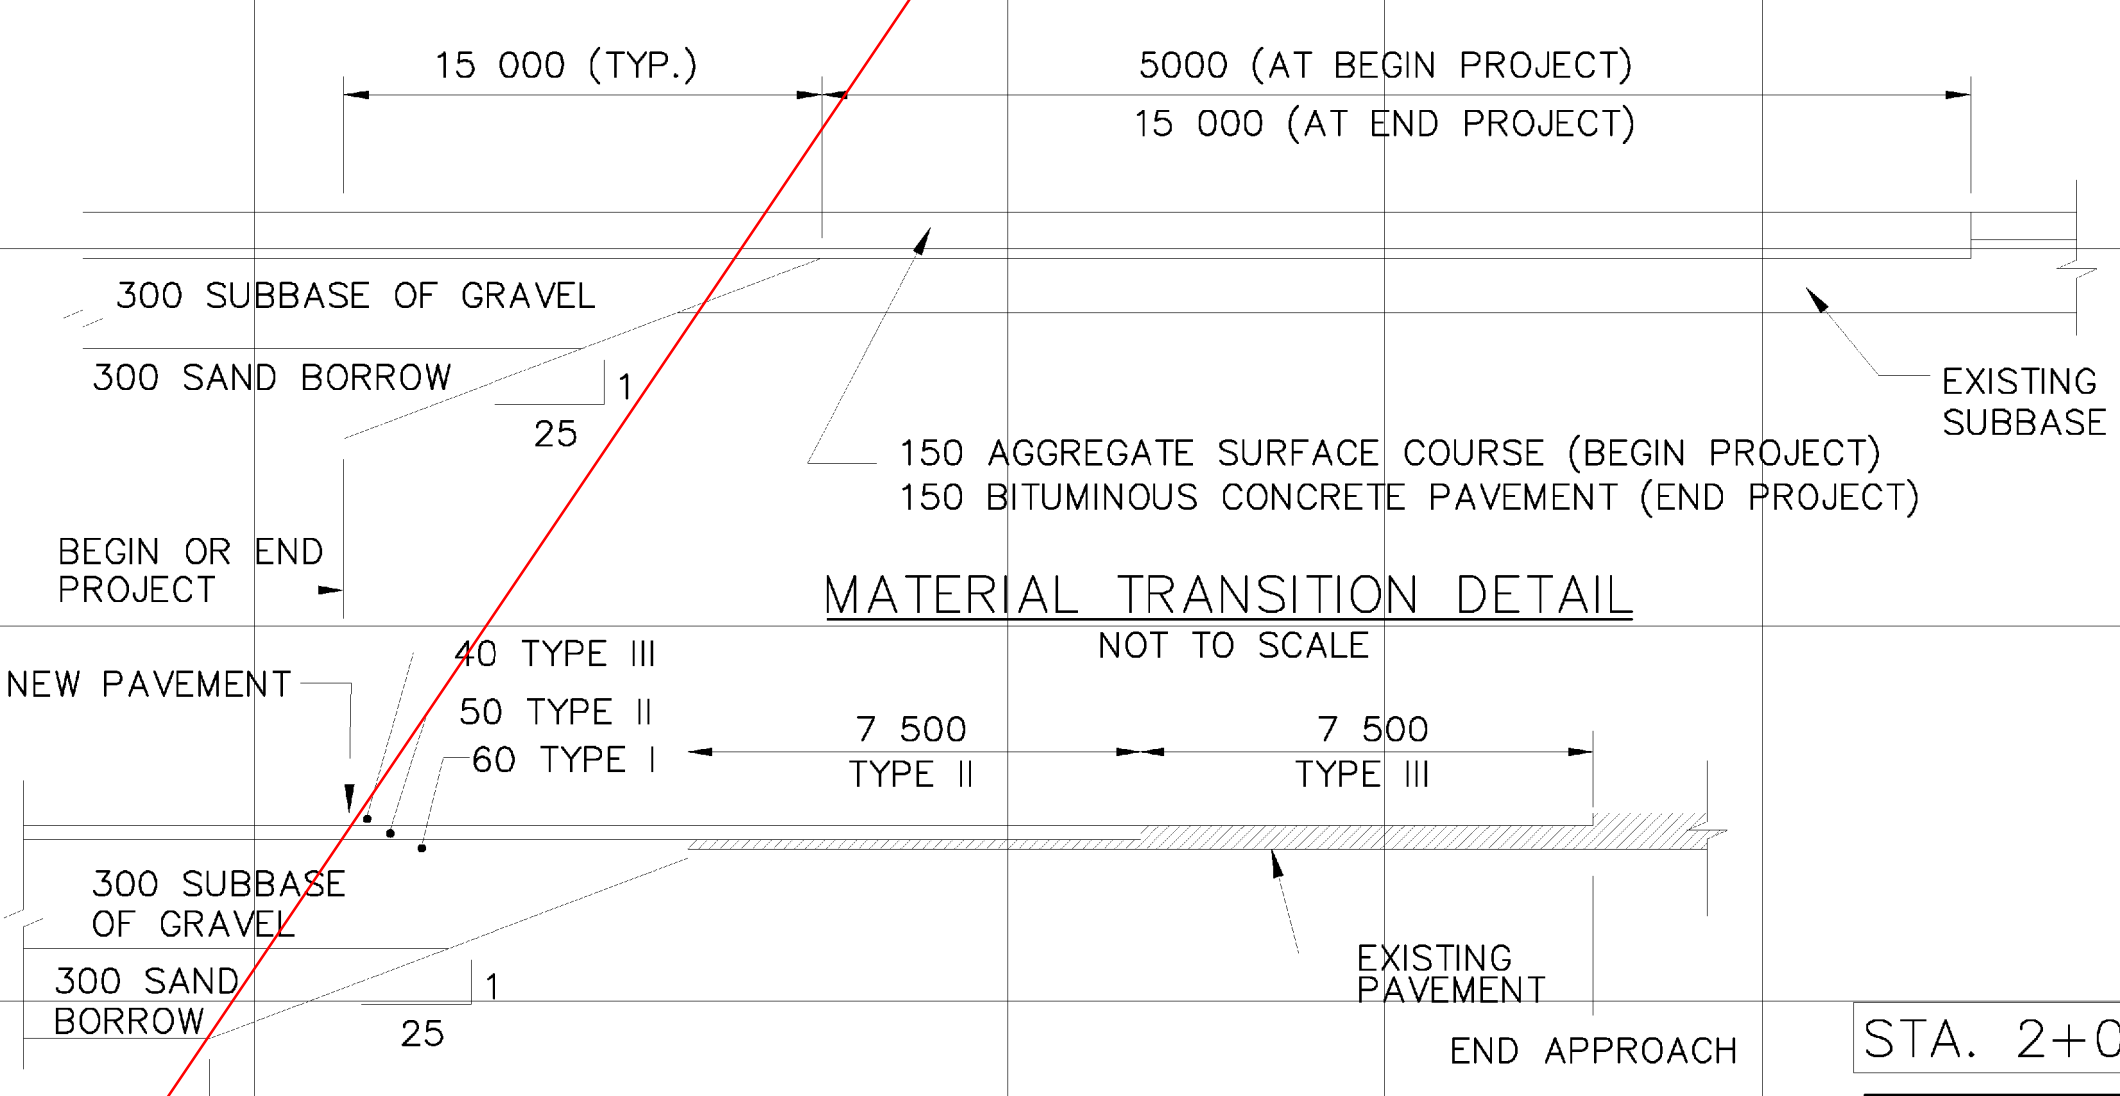

STA. 2+000 - STA. 2+060

STATE OF VERMONT AGENCY OF TRANSPORTATION			
Town Of	RIPTON	Bridge No.	BRIDGE #17
Highway No.	TH 18	Log Sta.	
TH 18 OVER SOUTH BRANCH MIDDLEBURY RIVER		Surv. Sta.	
ROADWAY CROSS SECTIONS (1)			
Designed By	Y I LIU	Drawn By	W J GAYNOR
Checked By	B P GUZAS	Date	8/09
		Bridge Design Supervisor	R L JOY
		Date	10/09
PROJECT	RIPTON	PROJECT NO.	FH 010-1(2)
I.G.C. Info.		Bridge Sheet No.	Sheet 23 of 26

