


TWO - PRECAST APPROACH SLABS
SCALE: 1:50

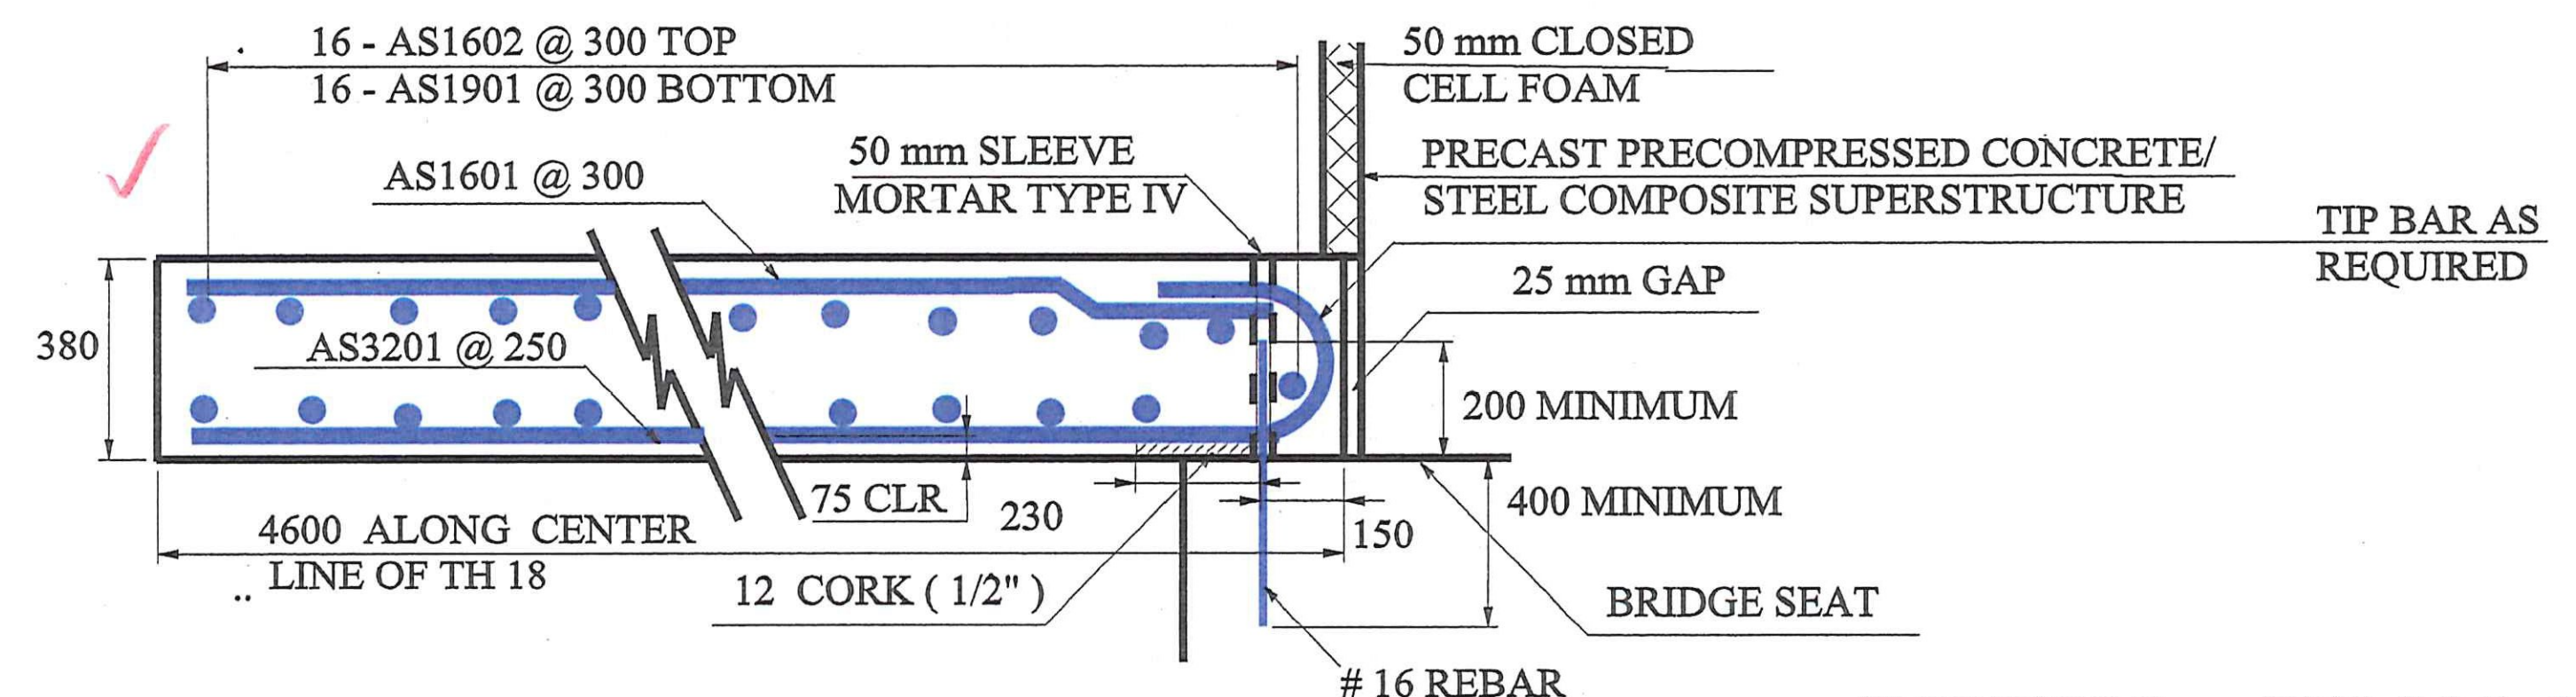

SECTION A - A THROUGH APPROACH SLAB
SCALE: NTS

RIPTON FH 010-1(42)
VTRANS - SEPT. 8, 2010
BY S.FARNSWORTH

5 of 7