


CURVE 1 (TH4)  
 D = 3° 00' 00.00"  
 R = 1909.86  
 T = 82.27'  
 L = 164.44'  
 E = 1.77'  
 BANKING = NORMAL

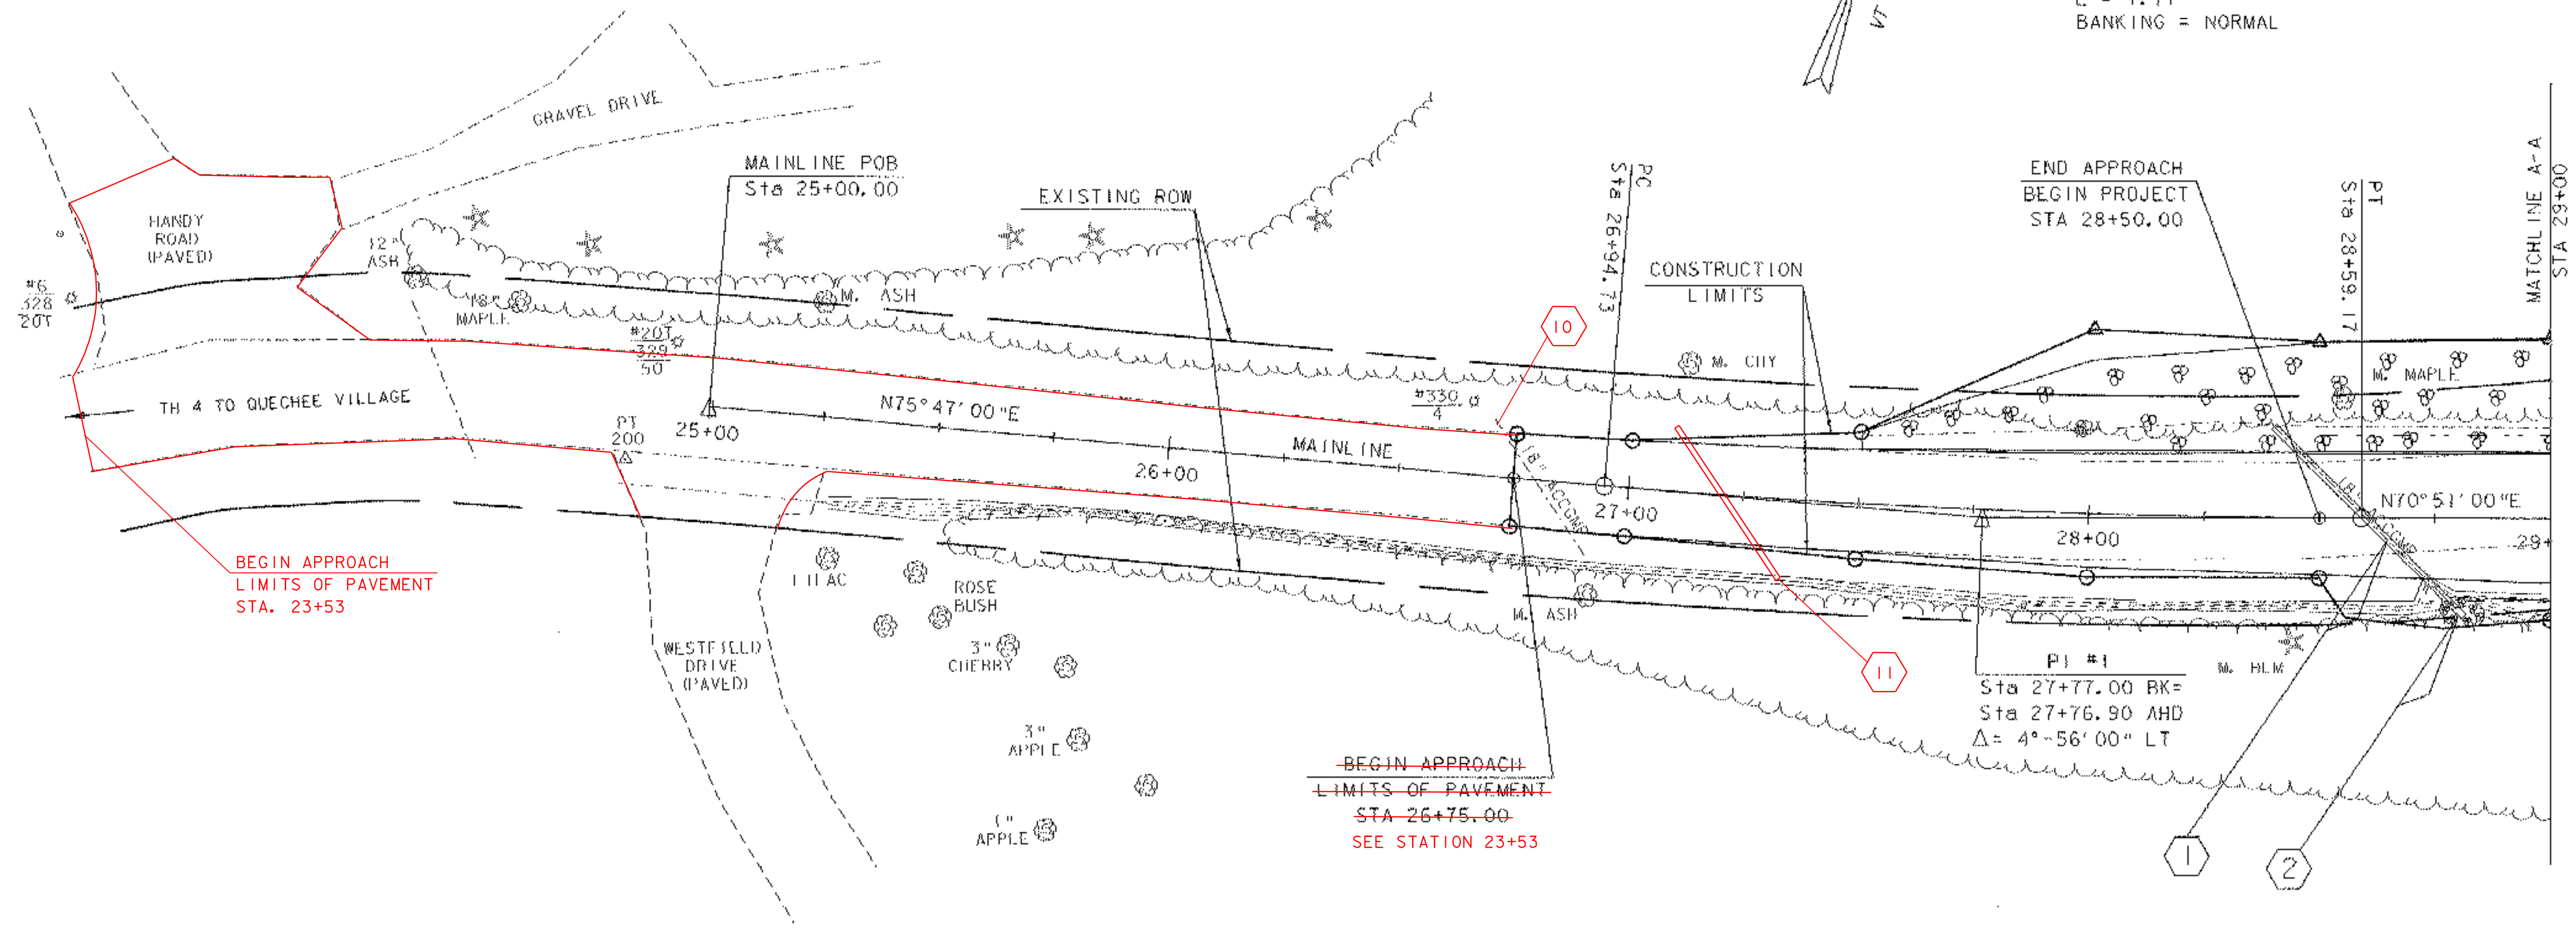

BEGIN APPROACH  
 LIMITS OF PAVEMENT  
 STA. 23+53

BEGIN APPROACH  
 LIMITS OF PAVEMENT  
 STA 26+75.00  
 SEE STATION 23+53

PI #1  
 Sta 27+77.00 BK=  
 Sta 27+76.90 AHD  
 Δ = 4°-56' 00" LT

SEE SHEET 22-23 FOR  
 DRAINAGE INFORMATION

LAYOUT SHEET 1

SCALE 1" = 20'-0"

DATUM	
VERTICAL	NAVD88
HORIZONTAL	NAD 1983/92

PROJECT: HARTFORD	PROJECT NO.: BRO-BTN 2004(1)
DESIGN FILE NAME: 89j045/structures/sj045bdr.dgn	PLOT DATE: #-FEB-2005
PARM FILE NAME: sj045la.l	SURVEY DATE: 5/93
SURVEYED BY: R. MOREAU	DRAWN BY: K.M. HIGGINS
SQUAD LEADER: C. P. WILLIAMS	SHEET: 10 OF 97
LAYOUT SHEET 1	