
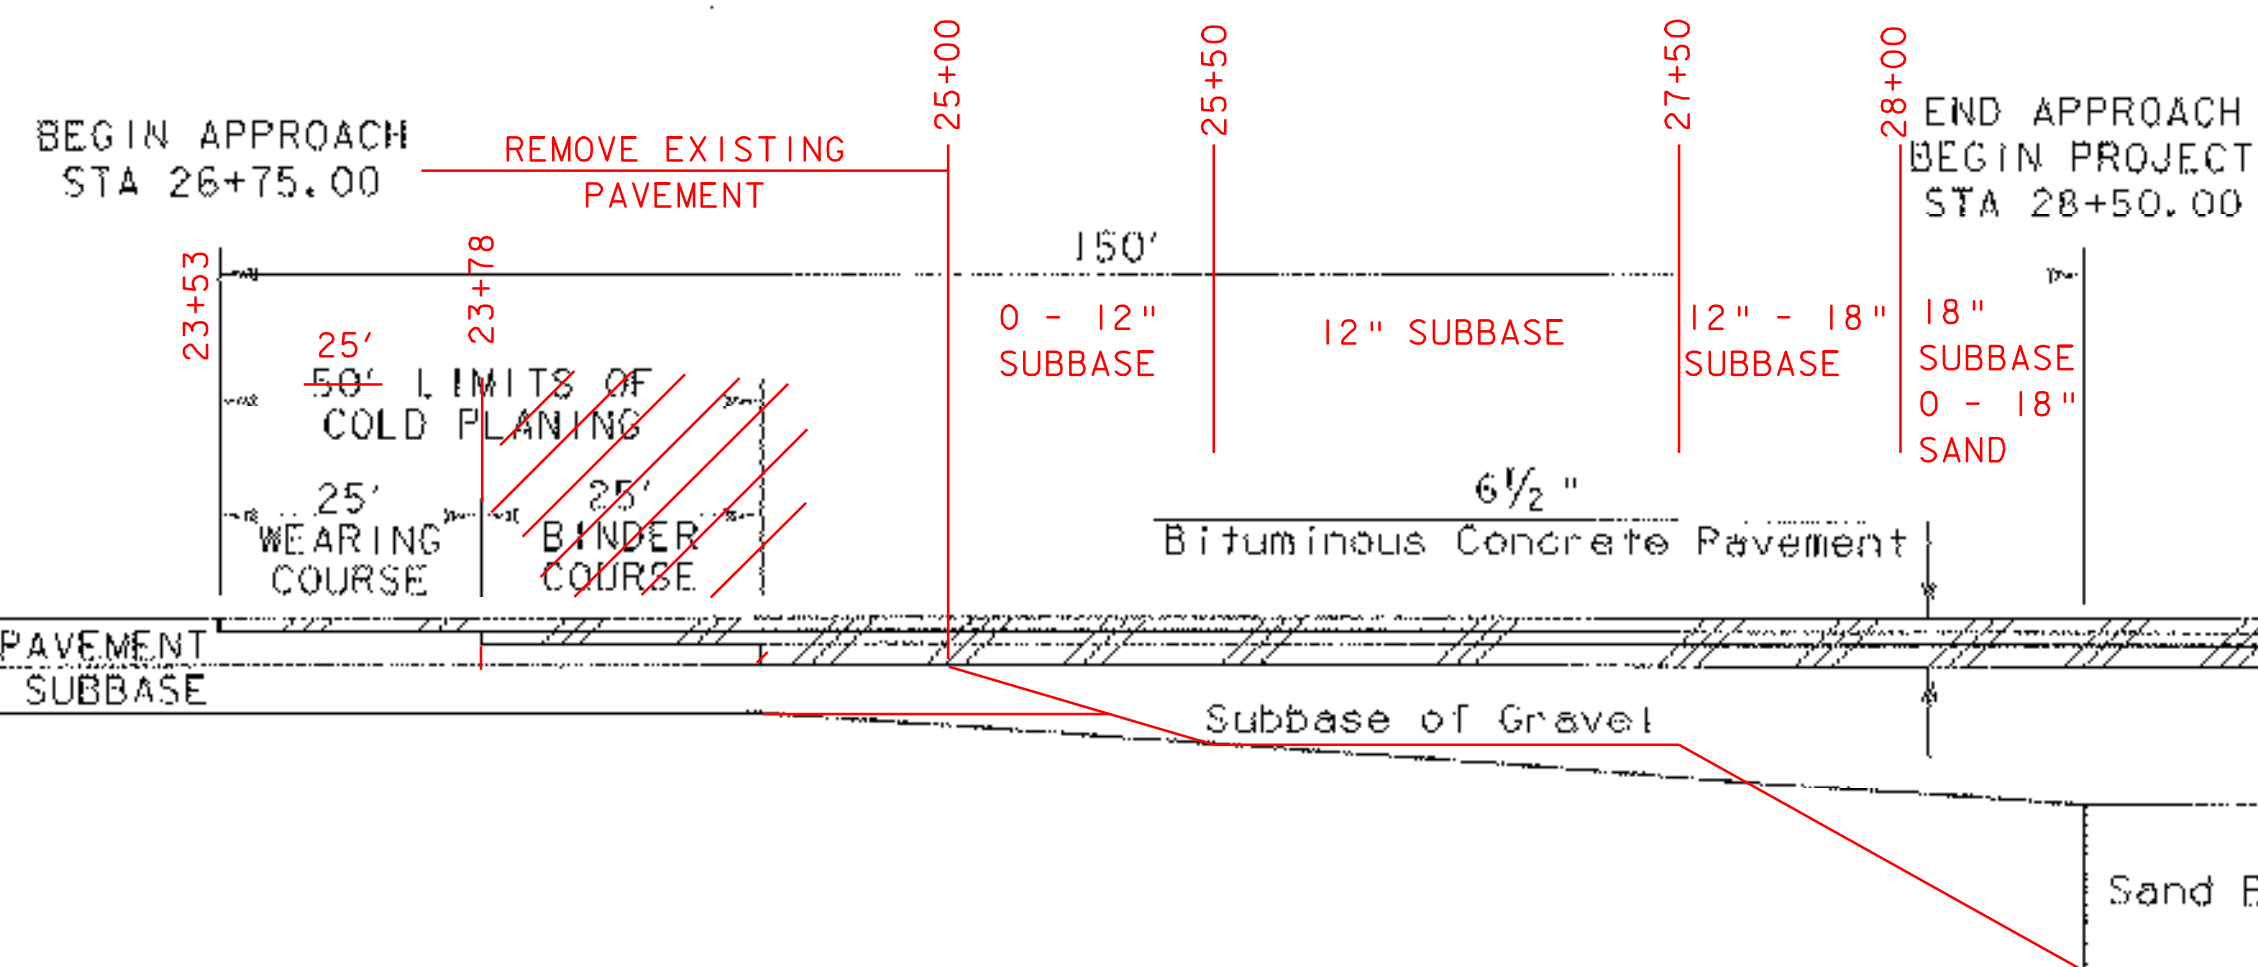


# Profile TH4

NOTE: GRADES SHOWN TO THE NEAREST TENTH REPRESENT EXISTING GROUND ELEVATION ALONG THE REVISED CENTERLINE.  
 GRADES SHOWN TO THE NEAREST HUNDREDTH REPRESENT FINISH GRADE ELEVATION ALONG THE REVISED CENTERLINE.

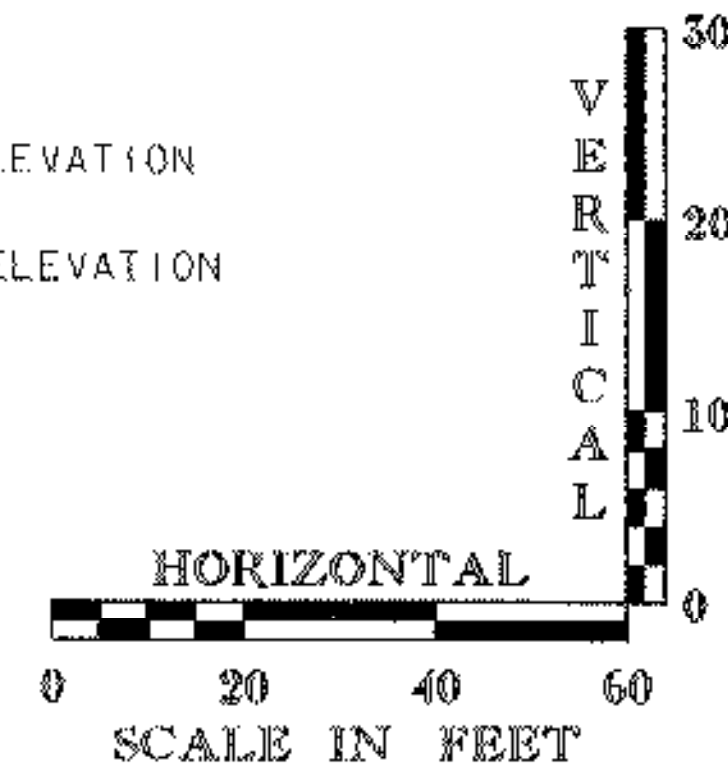

**SUBBASE TAPER @ BEGIN PROJECT**  
nts

DATUM	
VERTICAL	NAVD88
HORIZONTAL	NAD 1983/92

PROJECT: HARTFORD	PROJECT NO.: BRO-BTN 2004(I)
DESIGN FILE NAME: /89j045/structures/sj045pro.dgn	PLOT DATE: 11-FEB-2005
IPARM FILE NAME: sj045pr1.i	SURVEY DATE: 5/93
SURVEYED BY: R. MOREAU	DRAWN BY: K. M. HIGGINS
SQUAD LEADER: C. P. WILLIAMS	SHEET: 14 OF 97
TH 4 PROFILE	