
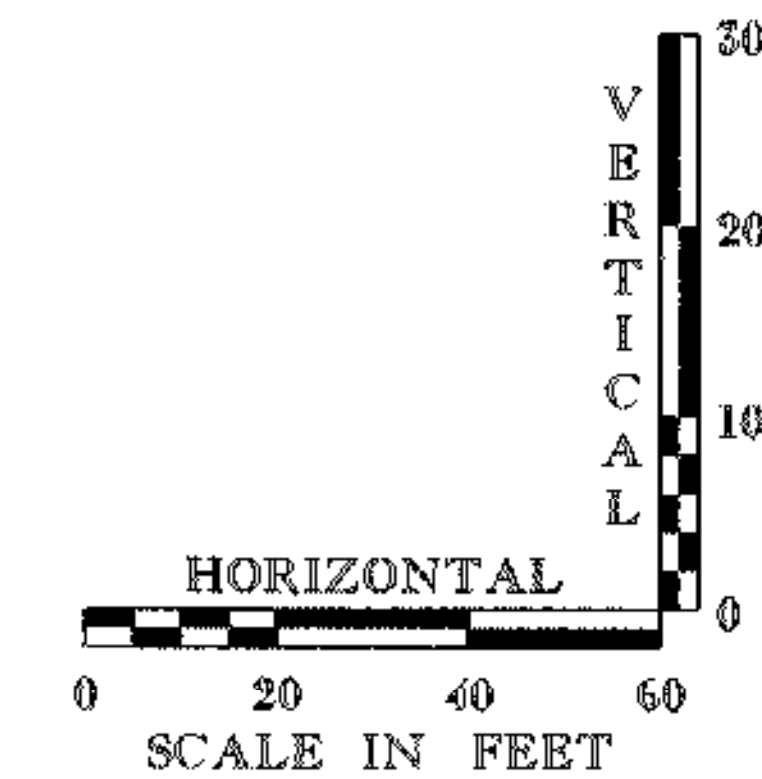


NOTE: GRADES SHOWN TO THE NEAREST TENTH REPRESENT EXISTING GROUND ELEVATION ALONG THE REVISED CENTERLINE.
 GRADES SHOWN TO THE NEAREST HUNDREDTH REPRESENT FINISH GRADE ELEVATION ALONG THE REVISED CENTERLINE.

Profile TH4

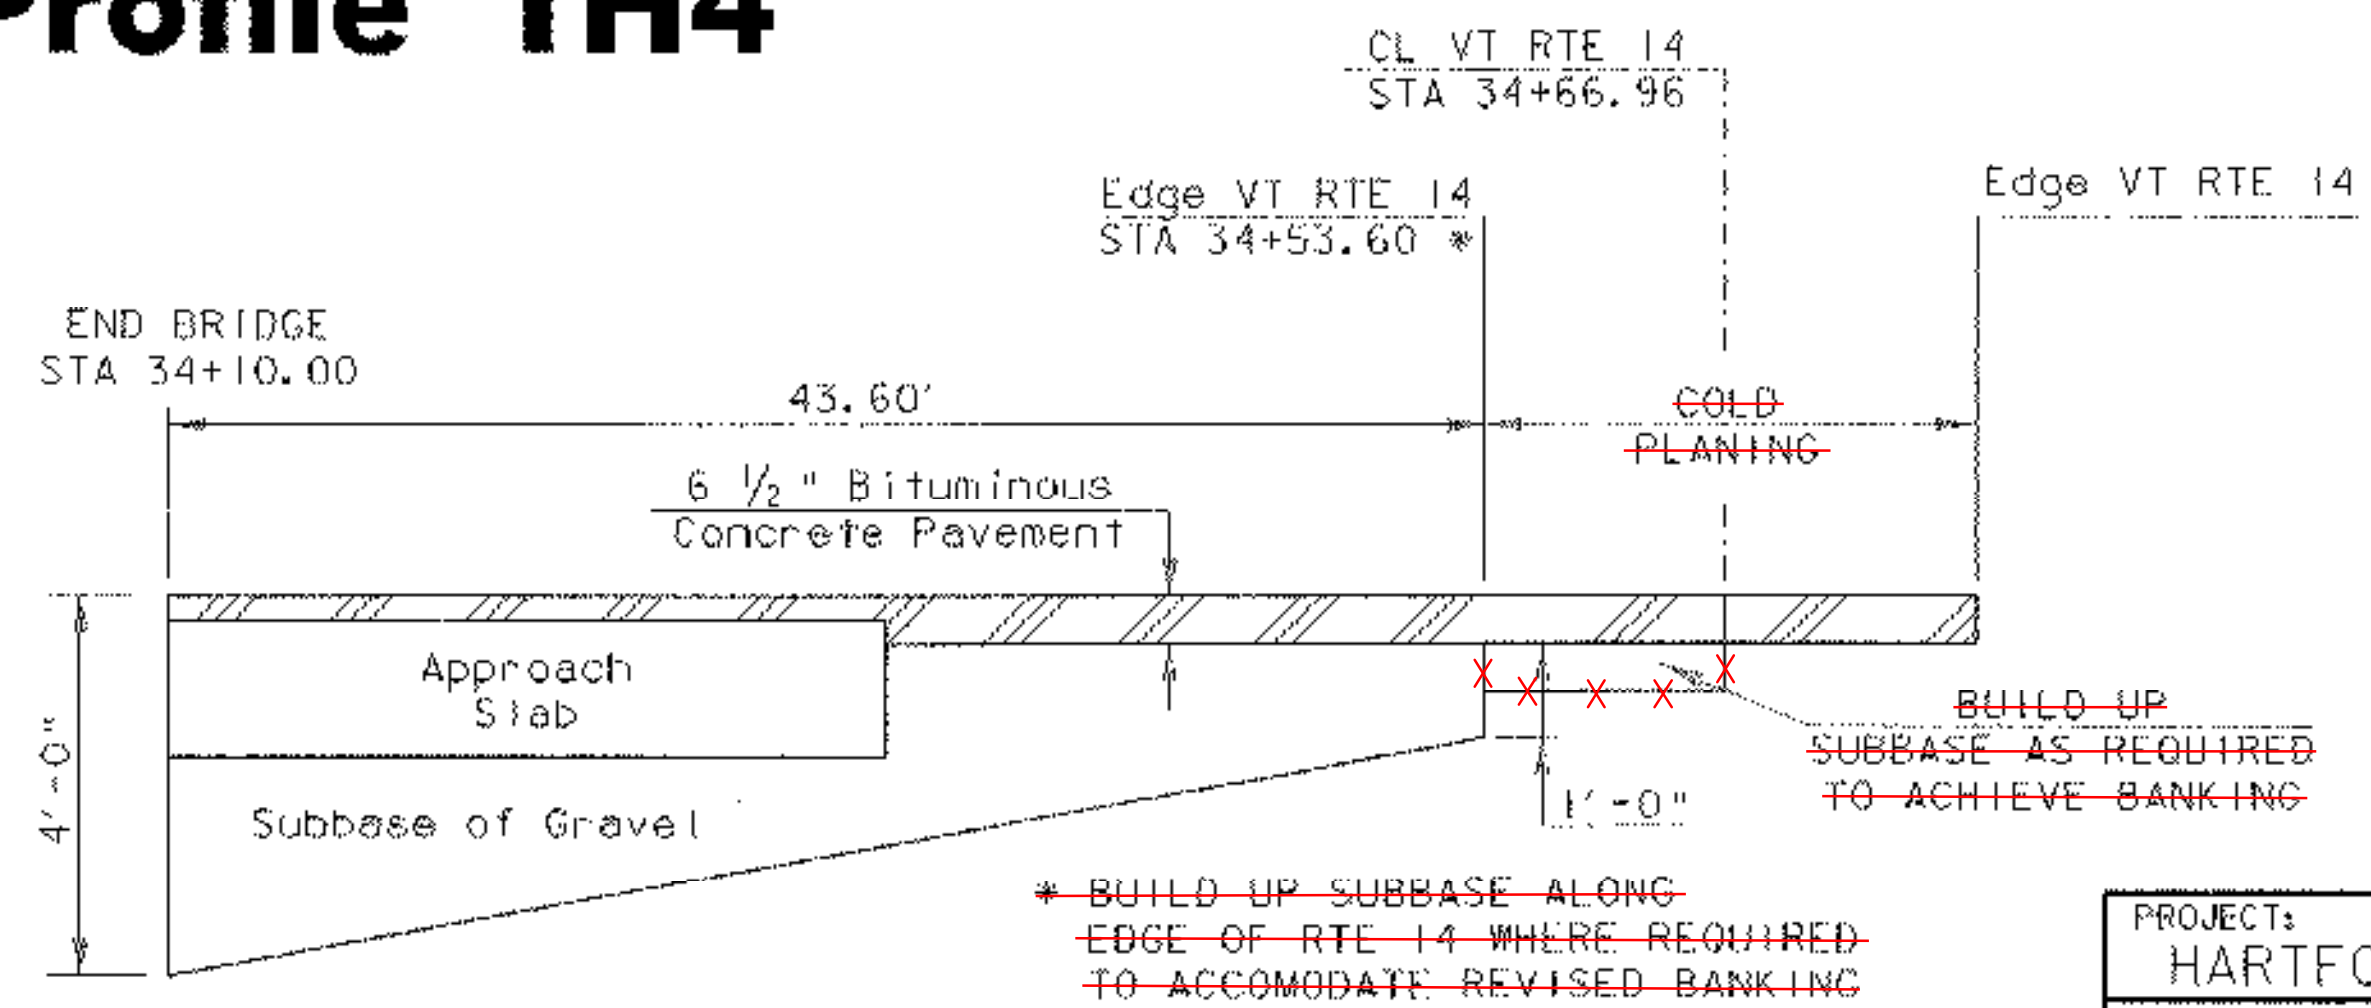

DATUM	
VERTICAL	NAVD88
HORIZONTAL	NAD 1983/92

SUBBASE TAPER @ INTERSECTION OF TH 4 & VT RTE 14

nts

PROJECT: HARTFORD	PROJECT NO. # BRO-BTN 2004(1)
DESIGN FILE NAME: /89j045/structures/sj045pro.dgn	PLOT DATE: 11-FEB-2005
IPARM FILE NAME: sj045pr2.t	SURVEY DATE: 5/93
SURVEYED BY: R. MOREAU	DRAWN BY: K. M. HIGGINS
SQUAD LEADER: C. P. WILLIAMS	SHEET: 15 OF 97
TH 4 PROFILE	