



SPAN #3 REINFORCING PLAN

SCALE 1/4" = 1'-0"

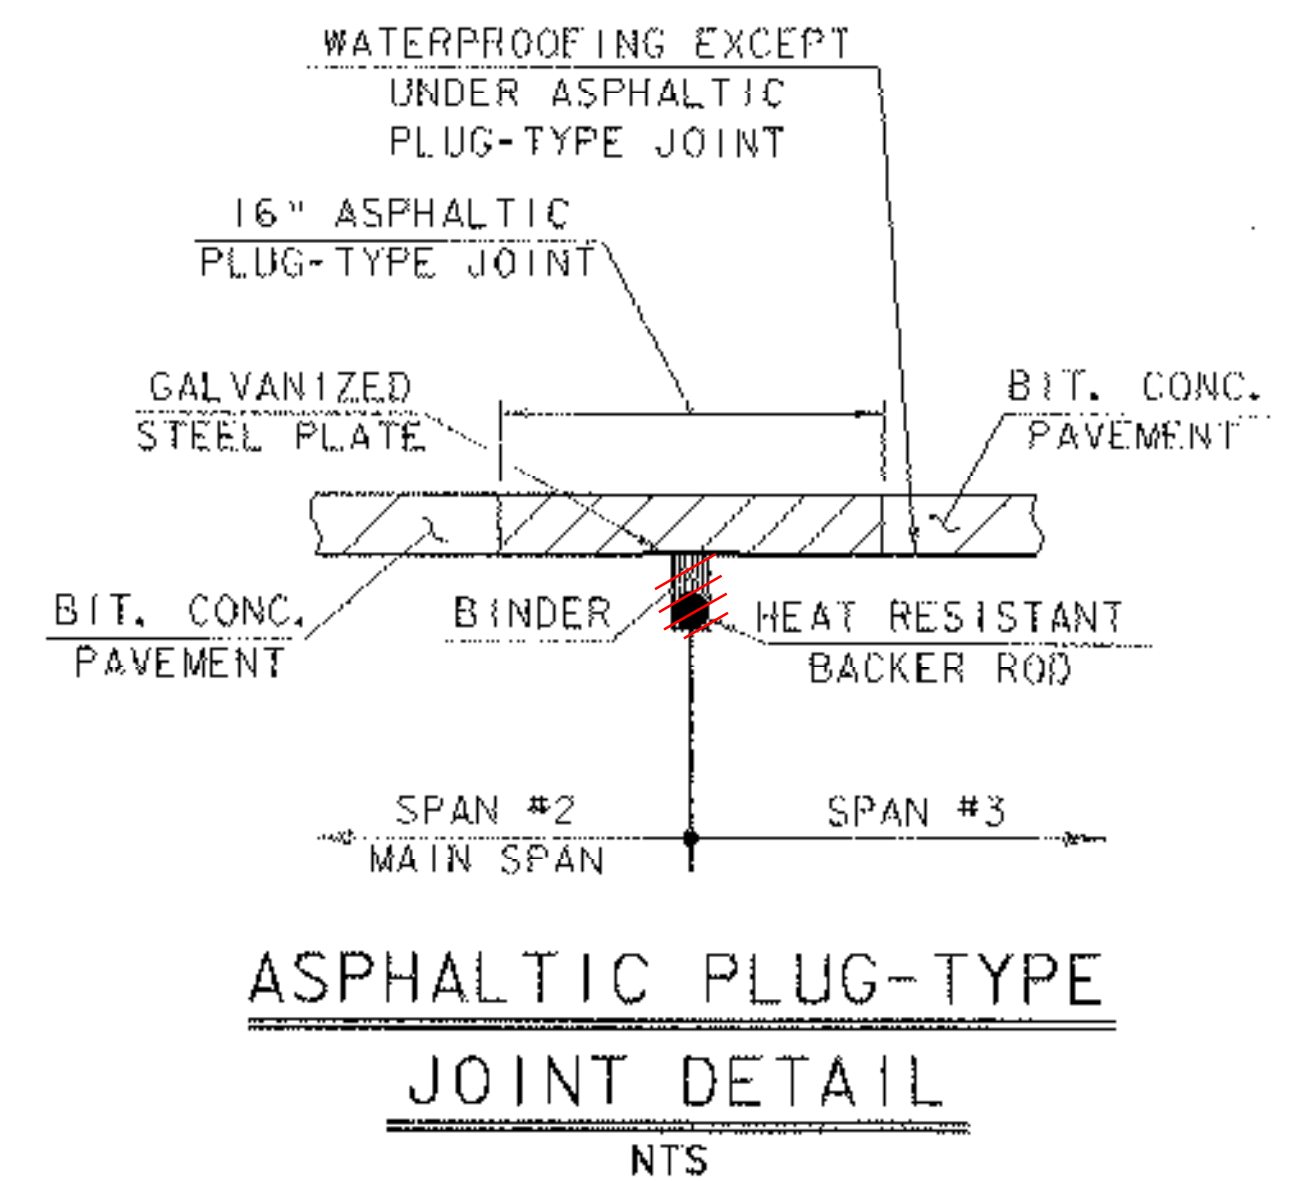

ASPHALTIC PLUG-TYPE JOINT DETAIL  
NTS

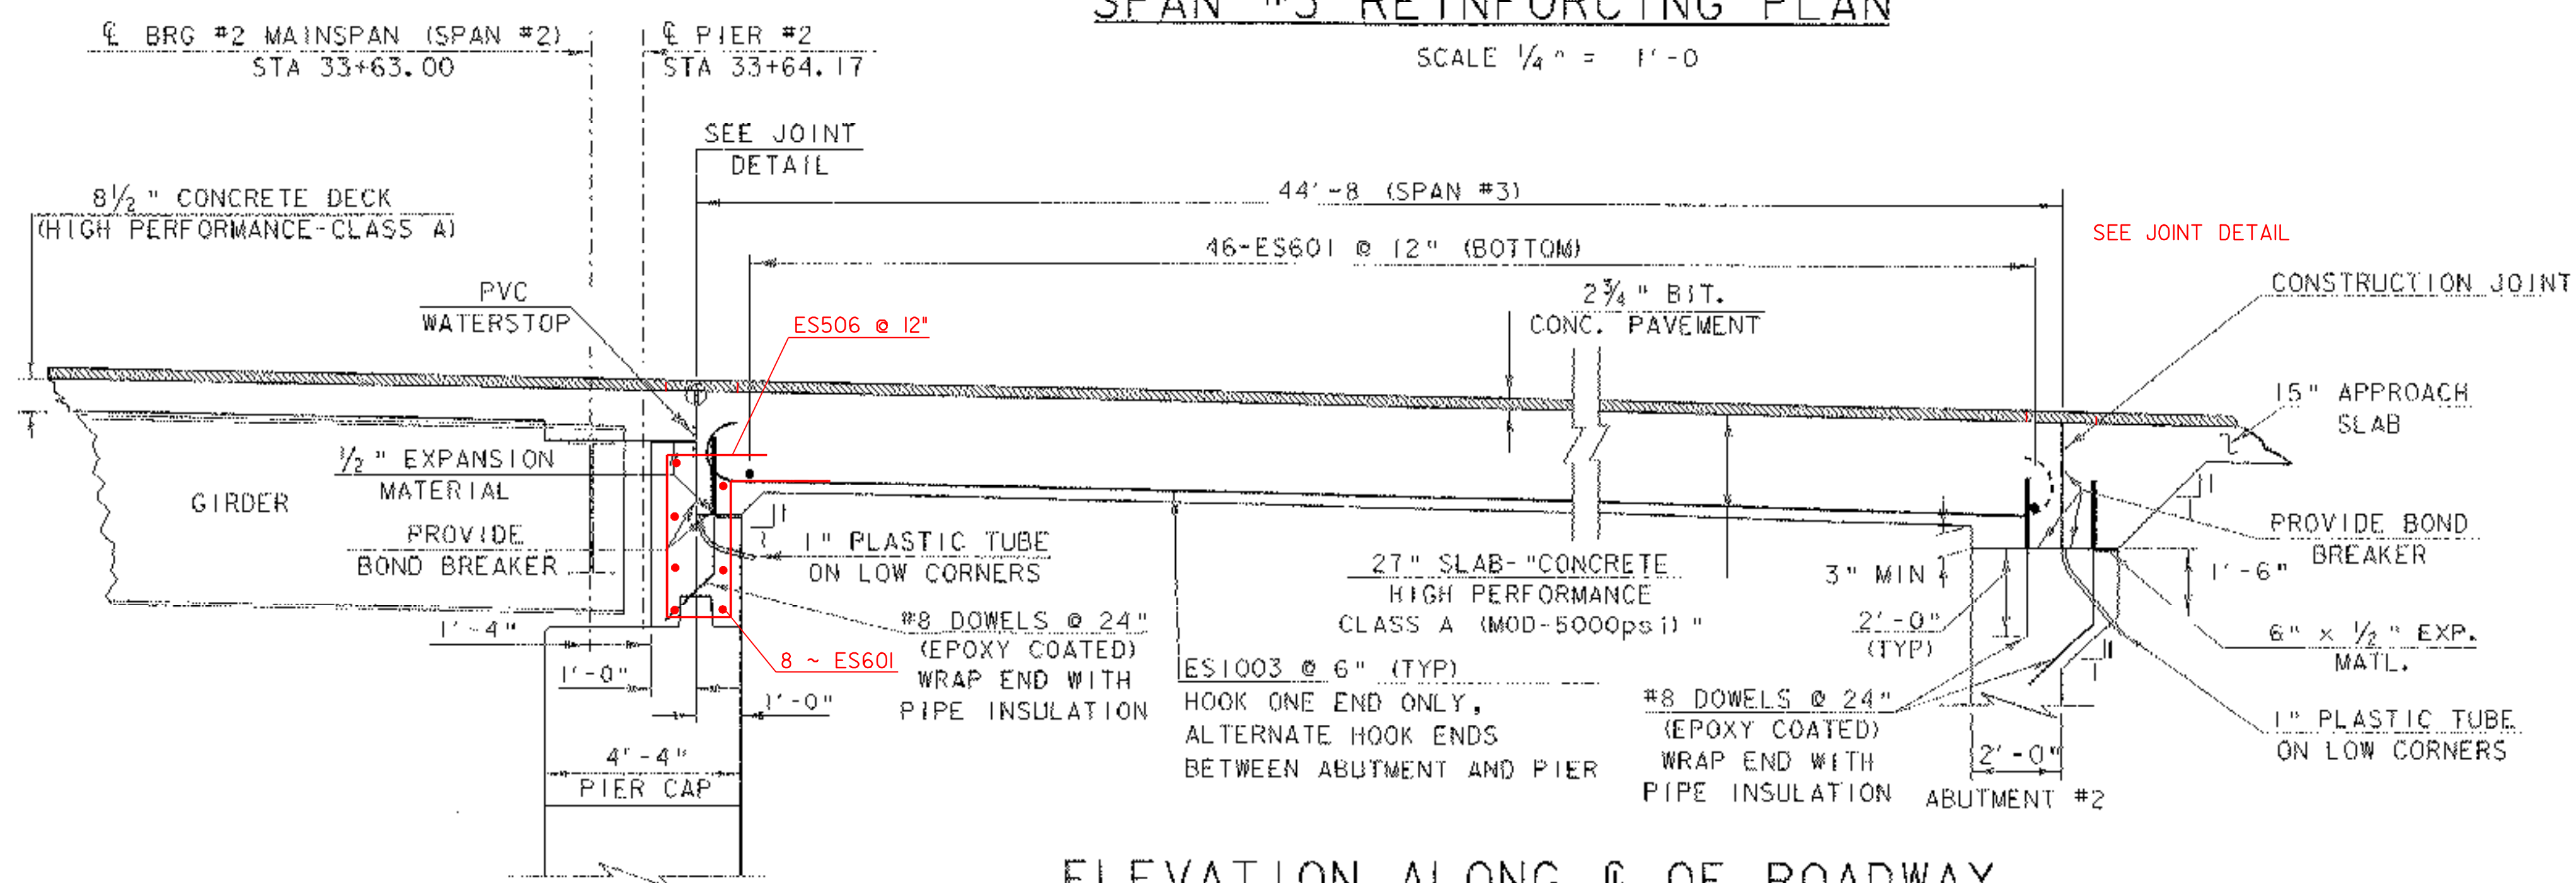

ELEVATION ALONG & OF ROADWAY

SCALE 3/8" = 1'-0"

NOTE:

1. SEE SHEET 38 FOR BRIDGE CAMBER
2. ▲ = CUT TO FIT IN FIELD
3. 3" CLR. UNLESS OTHERWISE SPECIFIED ON THE PLANS

SCALE 1/4" = 1'-0"  
0 2 4 6

SCALE 3/8" = 1'-0"  
0 1 2 3 4

SCALE 3/4" = 1'-0"  
0 1 2

PROJECT: HARTFORD	PROJECT NO.: BRO-BTN 2004 (1)
DESIGN FILE NAME: B9j045/structures/sj045sup.dgn	PLOT DATE: 11-FEB-2005
IPARM FILE NAME: sj045span3.1	DRAWN BY: T. HUSK
DESIGNED BY: K. M. HIGGINS	CHECKED BY: K. M. HIGGINS
SQUAD LEADER: C. P. WILLIAMS	
SPAN #3 DETAILS	SHEET: 35 OF 97