


\* NO WELD FOR 1" (VERT. LEG OF BRACE ONLY) (TYP ALL BRACES)

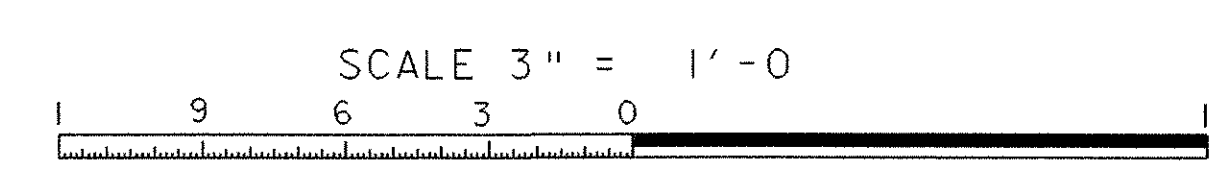

PROJECT: HARTFORD	PROJECT NO. # BR0-BTN 2004 (1)
DESIGN FILE NAME: /89j045/structures/sj045brg.dgn	PLOT DATE: 11-FEB-2005
IPARM FILE NAME: sj045fixbrg.i	DRAWN BY: K. M. HIGGINS
DESIGNED BY: K. M. HIGGINS	CHECKED BY: M. LONGSTREET
SQUAD LEADER: C. P. WILLIAMS	FIXED BEARING DETAILS (PIER #2)
	SHEET: 41 OF 97