



APPROACH SLAB No. 1 PLAN
SCALE 1/4" = 1'-0"

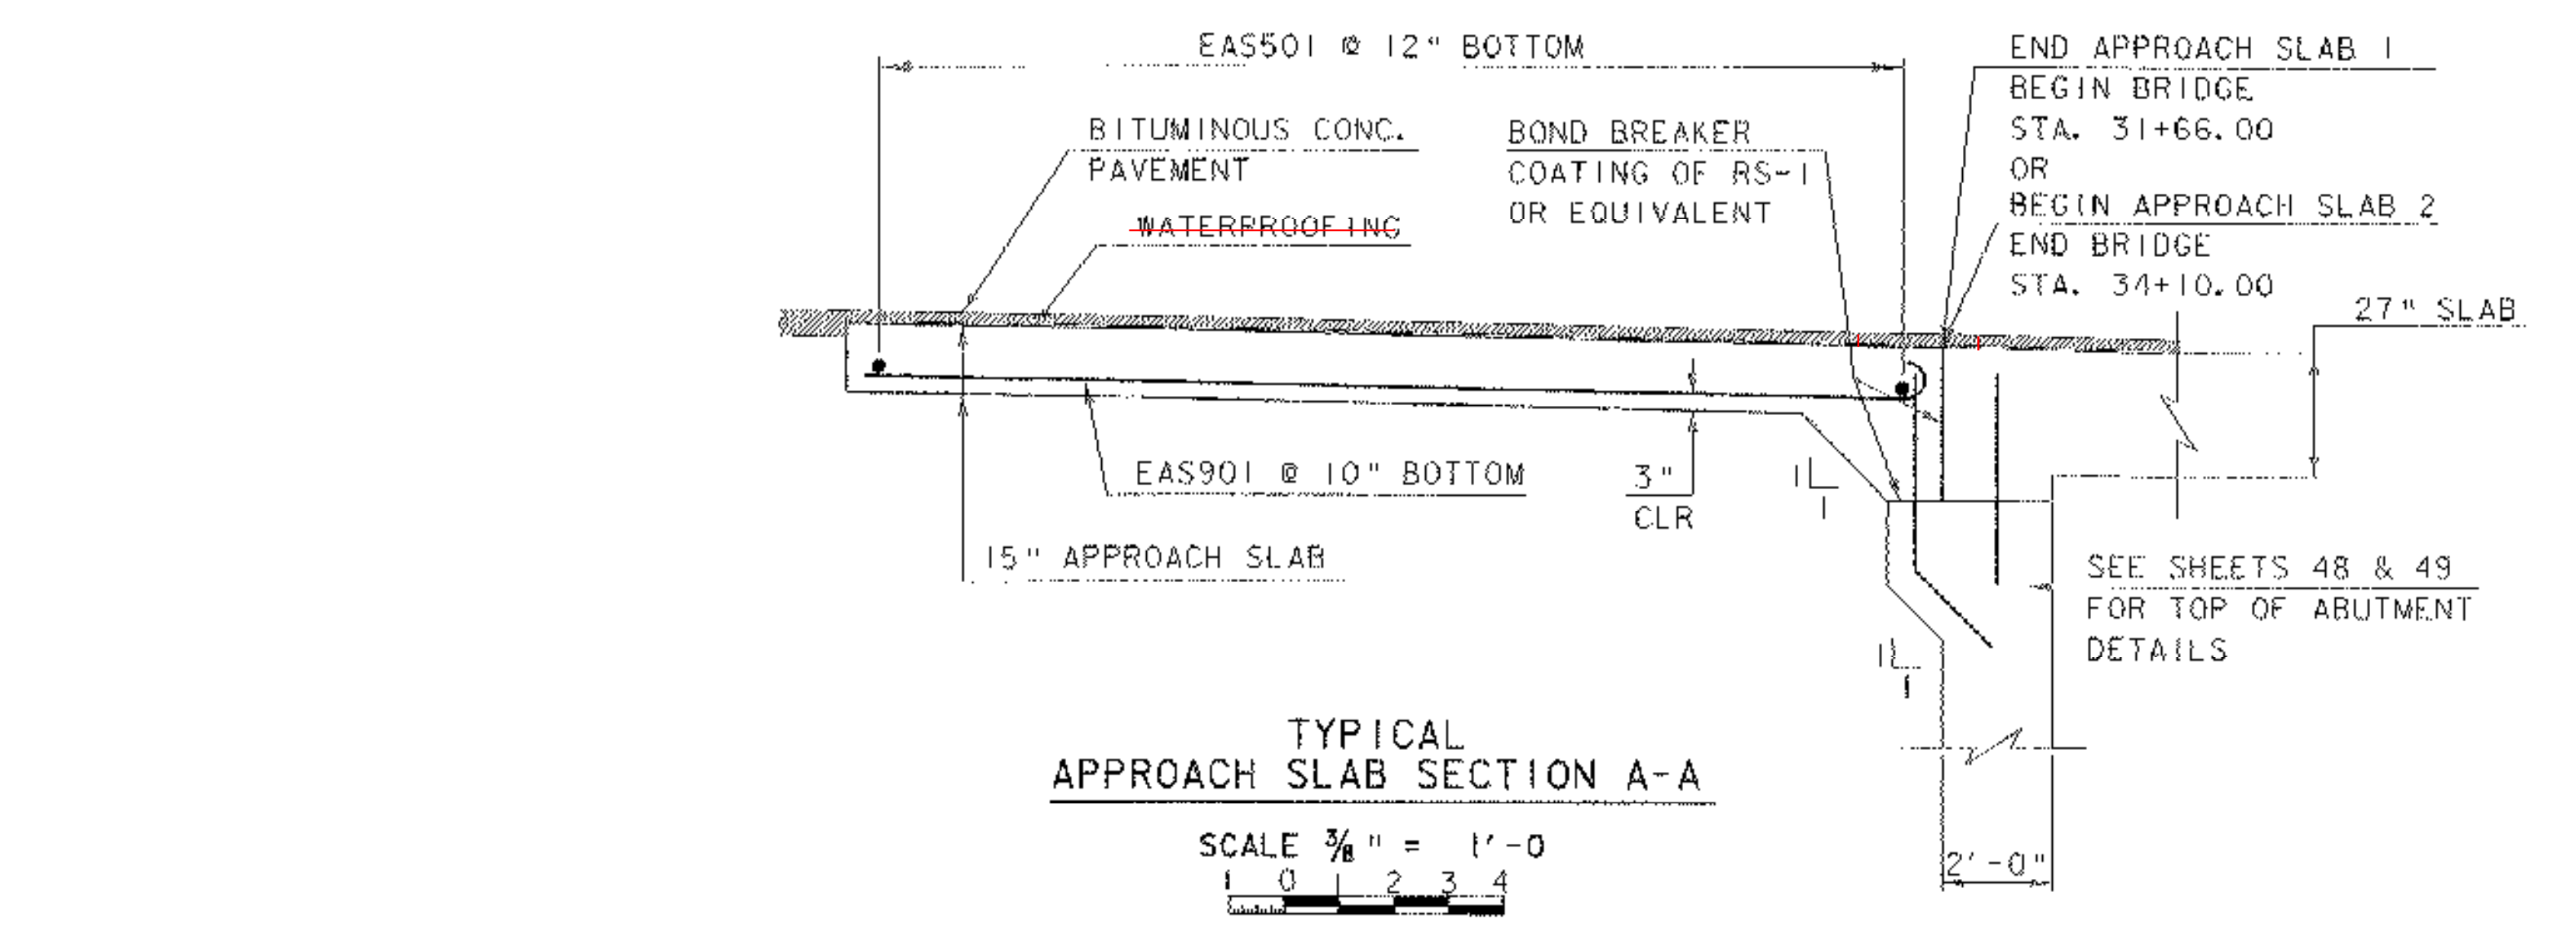

TYPICAL APPROACH SLAB SECTION A-A
SCALE 3/8" = 1'-0"

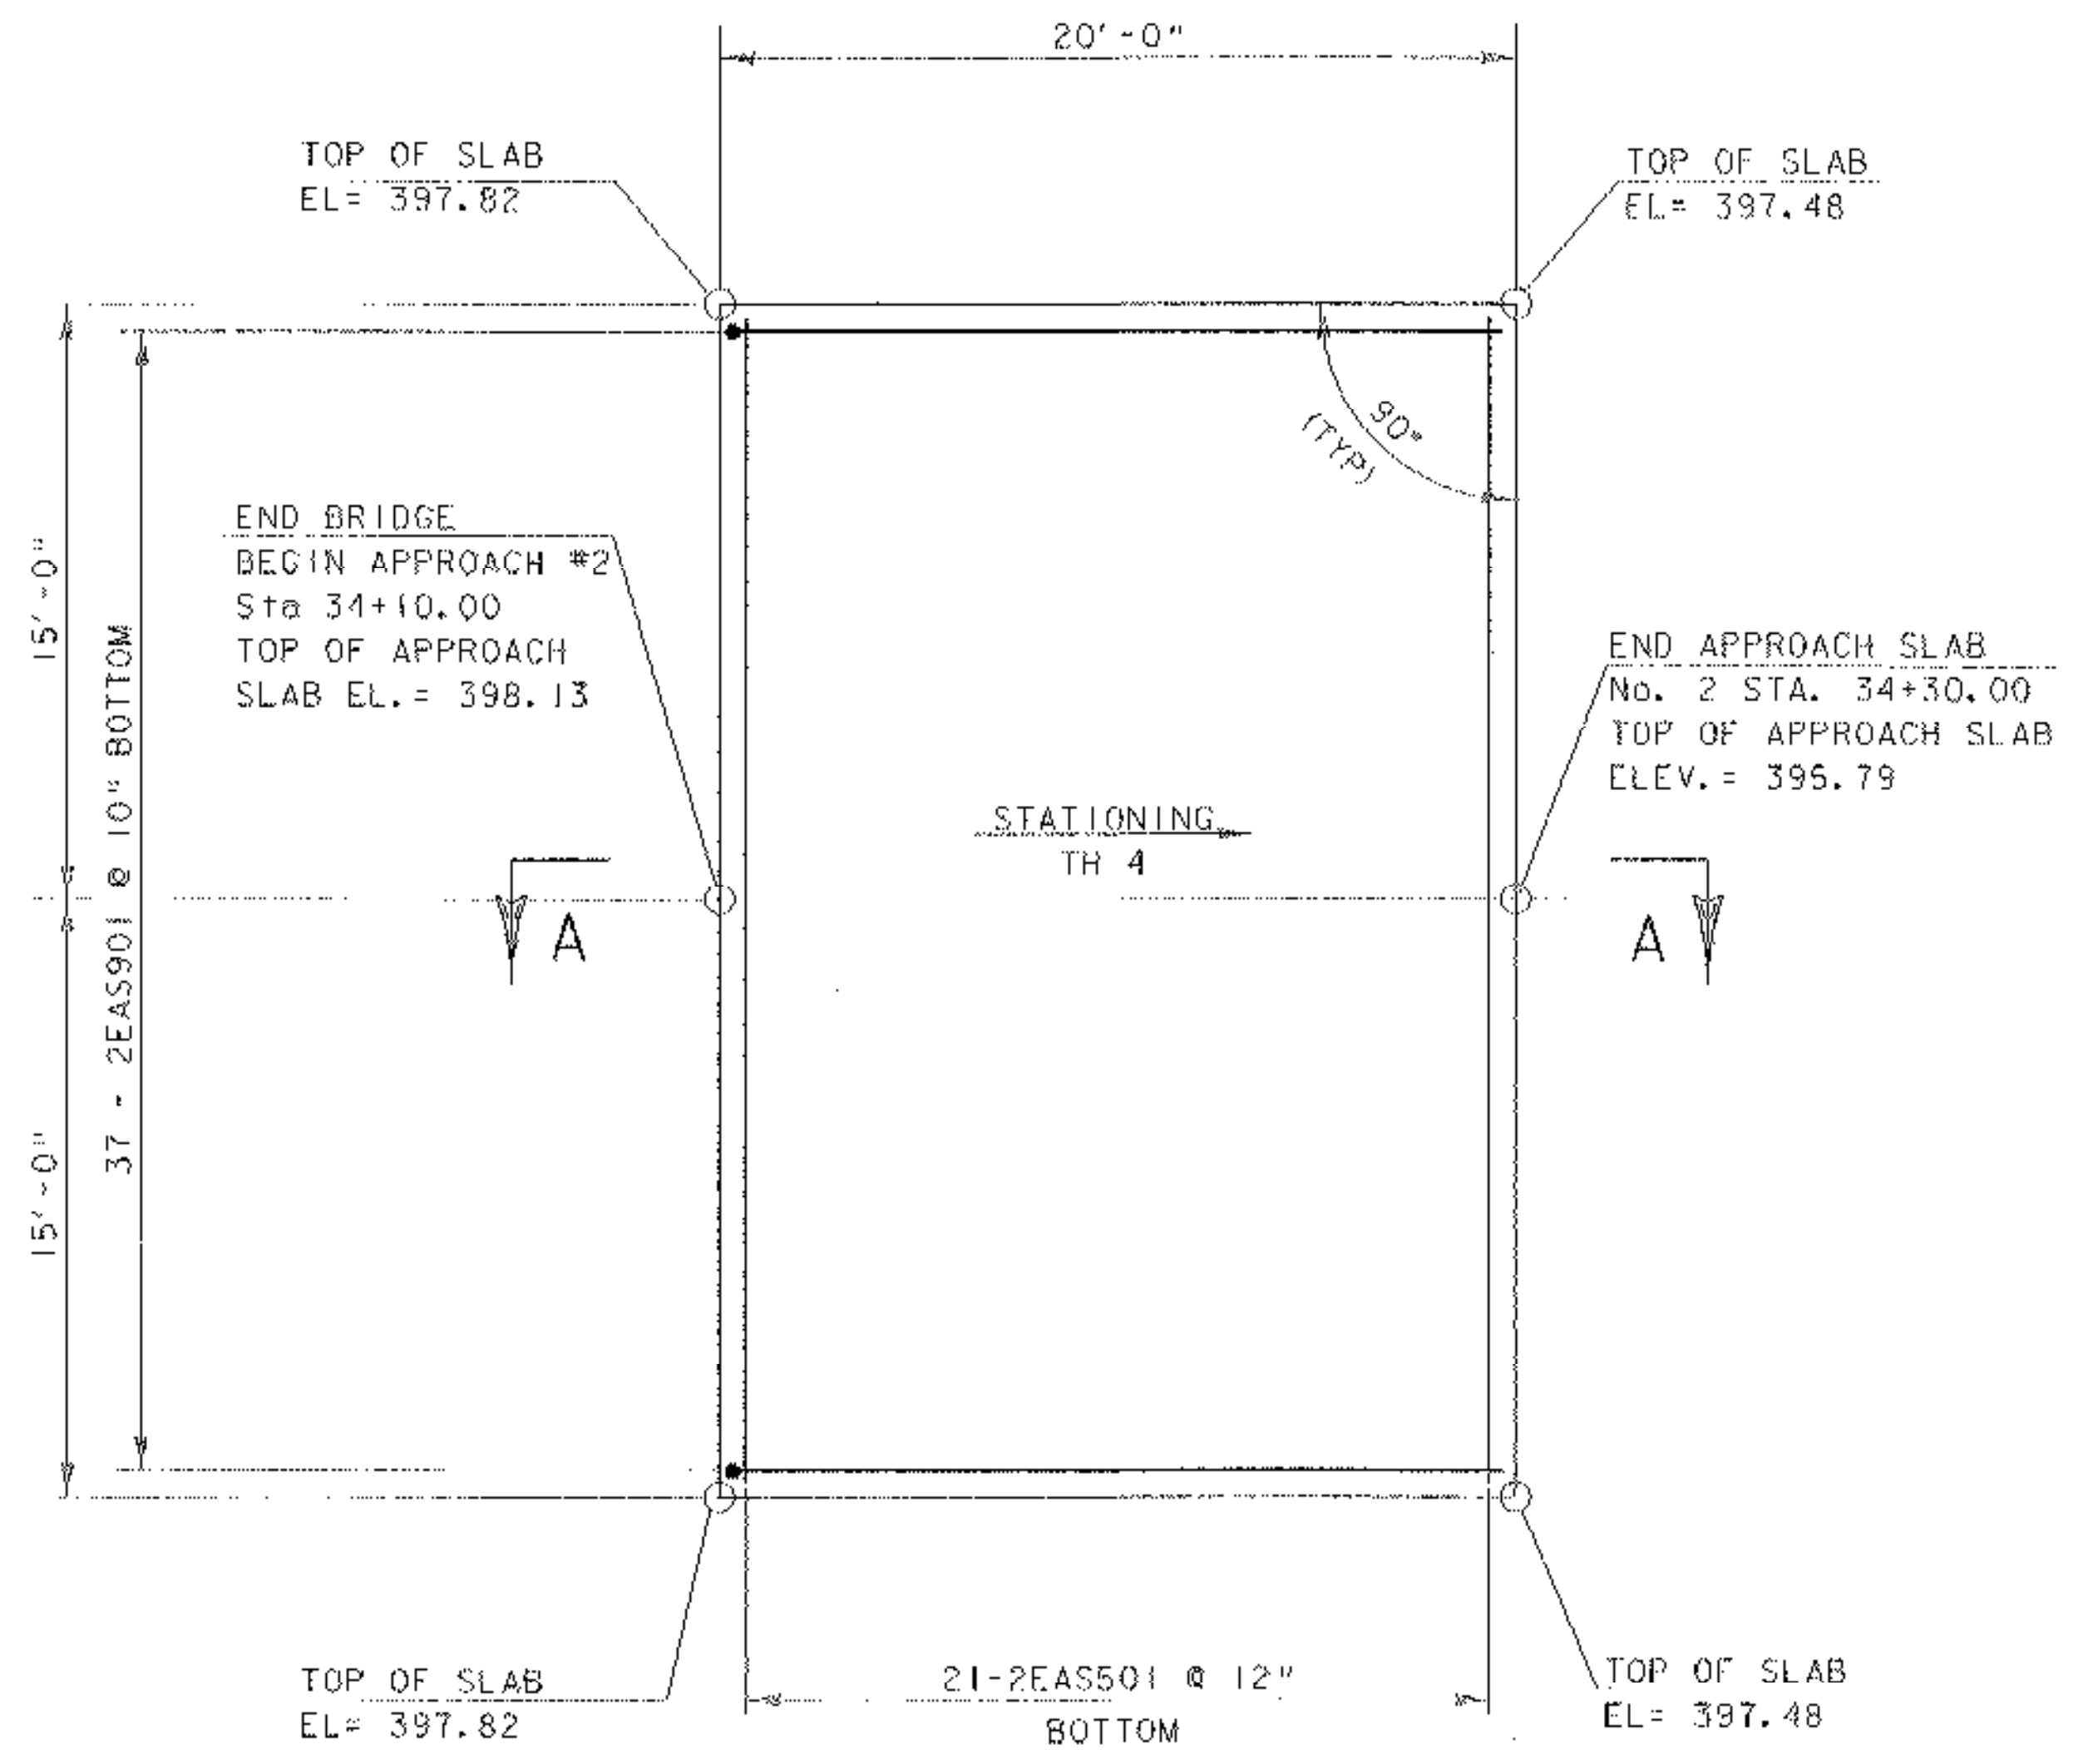

APPROACH SLAB No. 2 PLAN
SCALE 1/4" = 1'-0"

NOTES:
 NF = NEAR FACE
 FF = FAR FACE
 EF = EACH FACE
 ▲ = CUT TO FIT IN FIELD
 3" CLEAR UNLESS OTHERWISE SPECIFIED ON PLANS
 ALL LAPS ARE 2'-2" UNLESS OTHERWISE SPECIFIED ON PLANS

| | |
|--|-----------------------------------|
| PROJECT: HARTFORD | PROJECT NO. # BRO-BTN 2004 (1) |
| DESIGN FILE NAME: 89j045/structures/sj045sub.dgn | PLOT DATE: 11-FEB-2005 |
| IPARM FILE NAME: sj045applx2.i | DRAWN BY: M LONGSTREET |
| DESIGNED BY: K. M. HIGGINS | CHECKED BY: K. M. HIGGINS |
| SQUAD LEADER: C. P. WILLIAMS | |
| APPROACH SLAB 1 & 2 DETAILS | SHEET: 47 OF 97 |