



ABUTMENT #1 PLAN

SCALE 1/4" = 1'-0"

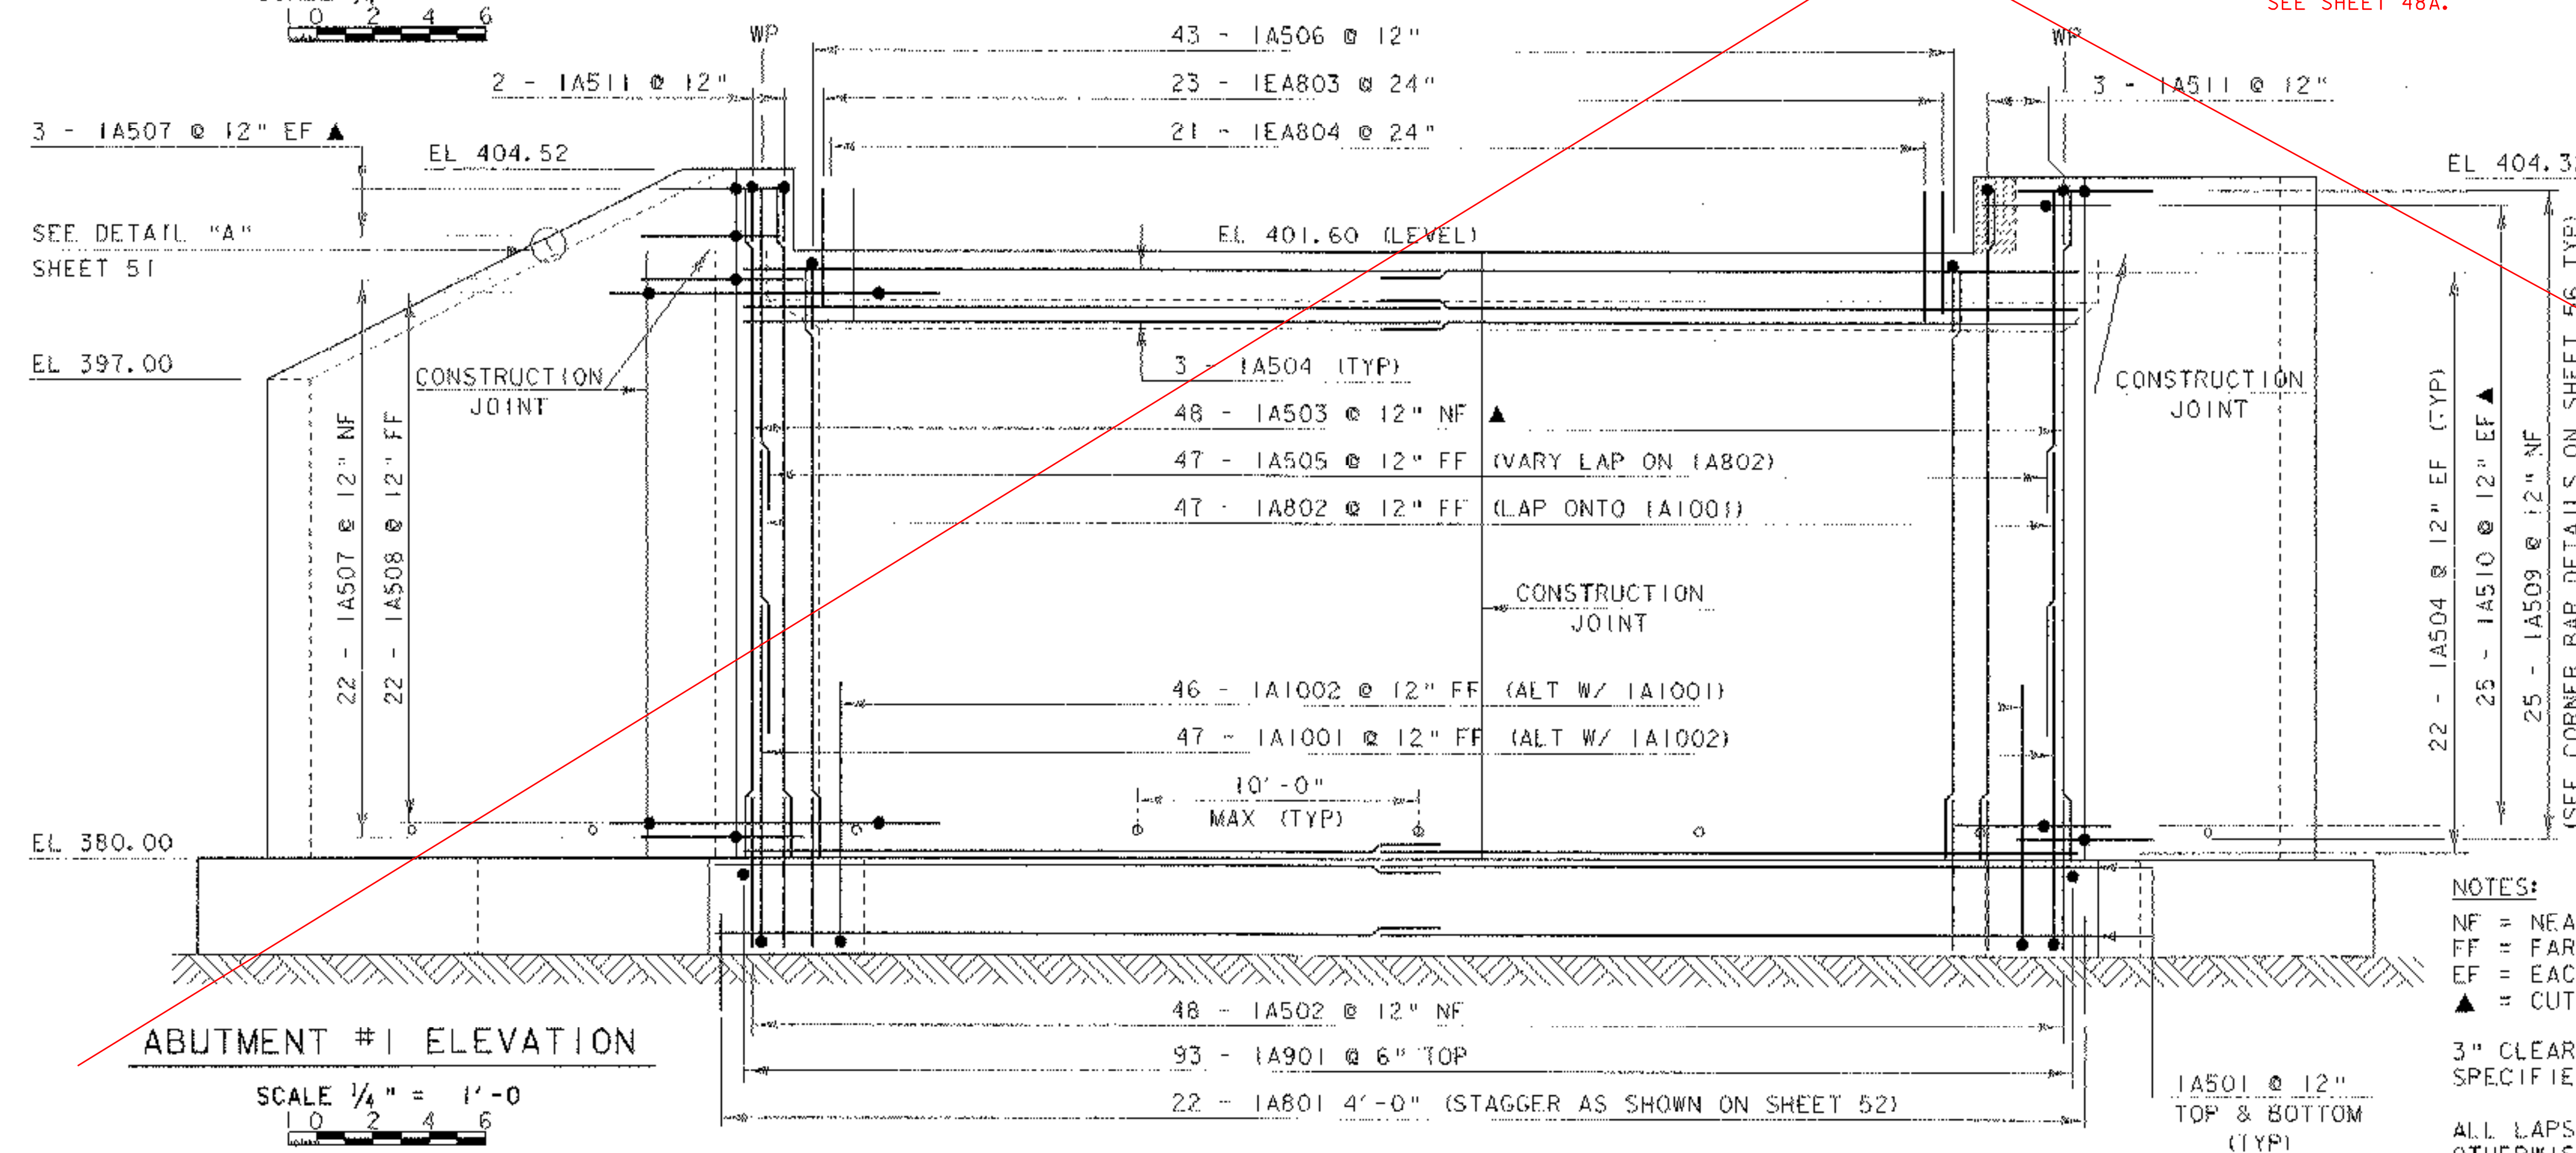

ABUTMENT #1 ELEVATION

SCALE 1/4" = 1'-0"

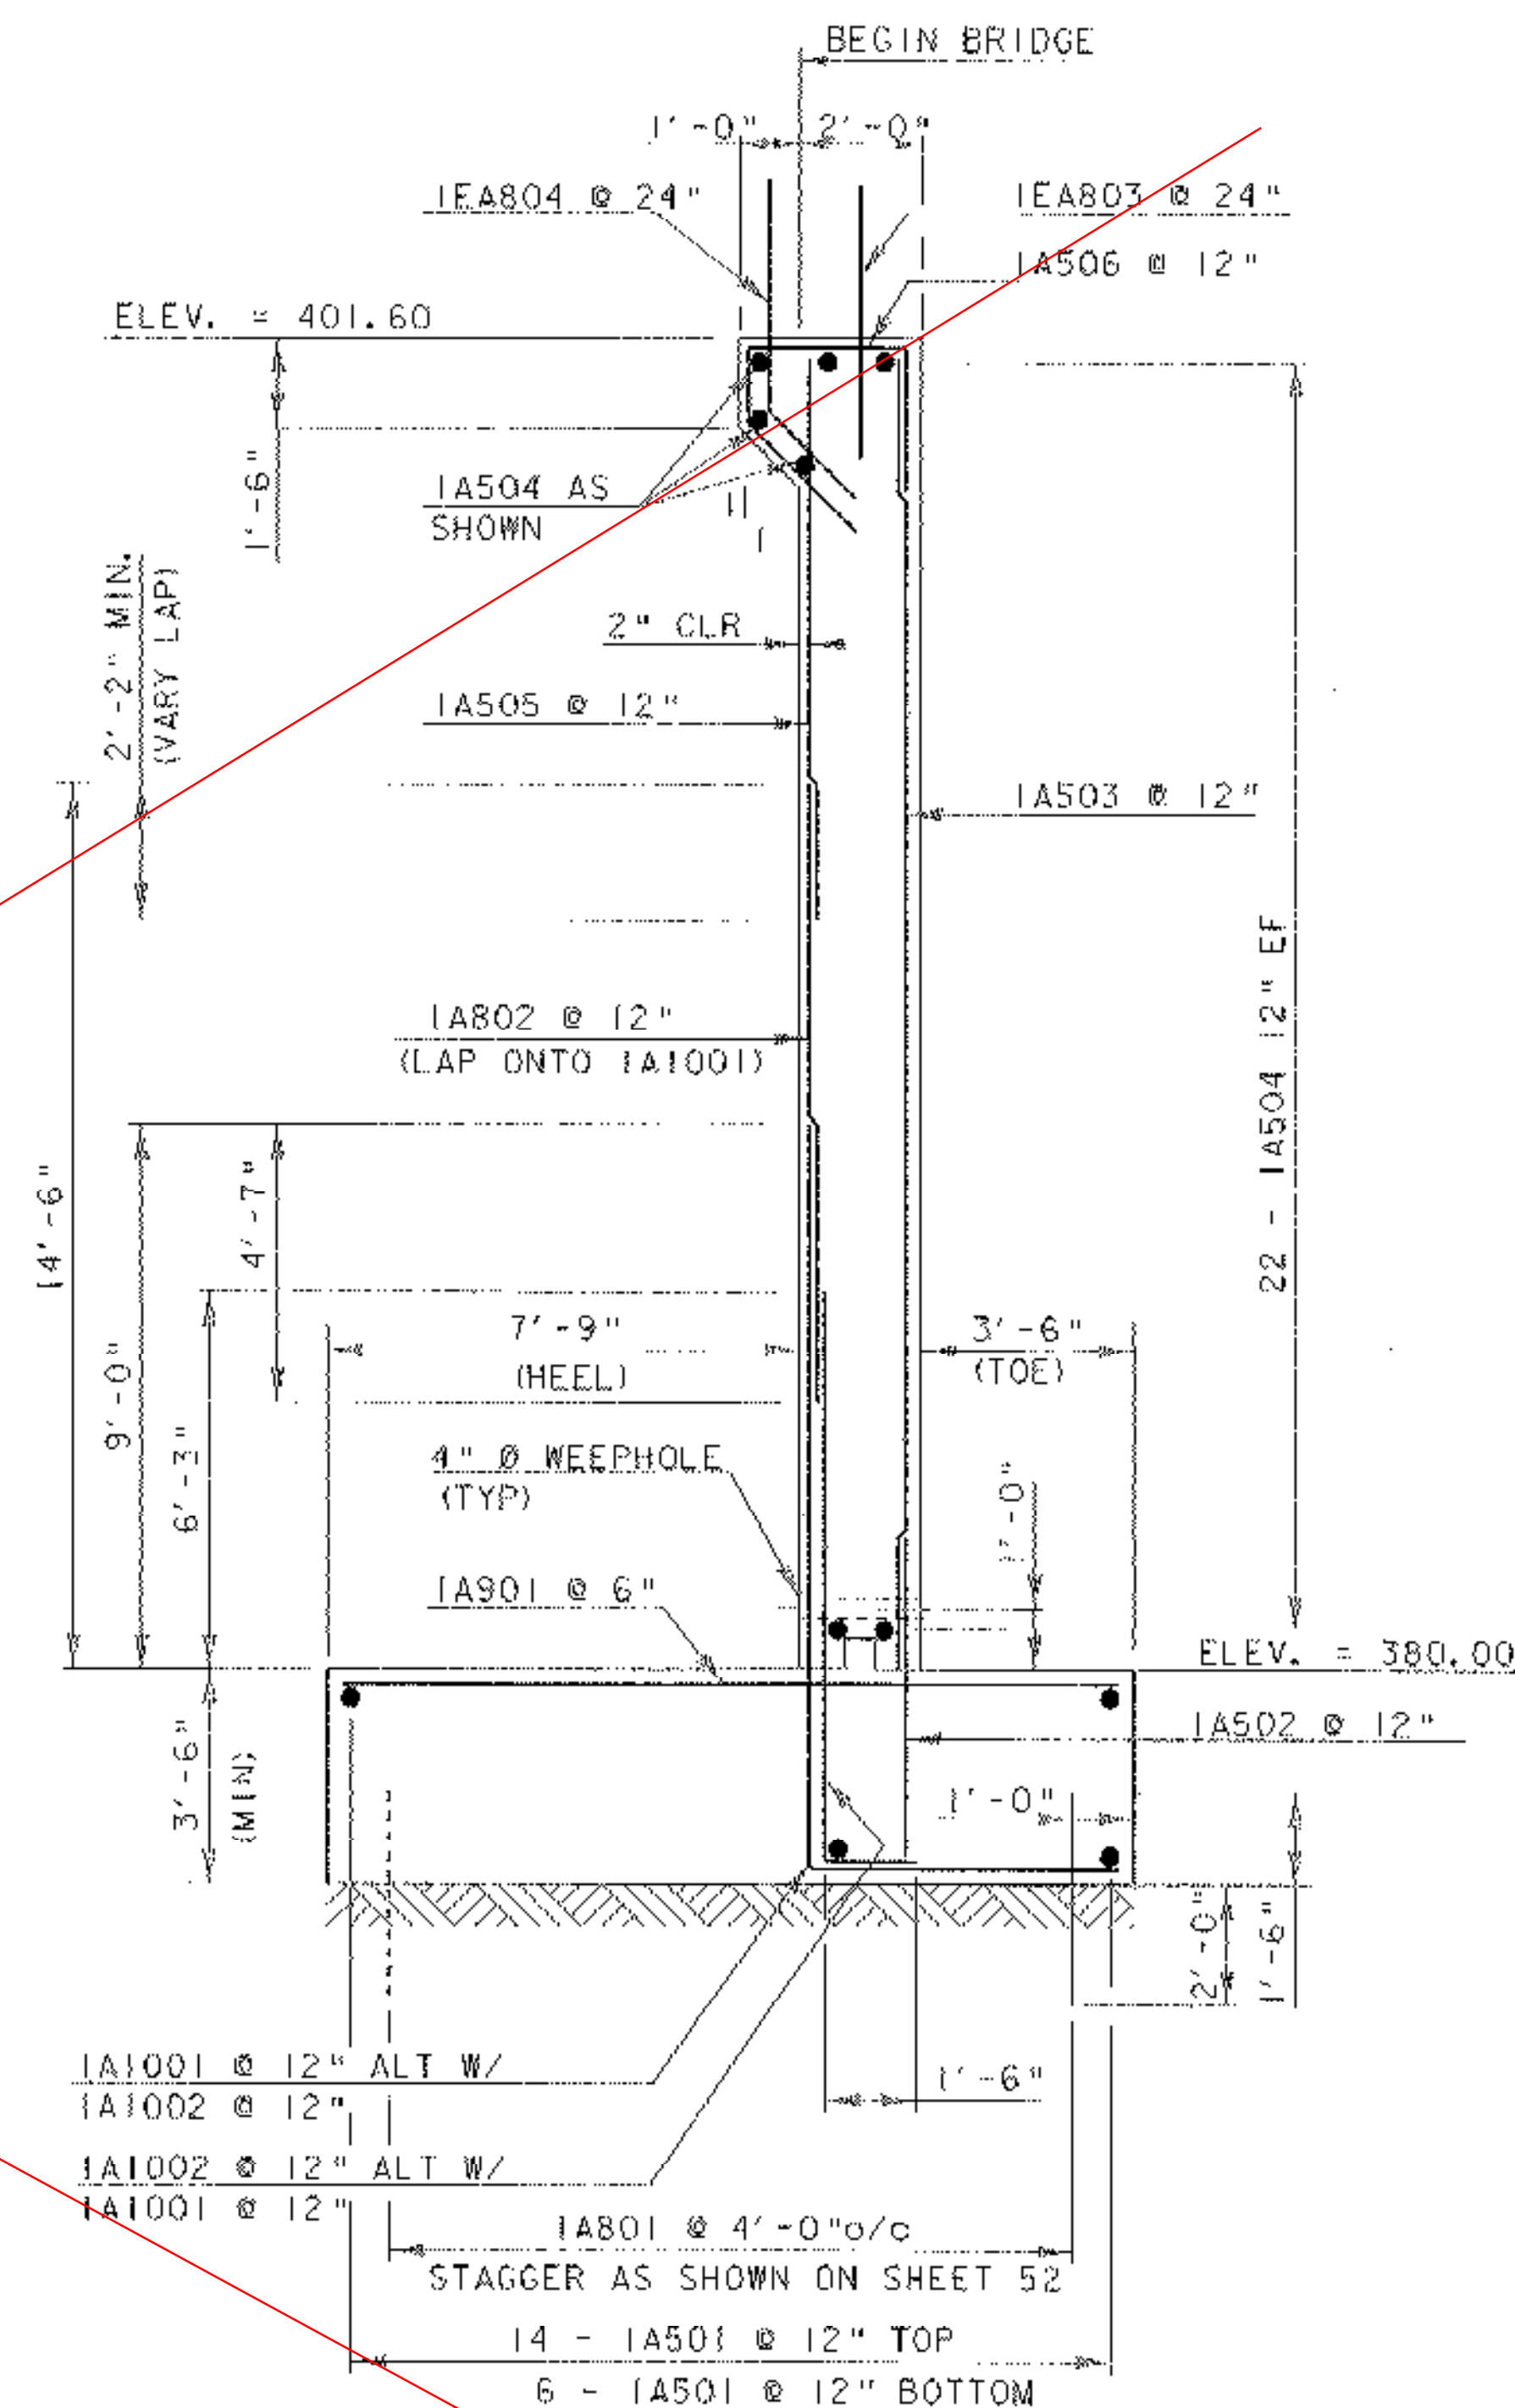

ABUTMENT #1 TYPICAL SECTION

SCALE 3/8" = 1'-0"



NOTE:

THE TOP OF THE FOOTING ELEVATION FOR ABUTMENT #1 WAS SET BASED ON THE LEDGE ELEVATION DETERMINED FROM B-04. ADJUSTMENTS IN FOOTING ELEVATION AND GEOMETRY ARE EXPECTED AS ACTUAL LEDGE ELEVATION AND CONDITION IS DETERMINED THROUGH EXCAVATION. THE ELEVATION AND GEOMETRY SHOWN REPRESENT THE LOWEST LEDGE ELEVATION EXPECTED.

NOTES:

- NF = NEAR FACE
- FF = FAR FACE
- EF = EACH FACE
- ▲ = CUT TO FIT IN FIELD

3" CLEAR UNLESS OTHERWISE SPECIFIED ON PLANS

ALL LAPS ARE 2'-2" UNLESS OTHERWISE SPECIFIED ON PLANS

SEE SHEET 48A.

PROJECT: <b>HARTFORD</b>	PROJECT NO.: <b>BRO-BTN 2004 (1)</b>
DESIGN FILE NAME: 89j045/structures/sj045sub.dgn	PLOT DATE: 11-FEB-2005
IPARM FILE NAME: sj045sub.i	DRAWN BY: M LONGSTREET
DESIGNED BY: K. M. HIGGINS	CHECKED BY: K. M. HIGGINS
SQUAD LEADER: C. P. WILLIAMS	SHEET: 48 OF 97