



ABUTMENT #1 PLAN REVISED

SCALE 1/4" = 1'-0"
 1 0 2 4 6

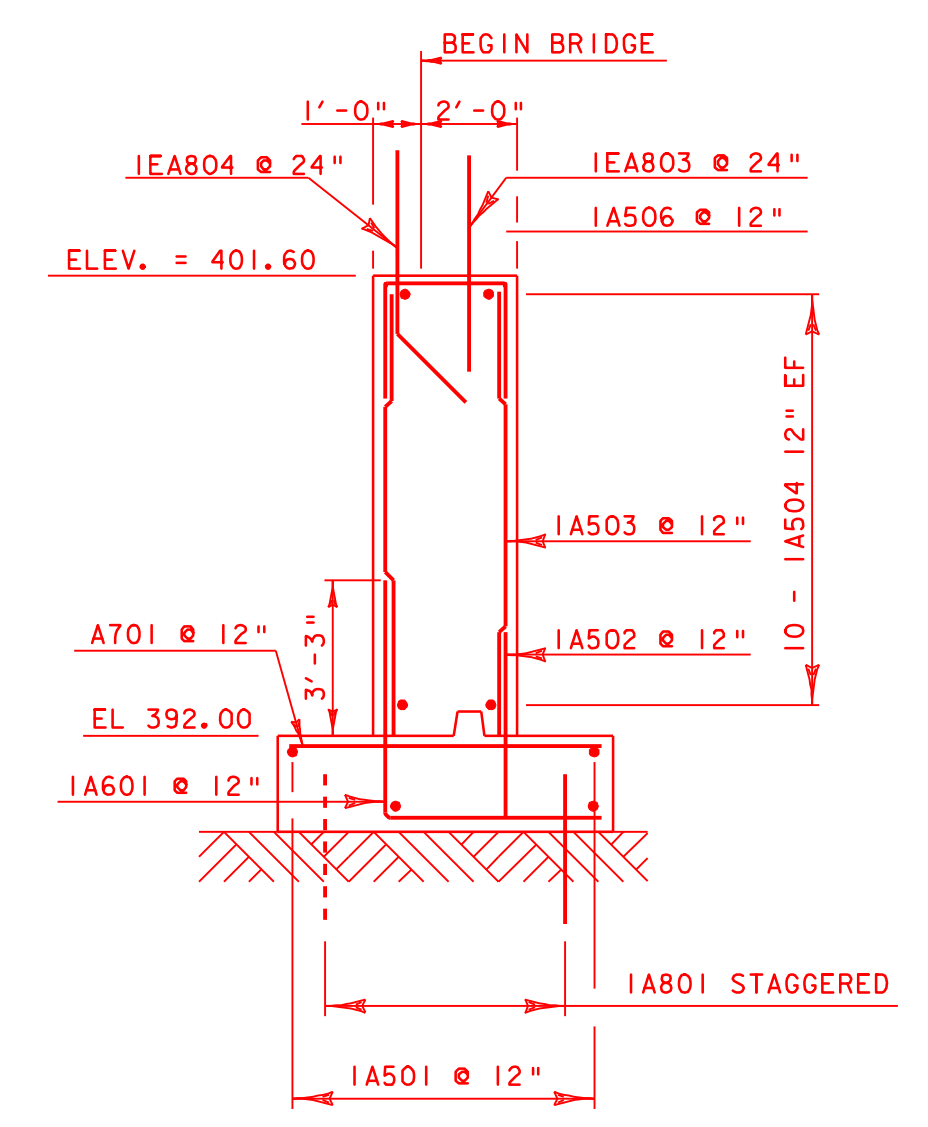


ABUTMENT #1 TYPICAL SECTION

WITH NEW STEEL
LEFT SIDE

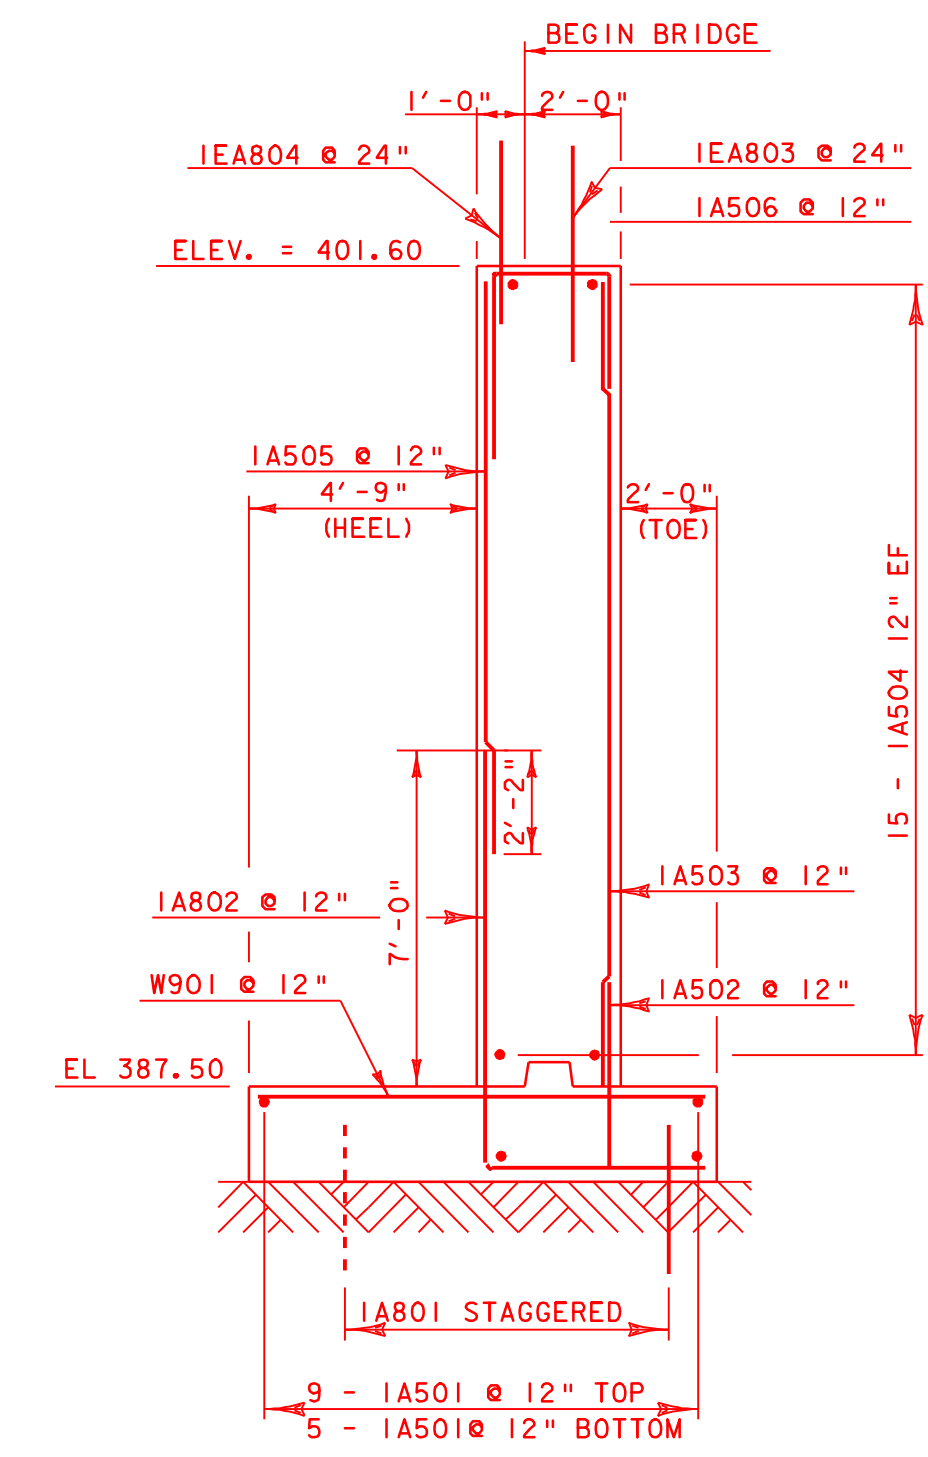

ABUTMENT #1 TYPICAL SECTION

WITH NEW STEEL
RIGHT SIDE

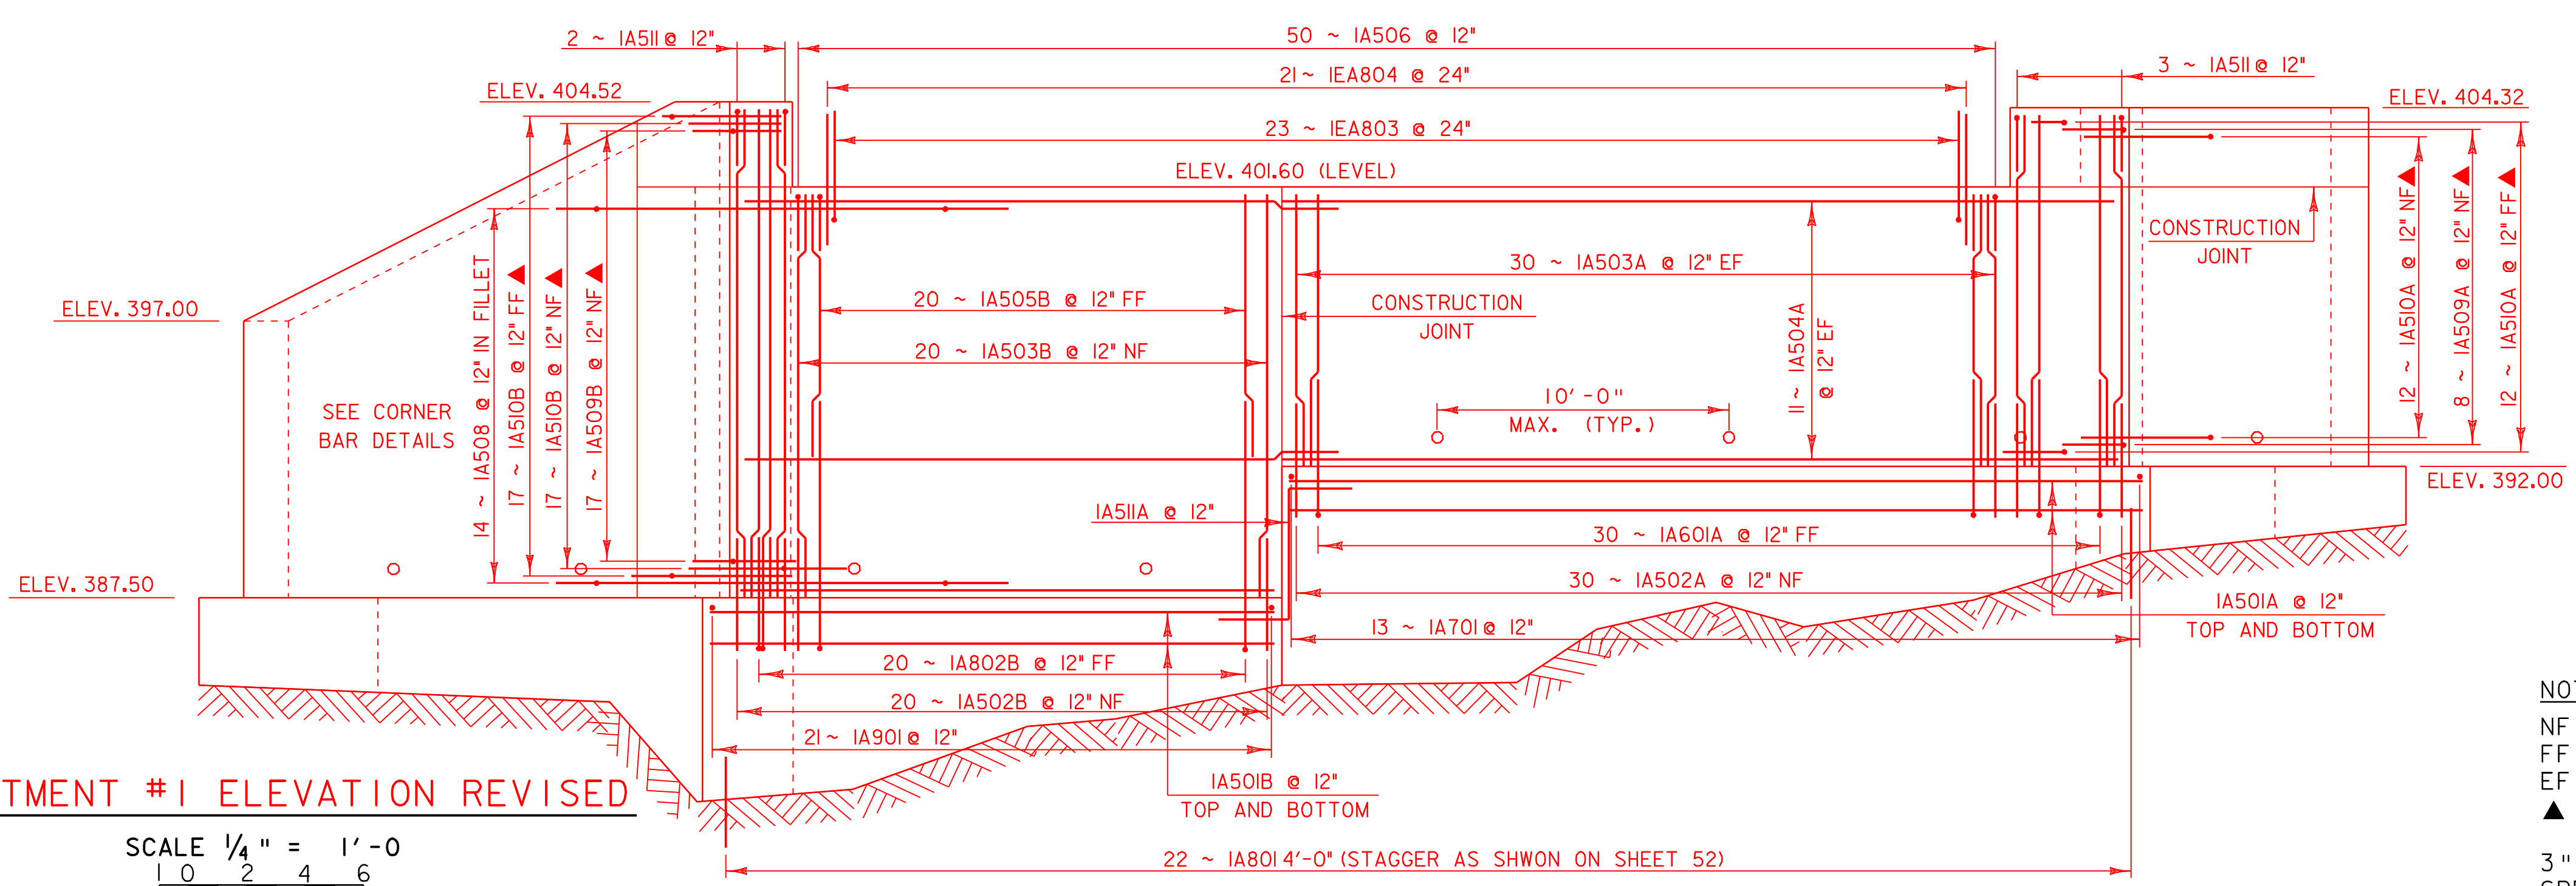

ABUTMENT #1 ELEVATION REVISED

SCALE 1/4" = 1'-0"
 1 0 2 4 6

- NOTES:**
 NF = NEAR FACE
 FF = FAR FACE
 EF = EACH FACE
 ▲ = CUT TO FIT IN FIELD

3" CLEAR UNLESS OTHERWISE SPECIFIED ON PLANS

ALL LAPS ARE 2'-2" UNLESS OTHERWISE SPECIFIED ON PLANS

PROJECT: HARTFORD	PROJECT NO.: BRO-BTN 2004 (1)
DESIGN FILE NAME: 89j045/structures/sj045sub.dgn	PLOT DATE: 09-MAY-2007 13:08
IPARM FILE NAME: sj045ab1.i	DRAWN BY: M LONGSTREET
DESIGNED BY: K. M. HIGGINS	CHECKED BY: K. M. HIGGINS
SQUAD LEADER: C. P. WILLIAMS	SHEET: 48A OF 97
ABUTMENT #1 DETAILS	