
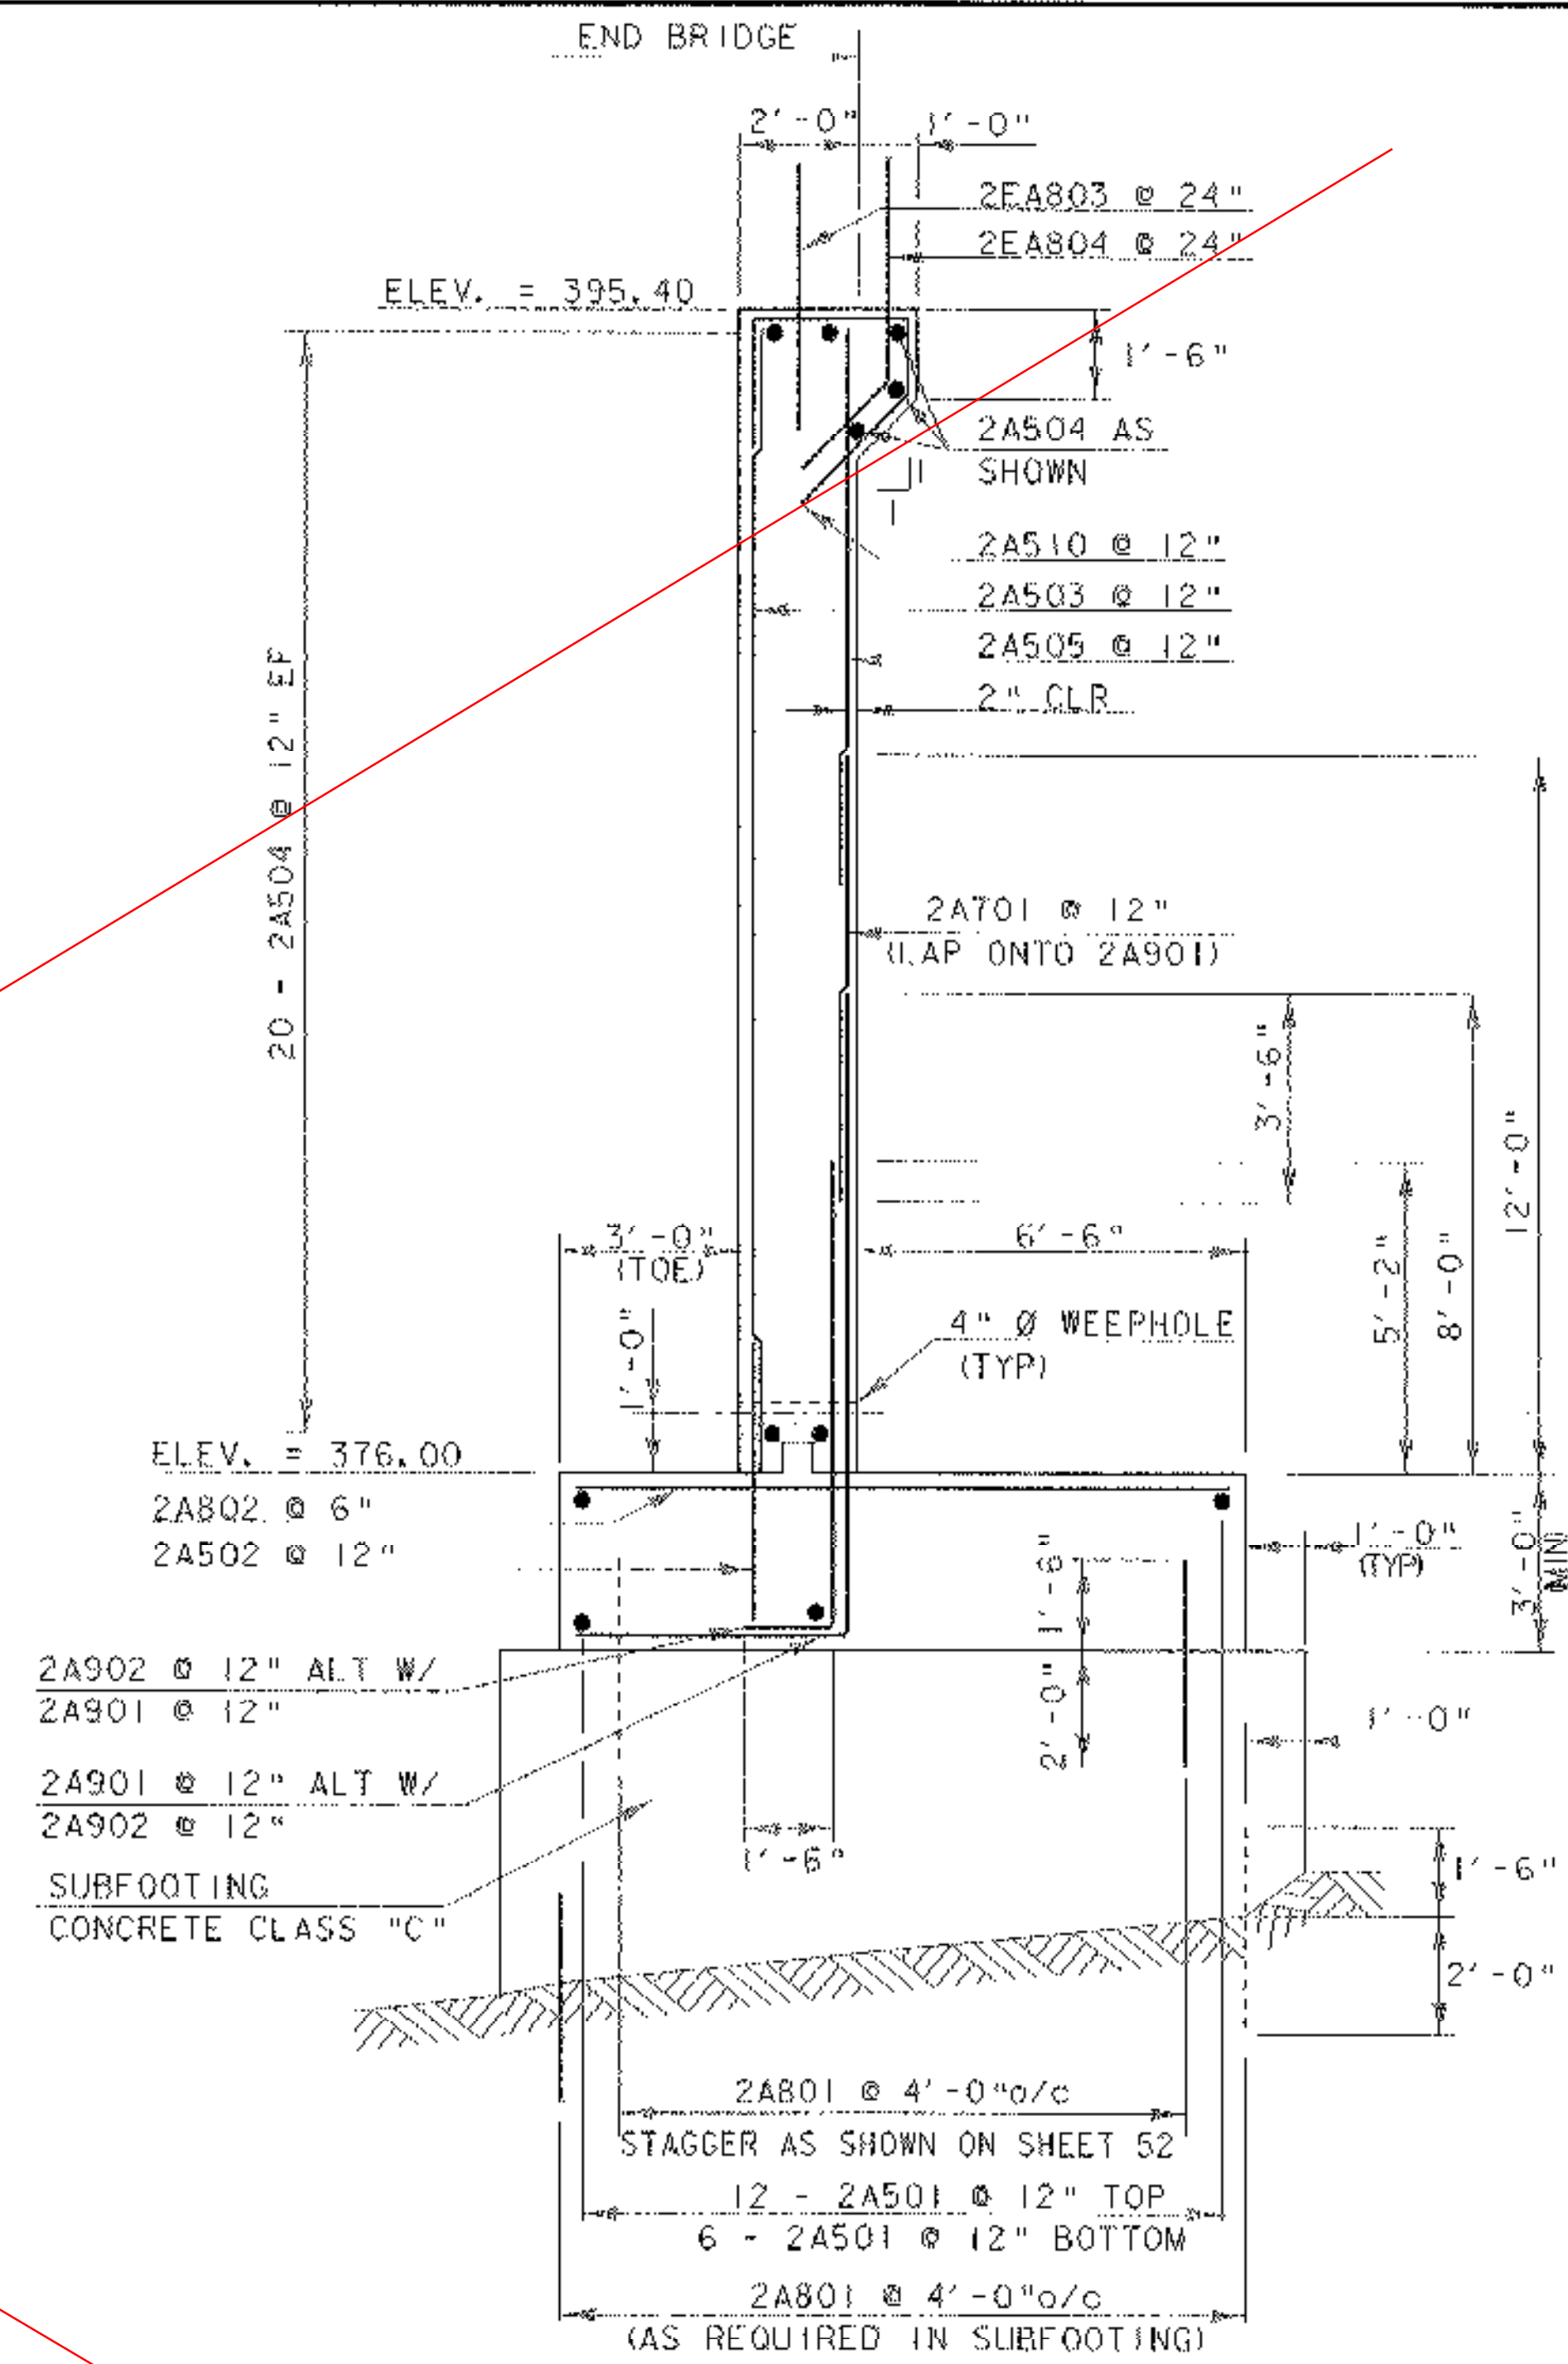


**ABUTMENT #2 PLAN**

SCALE 1/4" = 1'-0"  
 1 0 2 4 6

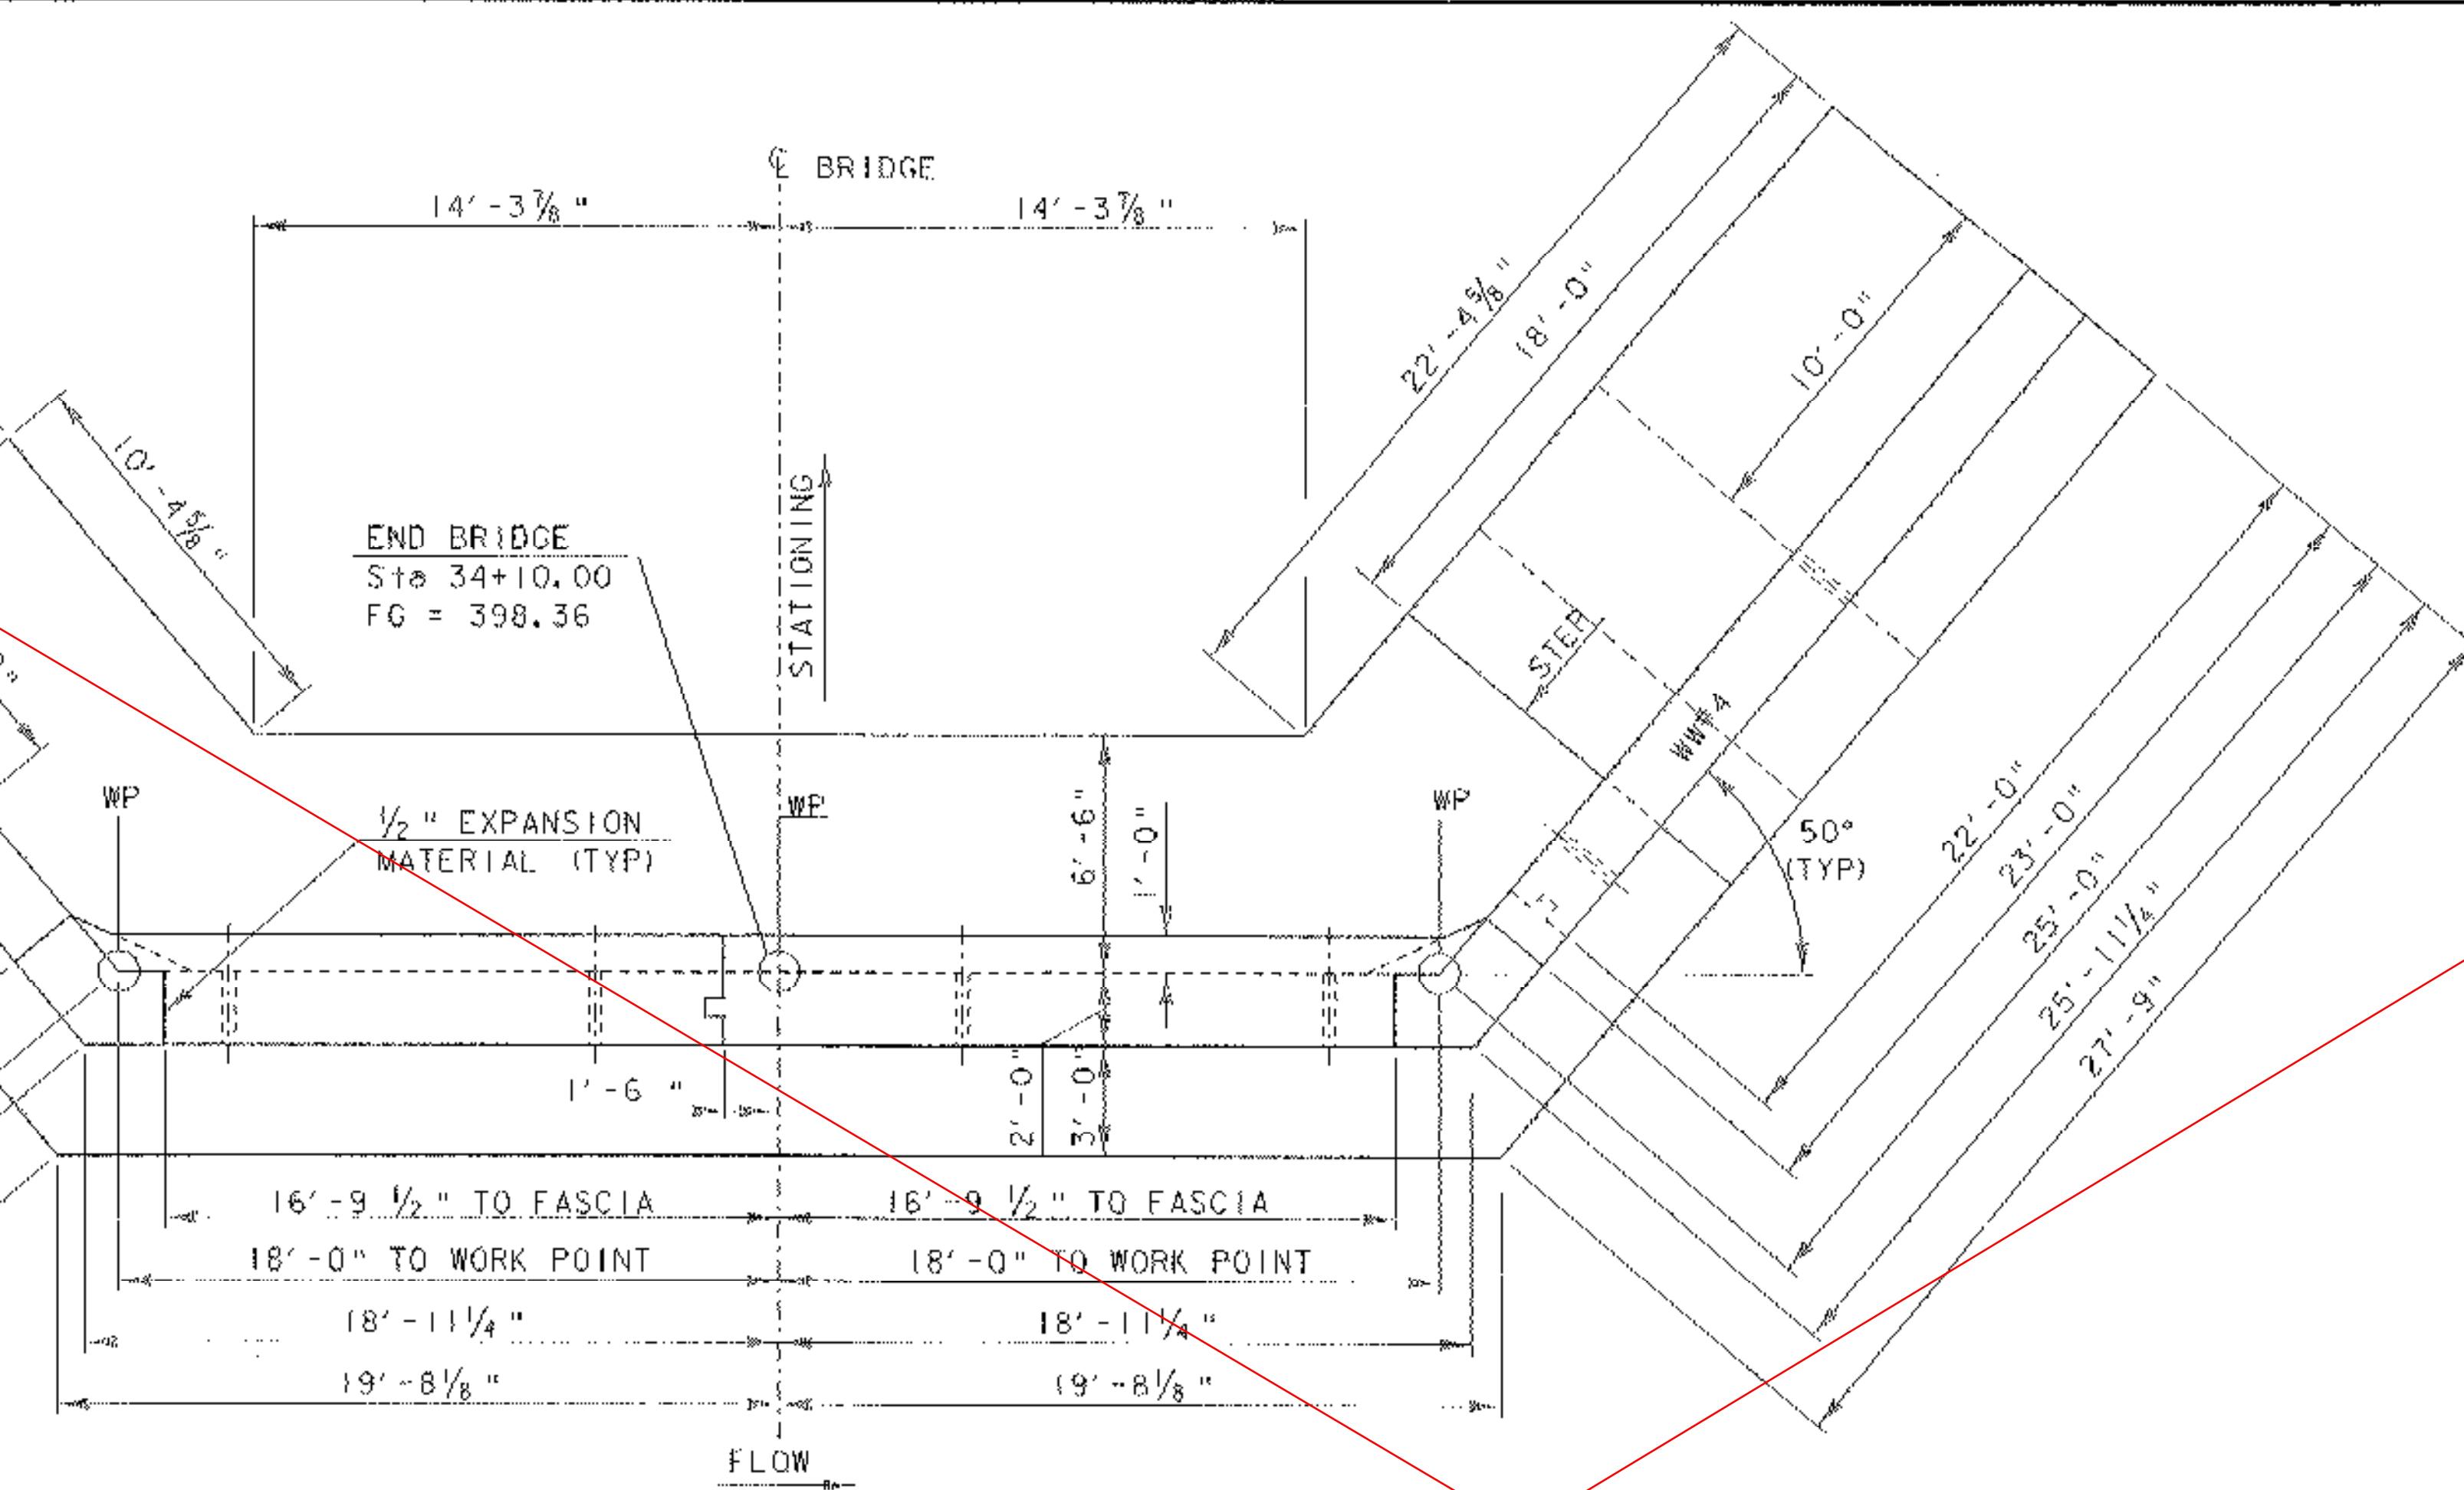

**ABUTMENT #2 TYPICAL SECTION**


SCALE 3/8" = 1'-0"  
 0 1 2 3 4

- NOTES:**
- NF = NEAR FACE
  - FF = FAR FACE
  - EF = EACH FACE
  - ▲ = CUT TO FIT IN FIELD
  - 3" CLEAR UNLESS OTHERWISE SPECIFIED ON PLANS
  - ALL LAPS ARE 2'-2" UNLESS OTHERWISE SPECIFIED ON PLANS

SEE REVISED SHEET

**ABUTMENT #2 ELEVATION**

SCALE 1/4" = 1'-0"  
 1 0 2 4 6

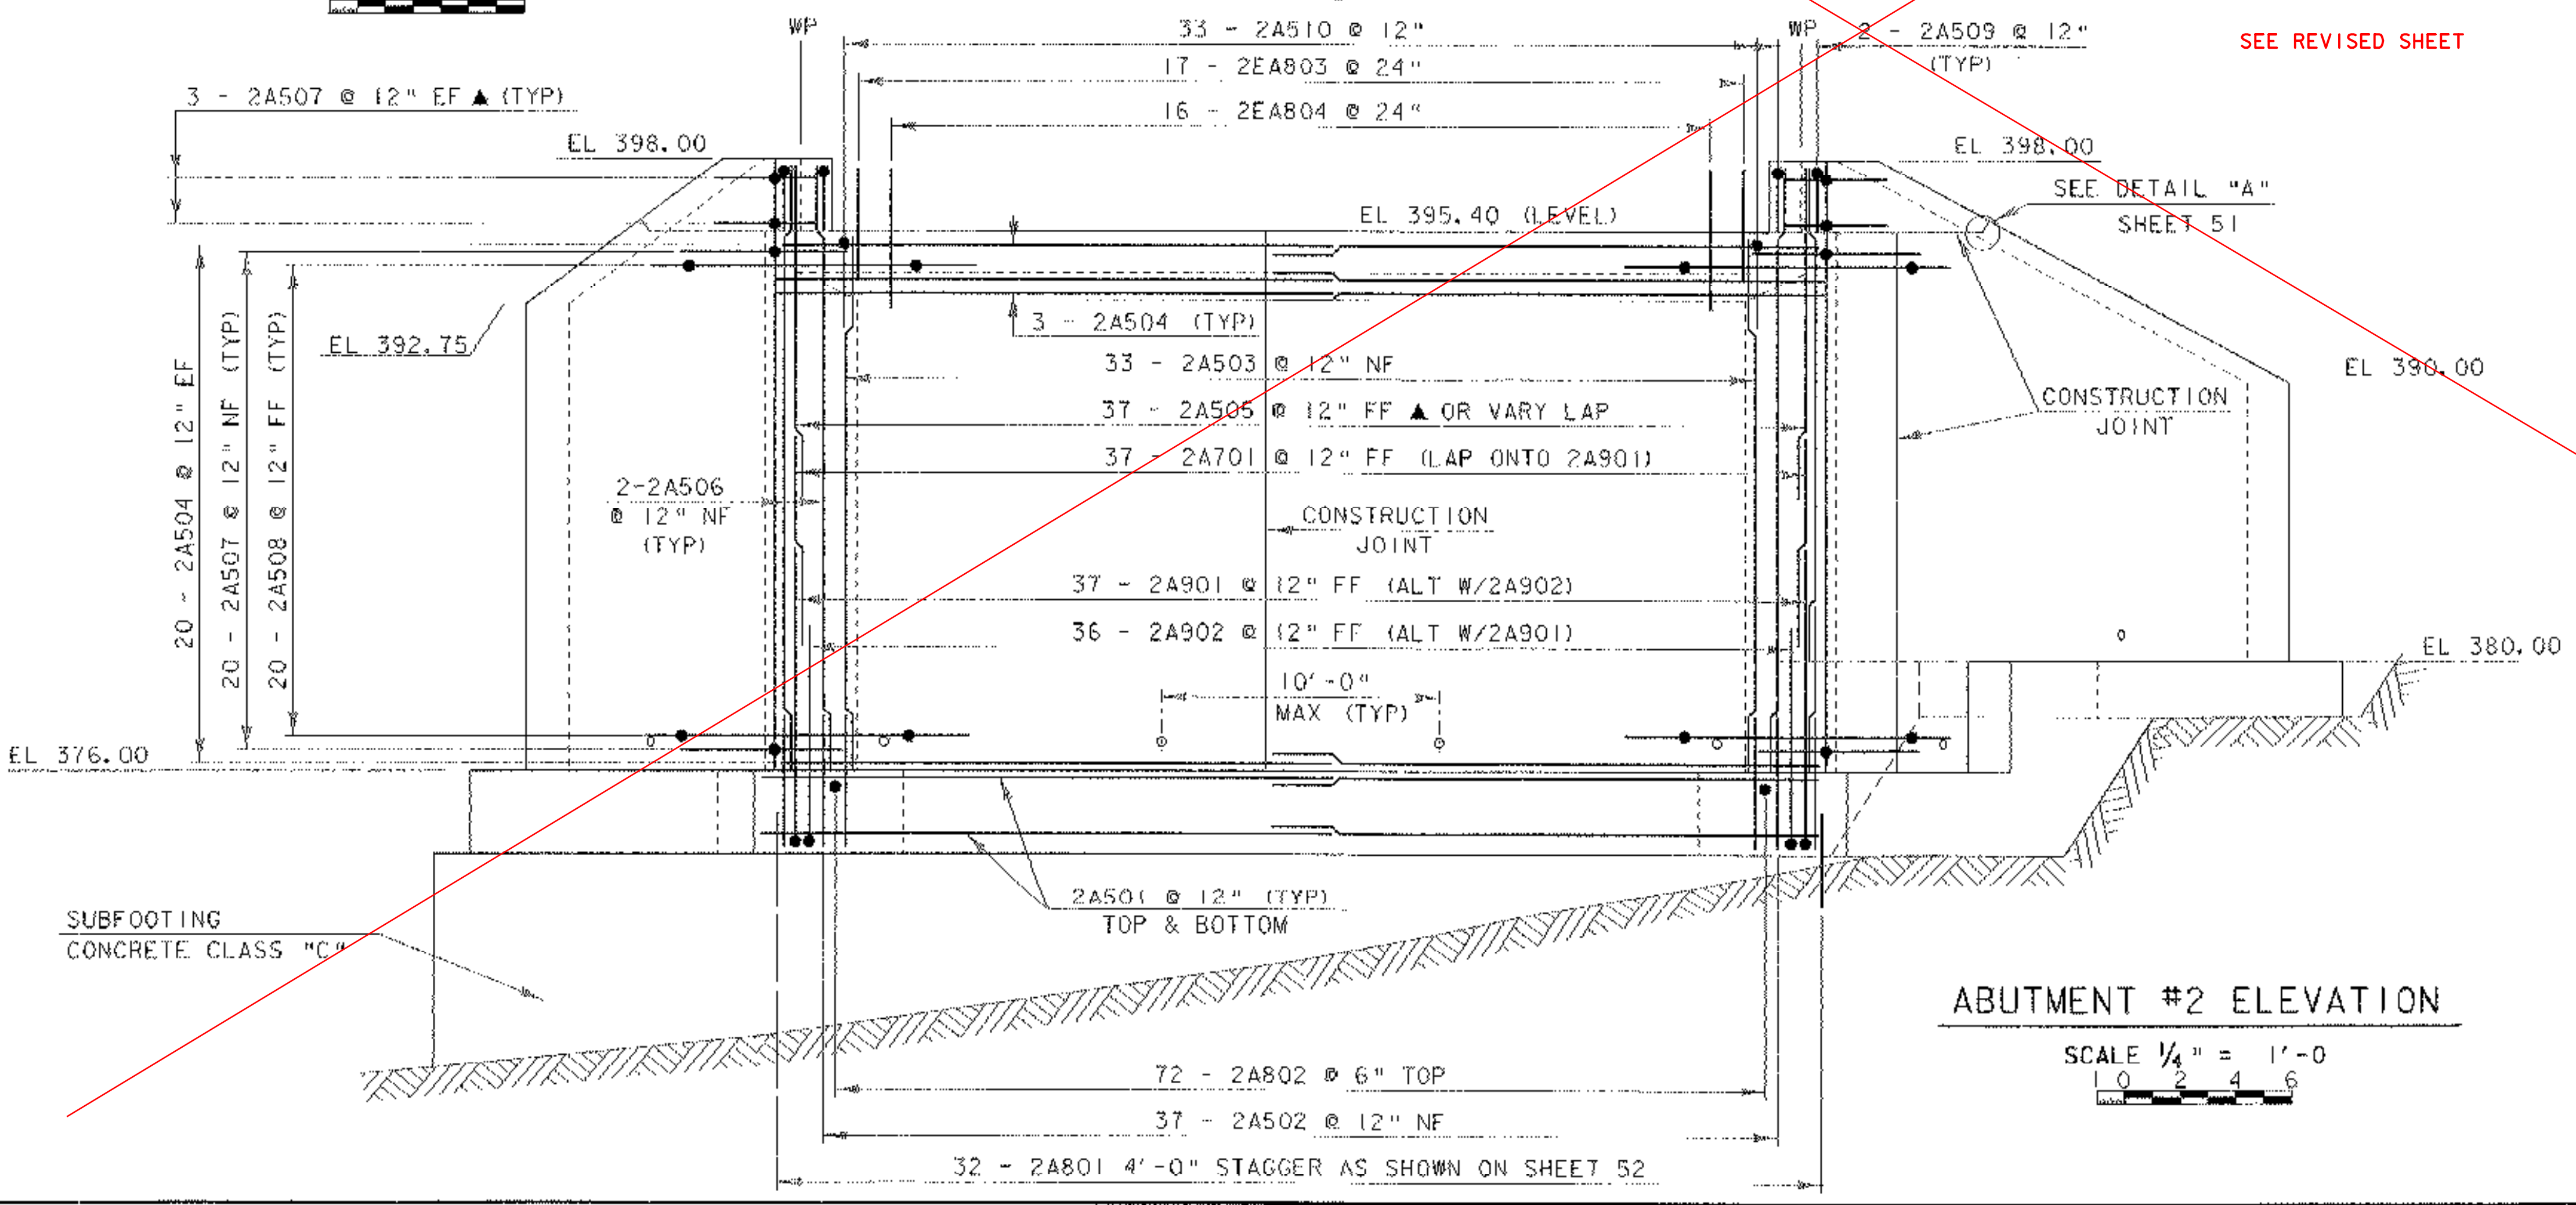

PROJECT: <b>HARTFORD</b>	PROJECT NO. 1 <b>BR0-BTN 2004 (1)</b>
DESIGN FILE NAME: 89j045/structures/sj045sub.dgn	PLOT DATE: 11-FEB-2005
IPARM FILE NAME: sj045ab2.i	DRAWN BY: E. L. RUSTAY
DESIGNED BY: K. M. HIGGINS	CHECKED BY: K. M. HIGGINS
SQUAD LEADER: C. P. WILLIAMS	SHEET: 49 OF 97
ABUTMENT #2 DETAILS	