


CURVE 1 (TH4)
 D = 3°00'00.00"
 R = 1909.86
 T = 82.27'
 L = 164.44'
 E = 1.77'
 BANKING = NORMAL

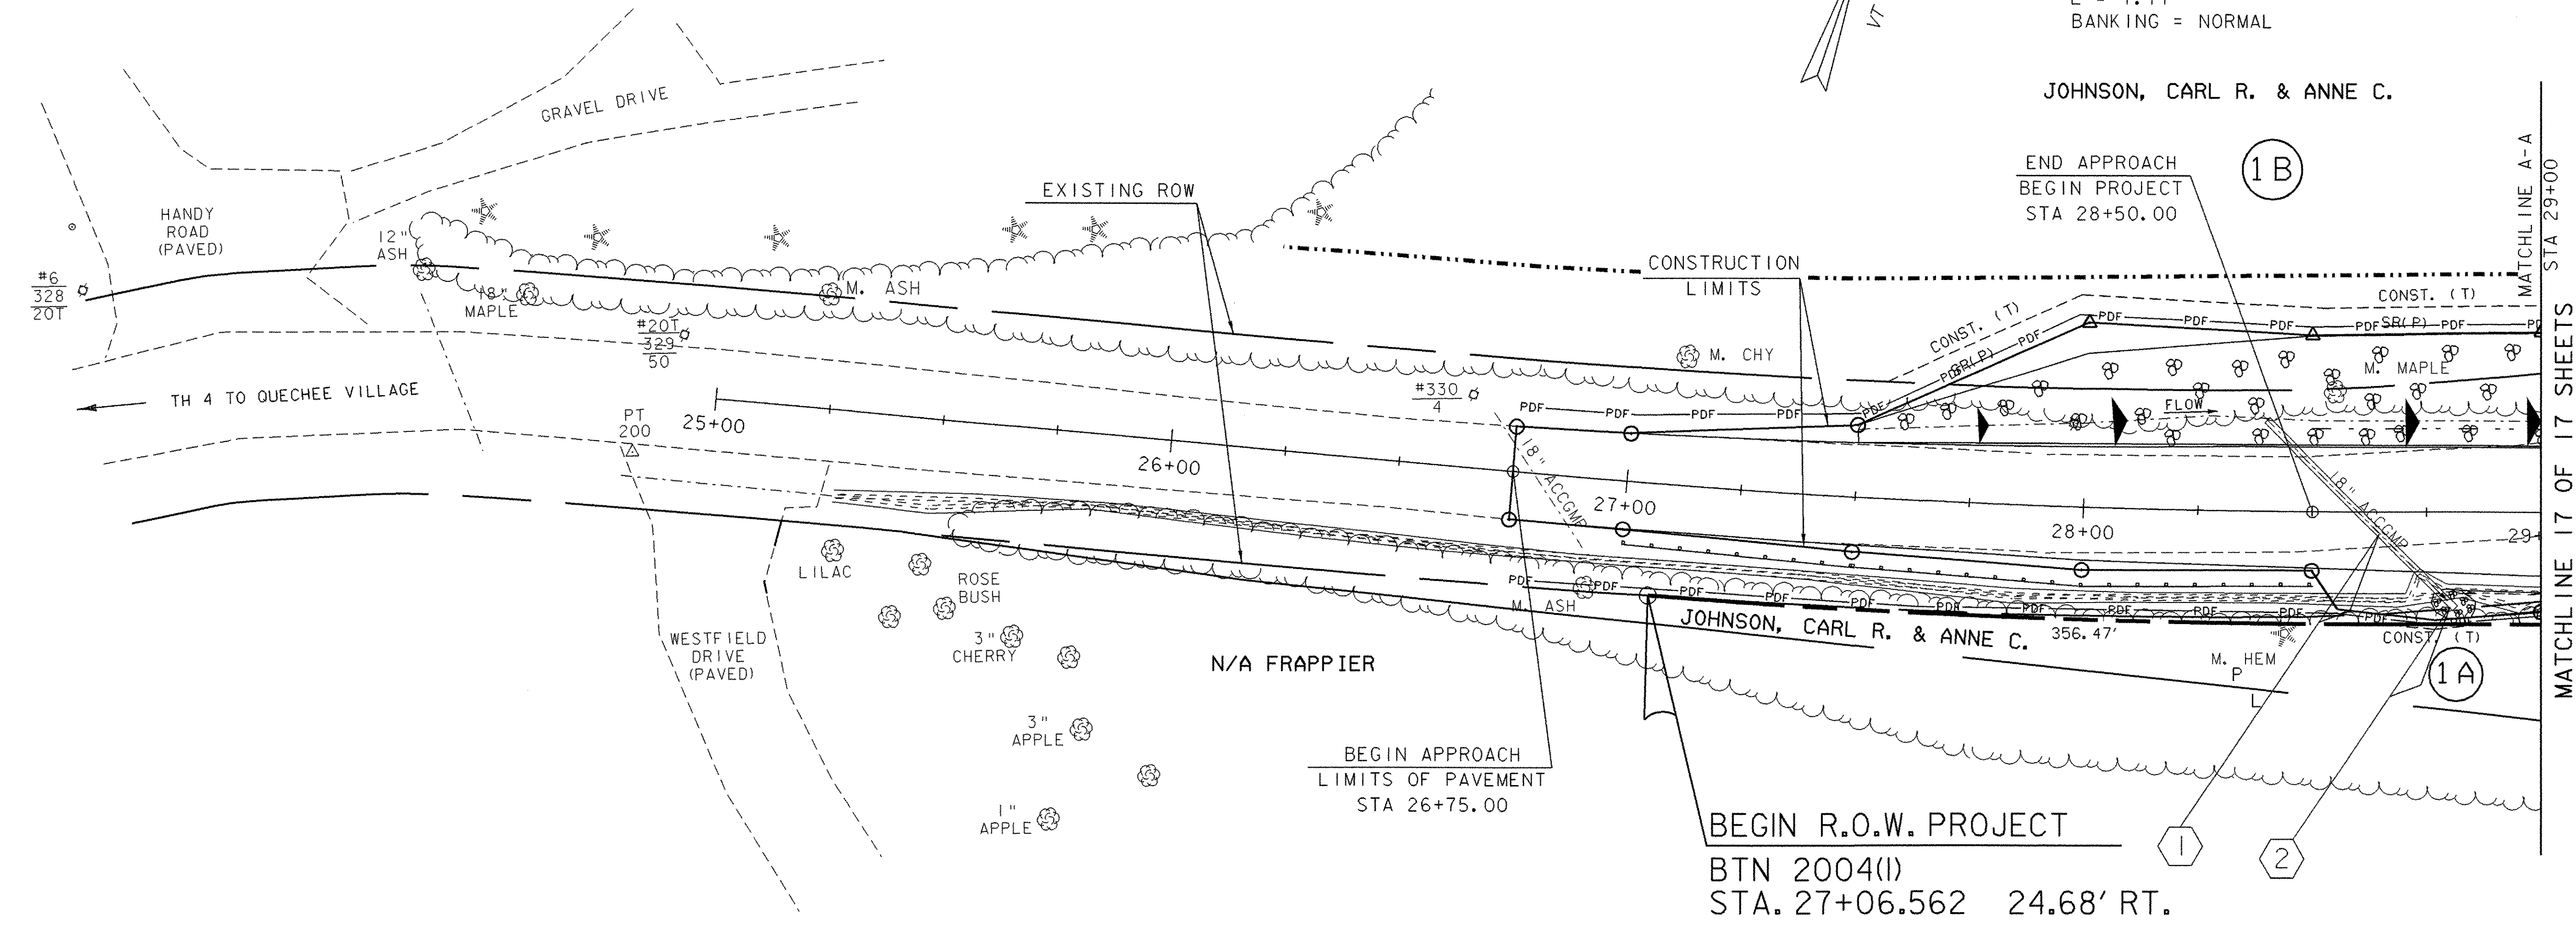

JOHNSON, CARL R. & ANNE C.

END APPROACH
 BEGIN PROJECT
 STA 28+50.00

1B

MATCHLINE A-A
 STA 29+00
 MATCHLINE 17 OF 17 SHEETS

BEGIN APPROACH
 LIMITS OF PAVEMENT
 STA 26+75.00

BEGIN R.O.W. PROJECT
 BTN 2004(I)
 STA. 27+06.562 24.68' RT.

LEGEND	
	FILTER CURTAIN
	SILT FENCE
	SAND BAGS
	STONE CHECK DAMS
	SOIL BOUNDARY
	PROPERTY LINE
	PROJECT DEMARCATION FENCE

SEE SHEET 22-23 FOR
 DRAINAGE INFORMATION

R. O. W.
 LAYOUT SHEET 1

SCALE 1" = 20'-0"

LINES SHOWN ON THIS PLAN AS EXISTING
 PROPERTY LINES P/L ARE BELIEVED TO
 BE ACCURATE BUT SHOULD NOT BE RELIED
 UPON FOR PURPOSES UNRELATED TO THE
 TOWN OF HARTFORD'S ACQUISITION OF LAND
 AND RIGHTS FOR THIS PROJECT.

DATUM
 VERTICAL NAVD88
 HORIZONTAL NAD 1983/92

PROJECT: HARTFORD	PROJECT NO.: BRO-BTN 2004(I)
DESIGN FILE NAME: 89j045/structures/sj045bdr.dgn	PLOT DATE: 11-FEB-2005
IPARM FILE NAME: sj045ial1	SURVEY DATE: 5/93
SURVEYED BY: R. MOREAU	DRAWN BY: K.M. HIGGINS
SQUAD LEADER: C. P. WILLIAMS	LAYOUT SHEET 1
R.O.W. SHEET 16 OF 17	SHEET 62 OF 97