
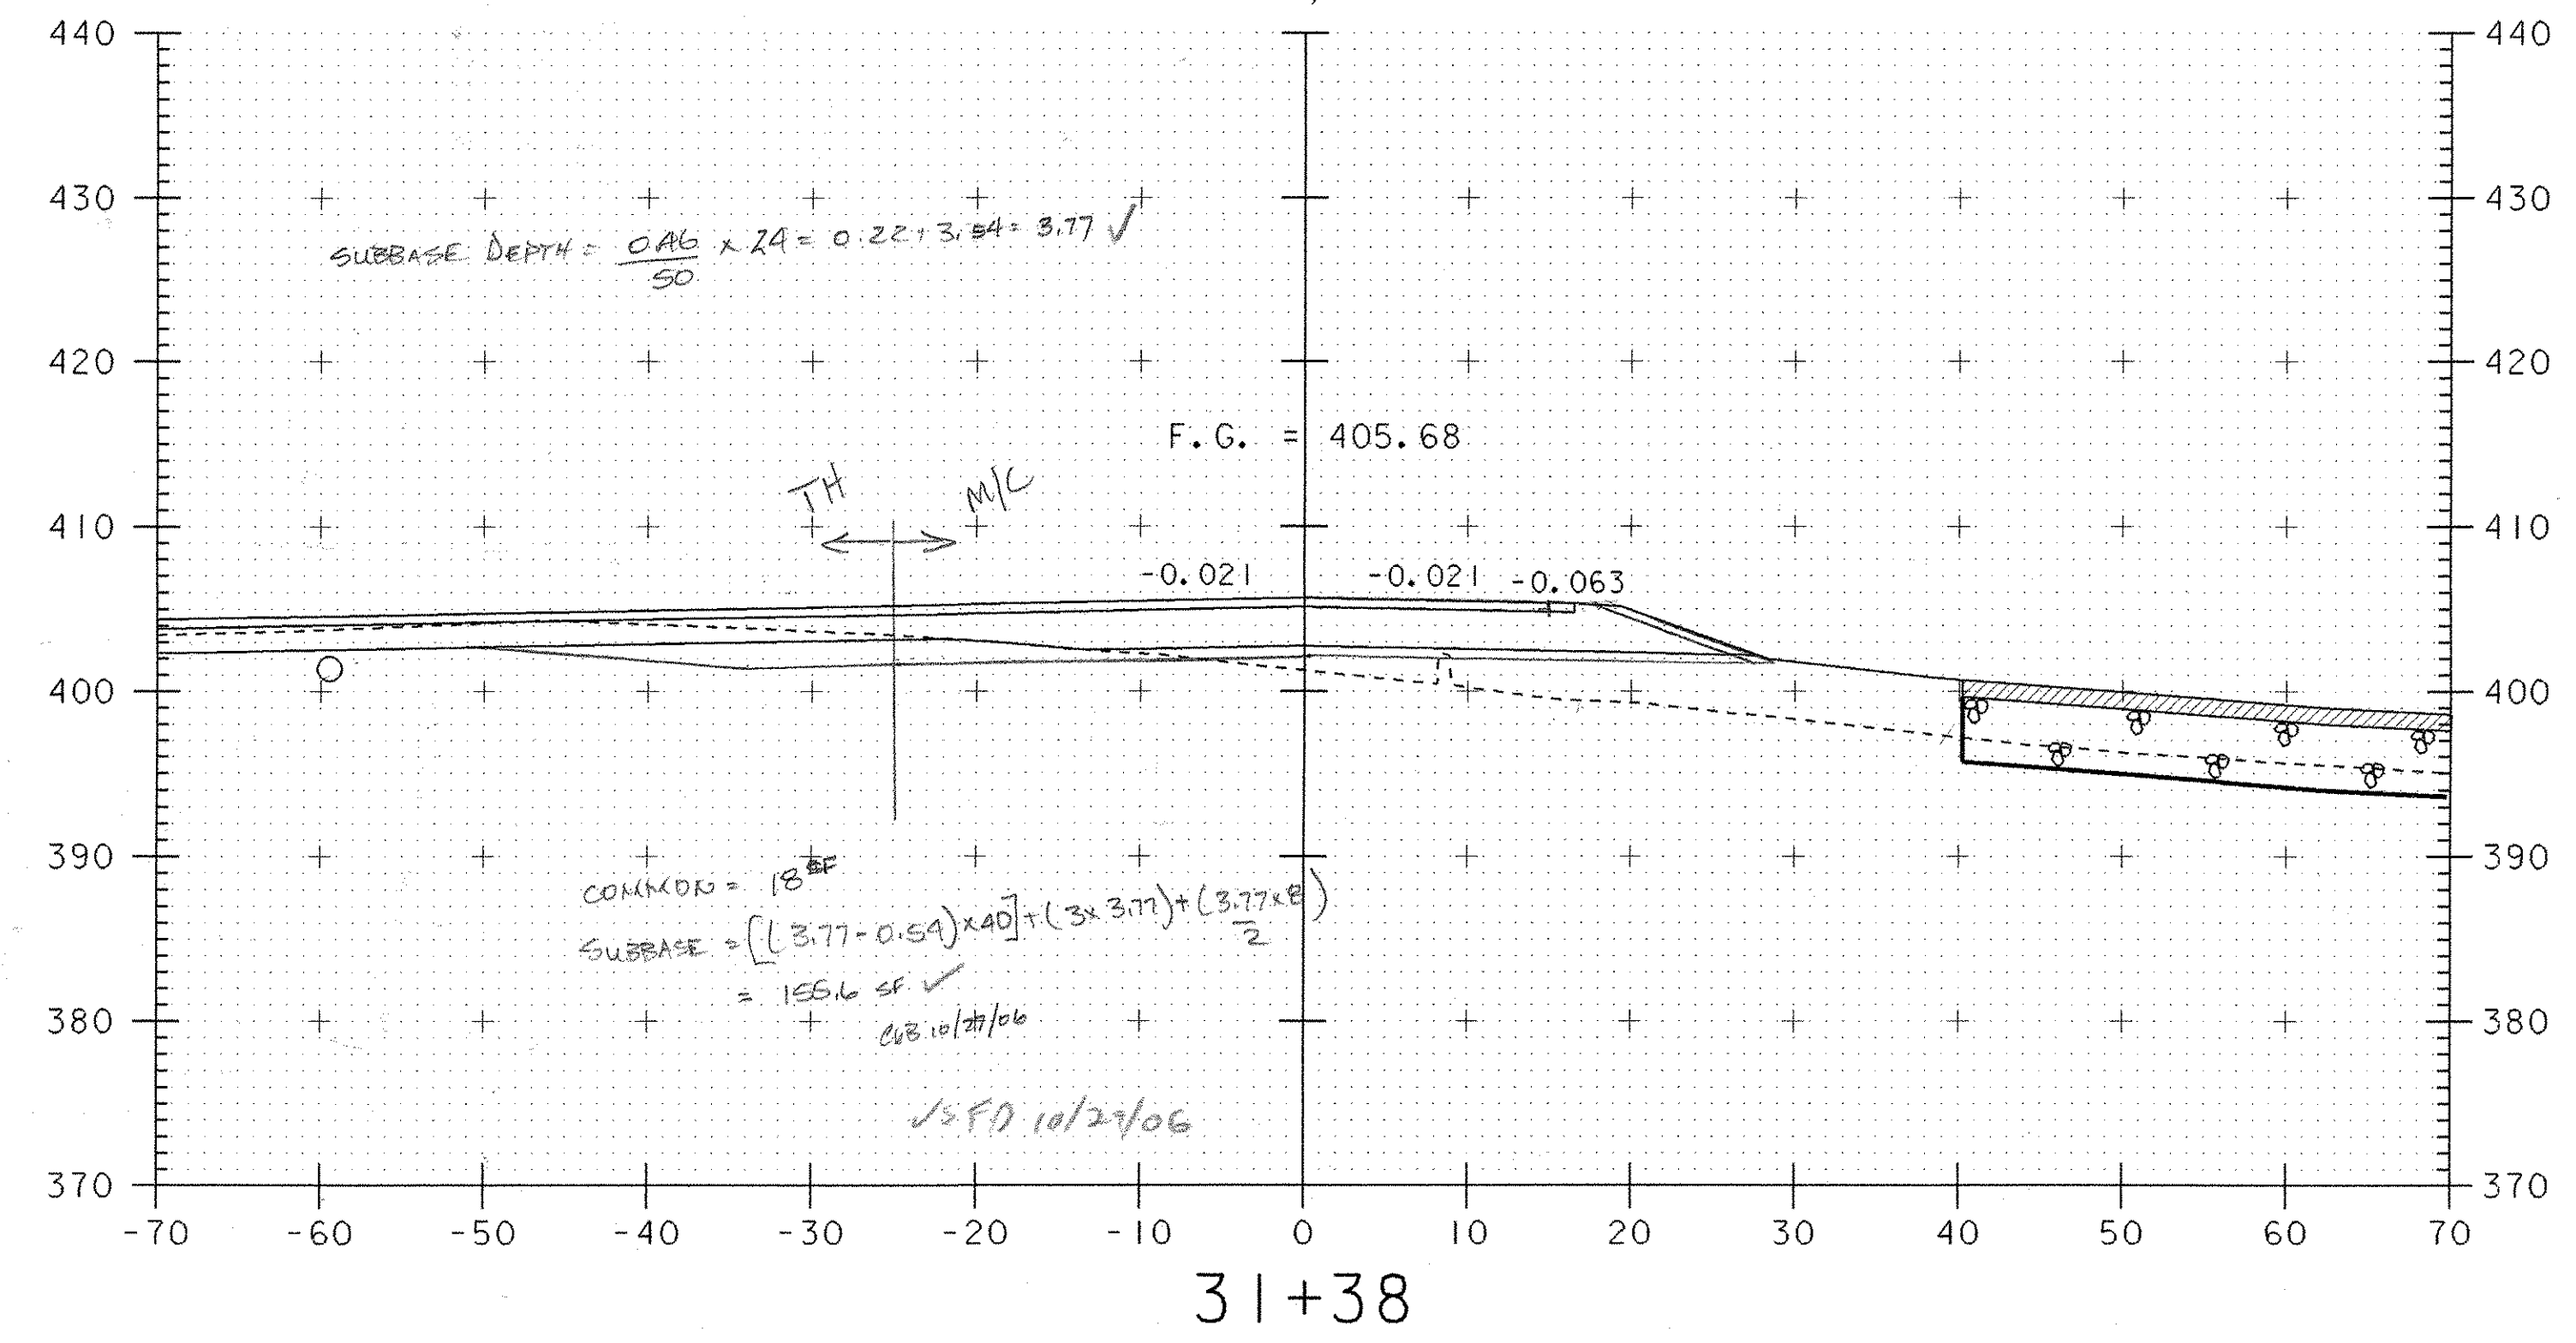
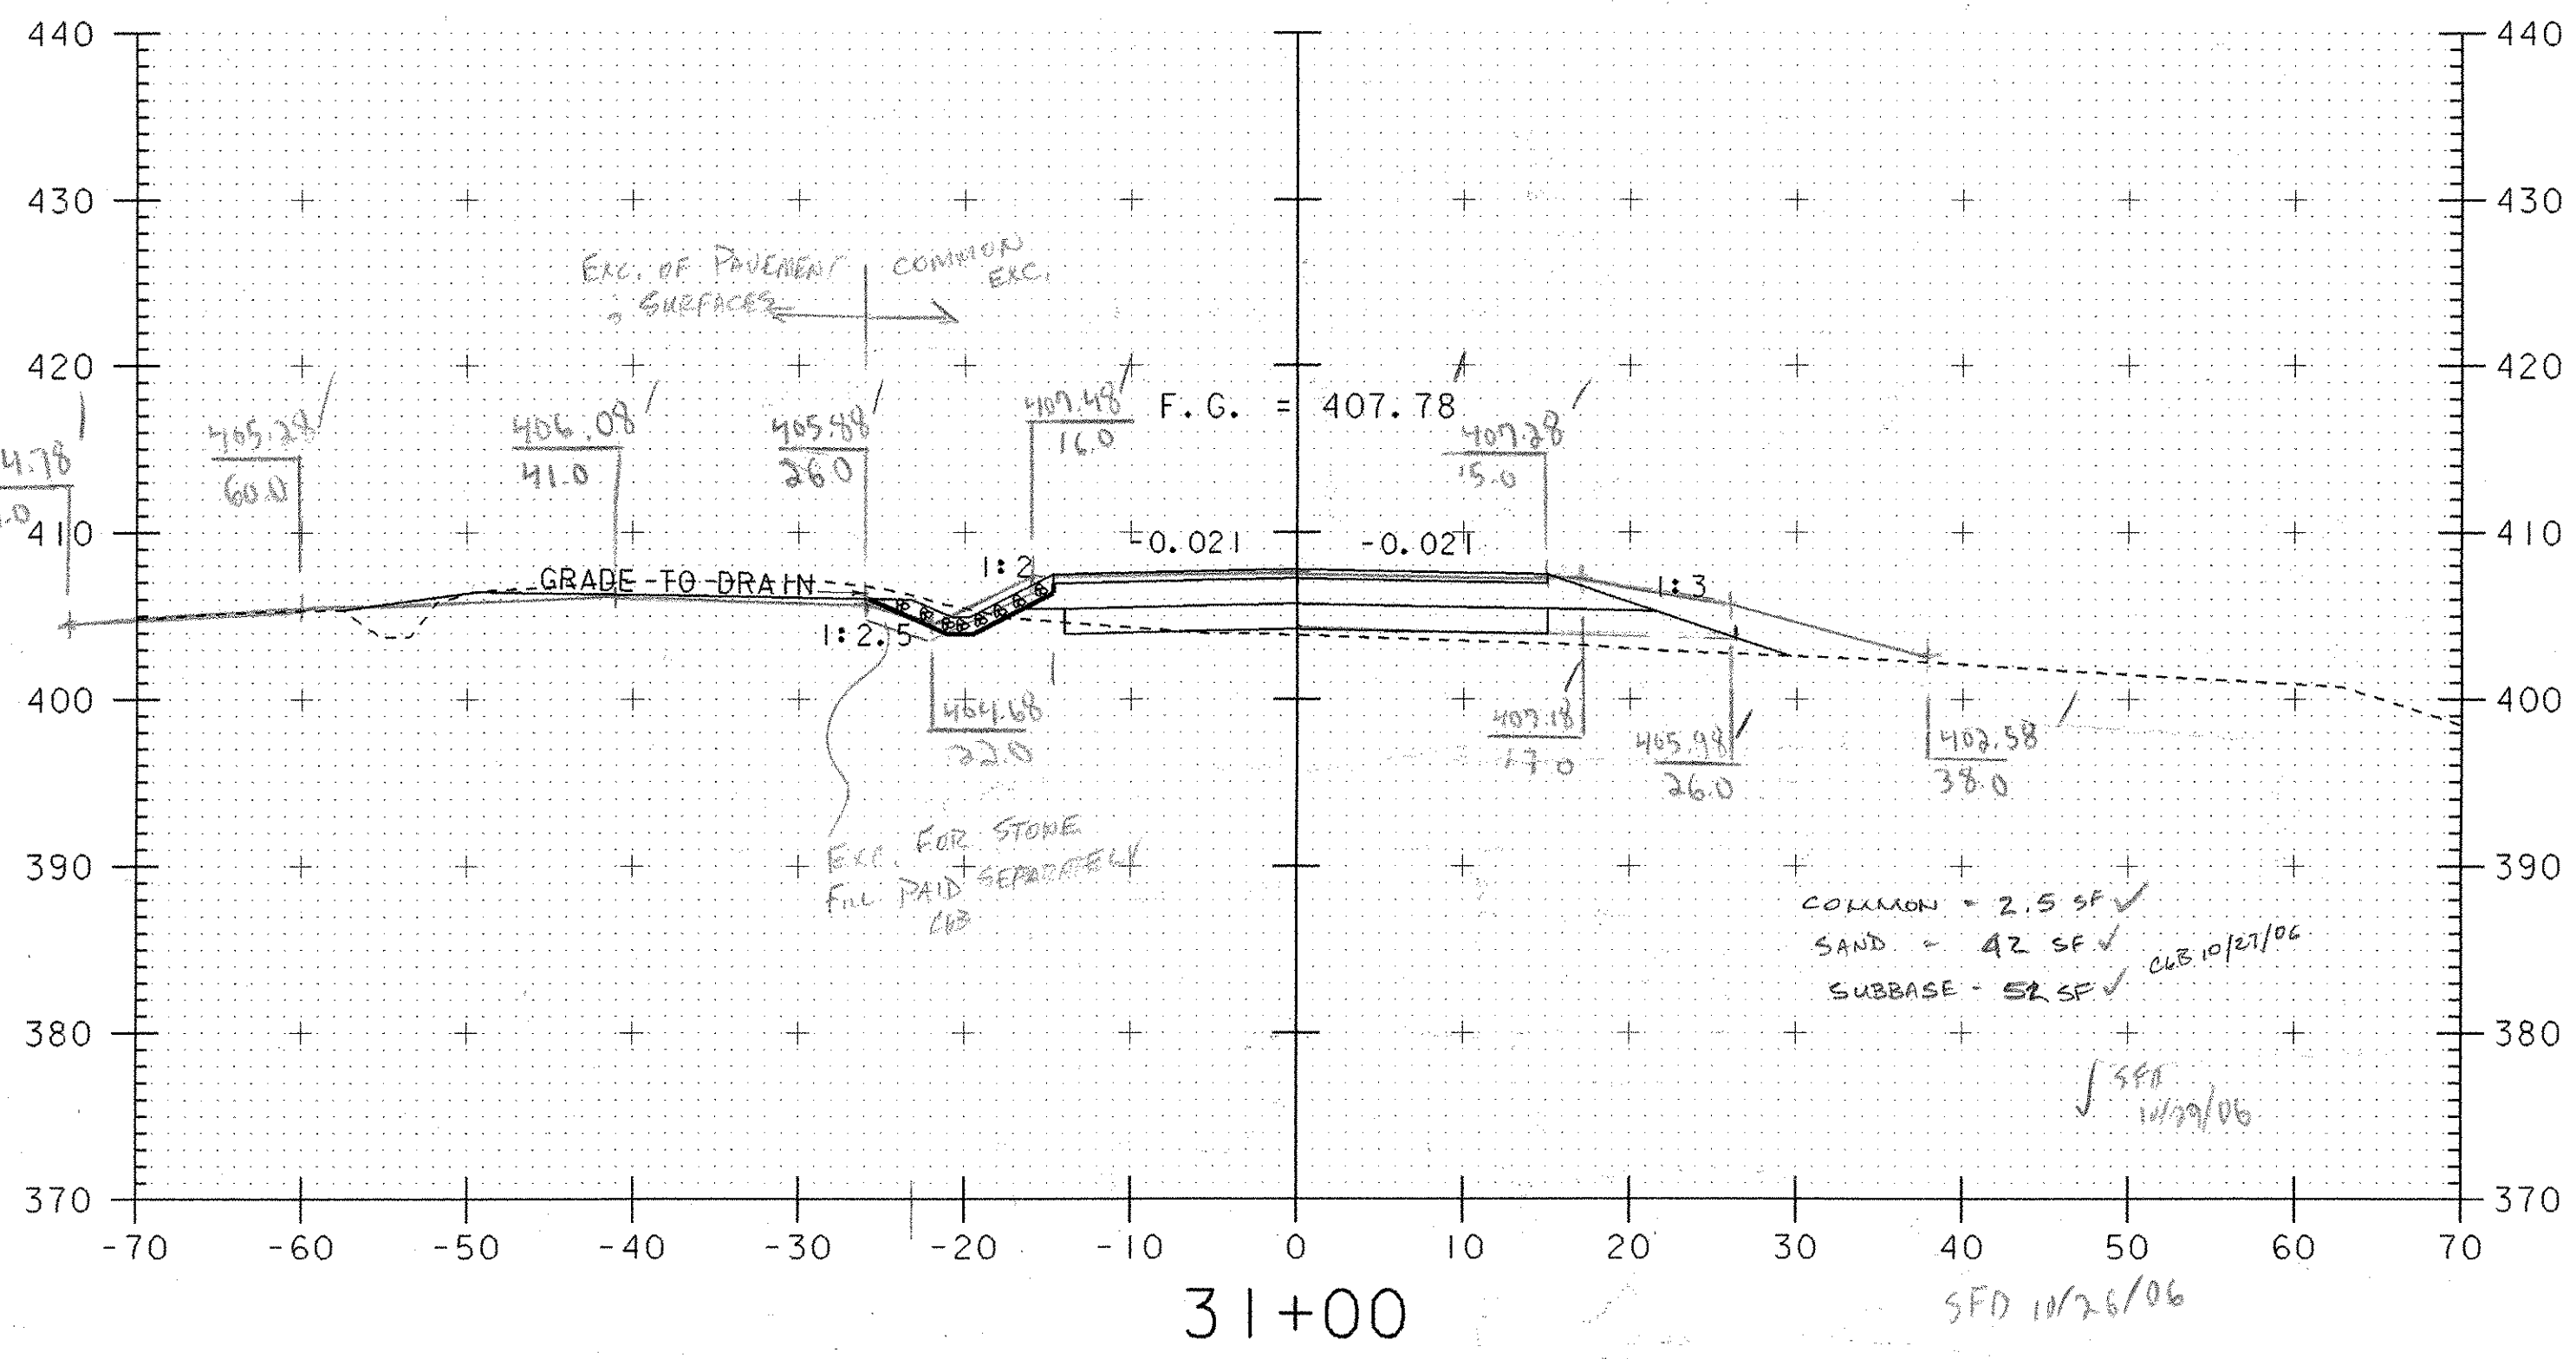
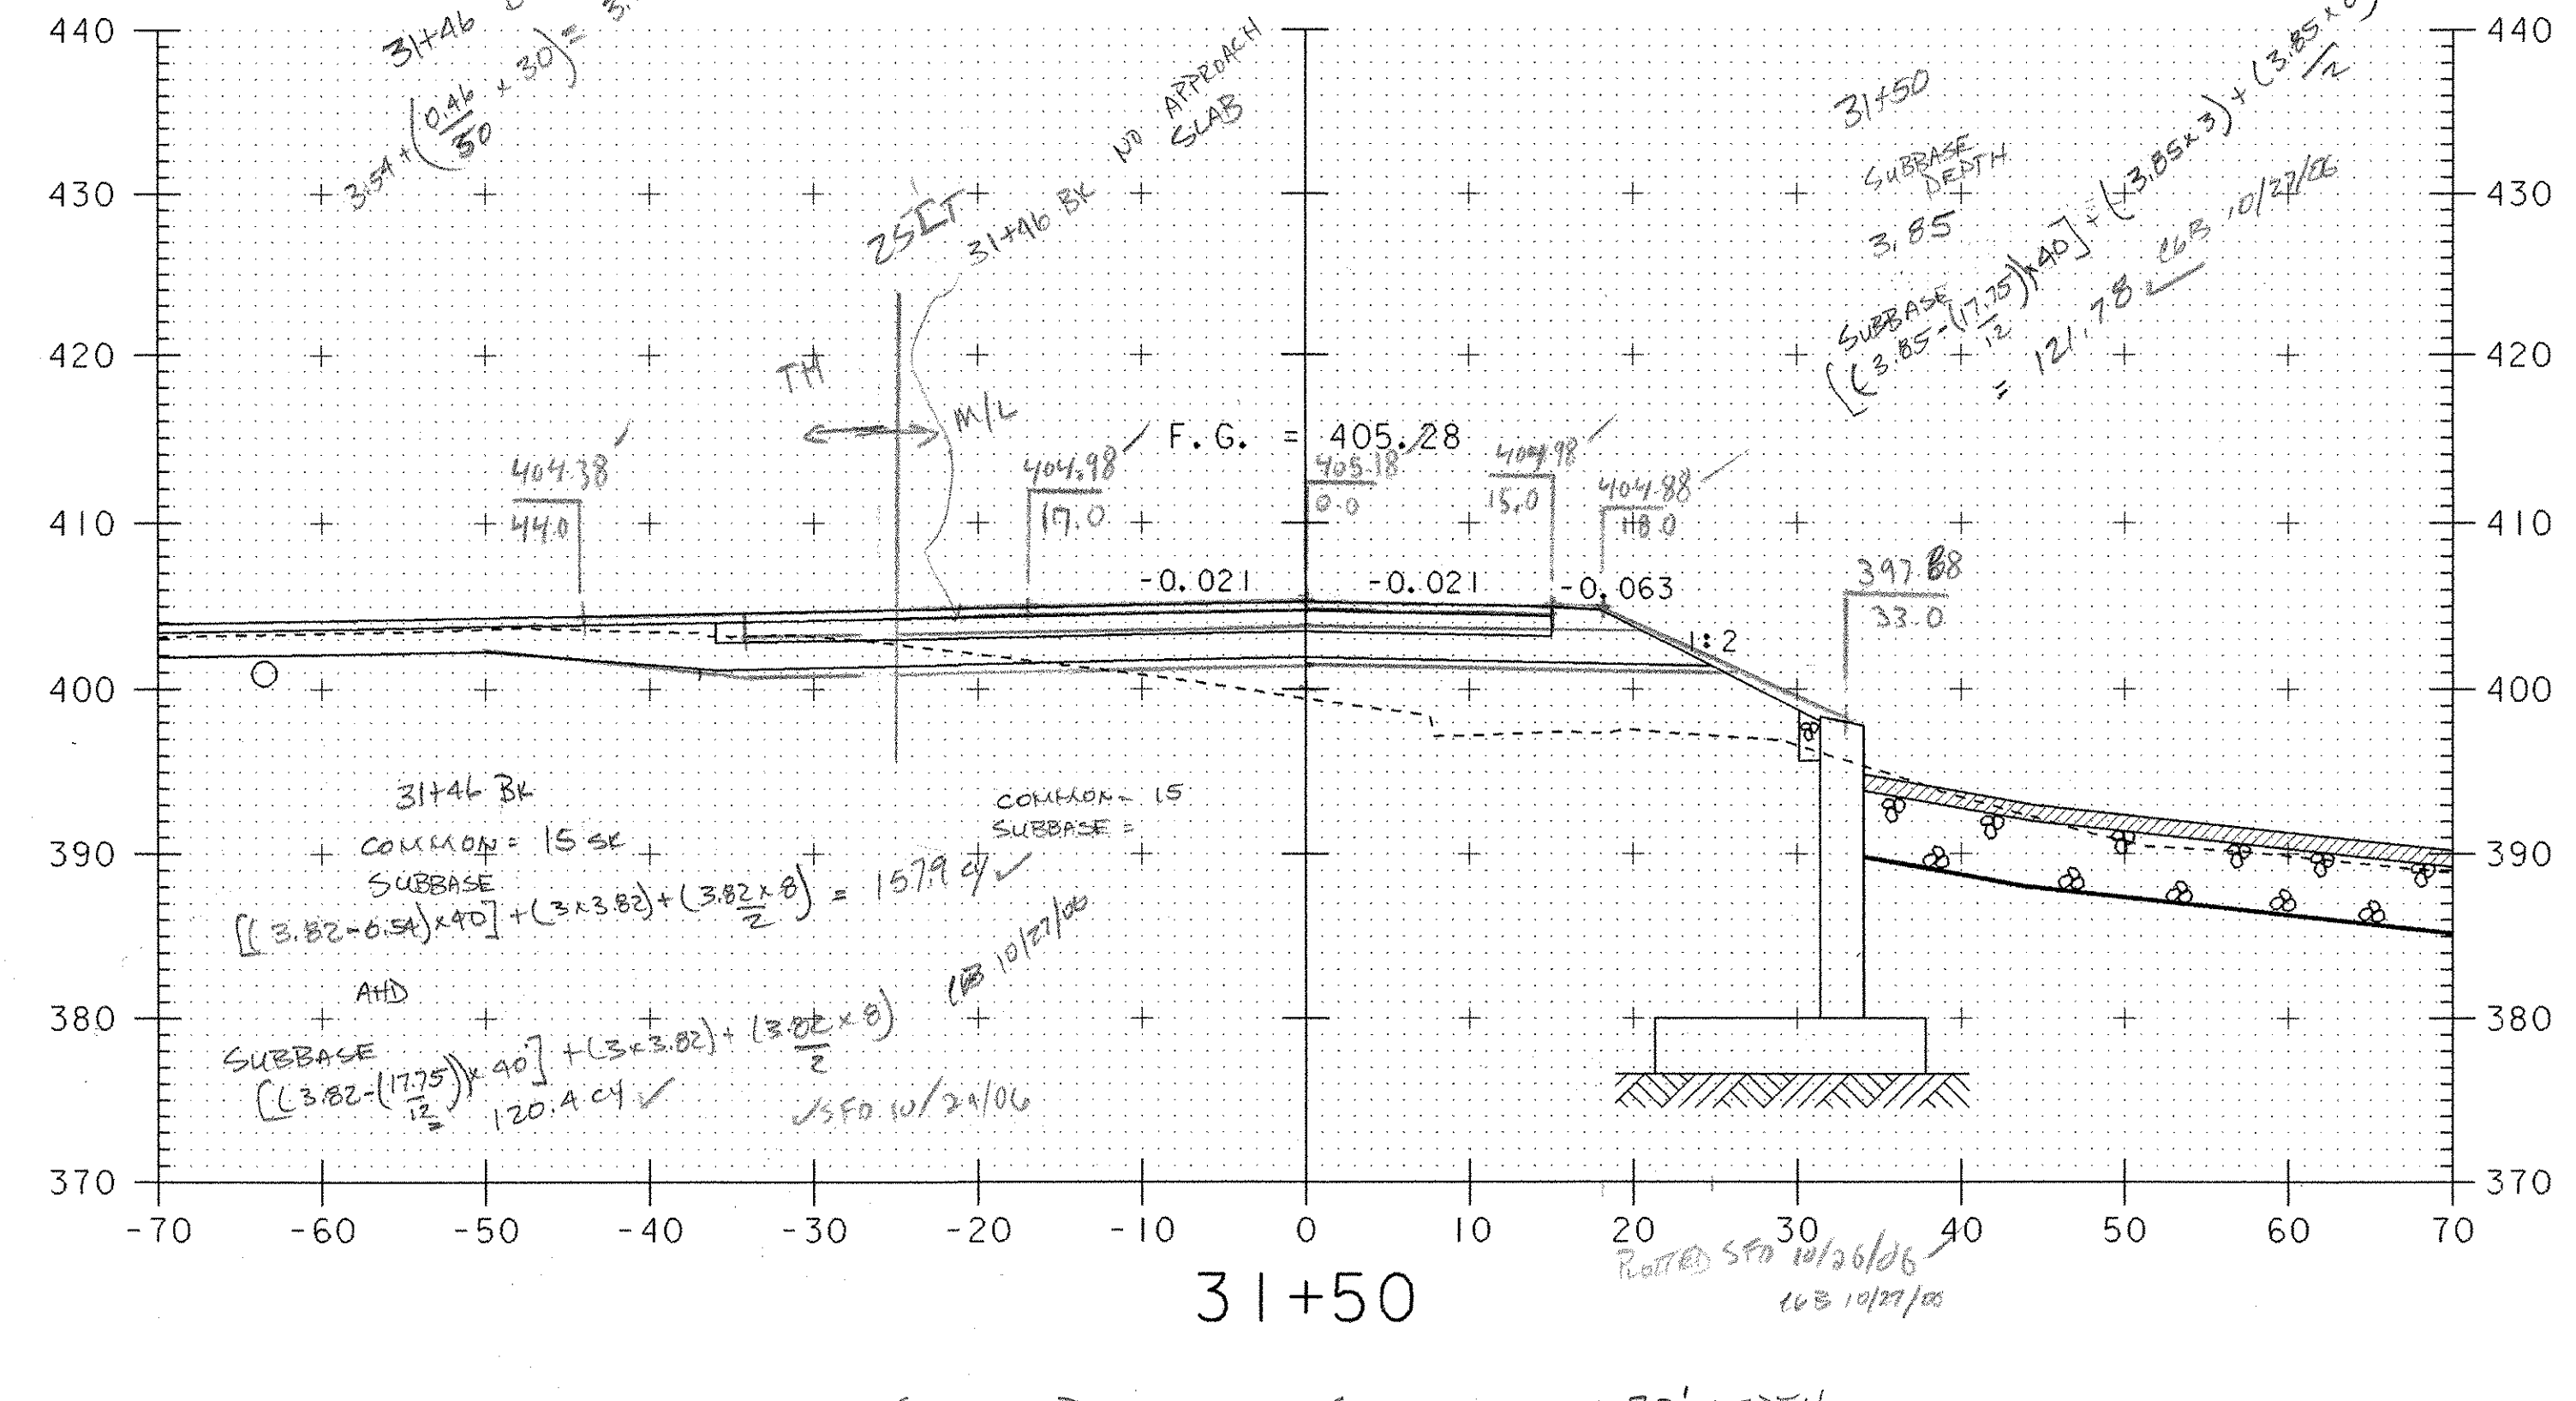


31+65 4.0' DEPTH
 SUBBASE = $\left\{ \left[4 - \left(\frac{17.25}{2} \right) \right] \times 40 \right\} + (4 \times 3) + (2 \times 8)$
 = 128.83
 10/27/06

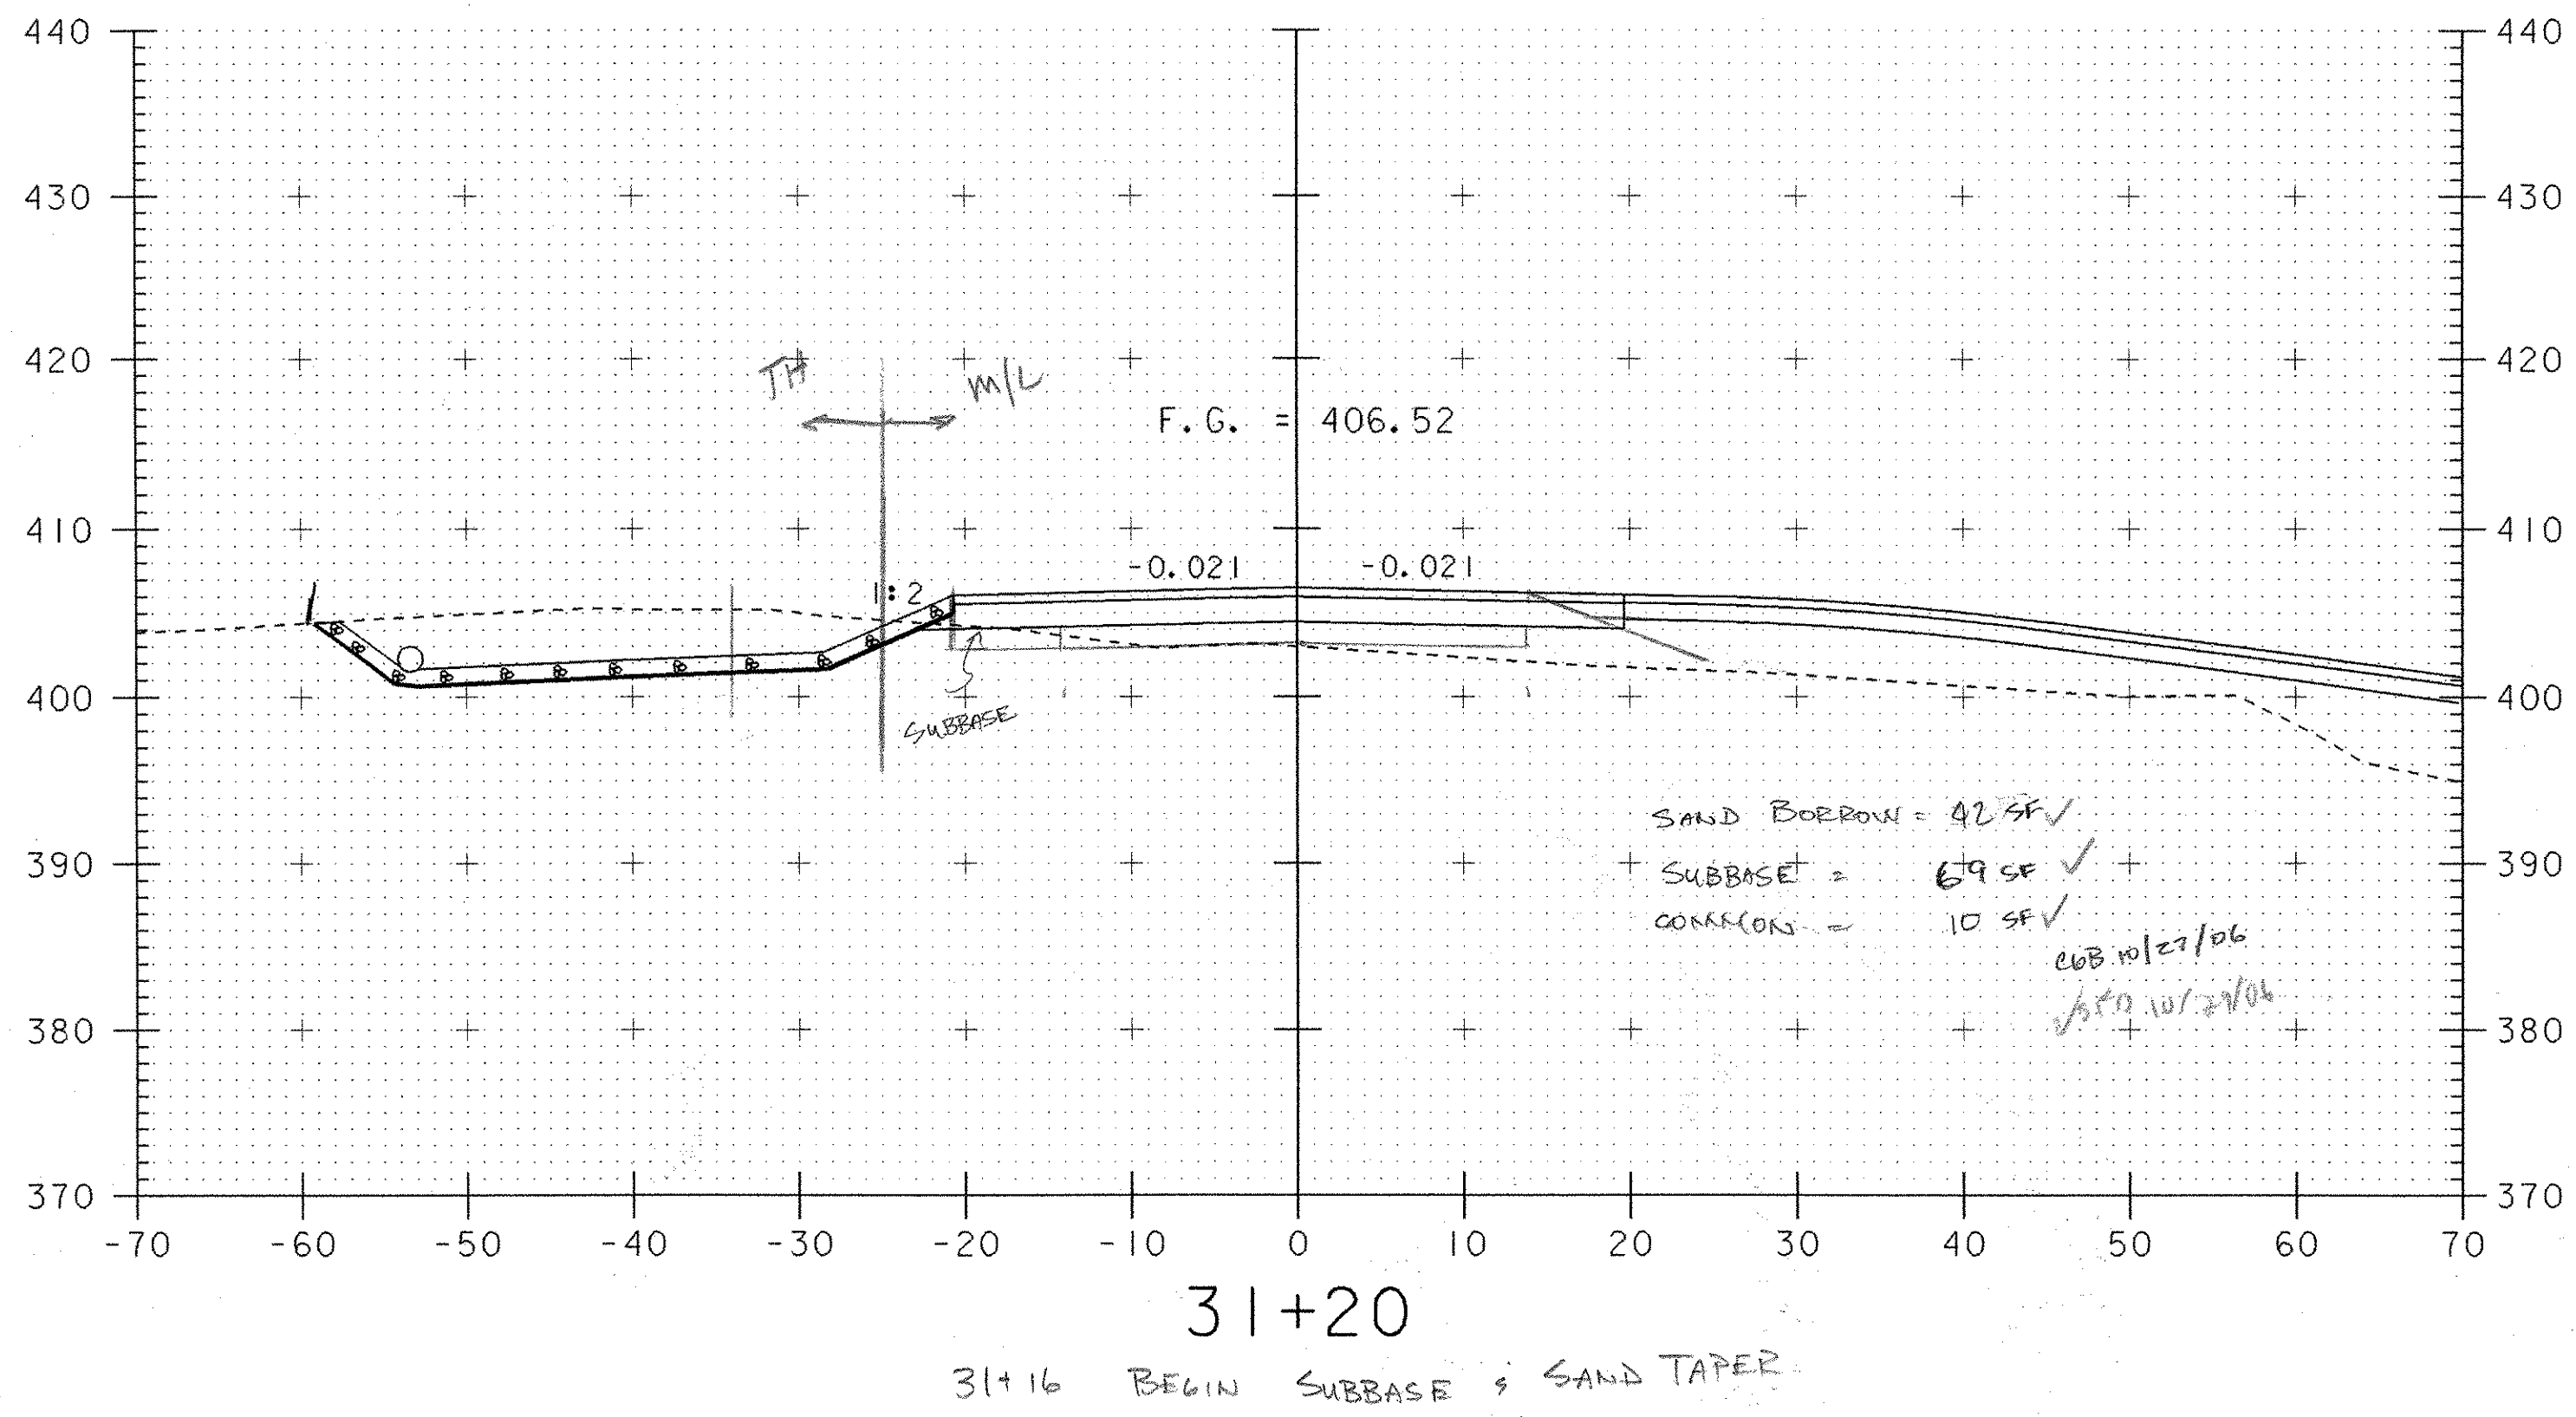

PROJECT: HARTFORD	PROJECT NO.: BRO-BTN 2004(1)
DESIGN FILE NAME: 89j045/structures/sj045xsl.dgn	PLOT DATE: 11-FEB-2005
IPARM FILE NAME: sj045m4.i	
TH 4 CROSS SECTIONS	
SECTION 31+00 THROUGH 31+50	SHEET: 68 OF 97