




34+50
 END PROJECT
 STA 34+50.00
 END BRIDGE
 STA 34+10.00

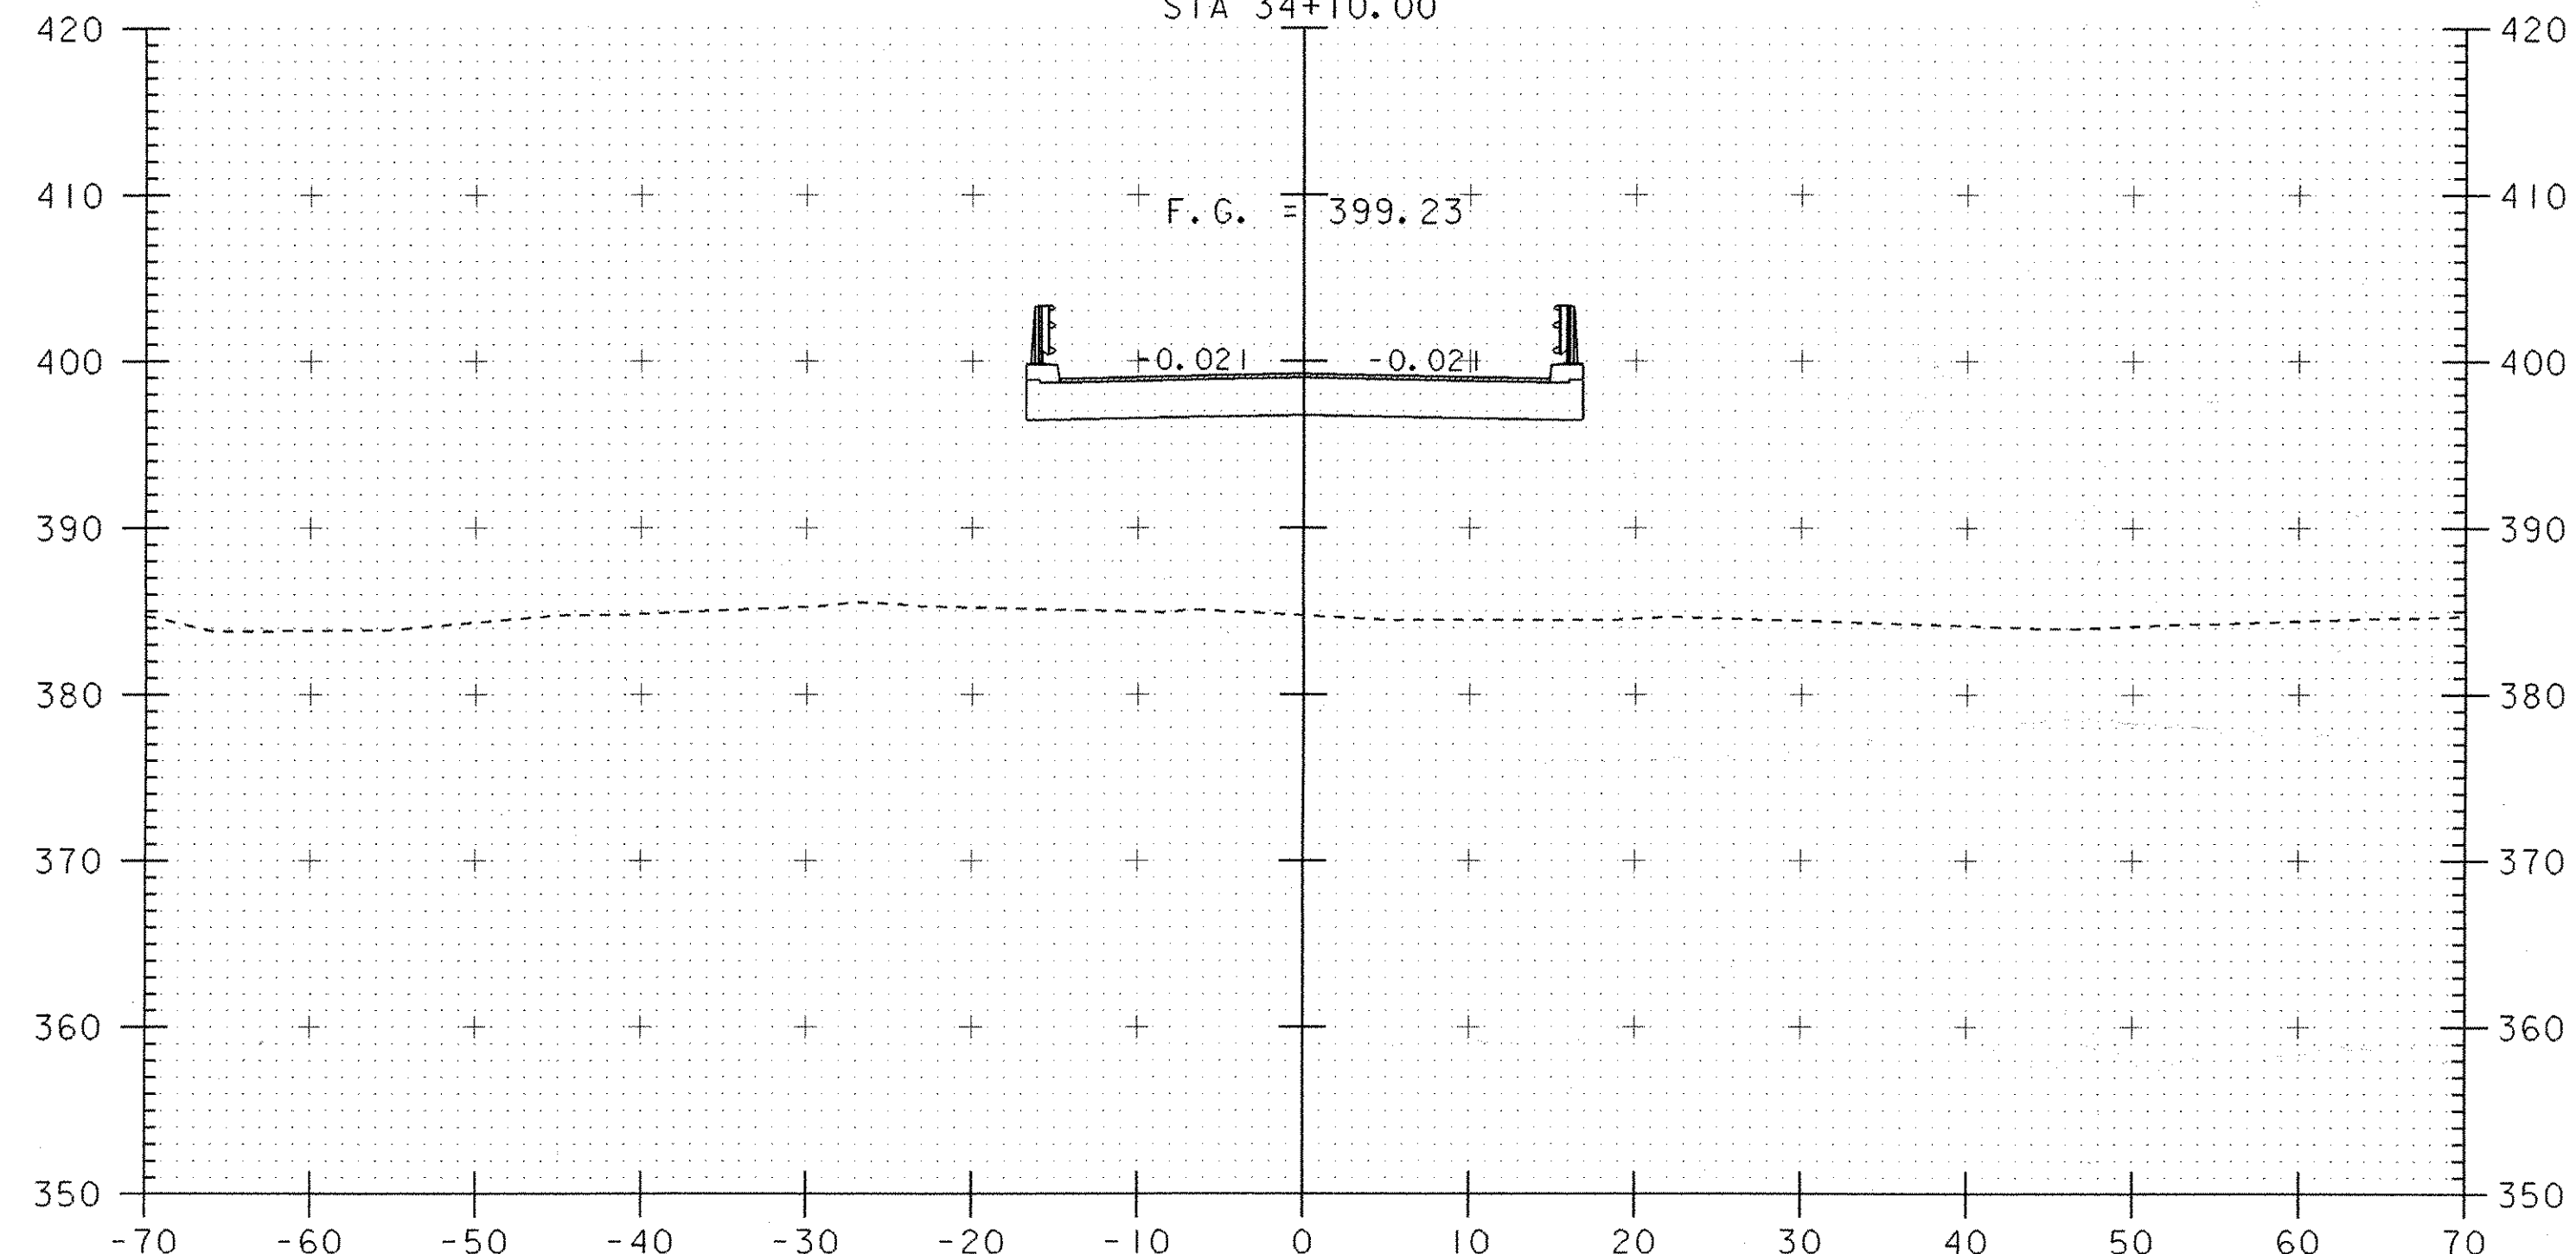


34+00

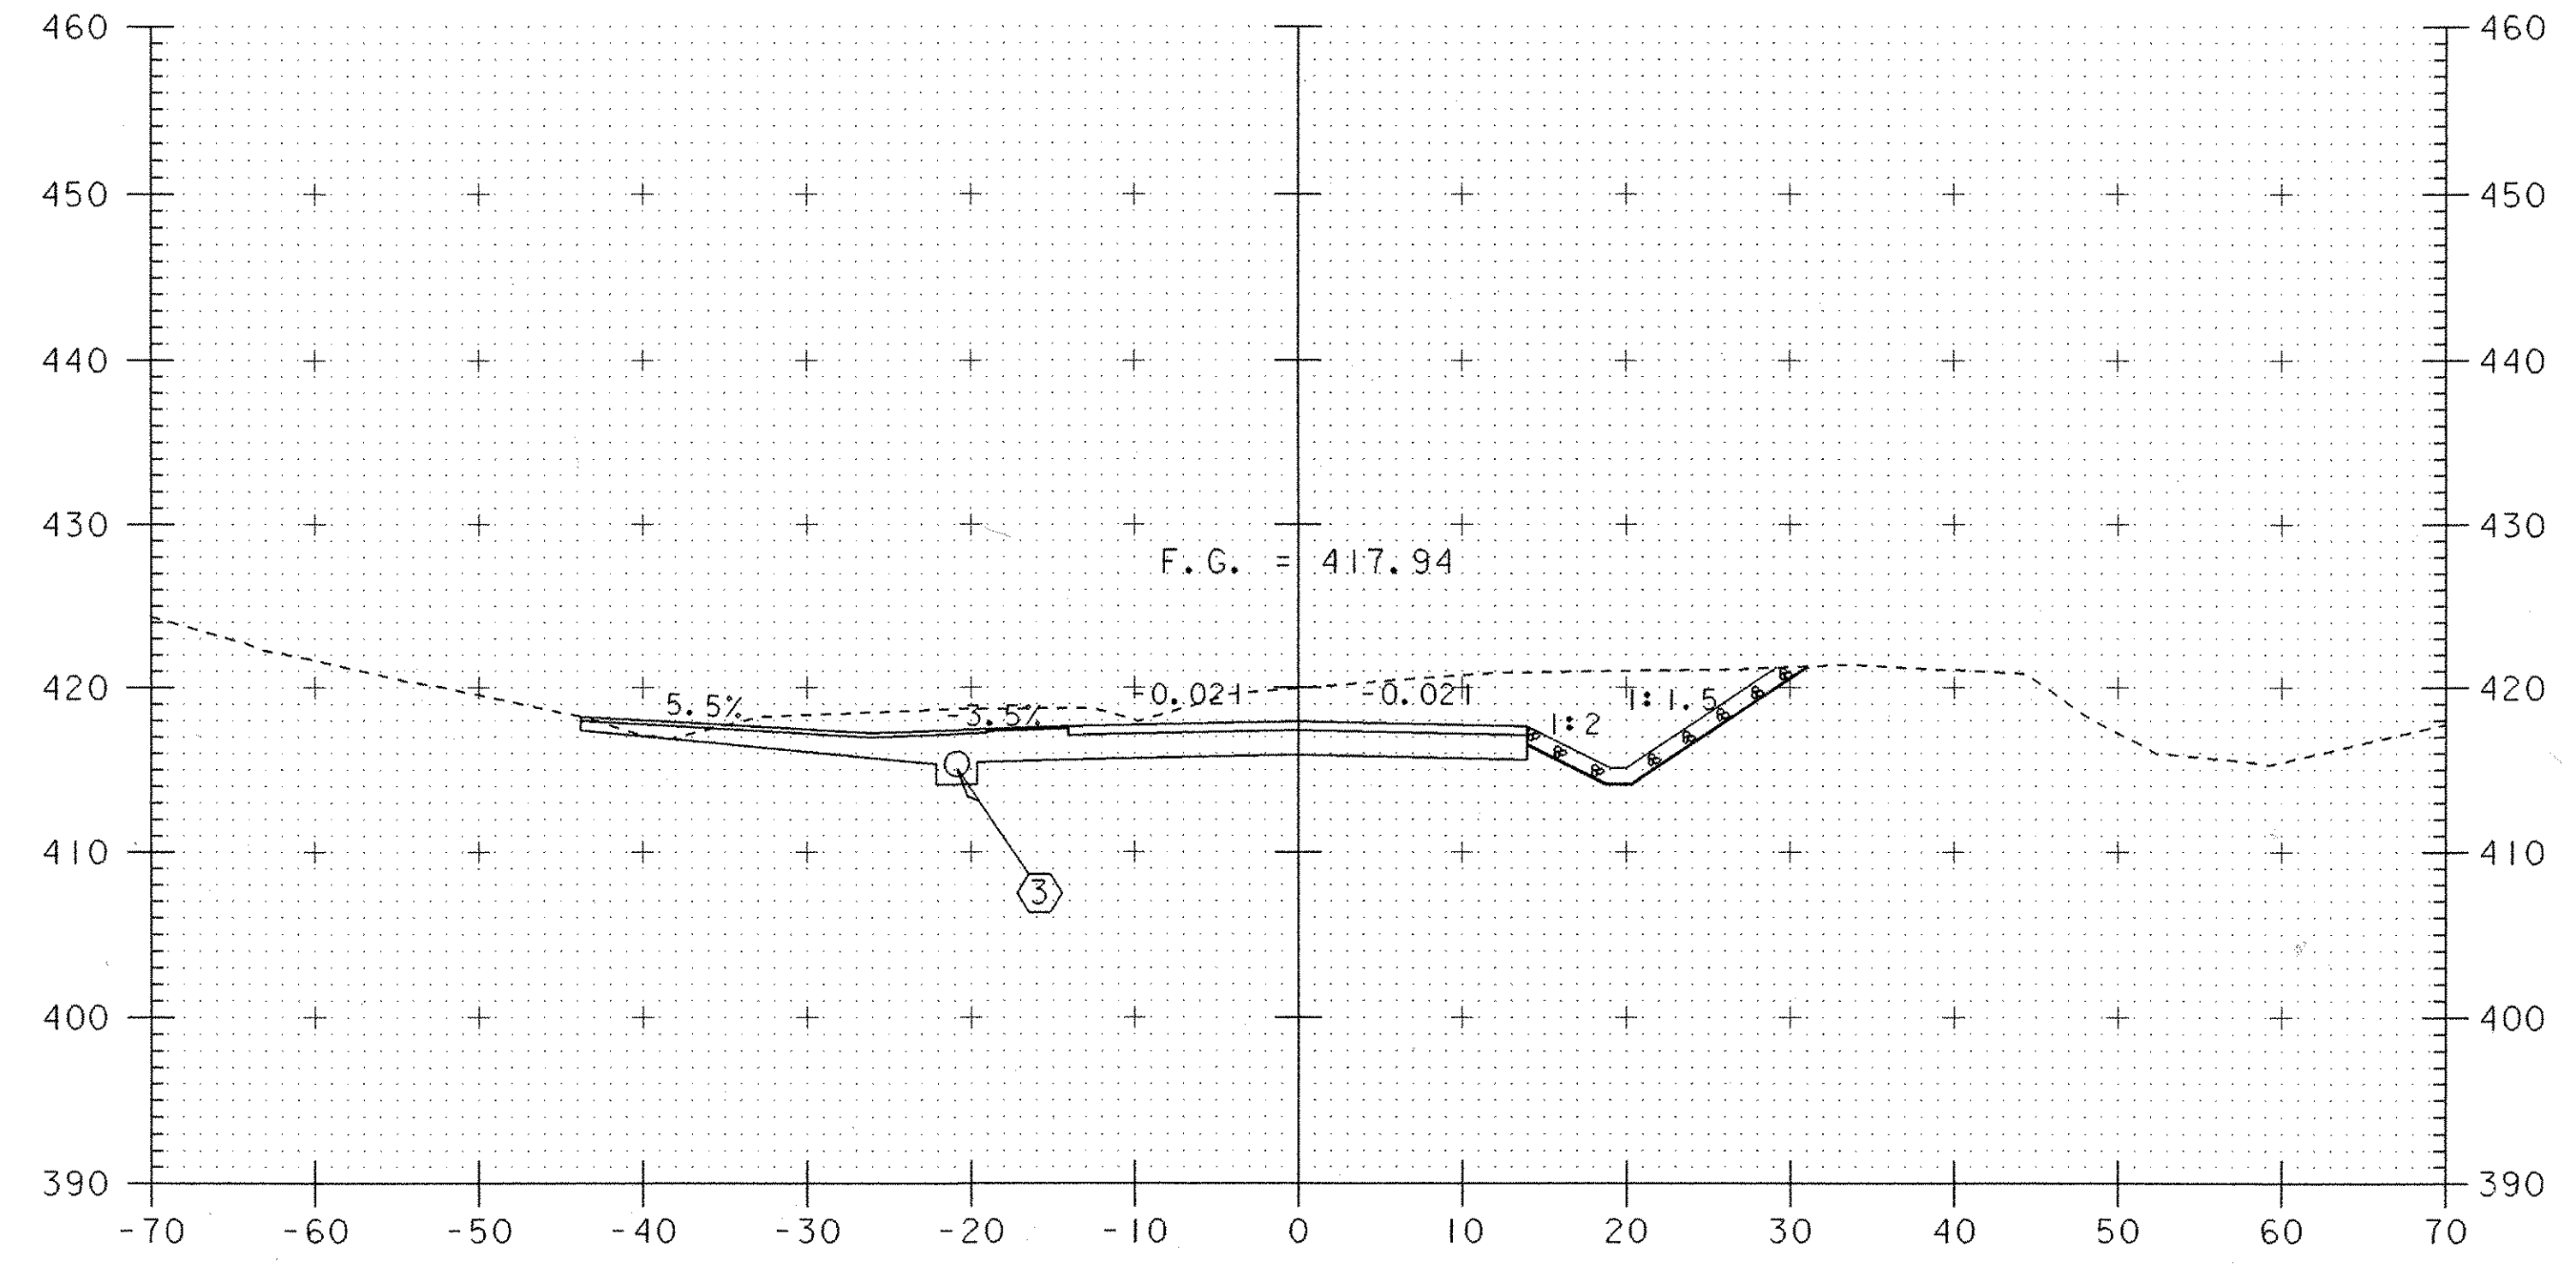

DRIVE SECTION @ 30+09

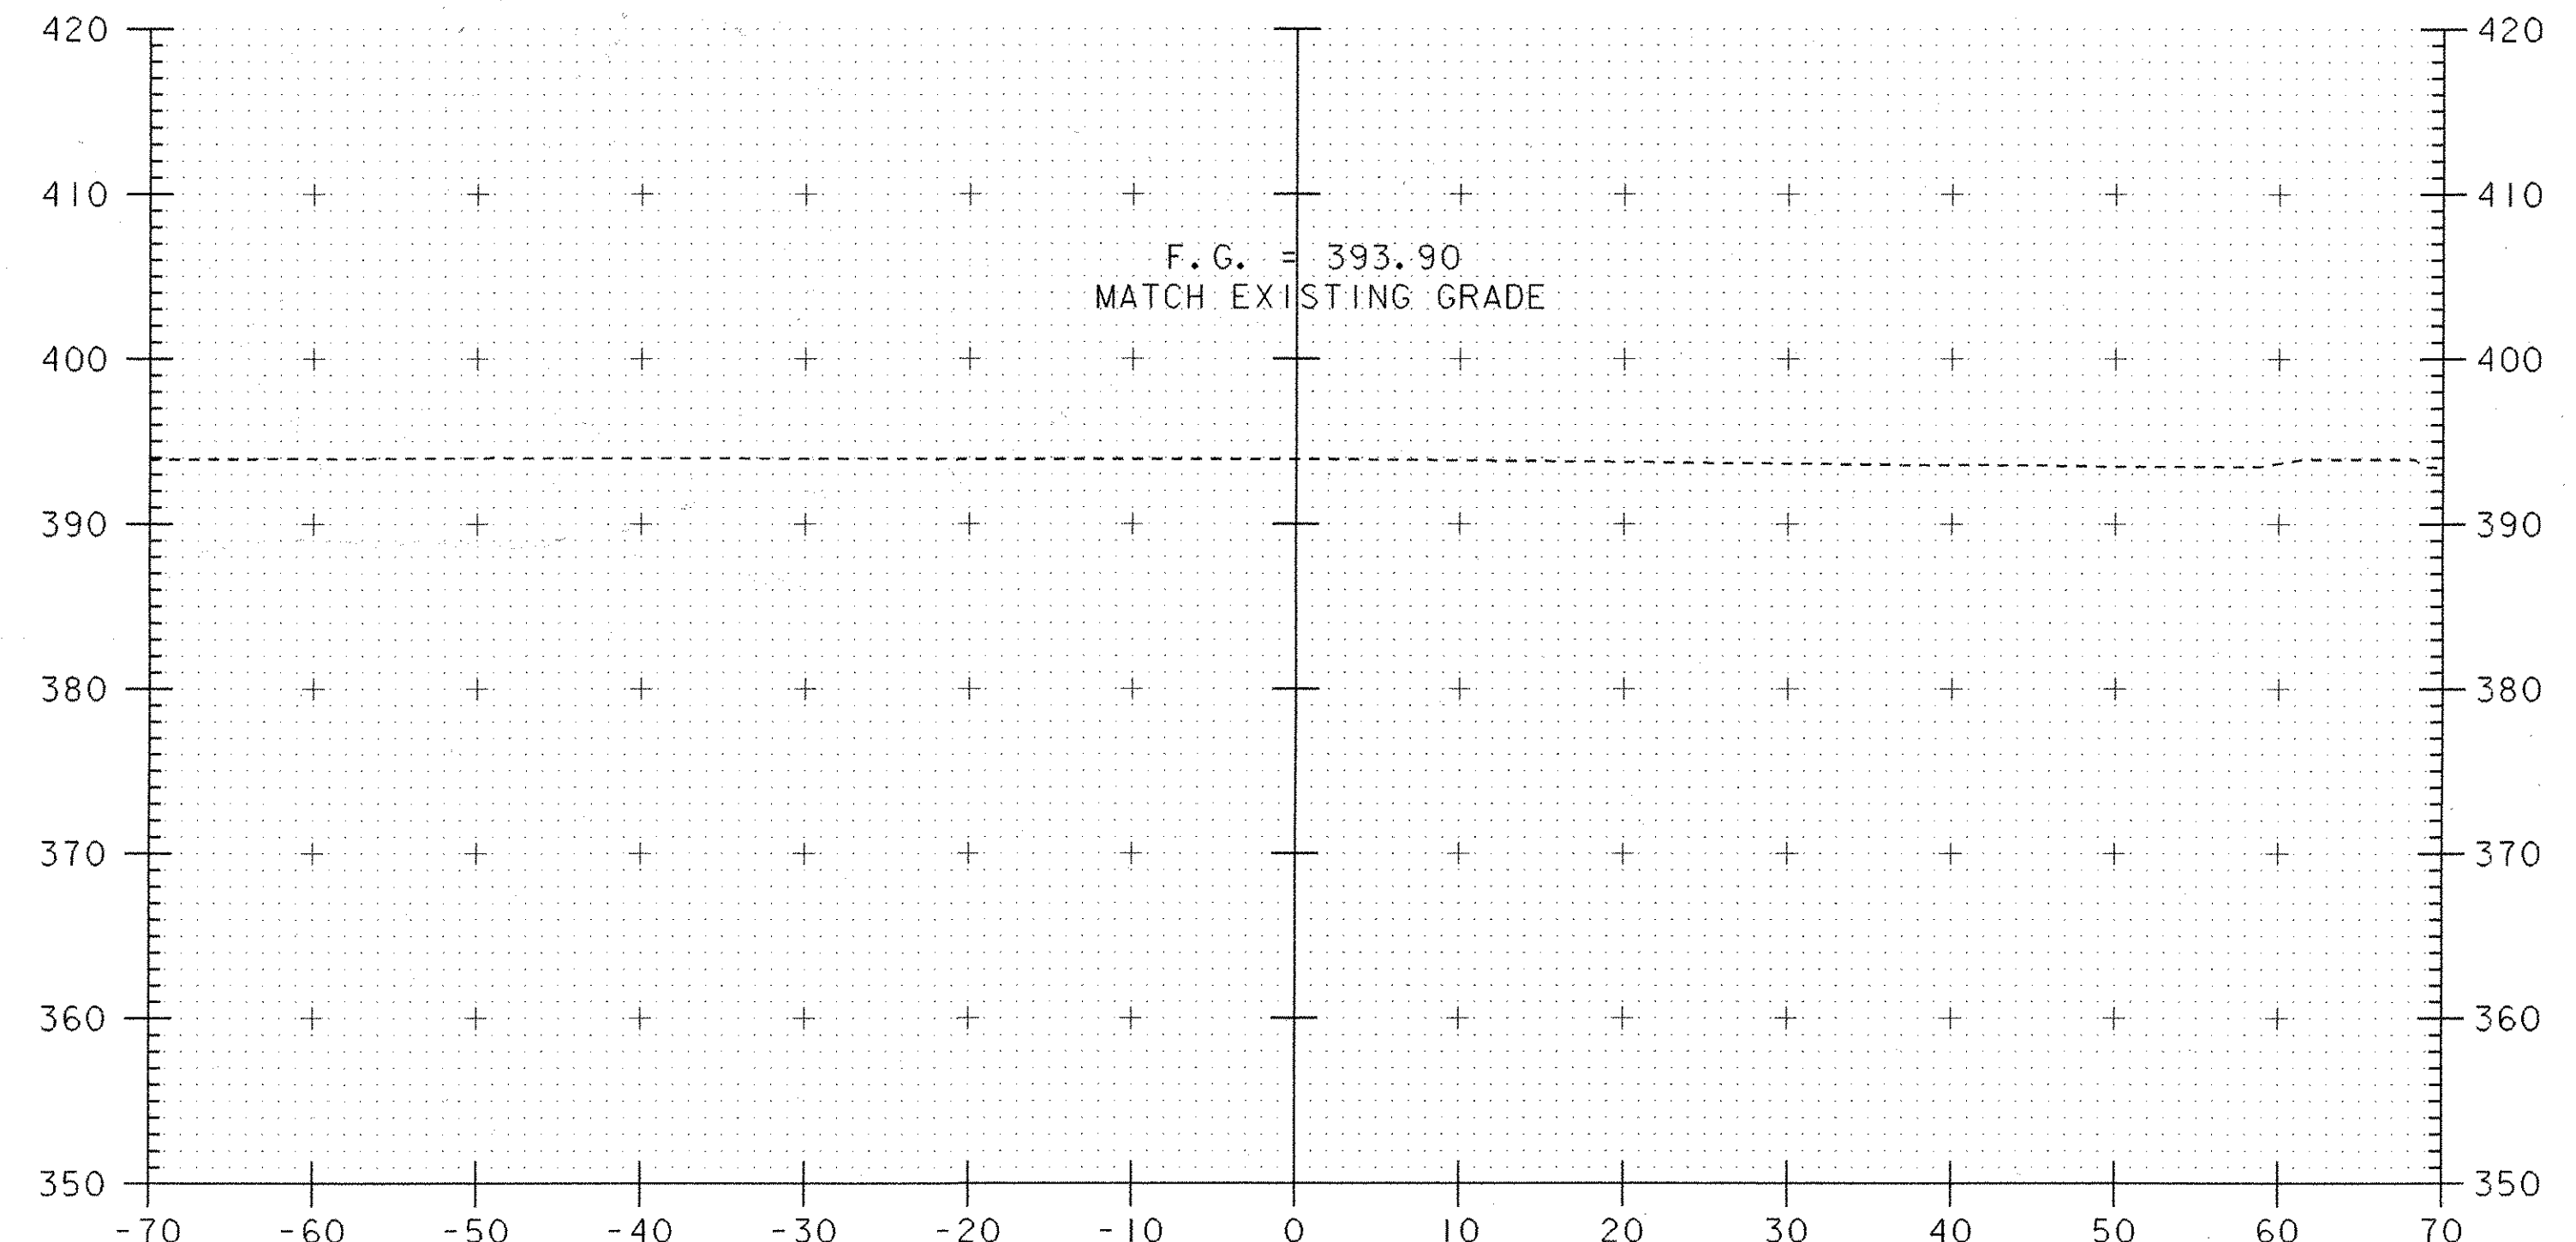

34+67

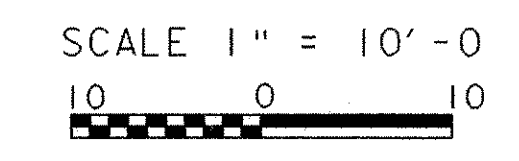

PROJECT: HARTFORD	PROJECT NO.: BRO-BTN 2004(1)
DESIGN FILE NAME: 89j045/structures/sj045xsl.dgn	PLOT DATE: 11-FEB-2005
IPARM FILE NAME: sj045m16.i	
TH 4 CROSS SECTIONS	
SECTION 34+00 THROUGH 34+67	SHEET: 70 OF 97