




207+25  
 BEGIN APPROACH  
 BEGIN COLDPLANING  
 STA 207+25.00

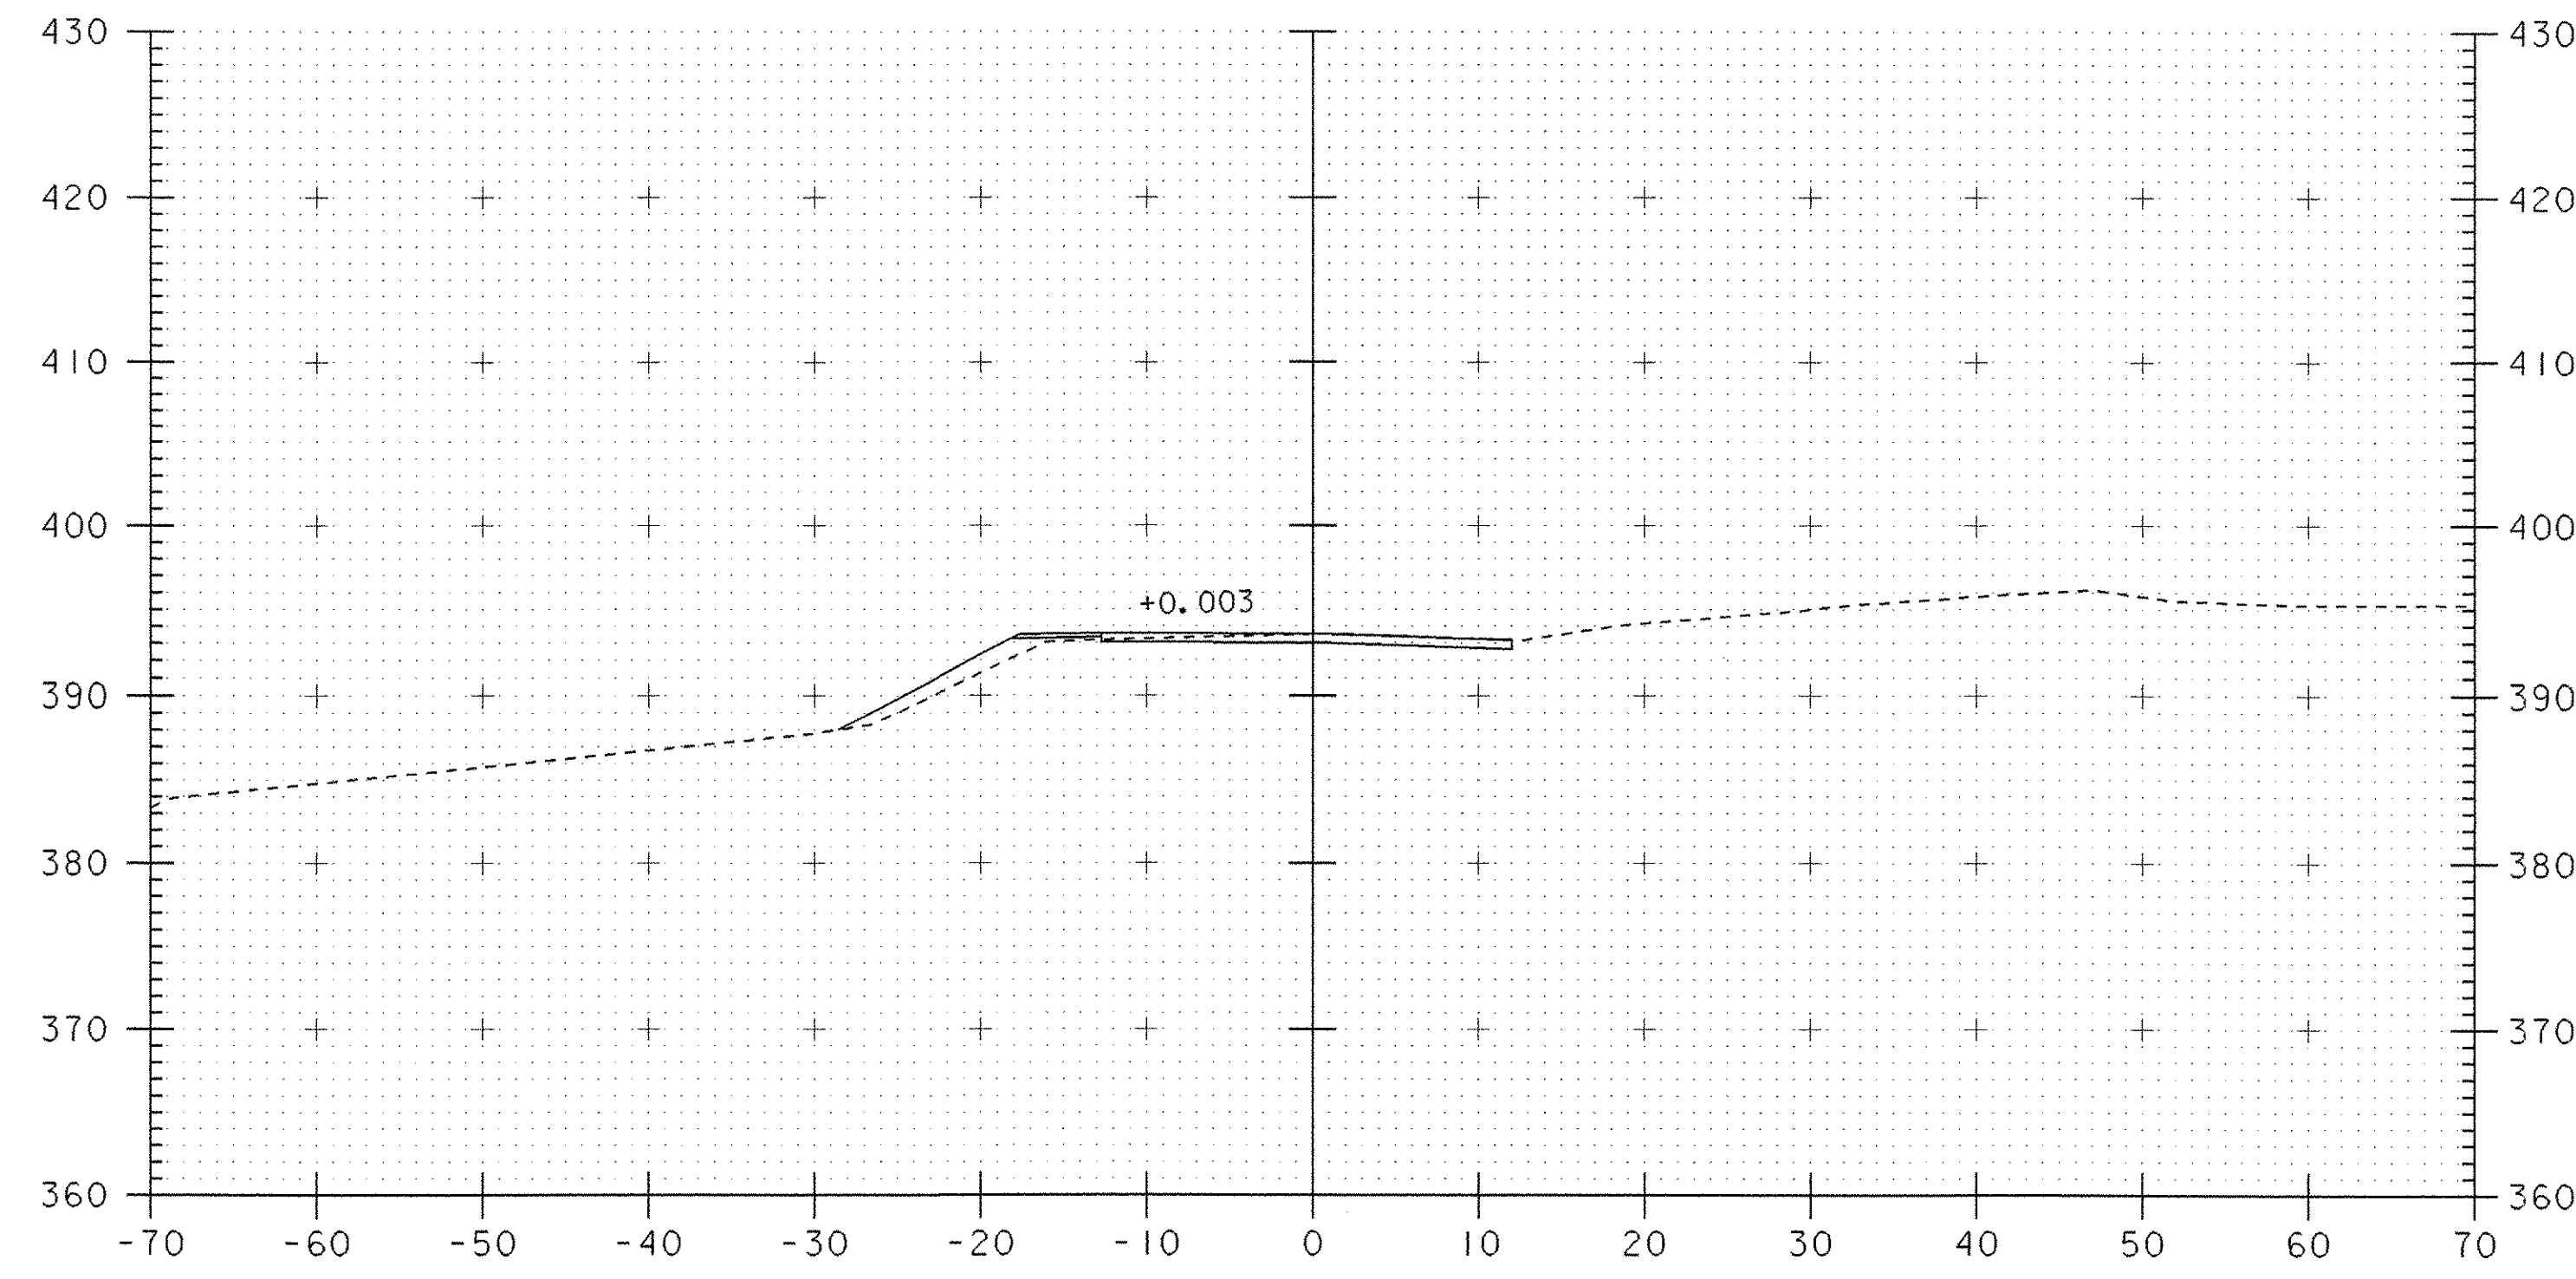

207+75

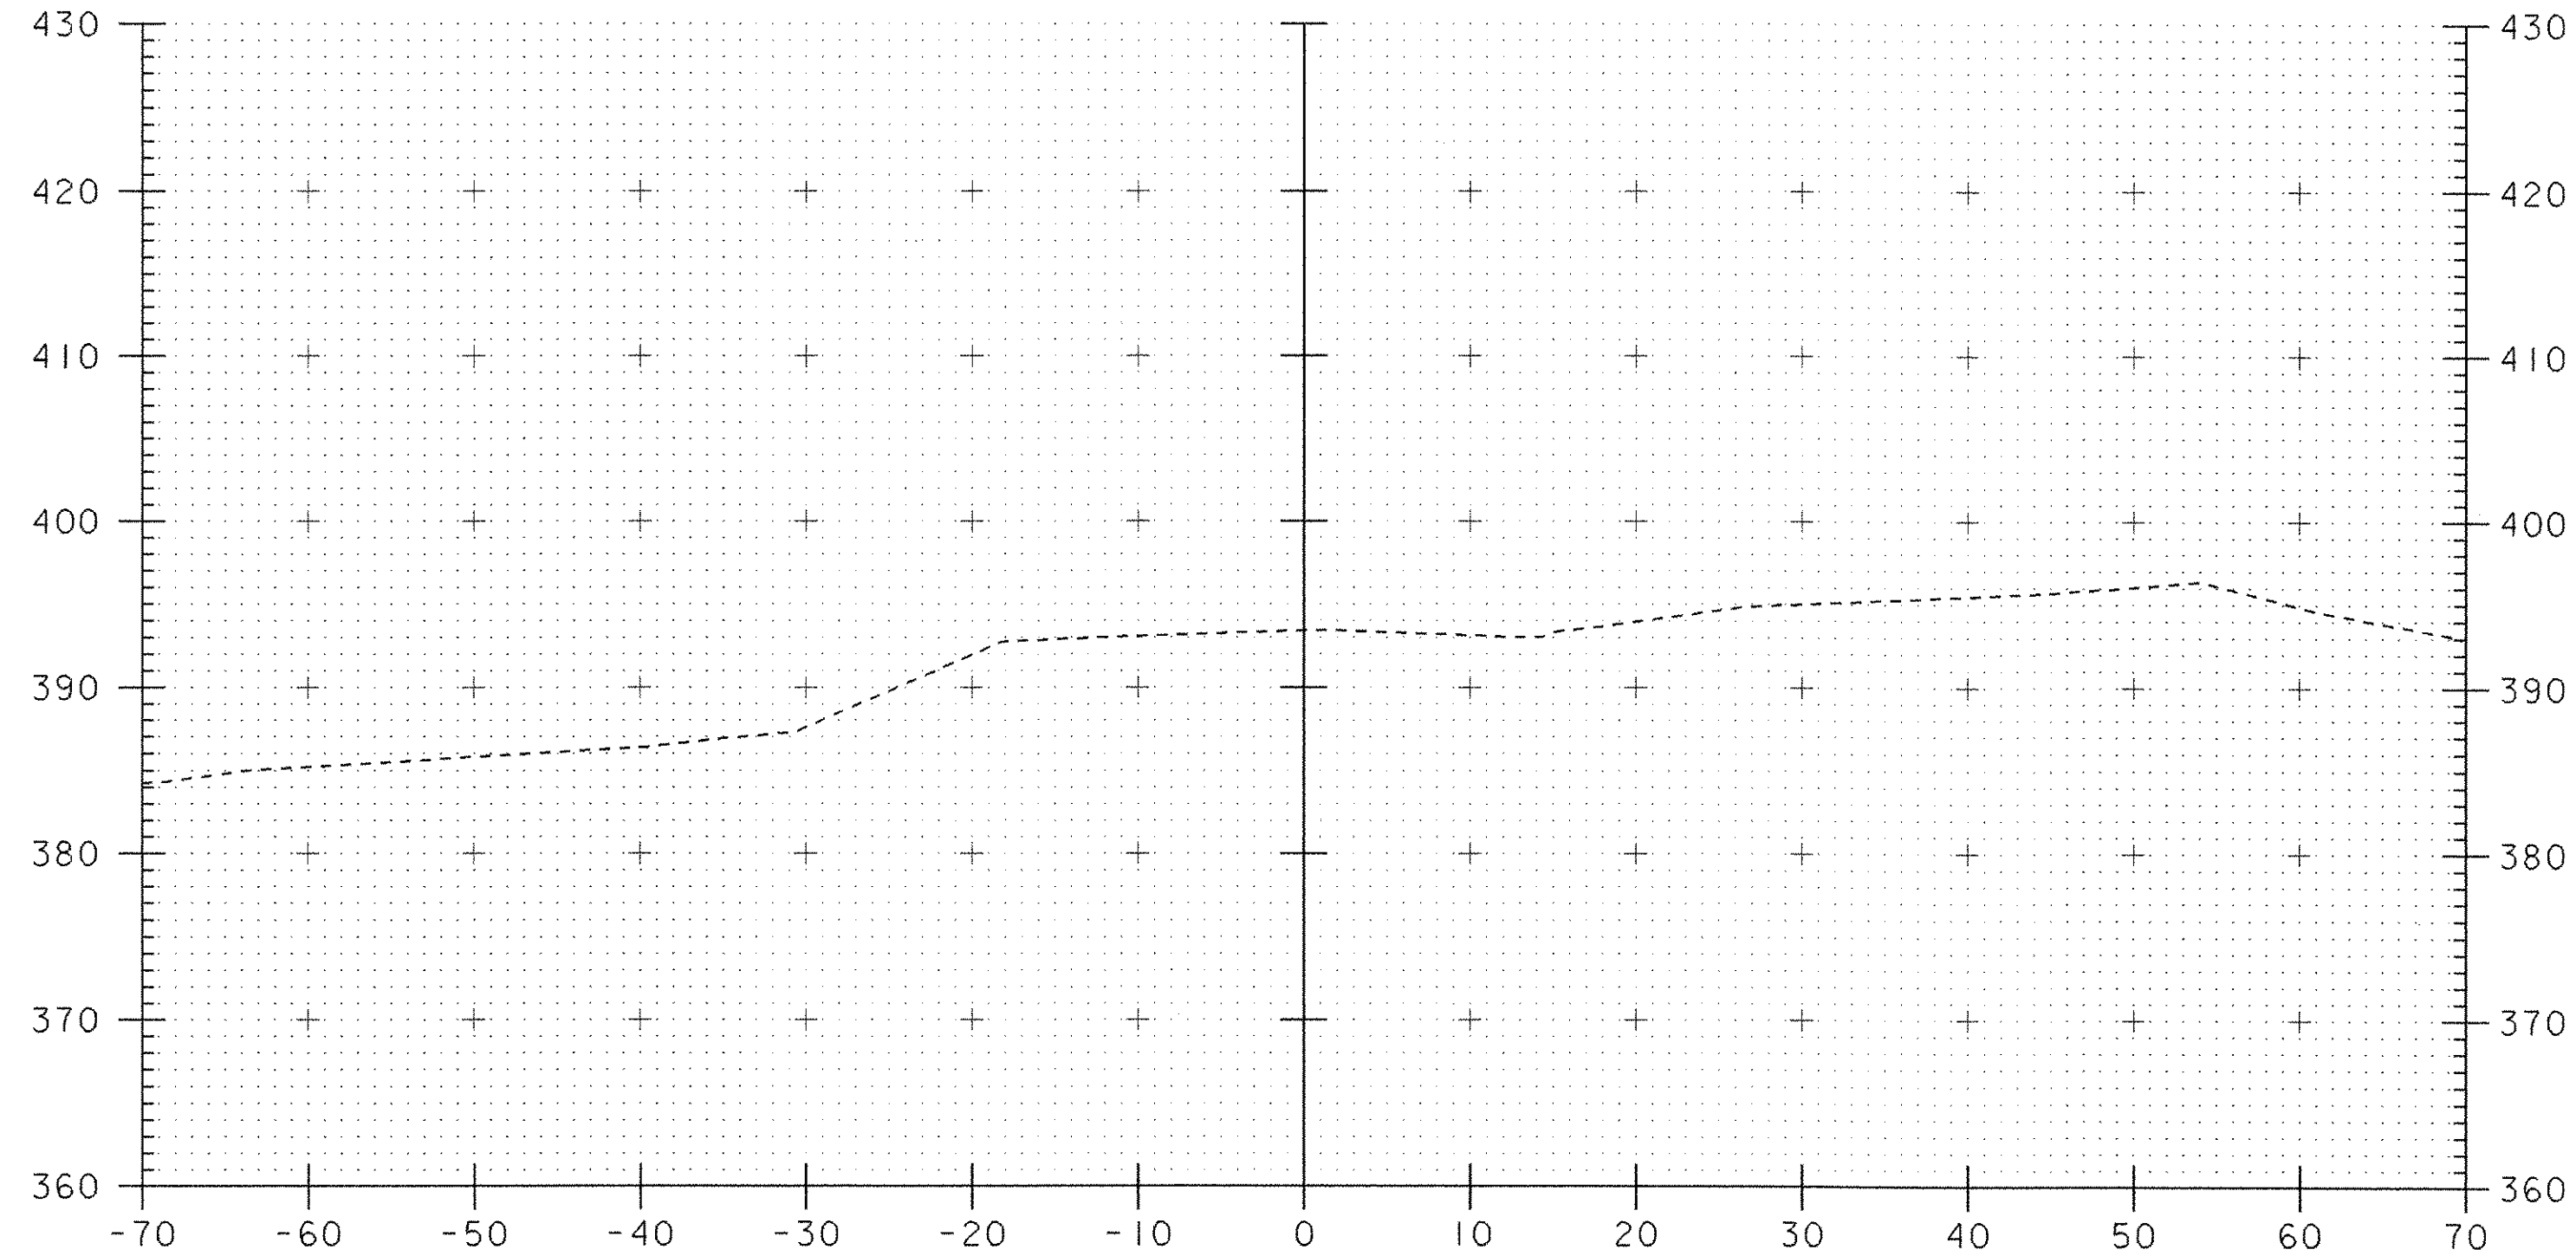

207+00

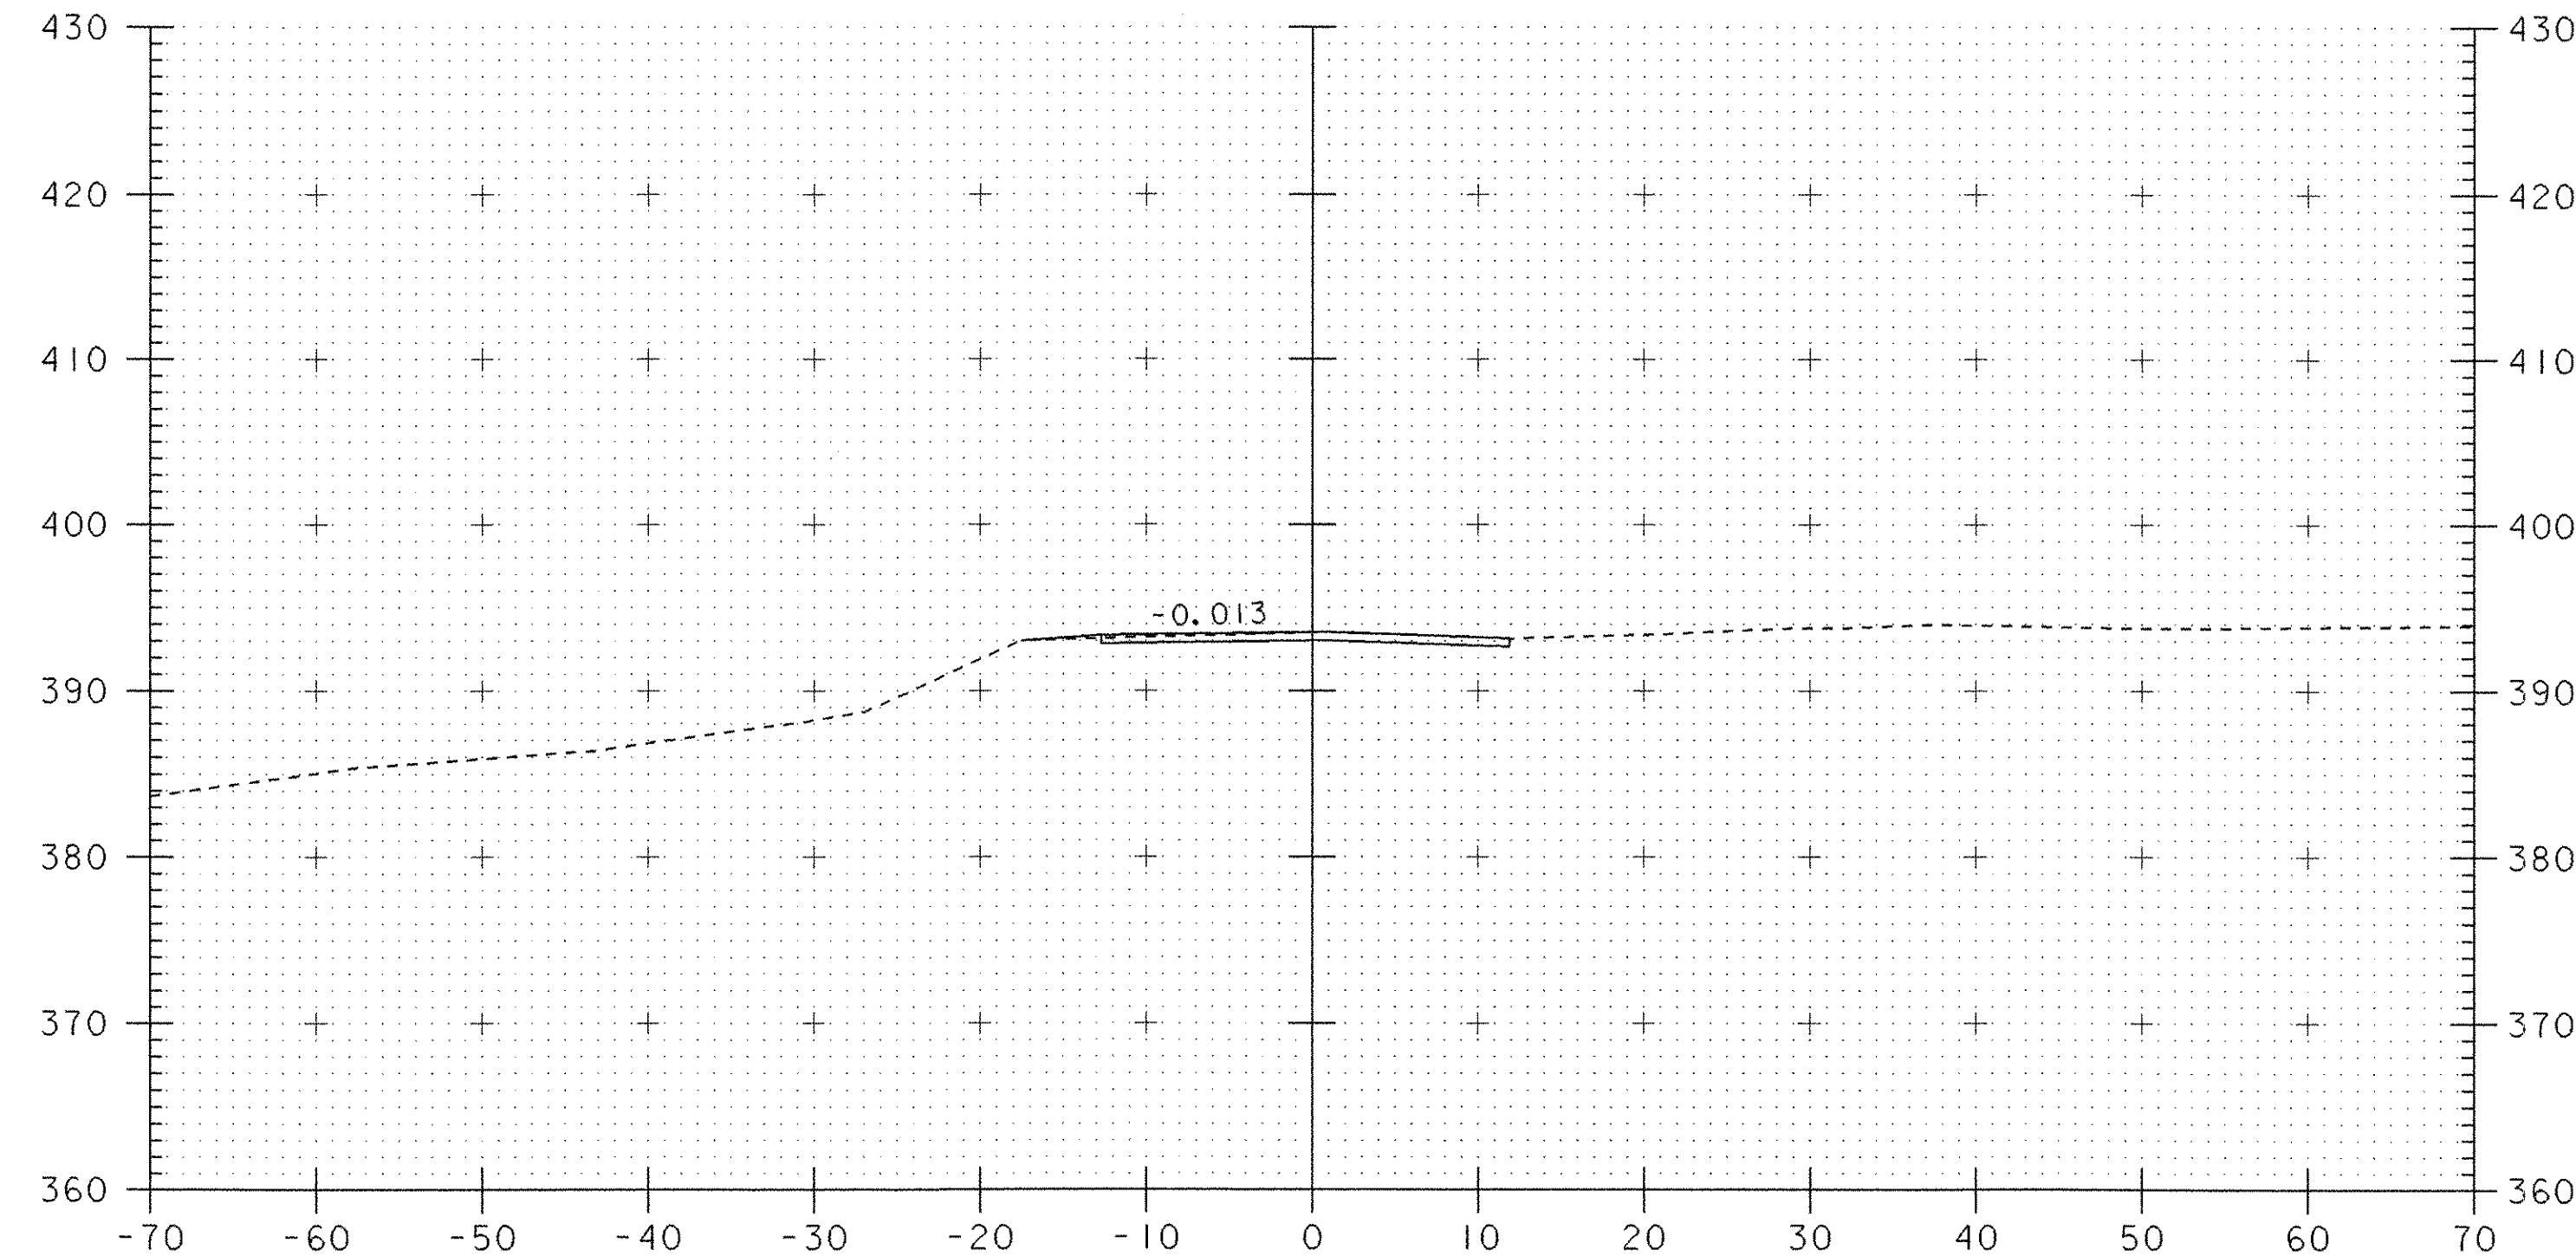

207+50



PROJECT: HARTFORD	PROJECT NO.: BRO-BTN 2004(I)
DESIGN FILE NAME: 89j045/structures/sj045xsl.dgn	PLOT DATE: 11-FEB-2005
IPARM FILE NAME: sj045vt2.i	
VT RT 14 CROSS SECTIONS	
SECTION 207+00 THROUGH 207+75	SHEET: 78 OF 97