
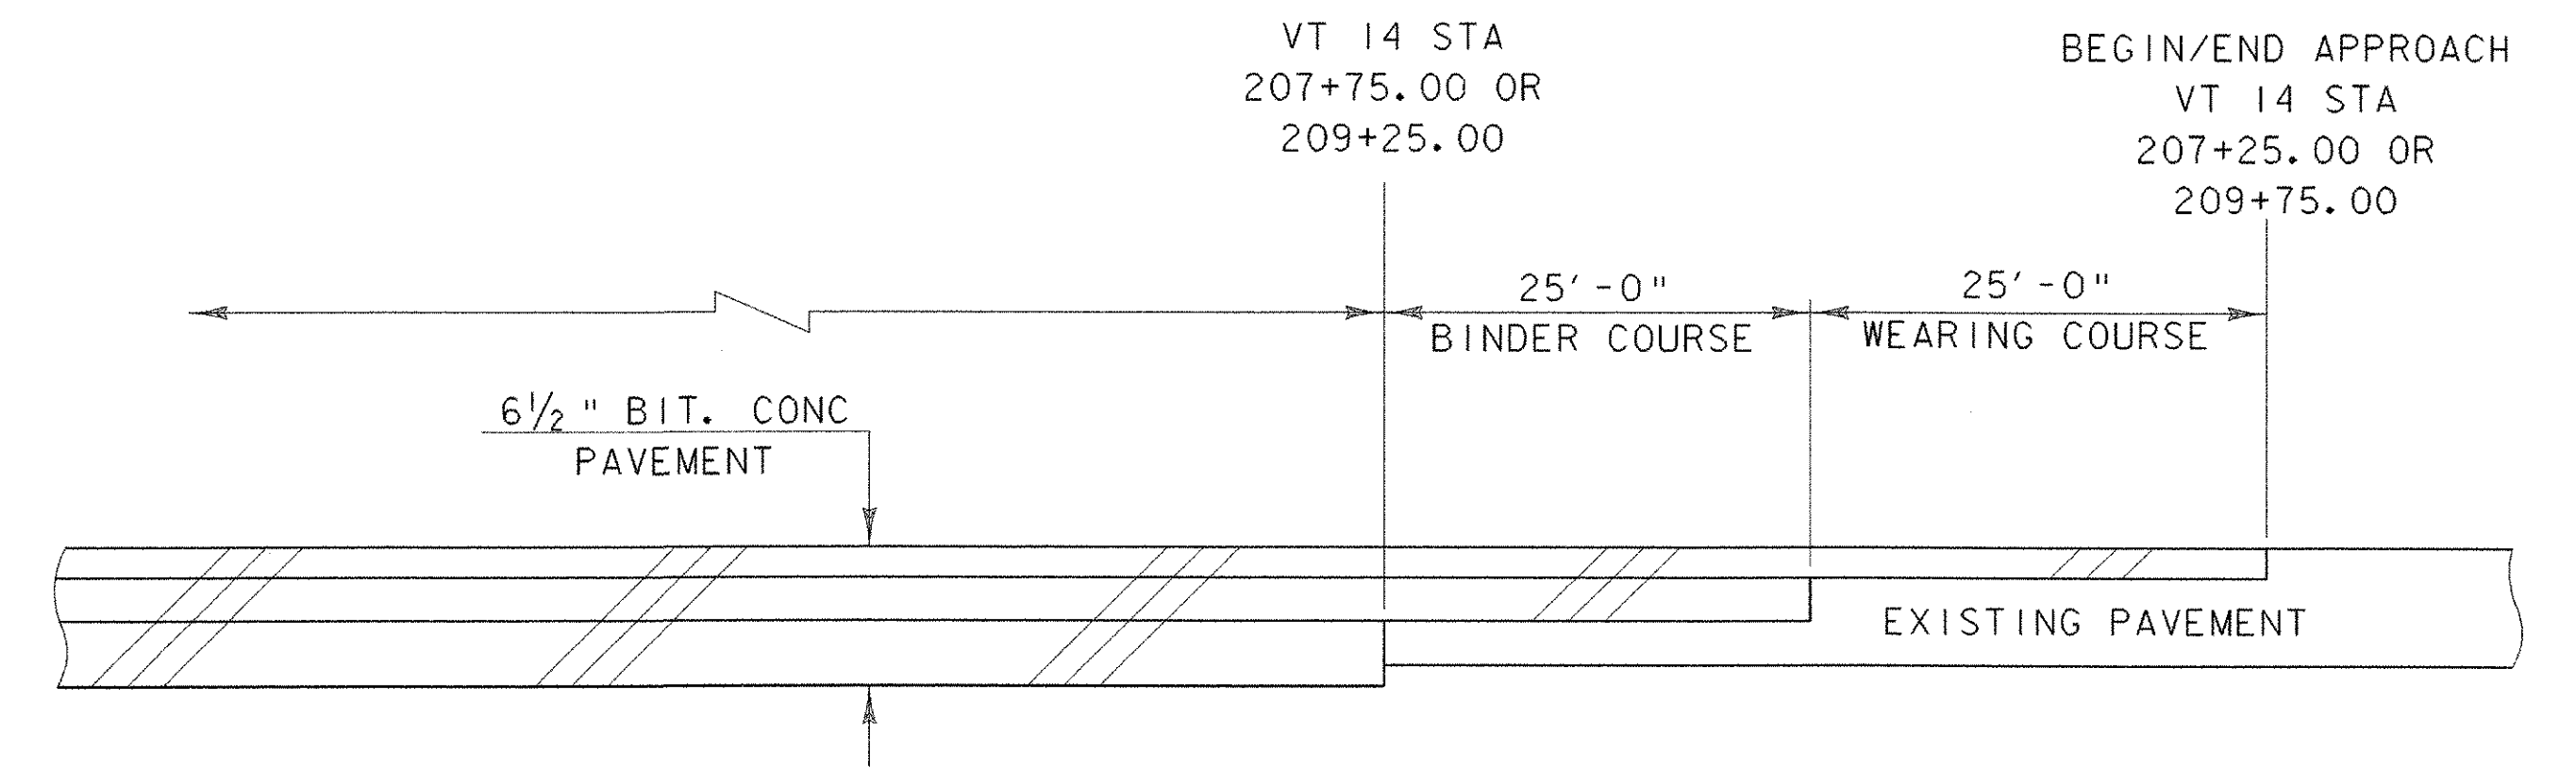


BANKING DIAGRAM FOR VT RTE 14
(STA. 207+25 THROUGH 209+50 LEFT LANE ONLY)

NTS

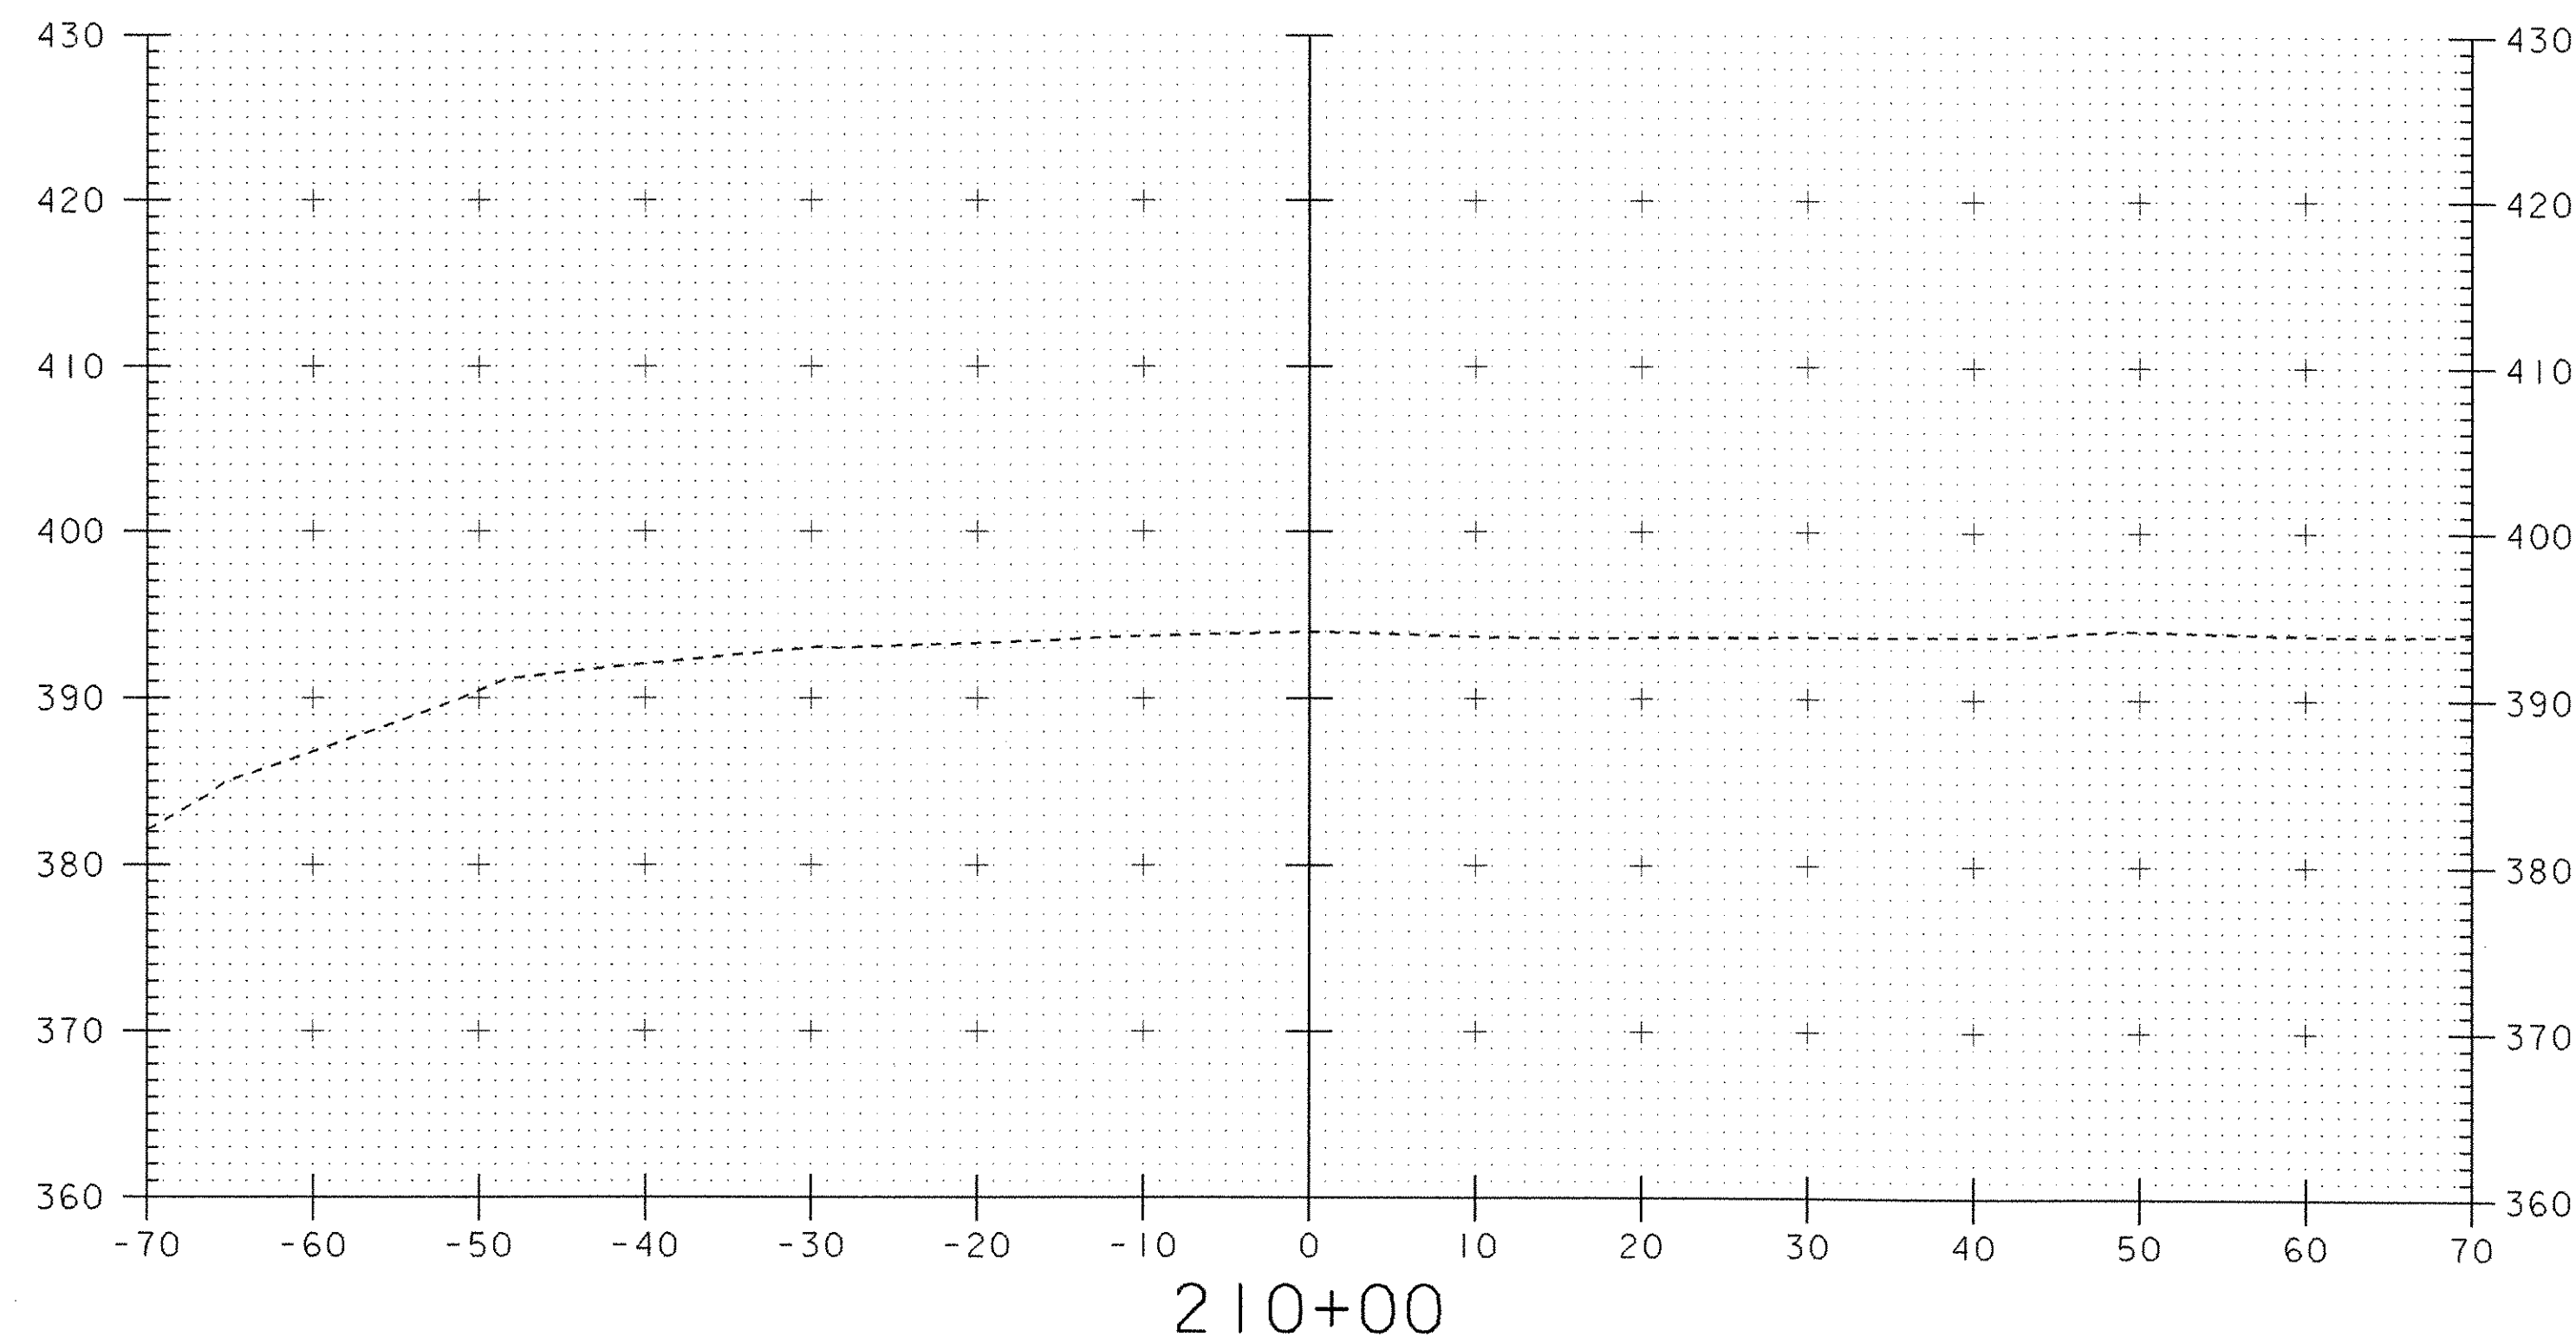

BEGIN/END APPROACH FOR VT RTE 14

NTS

SCALE 1" = 10'-0"
10 0 10

PROJECT: HARTFORD	PROJECT NO.: BRO-BTN 2004(I)
DESIGN FILE NAME: 89j045/structures/sj045xsl.dgn	PLOT DATE: 11-FEB-2005
IPARM FILE NAME: sj045v+5.i	
VT RT 14 CROSS SECTIONS	
SECTION 210+00	SHEET: 81 OF 97