


STA 51+58.00 RT  
 BEGIN STONE FILL TYPE IV  
 BEGIN UNCLASSIFIED CHANNEL EXCAVATION  
 BEGIN GEOTEXTILE UNDER STONE FILL  
 BEGIN GRUBBING MATERIAL

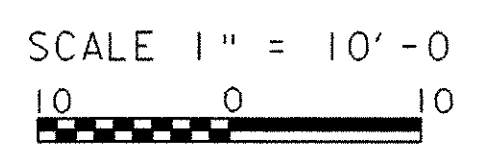

PROJECT: HARTFORD	PROJECT NO.: BRO-BTN 2004(I)
DESIGN FILE NAME: 89j045/structures/sj045xsl.dgn	PLOT DATE: 11-FEB-2005
IPARM FILE NAME: sj045ch3.i	
CHANNEL CROSS SECTIONS	
SECTION 51+75 THROUGH 52+00	SHEET: 84 OF 97