


52+50

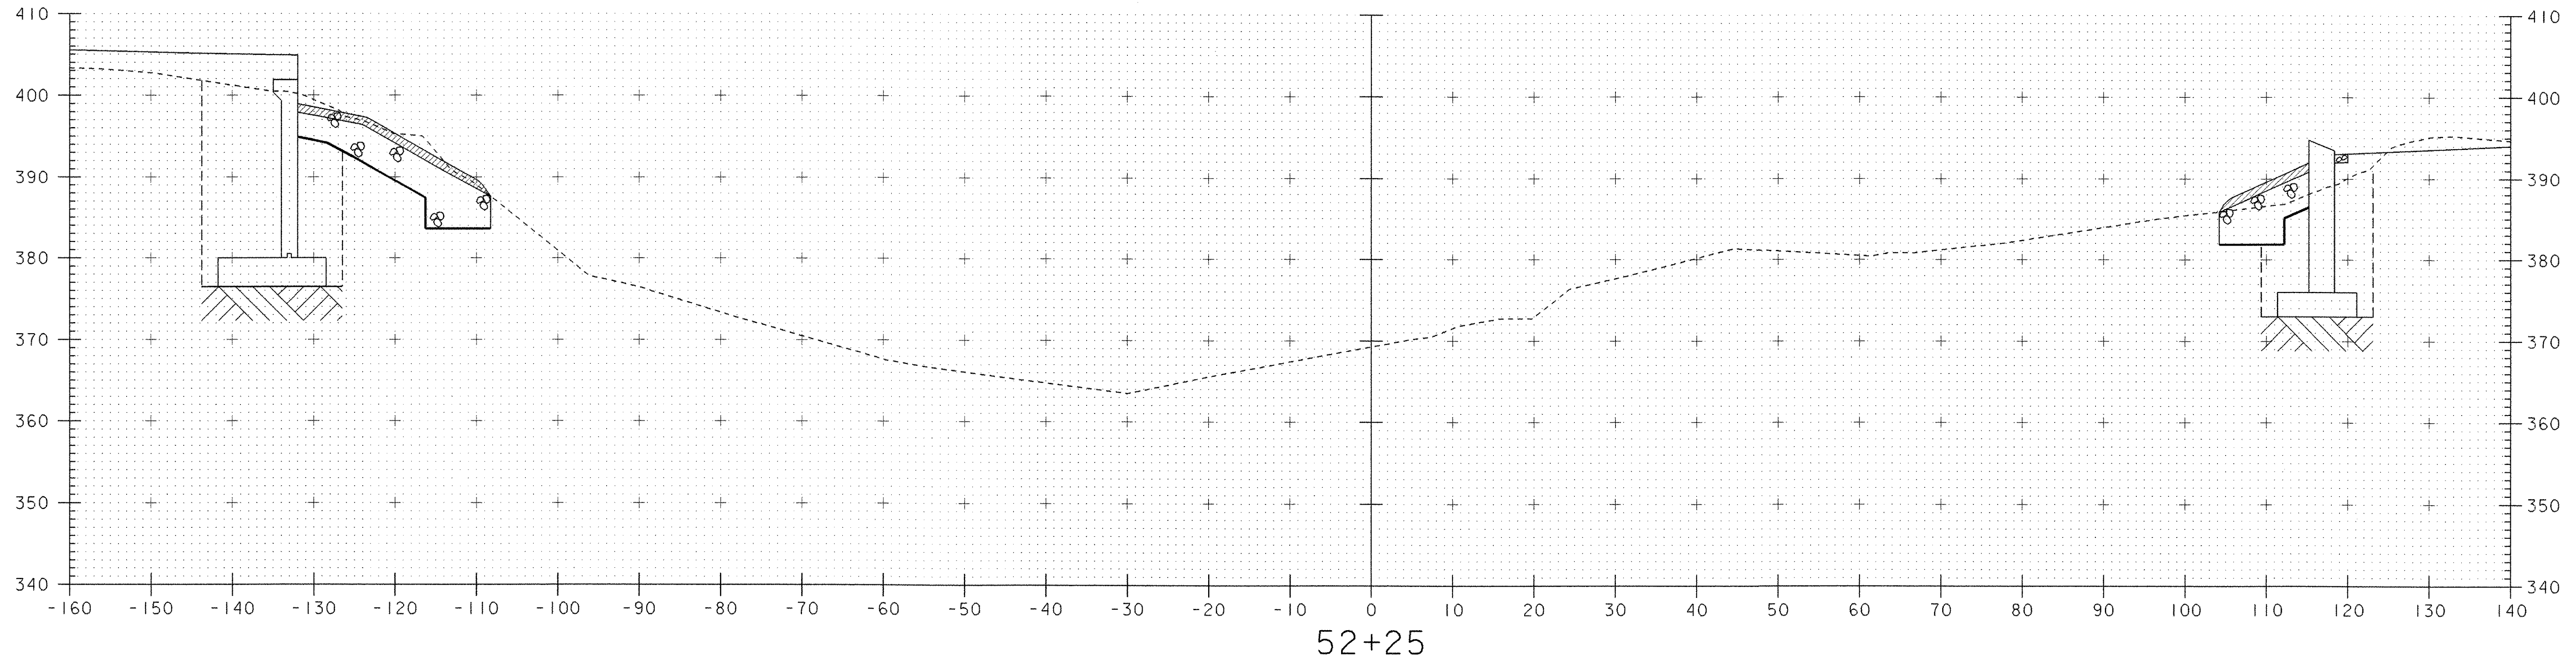

52+25

SCALE 1" = 10'-0"  
 10 0 10

PROJECT: HARTFORD	PROJECT NO.: BRO-BTN 2004(I)
DESIGN FILE NAME: 89j045/structures/sj045xsl.dgn	PLOT DATE: 11-FEB-2005
IPARM FILE NAME: sj045ch4.i	
CHANNEL CROSS SECTIONS	
SECTION 52+25 THROUGH 52+50	SHEET: 85 OF 97