


53+00

STA 52+95.00 LT  
 END STONE FILL TYPE IV  
 END UNCLASSIFIED CHANNEL EXCAVATION  
 END GEOTEXTILE UNDER STONE FILL  
 END GRUBBING MATERIAL

STA 52+80.00 RT  
 END STONE FILL TYPE IV  
 END UNCLASSIFIED CHANNEL EXCAVATION  
 END GEOTEXTILE UNDER STONE FILL  
 END GRUBBING MATERIAL

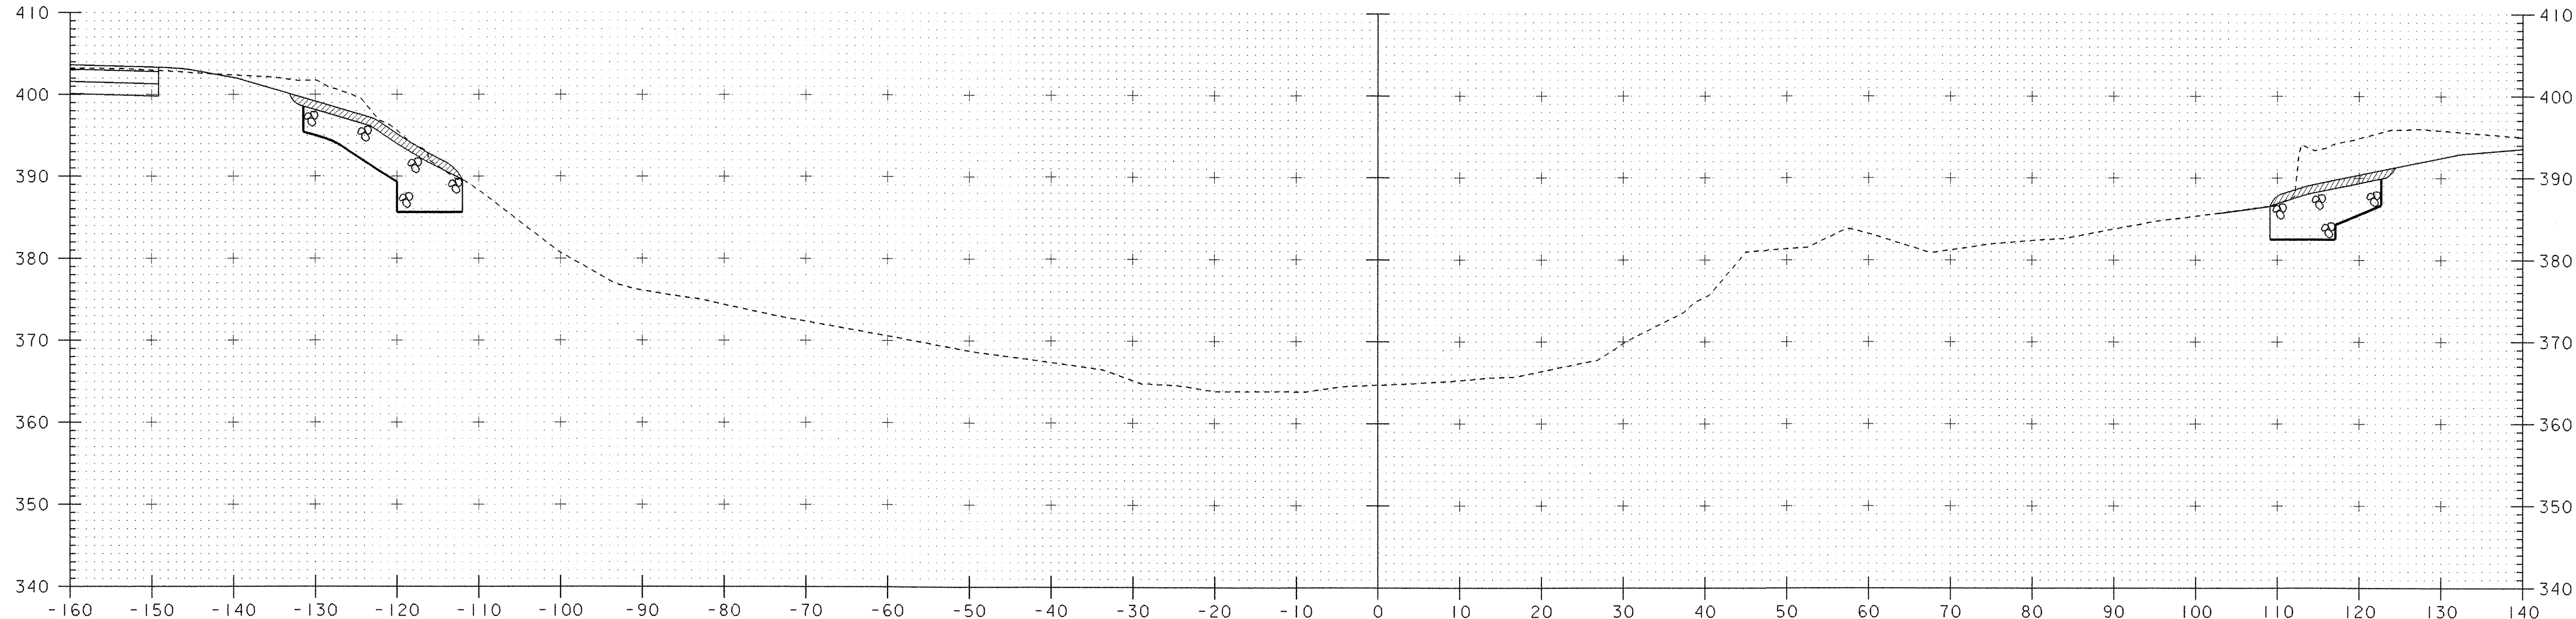

52+75

SCALE 1" = 10'-0"  
 10 0 10

PROJECT: HARTFORD	PROJECT NO.: BRO-BTN 2004(I)
DESIGN FILE NAME: 89j045/structures/sj045xsl.dgn	PLOT DATE: 11-FEB-2005
IPARM FILE NAME: sj045ch5.j	
CHANNEL CROSS SECTIONS	
SECTION 52+75 THROUGH 53+00	SHEET: 86 OF 97