


54+00

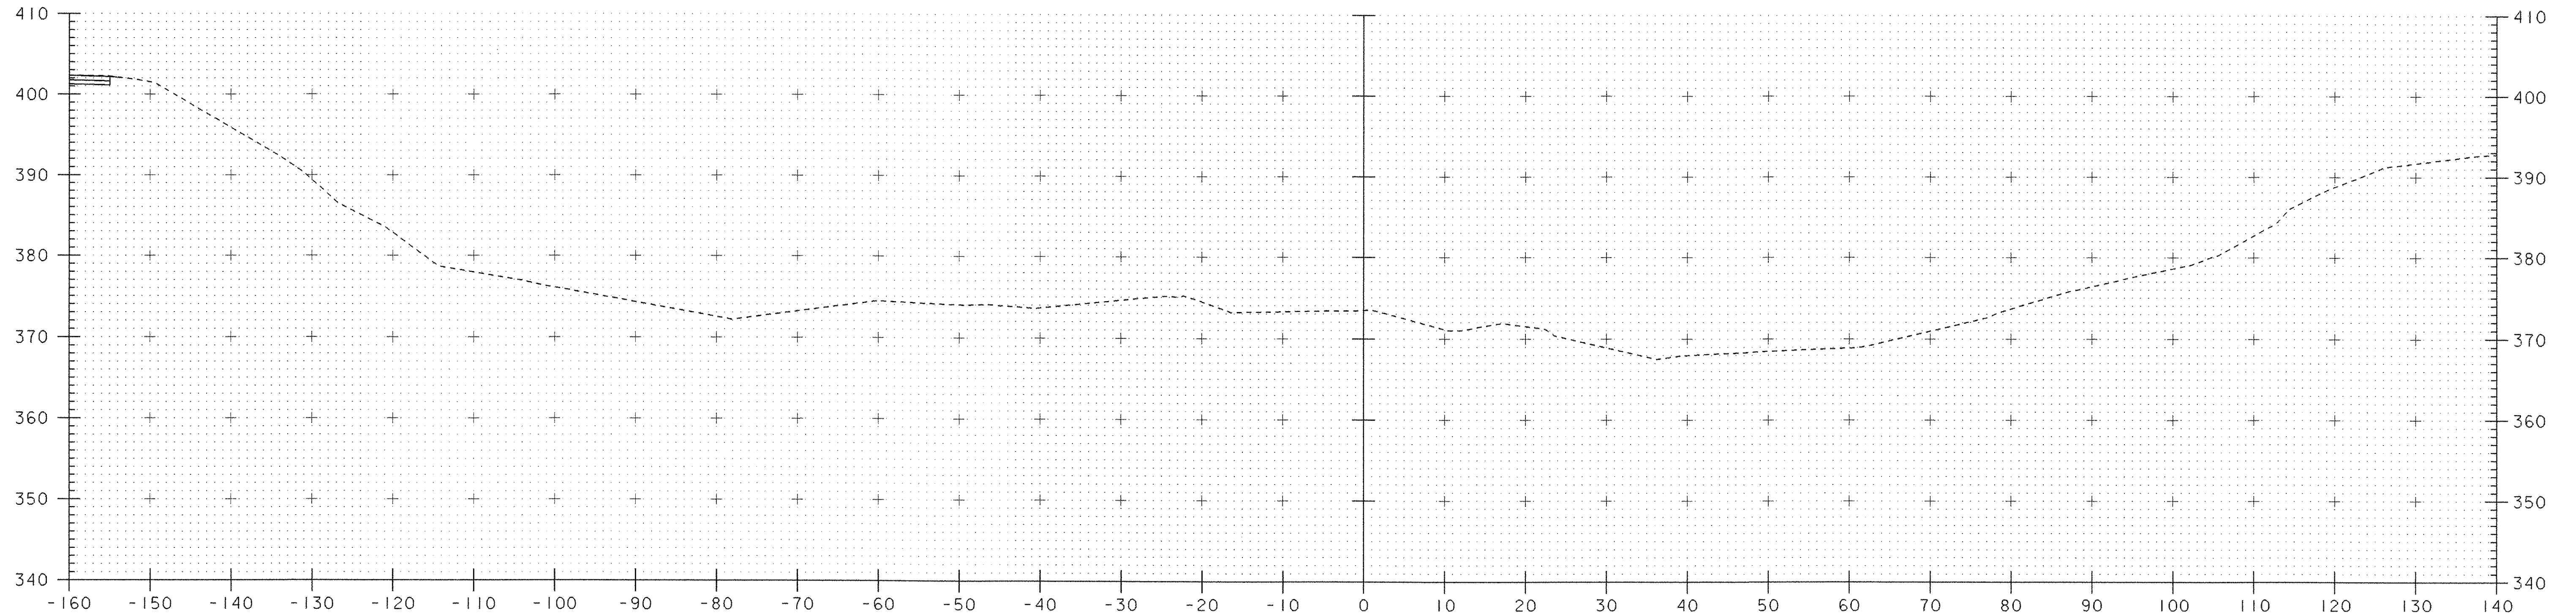

53+50

SCALE 1" = 10'-0"  
 10 0 10

PROJECT: HARTFORD	PROJECT NO.: BRO-BTN 2004(I)
DESIGN FILE NAME: 89j045/structures/sj045xsl.dgn	IPARM FILE NAME: sj045ch6.i
CHANNEL CROSS SECTIONS	
SECTION 53+50 THROUGH 54+00	SHEET: 87 OF 97