


PANEL A1 (3-REQD)

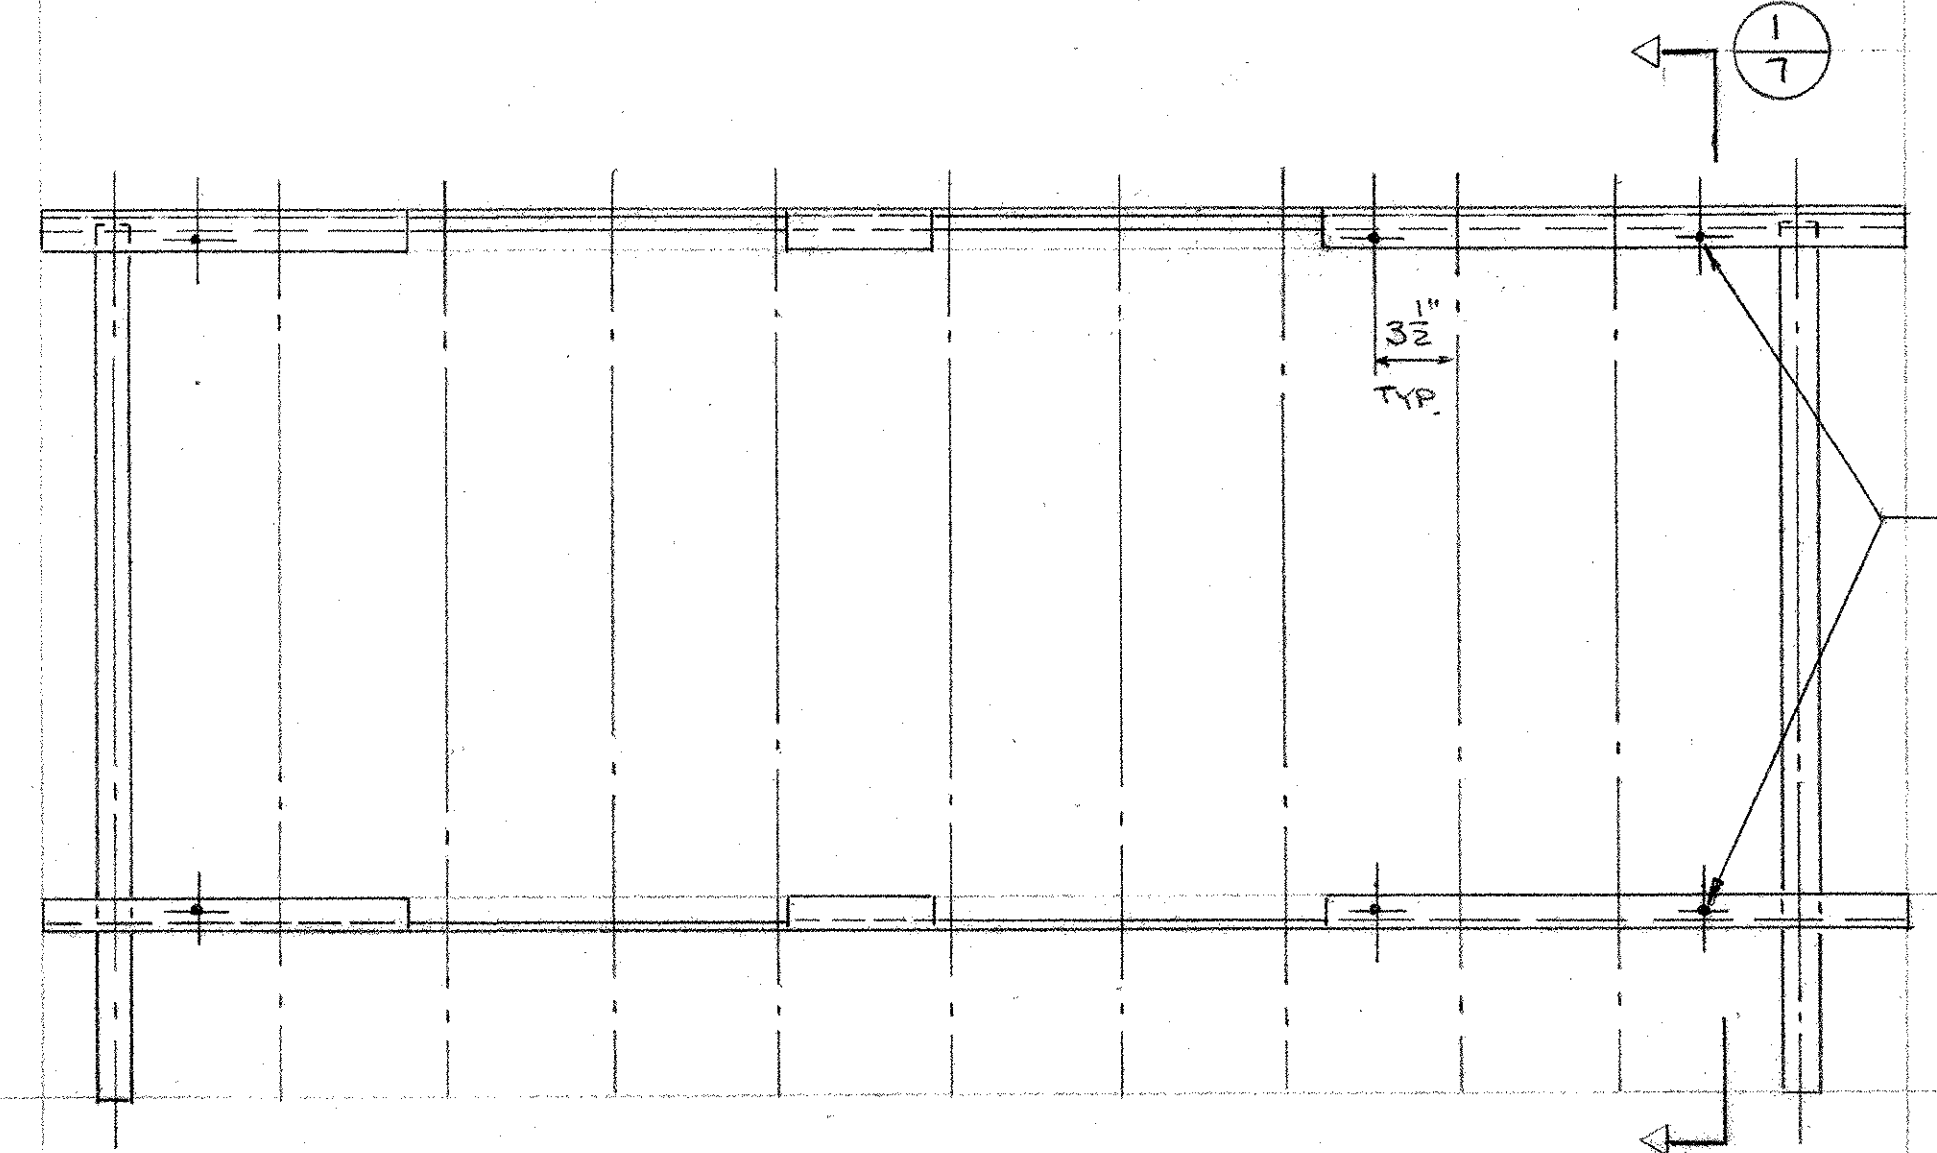

PANEL A2 (1-REQD)

RECEIVED
 CK'D BY MMH CK'D BY _____
 MAY 12 2006
 RESUBMIT _____ APPROVED _____
 BY CPW DATE 5/15/06

AUCIELLO IRON WORKS INC 580 MAIN ST. HUDSON, MA (978) 568-8382	
V.T. AGENCY OF TRANSPORTATION HARTFORD PROJ# BRO-BTN2004(1) BRIDGE #3 T.H.4 OVER WHITE RIVER	
ALUM. PICKET PANELS	
SURFACE PREP: NONE	FINISH: BLACK ANODIZE
FOR: FRANK W. WHITCOMB CORP. DR: WM 3.23.06 CHK: CPW 3.24.06 JOB NO. AB60012-1001	
DWG. NO. BR-2878 SHEET 3 OF 3	

ISSUE	DATE	DESCRIPTION
2	5-8-06	FOR APPROVAL
1	3-24-06	FOR APPROVAL