



Profile

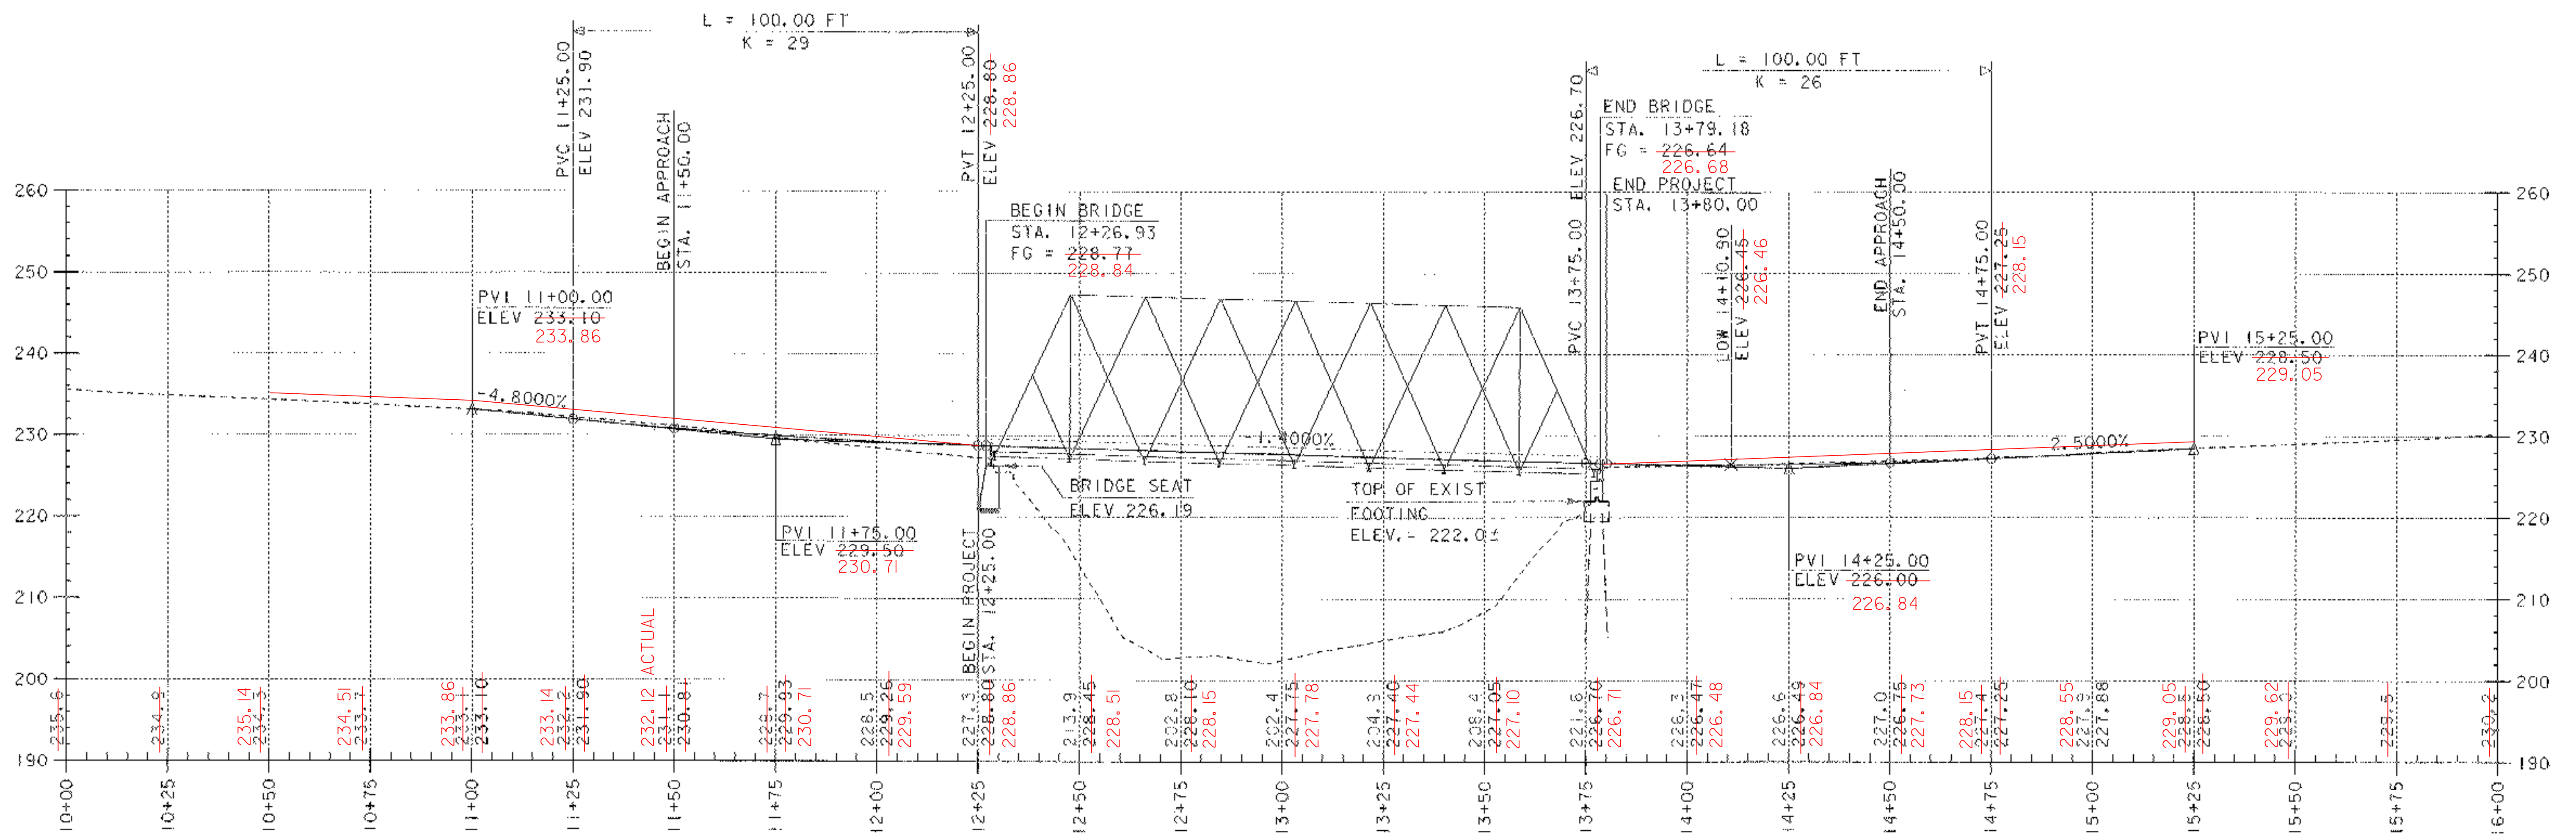

NOTE: EXISTING CENTERLINE ELEVATIONS ARE SHOWN TO THE TENTH.
PROPOSED CENTERLINE ELEVATIONS ARE SHOWN TO THE HUNDREDTH.

DATUM
VERTICAL NGVD 1929
HORIZONTAL ASSUMED

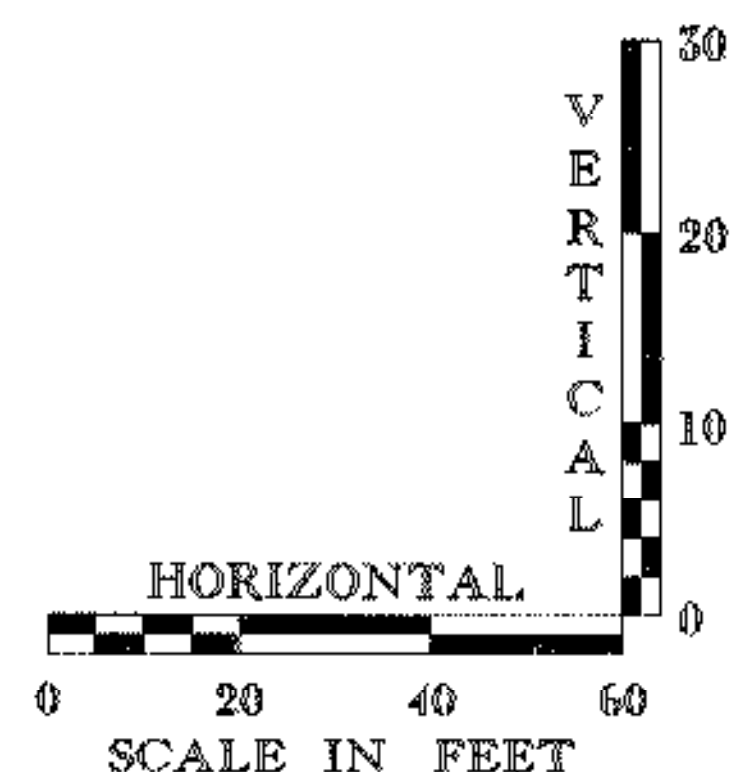

PROJECT: NEW HAVEN-WEYBRIDGE	PROJECT NO. # BHO-BTN 2005(1)
DESIGN FILE NAME: /usr/sfr4/89j081/sj081pr1.dgn	PLT DATE: 28-FEB-2007
IFARM FILE NAME: sj081pro.l	SURVEY DATE: 7/90
SURVEYED BY: R. MOREAU	DRAWN BY: W.B. SYMGND
SQUAD LEADER: C.P. WILLIAMS	SHEET: 9 OF 53
PROFILE SHEET	