


**PLAN**

SCALE 1" = 10'-0"

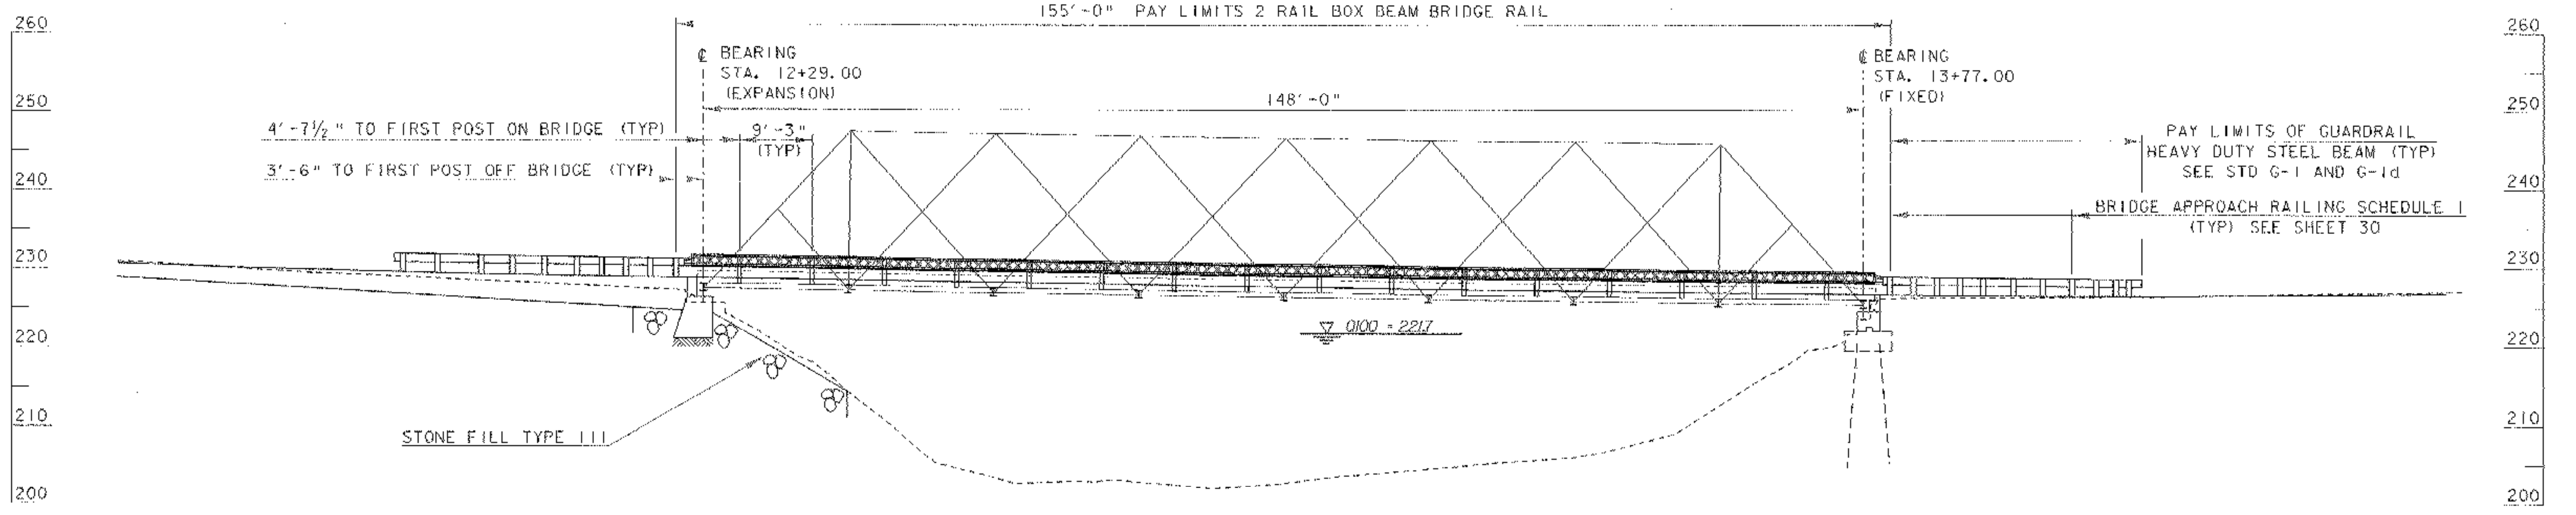

**ELEVATION**

SCALE 1" = 10'-0"

DATUM  
 VERTICAL NGVD 1929  
 HORIZONTAL ASSUMED

PROJECT: NEW HAVEN - WEYBRIDGE	PROJECT NO.: BHO-BTN 2005(1)
DESIGN FILE NAME: s:\r4\89\081\s\081pe.dgn	PLOT DATE: 28-FEB-2007
IPARM FILE NAME: s\j081pe.i	SURVEY DATE: 7/90
SURVEYED BY: R. MOREAU	DRAWN BY: P.G. JARVIS
SQUAD LEADER: C.P. WILLIAMS	SHEET: 11 OF 53
PLAN AND ELEVATION SHEET	