


STA 20+15  
 (ABUTMENT No. 1)  
 BEGIN STONE FILL TYPE III  
 BEGIN GEOTEXTILE UNDER STONE FILL  
 BEGIN GRUBBING MATERIAL  
 BEGIN UNCLASSIFIED CHANNEL EXCAVATION

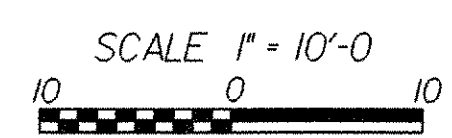

DATUM	
VERTICAL	NGVD
HORIZONTAL	ASSUMED

PROJECT:	NEW HAVEN - WEYBRIDGE	PROJECT NO.:	BHO-BTN 2005 (1)	
DESIGN FILE NAME:	/str4/89j081/sj081xs1.dgn		PLOT DATE:	28-FEB-2007
IPARM FILE NAME:	sj081c12.i		SURVEY DATE:	7/90
SURVEYED BY:	R. MOREAU		DRAWN BY:	P. G. JARVIS
SQUAD LEADER:	C. P. WILLIAMS		CHANNEL SECTIONS STA. 20+20 - STA. 20+30 SHEET: 41 OF 53	