


STA 20+80
(ABUTMENT No. 1)

END STONE FILL TYPE III
 END GEOTEXTILE UNDER STONE FILL
 END GRUBBING MATERIAL
 END UNCLASSIFIED CHANNEL EXCAVATION

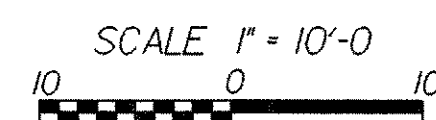

DATUM
 VERTICAL NGVD
 HORIZONTAL ASSUMED

PROJECT: NEW HAVEN - WEYBRIDGE	PROJECT NO.: BHO-BTN 2005 (1)
DESIGN FILE NAME: /str4/89j081/sj081xs1.dgn	PLOT DATE: 28-FEB-2007
IPARM FILE NAME: sj081c15.i	SURVEY DATE: 7/90
SURVEYED BY: R. MOREAU	DRAWN BY: P.G. JARVIS
SQUAD LEADER: C.P. WILLIAMS	
CHANNEL SECTIONS STA. 20+80 - STA. 20+90 SHEET: 44 OF 53	