




MK-F1 8 1/2" X 48 1/8" X 55'-11 5/8" 1 REQ'D COMB. 50 APPROX. WT. = 7210#

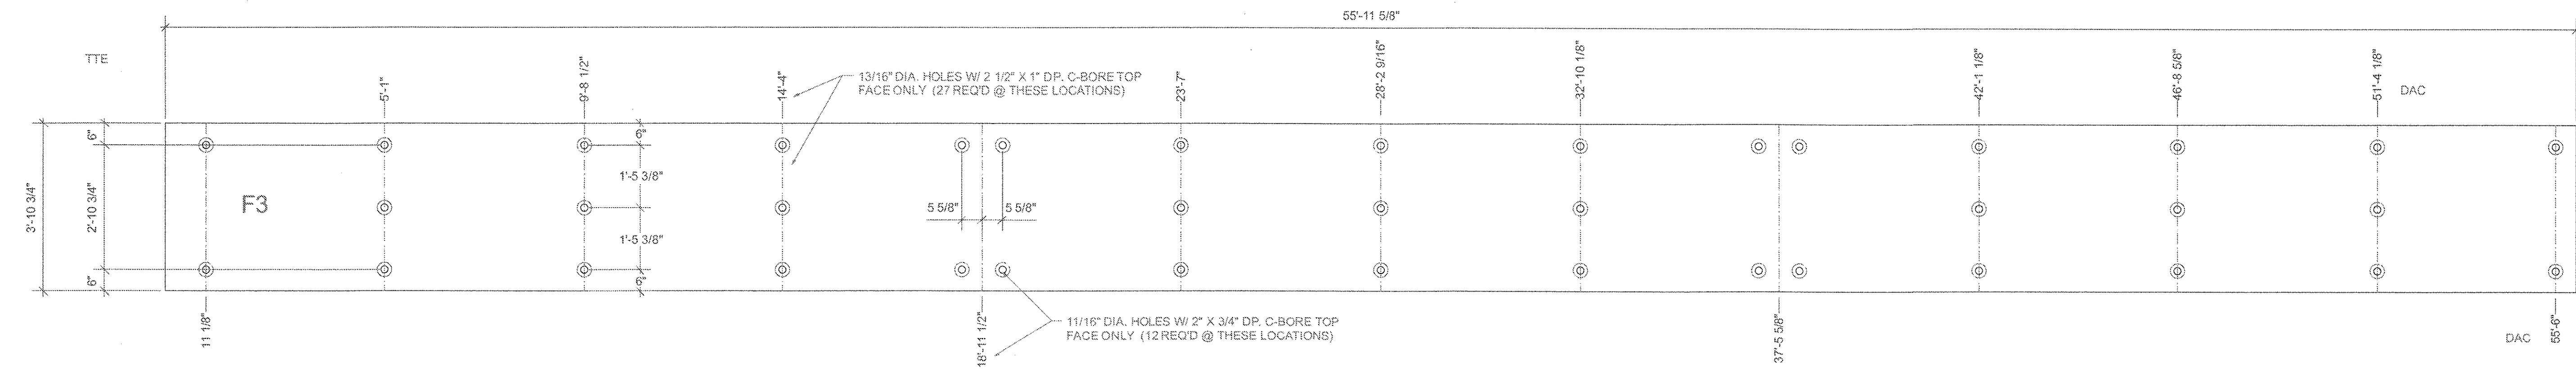

MK-F3 8 1/2" X 46 3/4" X 55'-11 5/8" 1 REQ'D COMB. 50 APPROX. WT. = 6860#

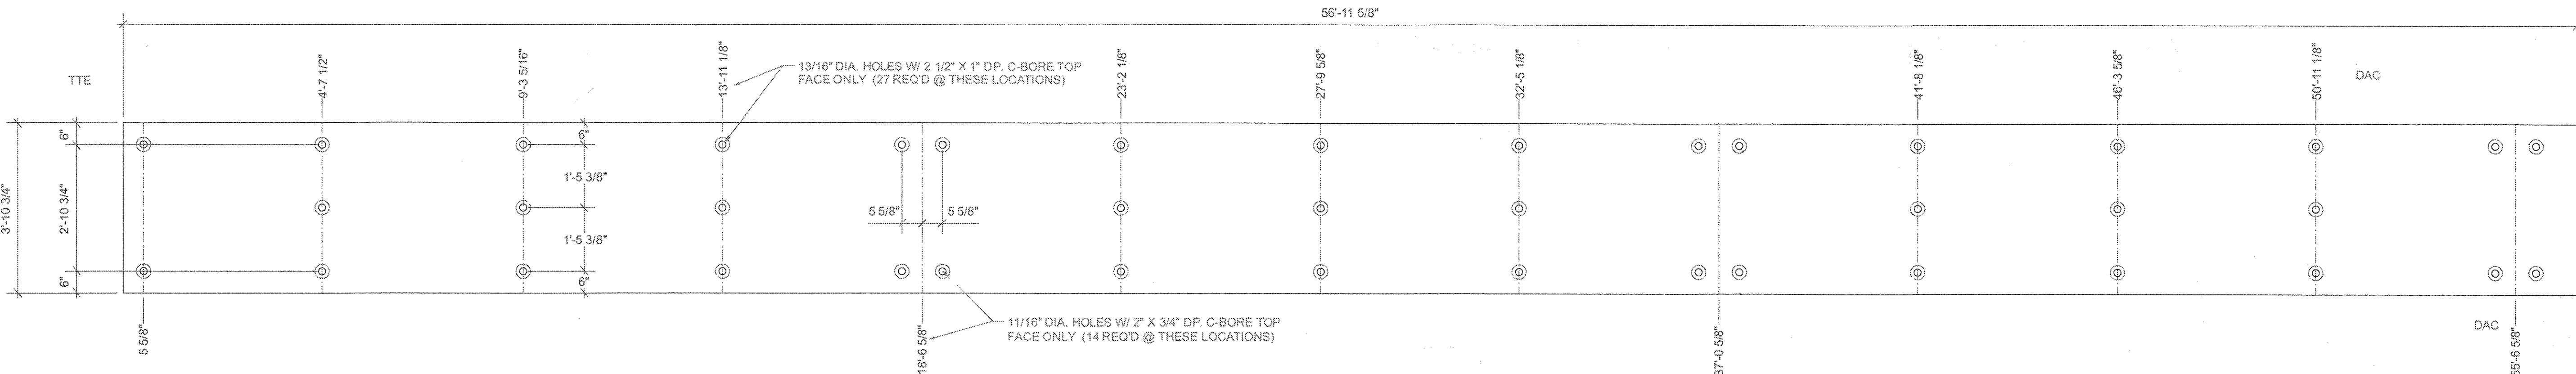

MK-F10 8 1/2" X 46 3/4" X 56'-11 5/8" 1 REQ'D COMB. 50 APPROX. WT. = 6970#

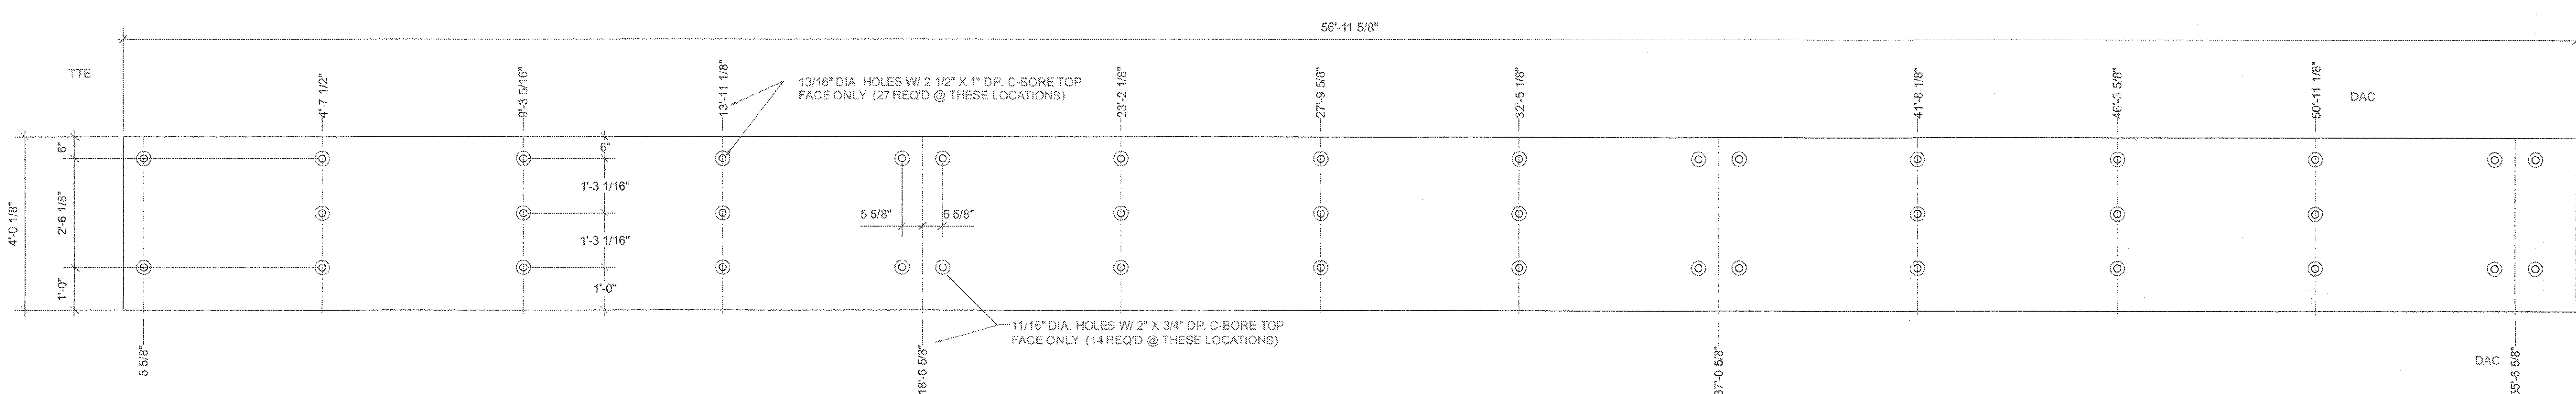

MK-F12 8 1/2" X 48 1/8" X 56'-11 5/8" 1 REQ'D COMB. 50 APPROX. WT. = 7340#

RECEIVED  
 OK'D BY: *EAC* OK'D BY: *RSR*  
 JUL 27 2007  
 RESUBMIT: \_\_\_\_\_ APPROVED: \_\_\_\_\_  
 BY: *CPW* DATE: *7/31/07*



LAMINATED CONCEPTS INC.

P.O. BOX 369  
 3310 STATE RTE 352  
 BIG FLATS, NEW YORK 14814  
 PHONE: 607.562.8110  
 FAX: 607.562.8105

DRAWN	DATE	REVISIONS		
		NO.	DATE	BY
MSS	6/4/07			
CHKD		1	7/17/07	ss
APPD		2	7/24/07	ss
SCALE				

PROJECT NAME	BHO-BTN 2005 (1) BRIDGE NO. 26 TOWNS OF NEW HAVEN AND WEYBRIDGE COUNTY OF ADDISON, VERMONT	PROJECT JOB NO.	2107-150-LT
PREPARED FOR	CCS CONSTRUCTORS, LLC MORRISVILLE, VT	SHEET NO.	2 OF 4

067-6D