




MK-F5 8 1/2" X 48 1/8" X 55'-6 5/8" 1 REQ'D COMB. 50 APPROX. WT. = 7150#

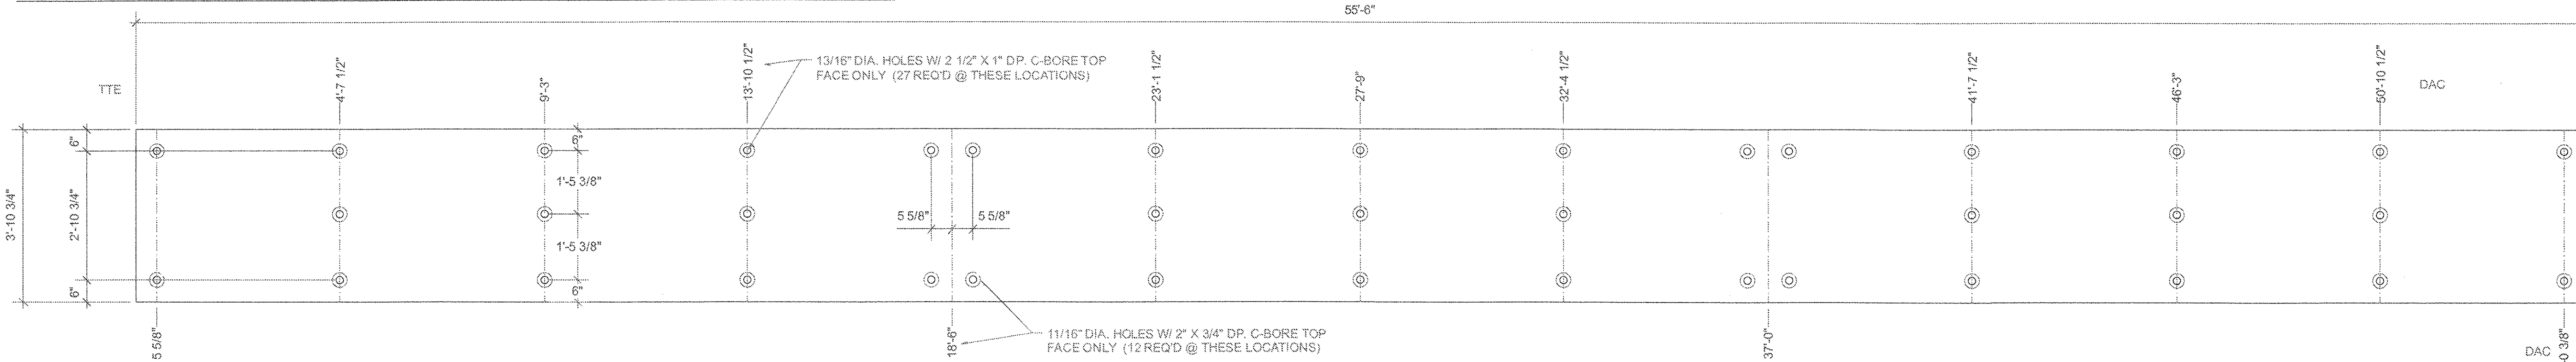

MK-F6 8 1/2" X 46 3/4" X 55'-6" 1 REQ'D COMB. 50 APPROX. WT. = 6800#

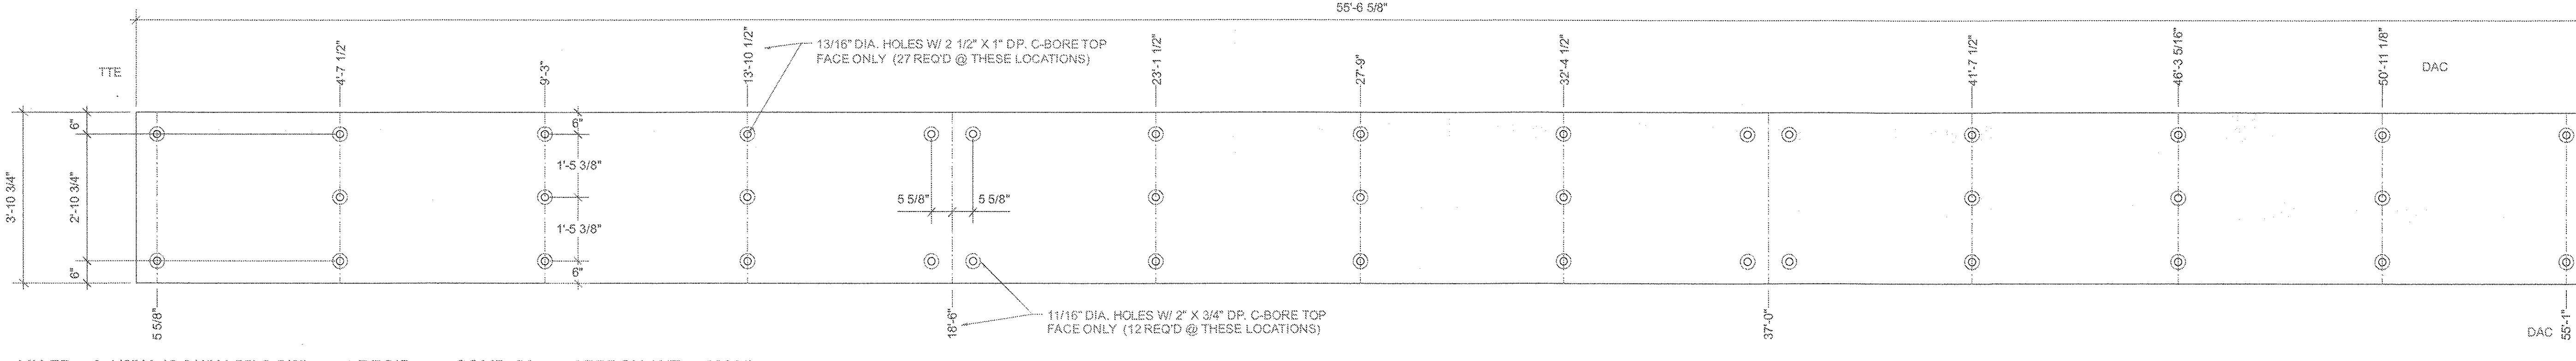


MK-F7 8 1/2" X 46 3/4" X 55'-6 5/8" 1 REQ'D COMB. 50 APPROX. WT. = 6800#

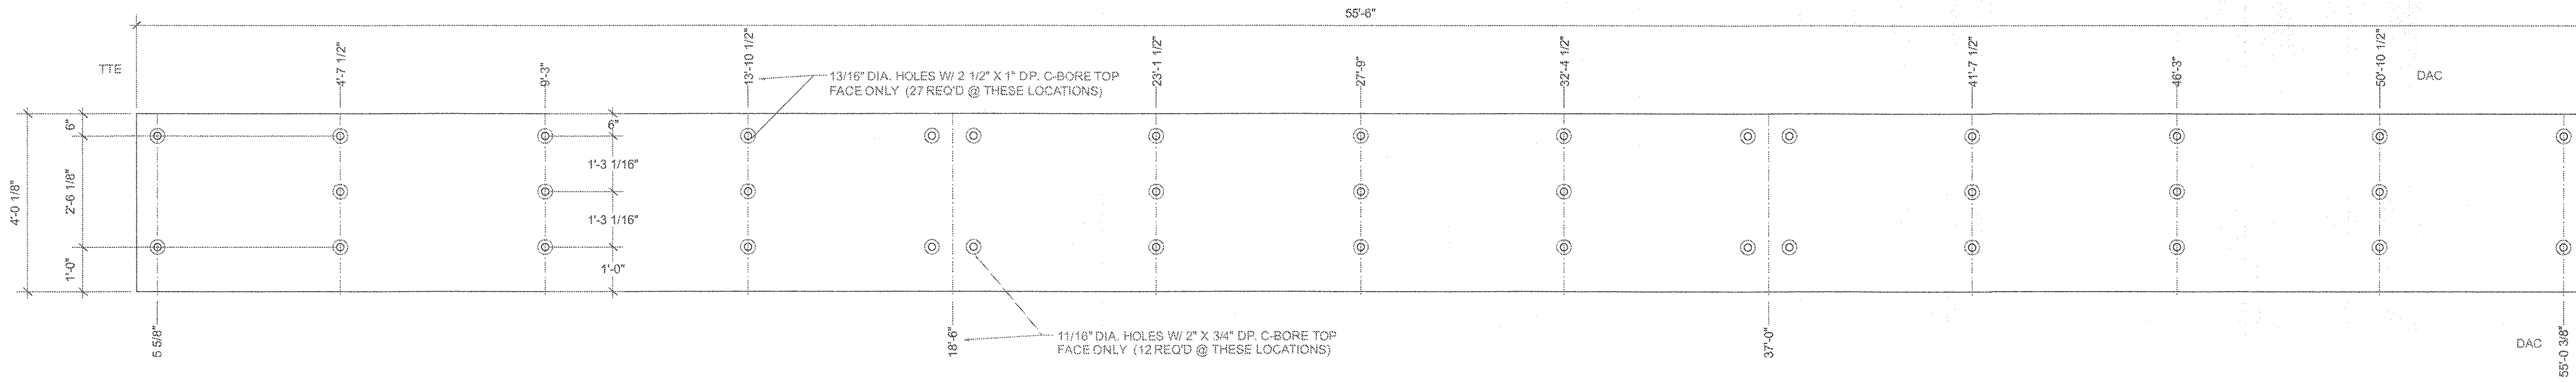

MK-F8 8 1/2" X 48 1/8" X 55'-6" 1 REQ'D COMB. 50 APPROX. WT. = 7150#

RECEIVED
 CK'D BY *ELK* OK'D BY *RSY*
 JUL 27 2007
 RESUBMIT _____ APPROVED _____
 BY *CPW* DATE 7/31/07

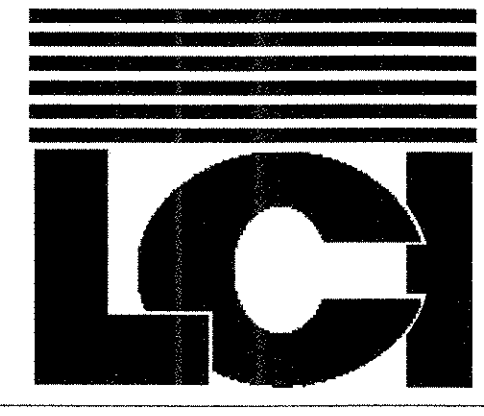

P. O. BOX 369
 3310 STATE RTE 352
 BIG FLATS, NEW YORK 14814
 PHONE: 607.562.8110
 FAX: 607.562.8105

DRAWN	DATE	REVISIONS			
		NO.	DATE	BY	REVISIONS
MSS	6/4/07				
CHKD		1	7/17/07	ss	revise panels
APPD		2	7/24/07	ss	revise panels
SCALE					

PROJECT NAME	BHO-BTN 2005 (1) BRIDGE NO. 26 TOWNS OF NEW HAVEN AND WEYBRIDGE COUNTY OF ADDISON, VERMONT	PROJECT JOB NO.	2107-150-LT
PREPARED FOR	CCS CONSTRUCTORS, LLC MORRISVILLE, VT	SHEET NO.	3 OF 4

LAMINATED CONCEPTS INC.

068-6D