




MK-F2 8 1/2" X 46 3/4" X 37-5 5/8" 1 REQ'D COMB. 50 APPROX. WT. = 4590#

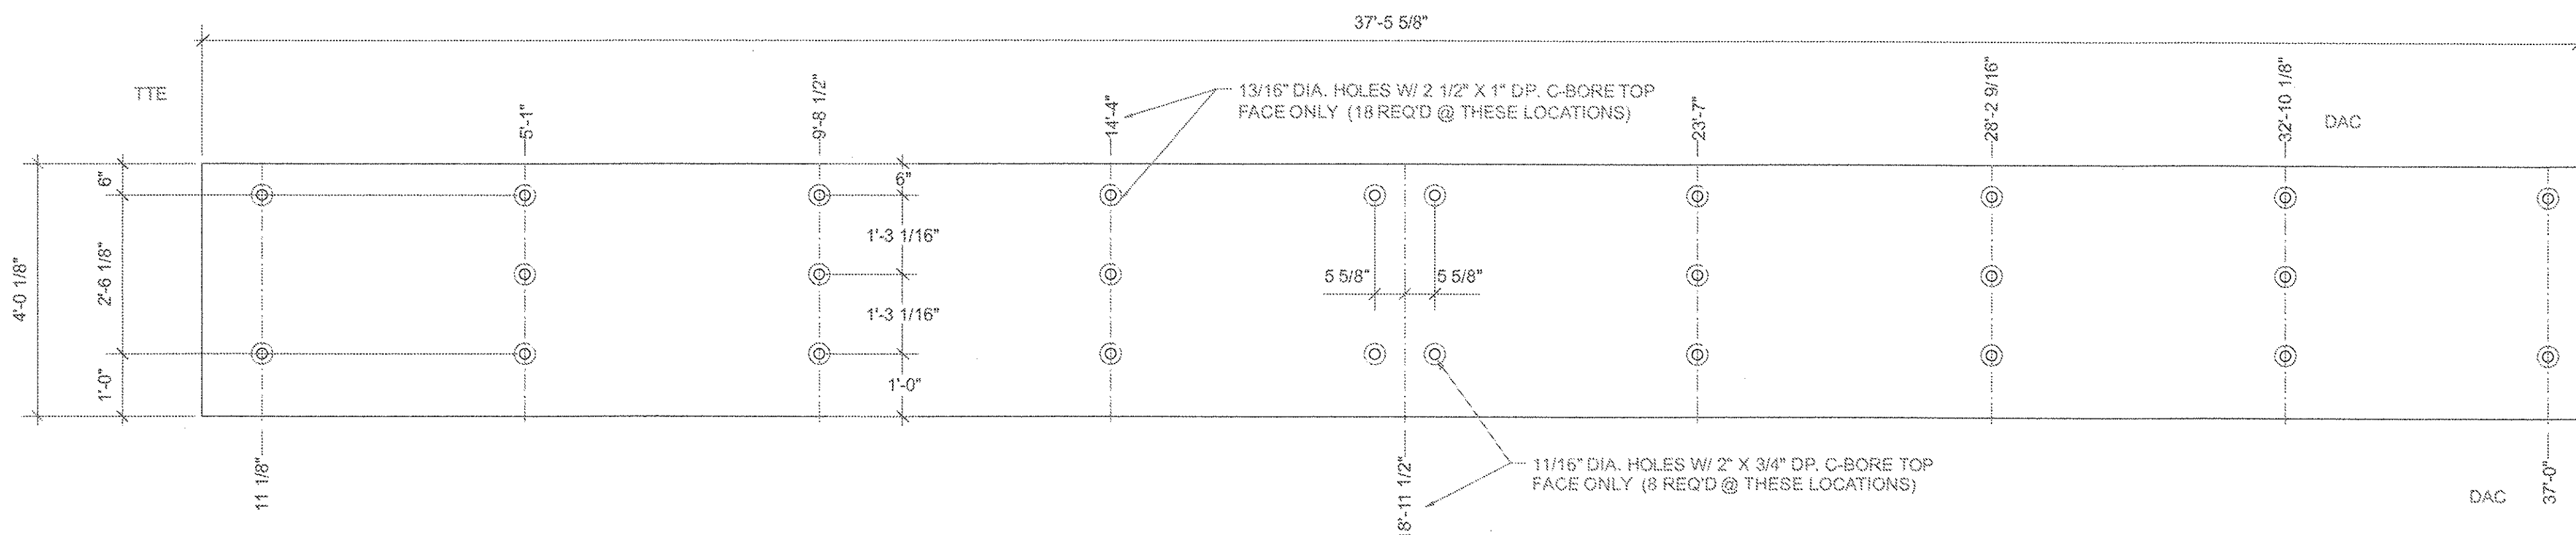


MK-F4 8 1/2" X 48 1/8" X 37-5 5/8" 1 REQ'D COMB. 50 APPROX. WT. = 4830#

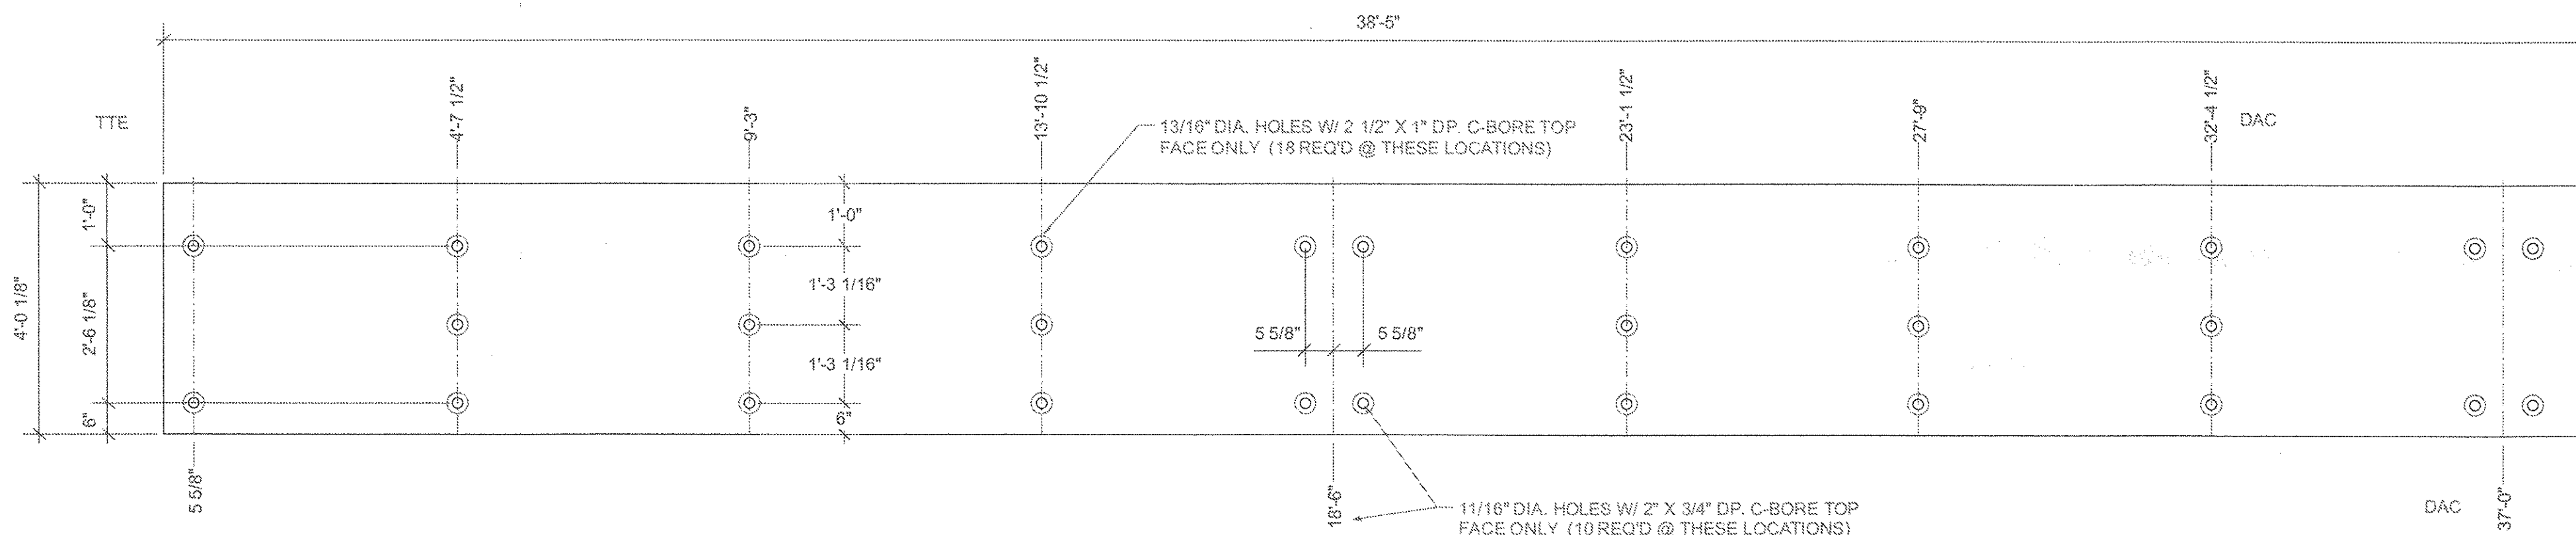

MK-F9 8 1/2" X 49 1/8" X 38'-5" 1 REQ'D COMB. 50 APPROX. WT. = 4830#

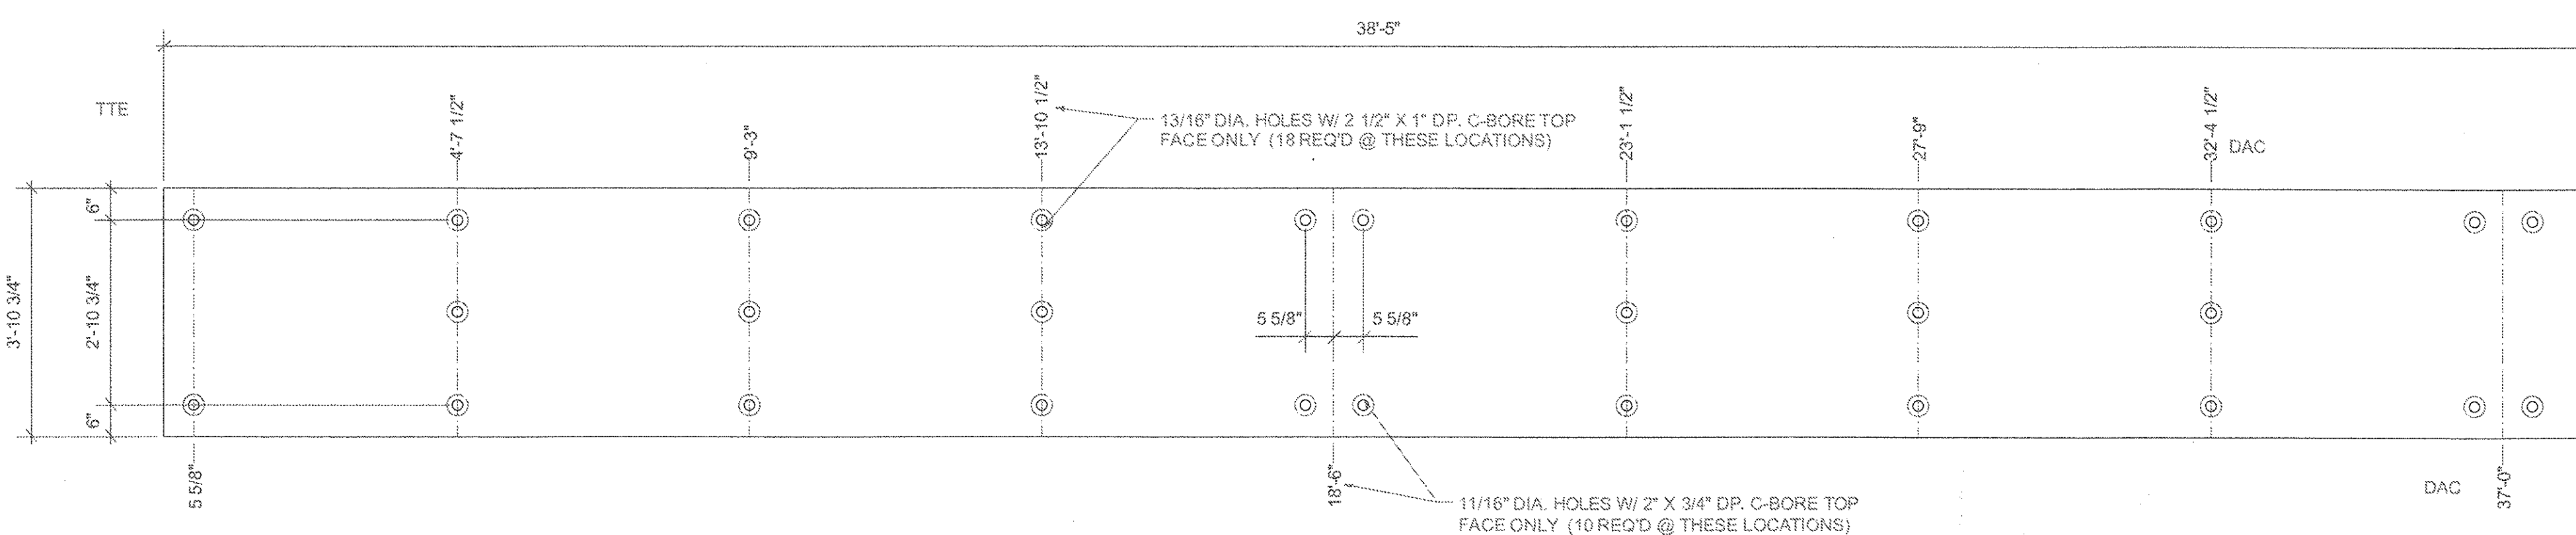

MK-F11 8 1/2" X 46 3/4" X 38'-5" 1 REQ'D COMB. 50 APPROX. WT. = 4600#

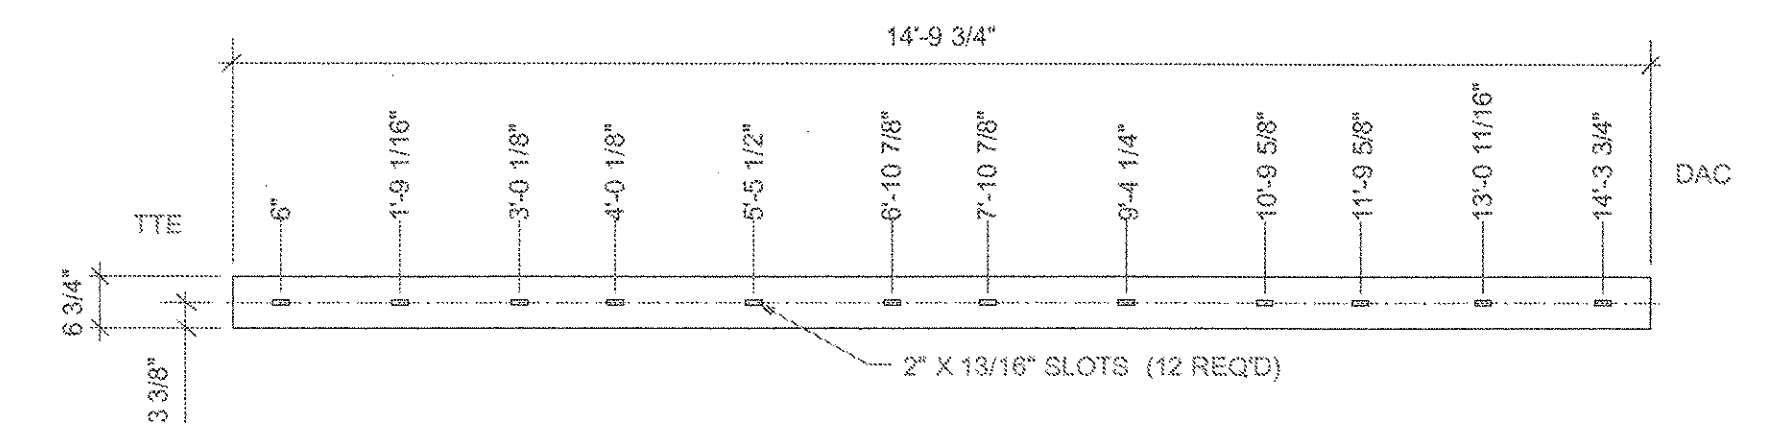

MK-ST1 6 3/4" X 5 1/2" X 14'-9 3/4" 24 REQ'D COMB. 50 APPROX. WT. = 172#

RECEIVED
 OK'D BY *EK* OK'D BY *RSY*
 JUL 27 2007
 RESUBMIT _____ APPROVED _____
 BY *CPW* DATE 7/31/07



LAMINATED CONCEPTS INC.

P.O. BOX 369
 3310 STATE RTE 352
 BIG FLATS, NEW YORK 14814
 PHONE: 607.562.8110
 FAX: 607.562.8105

DRAWN	DATE	REVISIONS			
		NO.	DATE	BY	REVISIONS
MSS	6/4/07				
CHKD	DATE	1	7/17/07	ss	revise panels
APPD	DATE	2	7/24/07	ss	revise panels
SCALE					

PROJECT NAME	BHO-BTN 2005 (1) BRIDGE NO. 26 TOWNS OF NEW HAVEN AND WEYBRIDGE COUNTY OF ADDISON, VERMONT	PROJECT JOB NO.	2107-150-LT
PREPARED FOR	CCS CONSTRUCTORS, LLC MORRISVILLE, VT	SHEET NO.	4 OF 4

0696D