


**INDEX OF SHEETS**

1. TITLE SHEET
2. PRELIMINARY INFORMATION
3. QUANTITY SHEET 1
4. QUANTITY SHEET 2
5. TIE SHEET
6. LAYOUT SHEET 1
7. LAYOUT SHEET 2
8. LAYOUT SHEET 3
9. PROFILE SHEET
10. TRAFFIC CONTROL
11. PLAN AND ELEVATION SHEET
12. GENERAL NOTES
13. DECK DETAILS SHEET 1
14. DECK DETAILS SHEET 2
15. TRUSS DETAILS
16. PLATE AND FLOOR BEAM DETAILS
17. GUSSET DETAILS
18. FLOOR BEAM CONNECTION DETAILS
19. FRAMING PLAN & CONNECTION DETAILS
20. LATERAL BRACING DETAILS
21. BEARING DETAILS
22. BEARING NOTES / MISC. DETAILS
23. EXPANSION JOINT DETAILS
24. EXPANSION JOINT PLAN
25. DOWN SPOUT DETAILS
26. ABUTMENT #1 DETAILS
27. ABUTMENT #2 DETAILS
28. BRIDGE RAIL DETAILS
29. LATTICE RAIL DETAILS
30. APPROACH RAIL DETAILS
31. TRAFFIC SIGN SHEET
32. TRAFFIC SIGN SUMMARY SHEET
33. R. O. W. PLAN
34. R. O. W. DETAILS
35. REINFORCING STEEL SCHEDULE
36. MAINLINE CROSS SECTIONS
37. MAINLINE CROSS SECTIONS
38. MAINLINE CROSS SECTIONS
39. MAINLINE CROSS SECTIONS
40. CHANNEL CROSS SECTIONS
41. CHANNEL CROSS SECTIONS
42. CHANNEL CROSS SECTIONS
43. CHANNEL CROSS SECTIONS
44. CHANNEL CROSS SECTIONS
45. CHANNEL CROSS SECTIONS
46. EROSION NARRATIVE
47. EROSION NOTES
48. EXISTING CONDITIONS
49. EROSION PREVENTION AND SEDIMENT CONTROL PLAN
50. FINAL CONDITIONS
51. EPSC1 (SILT FENCE)
52. EPSC5 (DITCH AND SLOPE PROTECTION)
53. EPSC7 (FILTER CURTAIN)

**LIST OF STANDARDS**

B-5	6/1/94
B-71	7/8/05
E-100	1/2/04
E-101	5/30/03
E-102	6/30/03
E-102A	5/1/04
E-107	6/30/03
E-107A	8/8/95
E-120	8/8/95
E-121	8/8/95
E-124	8/8/95
E-142	9/20/95
E-152	5/1/04
E-155	5/1/04
E-160	5/20/99
E-164	5/20/99
G-1	1/3/2000
G-1d	1/3/2000

# STATE OF VERMONT AGENCY OF TRANSPORTATION

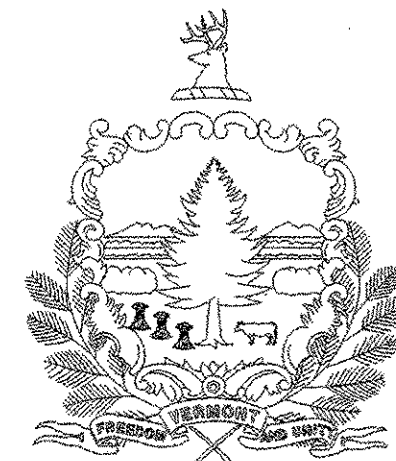

## PROPOSED IMPROVEMENT




TOWNS OF NEW HAVEN & WEYBRIDGE  
COUNTY OF ADDISON

ROUTE NO : TH 7/11, CL 3 BRIDGE NO : 26

PROJECT LOCATION : LOCATED IN THE COUNTY OF ADDISON, TOWN OF NEW HAVEN & WEYBRIDGE, ON TH 7/11,  
BR 26 OVER THE OTTER CREEK, AT THE NEW HAVEN - WEYBRIDGE TOWN LINE.

PROJECT DESCRIPTION : THE PROJECT CONSISTS OF REHABILITATING THE EXISTING STRUCTURE  
INCLUDING ONE NEW ABUTMENT WITH RELATED CHANNEL AND APPROACH WORK.

LENGTH OF STRUCTURE :	151.42 FEET
LENGTH OF ROADWAY :	3.58 FEET
LENGTH OF PROJECT :	155.00 FEET

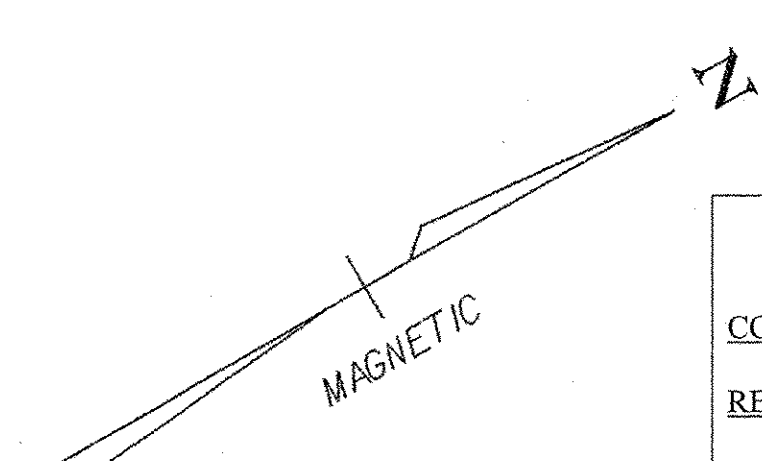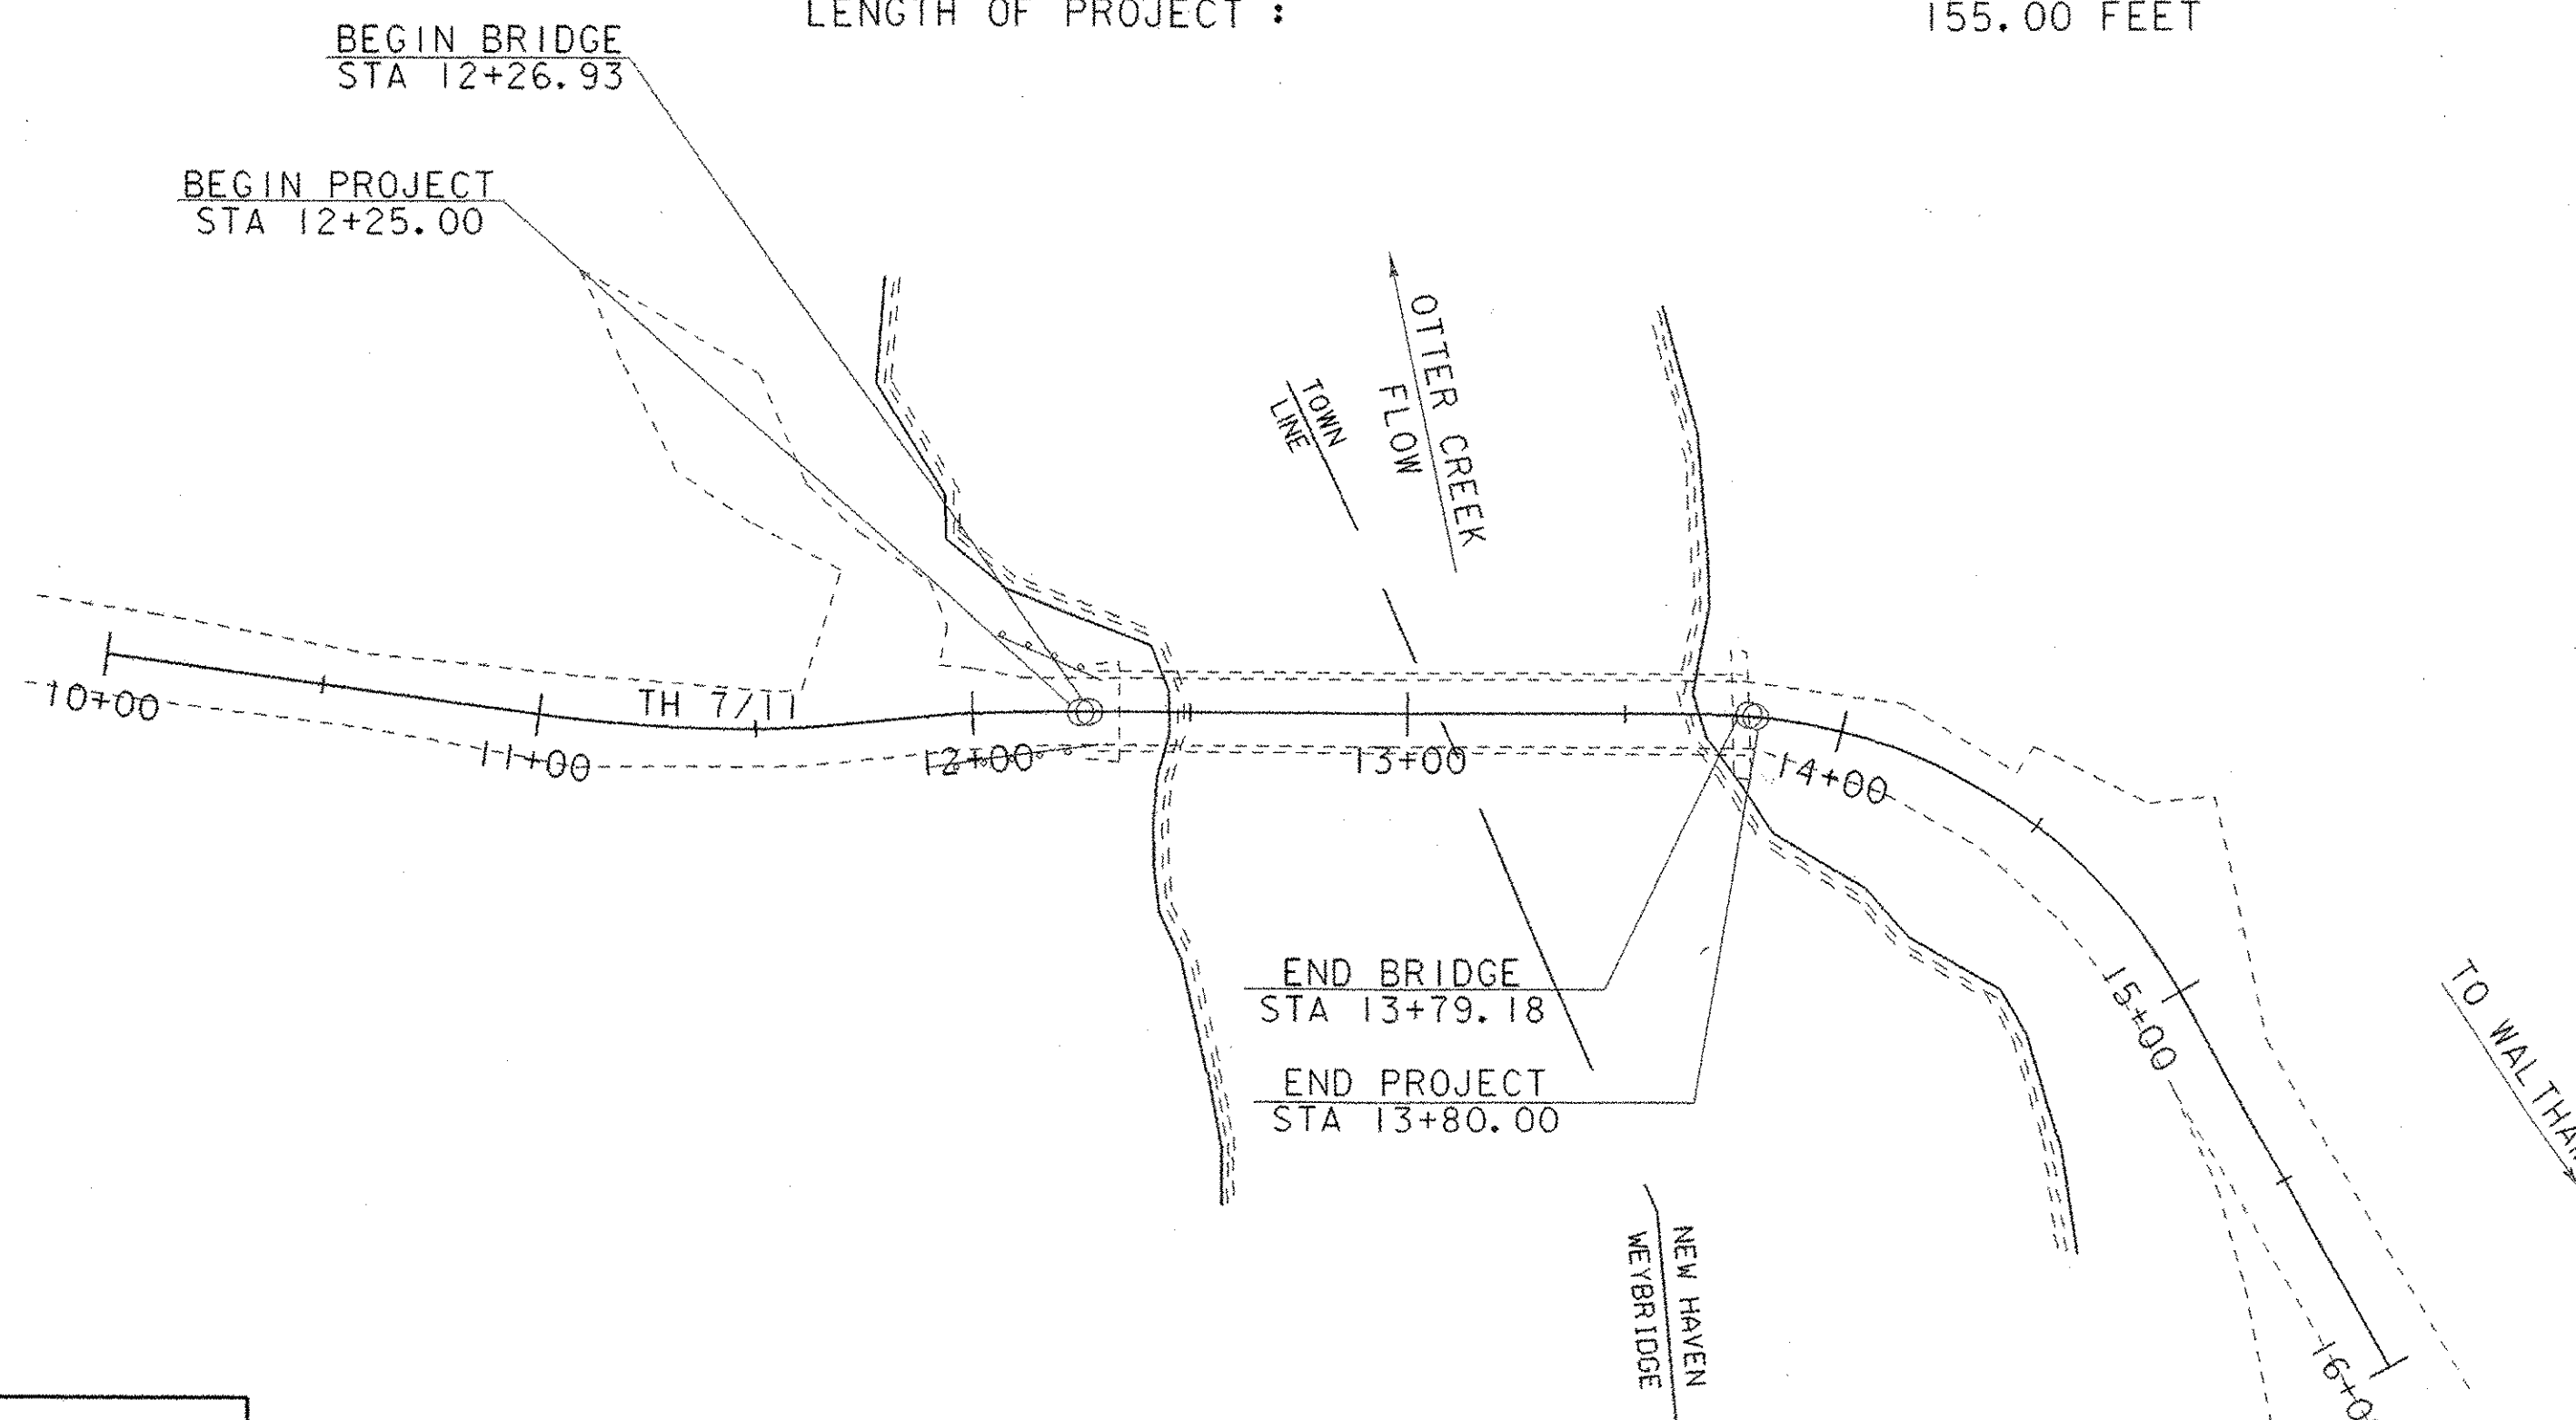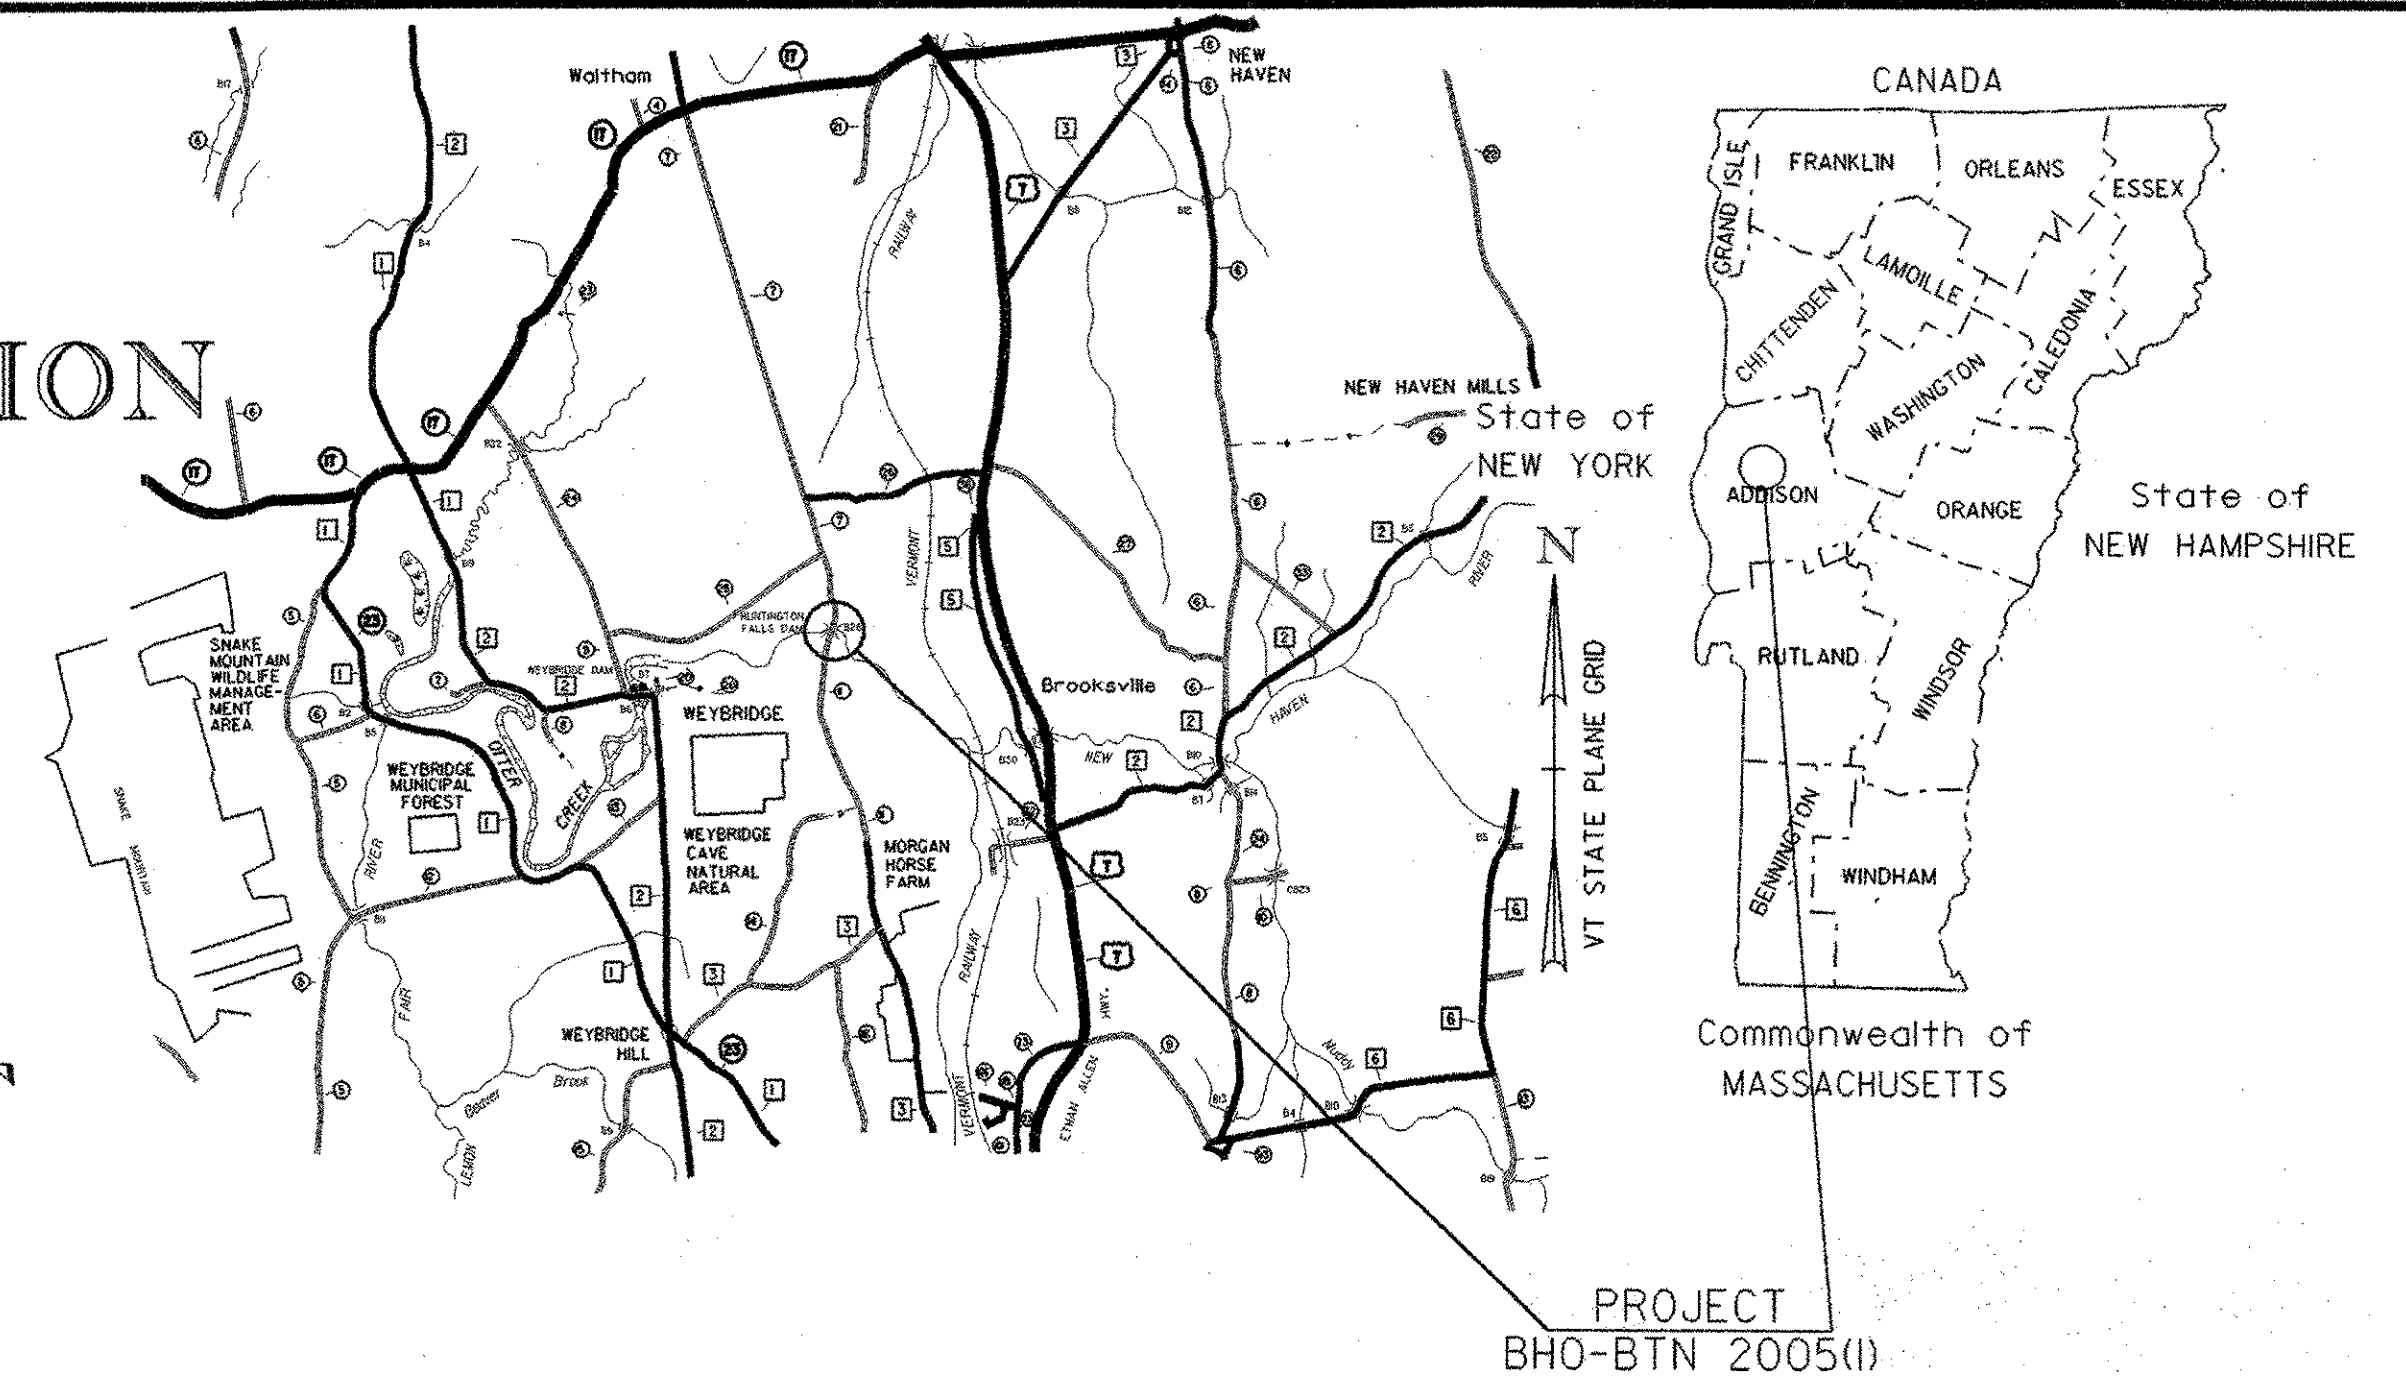


<b>RECORD PLANS</b>	
CONTRACTOR:	CCS CONSTRUCTORS LLC - MORRISVILLE, VT
RESIDENT ENGINEER:	DALE NORTON
CONSTRUCTION BEGAN:	MAY 17, 2007
CONSTRUCTION COMPLETE:	SEPTEMBER 18, 2008
RECORD PLANS BY:	DALE NORTON & BEN LOGAN
I HEREBY CERTIFY THAT ALL THE CONSTRUCTION REQUIRED BY THIS SET OF DRAWINGS HAS BEEN ACCOMPLISHED AS INDICATED HEREIN.	
BY	<i>Dale R. Norton</i> RESIDENT ENGINEER
DATE	6/3/2009
NOTE: Any further information concerning final quantities, amounts or other details relative to this project may be found at Central Files in the electronic archives.	

CONVENTIONAL SYMBOLS	
COUNTY LINE	
TOWN LINE	
LIMITS OF ACCESS	
POINT OF ACCESS	
FENCE LINE	
STONE WALL	
TRAVELED WAY	
GUARD RAIL	
RAILROAD	
SURVEY LINE	
CULVERT	
POWER POLE	
TELEPHONE POLE	
TREES	
CONTROL OF ACCESS	
PROPERTY LINE	
R.O.W. TAKING LINE	
SLOPE RIGHTS	
TOP OF CUT	
TOE OF SLOPE	

SURVEYED BY : R. MOREAU  
SURVEYED DATE : 7/90


DATUM  
VERTICAL NGVD 1929  
HORIZONTAL ASSUMED

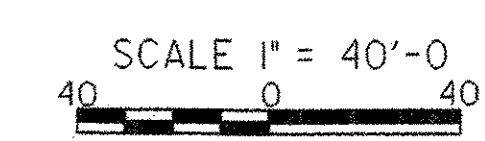

THESE PLANS ARE SUBJECT TO SUCH ENGINEERING CHANGES AS MAY BE REQUIRED BY THE FEDERAL HIGHWAY ADMINISTRATION OR THE DIRECTOR OF PROGRAM DEVELOPMENT.

CONSTRUCTION IS TO BE CARRIED ON IN ACCORDANCE WITH THESE PLANS AND THE STANDARD SPECIFICATIONS FOR CONSTRUCTION DATED 2006, AS APPROVED BY THE FEDERAL HIGHWAY ADMINISTRATION ON JUNE 15, 2006 FOR USE ON THIS PROJECT, INCLUDING ALL SUBSEQUENT REVISIONS AND SUCH REVISED SPECIFICATIONS AND SPECIAL PROVISIONS AS ARE INCORPORATED IN THESE PLANS.


DIRECTOR OF PROGRAM DEVELOPMENT	
APPROVED <i>Richard J. Stearns</i>	DATE 1-30-07
PROJECT MANAGER : C. P. WILLIAMS	
PROJECT NAME : NEW HAVEN - WEYBRIDGE	
PROJECT NUMBER : BHO-BTN 2005 (1)	
SHEET 1 OF 53 SHEETS	

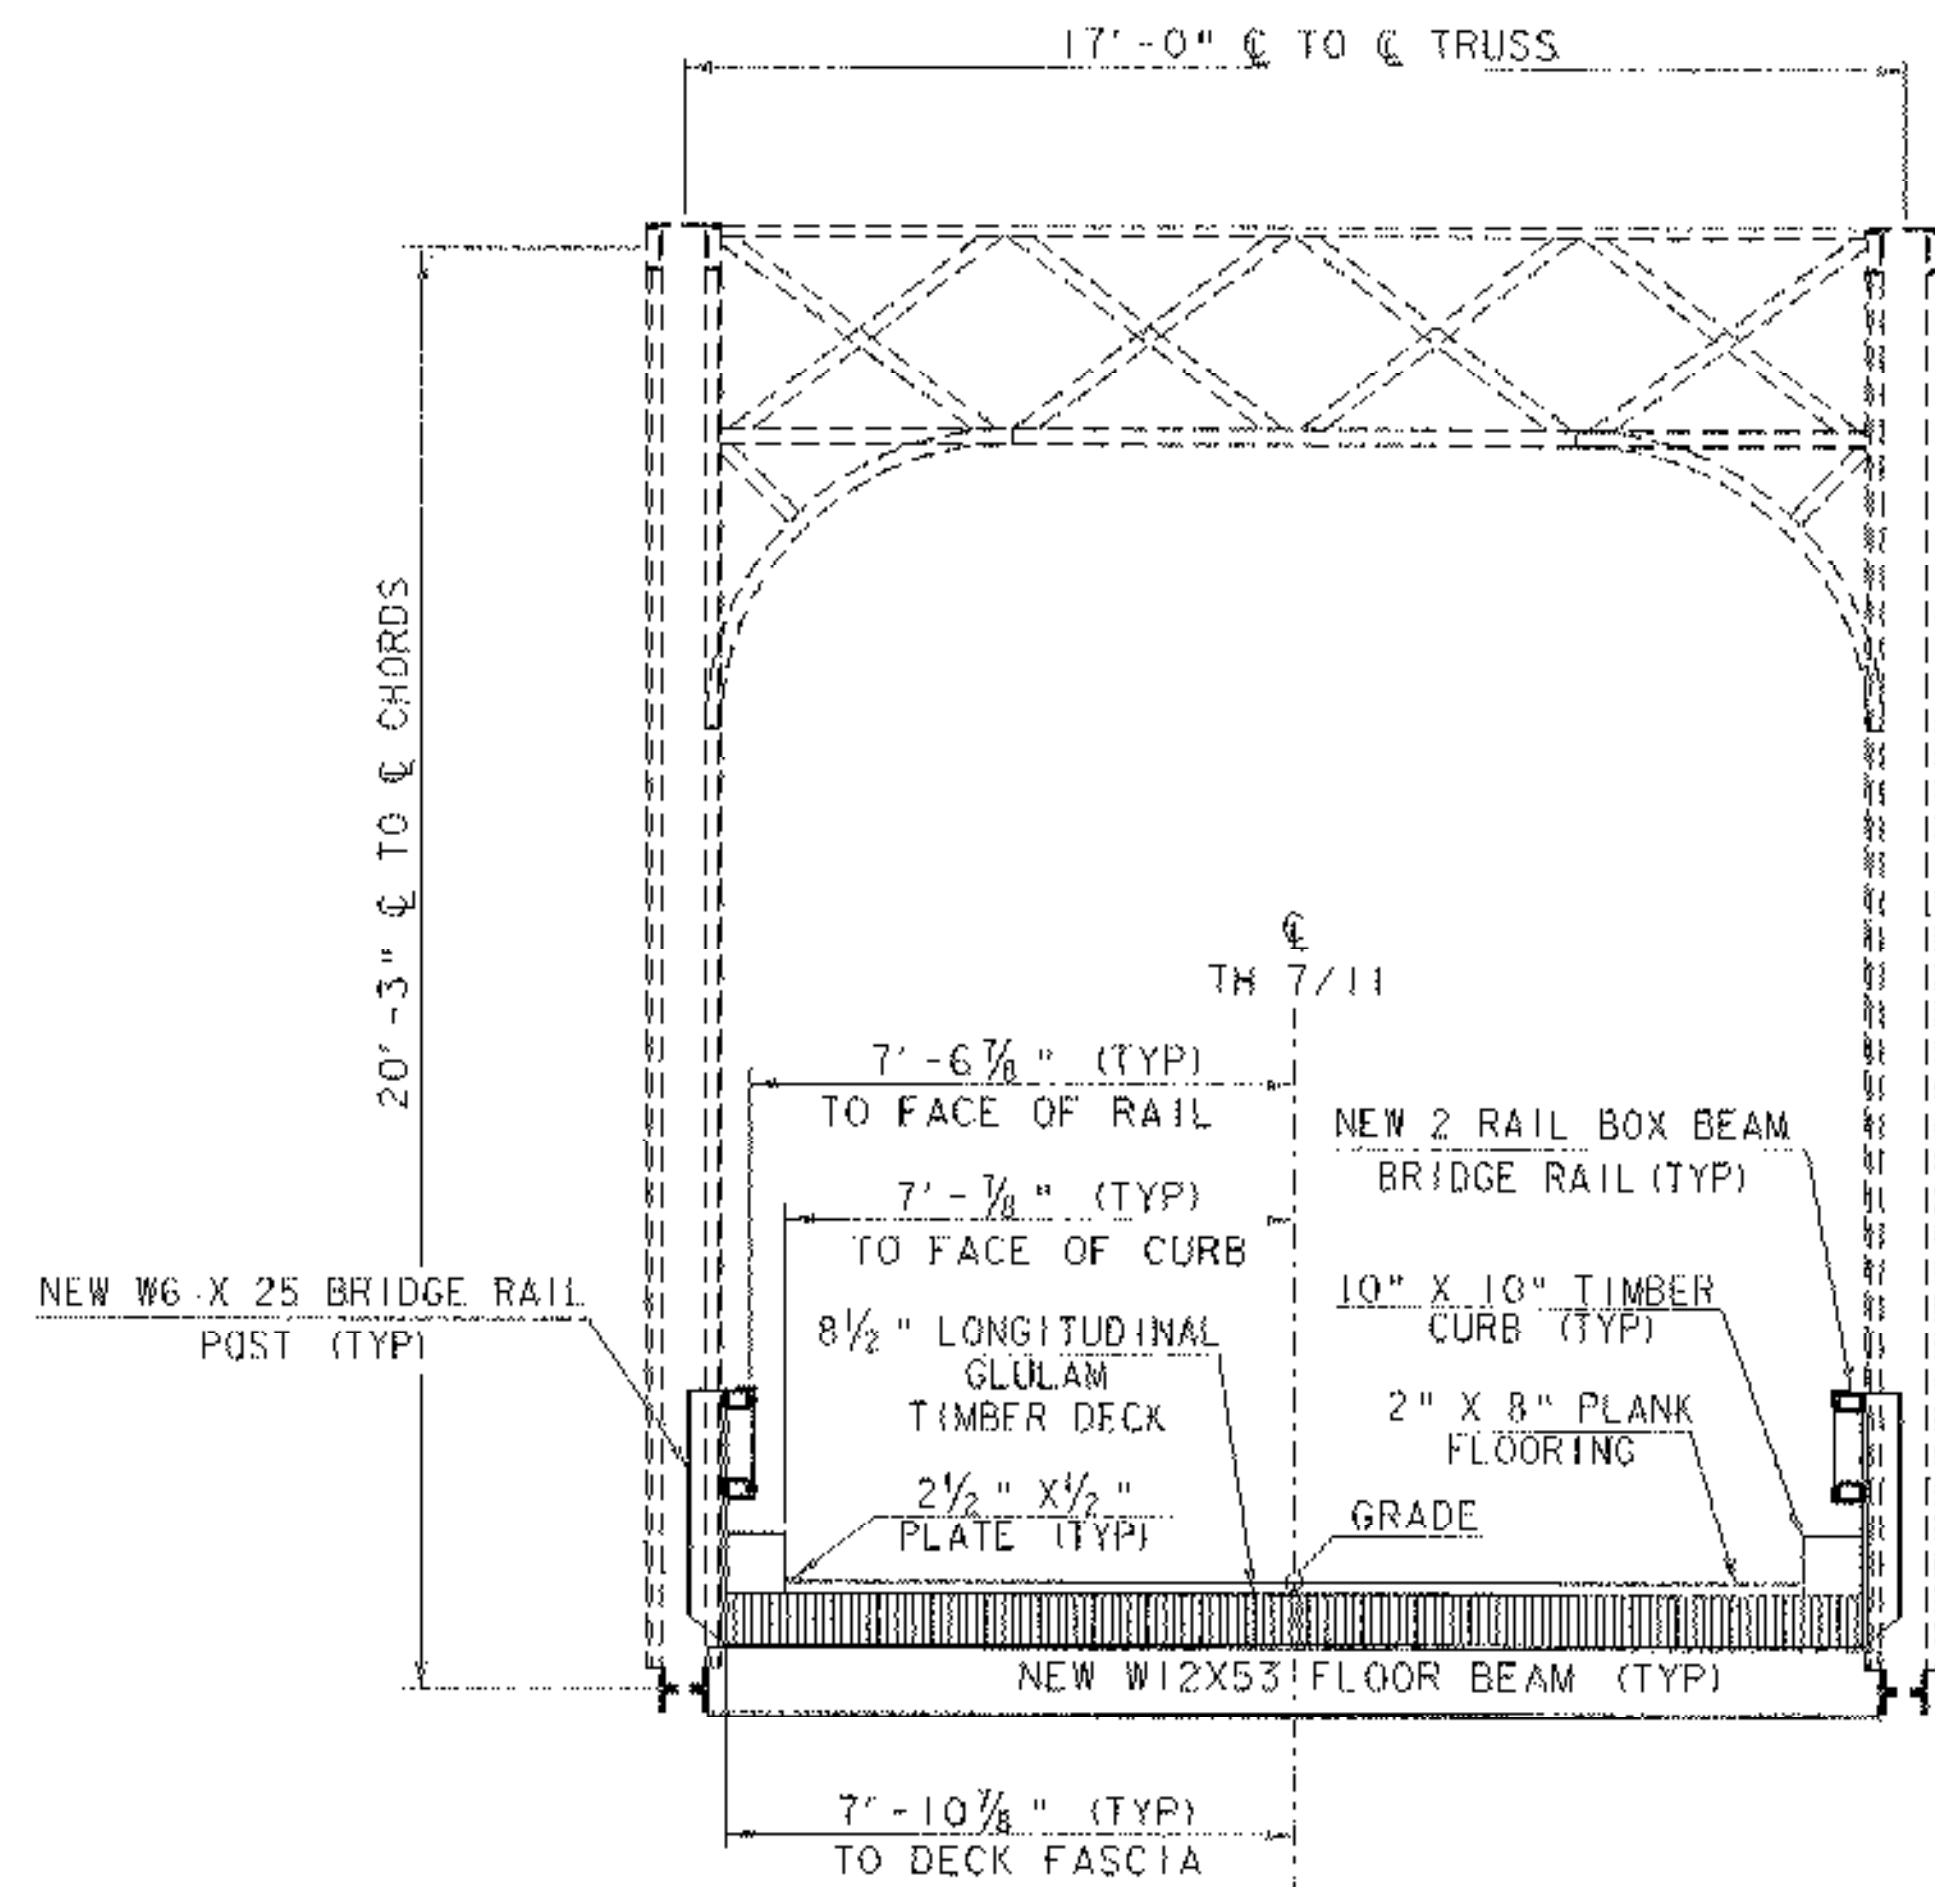

NOTE: THE TRANSVERSE DECKING WAS INSTALLED AS PER PLAN. SUBSEQUENT TO FINAL INSPECTION AND ACCEPTANCE, THE TRANSVERSE DECKING DETERIORATED TO THE POINT THE TOWNS CLOSED THE BRIDGE. THE AGENCY, USING DISTRICT FORCES, REDECKED THE ENTIRE DECK WITH DOUGLADS FIR 2X8 PLANKING, PLACED LONGITUDINALLY, AND SECURELY LAG BOLTED IN PLACE. THE "REDECKING" WAS DONE IN APRIL 2009.

TYPICAL BRIDGE SECTION

SCALE 3/8" = 1'-0"  
0 1 2 3 4

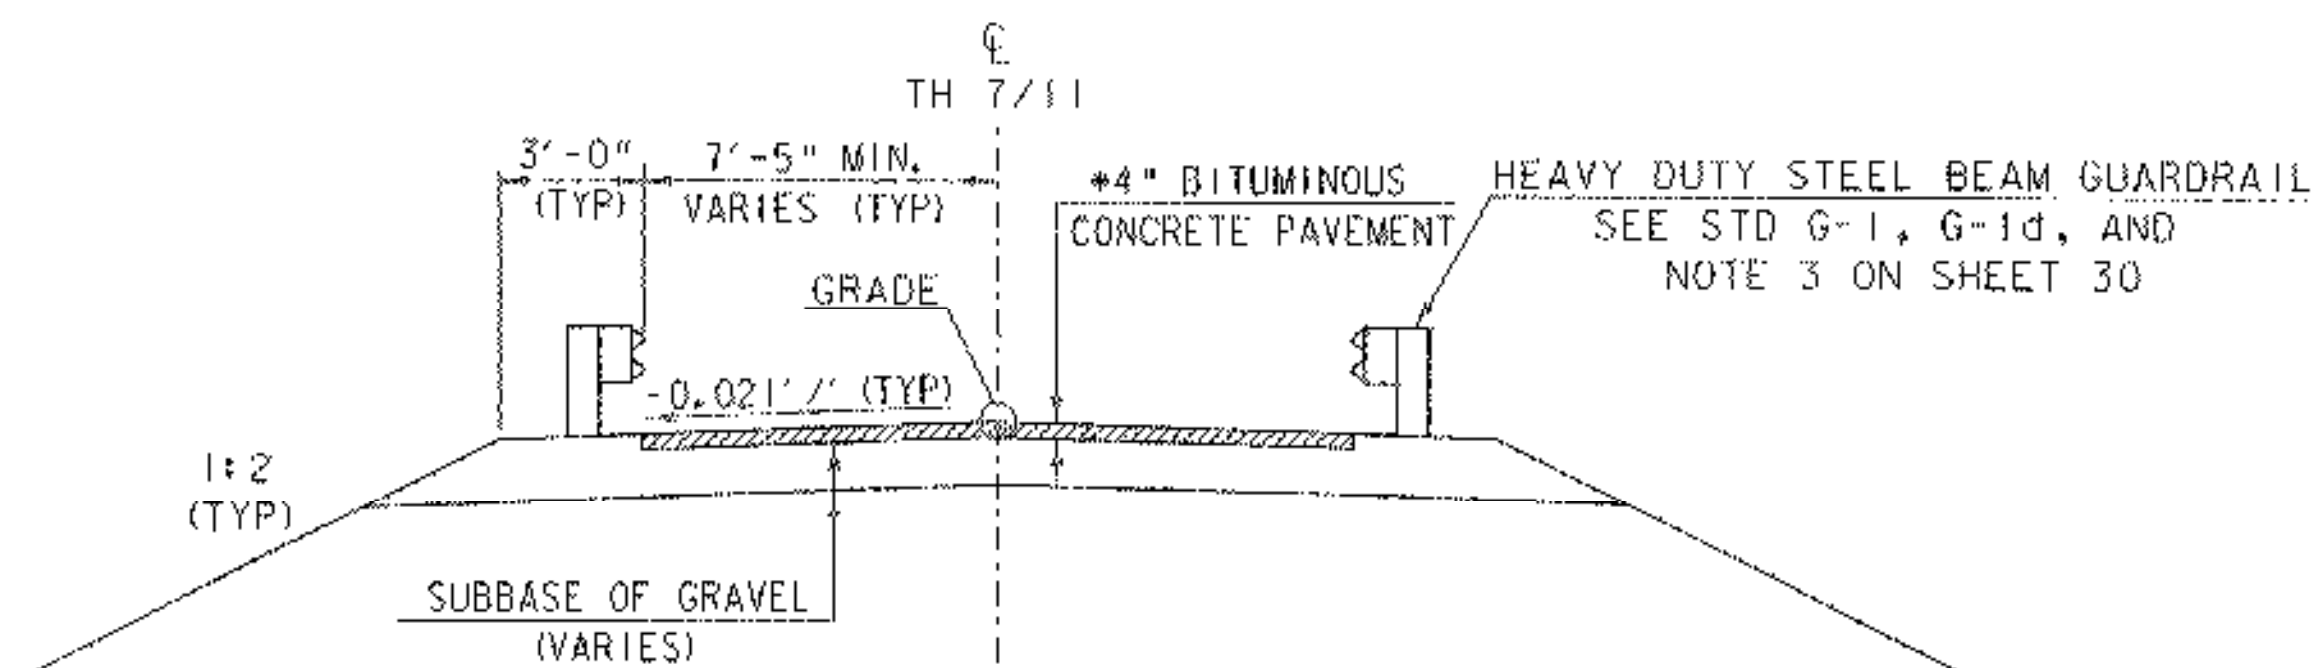

ROADWAY TYPICAL

SCALE 1/4" = 1'-0"  
0 2 4 6

#1 1/2" TYPE III OVER  
2 1/2" TYPE I

MATERIAL ITEM	TOLERANCE
PAVEMENT	± 1/4" TOTAL THICKNESS
BASE COURSE	± 1/2"
SUBBASE	± 1"

FINAL HYDRAULICS REPORT

HYDROLOGIC DATA

DRAINAGE AREA: 748 sq. mi.  
 CHARACTER OF TERRAIN: Rolling hills  
 CHARACTER & TYPE OF STREAM: Stream, semi-artificial, probably incised, not bridged or unbridged  
 NATURE OF STREAMBED: Sand, gravel, cobbles, and ledge  
 02.33= 5,000 cfs      050= 10,850 cfs  
 010= 8,000 cfs      0100= 12,200 cfs  
 025= 8,650 cfs      0500= 15,500 cfs  
 DATE OF FLOOD OF RECORD: November, 1927  
 WATER SURFACE ELEV. @ 224.5+ ESTIMATED DISCHARGE: 18,800 cfs  
 NATURAL STREAM VELOCITY @ 025 = 6.4 fps  
 ICE CONDITIONS: Moderate      DERRIS: Slight  
 DOES THE STREAM REACH MAXIMUM HIGHWATER ELEVATION RAPIDLY? No  
 IS ORDINARY RISE RAPID? No  
 IS STAGE AFFECTED BY UPSTREAM OR DOWNSTREAM CONDITIONS? Yes  
 IF YES, DESCRIBE: Huntington Falls Dam is about 350 ft. downstream.  
 WATERSHED STORAGE: N.A. HEADWATERS: UNIFORM THROUGHOUT WATERSHED IMMEDIATELY ABOVE SITE

EXISTING STRUCTURE

STRUCTURE TYPE: Single span steel truss bridge      YEAR BUILT: 1908  
 CLEAR SPAN (NORMAL TO STREAM): 140 ft.  
 VERTICAL CLEARANCE ABOVE STREAMBED: 22 ft.  
 WATERWAY OF FULL OPENING: 2,350 sq. ft.  
 DISPOSITION OF STRUCTURE: Rehabilitation  
 TYPE OF MATERIAL UNDER SUBSTRUCTURE: Asphalt # 1 on ledge, # 2 on piling  
 WATER SURFACE ELEV. @ 02.33= 218.7      VELOCITY= 3.3 fps  
 010= 213.9      "      4.8 fps  
 025= 220.7      "      5.4 fps  
 050= 221.1      "      5.9 fps  
 0100= 221.7      "      6.3 fps  
 LONG TERM STREAM BED CHANGES: None noted.  
 Controlled by the downstream dam.  
 IS THE ROADWAY OVERTOPPED BELOW THE 0100? No      FREQUENCY:  
 RELIEF ELEVATION: 226.3      DISCHARGE OVER ROAD @ 0100: 0  
 UPSTREAM STRUCTURE: Town Middlebury Weyr.      DISTANCE: 3.8 miles  
 HIGHWAY NO.: T.H. 5 & T.H. 3      STRUCTURE NO.: 1  
 STRUCTURE TYPE: Covered Bridge  
 CLEAR SPAN: 171 ft.      CLEAR HEIGHT: 20 ft.  
 YEAR BUILT: 1830      FULL WATERWAY: N.A.  
 DOWNSTREAM STRUCTURE: Town Weybridge      DISTANCE: 1.3 miles  
 HIGHWAY NO.: T.H. 2      STRUCTURE NO.: 6  
 STRUCTURE TYPE: Two span steel beam bridge  
 CLEAR SPAN: 118 ft.      CLEAR HEIGHT: 22 ft.  
 YEAR BUILT: 1971      FULL WATERWAY: N.A.

PROPOSED STRUCTURE

STRUCTURE TYPE: Rehabilitate existing single span steel truss bridge.  
 CLEAR SPAN (NORMAL TO STREAM): 140 ft.  
 VERTICAL CLEARANCE ABOVE STREAMBED: 23 ft.  
 WATERWAY OF FULL OPENING: 2,500 sq. ft.  
 WATER SURFACE ELEV. @ 02.33= 218.7      VELOCITY= 3.3 fps  
 010= 213.9      "      4.8 fps  
 025= 220.7      "      5.4 fps  
 050= 221.1      "      5.9 fps  
 0100= 221.7      "      6.3 fps  
 IS THE ROADWAY OVERTOPPED BELOW THE 0100? No      FREQUENCY:  
 RELIEF ELEVATION: 226.5      DISCHARGE OVER ROAD @ 0100: 0  
 AVERAGE LOW ELEVATION OF SUPERSTRUCTURE: 225.5  
 VERTICAL CLEARANCE @ 0100 = 3.8 ft.  
 SCOUR: Contractions scour = 8 ft. @ 0100 & 9 ft. @ 0500.  
 REQUIRED CHANNEL PROTECTION: Stone Fill, Type III

PERMIT INFORMATION

AVERAGE DAILY FLOW: 1,880 cfs  
 ORDINARY LOW WATER: 670 cfs      ELEV.: 216.0  
 ORDINARY HIGH WATER: 2,150 cfs      ELEV.: 218.0

ADDITIONAL COMMENTS

\* The scour depths listed are based on free flow (live bed contraction scour). The operation of the downstream dam could affect scour depths at the bridge. The presence of ledge would limit the scour depth. The existing bridge has been in place since 1908, with no known scour related problems.

DESIGN CRITERIA

- DESIGN LIVE LOAD AASHTO: H-20
- DESIGN SPAN: 140'-0" C-C BEARING
- ALLOWABLE LOAD FOR SPREAD FOOTINGS ON SOIL: N/A ON LEDGE: 10 ksf
- ALLOWABLE LOAD FOR PILING: N/A ESTIMATED LENGTH: N/A
- STRUCTURAL STEEL AASHTO GRADE: A572 GR. 50
- REINFORCING STEEL GRADE: 60
- CONCRETE, HIGH PERFORMANCE CLASS A: f'c: 4000 PSI
- CONCRETE, HIGH PERFORMANCE CLASS B: f'c: 3500 PSI

TRAFFIC MAINTENANCE

- IS TRAFFIC TO BE MAINTAINED? NO      IF YES, ON EXISTING STRUCTURE: N/A OR ON TEMPORARY BRIDGE: N/A
- TEMPORARY BRIDGE REQUIREMENTS: ONE OR TWO WAY: N/A      TRAFFIC CONTROL SIGNALS REQUIRED: N/A  
 MINIMUM CLEAR SPAN (NORMAL TO STREAM): N/A      VERTICAL CLEARANCE ABOVE STREAMBED: N/A  
 WATERWAY OF FULL OPENING: N/A  
 ARE SIDEWALKS REQUIRED? N/A      IF SO, ON WHAT SIDE? N/A  
 STRUCTURE TYPE: Not required. The road will be closed.

LOAD FACTOR LOAD RATING (TONS)

LOADING LEVELS (LOAD FACTOR)	TRUCK						
	B	HS	3S2	6 AXLE	3A STR.	4A STR.	5A SEMI
INVENTORY A=2.17 B=1.00	16	23					
POSTED A=1.55 B=1.40	22	32	34		25	27	33
OPERATING A=1.30 B=1.67		38	40	34	30	32	

STATE OF VERMONT  
AGENCY OF TRANSPORTATION

Town of: NEW HAVEN-WEYBRIDGE      Bridge No.: 26  
 Highway No.: TH 7/TH 11      Log Sta.:  
 Surv. Sta.:

TH 7/TH 11 OVER OTTER CREEK

PRELIMINARY INFORMATION

Designed By: W.B. SYMONDS      Drawn By: W.B. SYMONDS  
 Checked By: P.G. JARVIS      Date: 4/98      Bridge Design Supervisor: C.P. WILLIAMS      Date: 4/98

PROJECT: NEW HAVEN-WEYBRIDGE      PROJECT NO.: BHO-BTN 2005 (1)

LOG. INFO: /str4/89j0812s081p1.dgn      PI 01170      28-FEB-2007

Bridge Sheet No.: sj081p1.i      Sheet 2 of 53

18 kip ESAL for flexible pavement from 1992 to 2012: <80,000  
 18 kip ESAL for flexible pavement from — to —: N/A  
 Design speed: 35 mph

YEAR	TRAFFIC DATA				
	ADT	DHV	% D	% T	% ADTT
1992	200	30		<1	
2012	270	35	57	<1	


# QUANTITY SHEET

SUMMARY OF ESTIMATED QUANTITIES										TOTALS		DESCRIPTIONS				DETAILED SUMMARY OF QUANTITIES		
SUPERSTR.	ABUT. #1	ABUT. #2				ROADWAY	EROSION CONTROL	BRIDGE	FULL C.C. ITEMS	GRAND TOTAL	FINAL	UNIT	ITEMS	ITEM NUMBER	ROUND	QUANTITIES	UNIT	ITEMS
						1				1		LS	CLEARING AND GRUBBING, INCLUDING INDIVIDUAL TREES AND STUMPS	201.10				
						235				235		CY	COMMON EXCAVATION	203.15				
	220							220		220		CY	UNCLASSIFIED CHANNEL EXCAVATION	203.27				
							10			10		CY	TRENCH EXCAVATION OF EARTH	204.20				
	50							50		50		CY	STRUCTURE EXCAVATION	204.25				
	15							15		15		CY	GRANULAR BACKFILL FOR STRUCTURES	204.30				
						200	20			310		CY	SUBBASE OF GRAVEL	301.15				
						2				2		CWT	EMULSIFIED ASPHALT	404.65				
						66				66		TON	BITUMINOUS CONCRETE PAVEMENT (PG58-34) CHANGED TO PG 58-28 BY CO #3	406.25				
	29	11						40		40		CY	CONCRETE, HIGH PERFORMANCE CLASS B	501.34				
1								1		1		LS	SHORING SUPERSTRUCTURE	502.10				
14292								14292		14292		LB	STRUCTURAL STEEL, ROLLED BEAM	506.50				
4480								4480		4480		LB	STRUCTURAL STEEL	506.60				
	1492	1088						2581		2581		LB	REINFORCING STEEL	507.15				
	36	32						68		68		LF	DRILLING AND GROUTING DOWELS	507.18				
		1						1		1		LS	SHEAR CONNECTORS (10 - 7/8" X 7")	508.15				
1								1		1		LS	STRUCTURAL PAINTING, SHOP APPLIED (7.7 Tons)	513.25				
1								1		1		LS	STRUCTURAL PAINTING, FIELD APPLIED (19.5 Tons)	513.30				
1								1		1		LS	CONTAINMENT & ENVIRONMENTAL PROTECTION, FIELD (19.5 Tons)	513.36				
1								1		1		LS	SURFACE PREPARATION, SHOP (7.7 Tons)	513.40				
1								1		1		LS	SURFACE PREPARATION, FIELD (19.5 Tons)	513.41				
16								16		16		LF	BRIDGE EXPANSION JOINT, VERMONT	516.11				
4.3								4.3		4.3		MFBM	NONSTRUCTURAL LUMBER, UNTREATED	522.30				
2.5								2.5		2.5		MFBM	NONSTRUCTURAL LUMBER, TREATED	522.35				
1								1		1		LS	STRUCTURAL GLUED LAMINATED TIMBER	522.40				
16								16		16		LF	JOINT SEALER, POLYURETHANE	524.21				
310								310		310		LF	BRIDGE RAILING, GALVANIZED 2 RAIL BOX BEAM	525.31				
1								1		1		EACH	PARTIAL REMOVAL OF STRUCTURE	529.20				
	2	2						4		4		EACH	BEARING DEVICE ASSEMBLY, PREFORMED FABRIC PAD	531.10				
							10			10		HR	ALL PURPOSE EXCAVATOR RENTAL, TYPE I	608.25				
						1				1		TON	DUST & ICE CONTROL WITH CALCIUM CHLORIDE	608.15				
							10			10		CY	STONE FILL, TYPE I	613.10				
240								240		240		CY	STONE FILL, TYPE III	613.12				
						180				180		LF	HD STEEL BEAM GUARDRAIL, GALVANIZED W/8 FEET POSTS	621.215				
						4				4		EACH	ANCHOR FOR STEEL BEAM RAIL	621.60				
						64				64		LF	REMOVAL AND DISPOSAL OF GUARDRAIL	621.80				
						40				40		LF	TEMPORARY TRAFFIC BARRIER	621.90				
									1	1		LS	FIELD OFFICE-ENGINEERS	631.10				
									1	1		LS	TESTING EQUIPMENT - CONCRETE	631.16				
									1	1		LS	TESTING EQUIPMENT - BITUMINOUS	631.17				


# QUANTITY SHEET

SUMMARY OF ESTIMATED QUANTITIES										TOTALS		DESCRIPTIONS			DETAILED SUMMARY OF QUANTITIES			
SUPERSTR	ABUT. #1	ABUT. #2				ROADWAY	EROSION CONTROL	BRIDGE	FULL C.E. ITEMS	GRAND TOTAL	FINAL	UNIT	ITEMS	ITEM NUMBER	ROUND	QUANTITIES	UNIT	ITEMS
									1	1		LS	TESTING EQUIPMENT - PROTECTIVE COATINGS	631.18				
									1	1		LU	FIELD OFFICE - TELEPHONE (NAB)	631.25				
						1				1		LS	MOBILIZATION/DEMOLITION	635.11				
						1				1		LS	TRAFFIC CONTROL	641.10				
							230			230		SY	GEOTEXTILE UNDER STONE FILL	649.31				
							60			60		SY	GEOTEXTILE FOR SILT FENCE	649.51				
							70			70		SY	GEOTEXTILE FOR FILTER CURTAIN	649.61				
							10			10		LB	SEED	651.15				
							10			10		LB	SEED-WINTER RYE	651.17				
							100			100		LB	FERTILIZER	651.18				
							1			1		TON	AGRICULTURAL LIMESTONE	651.20				
							180			180		SY	GRUBBING MATERIAL	651.40				
							1			1		LS	EPSC PLAN	652.10				
							50			50		HR	MONITORING EPSC PLAN	652.20				
							1			1		LU	MAINTENANCE OF EPSC PLAN (N.A.B.I.)	652.30				
							200			200		SY	TEMPORARY EROSION MATTING	653.20				
						290				290		LF	BARRIER FENCE	653.50				
							280			280		LF	PROJECT DEMARCATION FENCE	653.55				
						63.13				63.13		SF	TRAFFIC SIGNS, TYPE A	675.20				
													BEGIN OPTION AA					
						148				148		LF	FLANGED CHANNEL SIGN POST	675.301				
						148				148		LF	SQUARE TUBE SIGN POST AND ANCHOR	675.341				
													END OPTION AA					
						7				7		EACH	REMOVING SIGNS	675.50				
						2				2		EACH	ERECTING SALVAGED SIGNS	675.60				
	2	3						5		5		GAL	SPECIAL PROVISION (WATER REPELLENT SILANE)	900.625				
						1				1		LS	SPECIAL PROVISION (FLOATING DOCK)	900.645				
							1			1		TON	SPECIAL PROVISION (STRAW MULCH)	900.680				


## SURVEY TIES

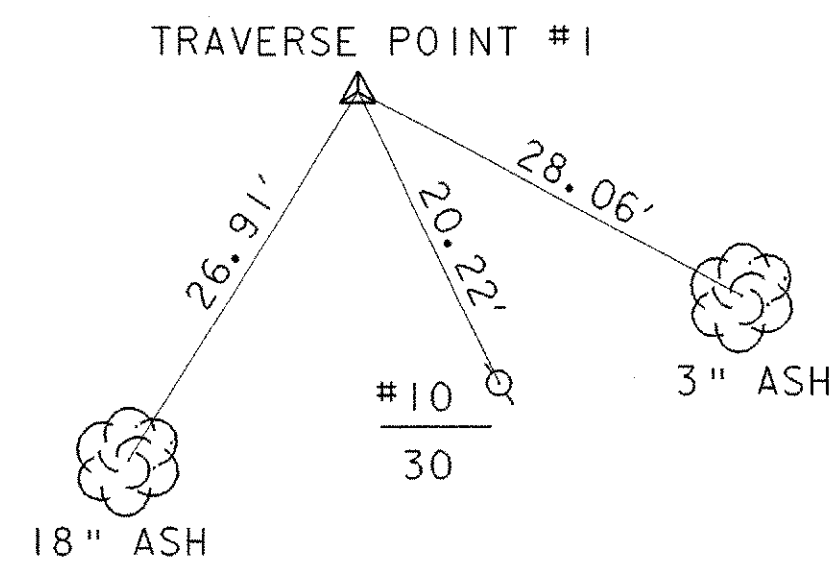


N = 10081.9152  
E = 10057.3576

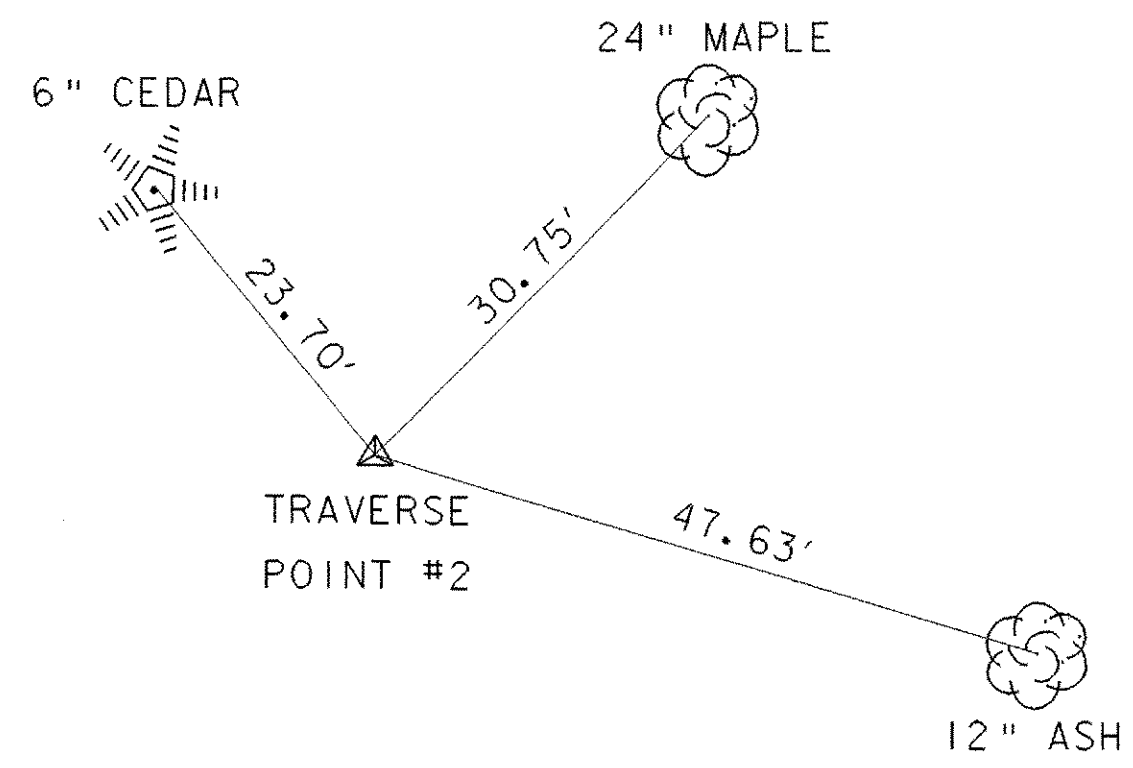

N = 10532.5307  
E = 10372.8820

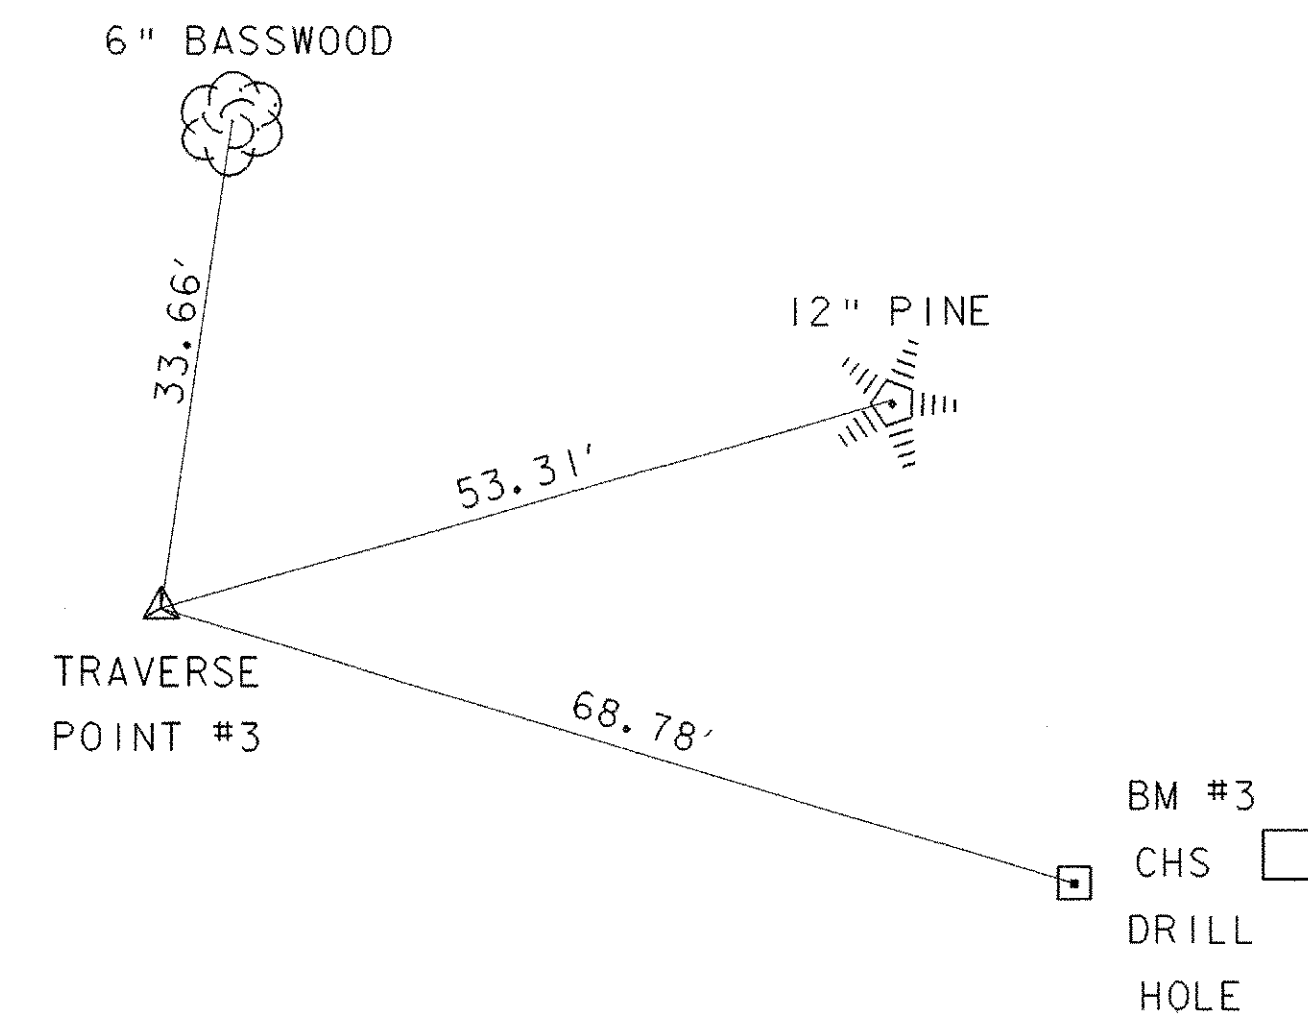


N = 10522.4974  
E = 10486.7547

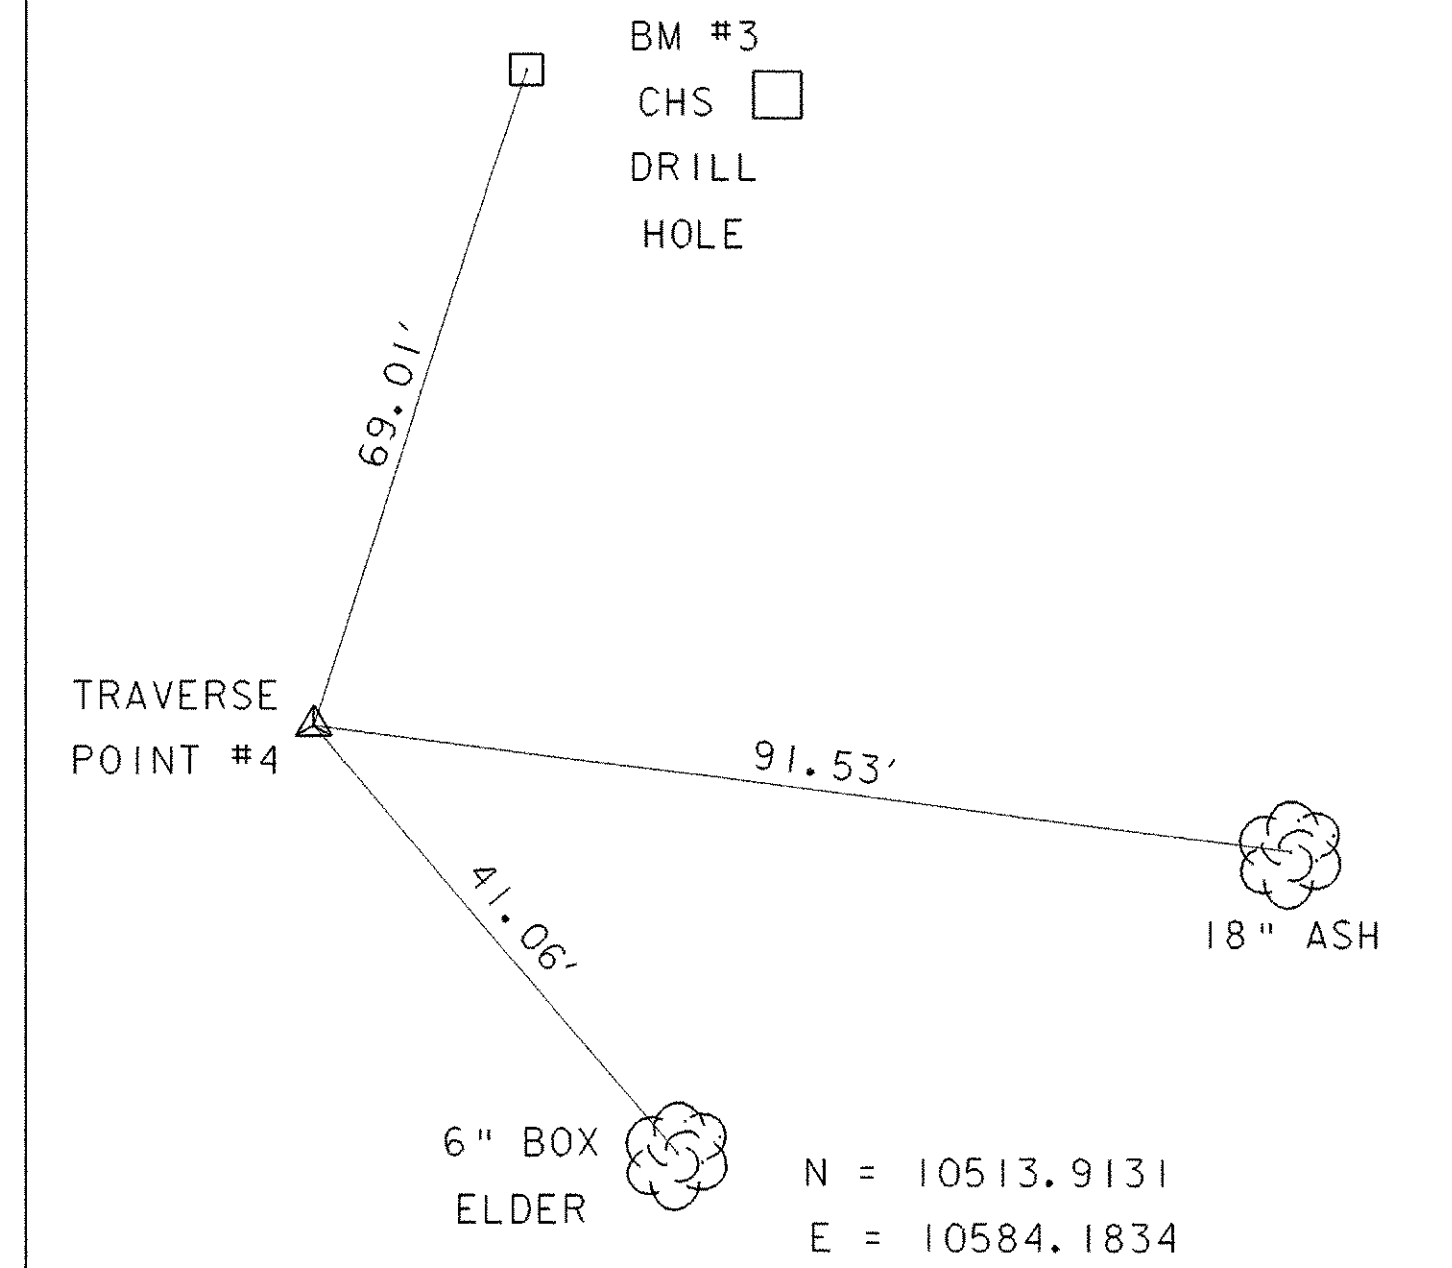

N = 10513.9131  
E = 10584.1834



## ALIGNMENT TIES

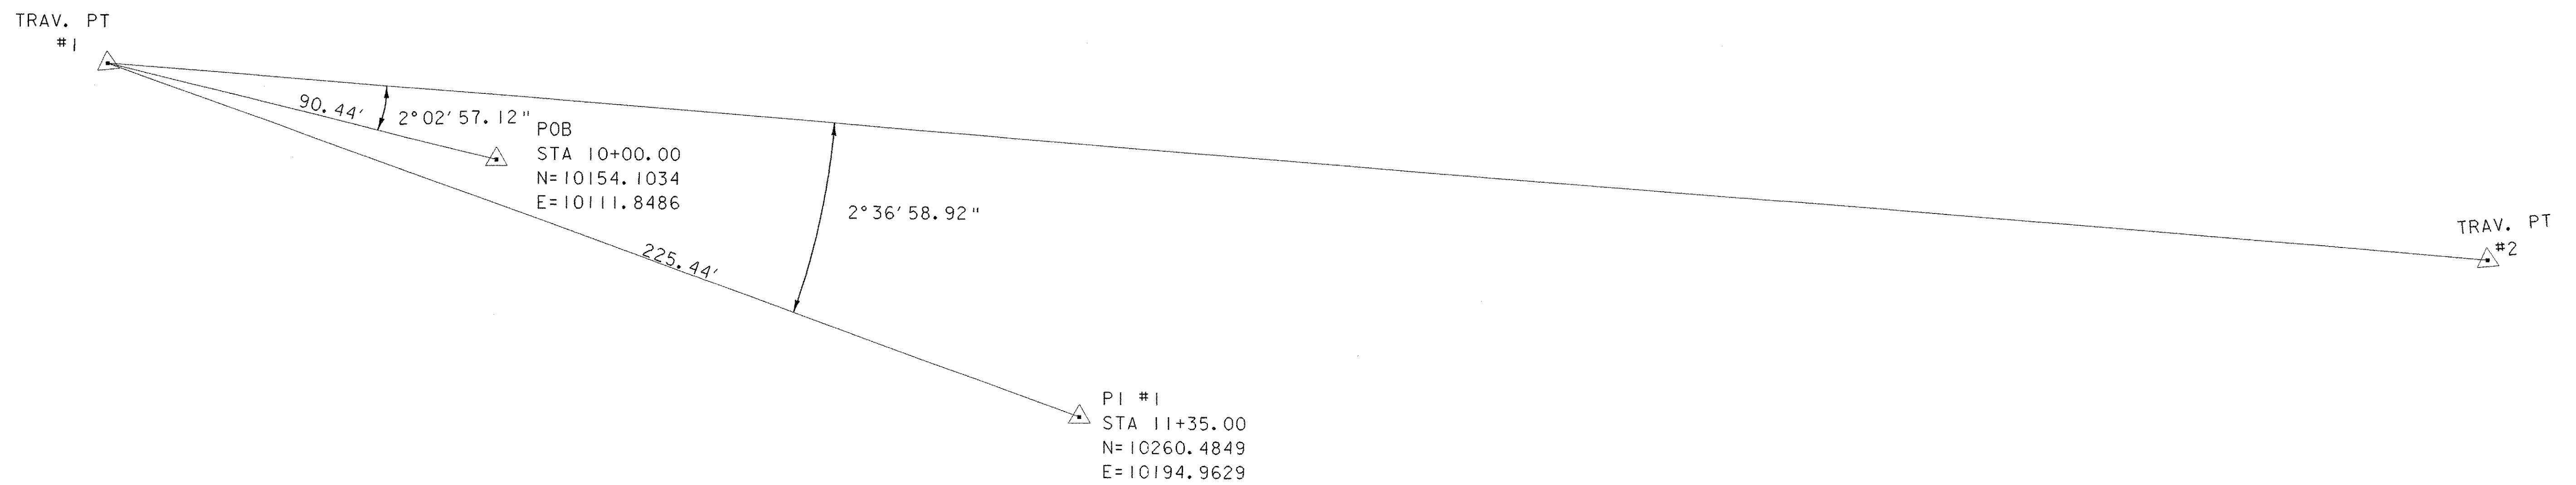

TIES ARE NOT TO SCALE

**DATUM**  
VERTICAL NGVD 1929  
HORIZONTAL ASSUMED

<b>PROJECT:</b> NEW HAVEN - WEYBRIDGE	<b>PROJECT NO.:</b> BHO-BTN 2005 (1)
DESIGN FILE NAME: /str4/89j081/sj081tie.dgn	PLOT DATE: 28-FEB-2007
IPARM FILE NAME: sj081tie.i	SURVEY DATE: 7/90
SURVEYED BY: R. MOREAU	DRAWN BY: P.G. JARVIS
SQUAD LEADER: C.P. WILLIAMS	SHEET: 5 OF 53
TIE SHEET	

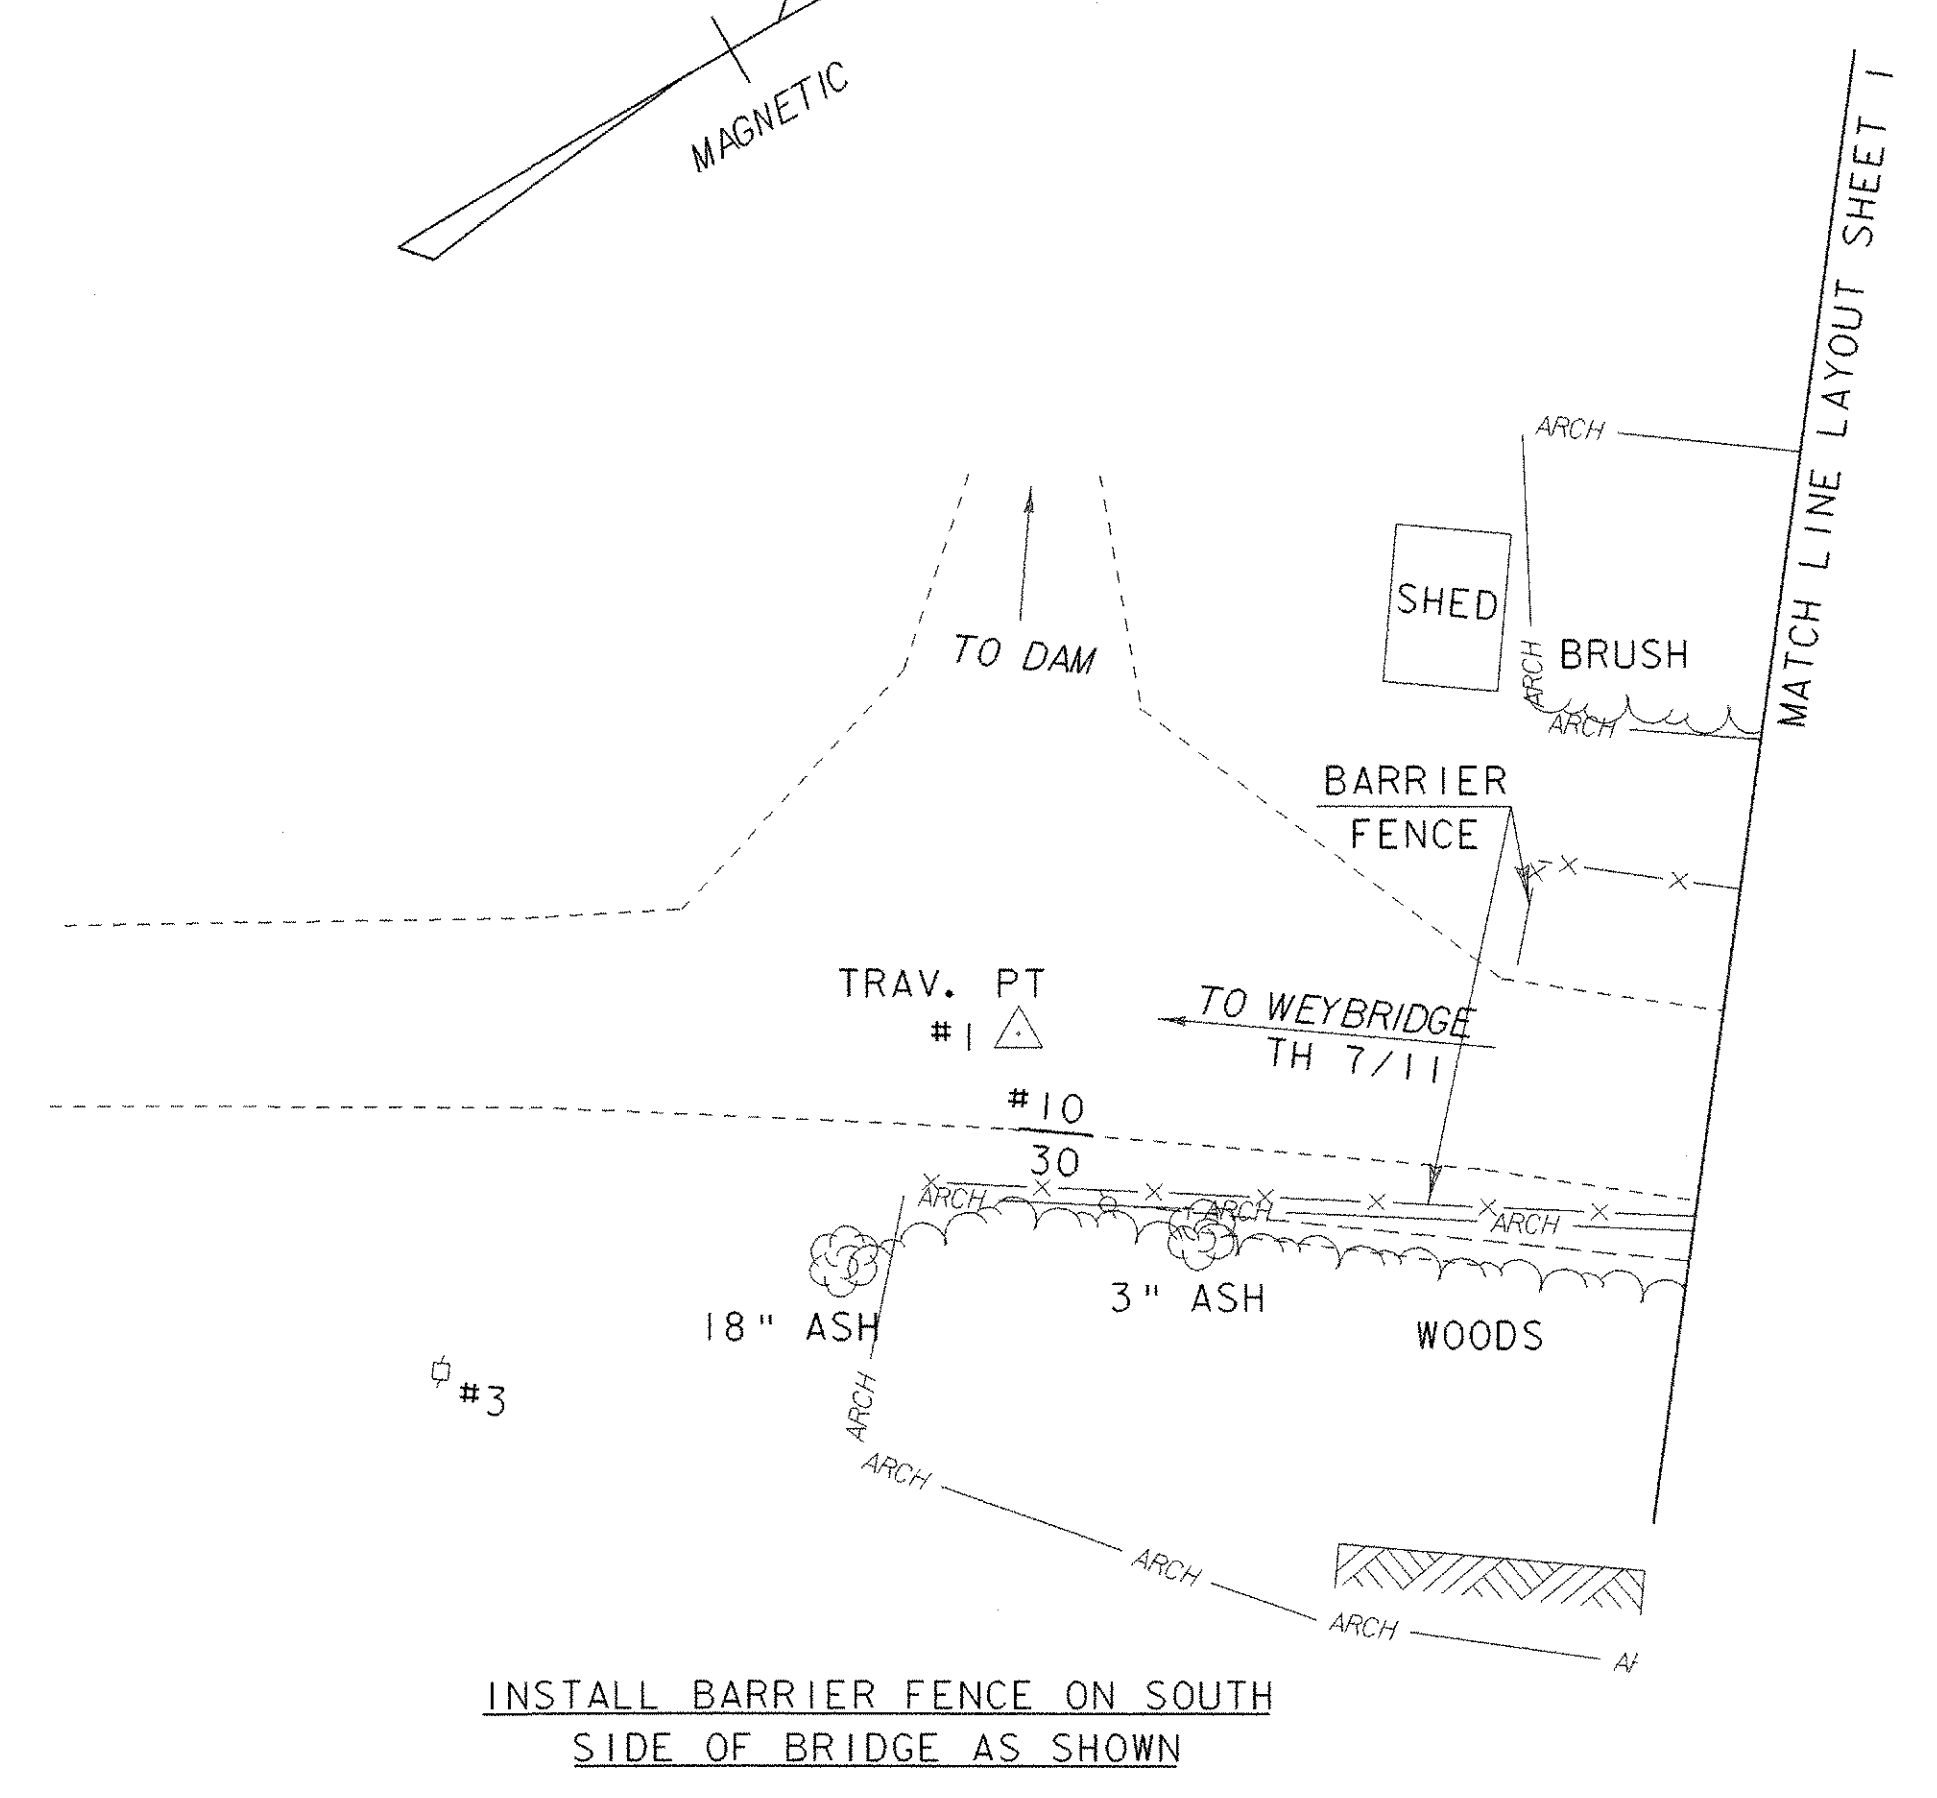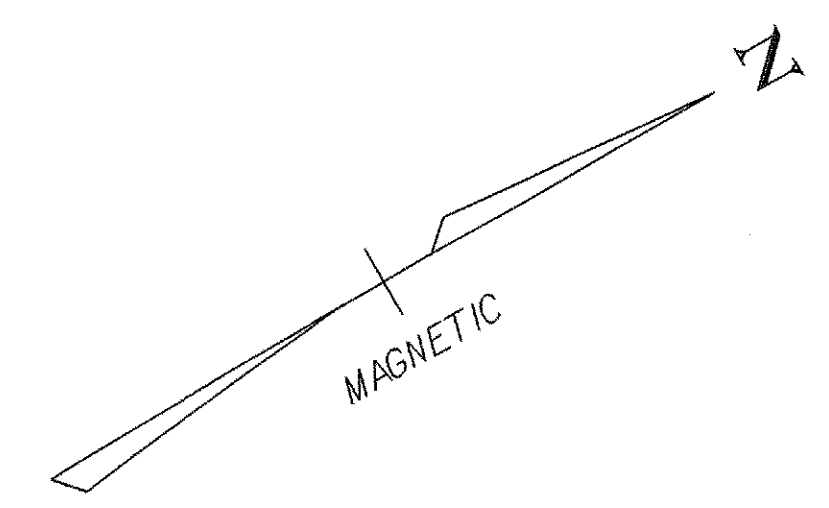

INSTALL BARRIER FENCE ON SOUTH  
SIDE OF BRIDGE AS SHOWN

LAYOUT SHEET 1

SCALE 1" = 20'-0"  
20 0 20

<b>DATUM</b>	
VERTICAL	NGVD 1929
HORIZONTAL	ASSUMED

PROJECT: NEW HAVEN-WEYBRIDGE	PROJECT NO.: BHO-BTN 2005(1)
DESIGN FILE NAME: /usr/str4/89j081/sj081bdr.dgn	PLOT DATE: 28-FEB-2007
IPARM FILE NAME: sj081a1.i	SURVEY DATE: 7/90
SURVEYED BY: R. MOREAU	DRAWN BY: W.B. SYMONDS
SQUAD LEADER: C.P. WILLIAMS	SHEET: 6 OF 53
LAYOUT SHEET 1	

**CURVE 1 DATA**  
 $\Delta = 12^{\circ}53'48''$  LT  
 $D = 19^{\circ}05'55''$   
 $R = 300.00'$   
 $T = 33.91'$   
 $L = 67.53'$   
 $E = 1.91'$   
 BANK = NORMAL

**BRIDGE RAIL - 2 RAIL BOX BEAM**  
 STA 12+26 - 13+80 LT & RT

**HEAVY DUTY STEEL BEAM GUARDRAIL**  
 STA 11+91 - 12+26 LT  
 STA 11+88 - 12+26 RT  
 STA 13+80 - 14+14 LT  
 STA 13+80 - 14+20 RT 15+45

**ANCHORS FOR STEEL BEAM GUARDRAIL**  
 STA 11+98 LT & RT  
 STA 14+07 LT  
 STA 14+13 RT  
 15+38


**CONSTRUCT DRIVE WITH 8.5' PAVED APRON**  
 1 1/2" TYPE III PAVEMENT  
 STA 11+87 LT

**REMOVAL OF EXISTING GUARDRAIL**  
 STA 12+06 - 12+30 LT  
 STA 11+90 - 12+29 RT

**CONSTRUCT TEMPORARY FLOATING DOCK**  
 STA 12+50 RT

**INSTALL BARRIER FENCE**  
 STA 9+00 - 9+85 RT  
 STA 9+60 - 10+35 LT  
 STA 10+00 - 11+15 RT

NOTE: 125 OF THIS RUN  
 WAS PAID FOR BY THE  
 TOWN OF NH DIRECTLY.

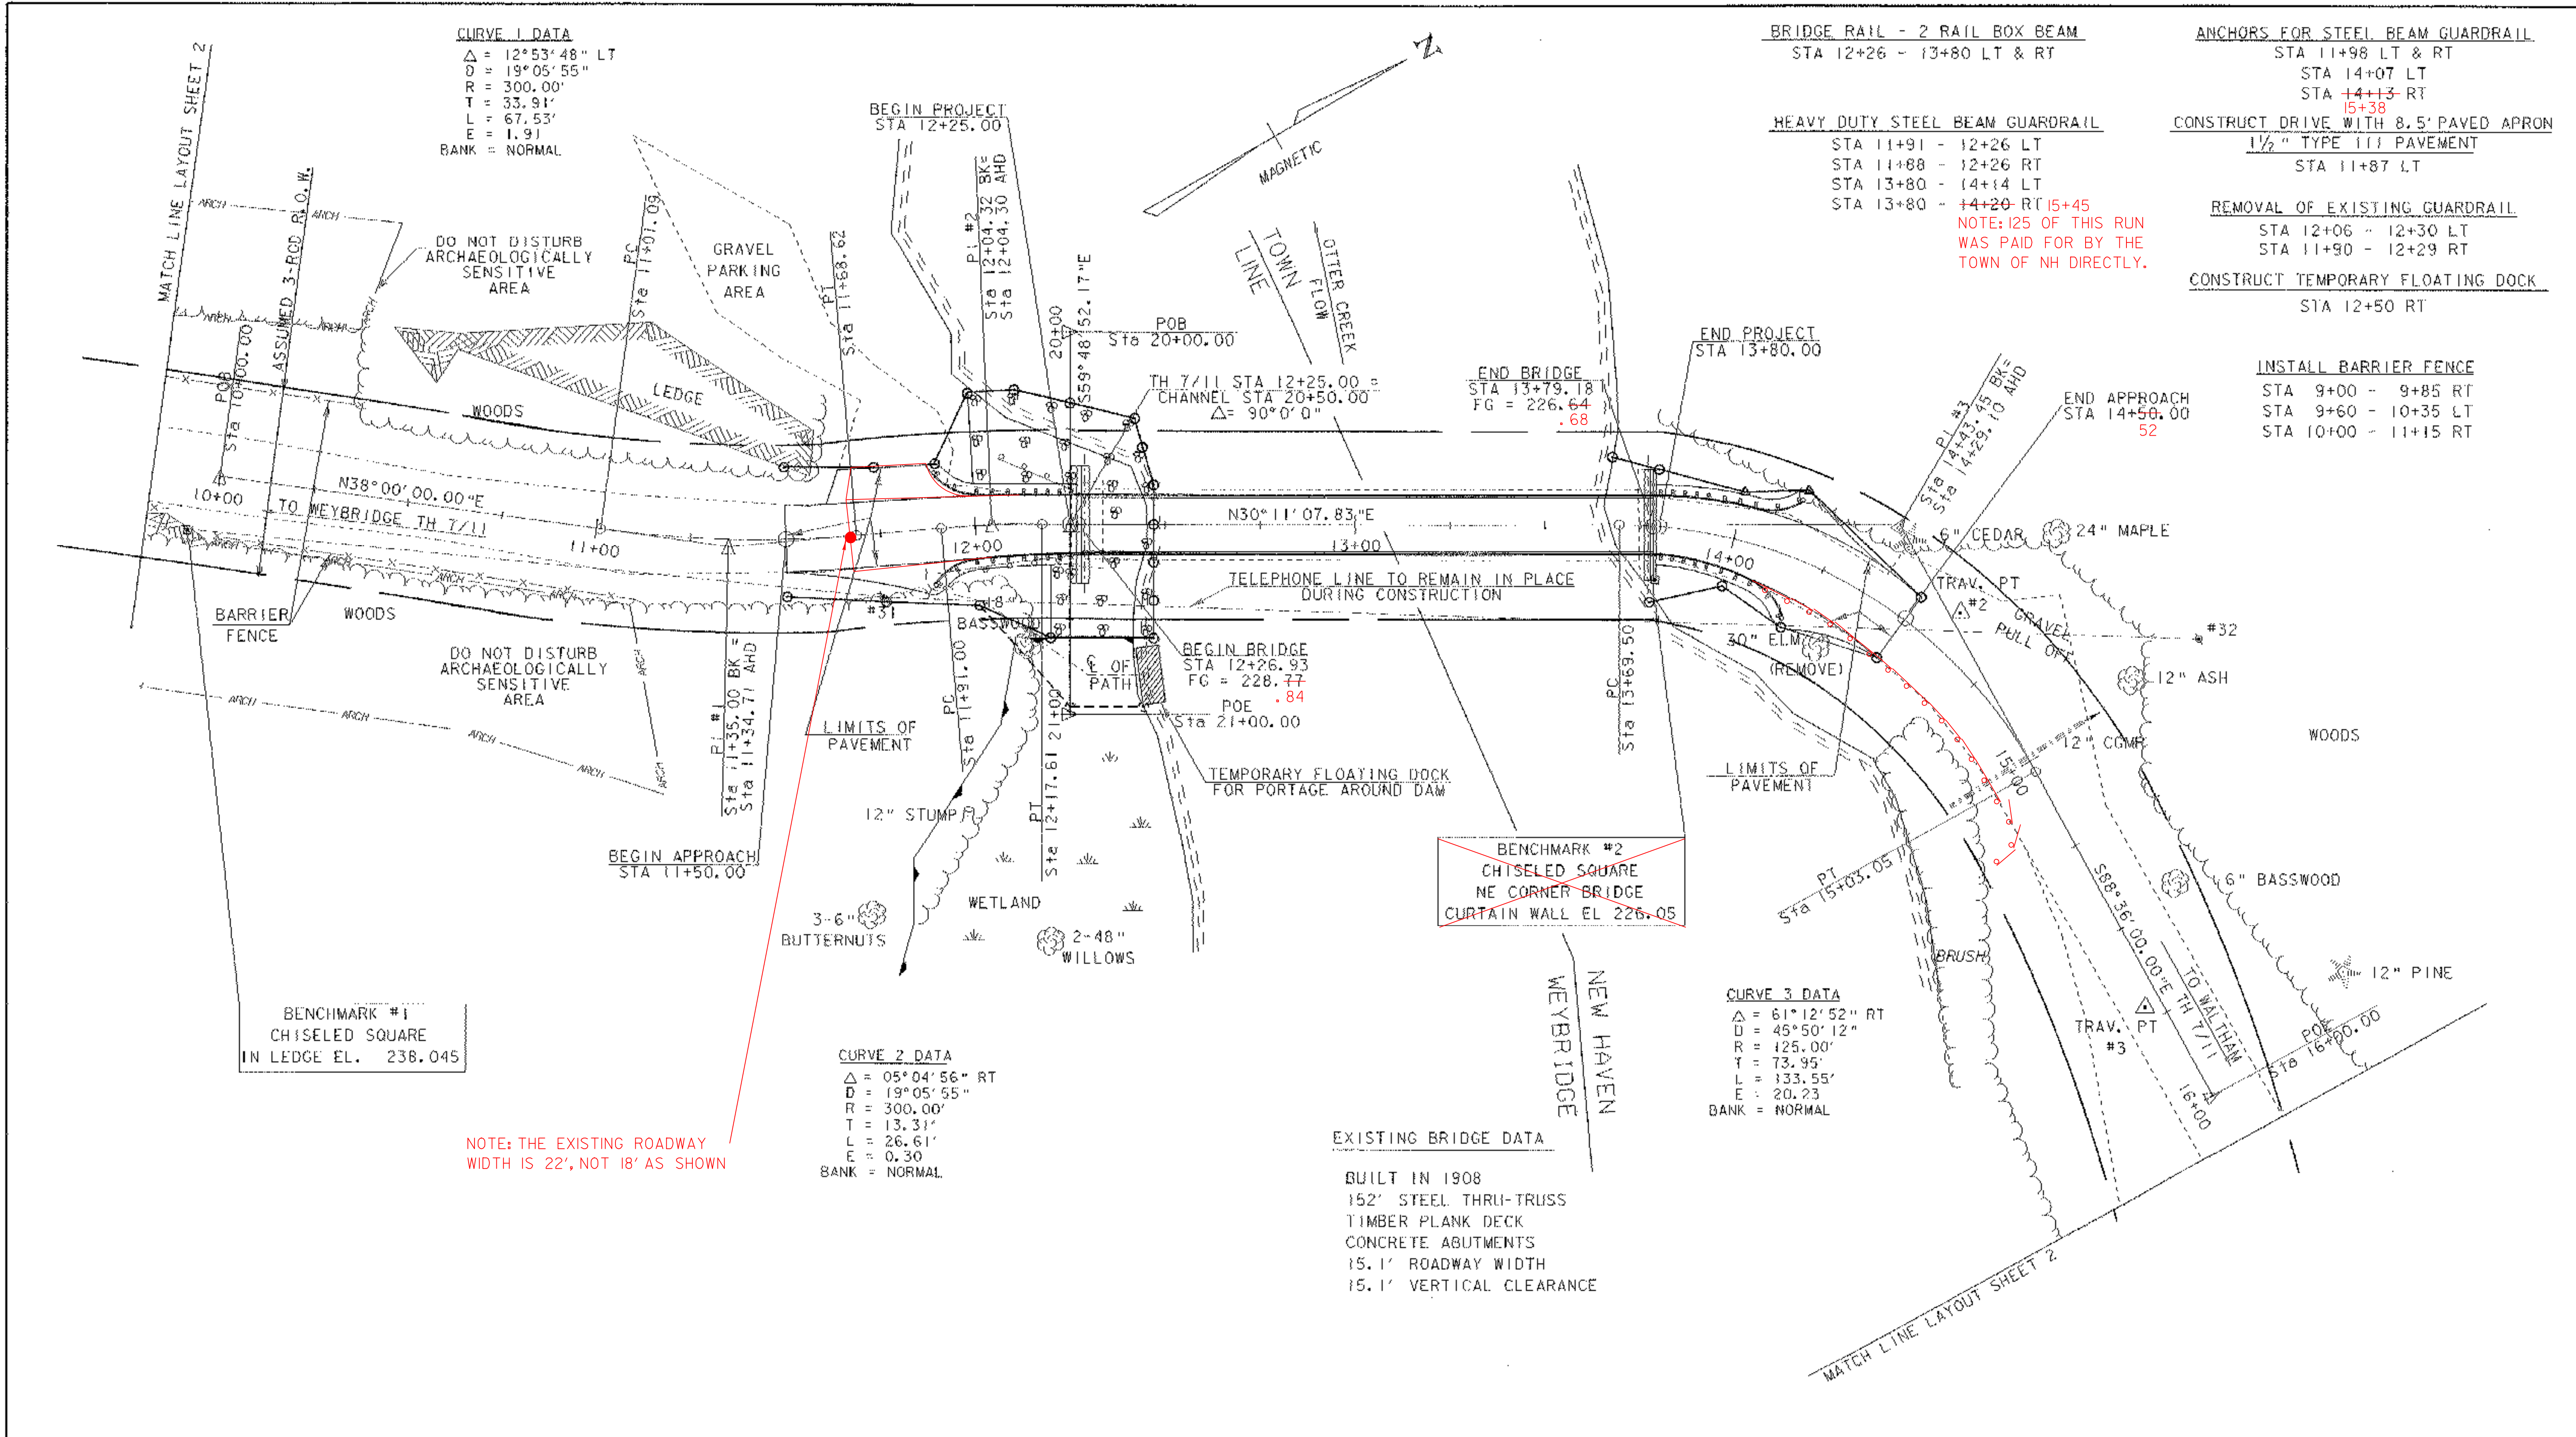

NOTE: THE EXISTING ROADWAY  
 WIDTH IS 22', NOT 18' AS SHOWN


**LAYOUT SHEET 2**

SCALE 1" = 20'-0"  
 20 0 20

**DATUM**  
 VERTICAL NGVD 1929  
 HORIZONTAL ASSUMED

PROJECT: <b>NEW HAVEN-WEYBRIDGE</b>	PROJECT NO.: <b>BHO-BTN 2005(1)</b>
DESIGN FILE NAME: /usr/str/4/89j081/sj081bdr.dgn	PLOT DATE: 28-FEB-2007
IPARM FILE NAME: sj081q2.1	SURVEY DATE: 7/90
SURVEYED BY: R. MOREAU	DRAWN BY: W.B. SYMONDS
SQUAD LEADER: C.P. WILLIAMS	SHEET: 7 OF 53
LAYOUT SHEET 2	

BENCHMARK #3  
 CHISELED SQUARE IN  
 LEDGE DRILL HOLE FOR  
 TIES IN CTR. EL 231.749

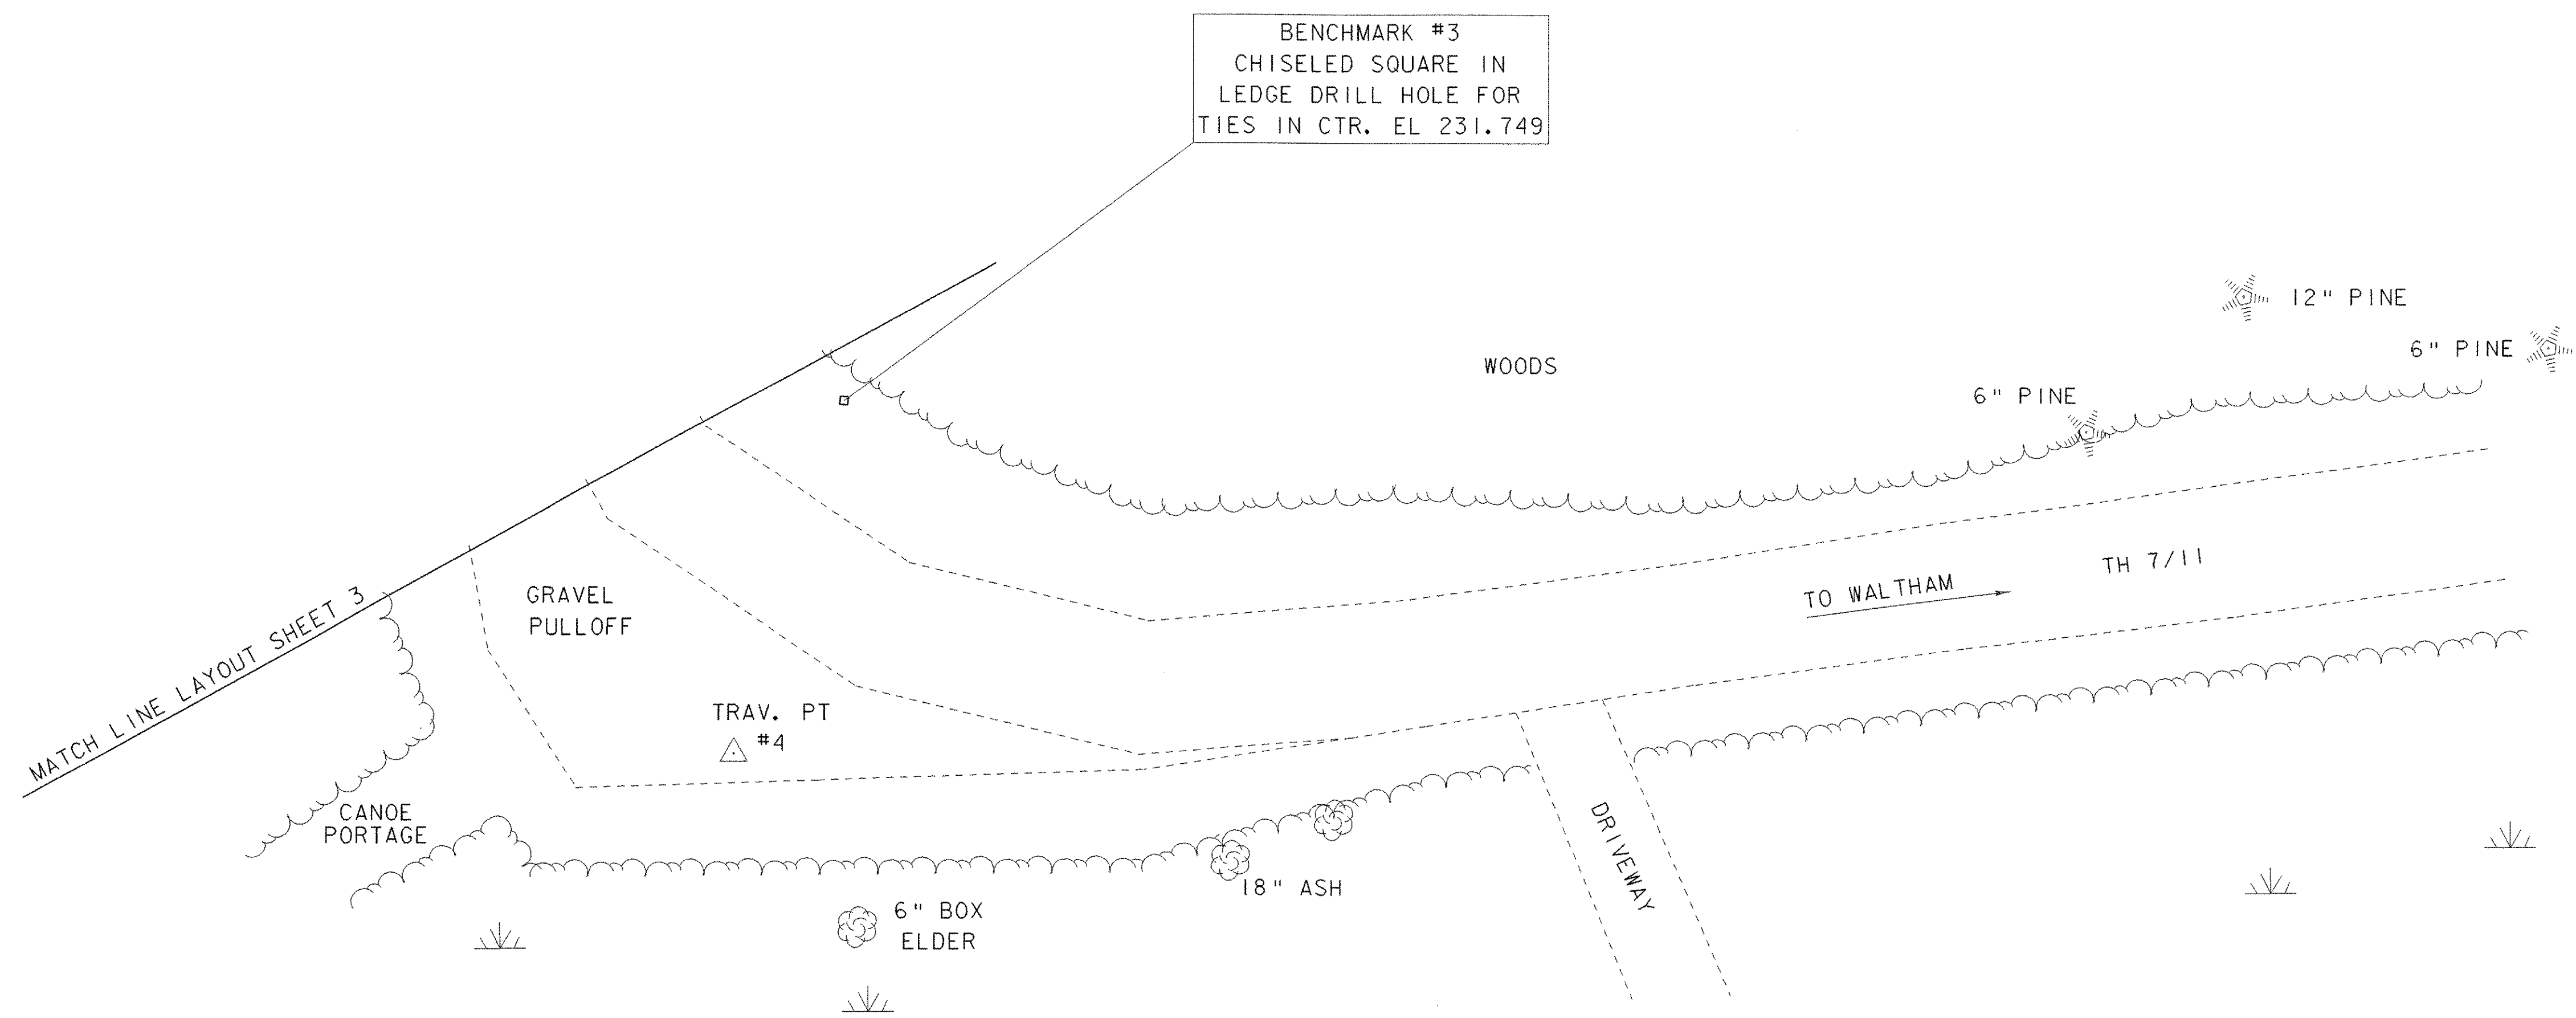

MATCH LINE LAYOUT SHEET 3


LAYOUT SHEET 3

SCALE 1" = 20'-0"  
 20 0 20

DATUM  
 VERTICAL NGVD 1929  
 HORIZONTAL ASSUMED


PROJECT: NEW HAVEN-WEYBRIDGE	PROJECT NO.: BHO-BTN 2005(1)
DESIGN FILE NAME: /usr/str4/89j081/sj08lbr.dgn	PLOT DATE: 28-FEB-2007
IPARM FILE NAME: sj08lq3.l	SURVEY DATE: 7/90
SURVEYED BY: R. MOREAU	DRAWN BY: W.B. SYMONDS
SQUAD LEADER: C.P. WILLIAMS	SHEET: 8 OF 53
LAYOUT SHEET 3	

# Profile

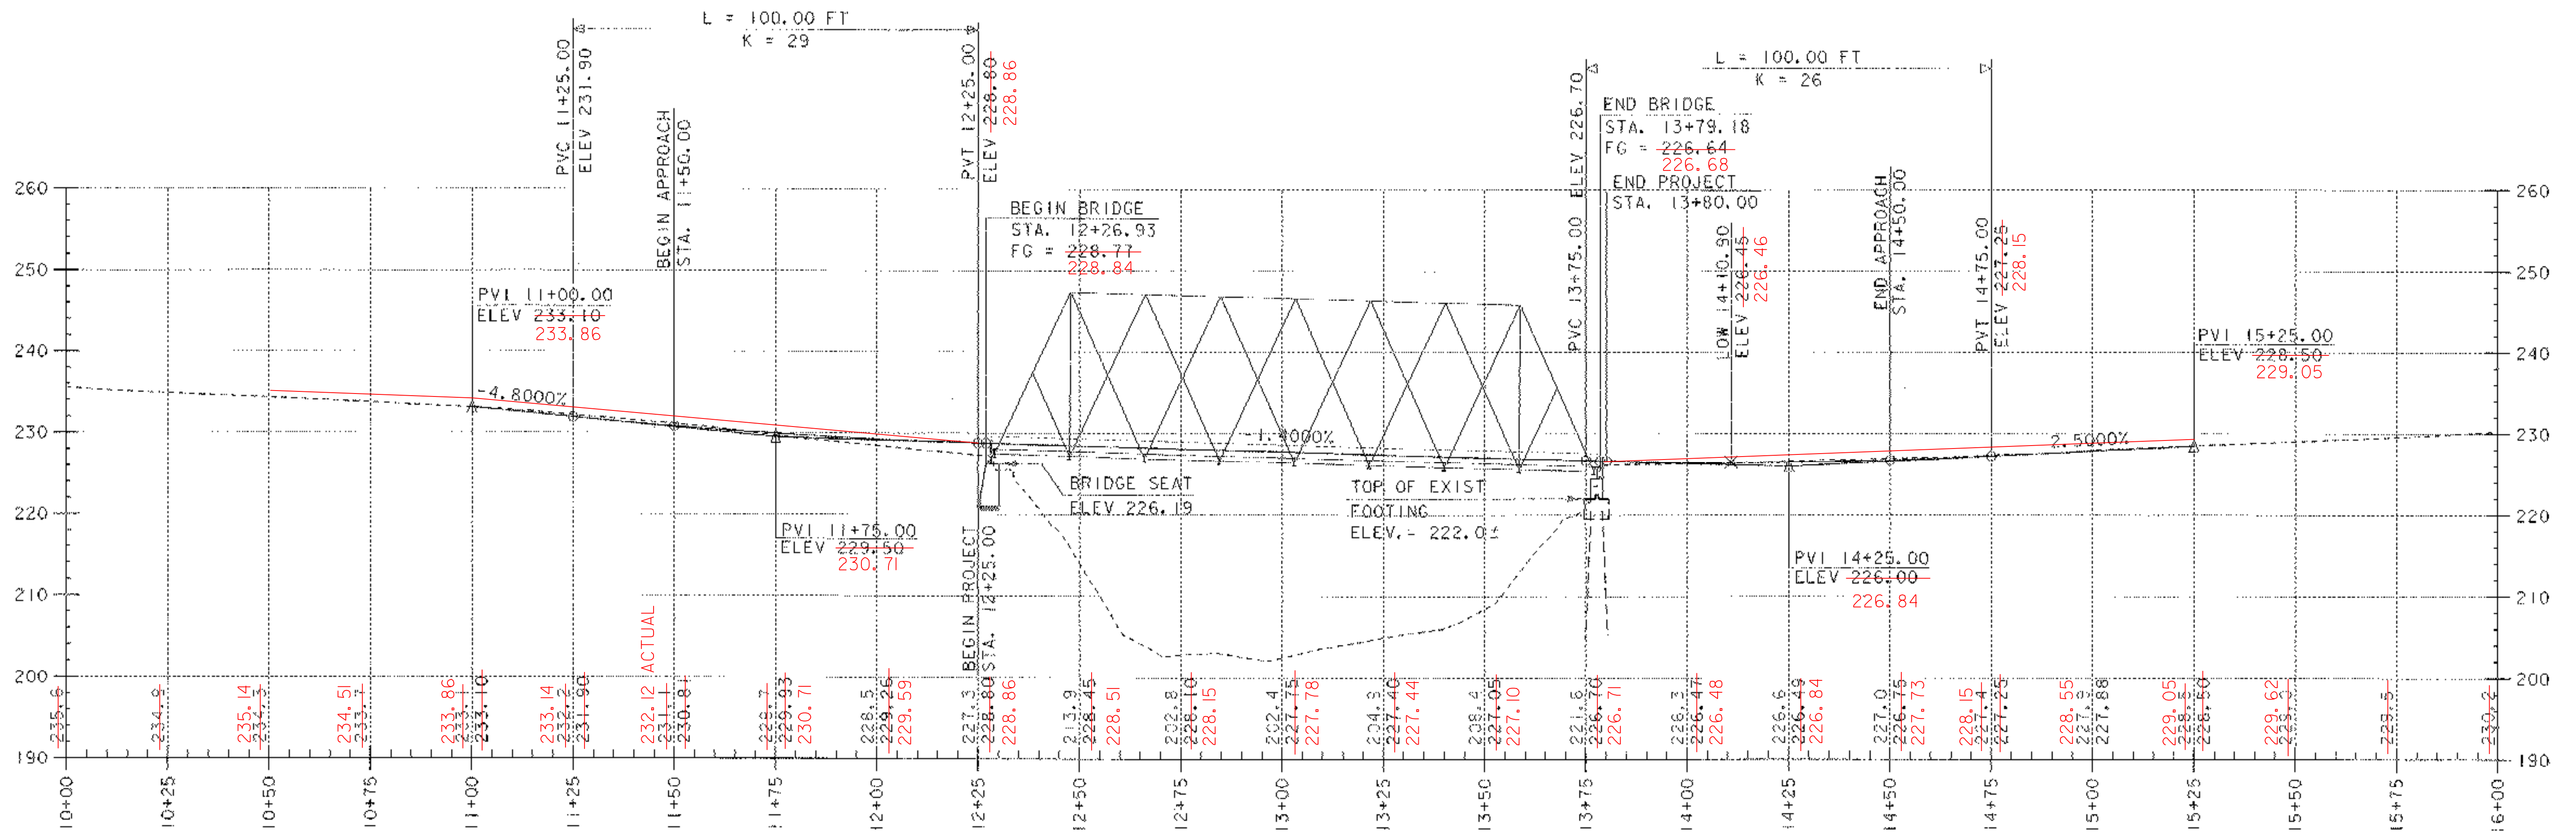

NOTE: EXISTING CENTERLINE ELEVATIONS ARE SHOWN TO THE TENTH.  
PROPOSED CENTERLINE ELEVATIONS ARE SHOWN TO THE HUNDREDTH.

DATUM  
VERTICAL NGVD 1929  
HORIZONTAL ASSUMED

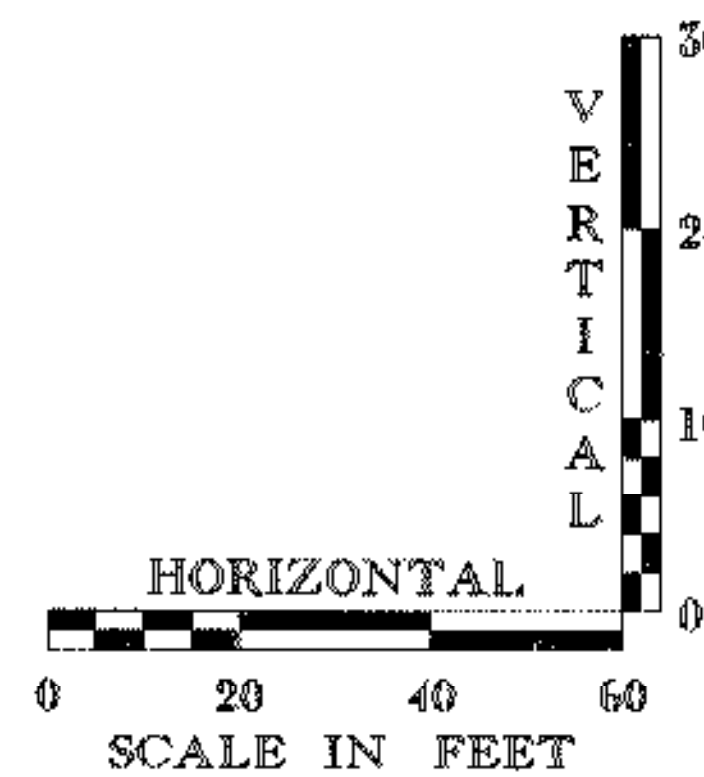





PROJECT: <b>NEW HAVEN-WEYBRIDGE</b>	PROJECT NO. # <b>BHO-BTN 2005(1)</b>
DESIGN FILE NAME: /usr/sfr4/89j081/sj081pr1.dgn	PLT DATE: 28-FEB-2007
IFARM FILE NAME: sj081pro.l	SURVEY DATE: 7/90
SURVEYED BY: R. MOREAU	DRAWN BY: W.B. SYMGND
SQUAD LEADER: C.P. WILLIAMS	SHEET: 9 OF 53
PROFILE SHEET	

**BRIDGE CLOSED**

R11-2  
MOUNTED ON TYPE  
111 BARRICADE (1)  
(MODIFIED)

NOTE:

TEMPORARY TRAFFIC BARRIER SHALL BE PLACED AT BOTH ENDS OF THE BRIDGE AS SHOWN. THE BARRIER SHALL BE PAID FOR UNDER ITEM 621.90 "TEMPORARY TRAFFIC BARRIER".

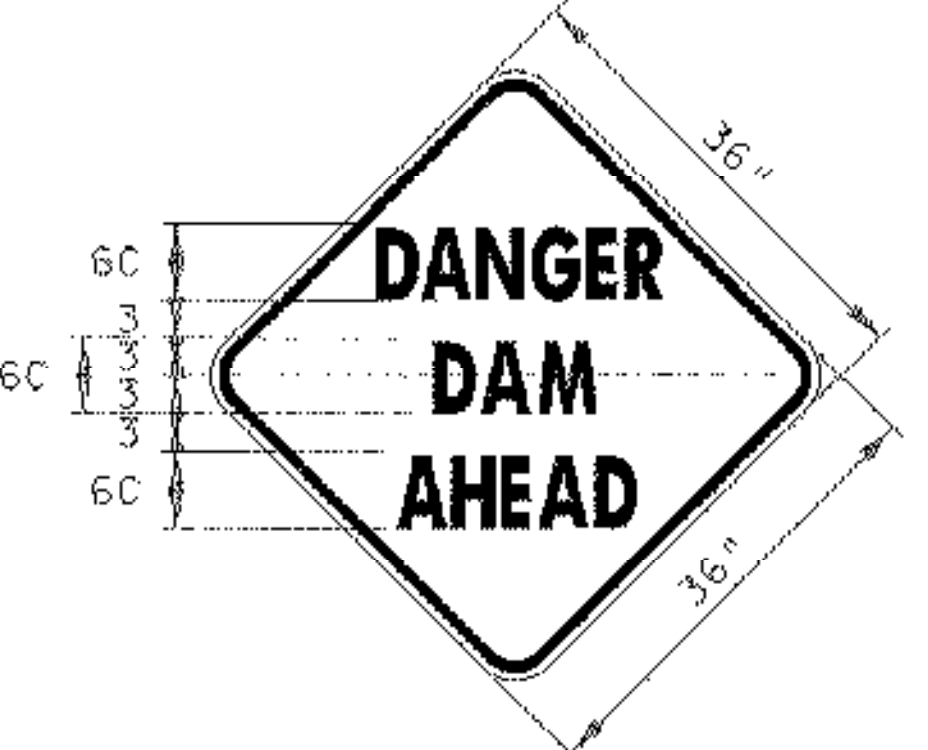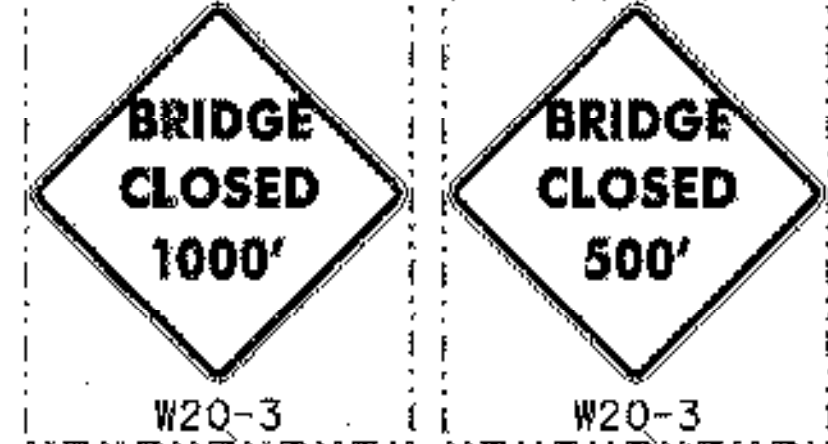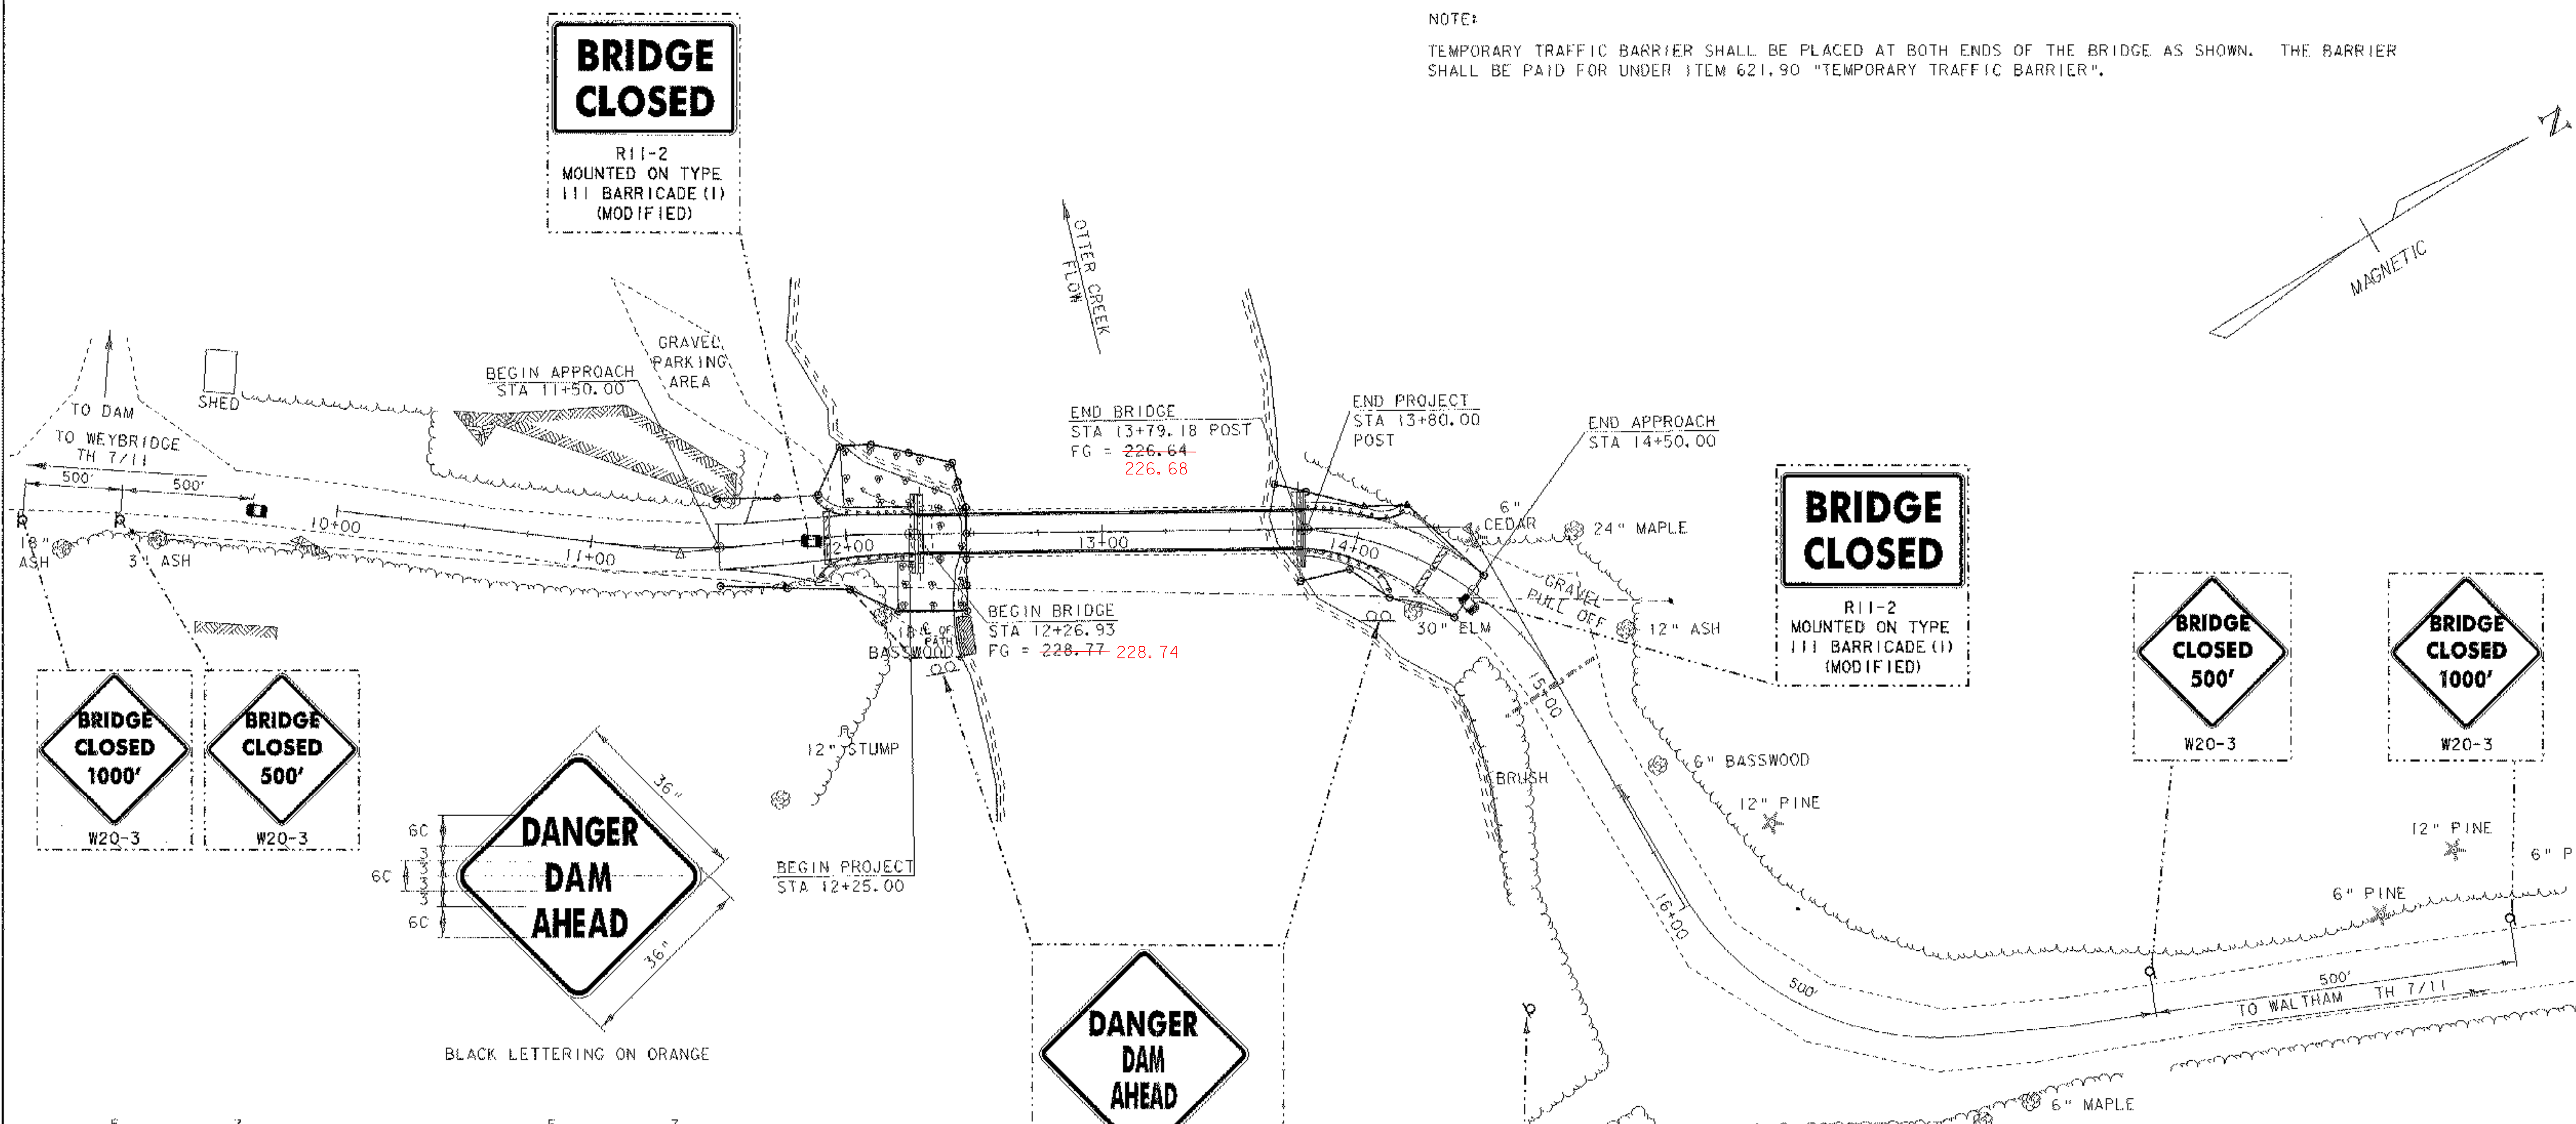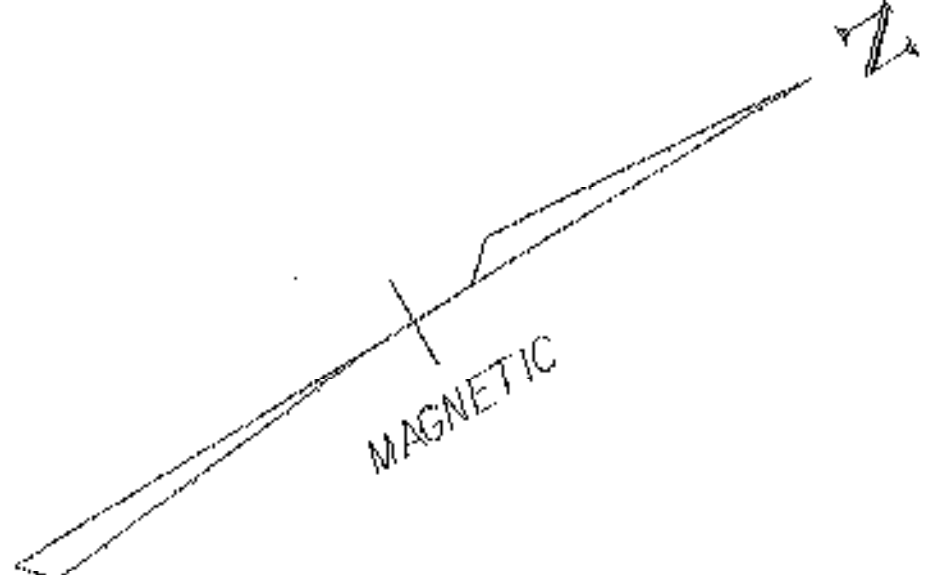




BLACK LETTERING ON ORANGE




THESE SIGNS SHALL BE VISIBLE AT ALL TIMES DURING CONSTRUCTION INCLUDING ALL PAINTING OPERATIONS



TO BE PLACED AT LOCATION OF EXISTING CANOE PORTAGE LANDING.

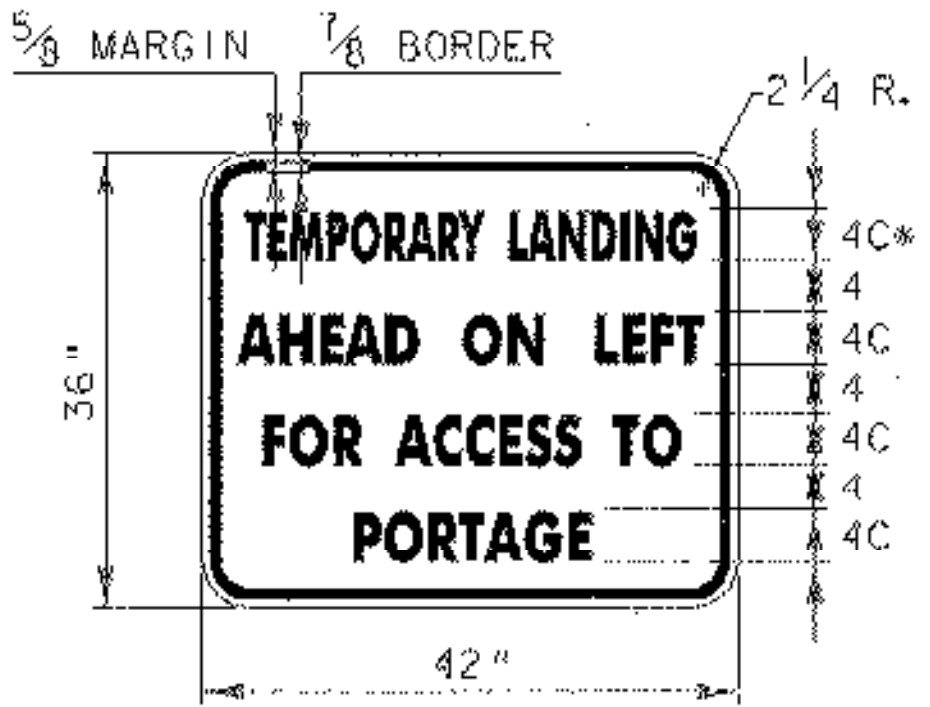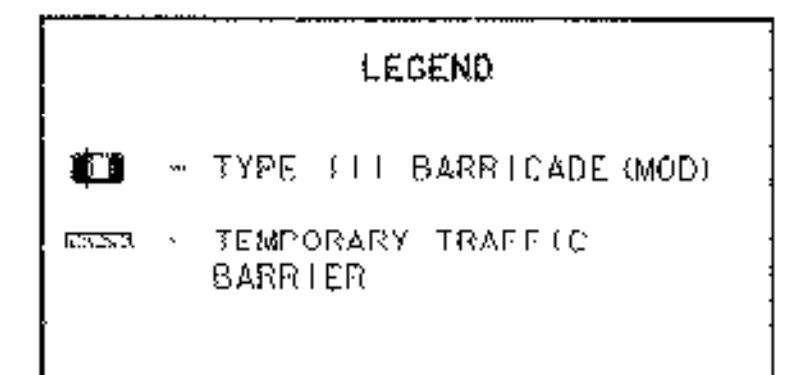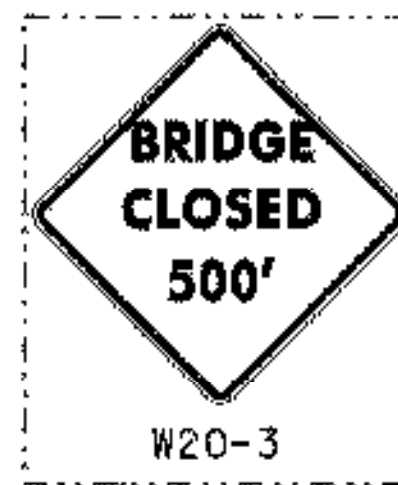


BLACK LETTERING ON ORANGE  
\*REDUCE SPACING BY 76%

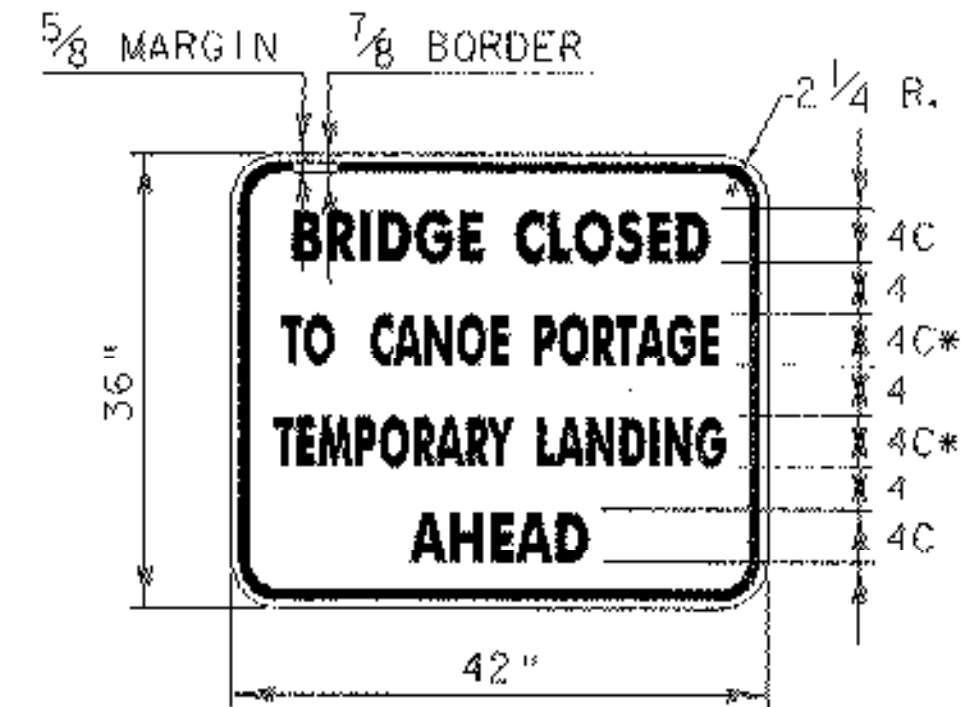



BLACK LETTERING ON ORANGE  
\*REDUCE SPACING BY 76%

TRAFFIC CONTROL SHEET

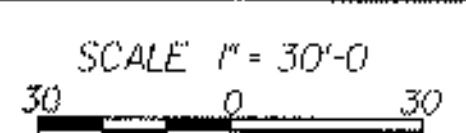

DATUM	
VERTICAL	NGVD 1929
HORIZONTAL	ASSUMED

PROJECT:	NEW HAVEN-WEYBRIDGE	PROJECT NO.:	BHO-BTN 2005 (1)
DESIGN FILE NAME:	/s/r/4/89j081/sj081trf.dgn	PLOT DATE:	28-FEB-2007
IPARM FILE NAME:	sj081det1	SURVEY DATE:	7/90
SURVEYED BY:	R. MOREAU	DRAWN BY:	P. G. JARVIS
SQUAD LEADER:	C. P. WILLIAMS	SHEET:	10 OF 53
TRAFFIC CONTROL SHEET			

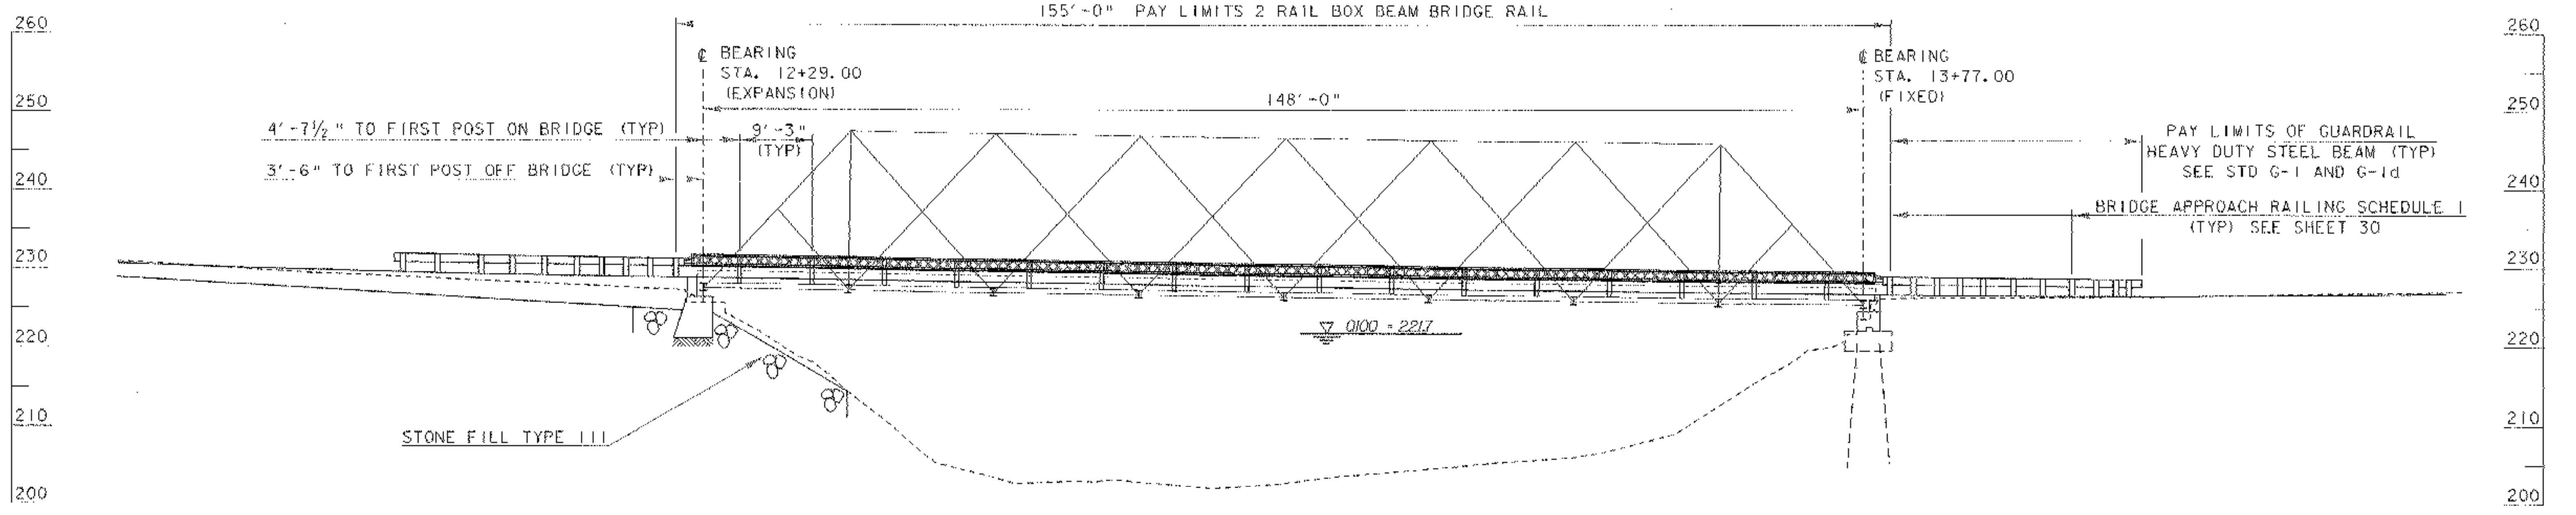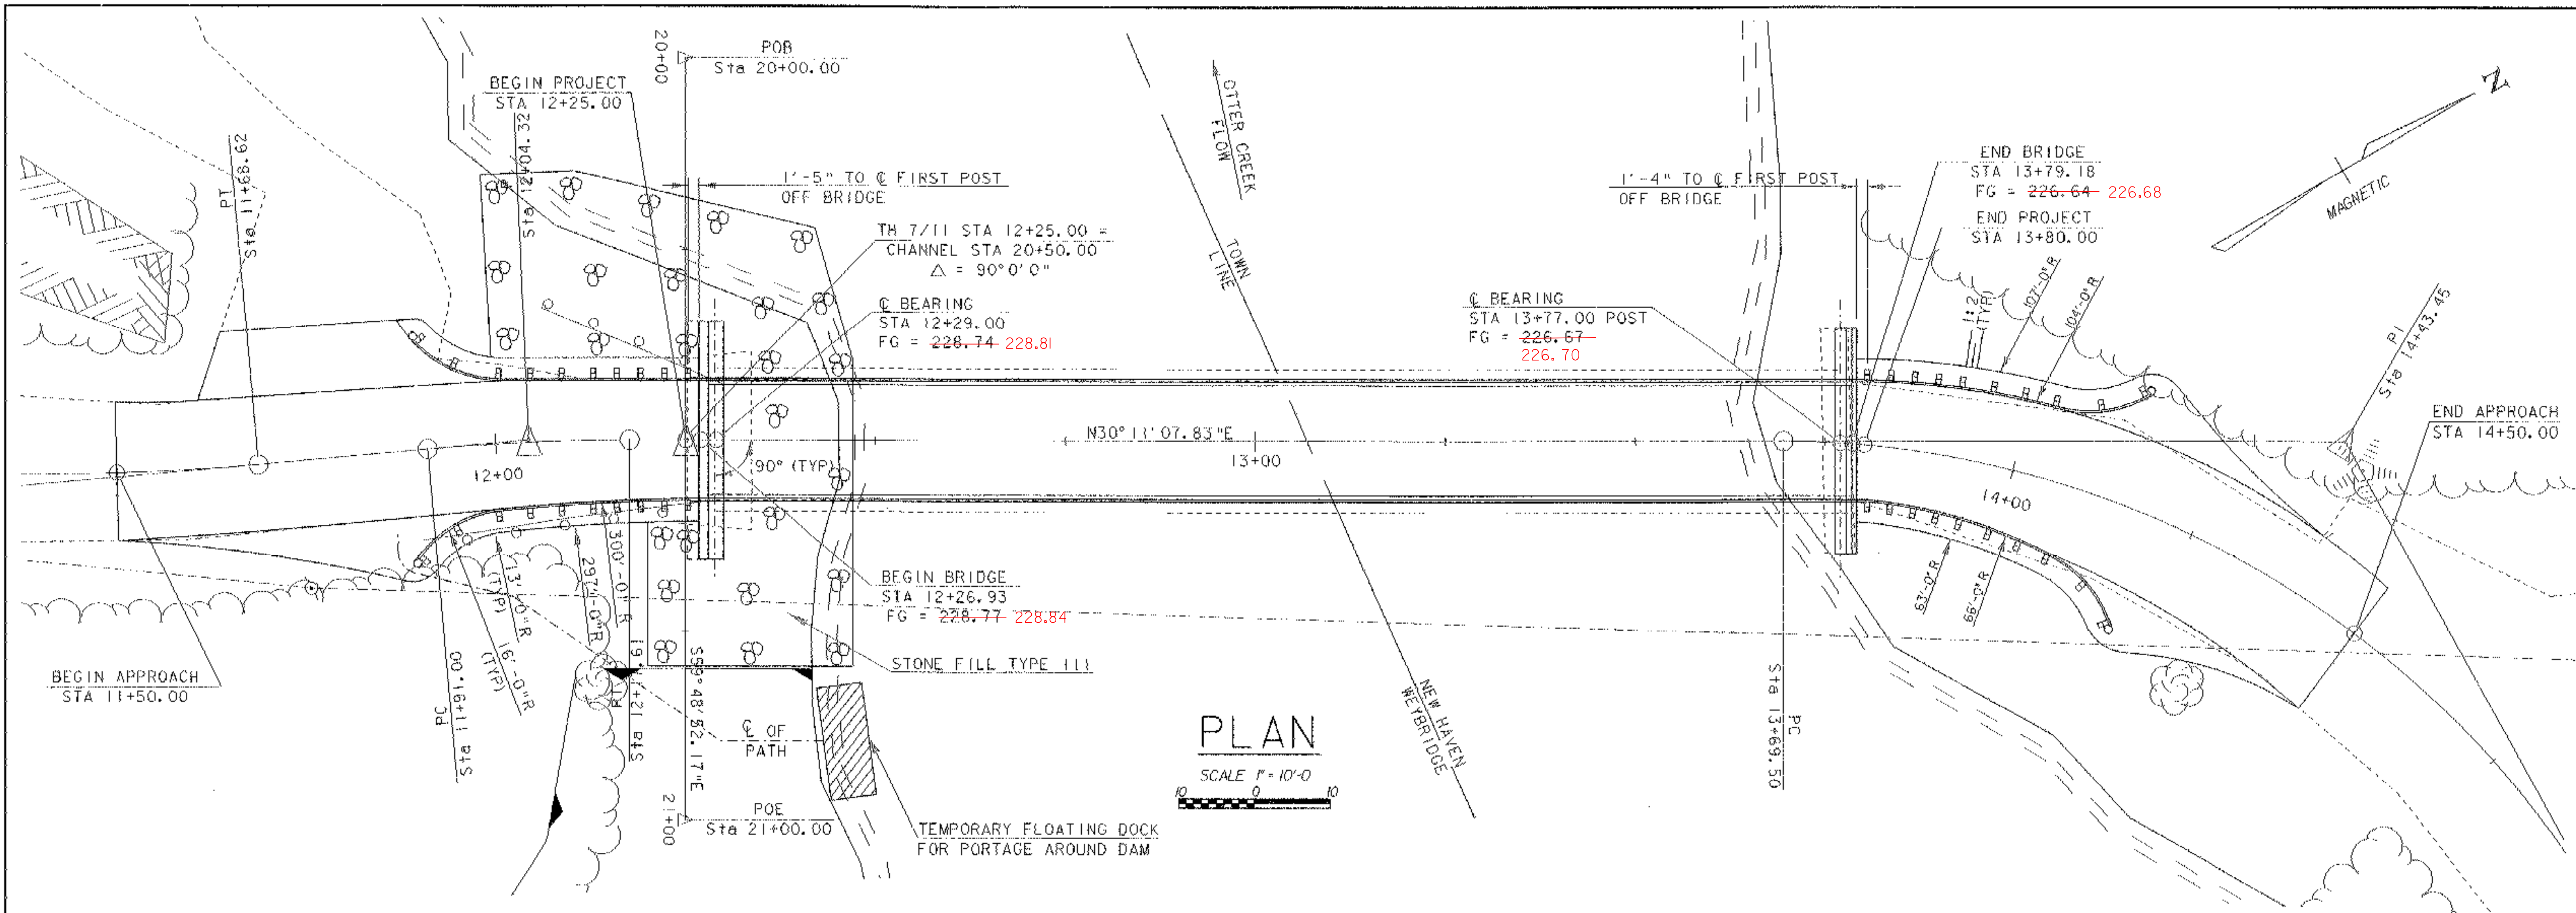

DATUM  
VERTICAL NGVD 1929  
HORIZONTAL ASSUMED

PROJECT: NEW HAVEN - WEYBRIDGE	PROJECT NO.: BHO-BTN 2005(1)
DESIGN FILE NAME: s:\r4\89\081\s\081pe.dgn	PLOT DATE: 28-FEB-2007
IPARM FILE NAME: s\j081pe.i	SURVEY DATE: 7/90
SURVEYED BY: R. MOREAU	DRAWN BY: P.G. JARVIS
SQUAD LEADER: C.P. WILLIAMS	SHEET: 11 OF 53
PLAN AND ELEVATION SHEET	

## GENERAL NOTES

1. ALL MATERIALS AND CONSTRUCTION SHALL CONFORM TO STATE OF VERMONT, AGENCY OF TRANSPORTATION STANDARD SPECIFICATIONS FOR CONSTRUCTION, DATED 2006, AND ITS LATEST REVISIONS, AND THE AASHTO STANDARD SPECIFICATIONS FOR HIGHWAY BRIDGES, SEVENTEENTH EDITION. THE GLULAM DECK SHALL CONFORM TO THE NATIONAL DESIGN SPECIFICATION FOR WOOD CONSTRUCTION, 1997 EDITION. AND WITH THE STRUCTURAL GLUED LAMINATED TIMBER SUPPLEMENT.
  2. ALL DIMENSIONS ARE HORIZONTAL OR VERTICAL AND ARE GIVEN AT 68 DEGREES F, UNLESS OTHERWISE NOTED.
  3. DESIGN MEETS H20-44 LIVE LOADING (POSTED RATING).
  4. BRIDGE 26 SHALL REMAIN CLOSED TO THROUGH TRAFFIC DURING CONSTRUCTION. ACCESS TO THE GRAVEL PARKING AREA AT STA 11+75 LEFT AND THE GRAVEL PULL OFF AT STA 14+75 LEFT WILL BE MAINTAINED AT ALL TIMES DURING CONSTRUCTION.
  5. ALL PROJECT SIGNS AND BARRICADES ON SITE SHALL BE THE RESPONSIBILITY OF THE CONTRACTOR AND PAID FOR UNDER THE ITEM 641.10 "TRAFFIC CONTROL". ANY DETOUR SIGNS OFF SITE SHALL BE THE RESPONSIBILITY OF THE TOWNS OF NEW HAVEN AND WEYBRIDGE.
  6. THE CONTRACTOR SHALL NOTIFY THE TOWNS OF NEW HAVEN AND WEYBRIDGE IN WRITING TWO WEEKS PRIOR TO CLOSING BRIDGE 26 TO TRAFFIC.
  7. A TEMPORARY FLOATING DOCK SHALL BE CONSTRUCTED AT STA 12+50 RT. THE DOCK SHALL BE PAID FOR UNDER THE ITEM 900.645 "SPECIAL PROVISIONS (FLOATING DOCK)". SEE SPECIAL PROVISIONS FOR DETAILS.
  8. ANY EXISTING SIGNS NOT REUSED SHALL REMAIN THE PROPERTY OF THE TOWN OF NEW HAVEN OR WEYBRIDGE. THE OWNERSHIP SHALL BE DETERMINED BY THE CURRENT LOCATION. THE CONTRACTOR SHALL REMOVE AND STOCKPILE SIGNS TO BE PICKED UP BY PHILIP BUSIER, ROAD FOREMAN, TOWN OF NEW HAVEN (453-3397) /BY ROBERT CYR, ROAD FOREMAN, TOWN OF WEYBRIDGE (545-2265).
  9. ITEM 529.20 "PARTIAL REMOVAL OF STRUCTURE" SHALL INCLUDE THE FOLLOWING:
    - REMOVAL OF TRUSS MEMBERS AS DETAILED IN THE CONTRACT PLANS OR AS ORDERED BY THE ENGINEER.
    - REMOVAL OF FLOOR BEAMS, STRINGERS, ANY PLATES OR ANGLES CONNECTING THE FLOOR BEAMS TO THE TRUSS, AND BEARING ASSEMBLIES
    - REMOVAL OF ANY MEMBER WITH MORE THAN 25% SECTION LOSS, AS DETERMINED BY THE ENGINEER.
    - REMOVAL OF LATERAL BRACING BETWEEN FLOOR BEAMS.
    - REMOVAL AND DISPOSAL OF THE EXISTING BRIDGE DECKING.
    - REMOVAL OF LATTICE RAILING, TO BE REHABILITATED AS DETAILED ON SHEET 28, AND REMOVAL OF THE SUPPORTING PLATES AND ANGLES.
    - REMOVAL AND DISPOSAL OF PORTIONS OF ABUTMENT 2 AS DETAILED IN THE CONTRACT PLANS.
    - REMOVAL OF ANY PORTION OF ABUTMENT 1 NOT REMOVED UNDER ITEMS 204.25 "STRUCTURE EXCAVATION" OR 203.27 "UNCLASSIFIED CHANNEL EXCAVATION".
  11. THESE PLANS WERE PREPARED BASED ON INFORMATION OBTAINED FROM FIELD MEASUREMENTS. THE CONTRACTOR MAY BE REQUIRED TO MAKE CHANGES TO THE DIMENSIONS SHOWN ON THE PLANS TO FIT THE ACTUAL FIELD CONDITIONS. THE CONTRACTOR SHALL FIELD VERIFY AND/OR OBTAIN ALL DIMENSIONS PRIOR TO FABRICATION.
  12. THE ITEM 502.10 "SHORING SUPERSTRUCTURE" SHALL BE PAYMENT FOR SUPPORTING THE SUPERSTRUCTURE WHILE TRUSS COMPONENTS, SUBSTRUCTURES, AND BEARINGS ARE BEING PLACED. THE CONTRACTOR MAY CHOOSE TO MOVE THE TRUSS, SO THAT WORK MAY BE CONDUCTED AT A STAGING AREA. PAYMENT FOR REMOVAL AND REPLACEMENT SHALL BE INCLUDED UNDER ITEM 502.10.
- ## PAINING NOTES
13. THE SURFACE PREPARATION OF THE EXISTING STEEL SHALL INCLUDE 100% REMOVAL OF THE EXISTING PAINT SYSTEM.
  14. THE COLOR OF THE FINAL COAT OF PAINT SHALL BE GREEN AND SHALL CONFORM WITH FEDERAL STANDARD NO. 595, COLOR CHIP #14062.
  15. AFTER THE FINAL COAT OF PAINT HAS BEEN APPLIED, AND HAS THOROUGHLY CURED, THE FOLLOWING STRUCTURAL STEEL SHALL BE GREASED PER SPECIFICATION 513:
    - FLOOR BEAMS
    - ALL TRUSS COMPONENTS BELOW THE TOP OF CURB
    - BEARINGS
  16. PAYMENT FOR THE GREASE SHALL BE INCIDENTAL TO THE ITEM 513.30 "STRUCTURAL PAINTING FIELD APPLIED". THE COLOR OF THE GREASE SHALL BE GREEN.
  17. ALL NEW STEEL ELEMENTS PROVIDED UNDER ITEM 506.50 "STRUCTURAL STEEL (ROLLED BEAM)" SHALL BE GIVEN AN APPROVED SHOP APPLIED PAINT SYSTEM PER SPECIFICATION 513. ALL EXISTING STEEL AND NEW STEEL UNDER THE ITEM 506.60 "STRUCTURAL STEEL", EXCEPT STEEL TO BE GALVANIZED, SHALL BE GIVEN A FIELD APPLIED PAINT SYSTEM PER SPECIFICATION 513.
  18. THE PAINT SYSTEM USED IN THE FIELD AND THE SHOP APPLIED PAINT SYSTEMS SHALL BE COMPATIBLE AND PROVIDED FROM THE SAME MANUFACTURER.
  19. ALL FAYING SURFACES SHALL MEET THE CLASS "B" SLIP COEFFICIENT AS SPECIFIED IN THE "AASHTO STANDARD SPECIFICATIONS FOR HIGHWAY BRIDGES". THE FAYING SURFACES ON THE TRUSS WHERE THE NEW FLOOR BEAMS CONNECT SHALL BE BLAST CLEANED AND PRIMED IN ACCORDANCE WITH SPECIFICATION 513, PRIOR TO THE INSTALLATION OF THE NEW STEEL ELEMENTS.

## CONCRETE NOTES

20. THE MINIMUM COVER FOR REINFORCING STEEL IN THE SUBSTRUCTURES SHALL BE TWO INCHES ALONG WALL FACES AGAINST EARTH, AND THREE INCHES ELSEWHERE UNLESS DETAILED OTHERWISE.
21. REINFORCING STEEL PLACEMENT TOLERANCES SHALL BE AS FOLLOWS:

SPACING	+/- 1"
CLEARANCE	+/- 1/4"
22. ALL EXPOSED EDGES OF CONCRETE SHALL BE CHAMFERED 1" X 1".
23. WATER REPELLENT SHALL BE APPLIED TO ALL EXPOSED CONCRETE SURFACES.
24. JOINTS AND SCORE MARKS IN CONCRETE SHALL BE CONSTRUCTED AS INDICATED ON THE PLANS OR AS DIRECTED BY THE ENGINEER.
25. SURFACES OF BRIDGE SEATS UNDER THE BEARING DEVICES SHALL BE LEVEL. OTHER AREAS OF THE BRIDGE SEAT SHALL BE SLOPED 2.0%. THE ABUTMENT SEATS SHALL BE SLOPED FULL WIDTH TOWARD MIDSPAN. THE ENTIRE BRIDGE SEAT SURFACE SHALL BE GIVEN A MAGNESIUM FLOAT FINISH.
26. CONCRETE PORTIONS OF THE ABUTMENT ABOVE THE ADJACENT BRIDGE SEAT ELEVATIONS SHALL NOT BE PLACED UNTIL THE TRUSS HAS BEEN PLACED AND FINISH GRADE HAS BEEN DETERMINED BY THE RESIDENT ENGINEER.
27. THE KEY IN CONCRETE CONSTRUCTION JOINTS SHALL BE MONOLITHIC AND CONTINUOUS FOR THE FULL LENGTH OF THE JOINT. UPWARD KEYS SHALL BE PLACED INTEGRALLY WITH THE CONCRETE BELOW THE JOINT.


## STEEL NOTES

28. THE NEW FLOORBEAMS, LATERAL BRACING, AND NEW TRUSS MEMBERS SHALL BE PAID FOR UNDER THE ITEM 506.50 "STRUCTURAL STEEL (ROLLED BEAM)". ALL OTHER PLATES, ANGLES, NEW LATTICE RAILING, AND STRUCTURAL TUBING FOR DOWN SPOUT SHALL BE INCLUDED UNDER THE ITEM 506.60 "STRUCTURAL STEEL".
29. ALL STRUCTURAL STEEL PAID FOR UNDER THE ITEM 506.50 "STRUCTURAL STEEL (ROLLED BEAM)" AND ITEM 506.60 "STRUCTURAL STEEL" SHALL CONFORM TO AASHTO M-270 GRADE 50. EXCEPT ALL STRUCTURAL TUBING SHALL CONFORM TO ASTM A-500 GRADE B.
30. ALL NEW STRUCTURAL STEEL ELEMENTS SUBJECT TO TENSION SHALL BE CHARPY V-NOTCH TESTED. THESE MEMBERS ARE DESIGNATED BY (CVN) IN THE APPLICABLE DETAILS. ANY REPAIRS ORDERED BY THE ENGINEER SUBJECT TO TENSION WILL ALSO REQUIRE CHARPY V-NOTCH TESTING.
31. ANY RIVETS THAT ARE REMOVED FOR REPAIRS DETAILED ON THE PLANS OR AS ORDERED BY THE ENGINEER SHALL BE REPLACED WITH 3/4" DIAMETER HIGH STRENGTH BOLTS MEETING AASHTO M-164 TYPE 1. ALL BOLTS SHALL BE FULL DIAMETER BODY ROUND HEAD BOLTS MEETING ANSI/ASME B 18.5 REQUIREMENTS, EXCEPT BOLTS FOR THE NEW LATTICE RAILING SHALL BE 7/16" DIAMETER, AND BOLTS FOR THE NEW COVER PLATE SHALL BE 3/8" DIAMETER, MEETING THE REQUIREMENTS ABOVE.
32. CONNECTIONS NOT DETAILED SHALL BE DETAILED BY THE FABRICATOR AND SUBMITTED TO THE PROJECT MANAGER FOR APPROVAL.
33. ALL BOLTS SHALL BE GALVANIZED IN ACCORDANCE WITH AASHTO M-298. FASTENERS FOR THE TRUSS SHALL RECEIVE INTERMEDIATE AND FINAL COATS OF PAINT AFTER INSTALLATION. FASTENERS FOR THE GLULAM DECK SHALL BE GALVANIZED ONLY.
34. EXISTING FLOOR BEAMS, STRINGERS, AND TRUSS MEMEBERS THAT ARE REMOVED SHALL BECOME PROPERTY OF THE CONTRACTOR. THE EXISTING STEEL IS PAINTED WITH A MATERIAL THAT MAY CONTAIN LEAD. THE CONTRACTOR MAY DISPOSE OF IT OR RETAIN IT FOR FUTURE USE. THE CONTRACTOR SHALL INFORM THE RESIDENT ENGINEER OF HIS/HER PLANS FOR DISPOSAL OR RETENTION OF THE STEEL PRIOR TO ITS REMOVAL.
35. THE EDGES OF THE GUSSET PLATES SHALL BE CAULKED AT THE LOCATION WHERE THEY MEET THE TRUSS MEMBERS. THE CAULK SHALL BE APPLIED BEFORE THE FINAL COAT OF PAINT. THE CONTRACTOR SHALL SUBMIT TO THE PROJECT MANAGER THE TYPE OF CAULK TO BE USED ALONG WITH THE MANUFACTURER'S RECOMMENDED USE. PAYMENT FOR THE CAULKING SHALL BE INCIDENTAL TO ITEM 513.30 "STRUCTURAL PAINTING, FIELD APPLIED".

## LEDGE NOTES


36. NO LEDGE SHALL BE EXCAVATED TO PLACE THE STONE FILL TYPE III. ANY SMOOTH LEDGE SHALL BE MECHANICALLY ROUGHENED TO KEY IN THE STONE FILL IF DEEMED NECESSARY BY THE RESIDENT ENGINEER. PAYMENT FOR ROUGHENING THE LEDGE SHALL BE CONSIDERED INCIDENTAL TO STONE FILL TYPE III.
37. ABUTMENT 1 SHALL BE FOUNDED ON LEDGE WHICH HAS BEEN CLEANED OF ALL LOOSE ROCK AND OTHER DEBRIS. THE LEDGE SHALL BE REMOVED AS REQUIRED TO ENSURE PLACEMENT ON COMPETENT ROCK. PAYMENT FOR ANY LEDGE REMOVAL SHALL BE INCLUDED UNDER ITEM 204.25 "STRUCTURE EXCAVATION".
38. DOWELS SHALL BE DRILLED AND GROUTED INTO LEDGE AT ABUTMENT 1 AND INTO EXISTING CONCRETE AT ABUTMENT 2 AS SHOWN ON THE PLANS. THE DOWELS SHALL HAVE A 2'-0" EMBEDMENT LENGTH AND SHALL EXTEND INTO THE NEW CONCRETE A MINIMUM OF 1'-6" UNLESS NOTED OTHERWISE. THE DRILLING AND GROUTING SHALL BE PAID FOR UNDER THE ITEM 507.16 "DRILLING AND GROUTING DOWELS", HOWEVER THE DOWELS SHALL BE PAID FOR UNDER THE ITEM 507.15 "REINFORCING STEEL".
39. UPON COMPLETION OF THE STRUCTURE EXCAVATION, AND PRIOR TO THE PLACING OF THE CONCRETE FORMS, THE RESIDENT ENGINEER SHALL CONTACT THE SOILS AND FOUNDATIONS ENGINEER/ENGINEERING GEOLOGIST FROM THE VERMONT AGENCY OF TRANSPORTATION, TO INSPECT THE ROCK TO DETERMINE IF IT IS COMPETENT TO SUPPORT THE DESIGN BEARING PRESSURE SHOWN ON THE PLANS. THE GEOLOGIST SHALL BE ALLOWED 5 WORKING DAYS FROM NOTICE OF EXCAVATION TO MAKE HIS INSPECTION AND REPORT HIS DETERMINATION ON THE COMPETENCY OF THE ROCK.

PROJECT: NEW HAVEN - WEYBRIDGE	PROJECT NO. : BHO-BTN 2005 (1)
DESIGN FILE NAME: 89j081/structures/sj081notes.dgn	
IPARM FILE NAME: sj081notes.i	PLOT DATE: 28-FEB-2007
DESIGNED BY: R.S. YOUNG	DRAWN BY: R.S. YOUNG
SQUAD LEADER: C.P. WILLIAMS	CHECKED BY: W.B. SYMONDS
GENERAL NOTES	SHEET: 12 OF 53

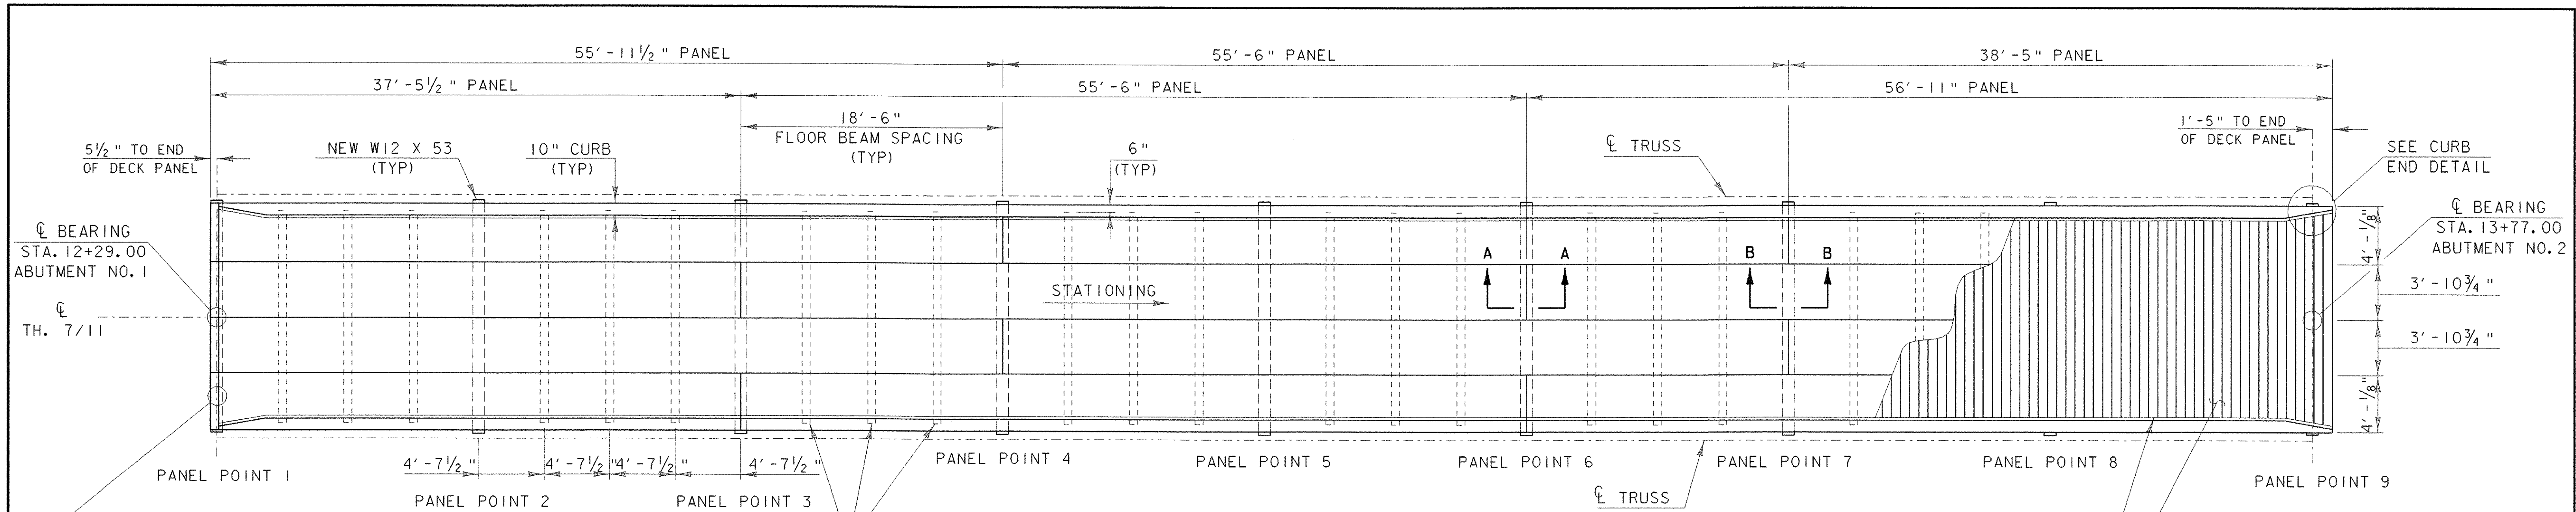


**DECK LAYOUT**

SCALE  $\frac{3}{16}'' = 1'-0$   
 1 0 2 4 6 8

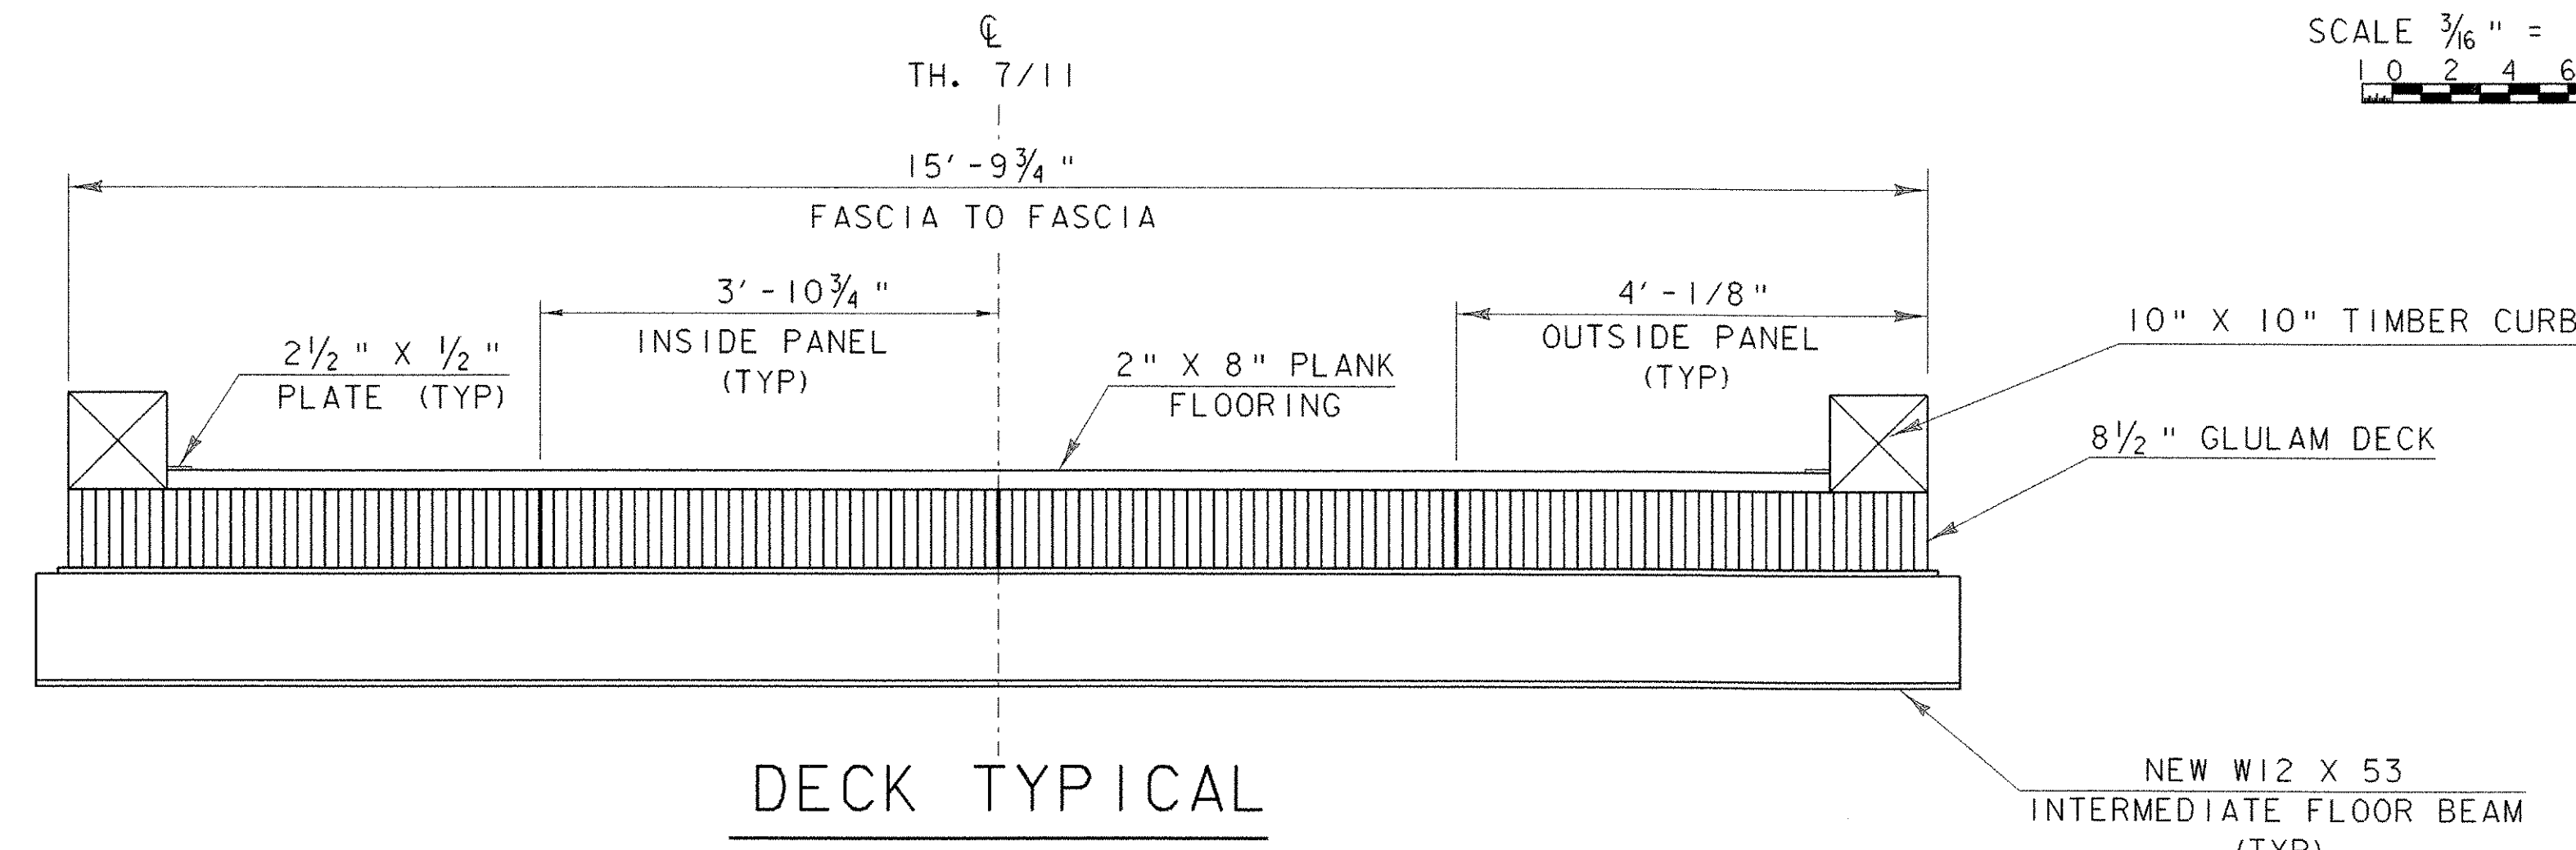


**DECK TYPICAL**

SCALE  $\frac{3}{4}'' = 1'-0$   
 0 1 2

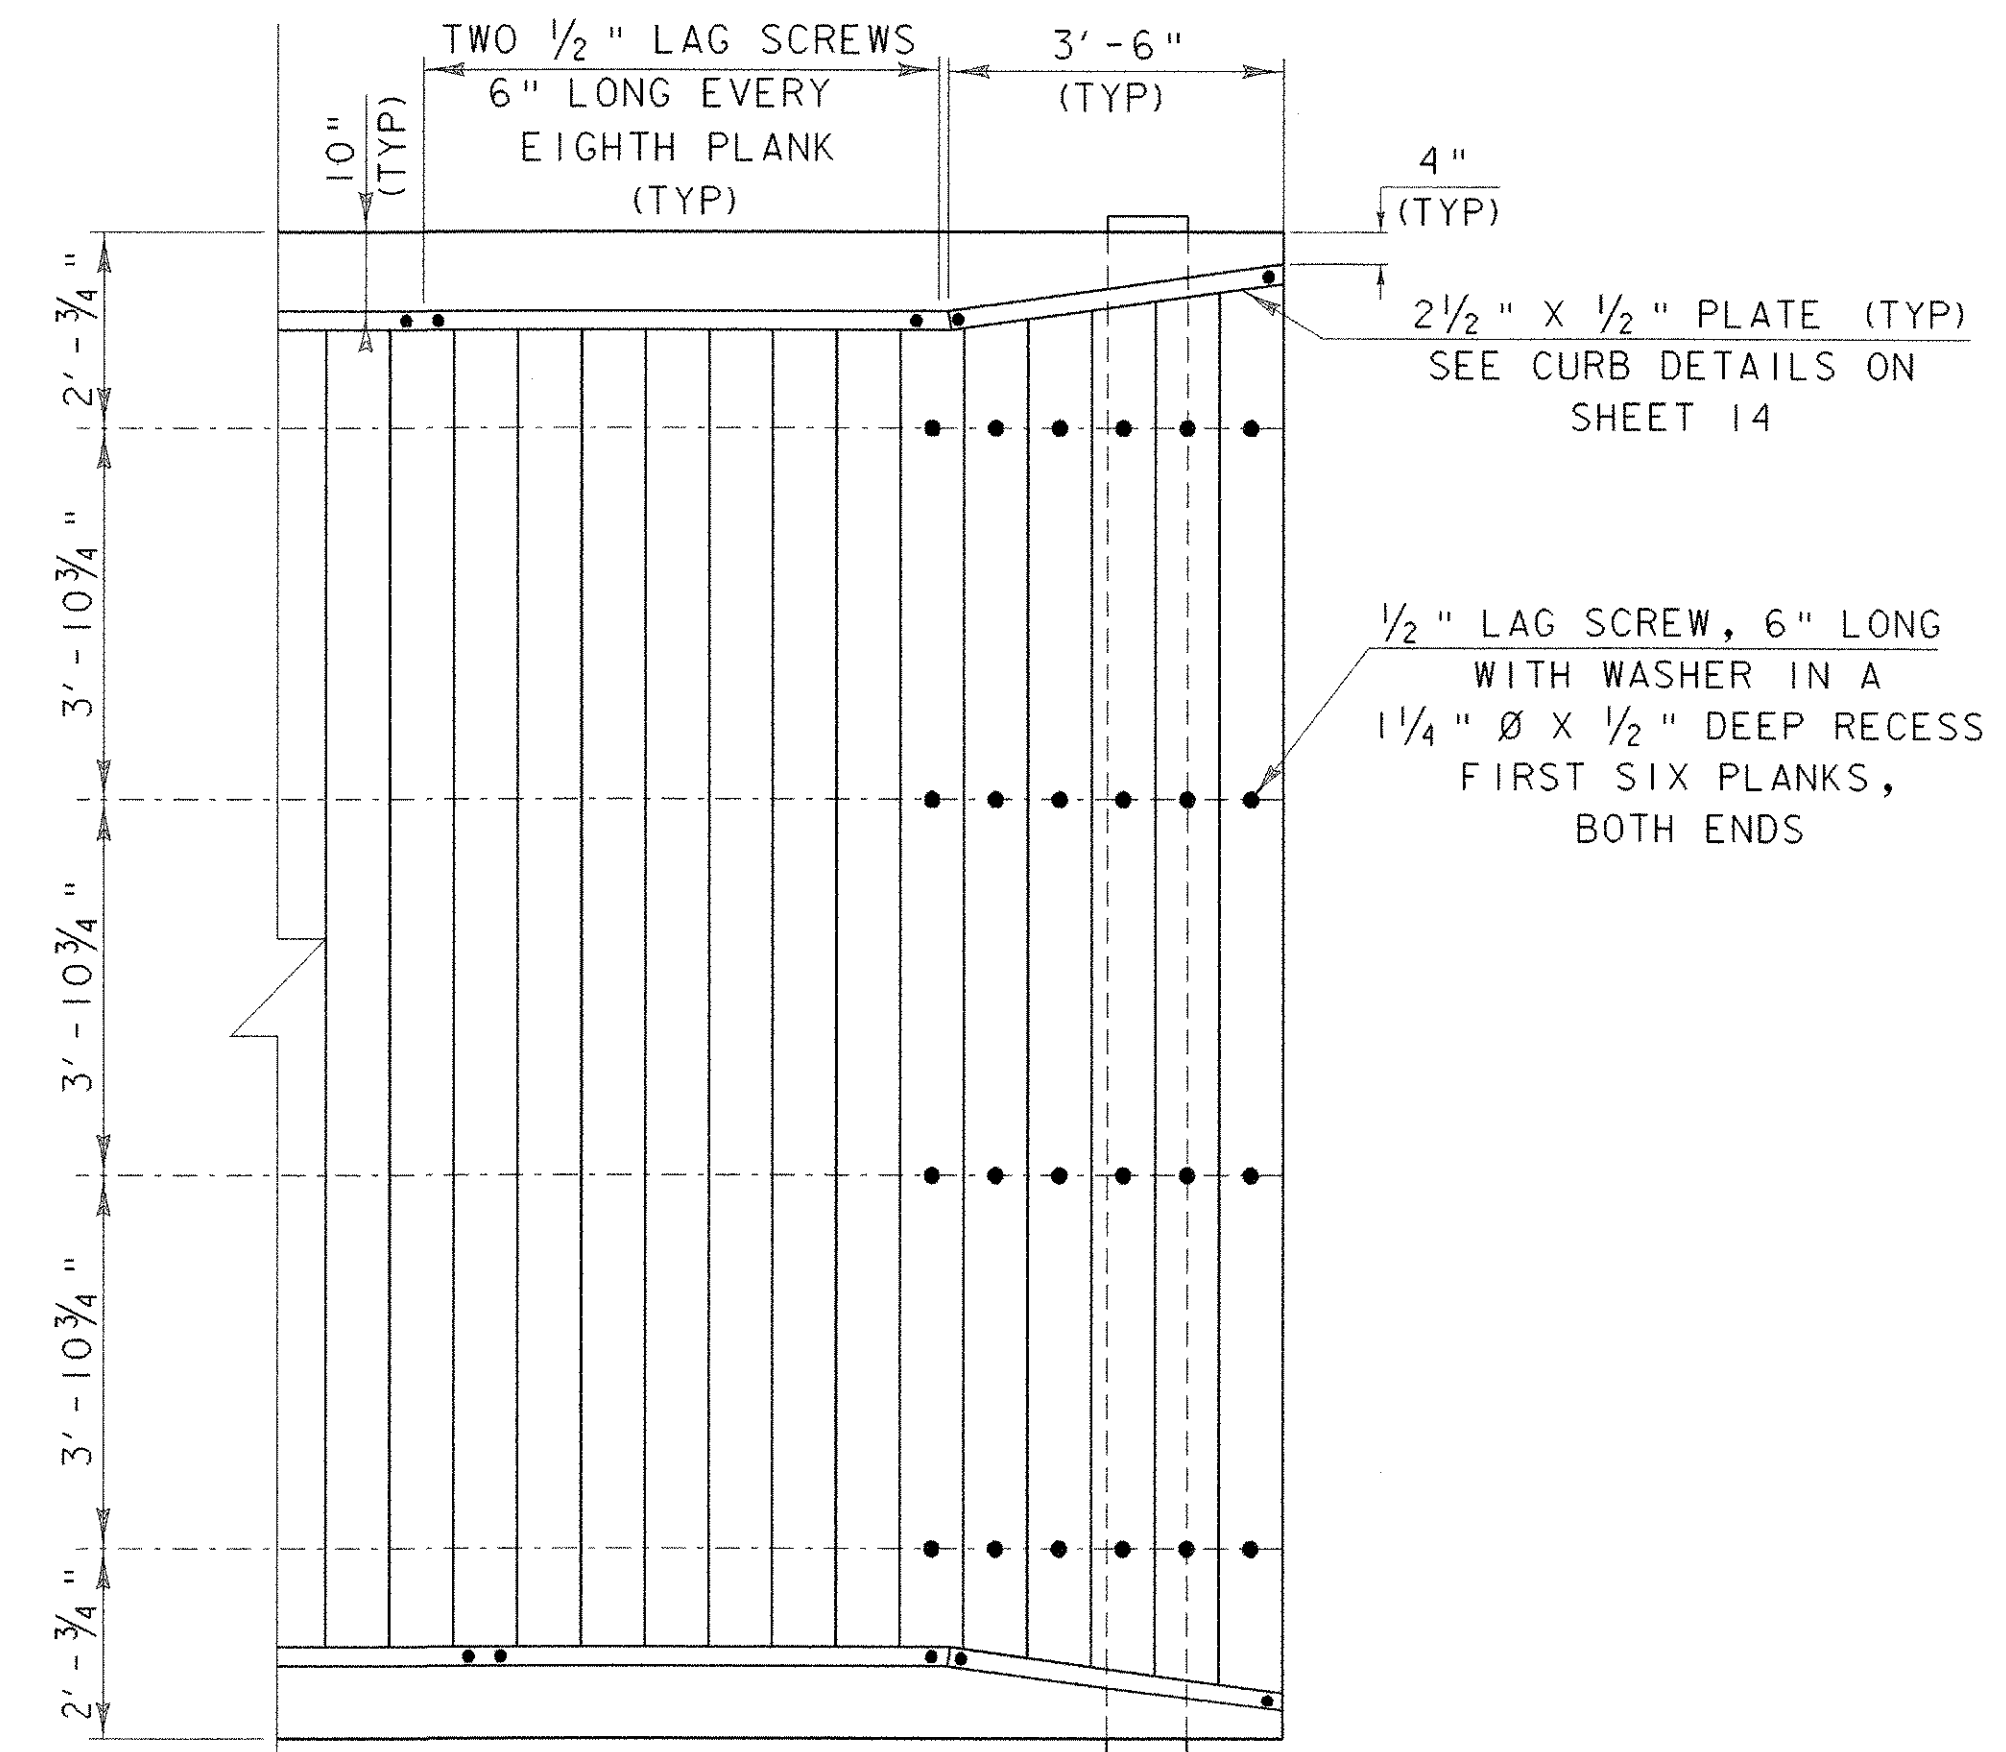


**DECK AND CURB DETAIL**

SCALE  $\frac{1}{2}'' = 1'-0$   
 0 1 2

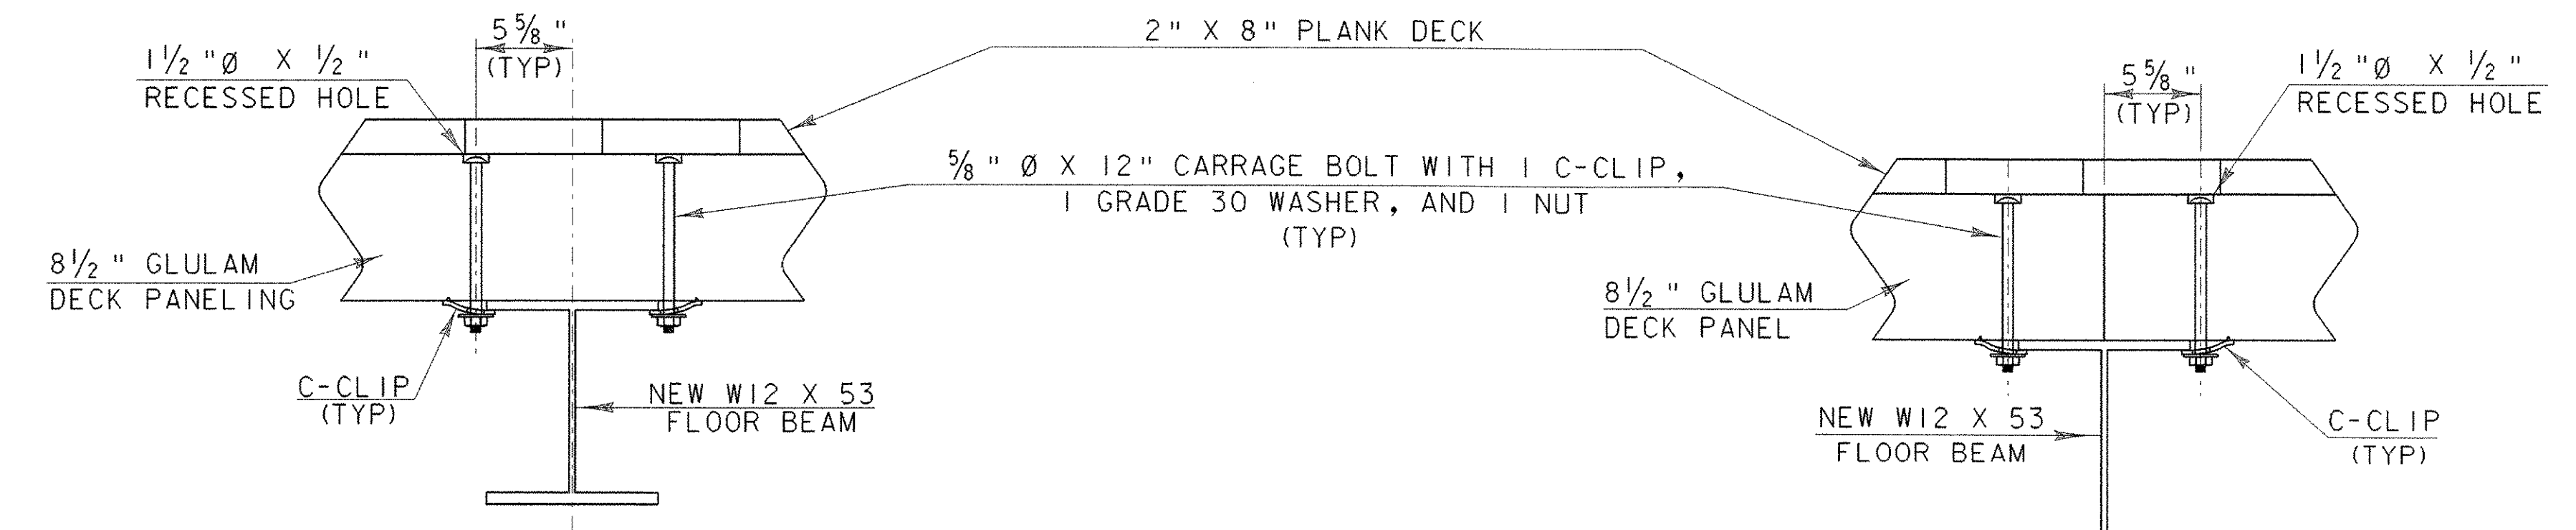

**SECTION B-B  
INTERMEDIATE PANEL CONNECTION**


SCALE  $1 \frac{1}{2}'' = 1'-0$   
 9 6 3 0

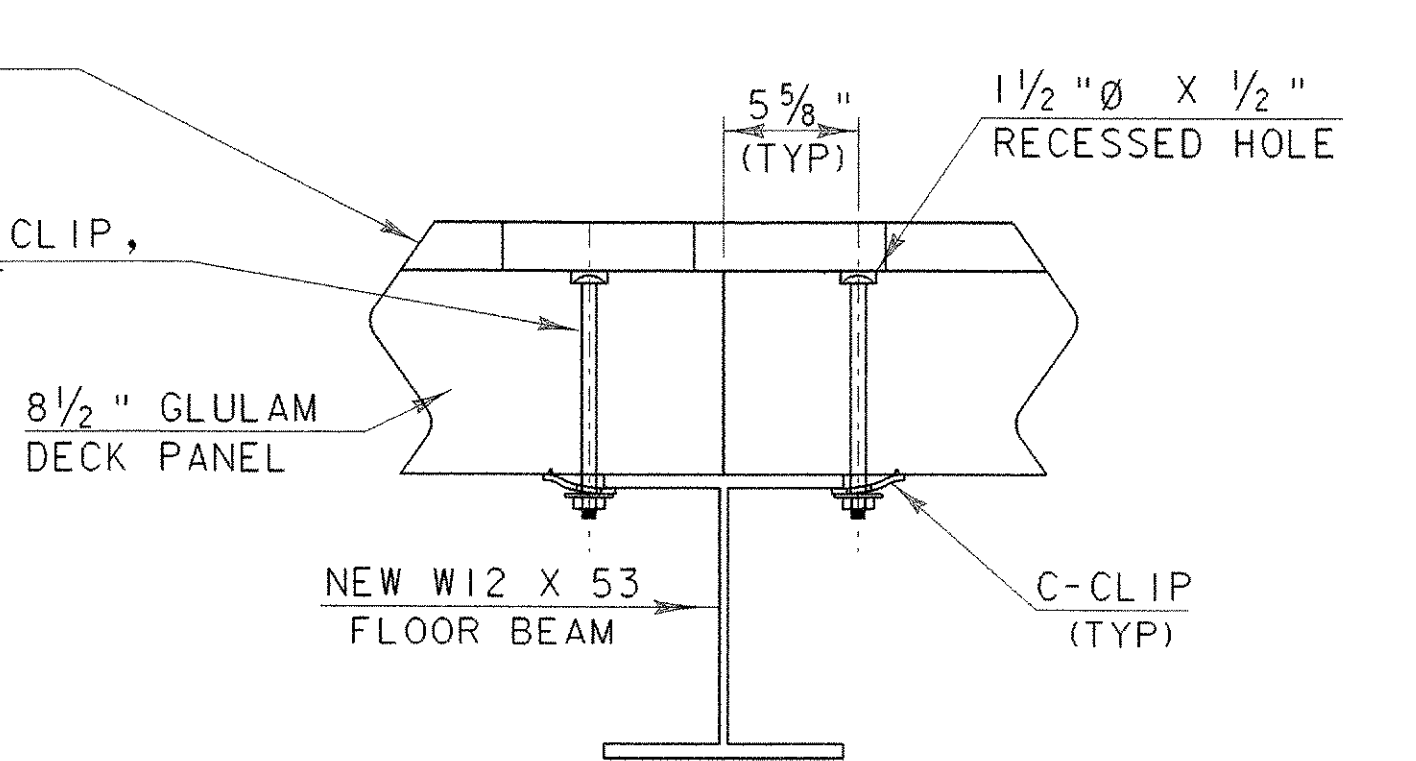

**SECTION A-A  
CONNECTION AT PANEL JOINT**

SCALE  $1 \frac{1}{2}'' = 1'-0$   
 1 9 6 3 0

PROJECT: <b>NEW HAVEN-WEYBRIDGE</b>	PROJECT NO.: <b>BHO-BTN 2005 (1)</b>
DESIGN FILE NAME: 89j081/structures/sj081deck.dgn	PLOT DATE: 28-FEB-2007
IPARM FILE NAME: deckplan.i	DESIGNED BY: R. S. YOUNG
SQUAD LEADER: C. P. WILLIAMS	DRAWN BY: D. A. ECKSTEIN
DECK DETAILS SHEET 1	CHECKED BY: R. S. YOUNG
	SHEET: 13 OF 53

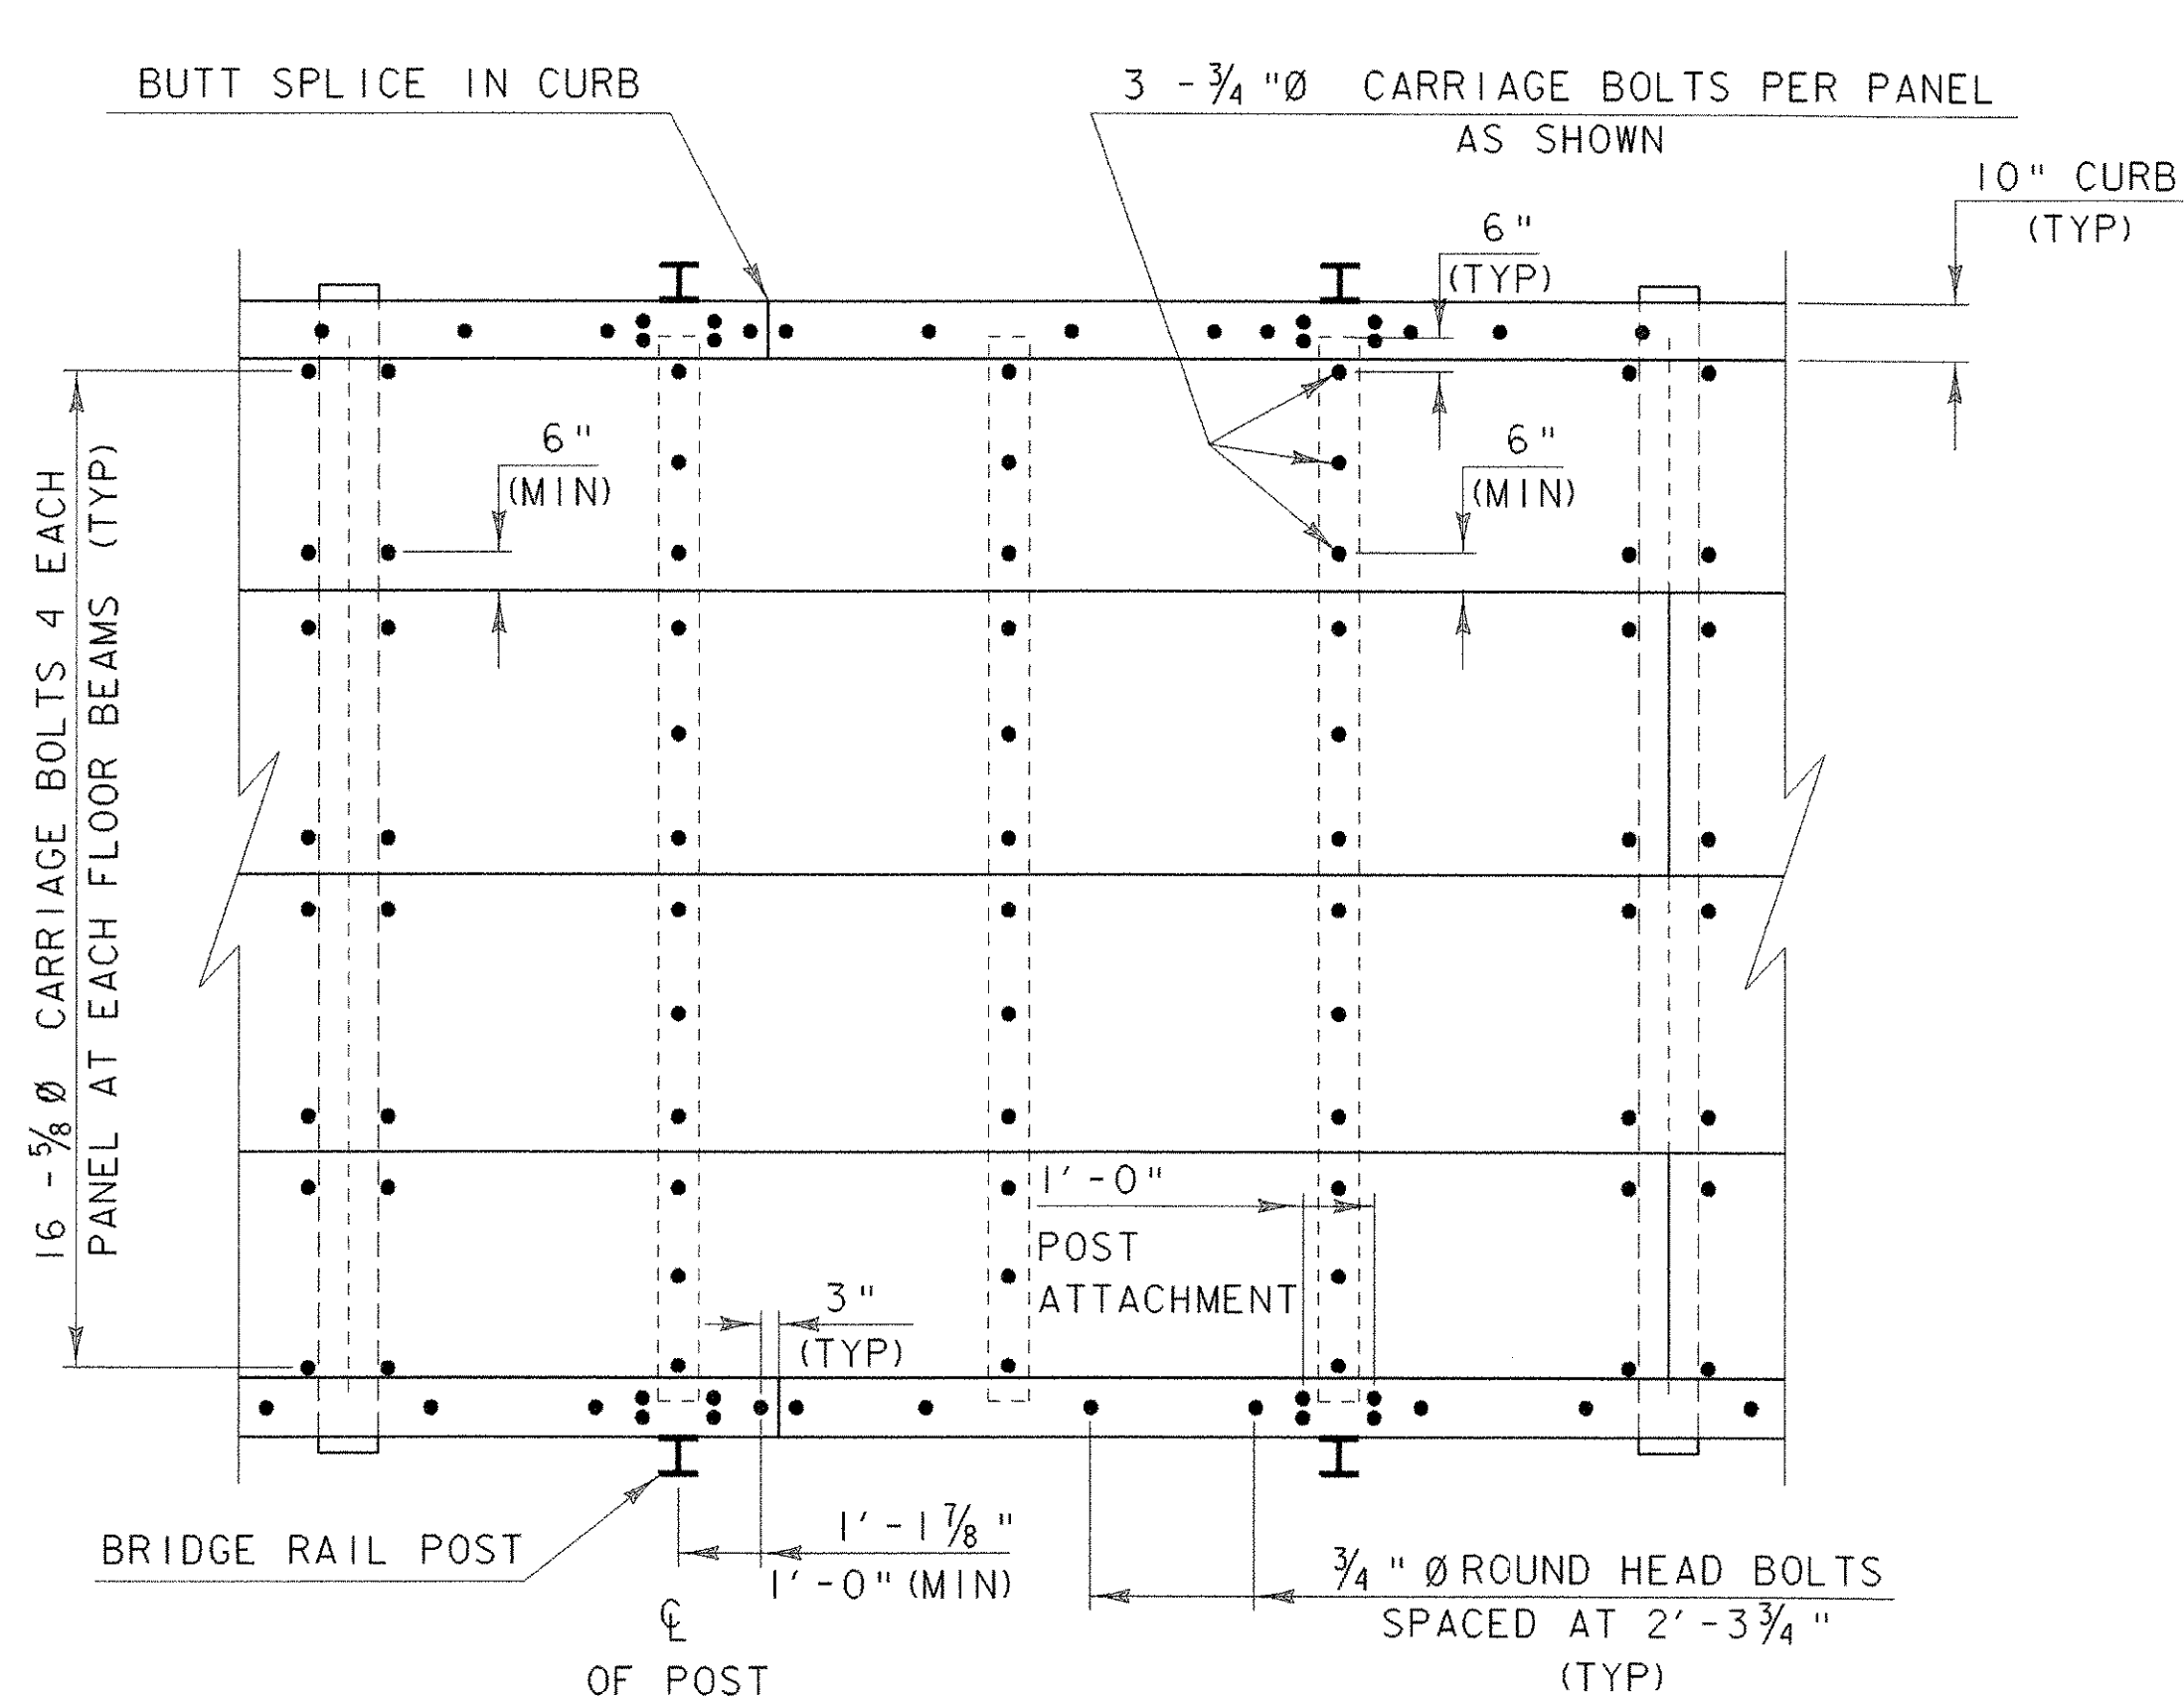


### BOLT DETAILS

(PLANK DECKING NOT SHOWN FOR CLARITY)


NOTE: SPLICE LOCATIONS OF CURB SHALL BE A MINIMUM 1'-3" FROM CL OF POST

SCALE 3/8" = 1'-0"

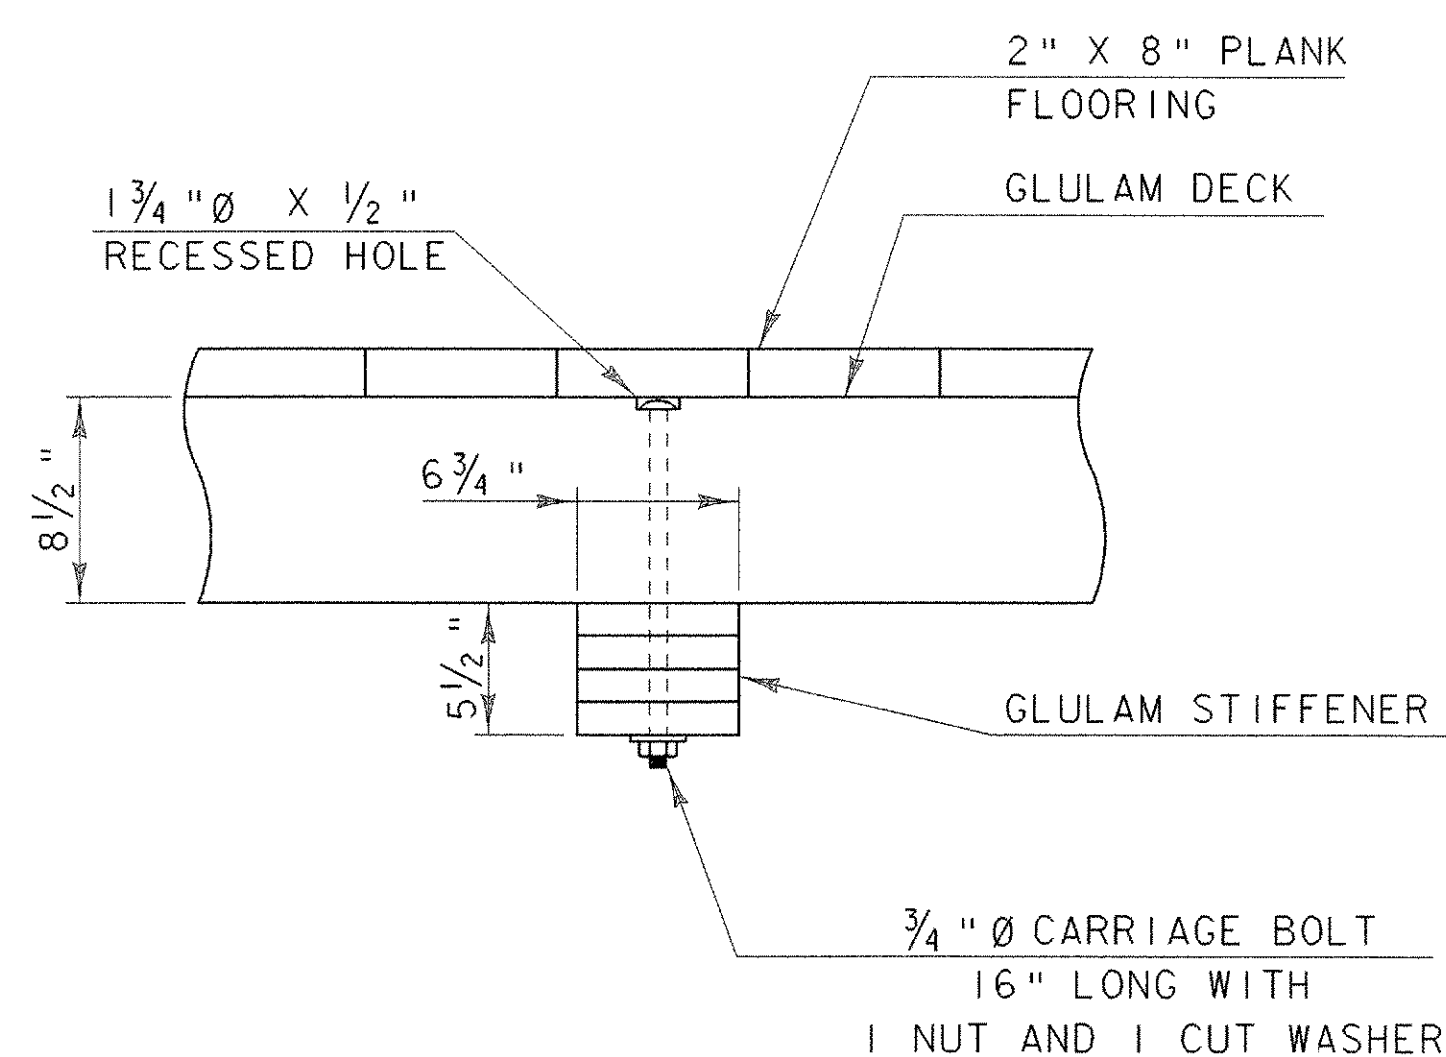


### TRANSVERSE STIFFENER DETAIL

SCALE 1/2" = 1'-0"

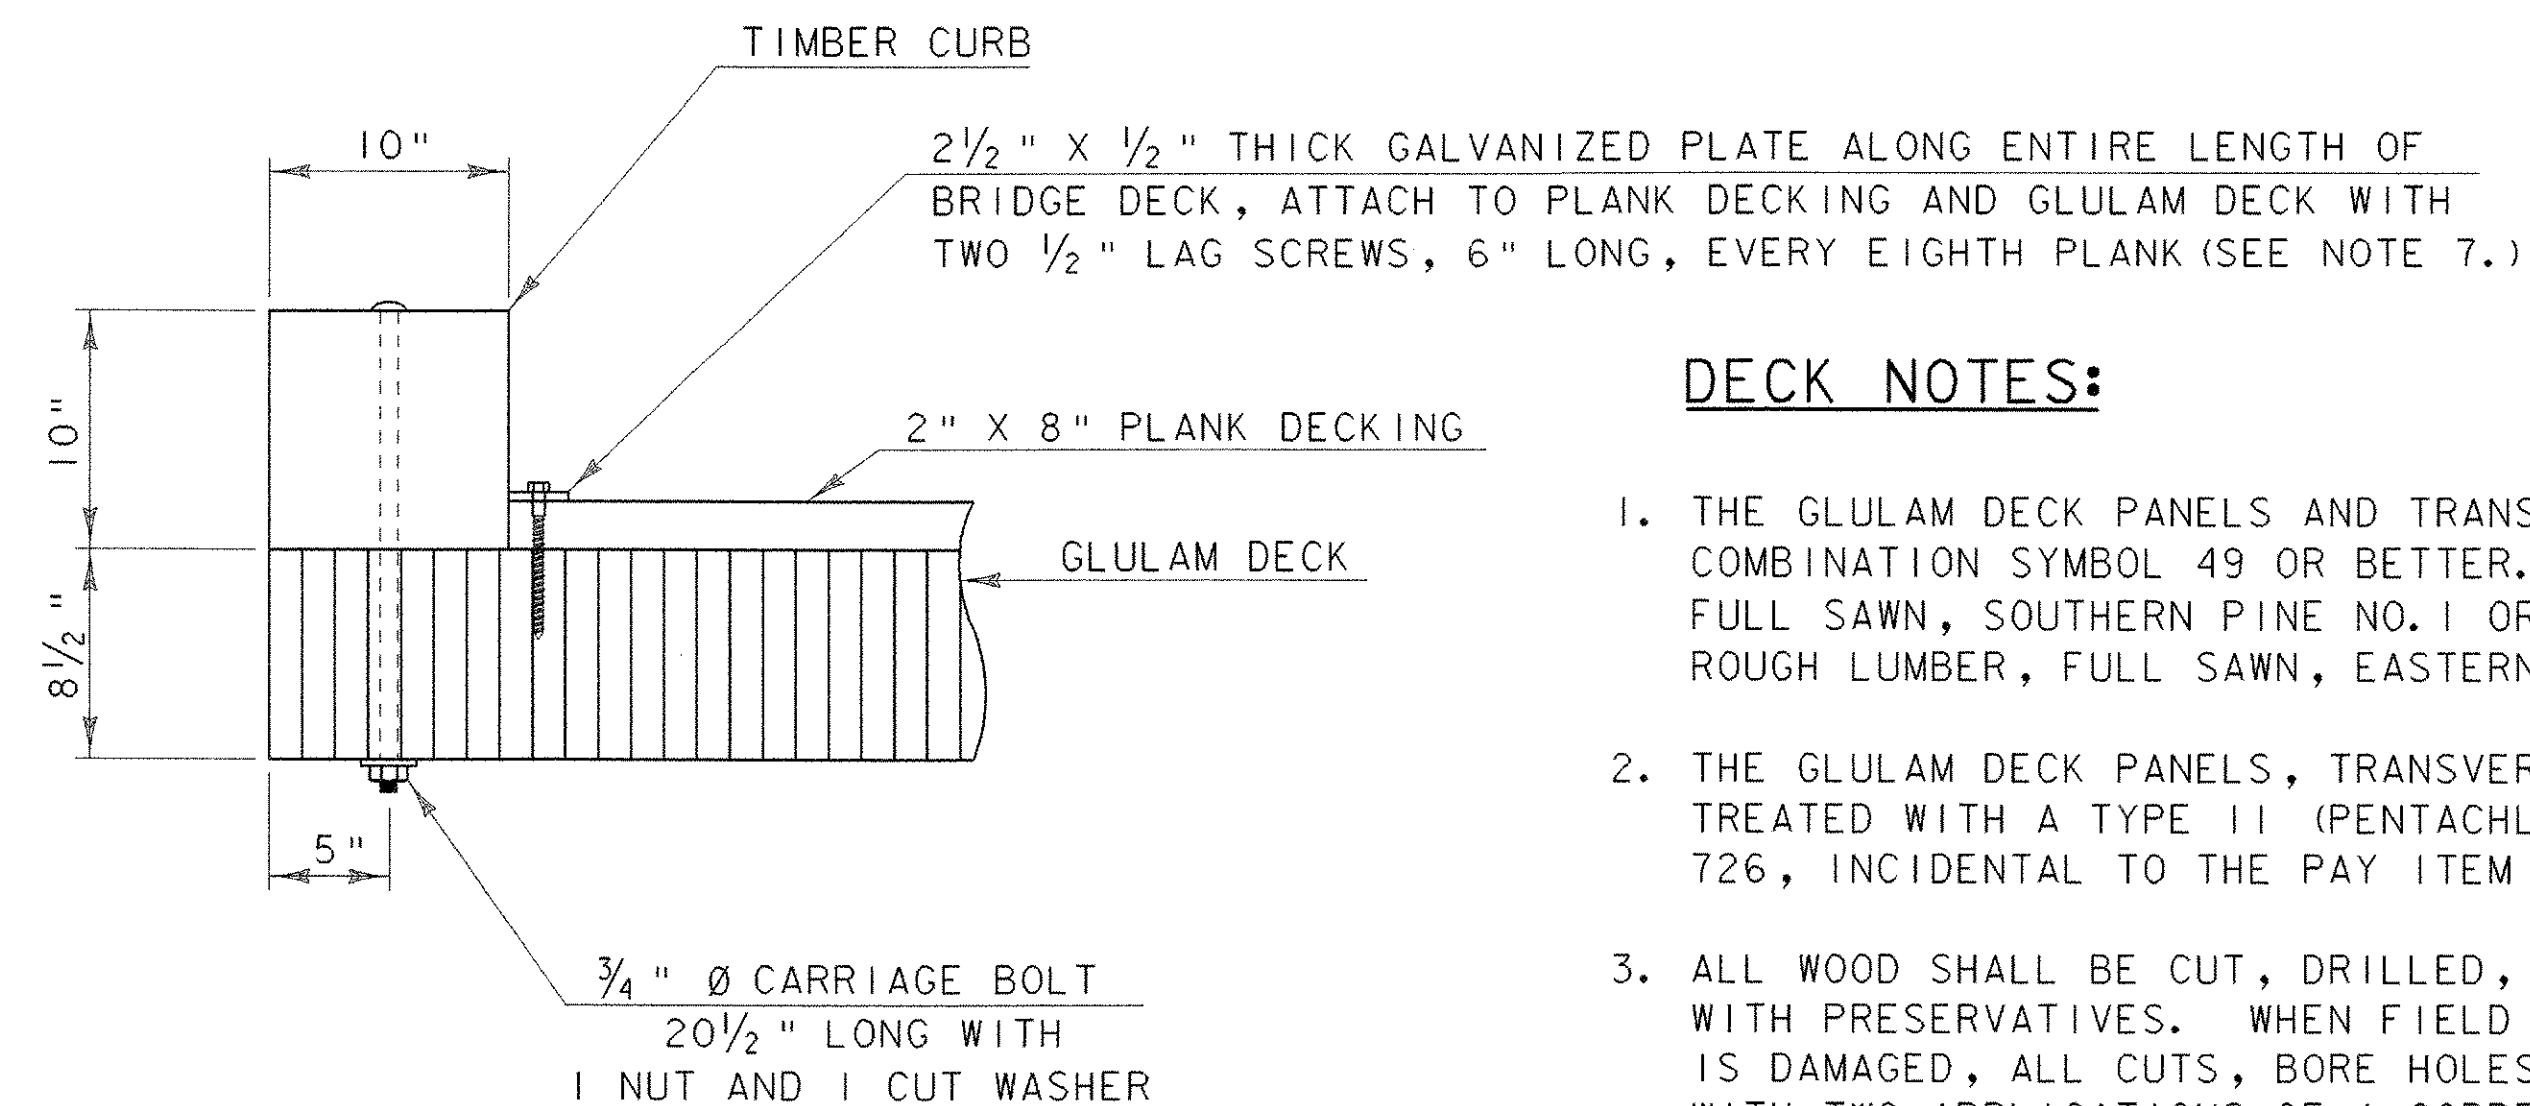

### CURB DETAIL

SCALE 1/2" = 1'-0"

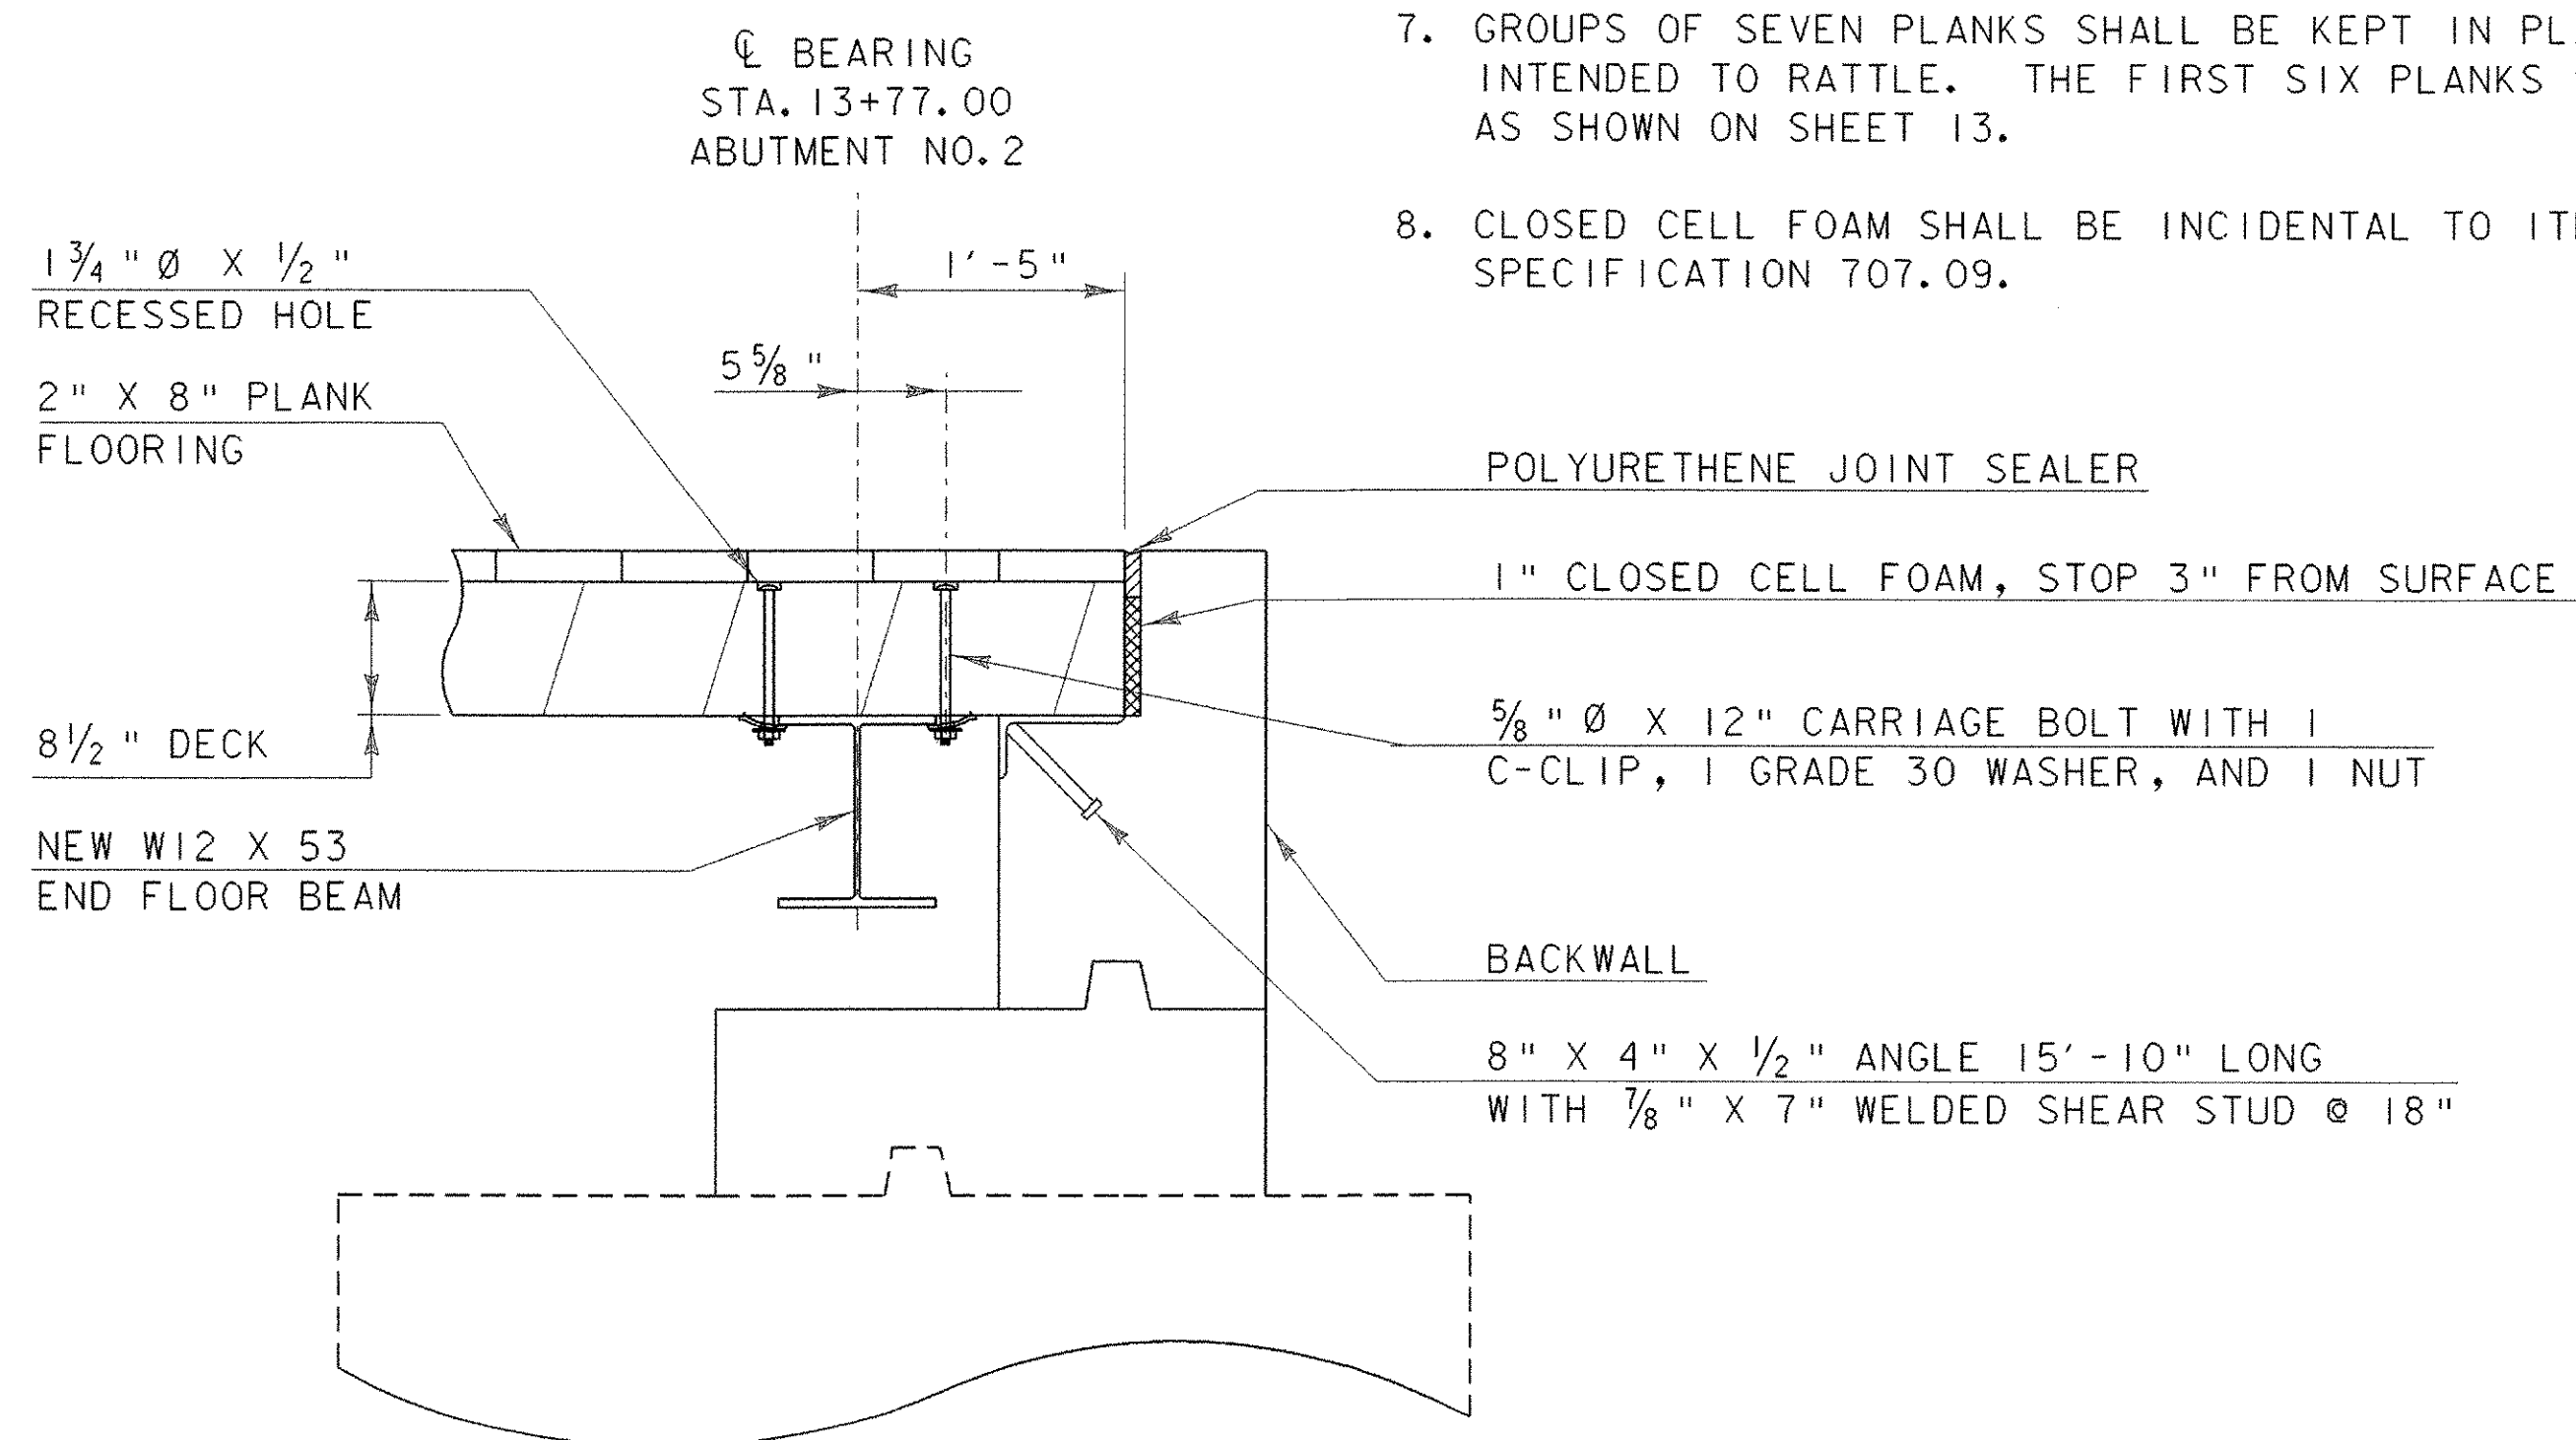

### FIXED END BRIDGE DETAIL AT ABUTMENT 2


(SEE SHEETS 23 AND 24 FOR HOLE LOCATIONS AT ABUTMENT 1)

SCALE 1" = 1'-0"

### DECK NOTES:

1. THE GLULAM DECK PANELS AND TRANSVERSE STIFFENERS SHALL BE SOUTHERN PINE, COMBINATION SYMBOL 49 OR BETTER. THE CURB SHALL BE 10" X 10" ROUGH LUMBER, FULL SAWN, SOUTHERN PINE NO. 1 OR BETTER. THE PLANK DECKING SHALL BE 2" X 8", ROUGH LUMBER, FULL SAWN, EASTERN HEMLOCK NO. 1 OR BETTER.
2. THE GLULAM DECK PANELS, TRANSVERSE STIFFENERS, AND THE TIMBER CURB SHALL BE TREATED WITH A TYPE II (PENTACHLOROPHENOL) PRESERVATIVE PER SPECIFICATION 726, INCIDENTAL TO THE PAY ITEM OF THE WOOD TREATED.
3. ALL WOOD SHALL BE CUT, DRILLED, AND COMPLETELY FABRICATED PRIOR TO TREATMENT WITH PRESERVATIVES. WHEN FIELD FABRICATION OF WOOD IS REQUIRED OR IF WOOD IS DAMAGED, BORE HOLES, AND DAMAGE SHALL BE IMMEDIATELY TREATED WITH TWO APPLICATIONS OF A COPPER NAPHTHENATE SOLUTION.
4. THE GLULAM DECK PANELS AND TRANSVERSE STIFFENERS SHALL BE PAID FOR UNDER ITEM 522.40 "STRUCTURAL GLUED LAMINATED TIMBER." THE CURB SHALL BE PAID FOR UNDER 522.35 "NONSTRUCTURAL LUMBER, TREATED." THE PLANK DECKING SHALL BE PAID FOR UNDER ITEM 522.30 "NONSTRUCTURAL LUMBER, UNTREATED."
5. BOLTS SHALL BE ASTM A307. BOLTS, NUTS, WASHERS, AND C-CLIPS SHALL BE INCLUDED UNDER THE ITEM 522.40 "STRUCTURAL GLUED LAMINATED TIMBER." ALL HARDWARE SHALL BE GALVANIZED.
6. THE ANGLE USED AT ABUTMENT #2, AND PLATES USED TO ATTACH PLANK FLOORING, SHALL BE INCLUDED UNDER ITEM 506.60 "STRUCTURAL STEEL", AND SHALL BE GALVANIZED IN ACCORDANCE WITH AASHTO M111. THE SHEAR STUDS SHALL BE PAID FOR UNDER ITEM 508.15 "SHEAR CONNECTORS".
7. GROUPS OF SEVEN PLANKS SHALL BE KEPT IN PLACE BY THE 1/2" PLATE ONLY. THEY ARE INTENDED TO RATTLE. THE FIRST SIX PLANKS SHALL BE ATTACHED WITH LAG SCREWS AS SHOWN ON SHEET 13.
8. CLOSED CELL FOAM SHALL BE INCIDENTAL TO ITEM 522.40 AND SHALL CONFORM TO SPECIFICATION 707.09.


PROJECT: NEW HAVEN-WEYBRIDGE	PROJECT NO.: BHO-BTN 2005 (1)
DESIGN FILE NAME: 89j081/structures/sj081deck.dgn	PLOT DATE: 28-FEB-2007
IPARM FILE NAME: deckdt1.i	DRAWN BY: D. A. ECKSTEIN
DESIGNED BY: R. S. YOUNG	CHECKED BY: R. S. YOUNG
SQUAD LEADER: C. P. WILLIAMS	SHEET: 14 OF 53
DECK DETAILS SHEET 2	

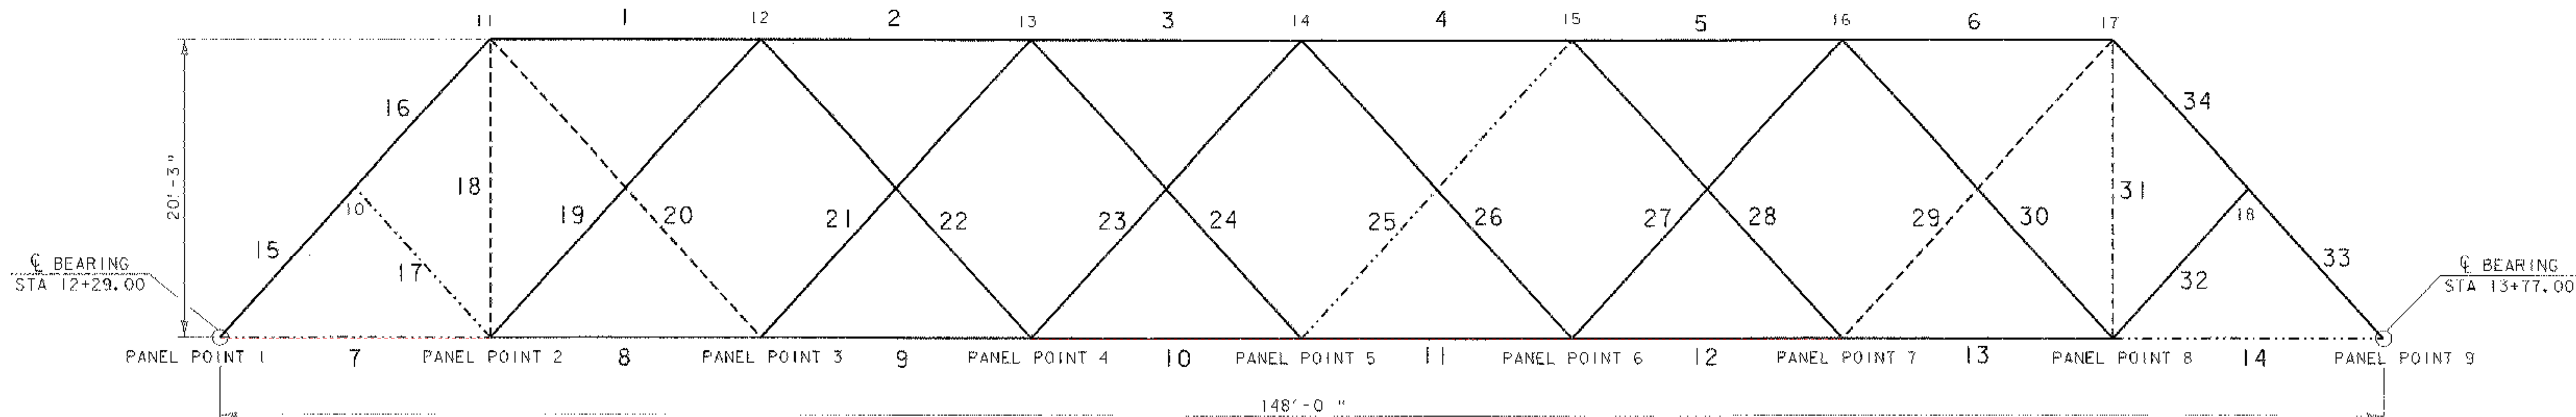

**TRUSS MEMBER REPLACEMENT CHART**

-----	MEMBERS TO BE REPLACED IN KIND WITH GRADE 50 STEEL ALL ANGLES SHALL BE CHARPY V-NOTCH TESTED - 18,31 ARE TWO 3" X 2 1/2" X 1/4" ANGLES - 20,29 ARE TWO 3" X 2 1/2" X 1/4" ANGLES
—————	MEMBERS TO BE REPLACED IN KIND WITH GRADE 50 STEEL IF MORE THAN 25% SECTION LOSS
- - - - -	MEMBERS TO BE REPLACED IN KIND WITH GRADE 50 STEEL ON THE UPSTREAM SIDE ONLY: ALL ANGLES SHALL BE CHARPY V-NOTCH TESTED - 17 IS TWO 3 1/2" X 2 1/2" X 1/4" ANGLES - 7,14 ARE FOUR 3" X 2 1/2" X 1/4" ANGLES - 25 IS TWO 2 1/2" X 2 1/2" X 1/4" ANGLES

**TRUSS ELEVATION (TYP) (LOOKING WEST)**

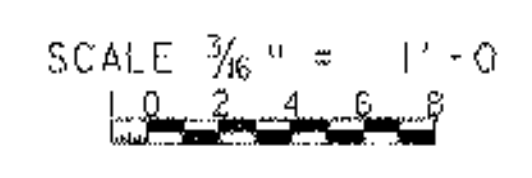


10, 11 ARE FOUR 3 1/2" X 3" X 1/4" ANGLES  
7 IS FOUR 3" X 2 1/2" X 1/4" ANGLE

12 IS FOUR 3 1/2" X 3" X 1/4" ANGLES  
(2 OF 4 REPLACED)


**TRUSS NOTES**

1. TRUSS MEMBERS SHALL BE REPLACED ACCORDING TO THE REPLACEMENT CHART.
2. ALL GUSSET PLATES SHALL BE REPLACED WITH 1/4" THICK GRADE 50 STEEL.
3. ANY RIVETS THAT ARE REMOVED FOR REPAIRS DETAILED ON THE PLANS OR AS ORDERED BY THE RESIDENT ENGINEER SHALL BE REPLACED WITH 3/4" DIAMETER, M-164, TYPE 1 BOLTS. THE CONTRACTOR SHALL VERIFY HOLE SIZE AND HOLE SPACING AS WELL AS GUSSET DIMENSIONS AT ALL LOCATIONS. HOLES FOR THE GUSSET PLATES MAY BE FIELD DRILLED.
4. HOLES IN THE EXISTING GUSSET PLATES FOR THE EXISTING RAIL SUPPORT SHALL BE OMITTED IN THE NEW GUSSET PLATES. THE EXISTING RAILING SHALL BE ATTACHED TO A NEW BOX BEAM RAIL.
5. WHEN EXISTING STEEL SIZES ARE NOT AVAILABLE, AN EQUIVALENT SIZE MAY BE SUBSTITUTED WITH APPROVAL OF THE PROJECT MANAGER.
6. THE EXISTING FLOORING SYSTEM INCLUDING TIMBER DECKING, STEEL STRINGERS, AND CHANNELS SHALL BE REMOVED AND REPLACED WITH GULAM DECK PANELS. SEE DECK DETAIL SHEETS 13 AND 14.
7. EXISTING FLOOR BEAMS ARE CURRENTLY HANGING BELOW THE TRUSS BOTTOM CHORDS. THE NEW FLOOR BEAMS AND LATERAL BRACING SHALL BE NESTED BETWEEN THE BOTTOM CHORDS. ONE FLOOR BEAM SHALL BE ADDED TO THE EXISTING FRAMING PLAN AT  $\bar{C}$  BEARING AT EACH END OF THE TRUSS. SEE FLOOR BEAM CONNECTION DETAILS ON SHEETS 18 AND 19.
8. THE ROUND HEAD END OF THE BOLTS SHALL BE VISIBLE FROM THE EXTERIOR SIDE OF THE TRUSS.
9. THE CONTRACTOR SHALL INSTALL THE FLOOR BEAMS SO THAT ANY SHOP CAMBER WILL BE POSITIVE.

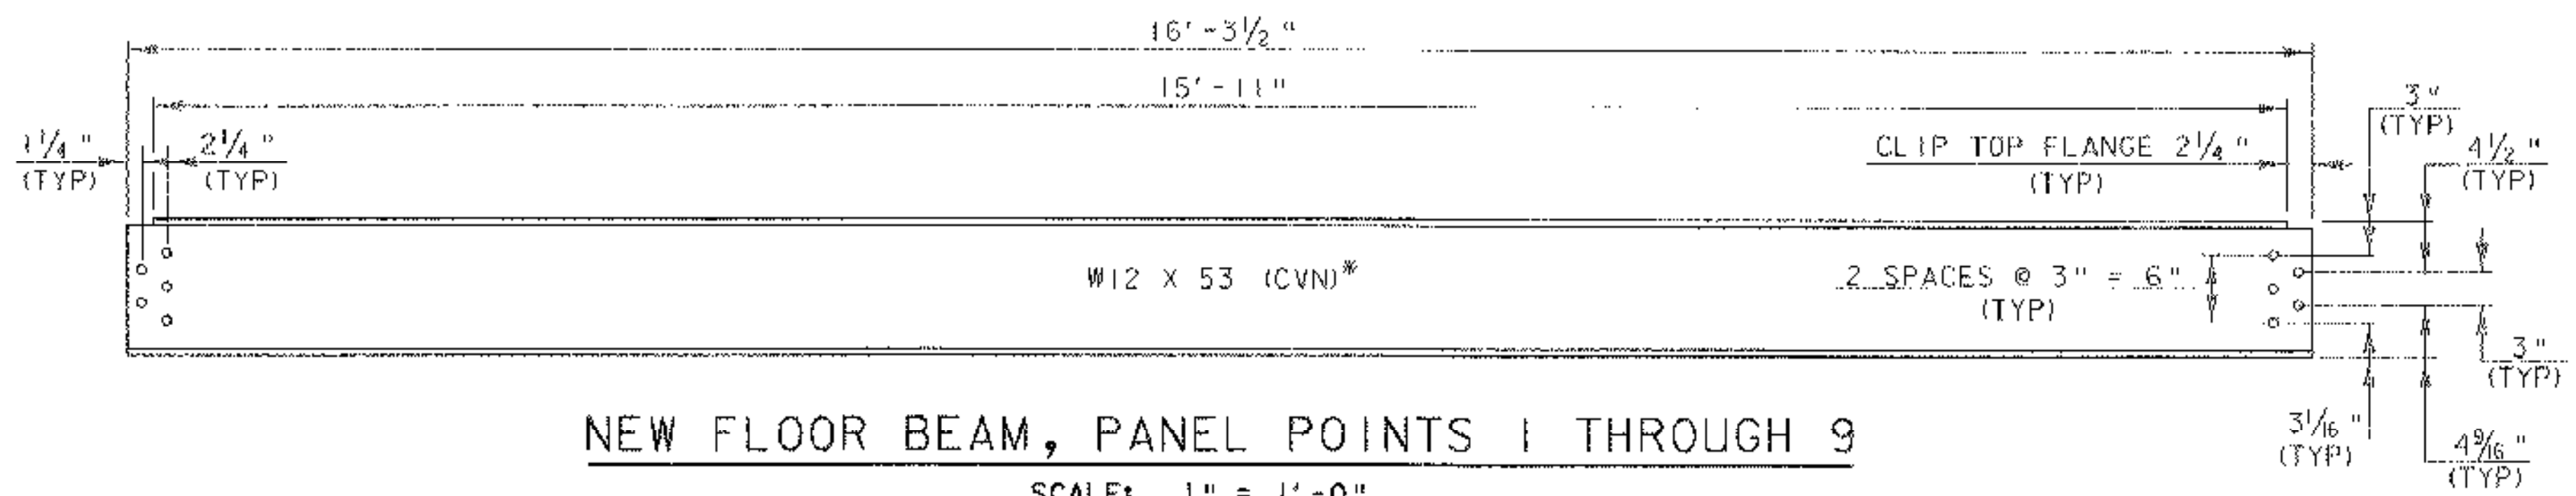


**NEW FLOOR BEAM, PANEL POINTS 1 THROUGH 9**

SCALE: 1" = 1'-0"  
\* FLOOR BEAMS SHALL BE CHARPY V-NOTCH TESTED

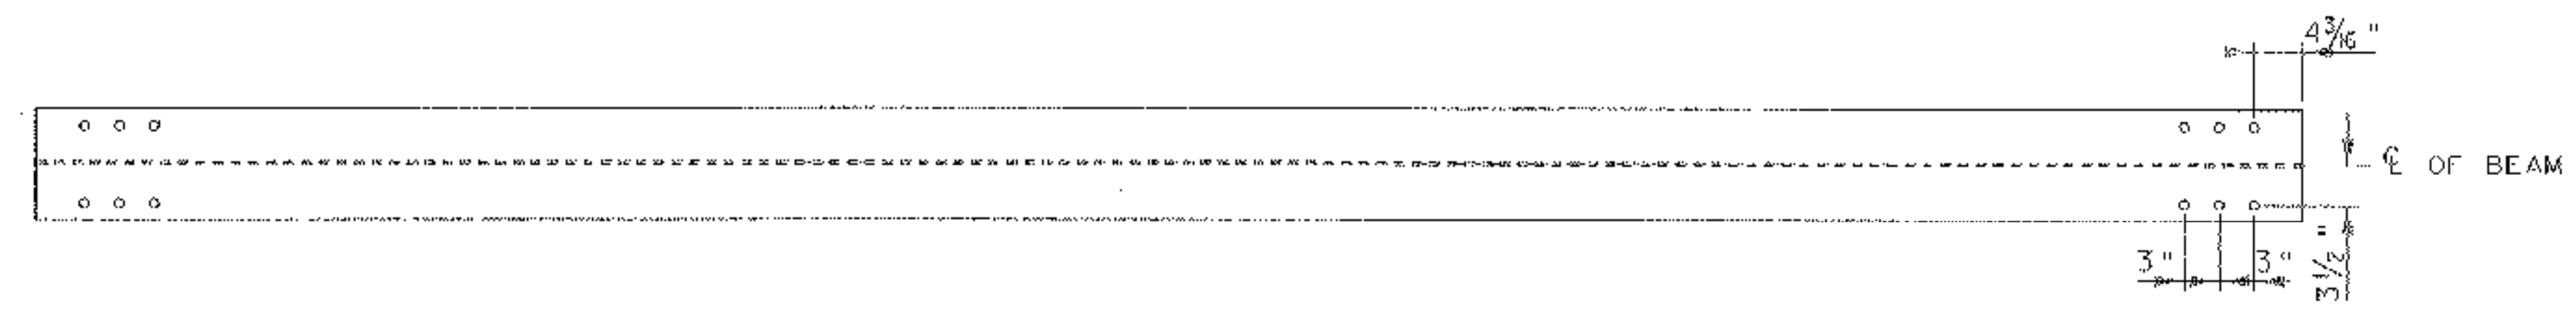


**BOTTOM FLANGE OF FLOOR BEAM**

SCALE: 1" = 1'-0"  
(7 REQUIRED AS SHOWN, 2 REQUIRED WITH HOLES ALONG ONE SIDE OF  $\bar{C}$  OF BEAM ONLY)

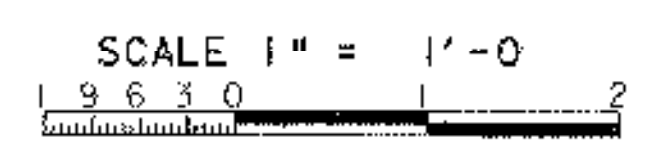


PROJECT: <b>NEW HAVEN - WEYBRIDGE</b>	PROJECT NO. # <b>BHO-BTN 2005 (1)</b>
DESIGN FILE NAME: 89j081/structures/sj081truss.dgn	PLOT DATE: 28-FEB-2007
IPARM FILE NAME: sj081trussdtl.1	DRAWN BY: R. S. YOUNG
DESIGNED BY: R. S. YOUNG	CHECKED BY: R. S. YOUNG
SQUAD LEADER: C. P. WILLIAMS	TRUSS DETAILS
	SHEET: 15 OF 53

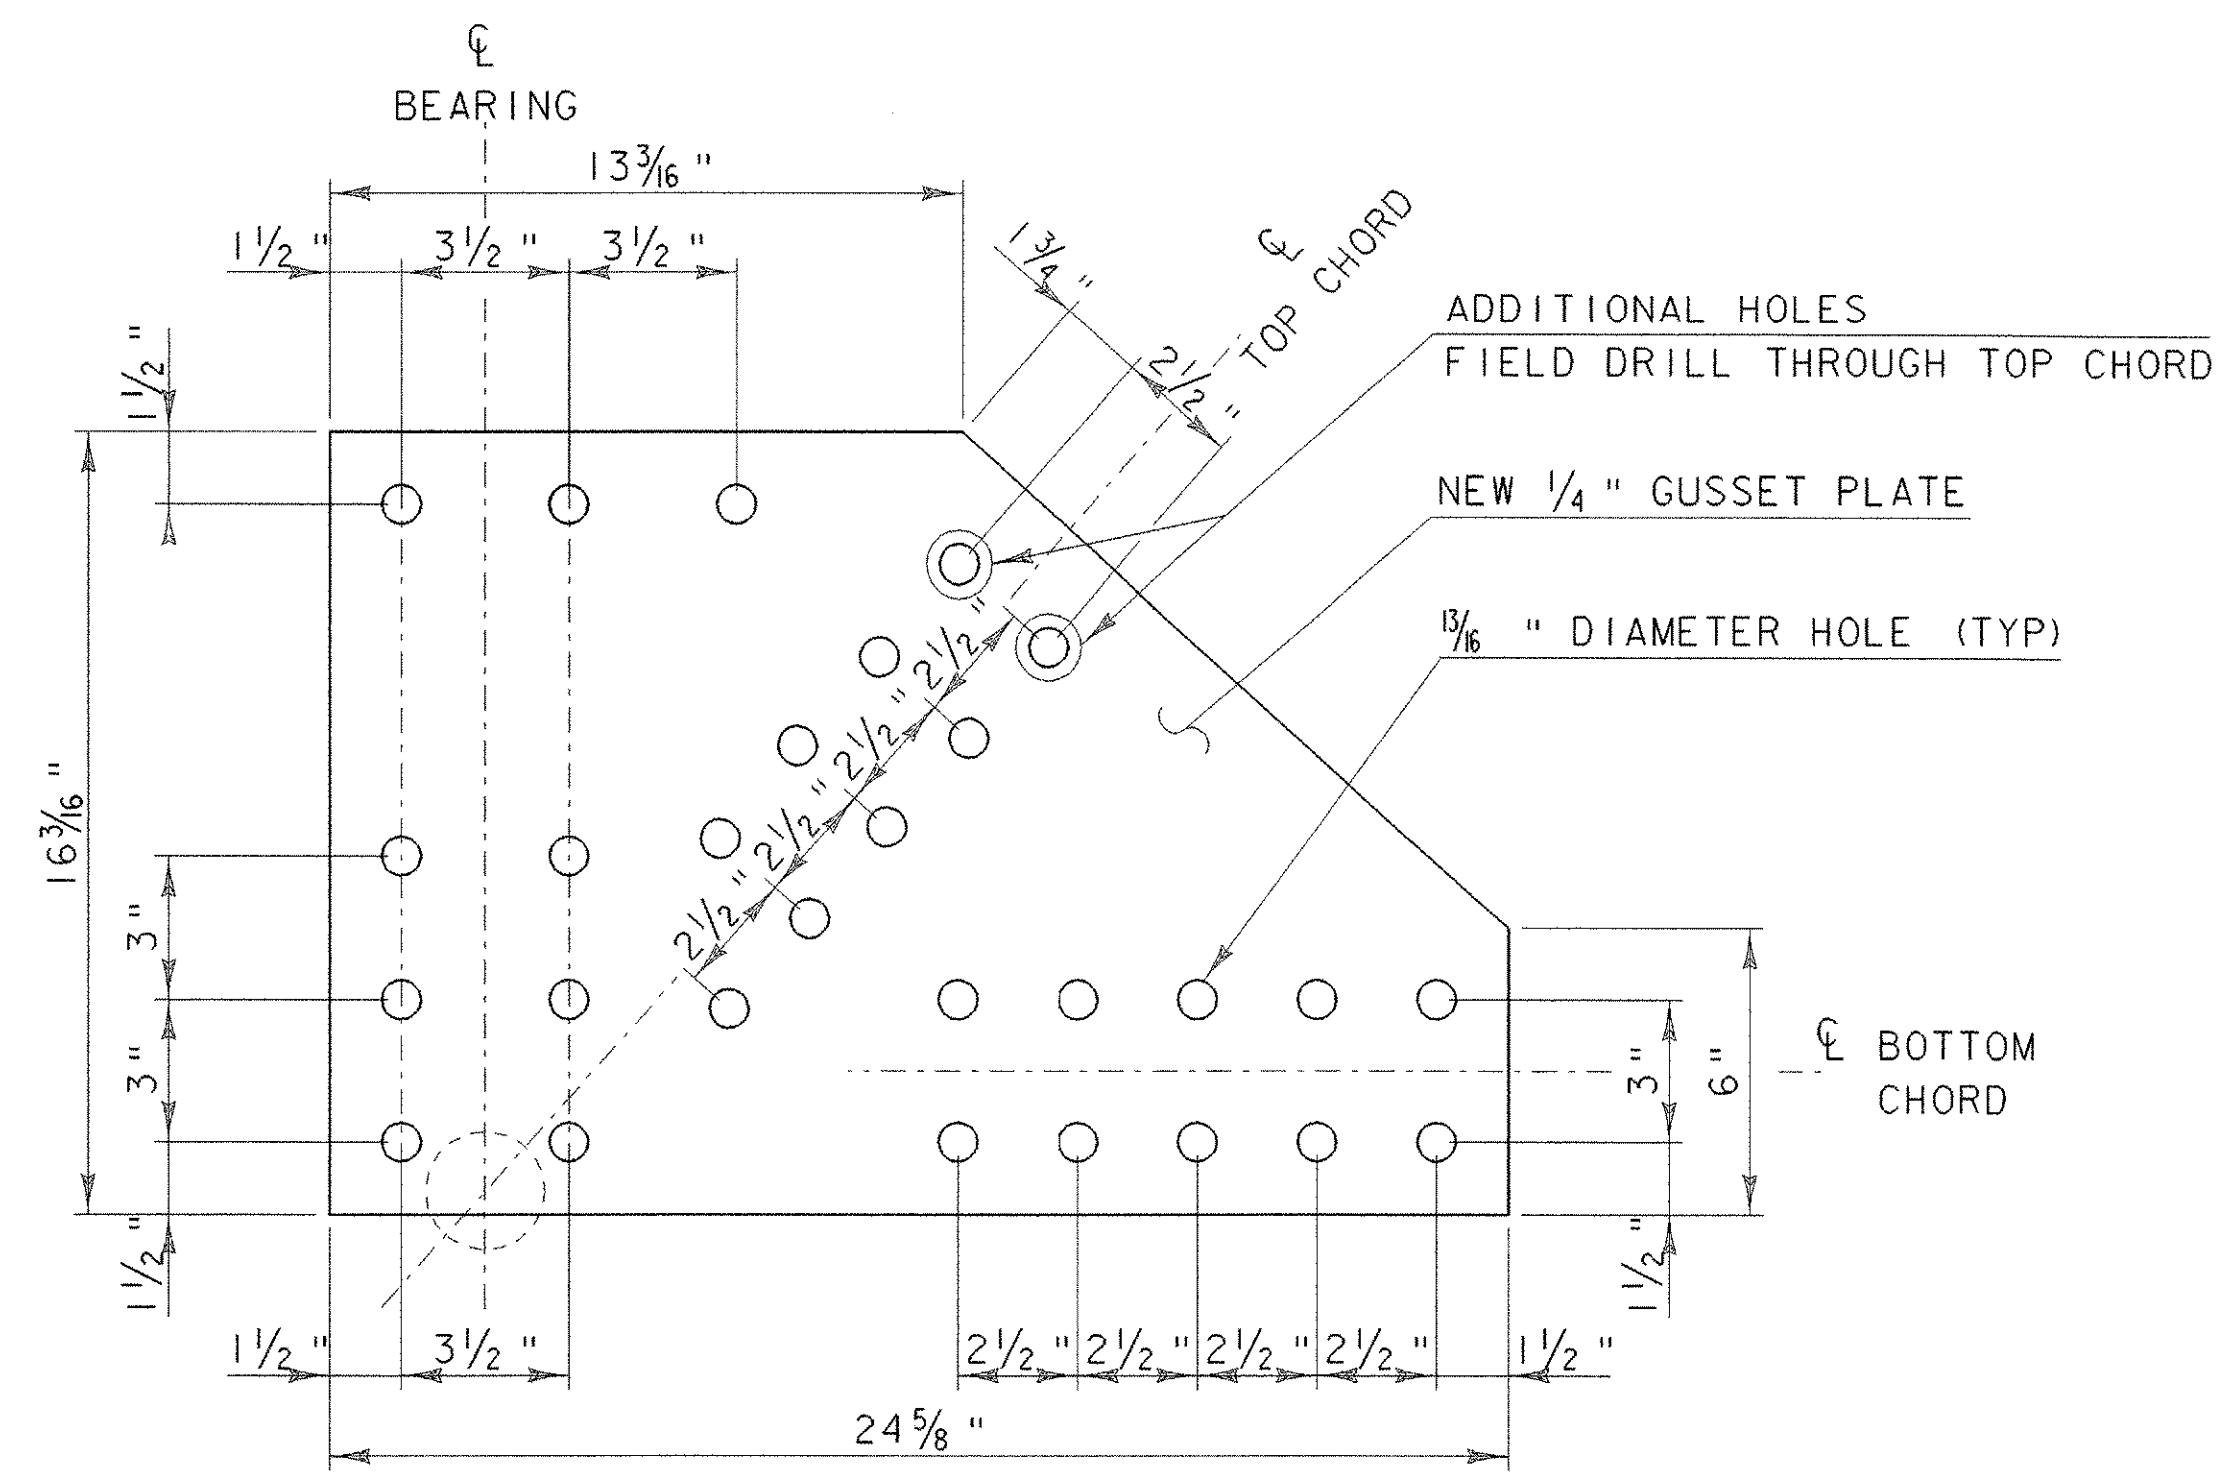


GUSSET PLATE AT PANEL POINTS 1 AND 9

SCALE: 3" = 1'-0" (8 REQUIRED)

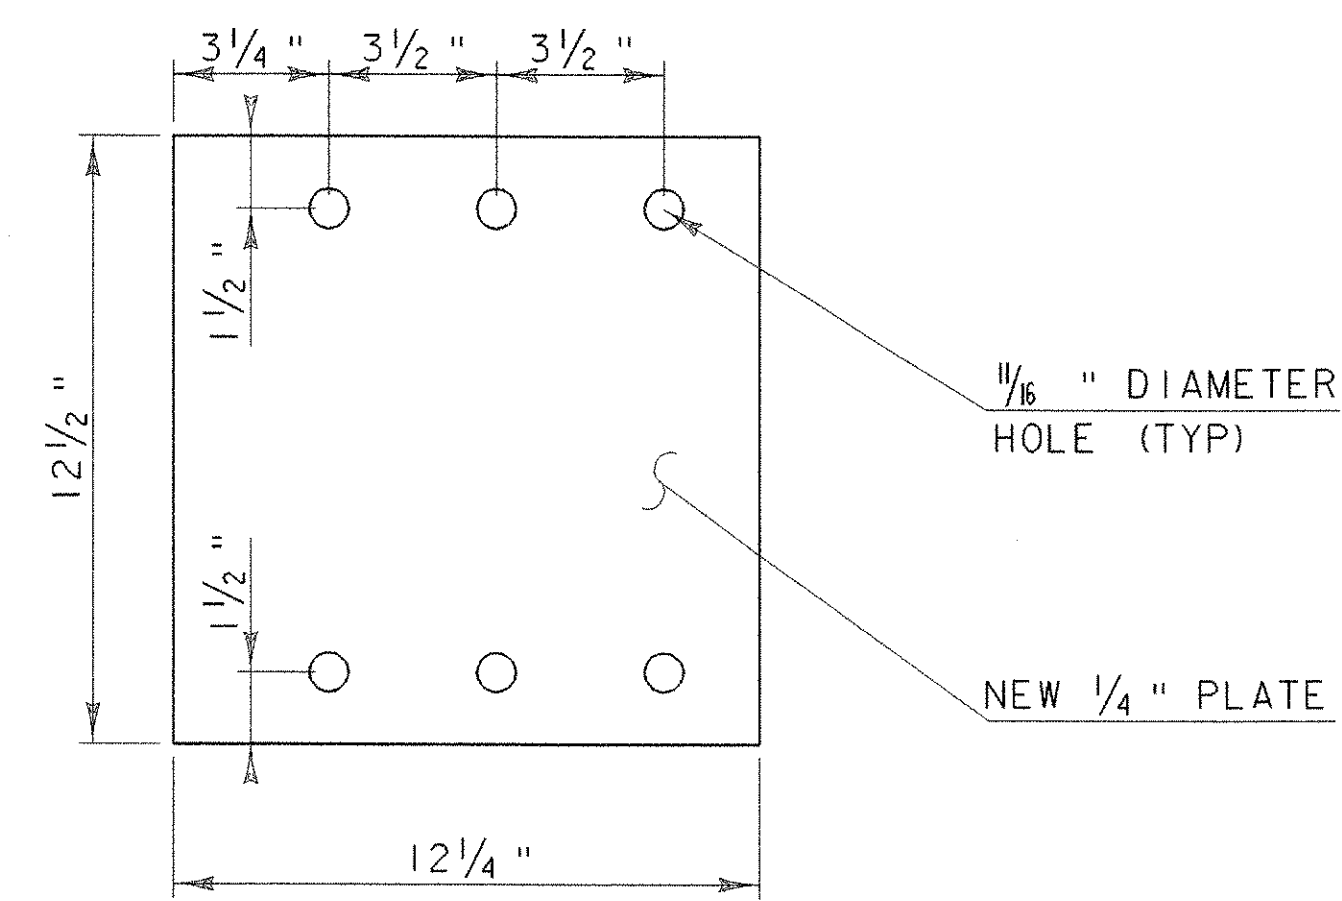

COVER PLATE

SCALE: 3" = 1'-0" (4 REQUIRED)

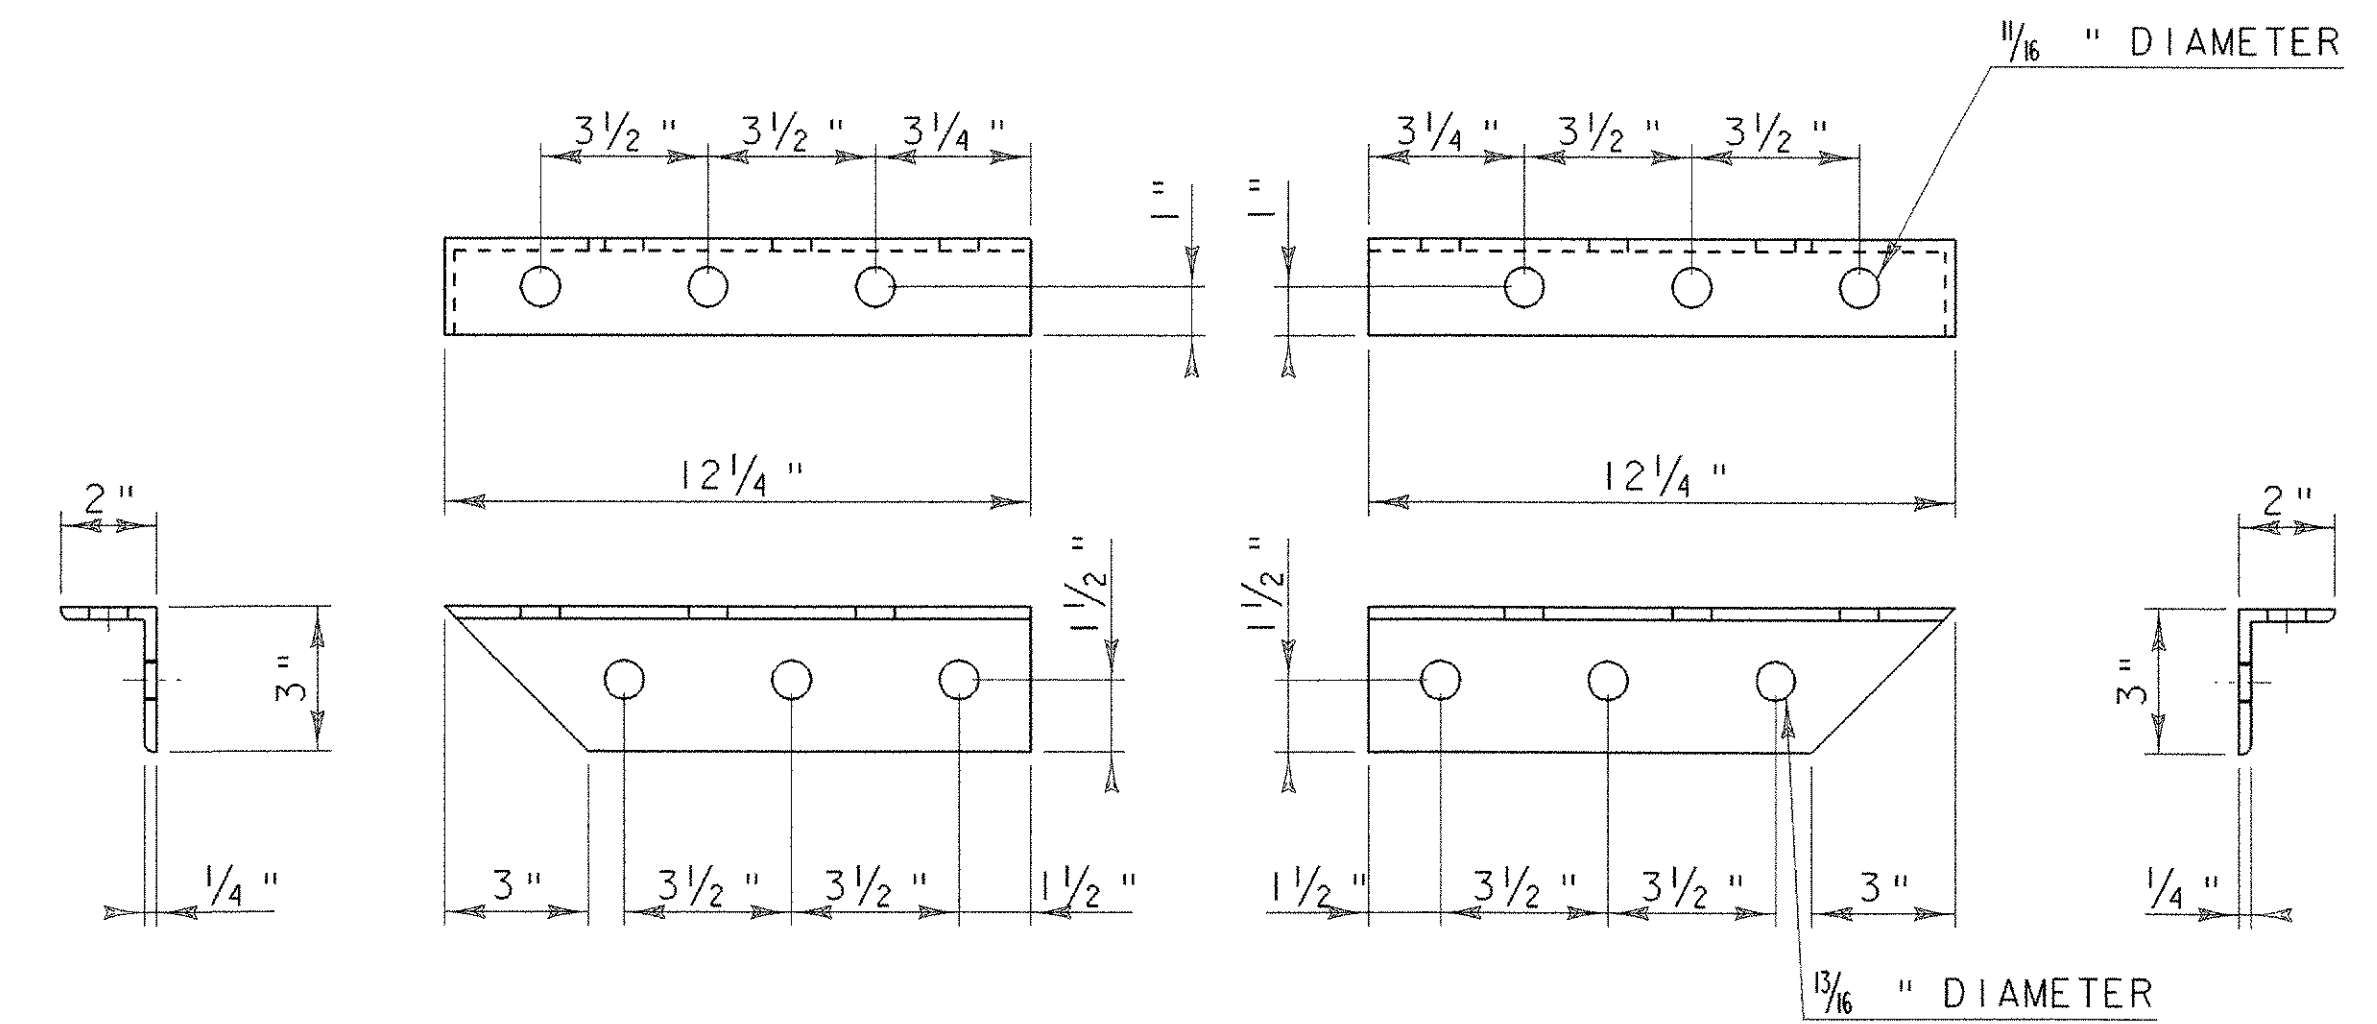

LEFT COVER BRACE


L 3"x2"x1/4"

SCALE: 3" = 1'-0" (4 REQUIRED)

RIGHT COVER BRACE


L 3"x2"x1/4"

SCALE: 3" = 1'-0" (4 REQUIRED)

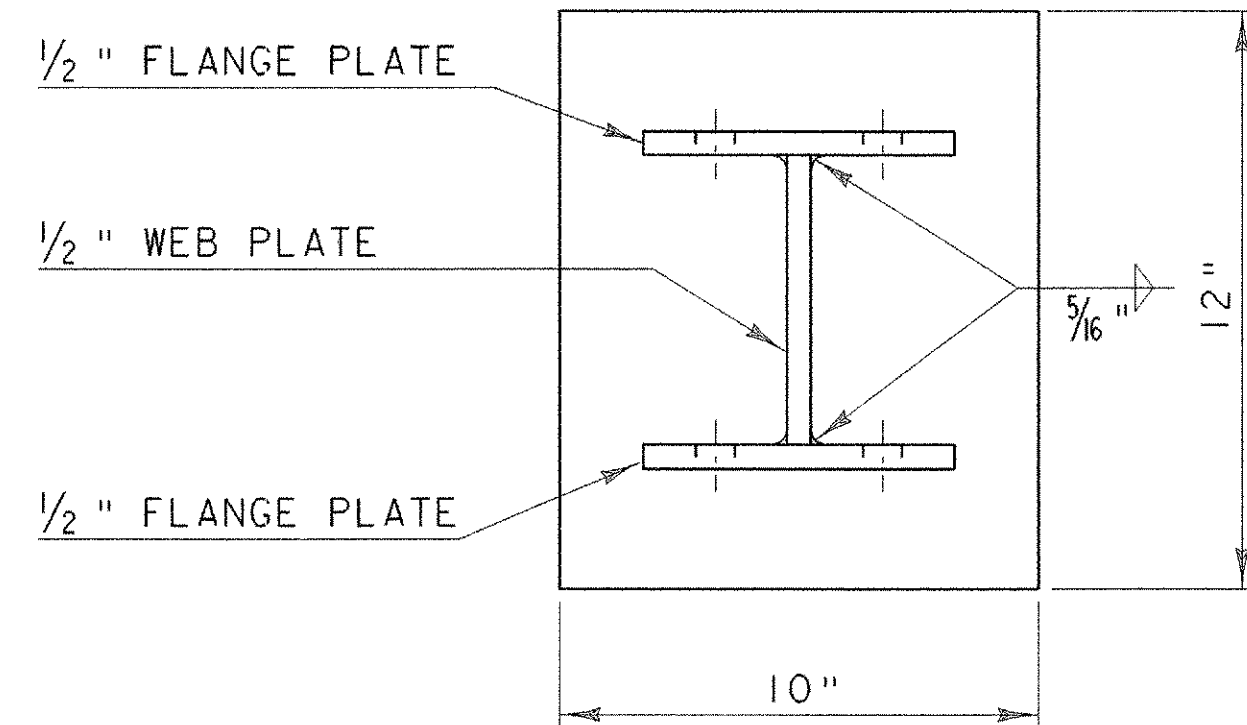


BEARING COLUMN  
TOP VIEW

SCALE: 3" = 1'-0"

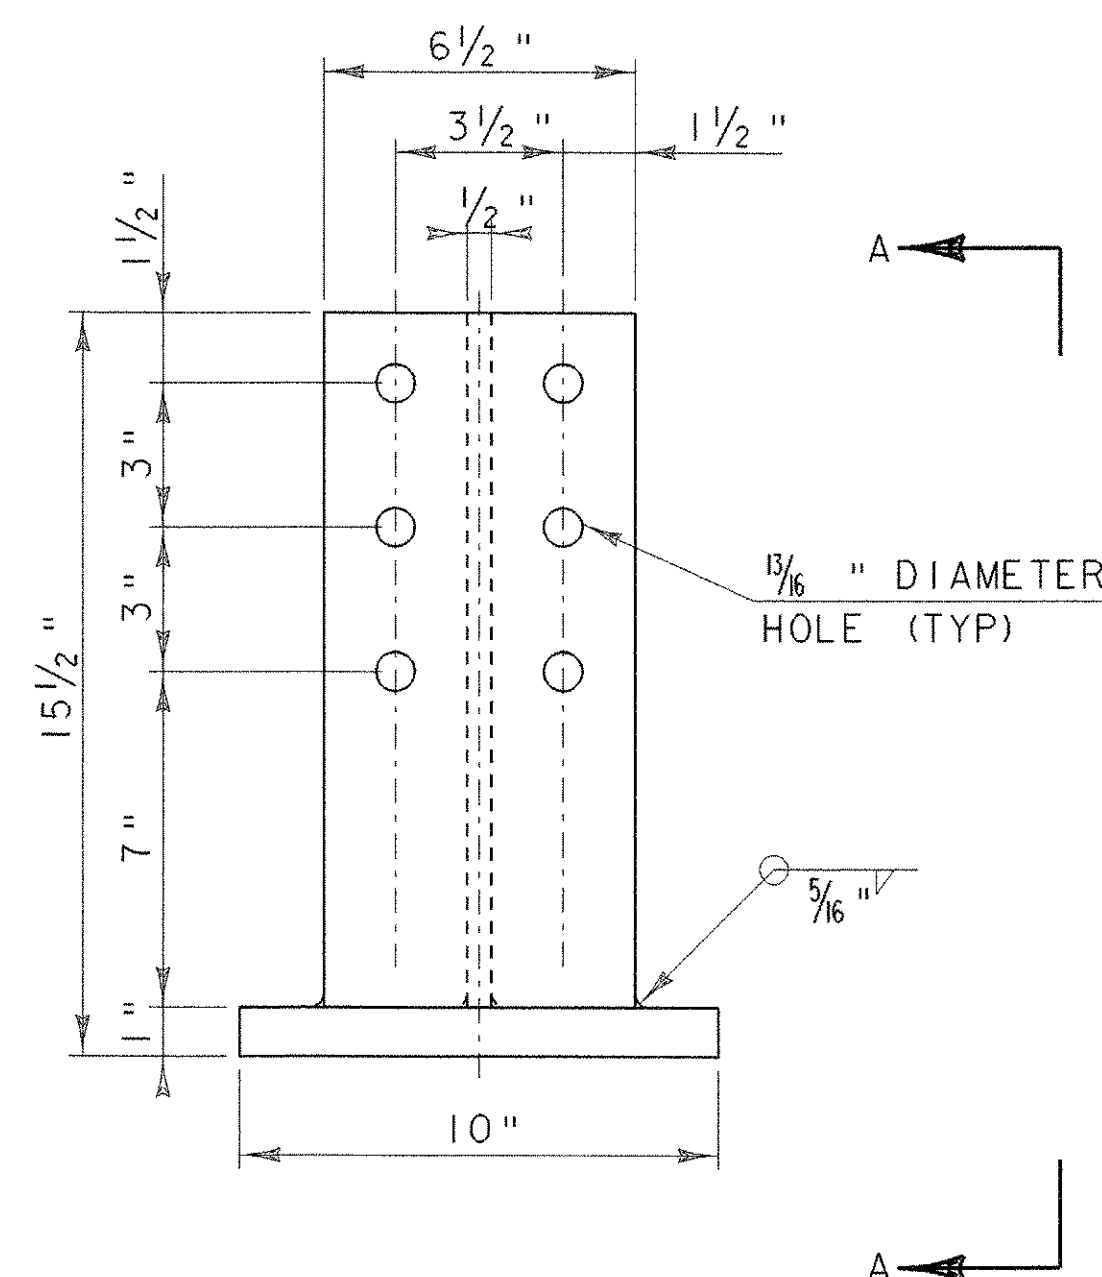


BEARING COLUMN HOLE PATTERN

SCALE: 3" = 1'-0" (4 REQUIRED)

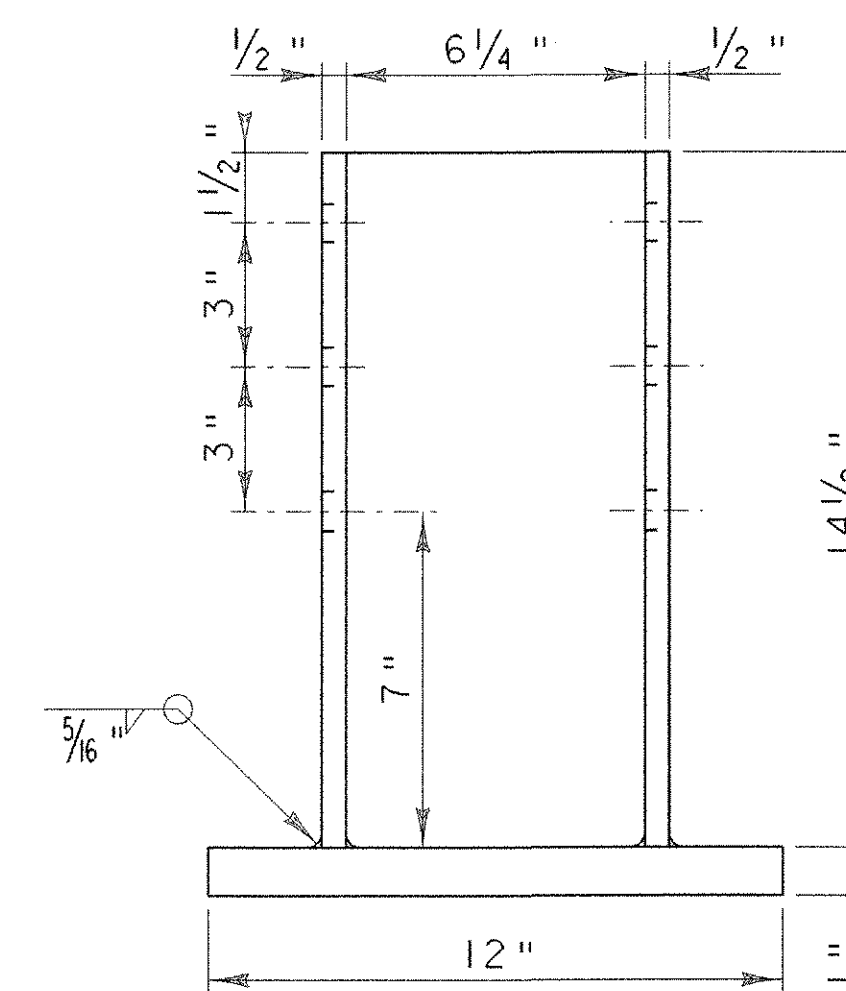

VIEW "A-A"


SCALE: 3" = 1'-0"

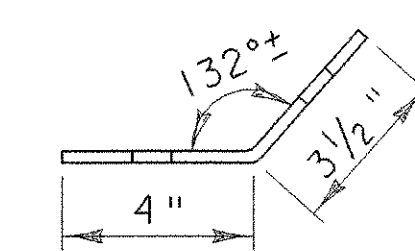


NEW BENT PLATE

PL 12 1/2" X 1/4" X 7 1/2" (4 REQUIRED)

SCALE: 3" = 1'-0"

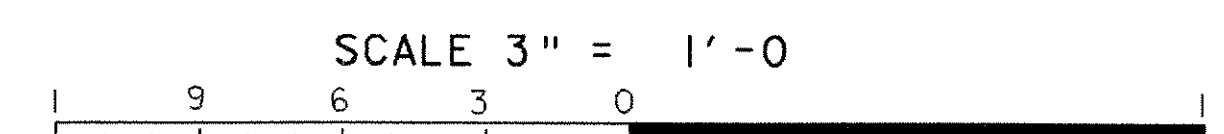


PROJECT: NEW HAVEN - WEYBRIDGE	PROJECT NO.: BHO-BTN 2005 (1)
DESIGN FILE NAME: 89j081/structures/sj081truss.dgn	
IPARM FILE NAME: sj081platebeam.i	PLOT DATE: 28-FEB-2007
DESIGNED BY: R.S. YOUNG	DRAWN BY: R.S. YOUNG
SQUAD LEADER: C.P. WILLIAMS	CHECKED BY: W.B. SYMONDS
BEARING PLATE AND COLUMN DETAILS SHEET: 16 OF 53	

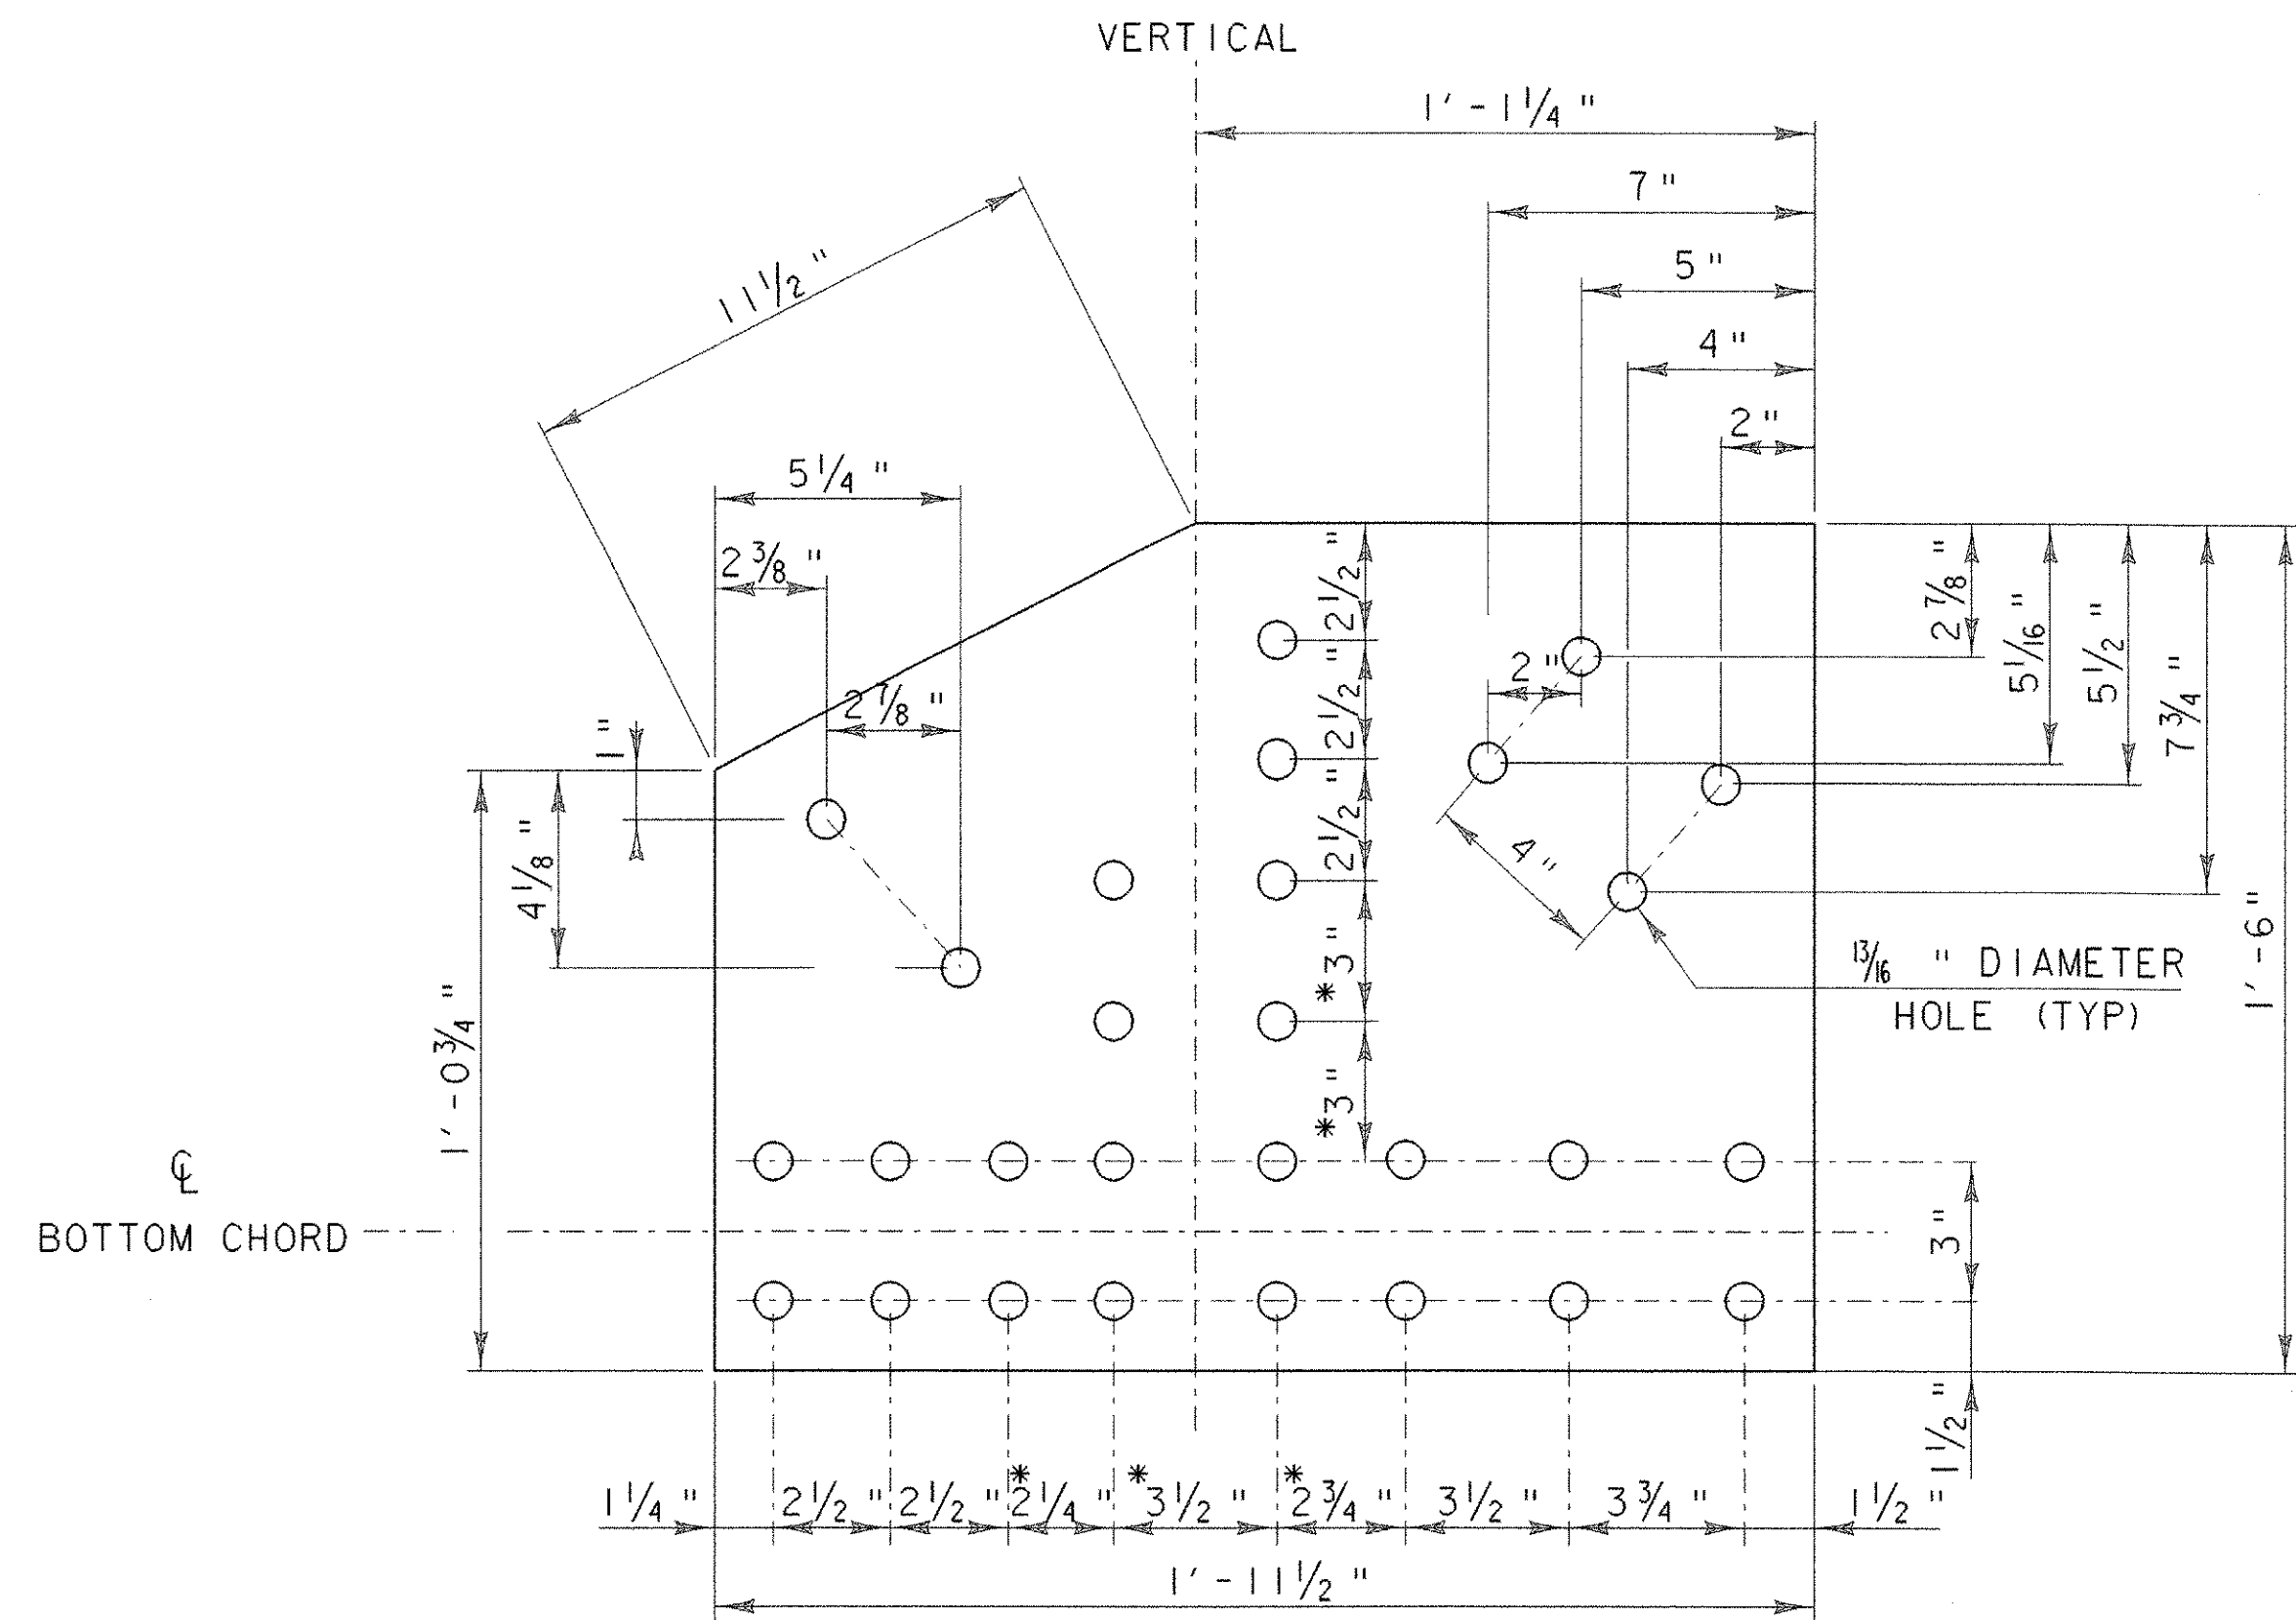


PANEL POINTS 2 AND 8

SCALE 3" = 1'-0 (8 REQUIRED)

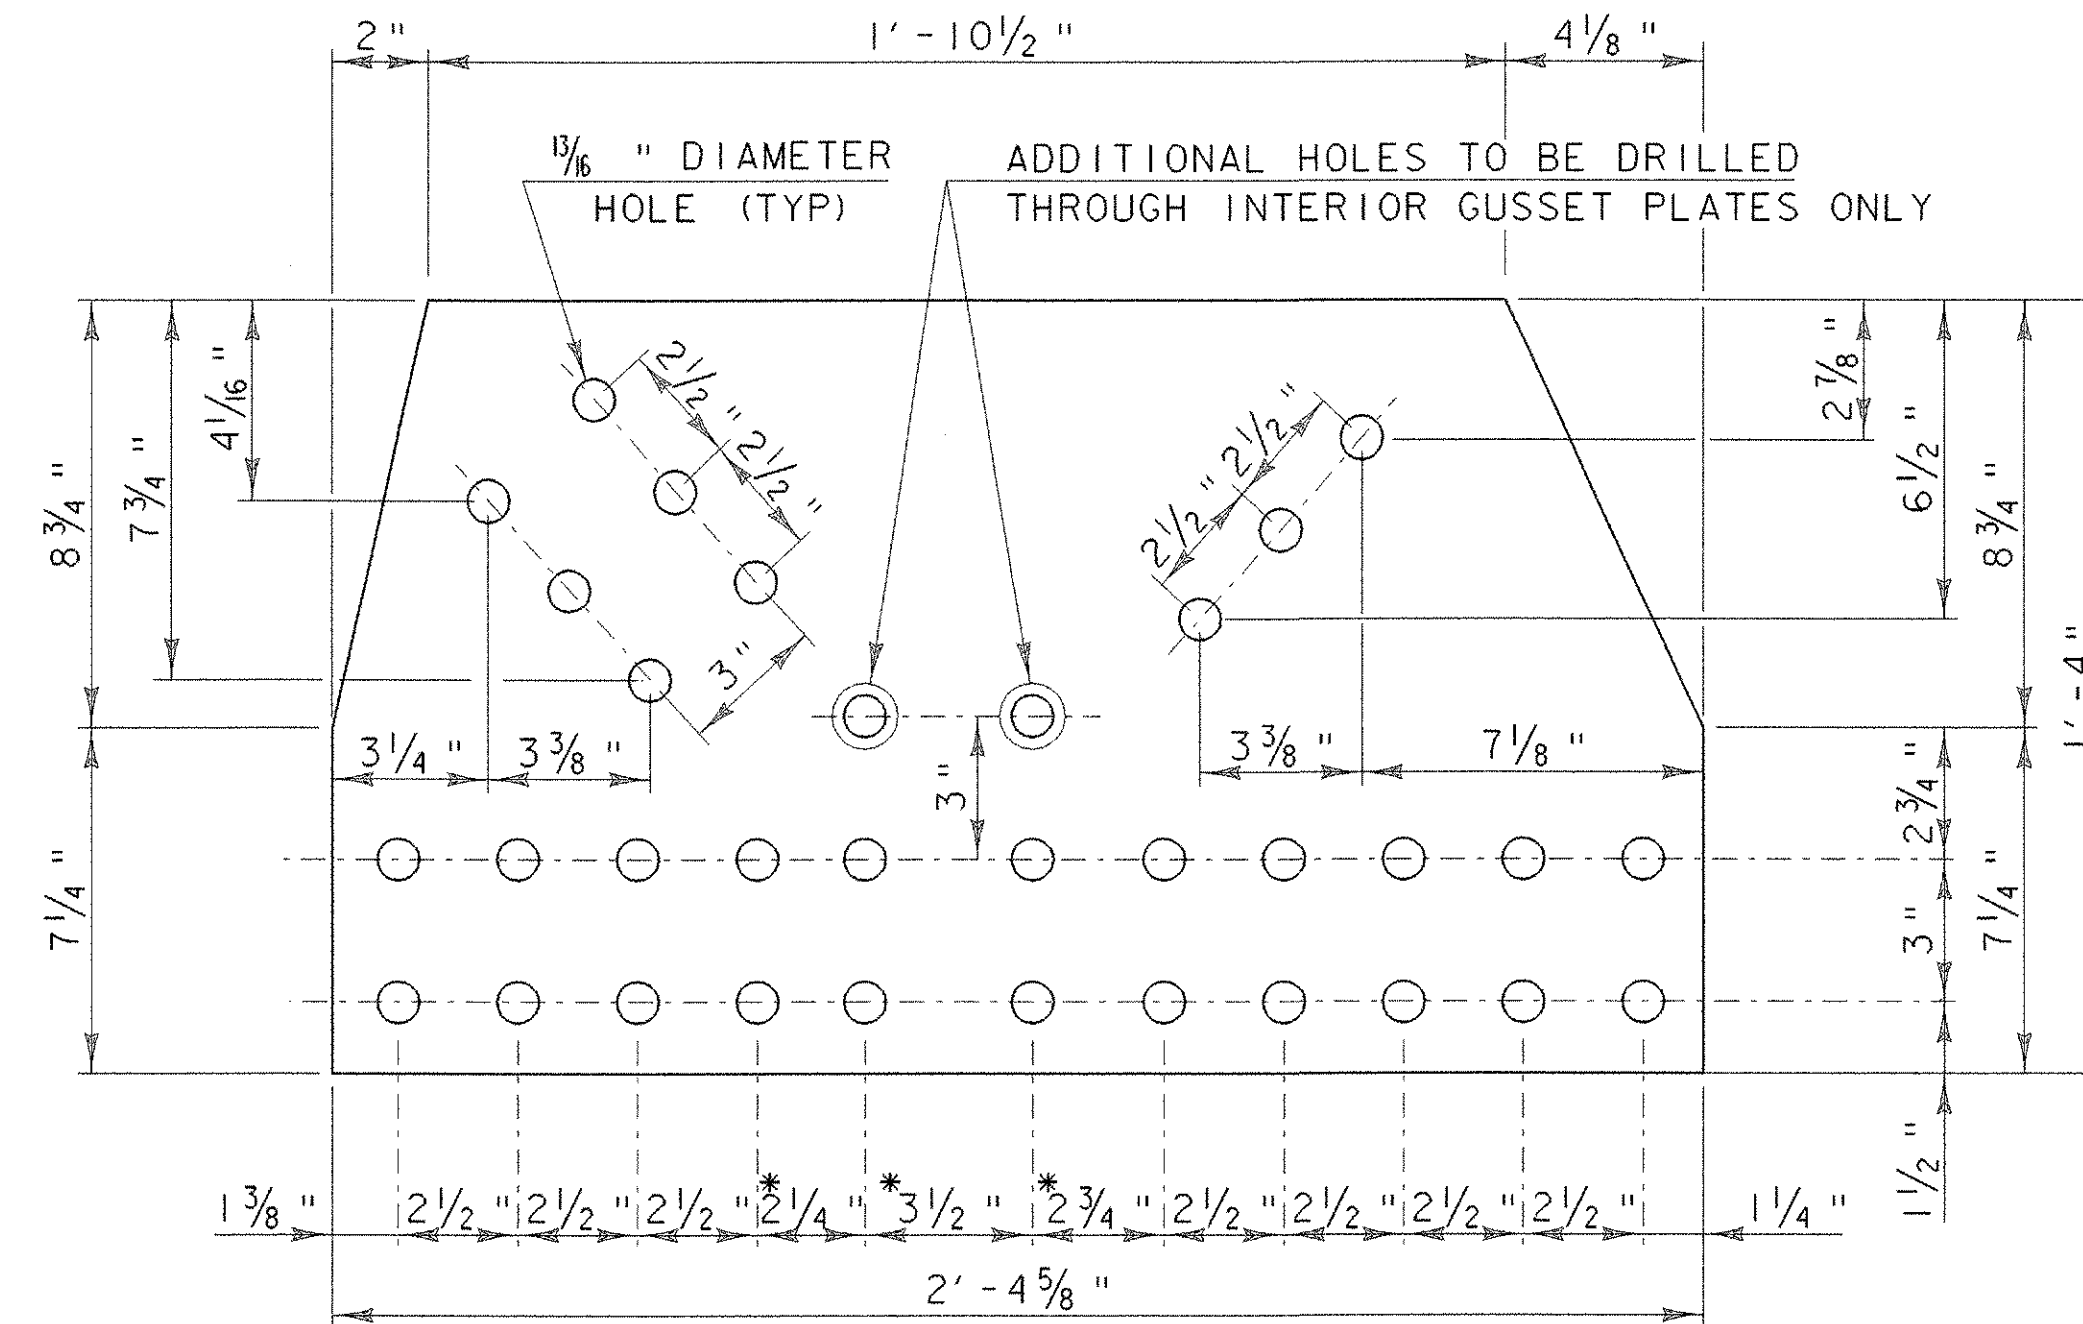


PANEL POINTS 3 AND 7

SCALE 3" = 1'-0 (8 REQUIRED)

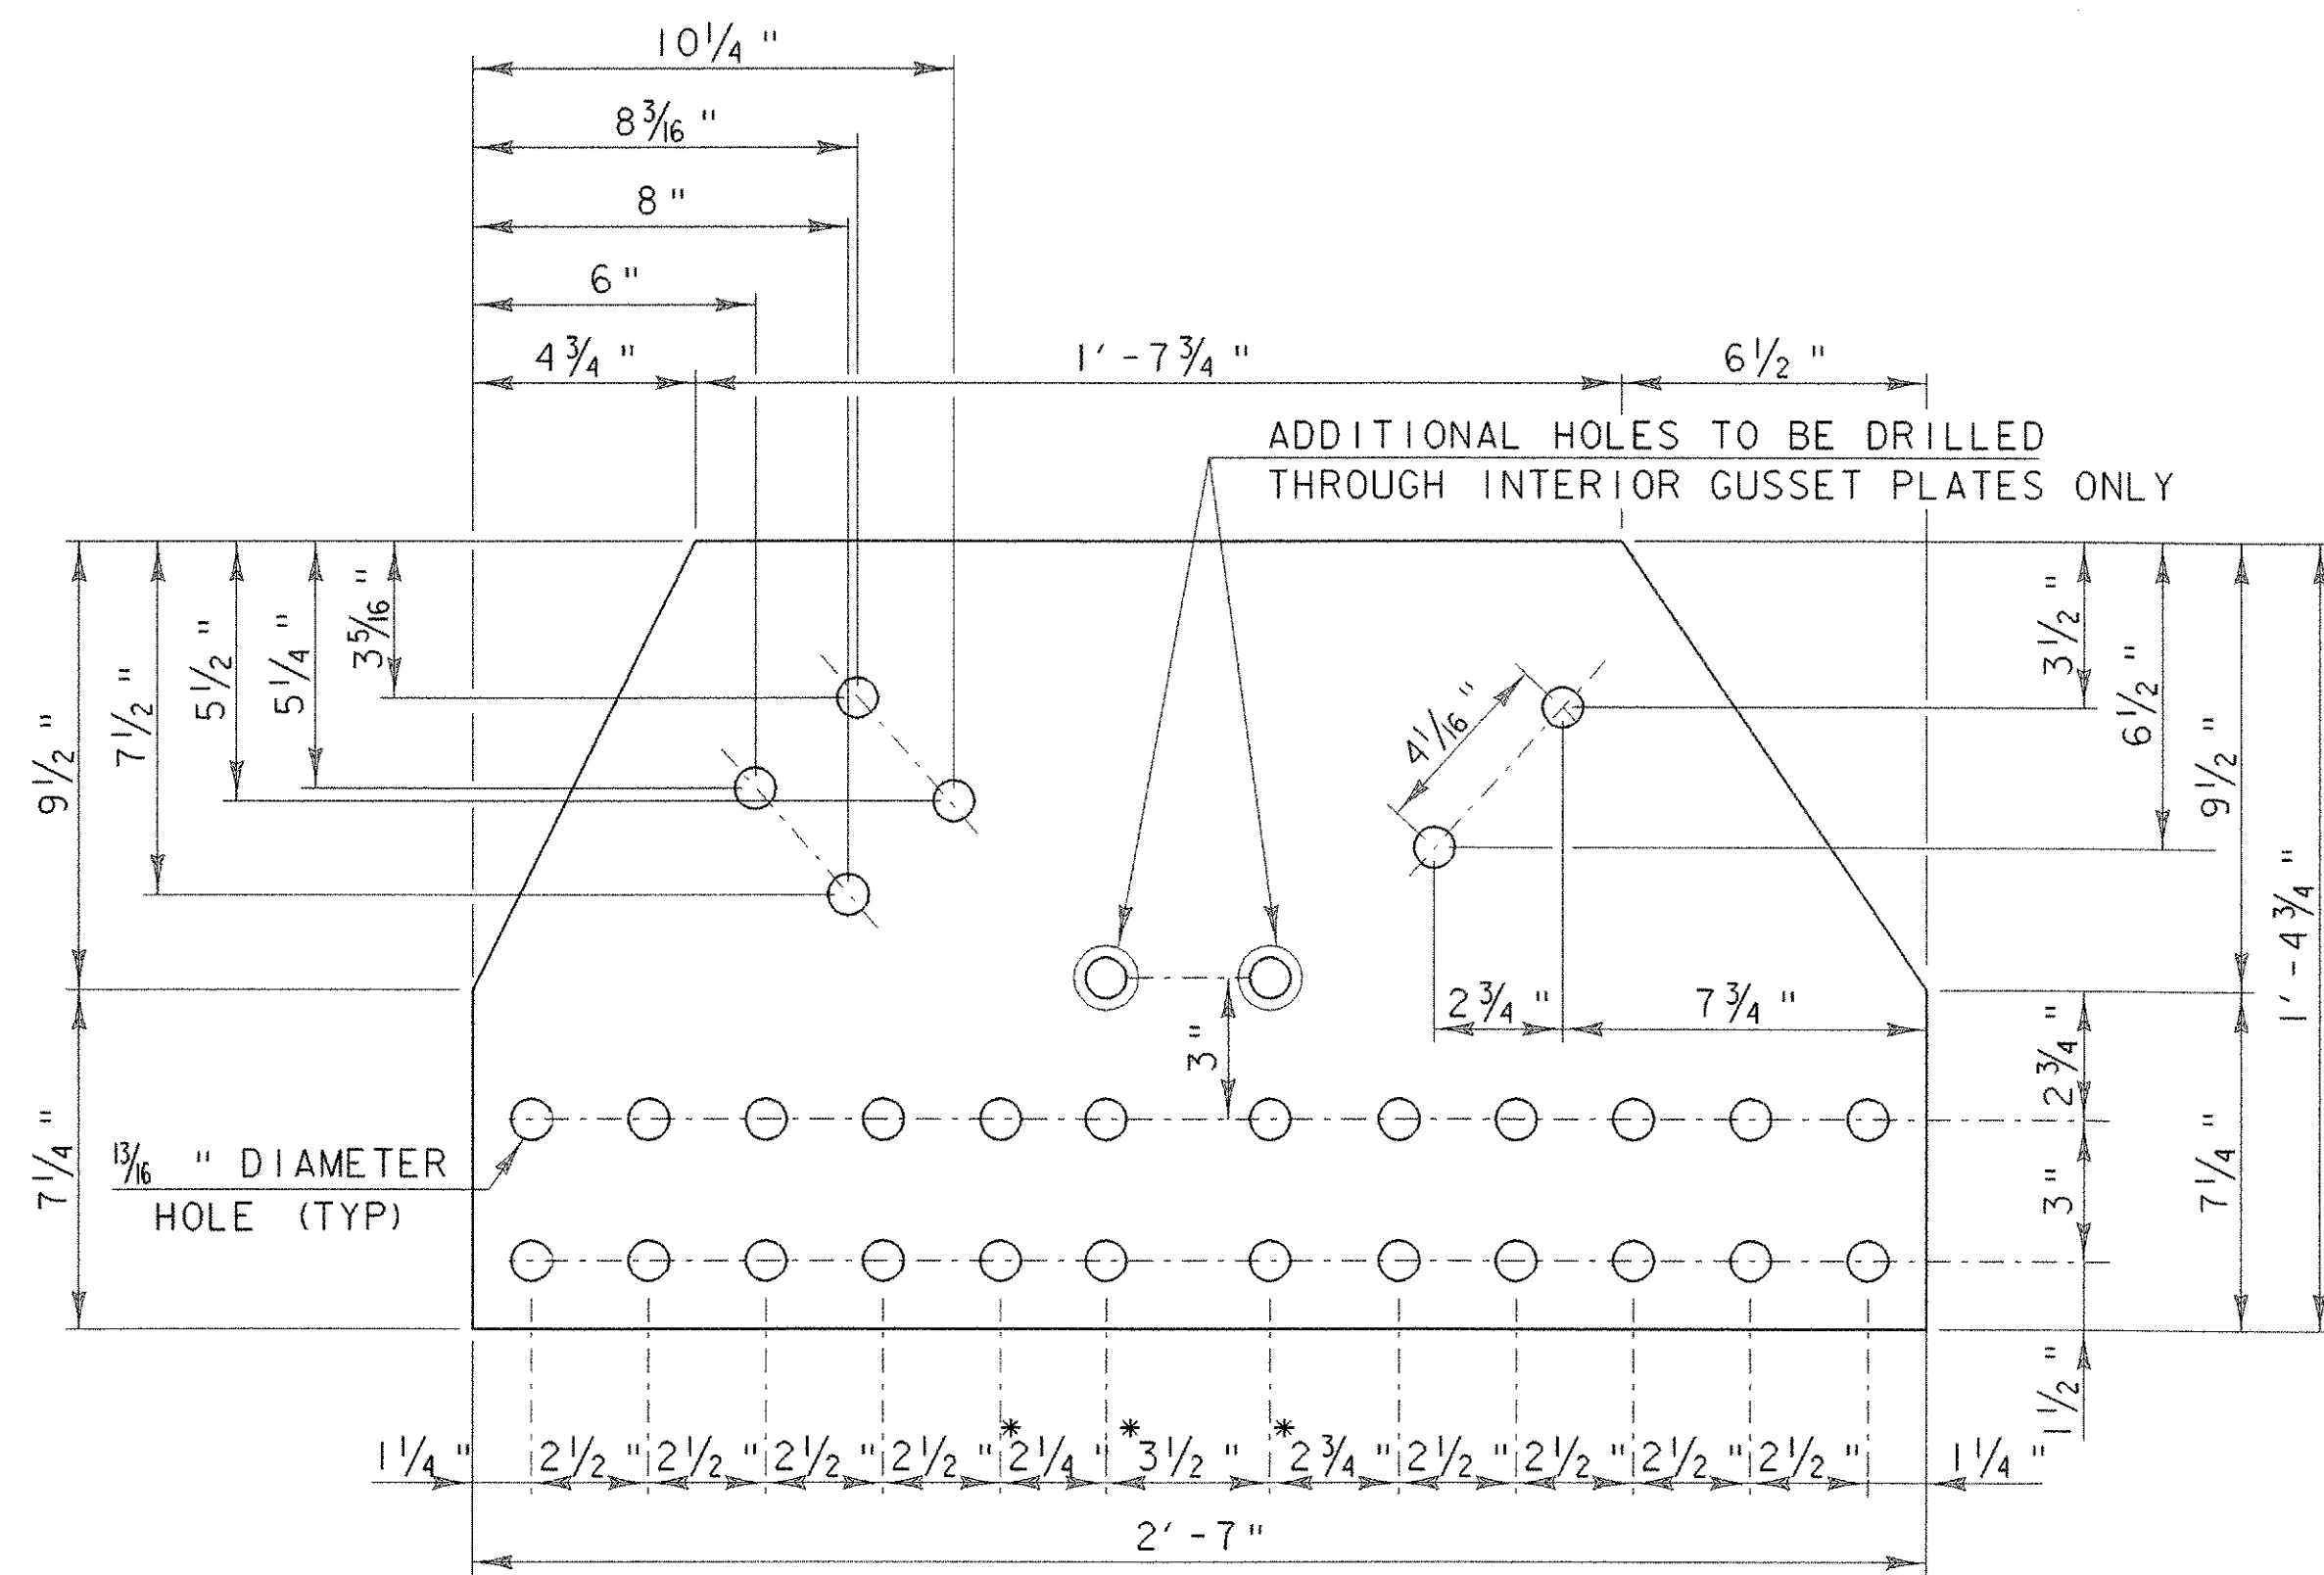

PANEL POINTS 4 AND 6

SCALE 3" = 1'-0 (8 REQUIRED)

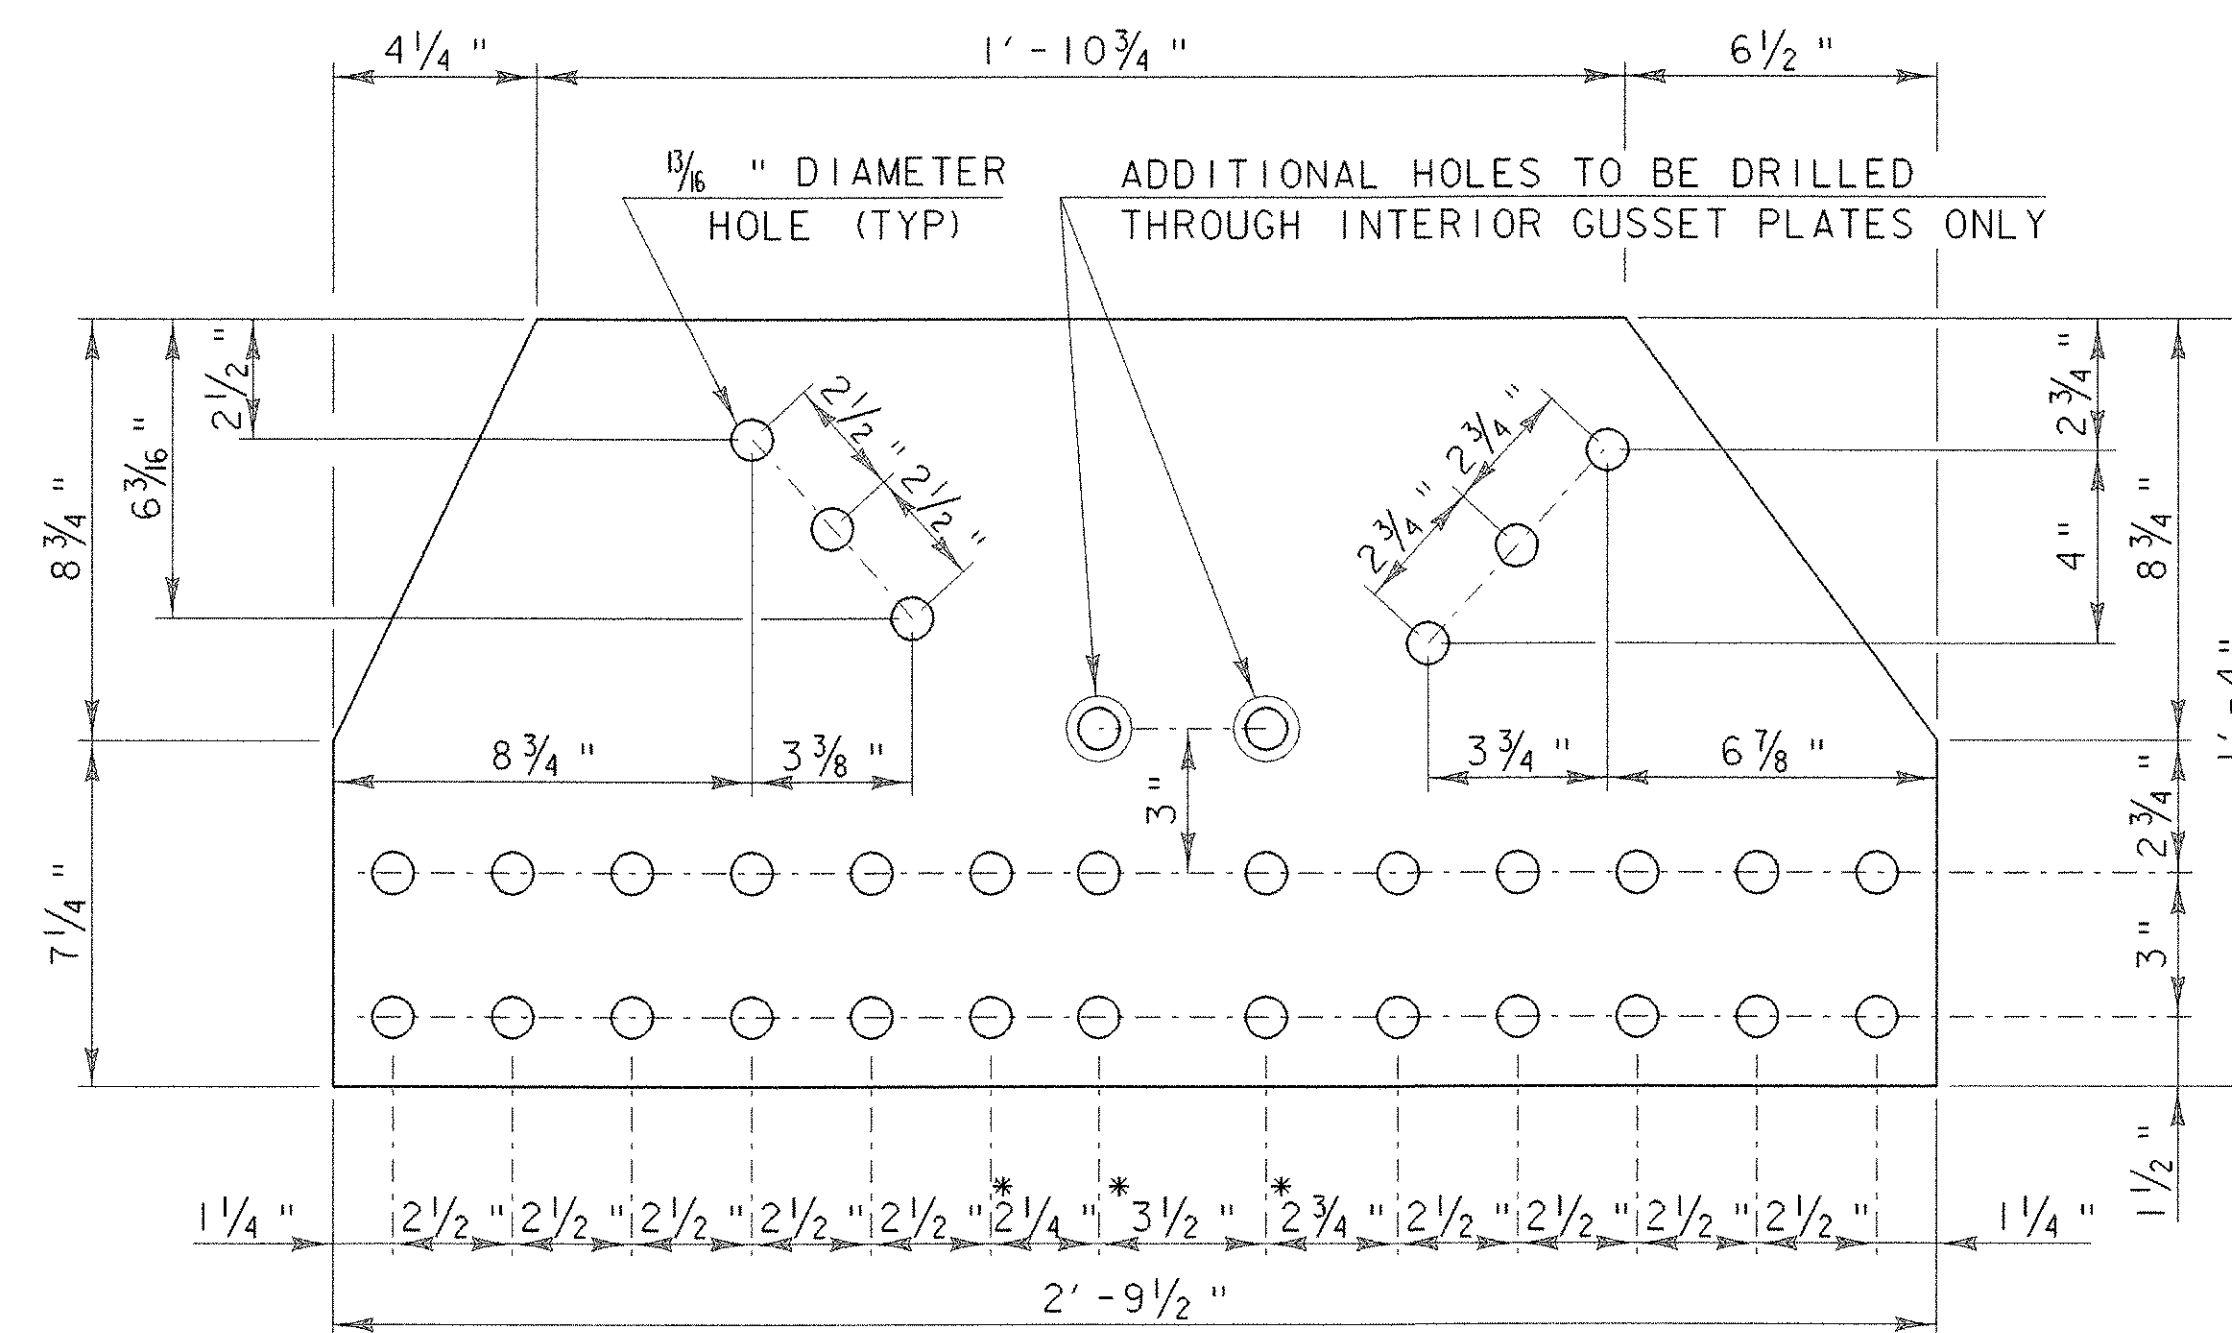


PANEL POINT 5


SCALE 3" = 1'-0 (4 REQUIRED)

**\*NOTE- INTERIOR GUSSET PLATES ONLY**


THE ORIGINAL SPACING HAS BEEN CHANGED FOR CONNECTION TO THE FLOOR BEAM. HOLES IN THE NEW VERTICAL ANGLES SHALL BE ADJUSTED ACCORDINGLY. HOLES IN THE EXISTING BOTTOM CHORD SHALL BE REAMED 1/4" TO FIT THE NEW SPACING. REAMING SHALL BE INCIDENTAL TO ITEM 506.60 "STRUCTURAL STEEL."

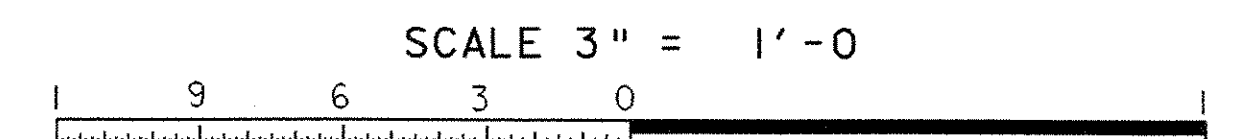


PROJECT:	PROJECT NO.:
NEW HAVEN - WEYBRIDGE	BHO-BTN 2005 (1)
DESIGN FILE NAME: 89j081/structures/sj081truss.dgn	
IPARM FILE NAME: sj081gusset.i	PLOT DATE: 28-FEB-2007
DESIGNED BY: R.S. YOUNG	DRAWN BY: M.C. LONGSTREET
SQUAD LEADER: C.P. WILLIAMS	CHECKED BY: R.S. YOUNG
GUSSET PLATES	SHEET: 17 OF 53

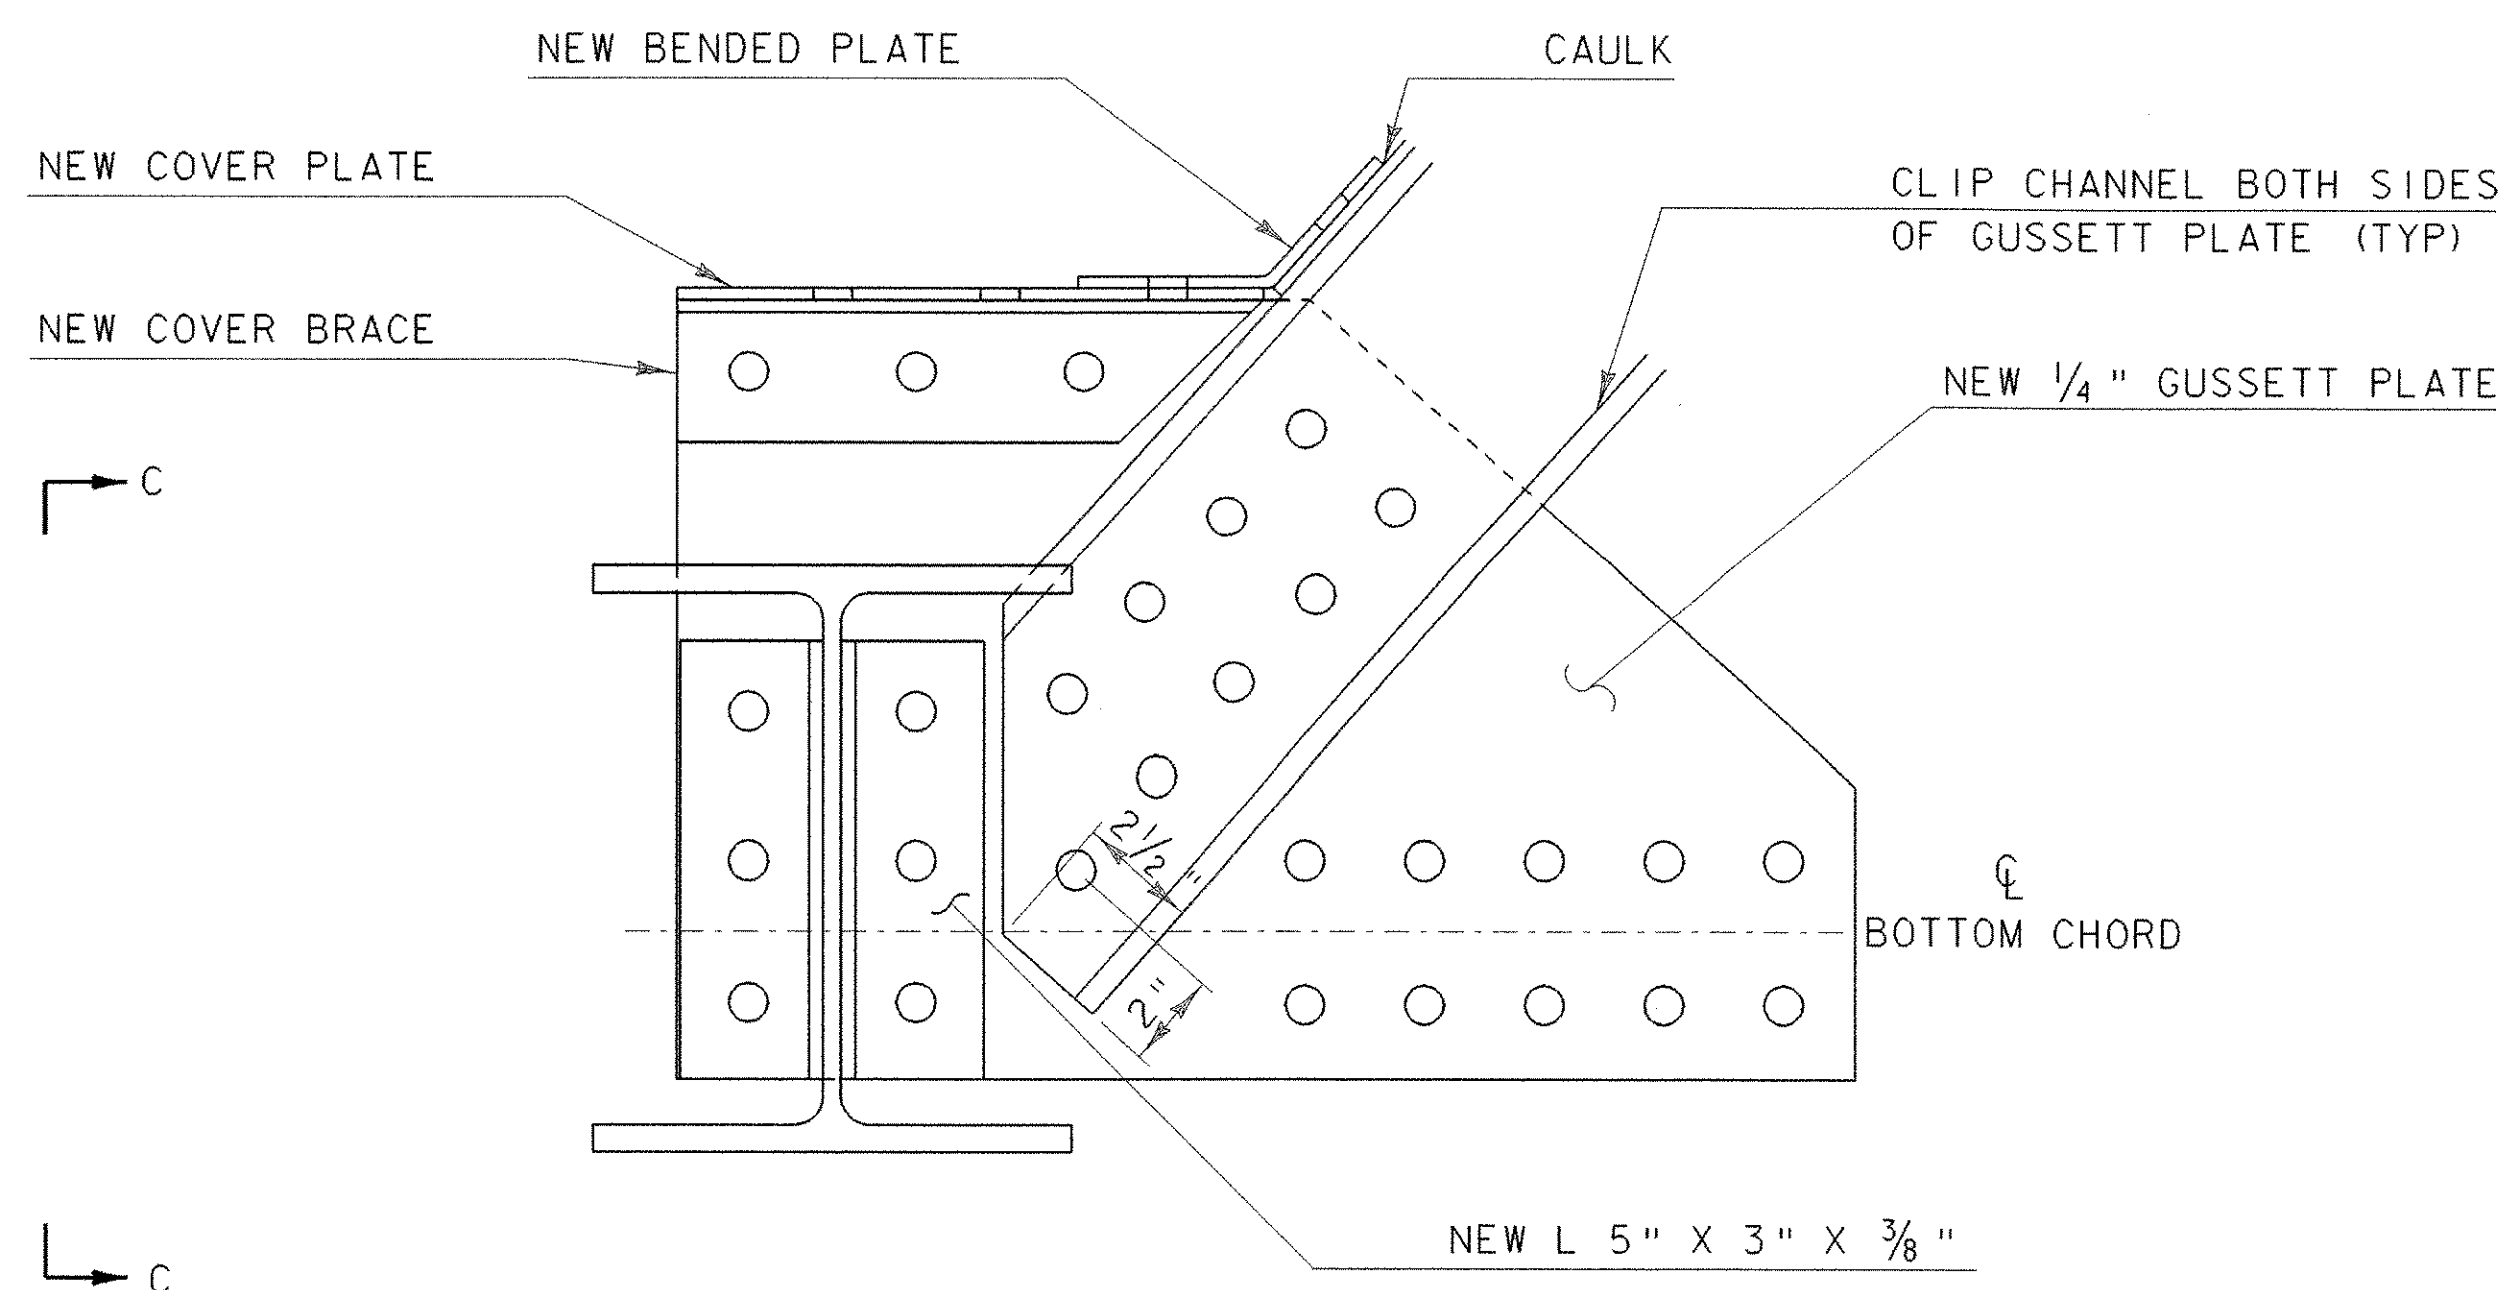

FLOOR BEAM CONNECTION AT  
PANEL POINTS 1 AND 9

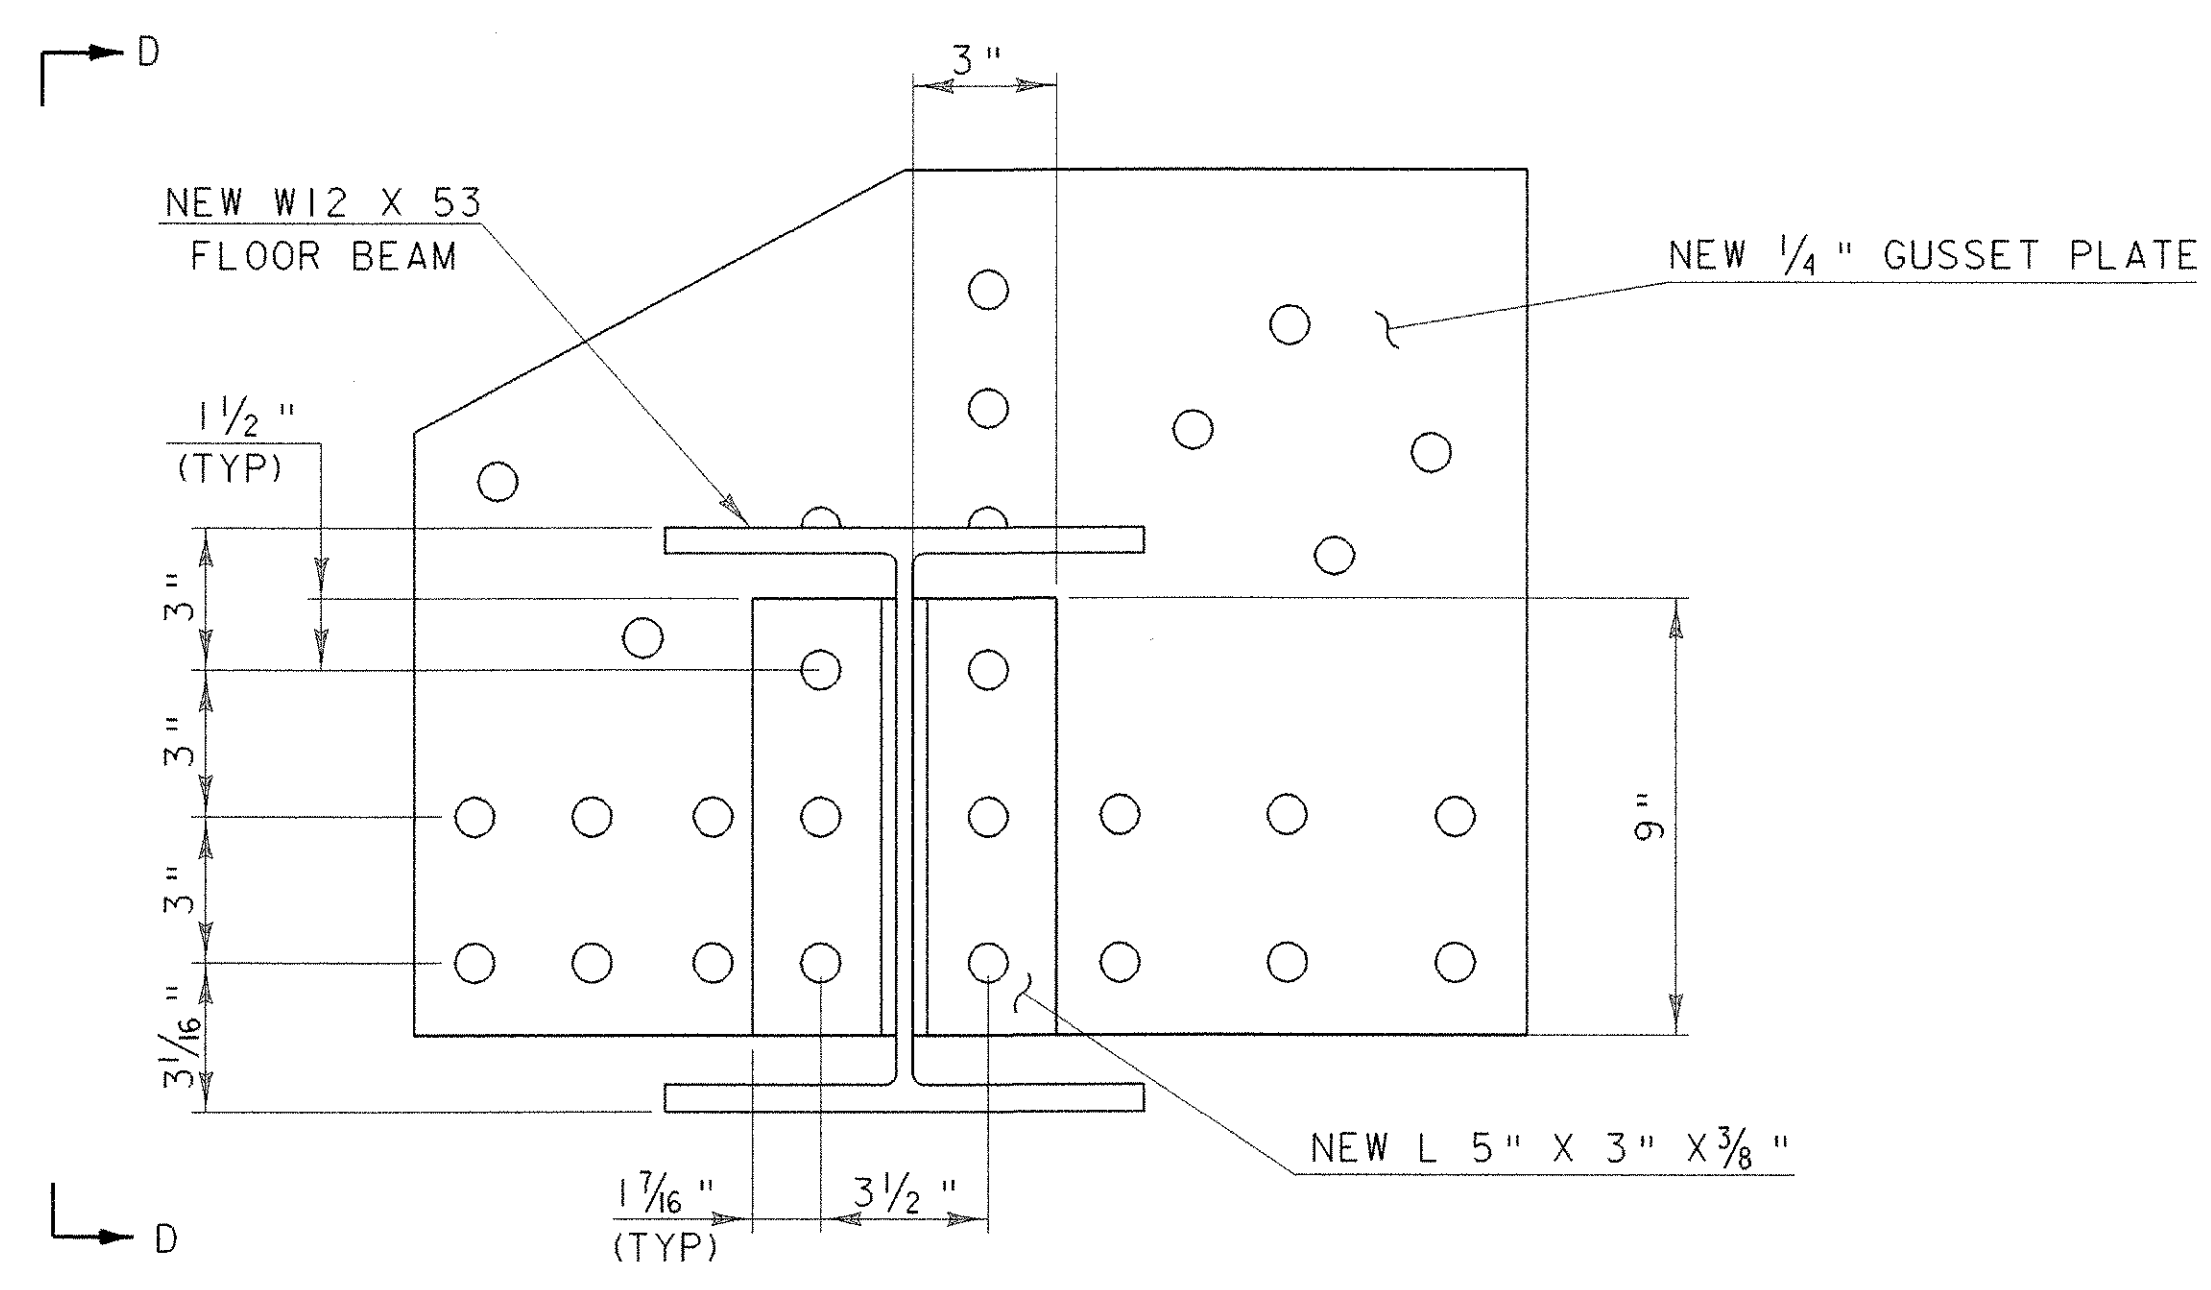


FLOOR BEAM CONNECTION AT  
PANEL POINTS 2 THROUGH 8

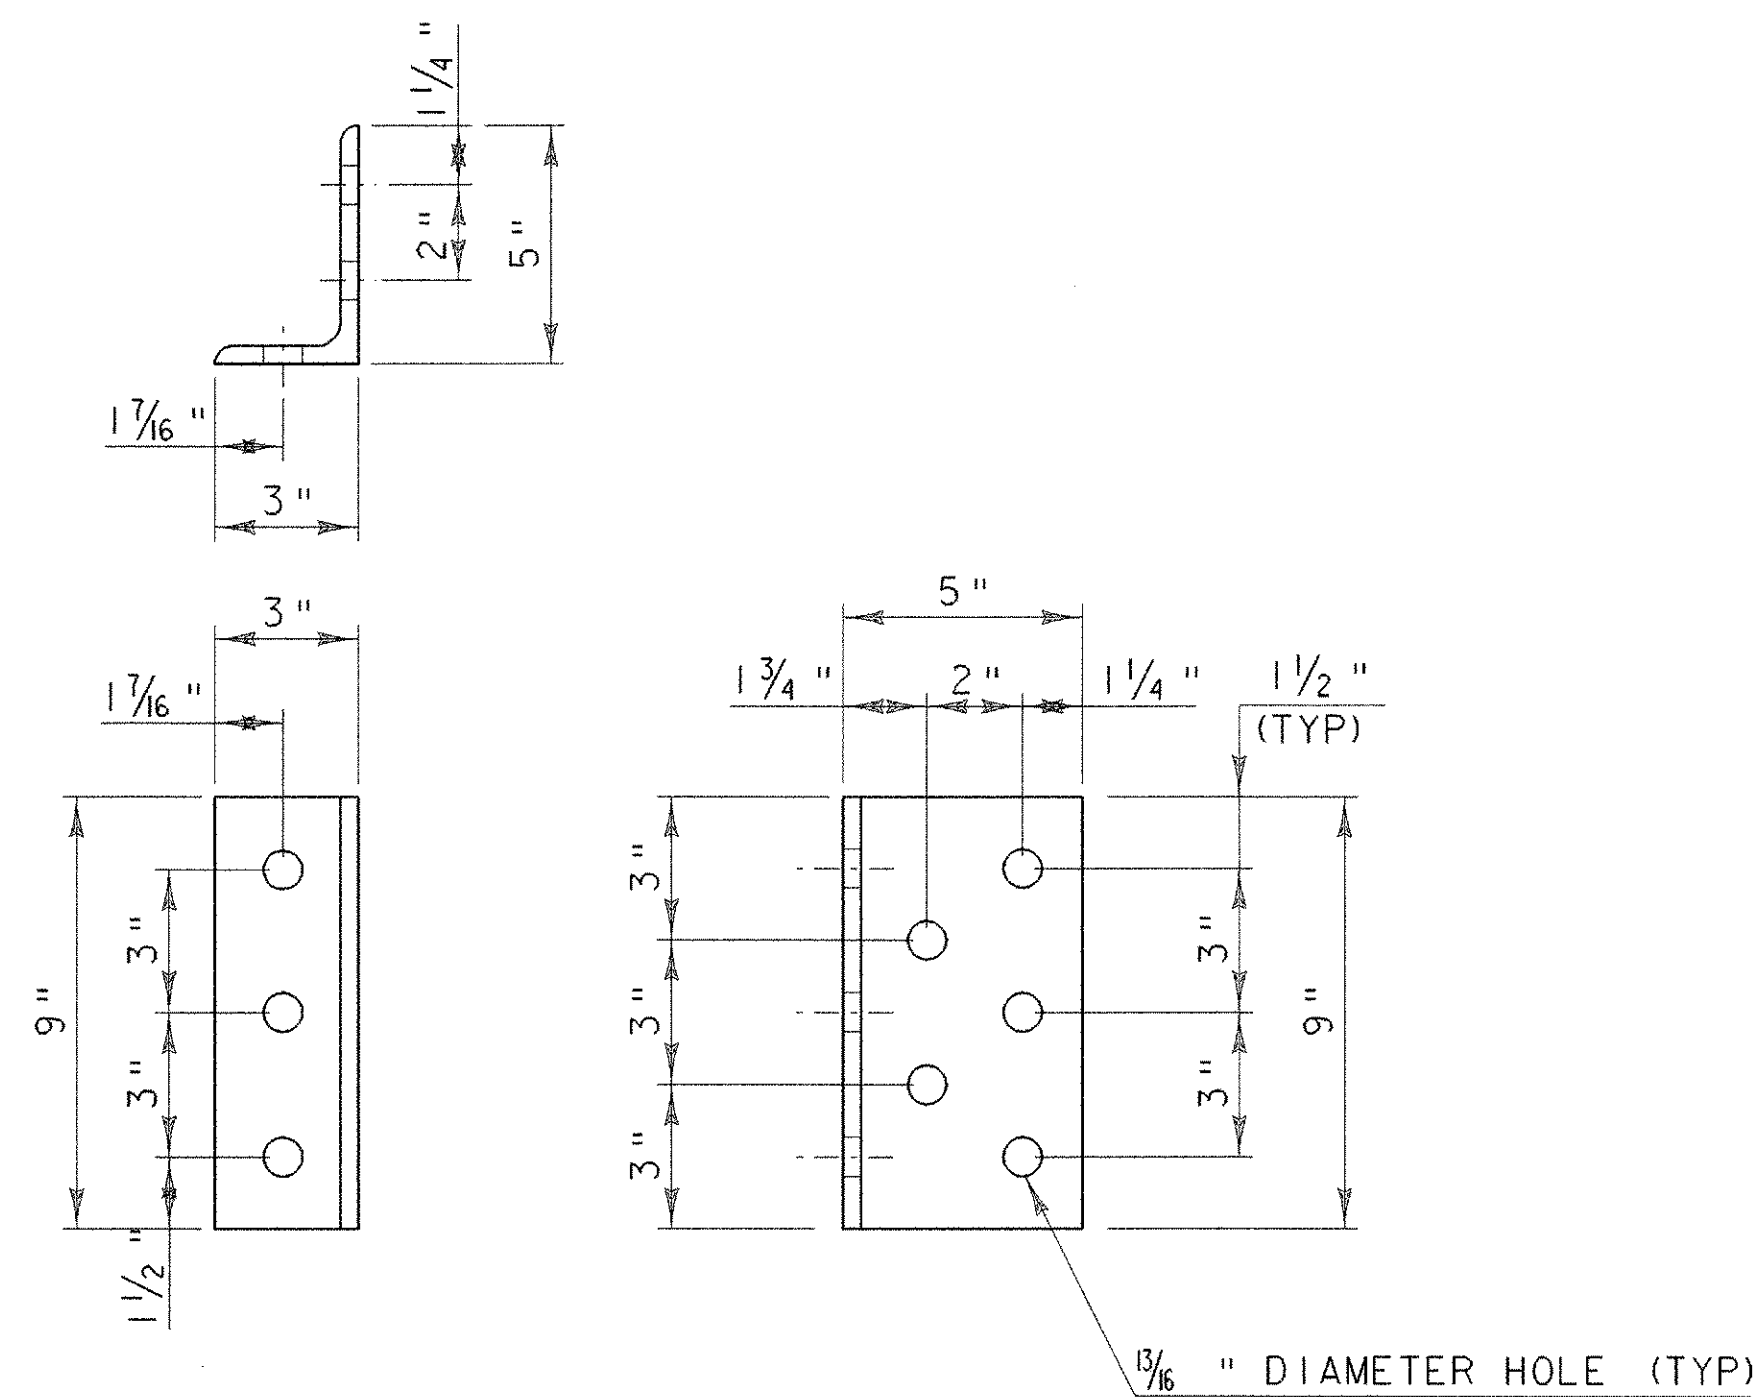


ANGLES AT PANEL  
POINTS 1 THROUGH 9

(36 REQUIRED)

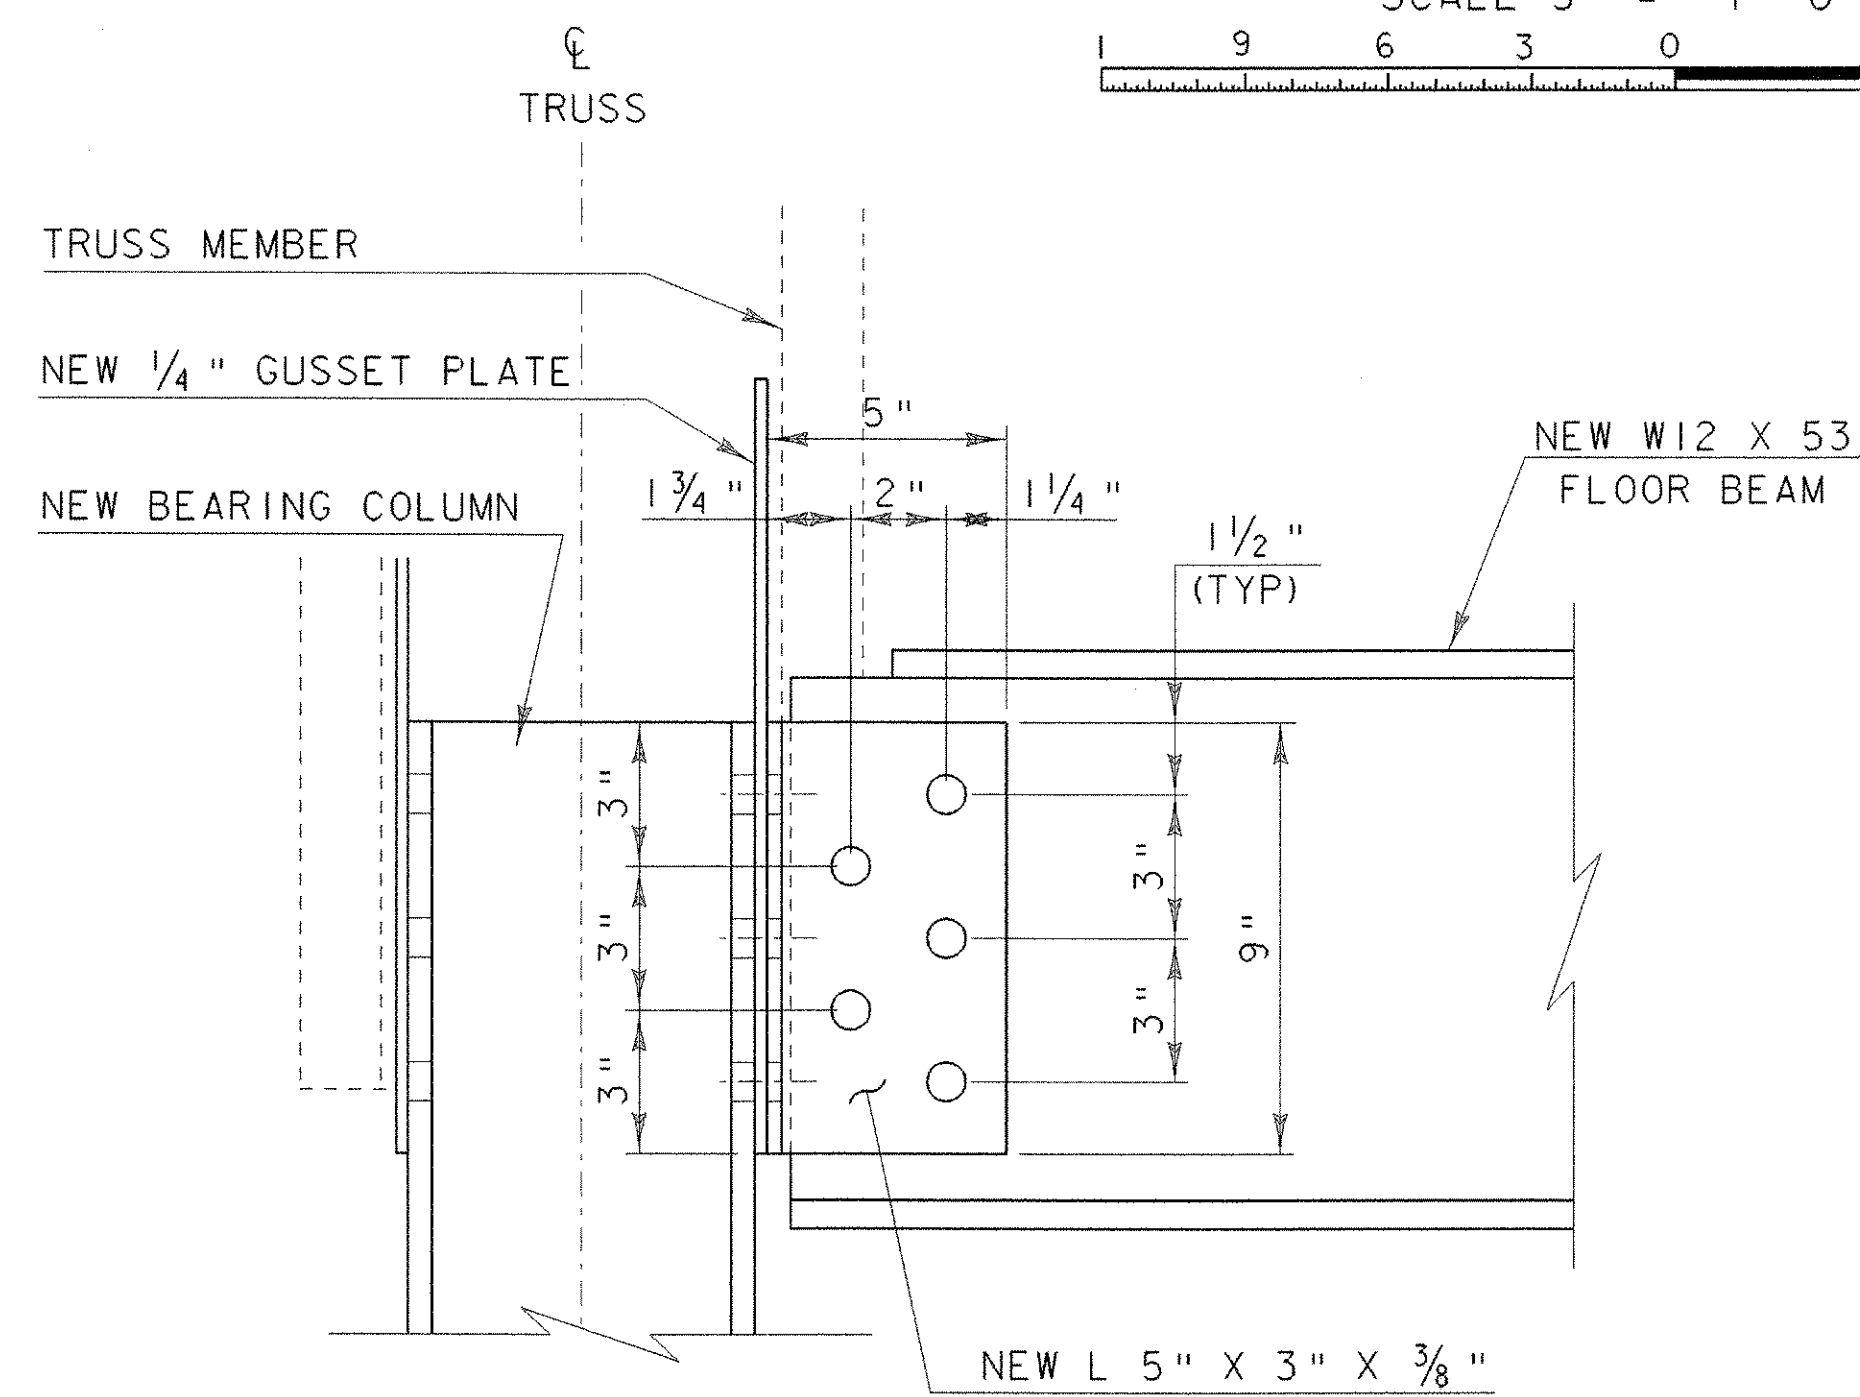

VIEW C-C

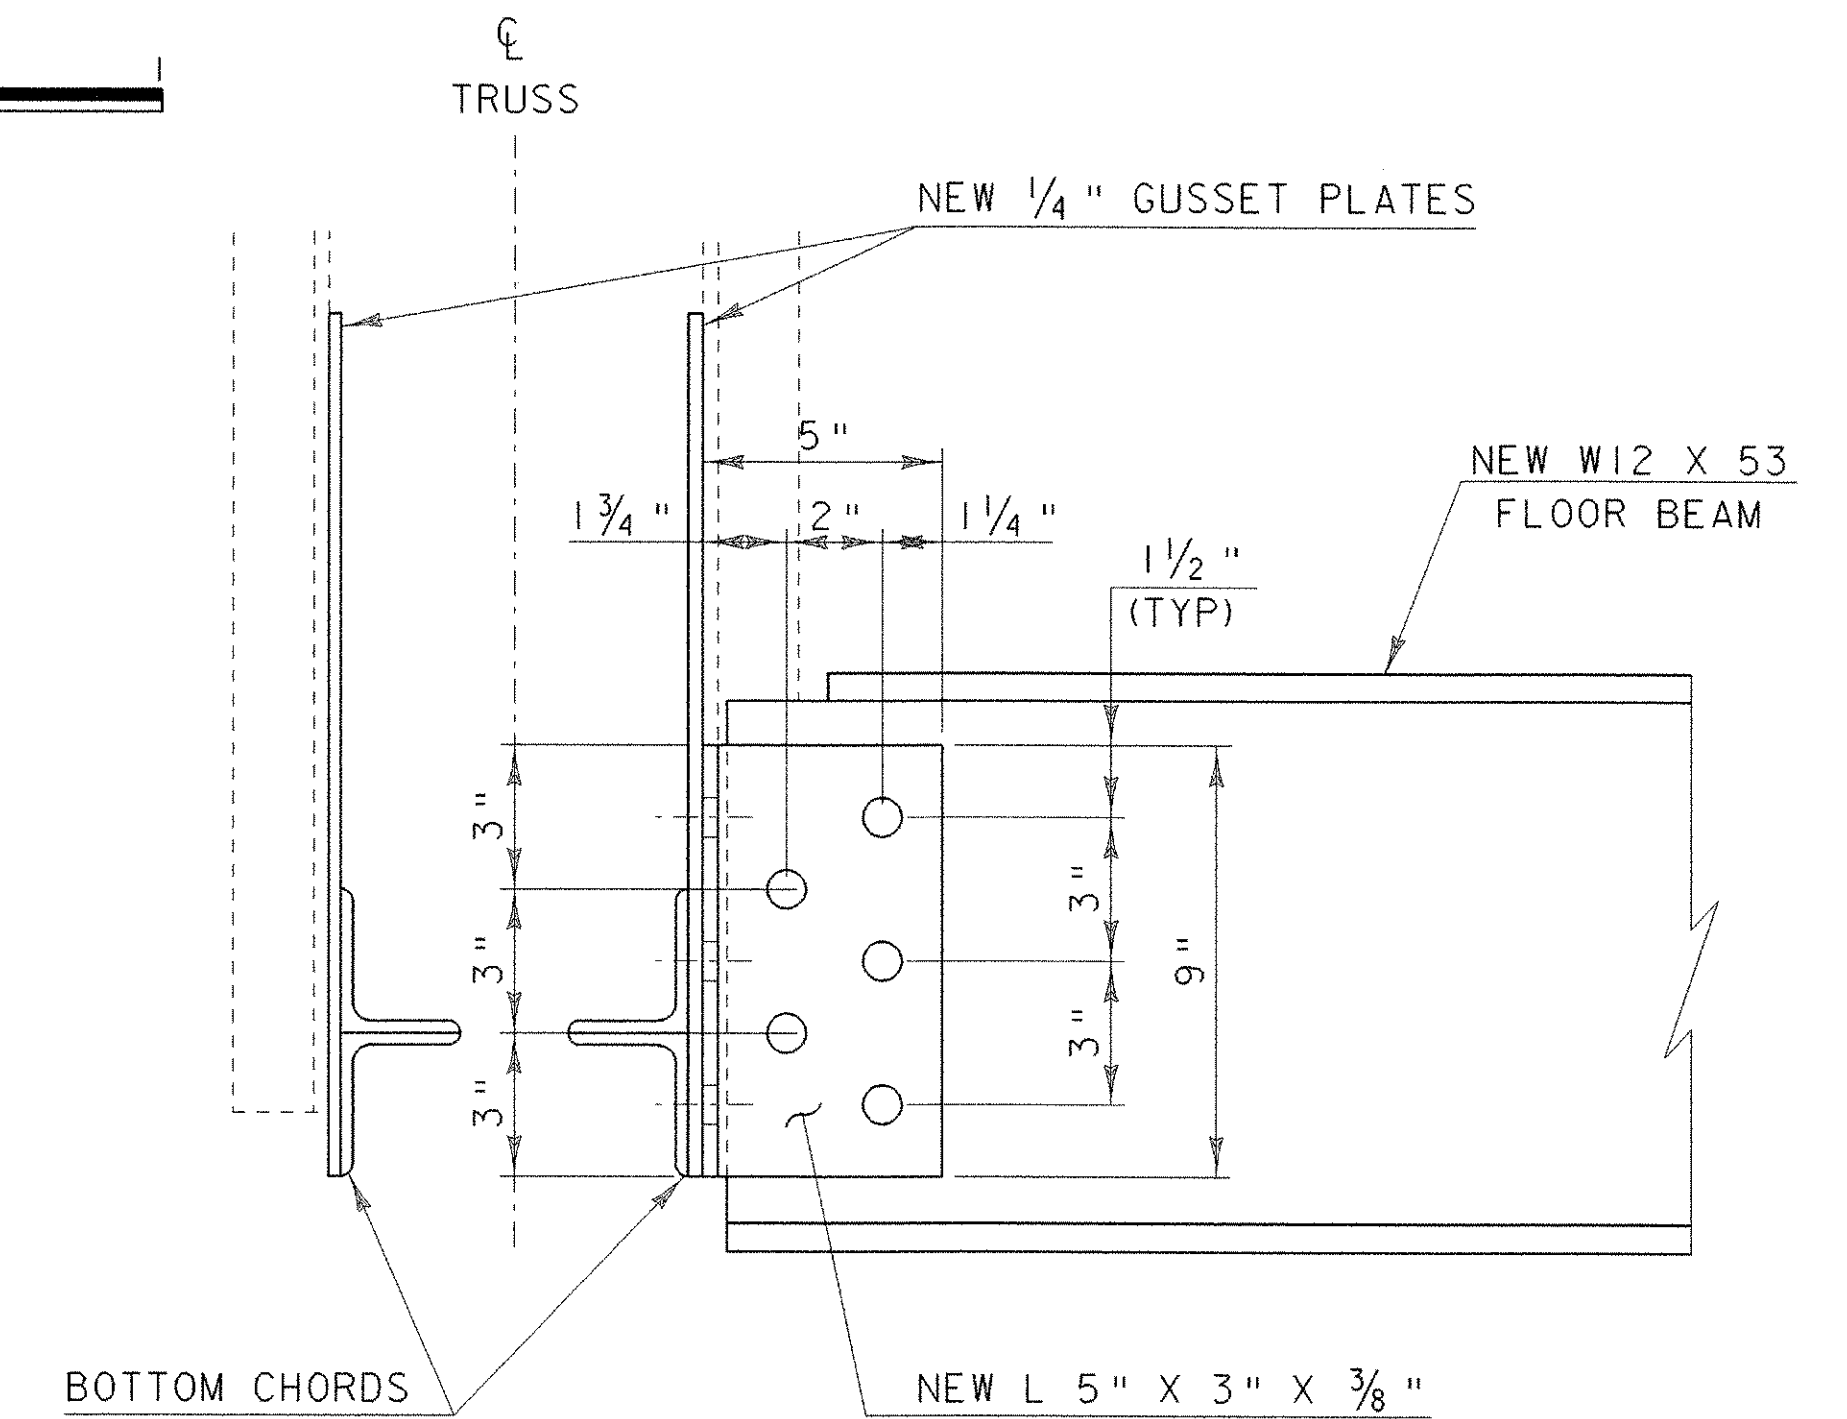


VIEW D-D



NOTE: EXISTING ANGLES CONNECTING THE TRUSS TO THE FLOOR BEAMS SHALL BE REPLACED WITH THE ANGLES DETAILED ON THIS SHEET.

PROJECT: NEW HAVEN-WEYBRIDGE	PROJECT NO.: BHO-BTN 2005 (1)
DESIGN FILE NAME: /89j081/structures/sj081 frame.dgn	PLOT DATE: 28-FEB-2007
IPARM FILE NAME: floorbeamconn.i	DESIGNED BY: R.S. YOUNG
SQUAD LEADER: C.P. WILLIAMS	DRAWN BY: R.S. YOUNG
FLOOR BEAM CONNECTION DETAILS	CHECKED BY: R.S. YOUNG
	SHEET: 18 OF 53

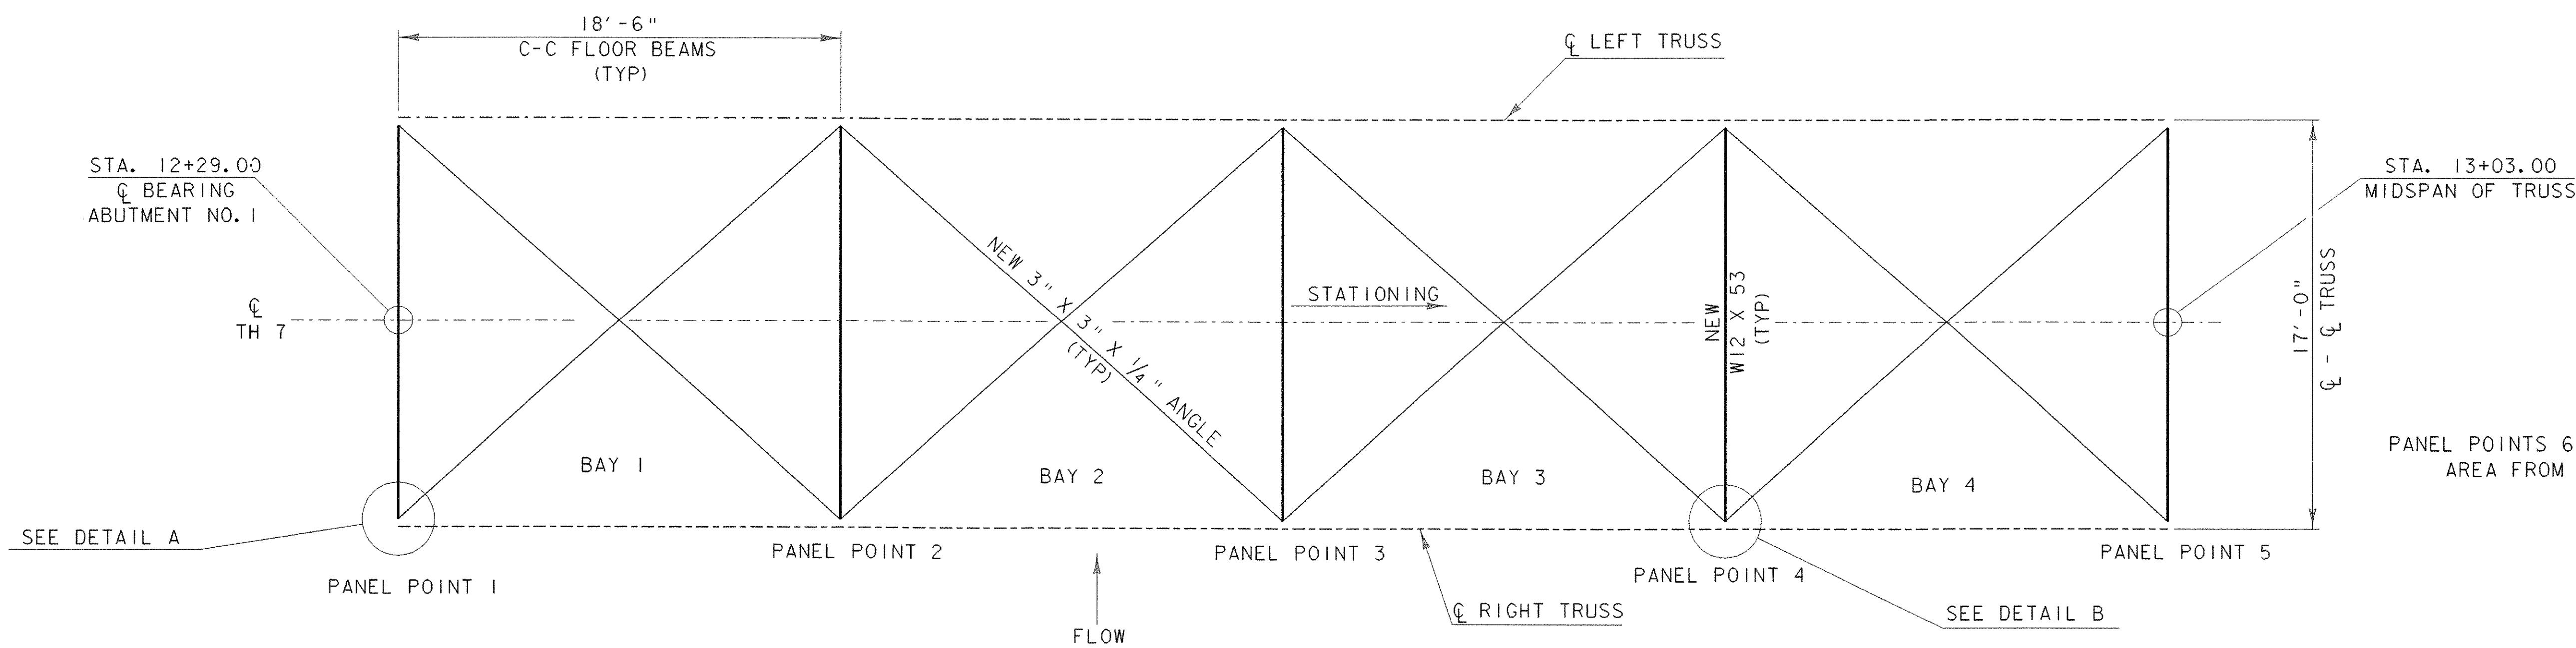


PANEL POINTS 6-9 AND BAYS 5-8 OCCUR IN THE AREA FROM MIDSPAN TO ABUTMENT NO. 2

### HALF PLAN OF FLOOR FRAMING PLAN


SCALE: 1/4" = 1'-0"

(BRIDGE FRAMING PLAN SYMMETRICAL ABOUT MIDSPAN)

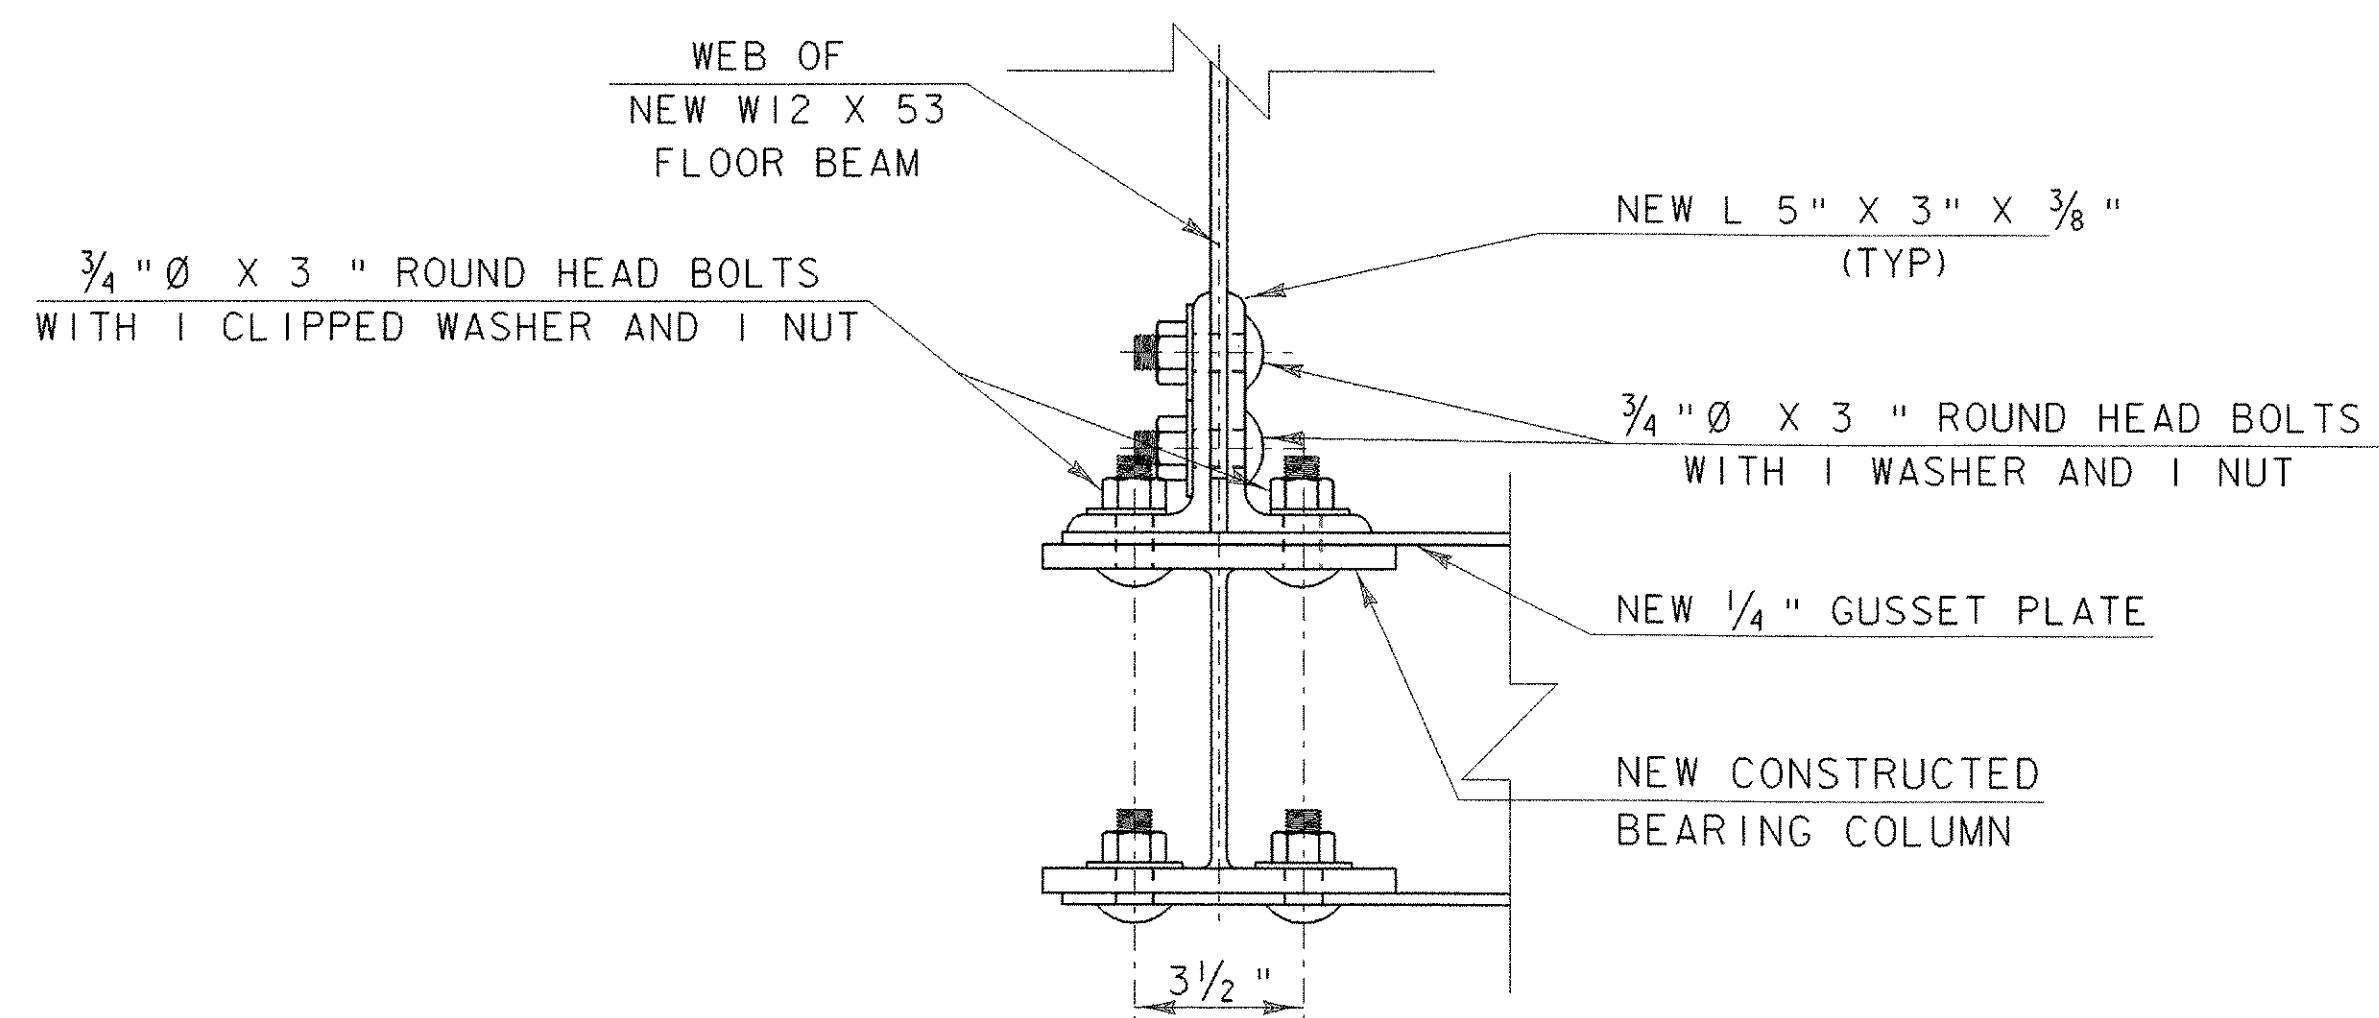


DETAIL A  
PLAN OF NEW FLOOR BEAM CONNECTION  
PANEL POINTS 1 AND 9

SCALE: 3" = 1'-0"

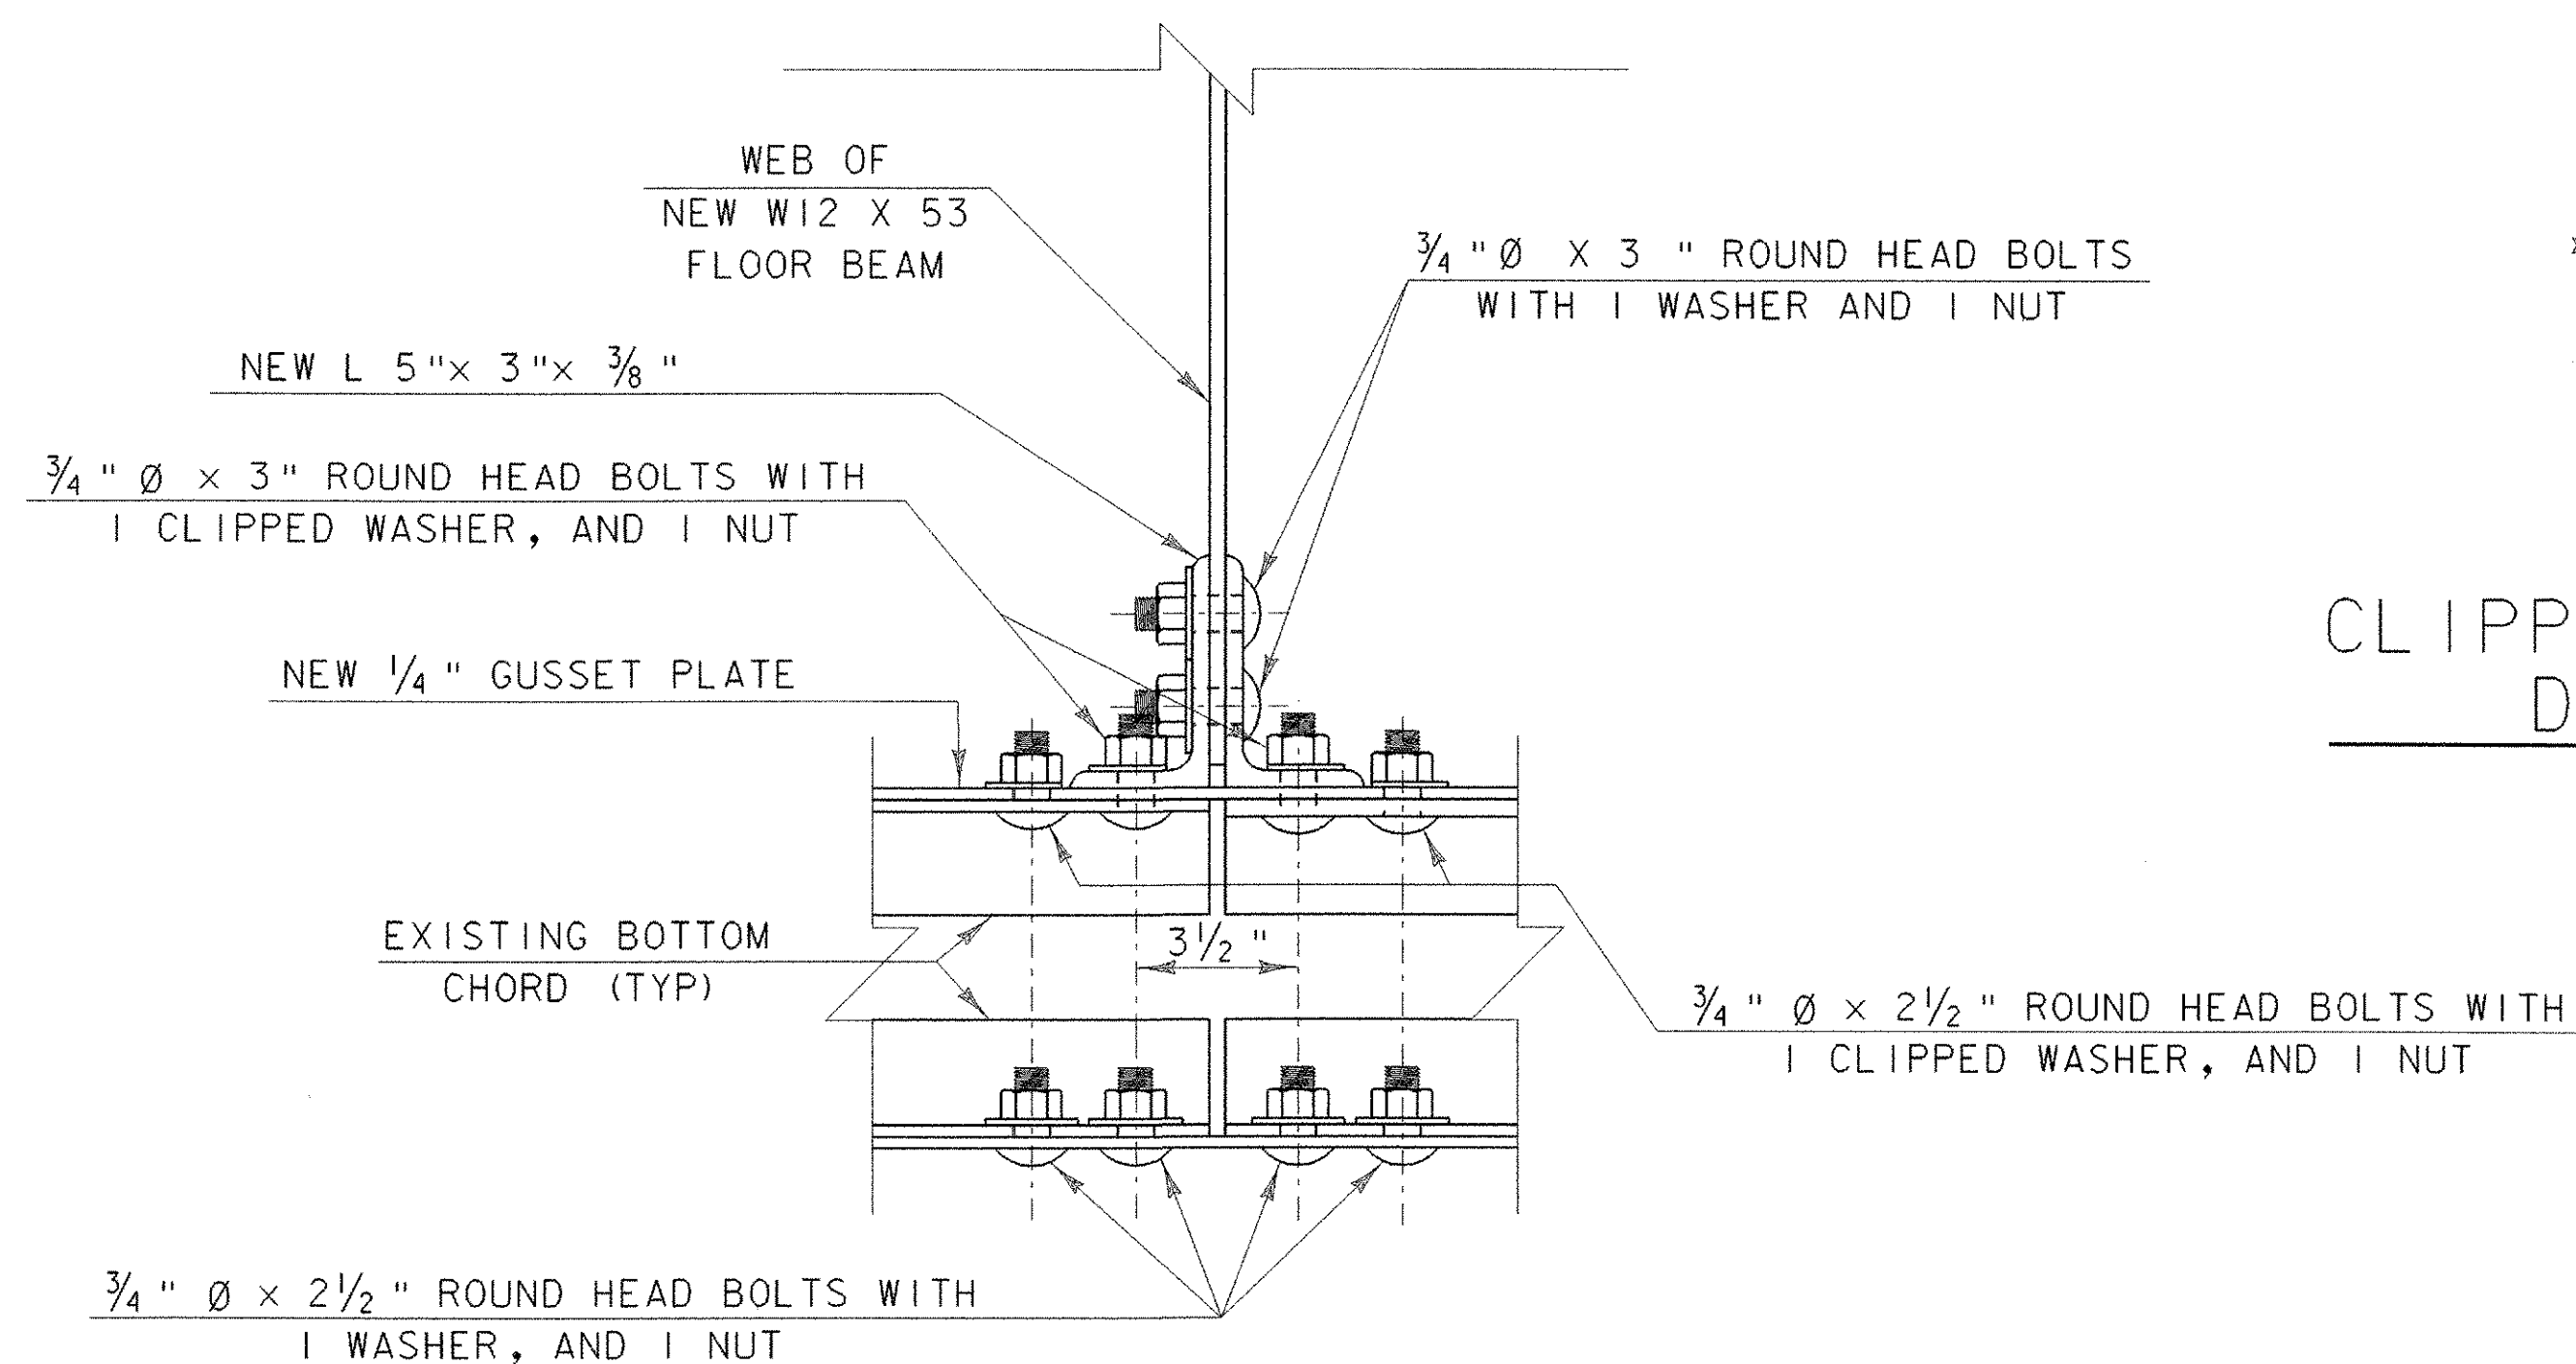


DETAIL B  
PLAN OF NEW FLOOR BEAM CONNECTION  
PANEL POINTS 2 THROUGH 8


SCALE: 3" = 1'-0"

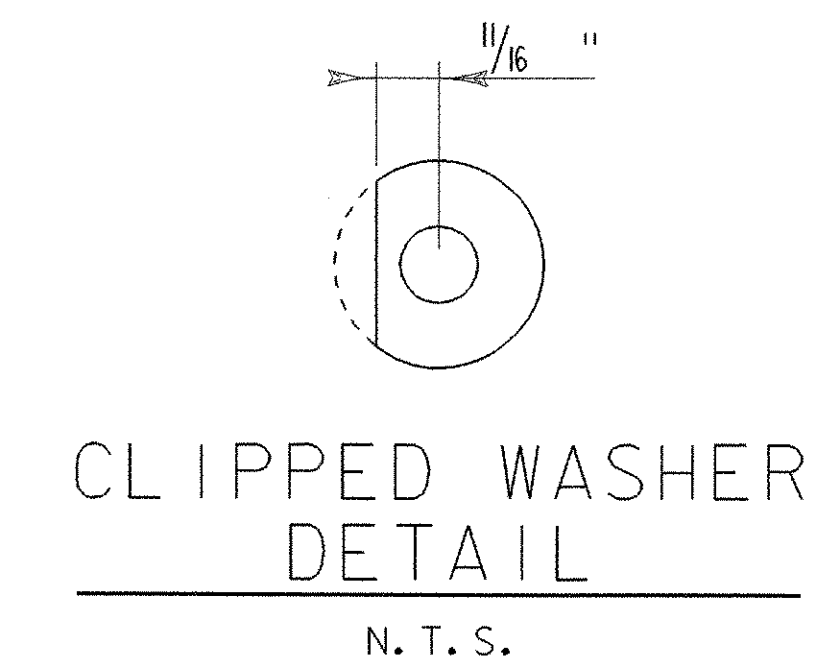


SCALE 1/4" = 1'-0"

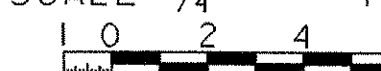

SCALE 3" = 1'-0"

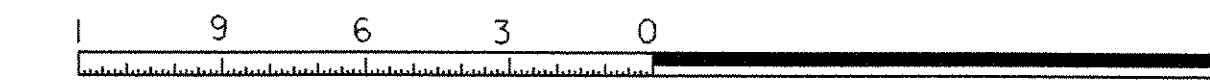


PROJECT: NEW HAVEN-WEYBRIDGE	PROJECT NO.: BHO-BTN 2005 (1)
DESIGN FILE NAME: /89j081/structures/sj081 frame.dgn	PLOT DATE: 28-FEB-2007
IPARM FILE NAME: frame.i	DESIGNED BY: R. S. YOUNG
SQUAD LEADER: C. P. WILLIAMS	DRAWN BY: D. A. ECKSTEIN
FRAMING PLAN & CONNECTION DETAILS	CHECKED BY: R. S. YOUNG
	SHEET: 19 OF 53

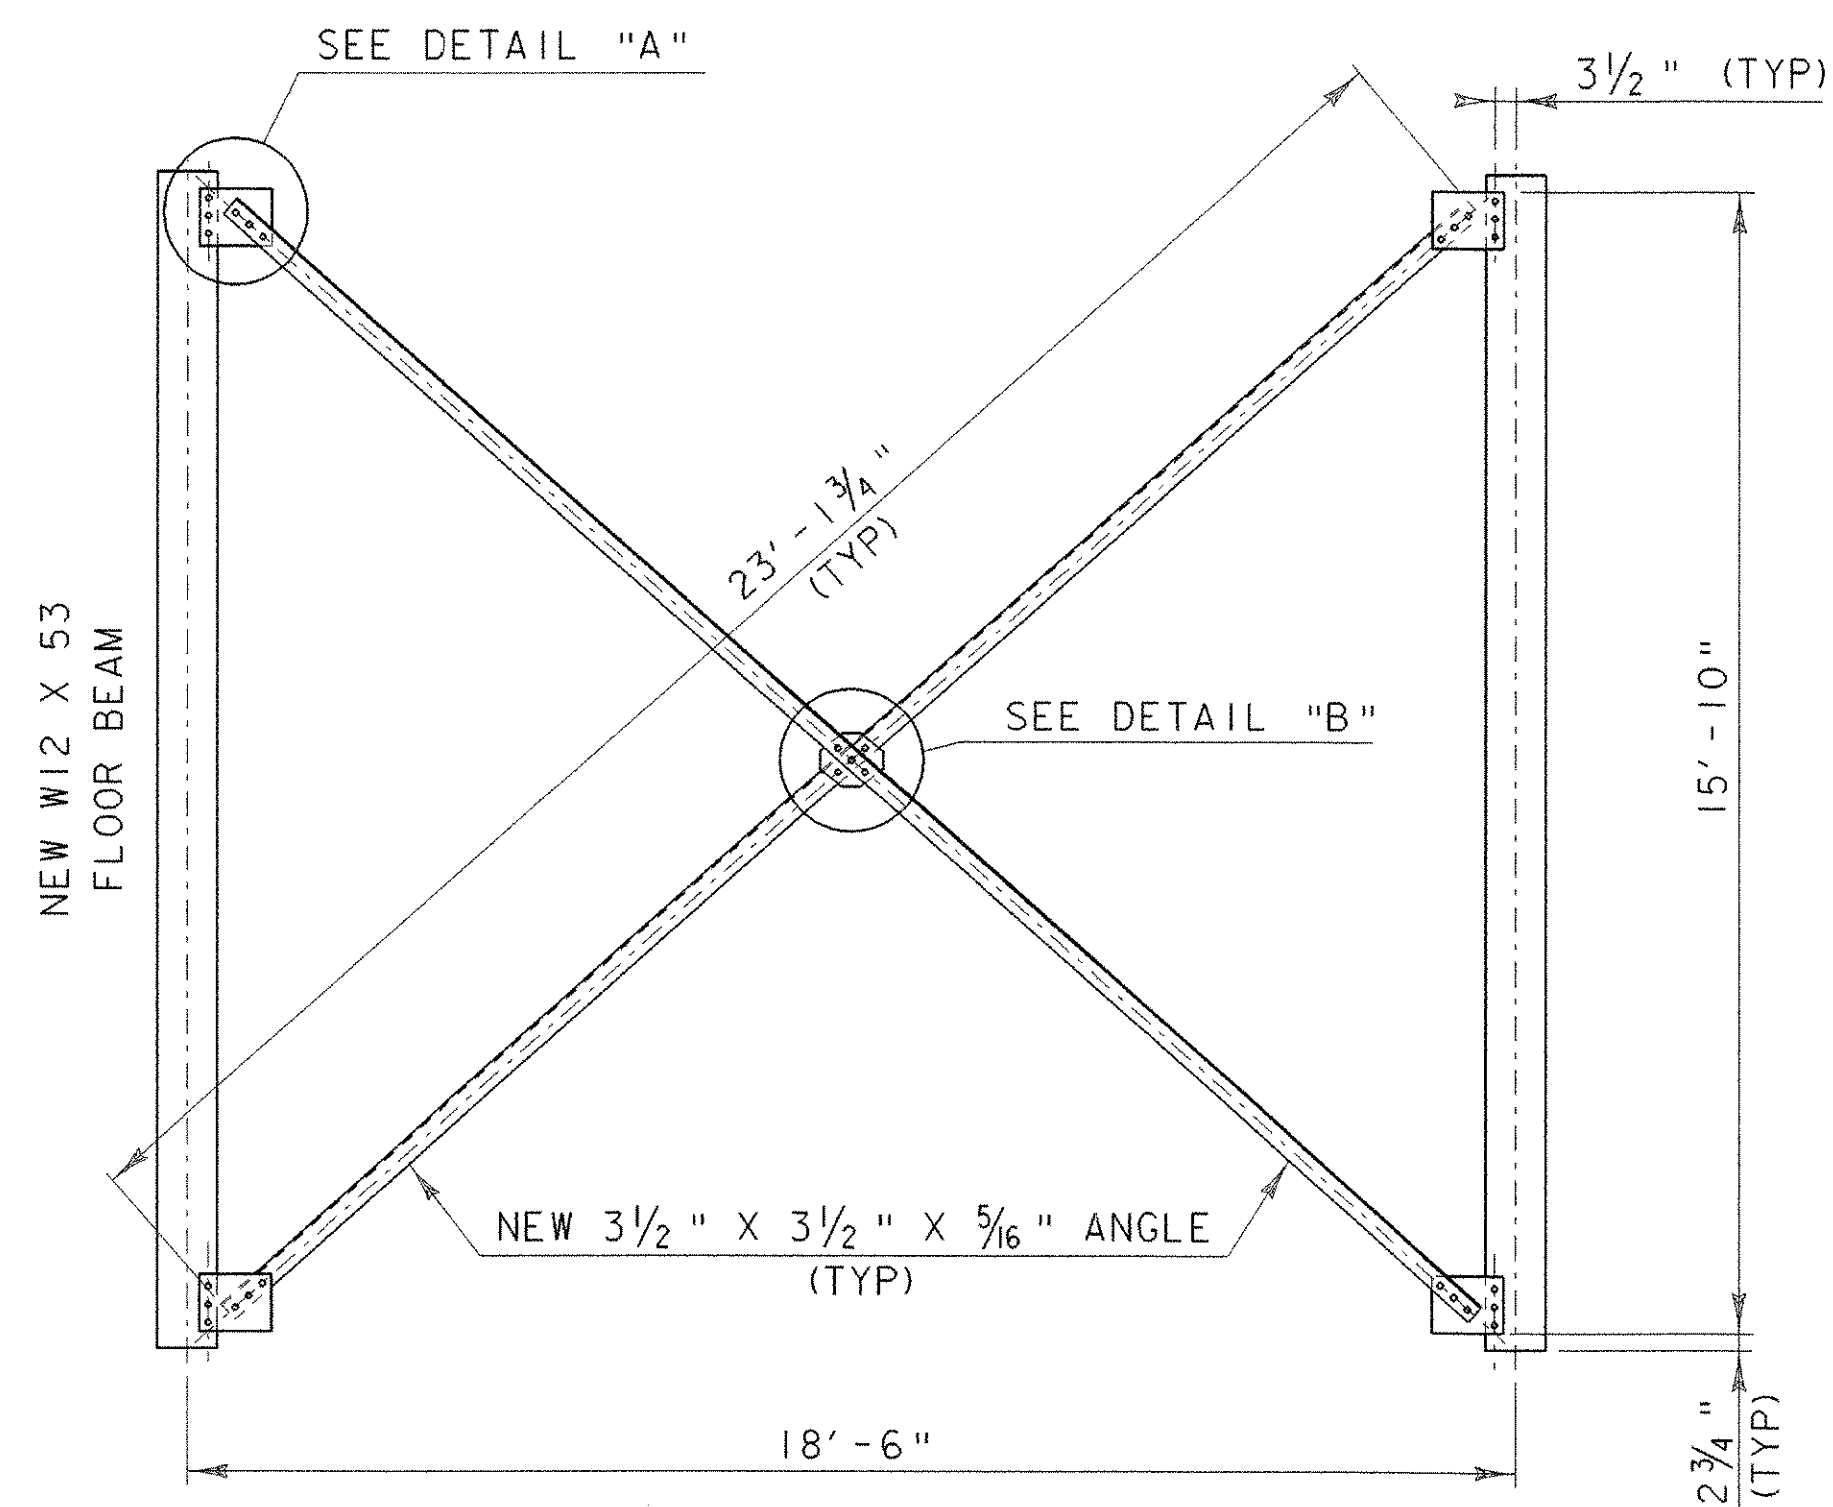


LATERAL BRACING DETAIL

SCALE: 3/8" = 1'-0"

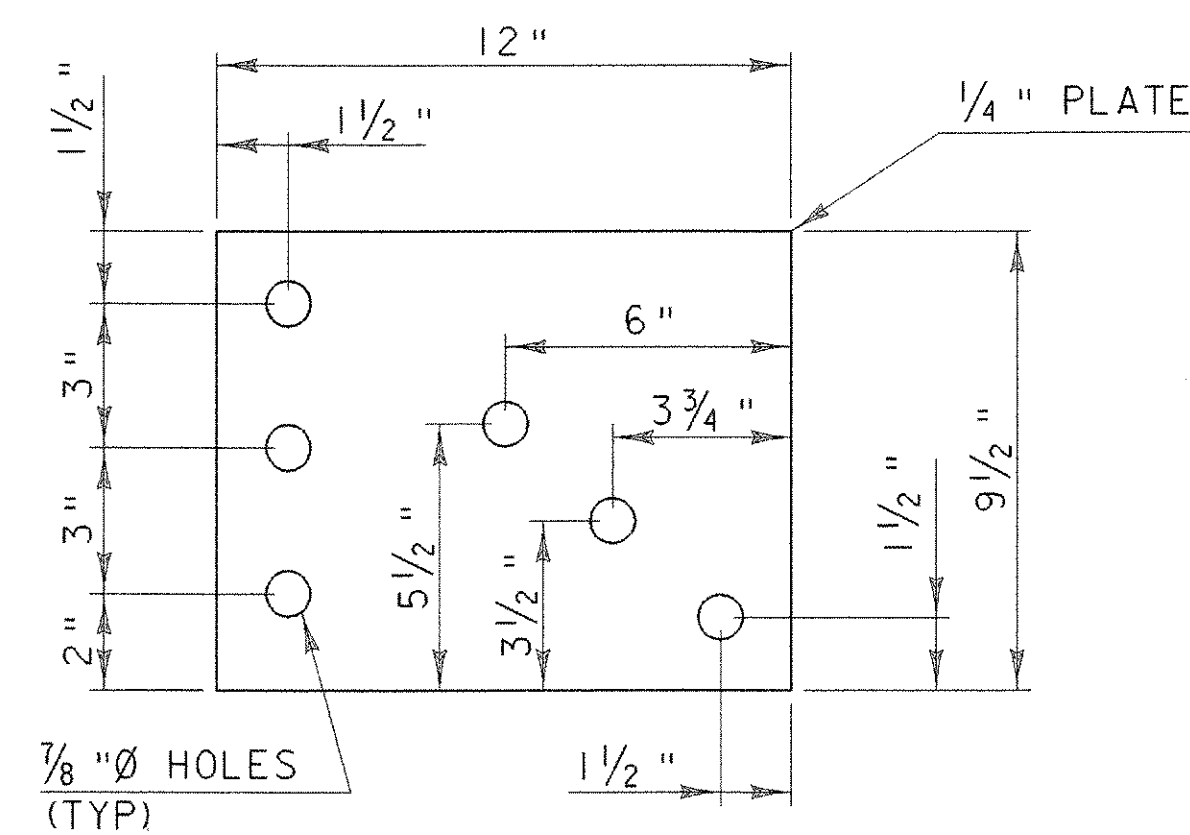


DETAIL "A"  
END CONNECTION PLATE

SCALE: 3" = 1'-0"  
(32 REQUIRED)

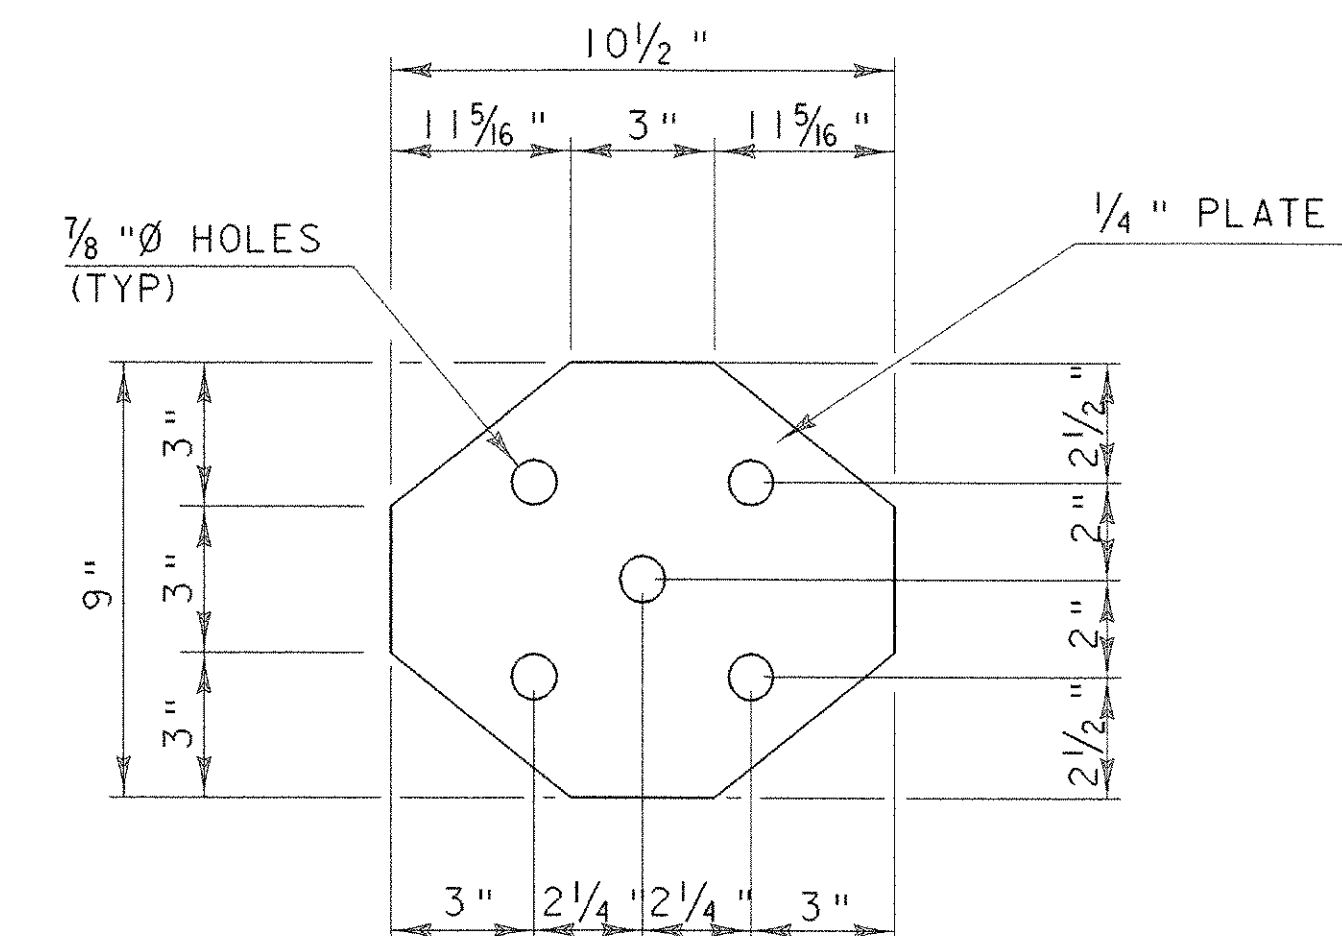

DETAIL "B"  
CENTER CONNECTION PLATE

SCALE: 3" = 1'-0"  
(8 REQUIRED)

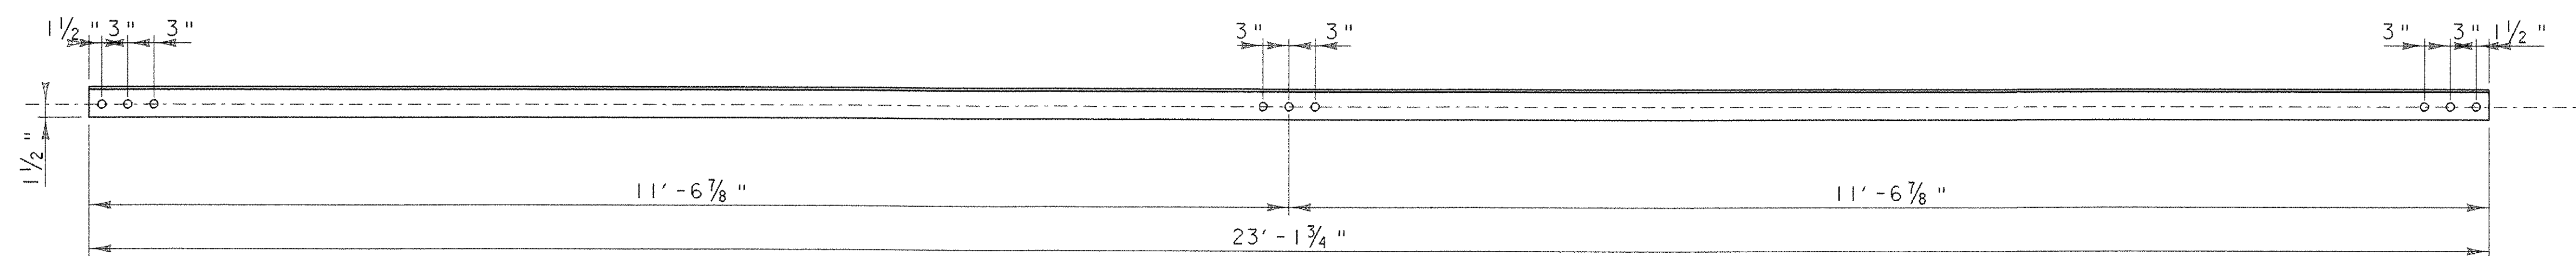

LATERAL BRACING (TYP)  
3 1/2" X 3 1/2" X 5/16" ANGLE

SCALE: 1" = 1'-0"


SCALE 3/8" = 1'-0




SCALE 1" = 1'-0



SCALE 3" = 1'-0

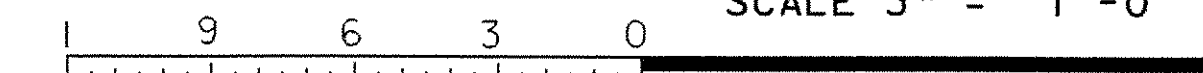


PROJECT: NEW HAVEN-WEYBRIDGE	PROJECT NO. : BHO-BTN 2005 (1)
DESIGN FILE NAME: /89j081/structures/sj081 frame.dgn	
IPARM FILE NAME: bracing.i	PLOT DATE: 28-FEB-2007
DESIGNED BY: R. S. YOUNG	DRAWN BY: D. A. ECKSTEIN
SQUAD LEADER: C. P. WILLIAMS	CHECKED BY: R. S. YOUNG
LATERAL BRACING DETAILS	SHEET: 20 OF 53

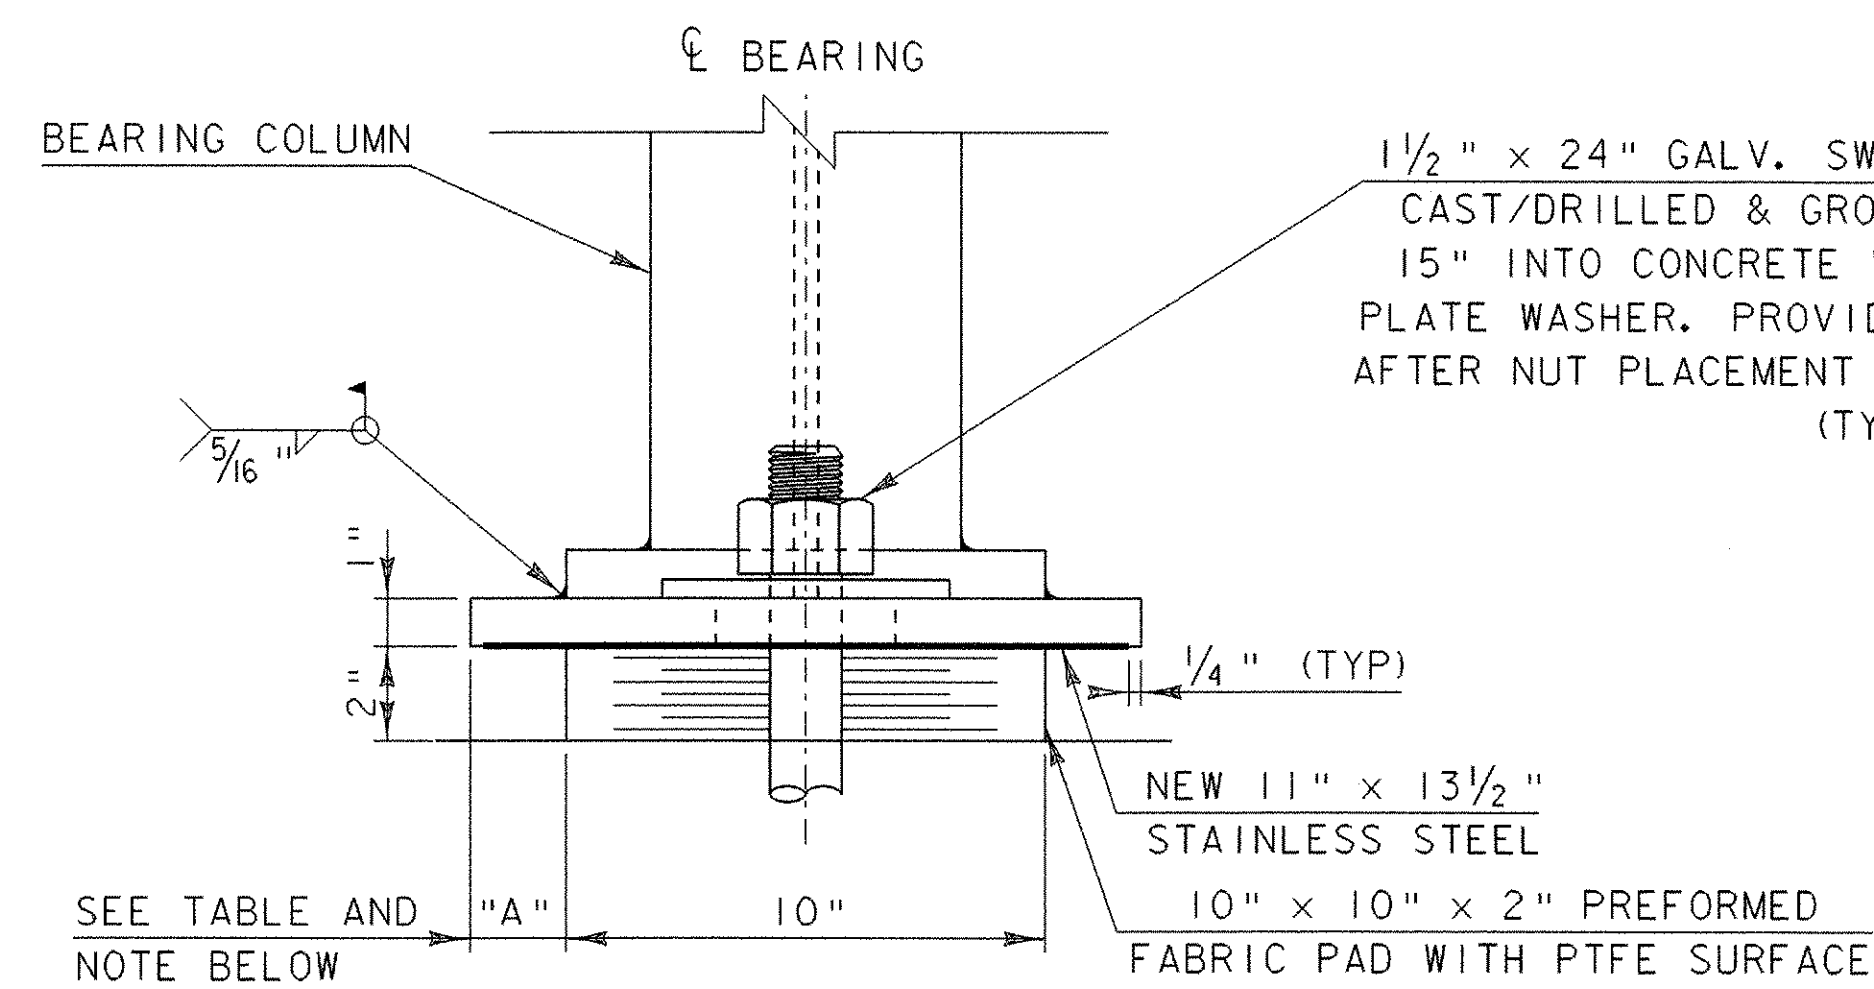


**SIDE ELEVATION EXPANSION BEARING**

STA 12 + 29.00

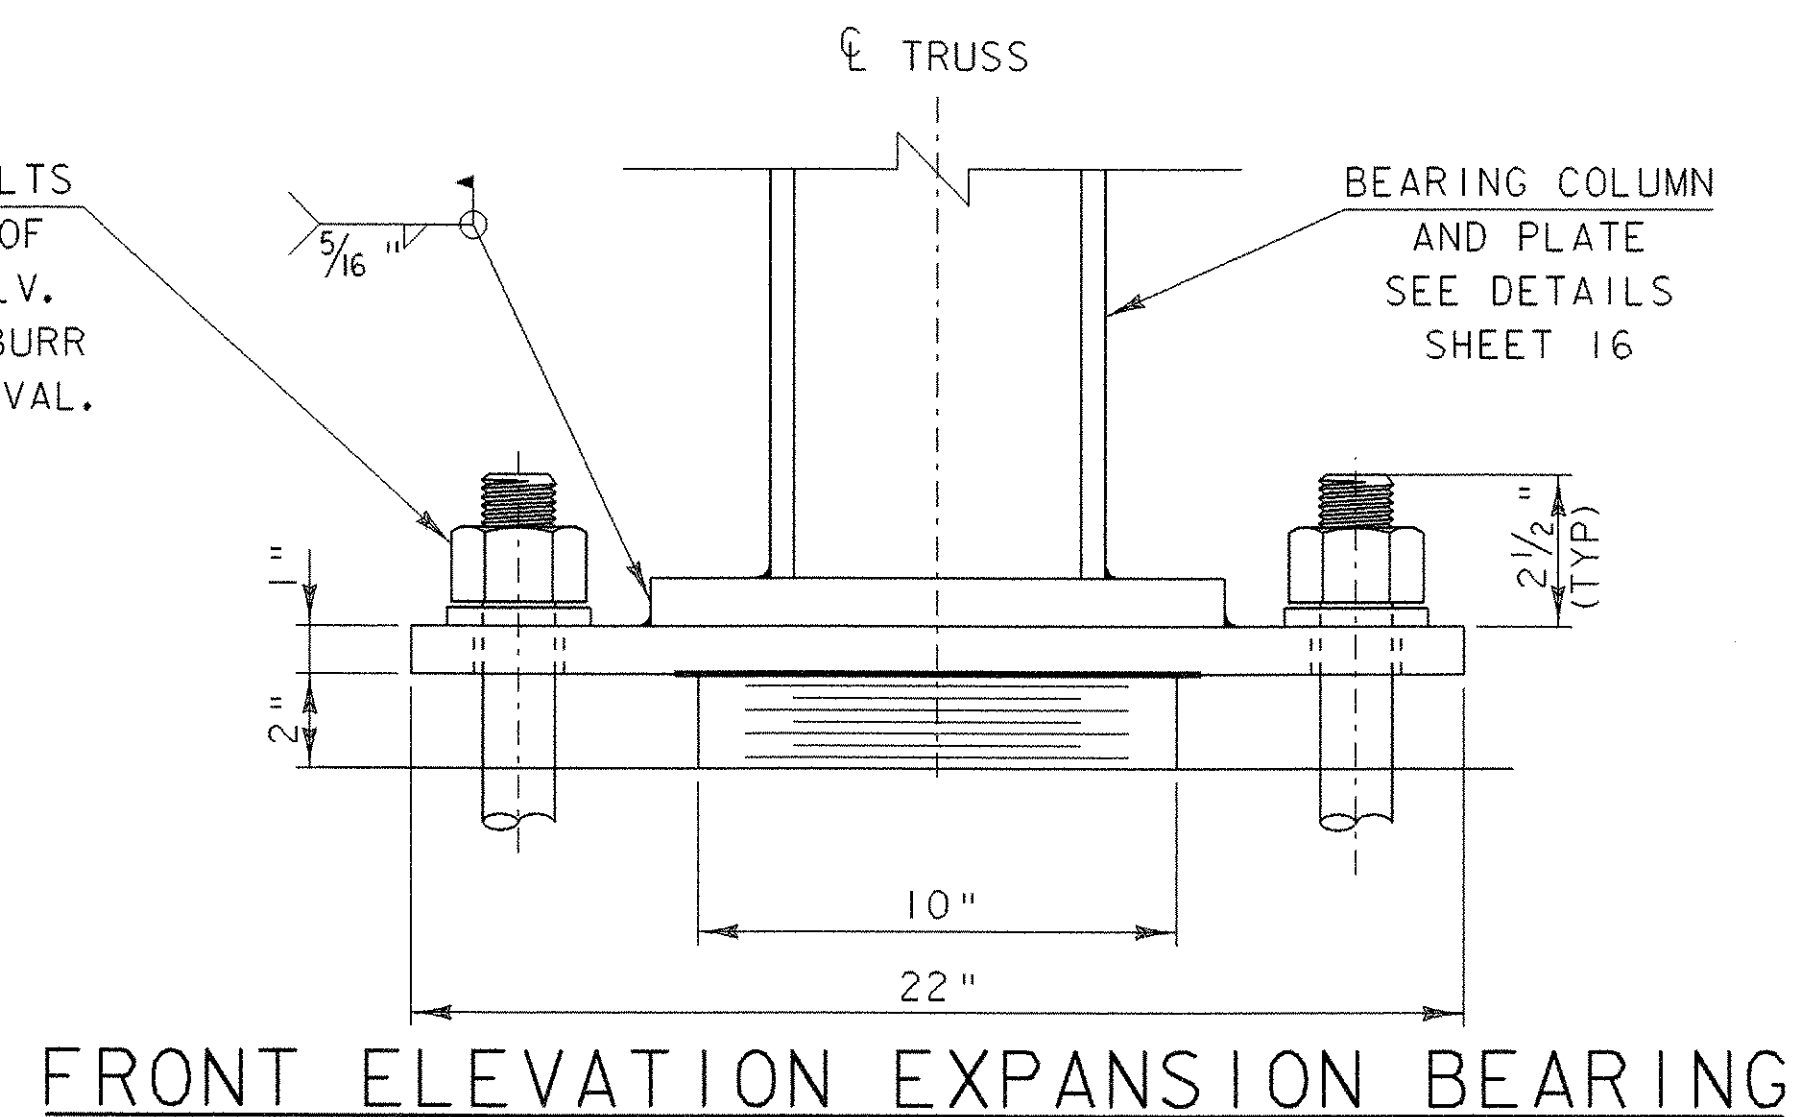


**FRONT ELEVATION EXPANSION BEARING**

STA 12 + 29.00

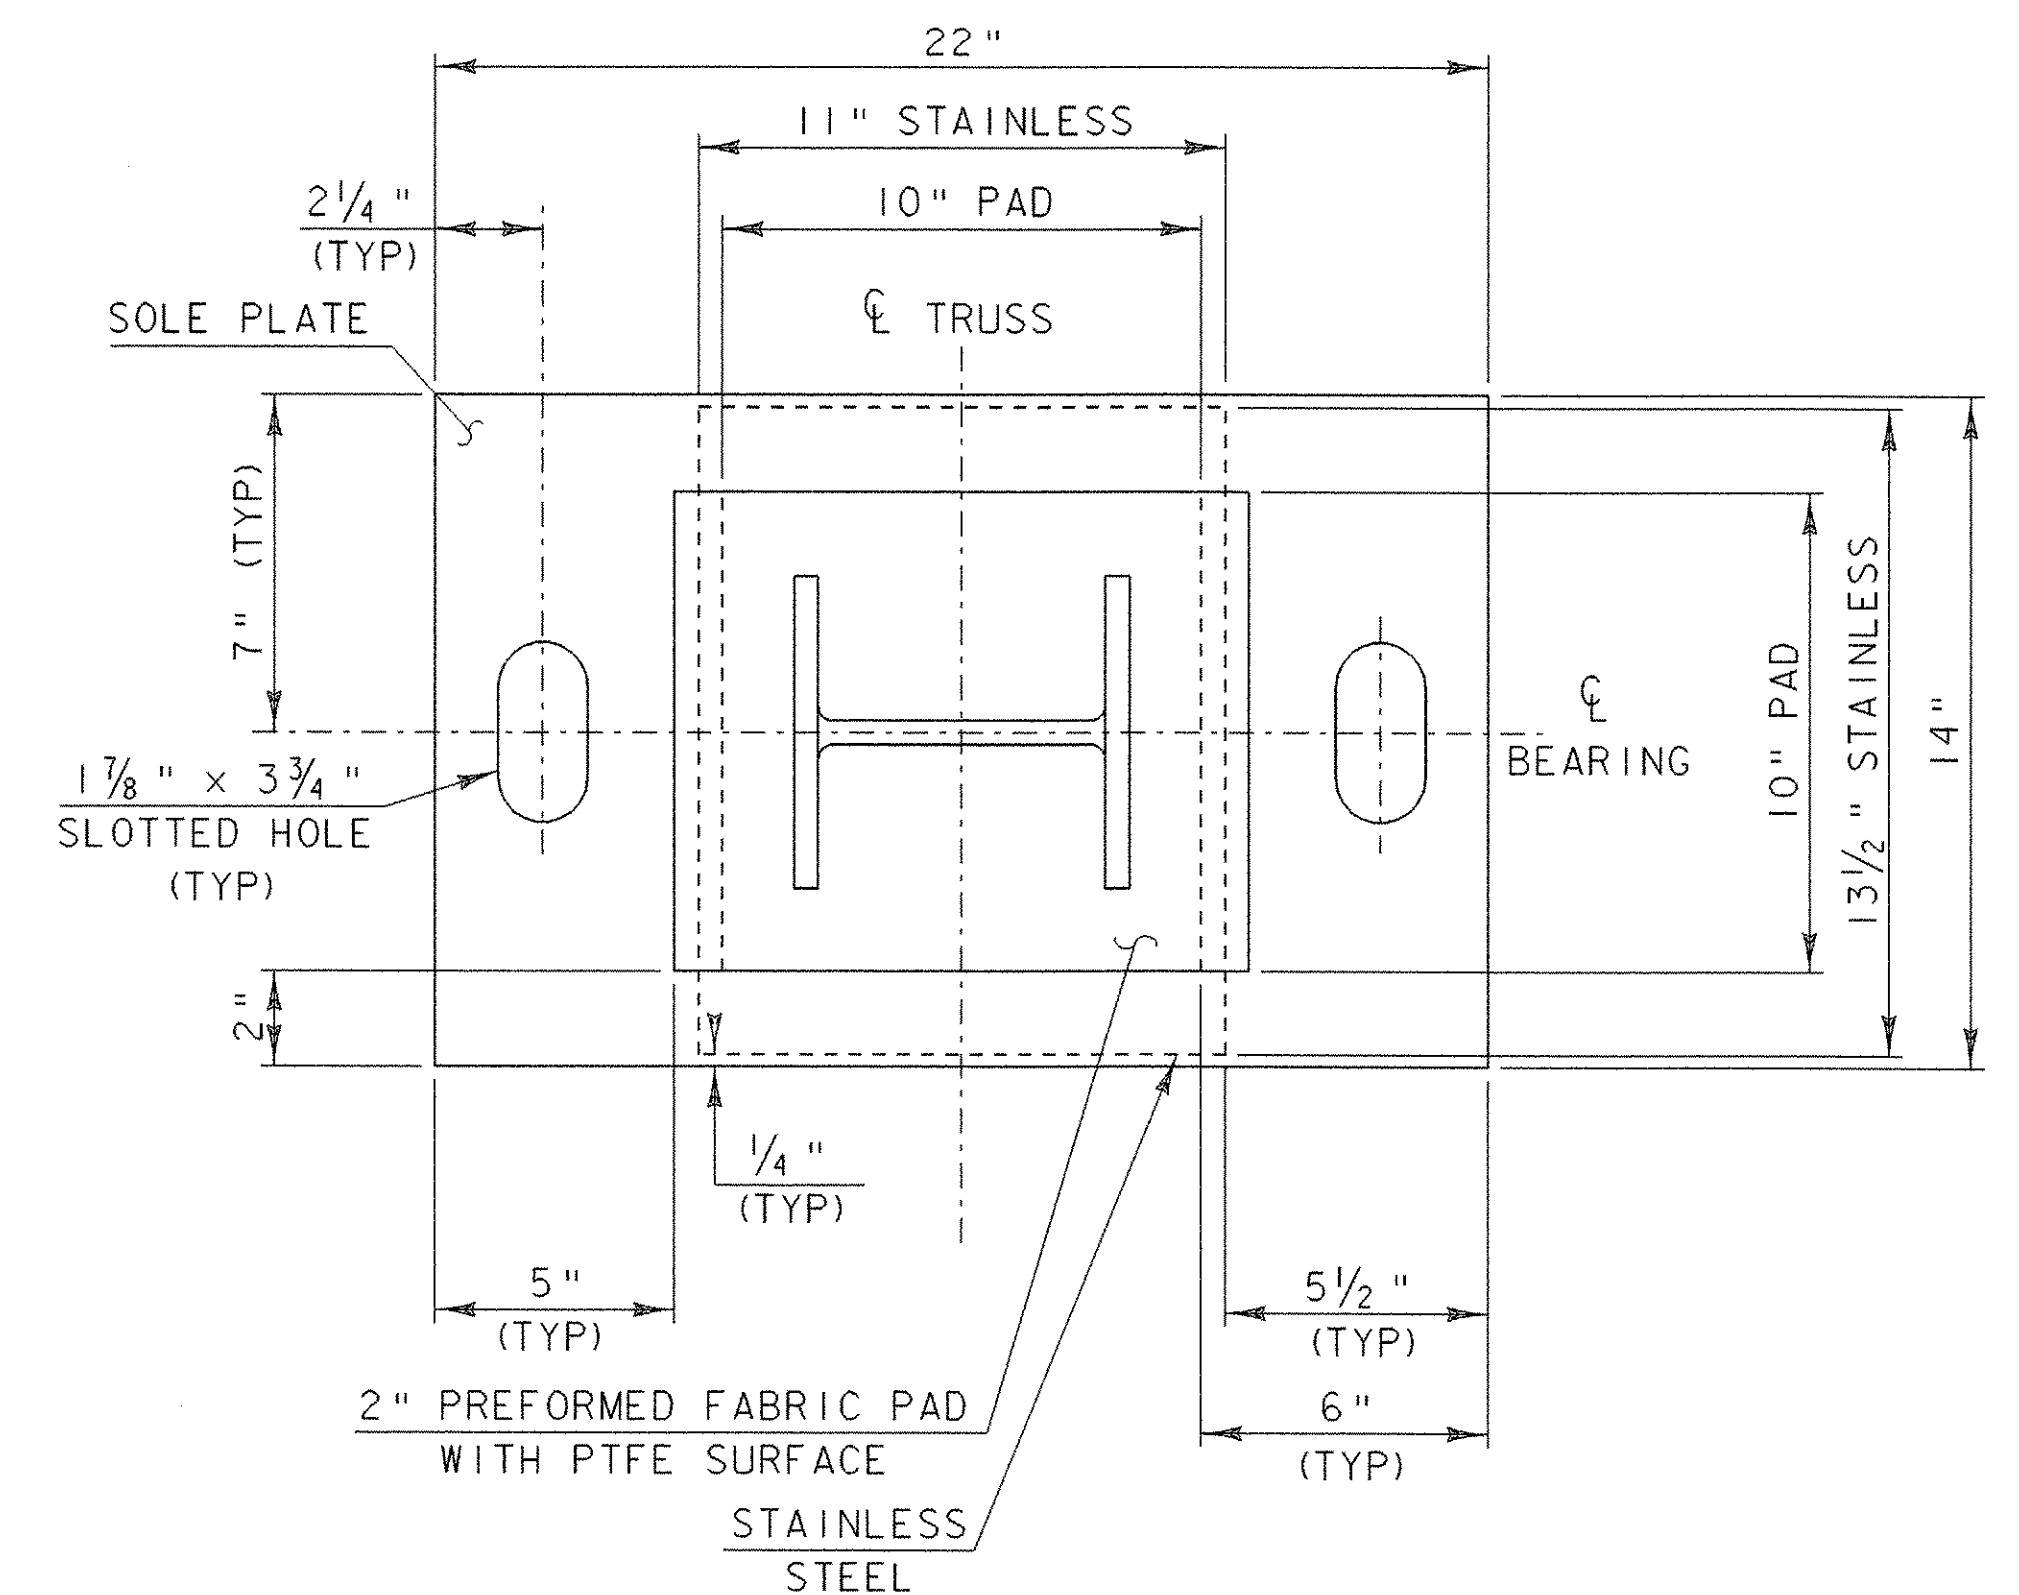


**PLAN VIEW EXPANSION BEARING**

STA 12 + 29.00

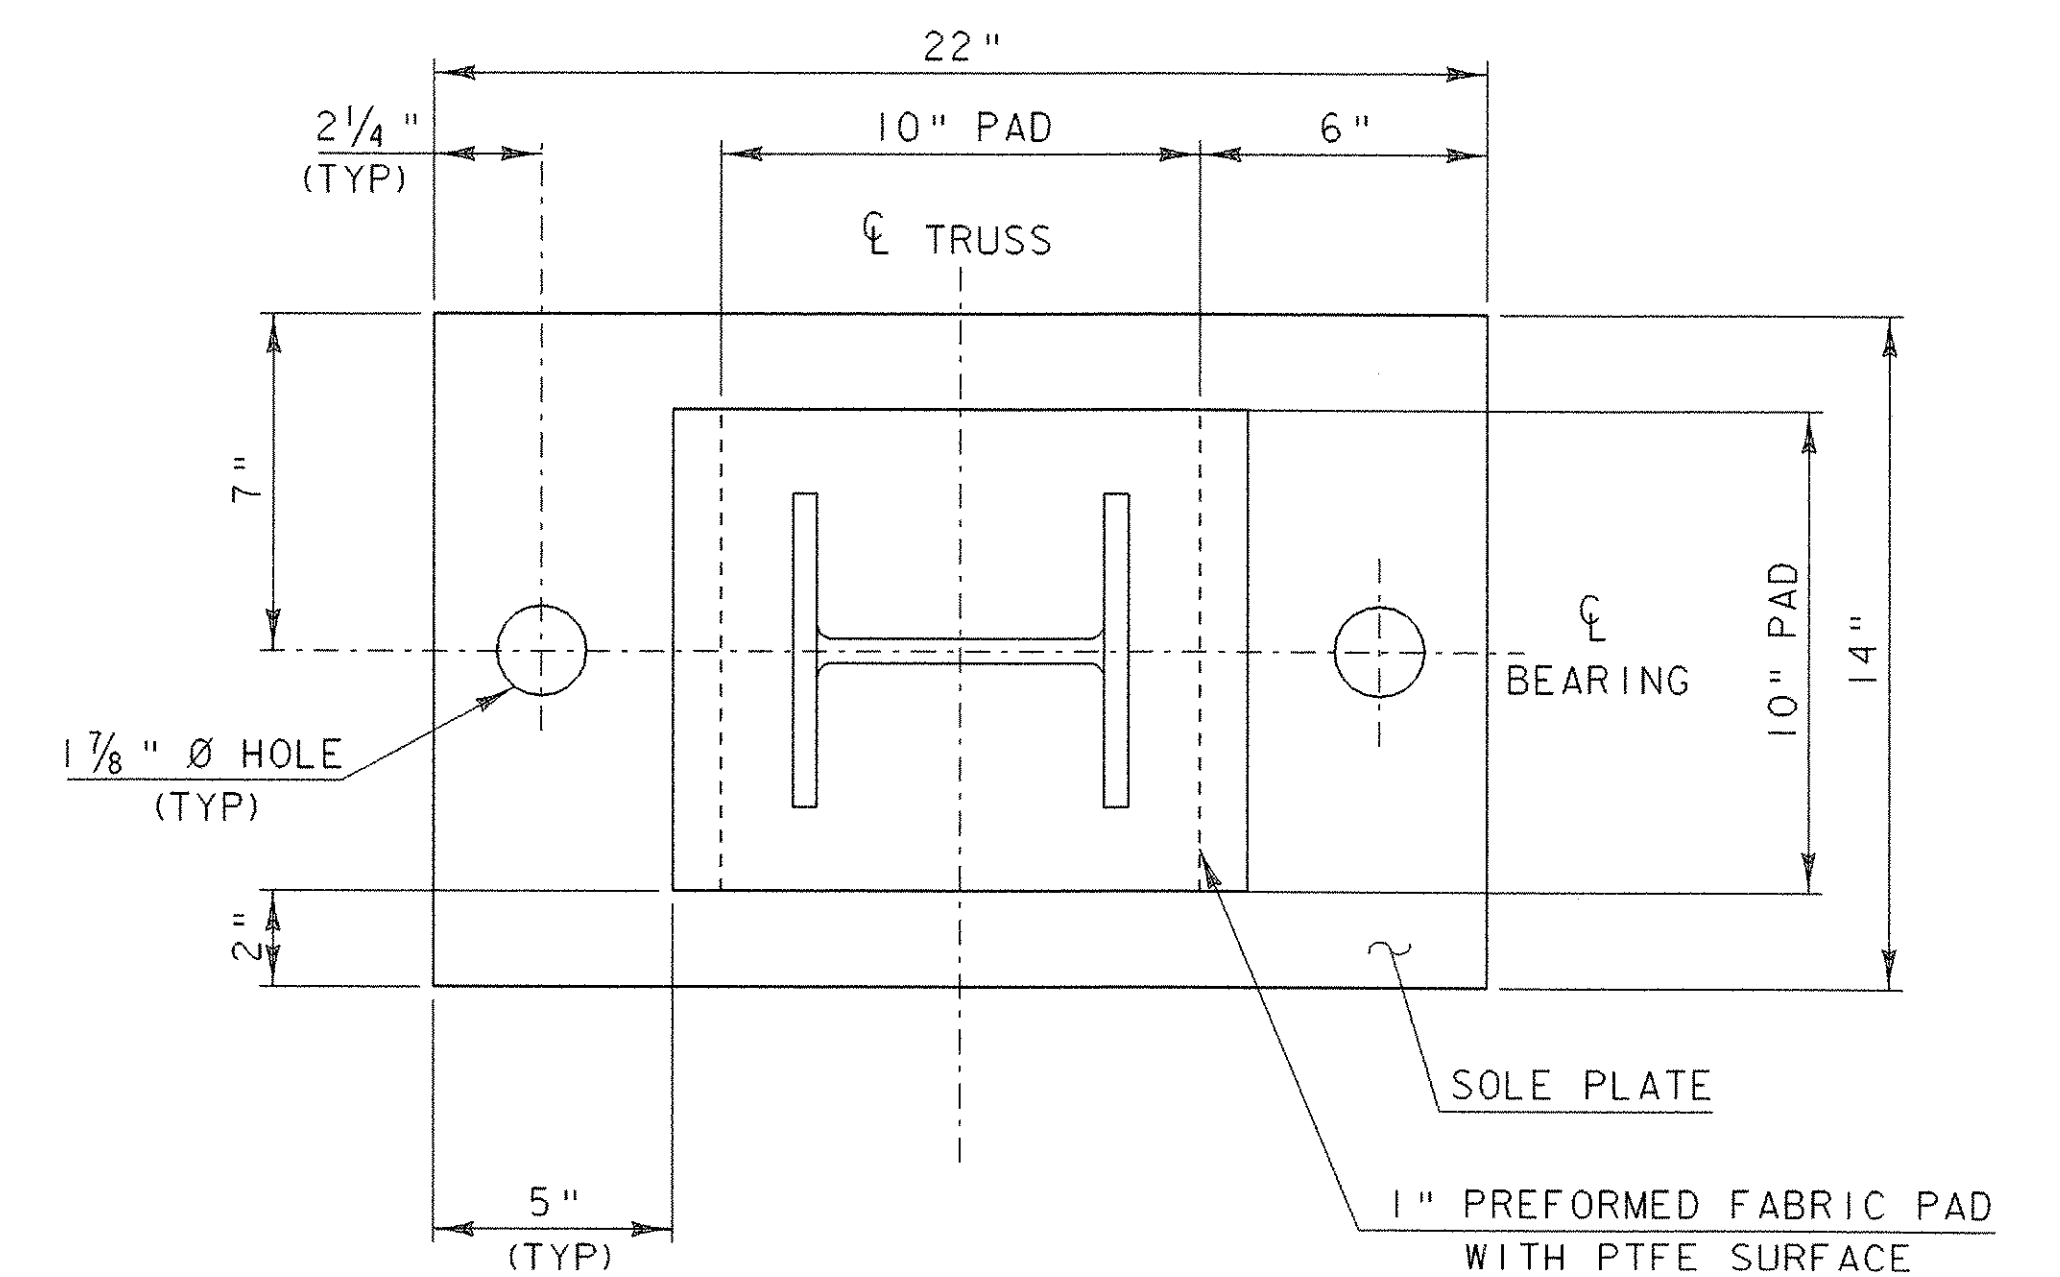


**PLAN VIEW OF FIXED BEARING**

STA 13 + 77.00

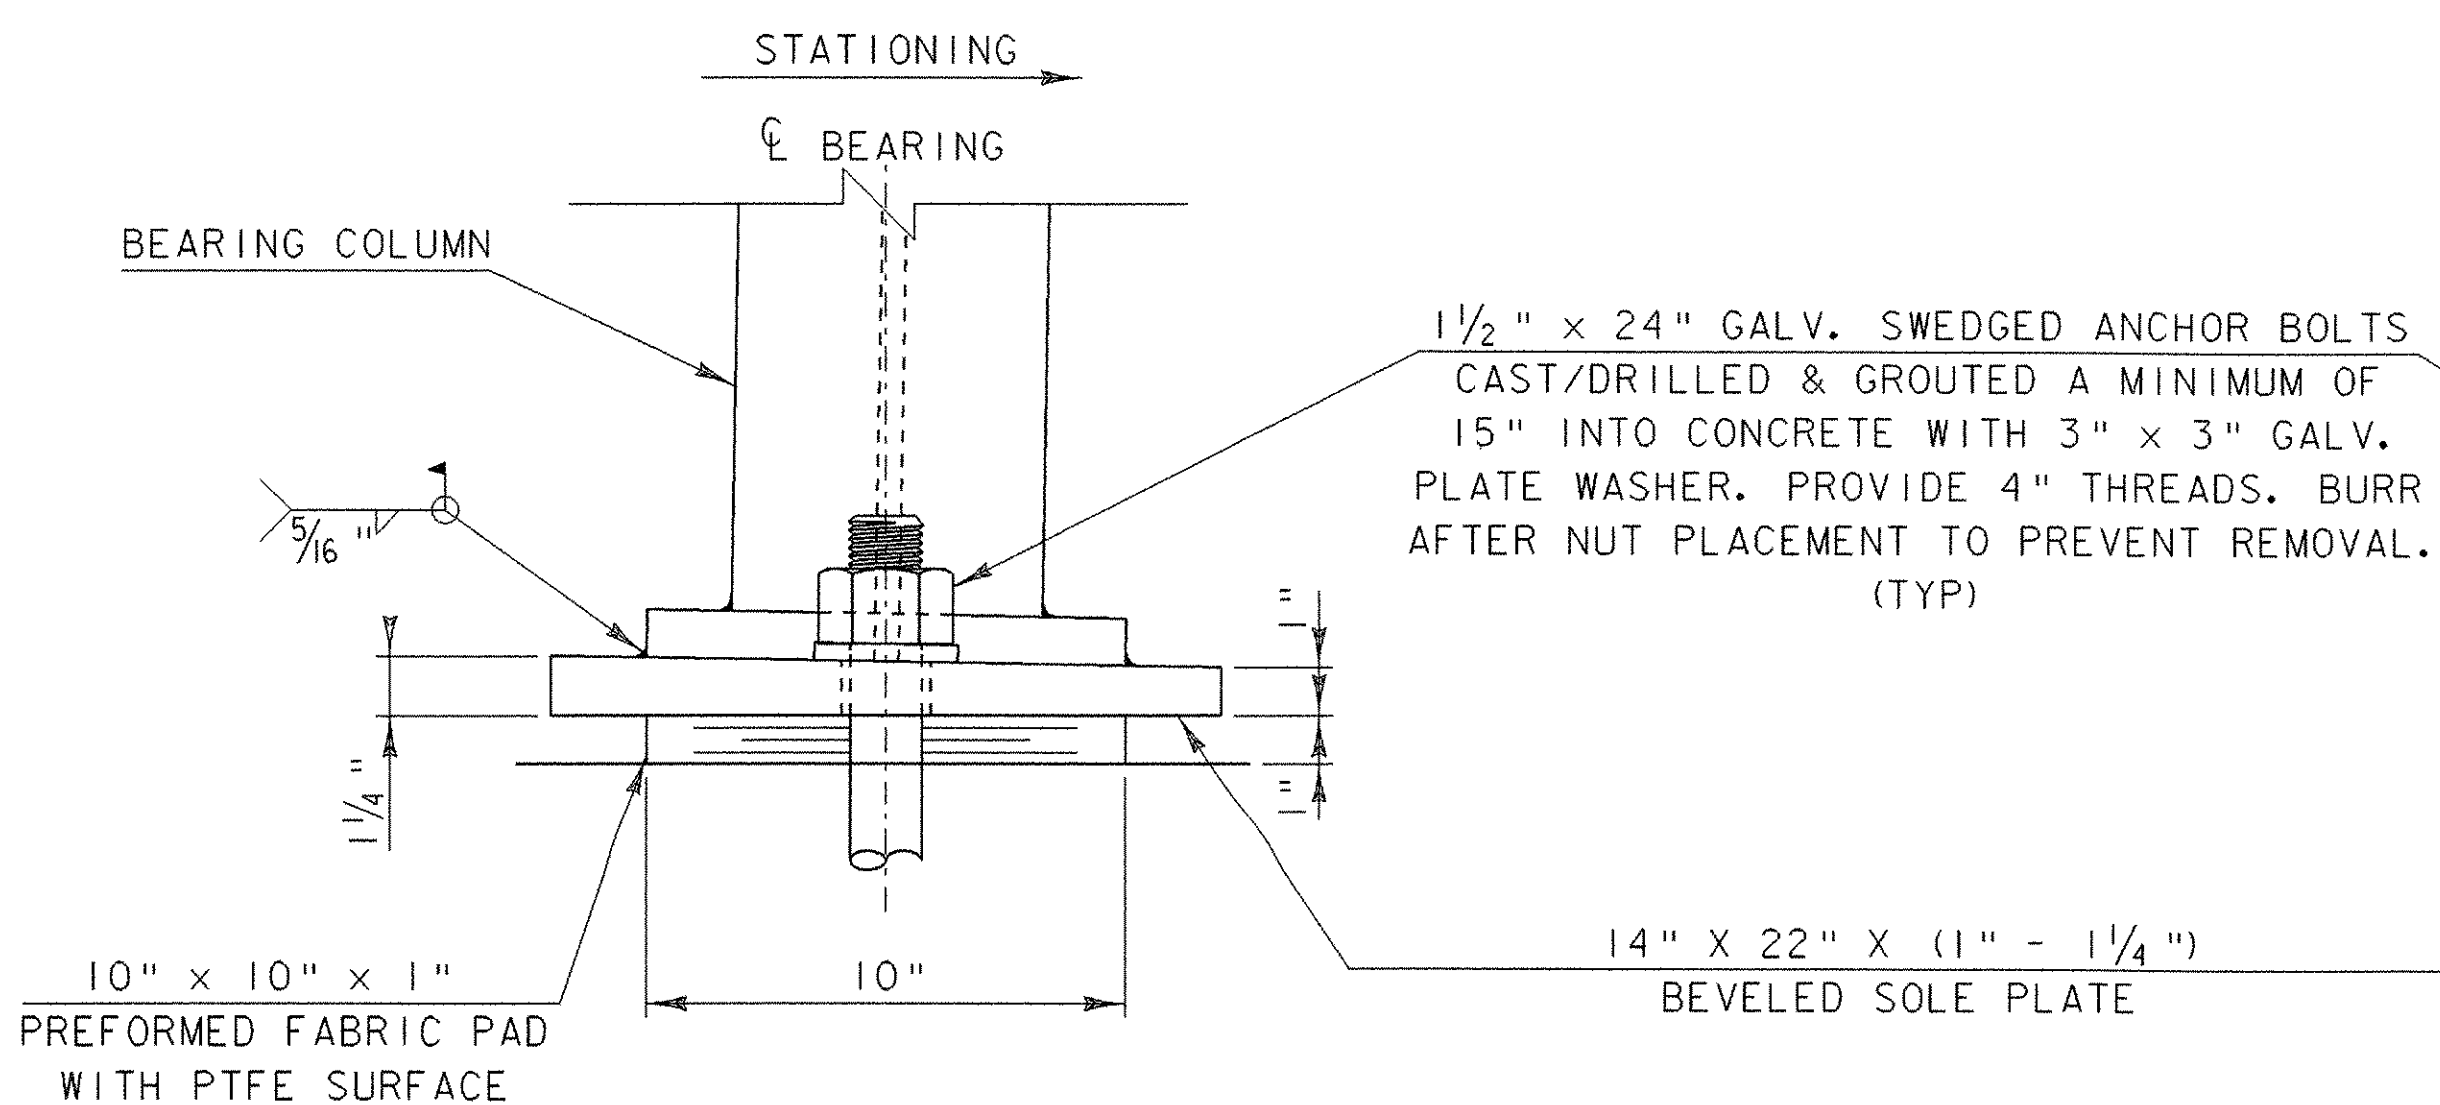

**SIDE ELEVATION FIXED BEARING**

STA 13 + 77.00

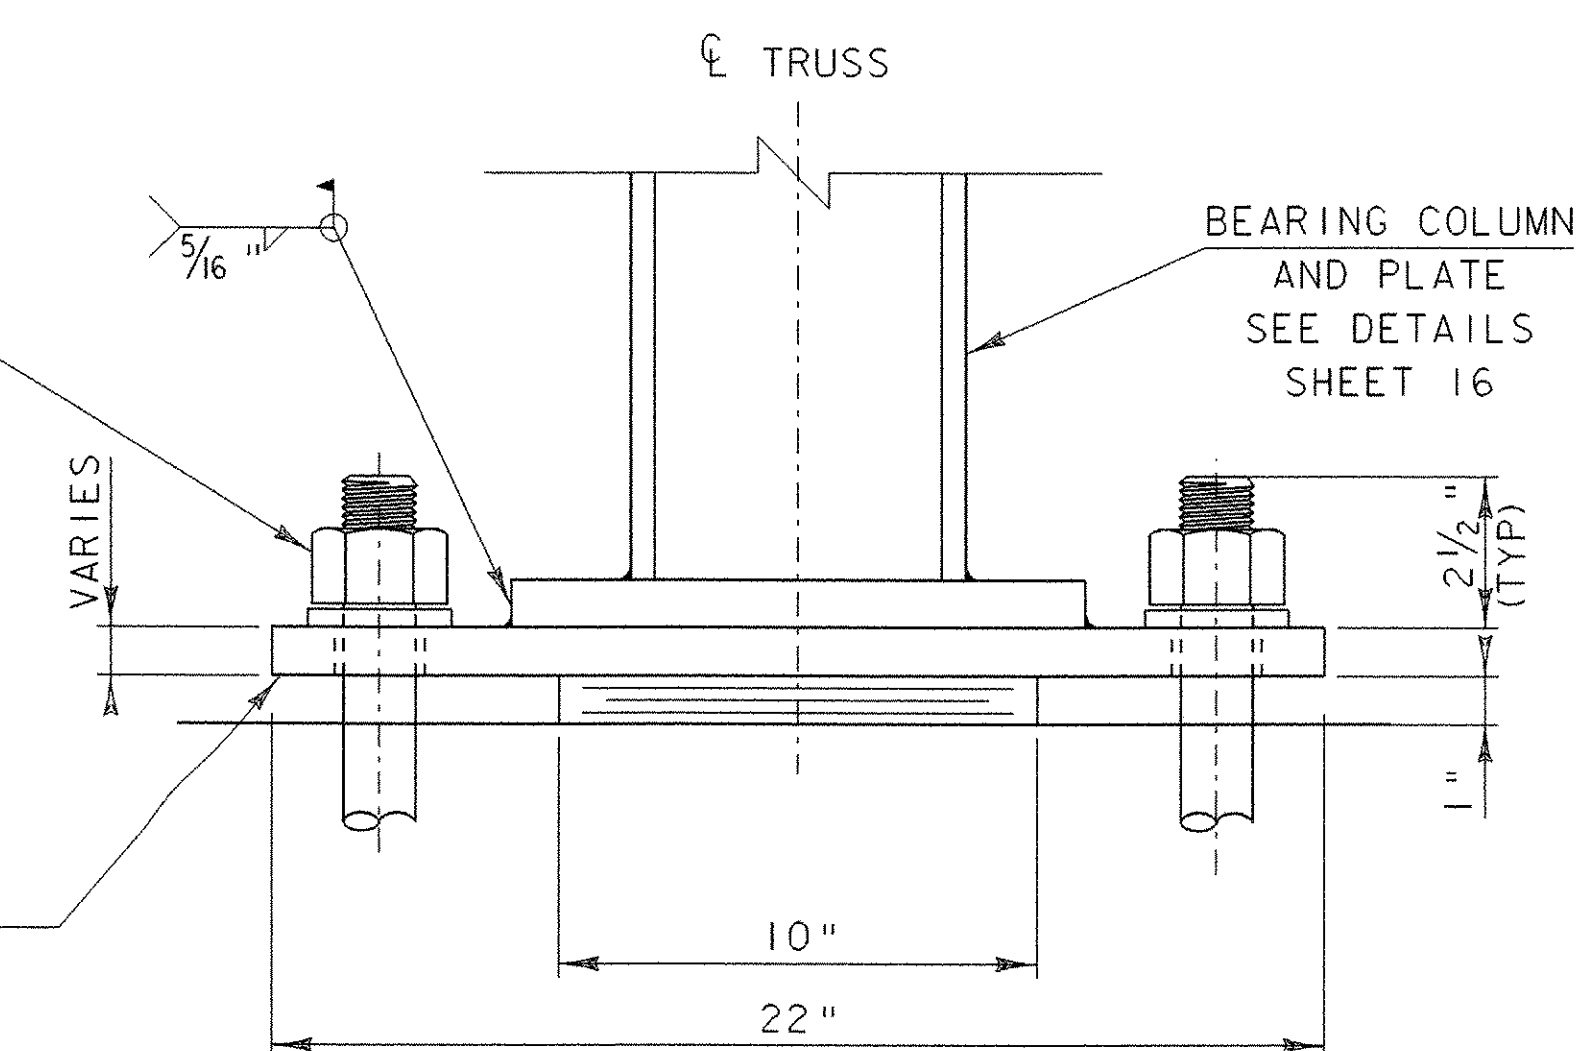


**FRONT ELEVATION FIXED BEARING**

STA 13 + 77.00

ALL DETAILS SCALE 3:1


SCALE 3" = 1'-0"

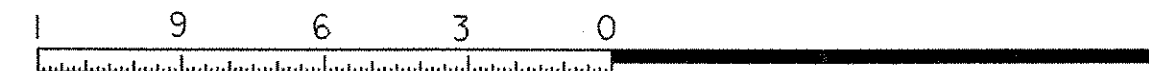

PROJECT: NEW HAVEN - WEYBRIDGE	PROJECT NO.: BHO-BTN 2005 (1)
DESIGN FILE NAME: 89j081/structures/sj081bearing.dgn	PLOT DATE: 28-FEB-2007
IPARM FILE NAME: sj081bearing2.1	DESIGNED BY: R. S. YOUNG
SQUAD LEADER: C. P. WILLIAMS	DRAWN BY: D. D. BEARD
BEARING DETAILS	CHECKED BY: R. S. YOUNG
	SHEET: 21 OF 53


## BEARING NOTES

- 1) BEARINGS SHALL CONFORM TO VAOT STANDARD SPECIFICATIONS FOR CONSTRUCTION SECTIONS 531 AND 731.
- 2) ALL COMPONENTS OF BEARINGS, EXCEPT STAINLESS STEEL, SHALL BE AASHTO M-270 GRADE 50 STEEL.
- 3) ALL COMPONENTS OF BEARING DEVICES SHALL BE METALIZED IN CONFORMANCE WITH VAOT STANDARD SPECIFICATIONS FOR CONSTRUCTION SECTIONS 531.04 AND 506.15. AREAS OF METALIZING DAMAGED BY FIELD WELDING OR HANDLING SHALL BE REPAIRED IN CONFORMANCE WITH ASTM A 760/A 760M.
- 4) ALL ANCHOR BOLTS, NUTS, AND WASHERS SHALL BE GALVANIZED. ALL WASHERS SHALL BE  $\frac{3}{8}$ " PLATE. PAYMENT FOR ANCHOR BOLTS, NUTS, AND WASHERS SHALL BE INCLUDED IN THE UNIT BID PRICE FOR ITEM 531.10 "BEARING DEVICE ASSEMBLY, PREFORMED FABRIC PAD". ANCHOR BOLTS SHALL CONFORM TO VAOT STANDARD SPECIFICATIONS FOR CONSTRUCTION SECTION 714.08.
- 5) MANUFACTURING OF THE SOLE PLATE, BEARING PADS, ANCHOR BOLTS, AND STAINLESS STEEL SHALL BE PAID FOR UNDER THE BID ITEM 531.10 "BEARING DEVICE ASSEMBLY, PREFORMED FABRIC PAD" PAYMENT FOR THE BEARING COLUMN AND PLATE SHALL BE INCLUDED UNDER THE ITEM 506.60 "STRUCTURAL STEEL."
- 6) DESIGN CRITERIA:
  - A: PAD TO CONCRETE DESIGN PRESSURE = 1000 PSI
  - B: MINIMUM ALLOWABLE DESIGN ROTATION = 0.015 RADIAN
  - C: HORIZONTAL CAPACITY SHALL BE MINIMUM OF 10% VERTICAL CAPACITY.
  - D: DESIGN LOAD PER TRUSS BEARING = 82 KIPS
    - RDL = 38 KIPS
    - REL = 44 KIPS
- 7) ANCHOR BOLTS SHALL BE CAST/DRILLED AND GROUTED PRIOR TO CONNECTING THE END FLOOR BEAMS

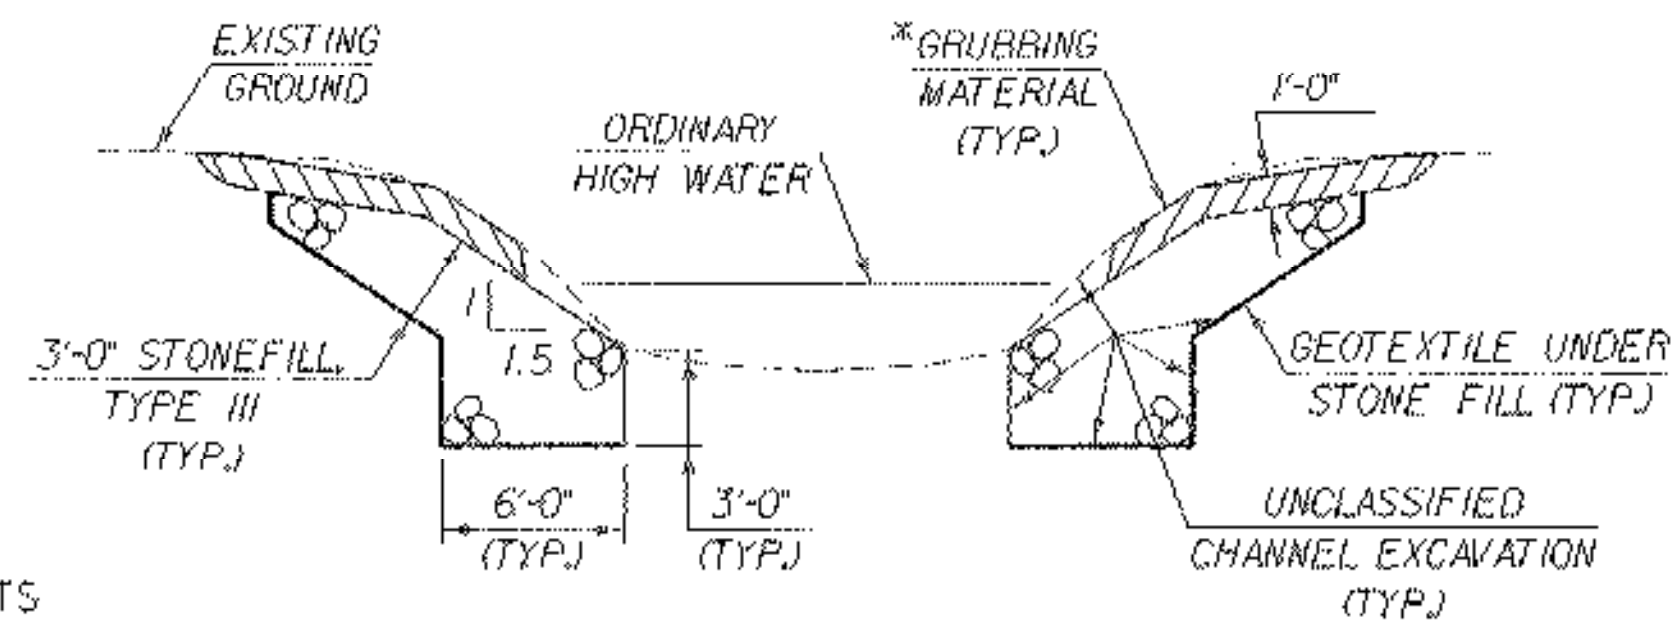


**TYPICAL CHANNEL SECTION**  
(NOT TO SCALE)

\*GRUBBING MATERIAL SHALL NOT BE PLACED ON THE STONE FILL IN THE AREA UNDER THE BRIDGE. WHENEVER CHANNEL SLOPE INTERSECTS ROADWAY SUBBASE, GRUBBING MATERIAL SHALL BEGIN AT THE BOTTOM OF SUBBASE.

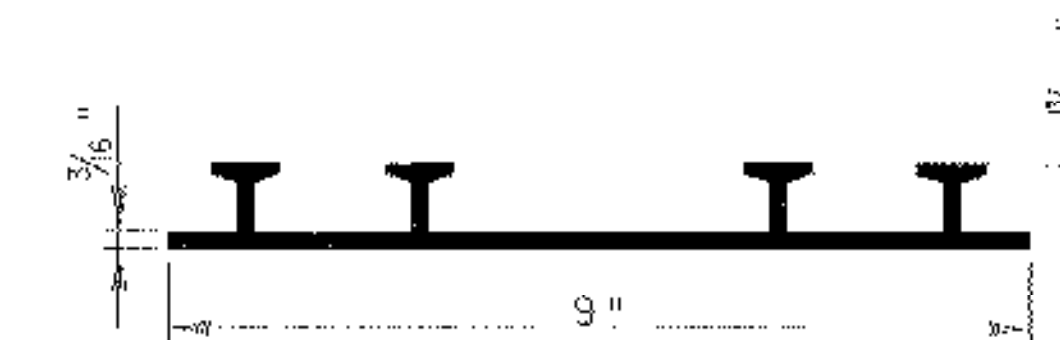

**P.V.C. WATERSTOP FOR CONSTRUCTION JOINTS**  
NFS


THE COSTS FOR P.V.C. WATERSTOP SHALL BE INCLUDED IN THE UNIT PRICE BID FOR CONCRETE. OTHER CONFIGURATIONS MAY BE USED UPON APPROVAL OF THE STRUCTURES ENGINEER.

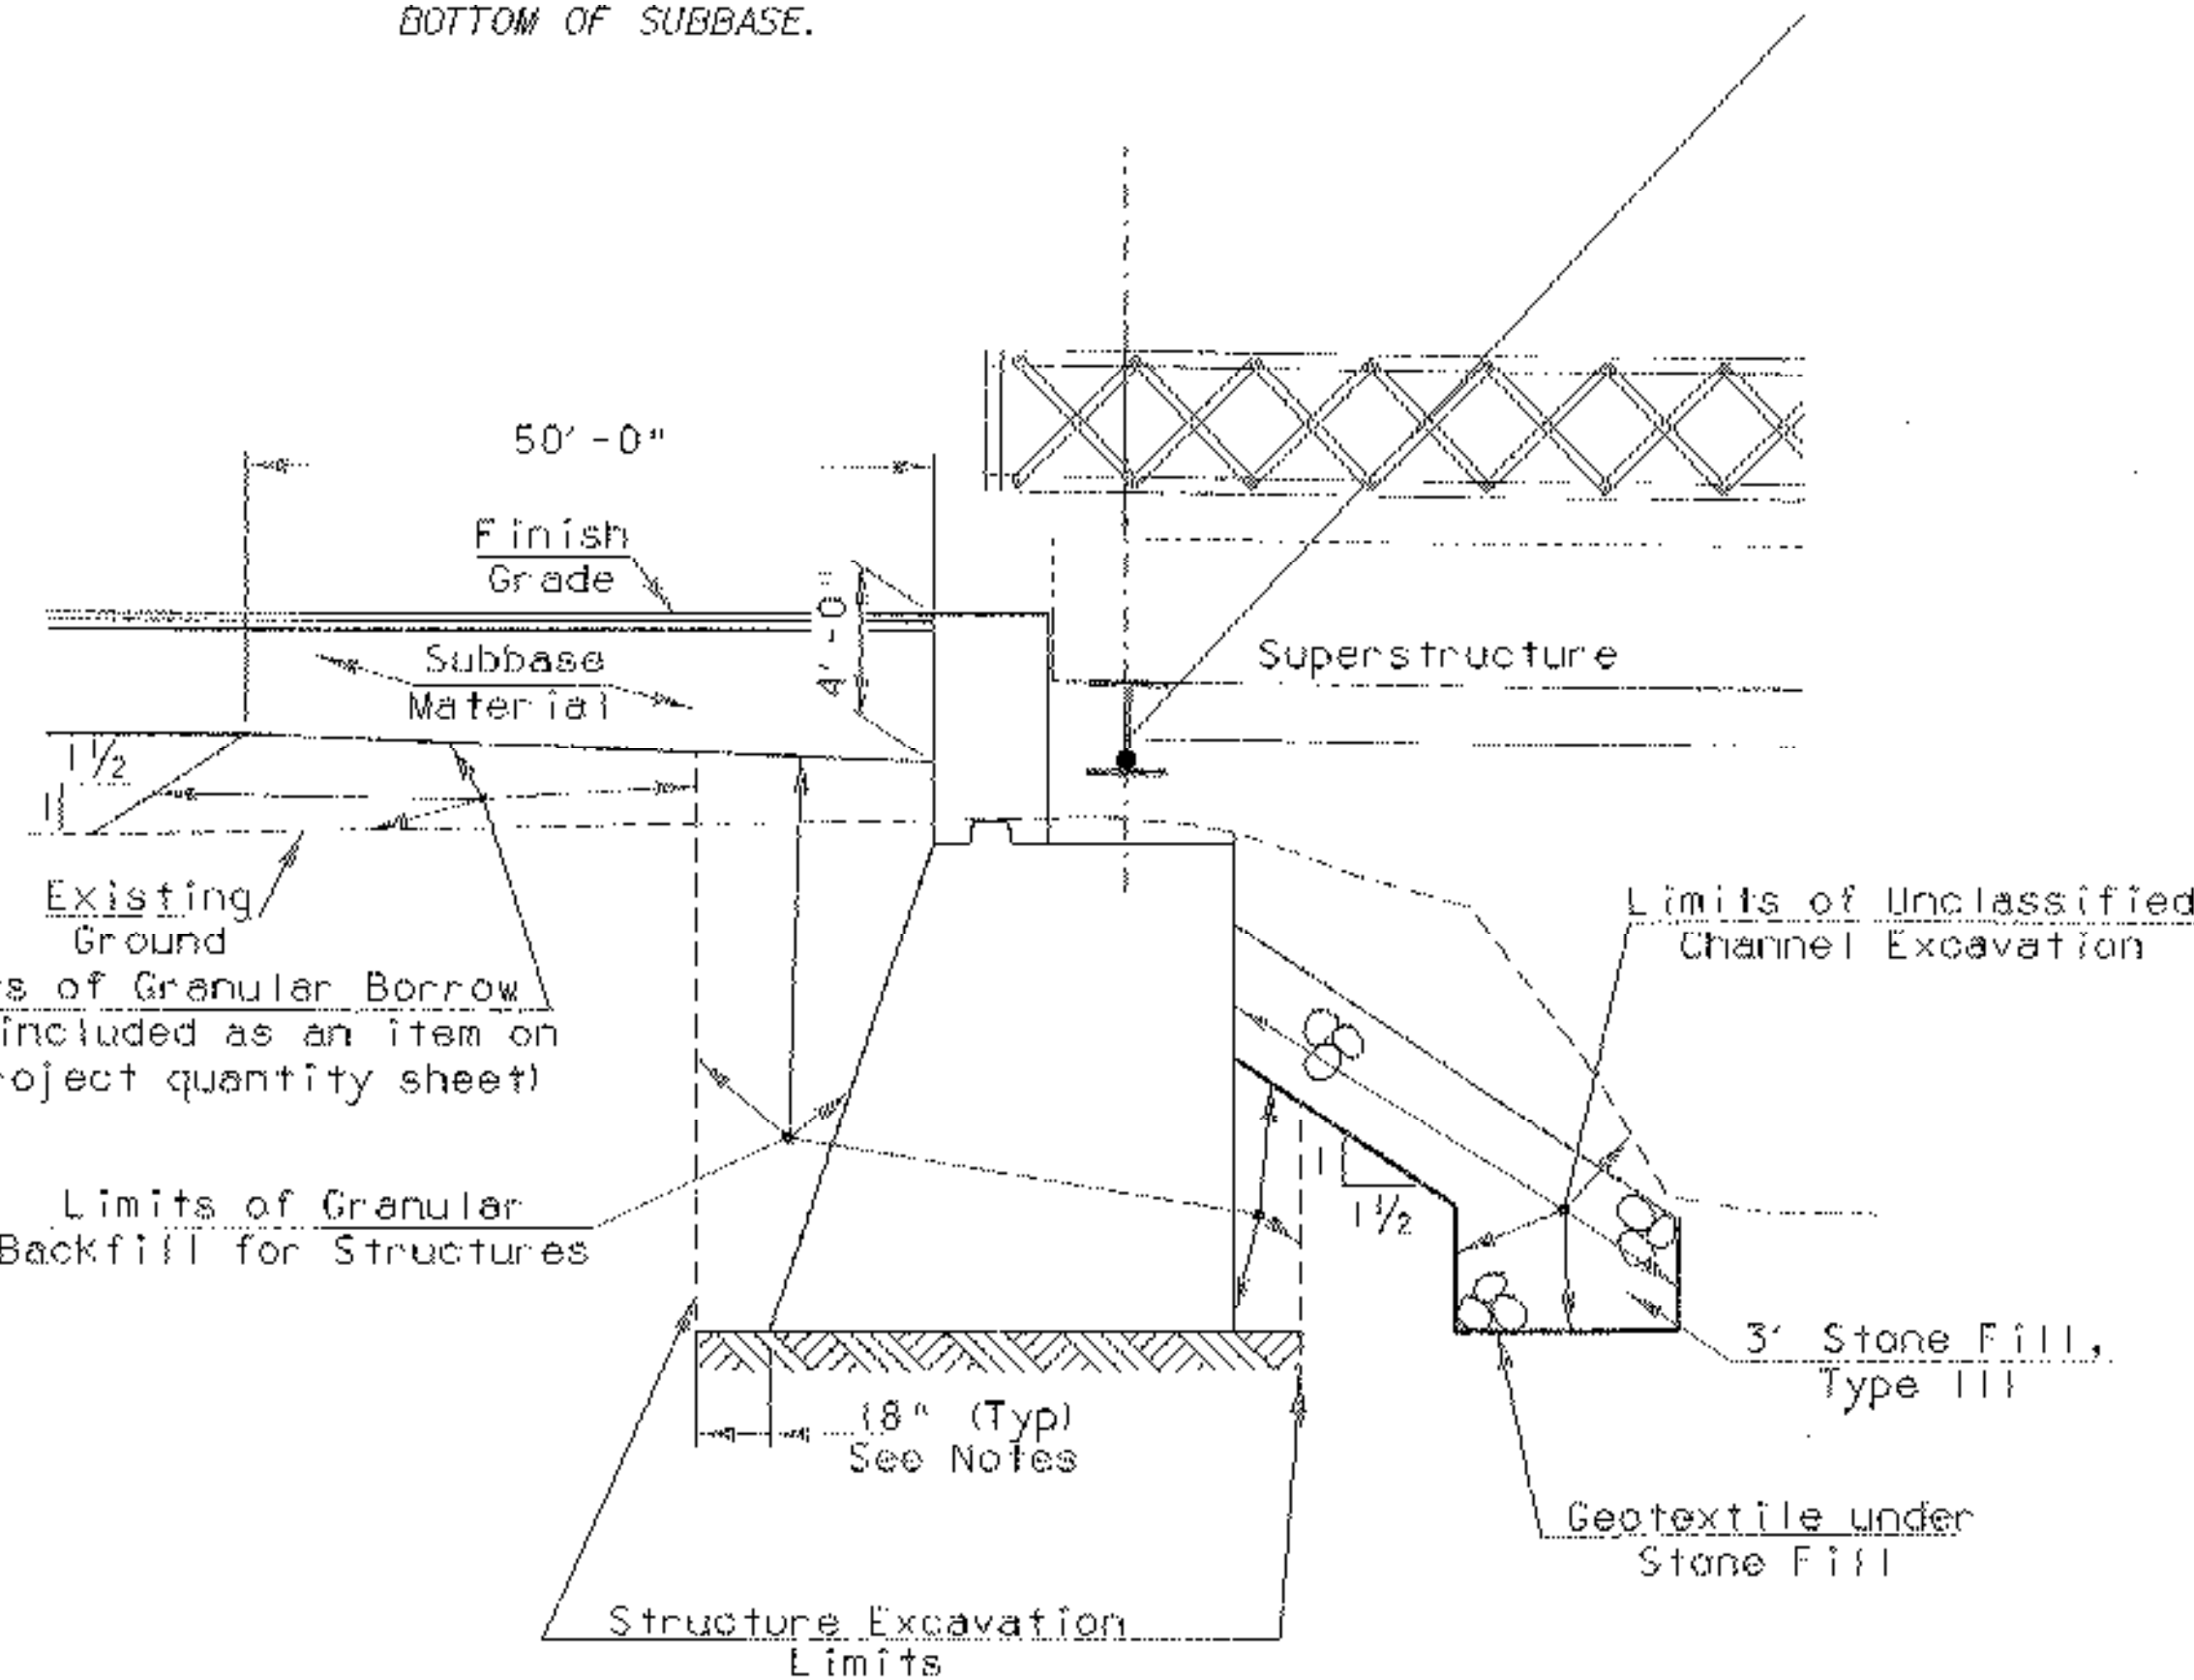


**ABUTMENT #1 TYPICAL SECTION**  
(NOT TO SCALE)

### NOTES

1. FOR PURPOSES OF ESTIMATING EARTHWORK QUANTITIES, THE LIMITS OF STRUCTURE EXCAVATION HAVE BEEN ASSUMED TO BE 18" OUTSIDE THE PERIMETER OF THE FOOTING.
2. THE ACTUAL EXCAVATION LIMITS TO BE DETERMINED BY THE CONTRACTOR. NO PAYMENT WILL BE MADE FOR WORK OUTSIDE THE STRUCTURE EXCAVATION LIMITS SHOWN ABOVE.

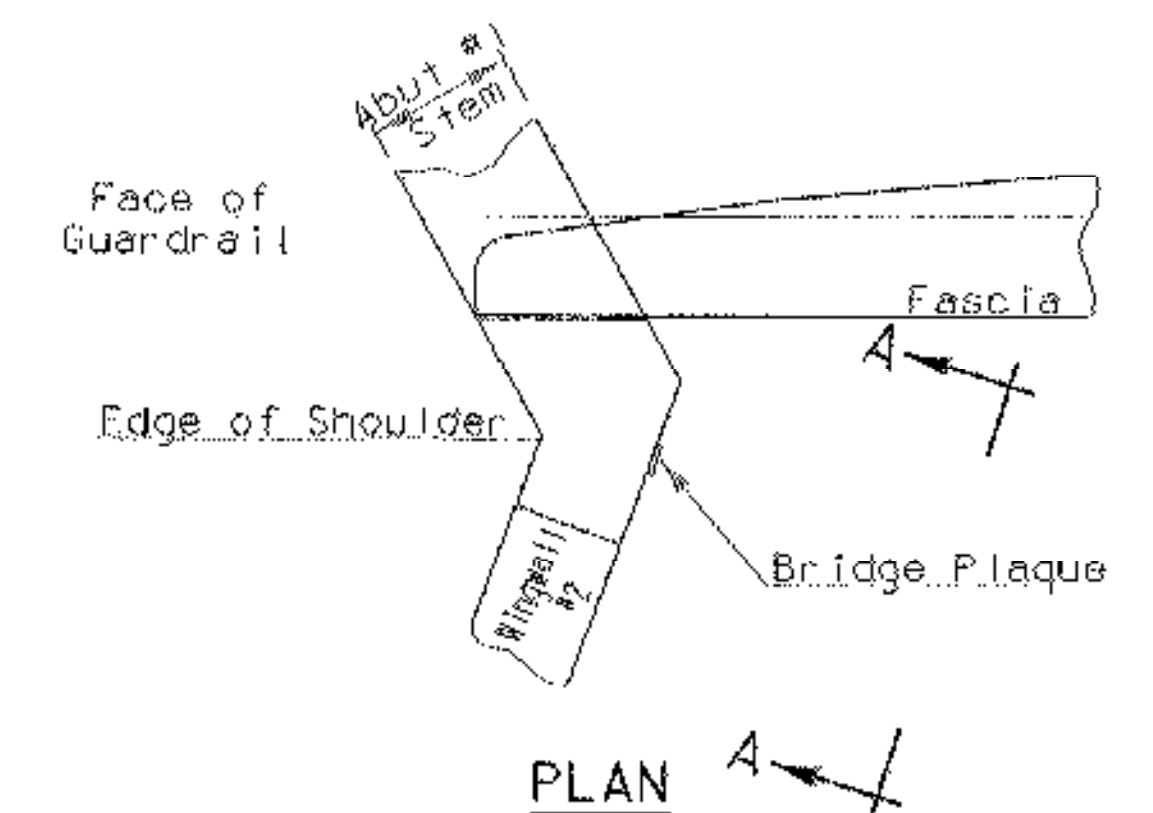


PLAN A-A

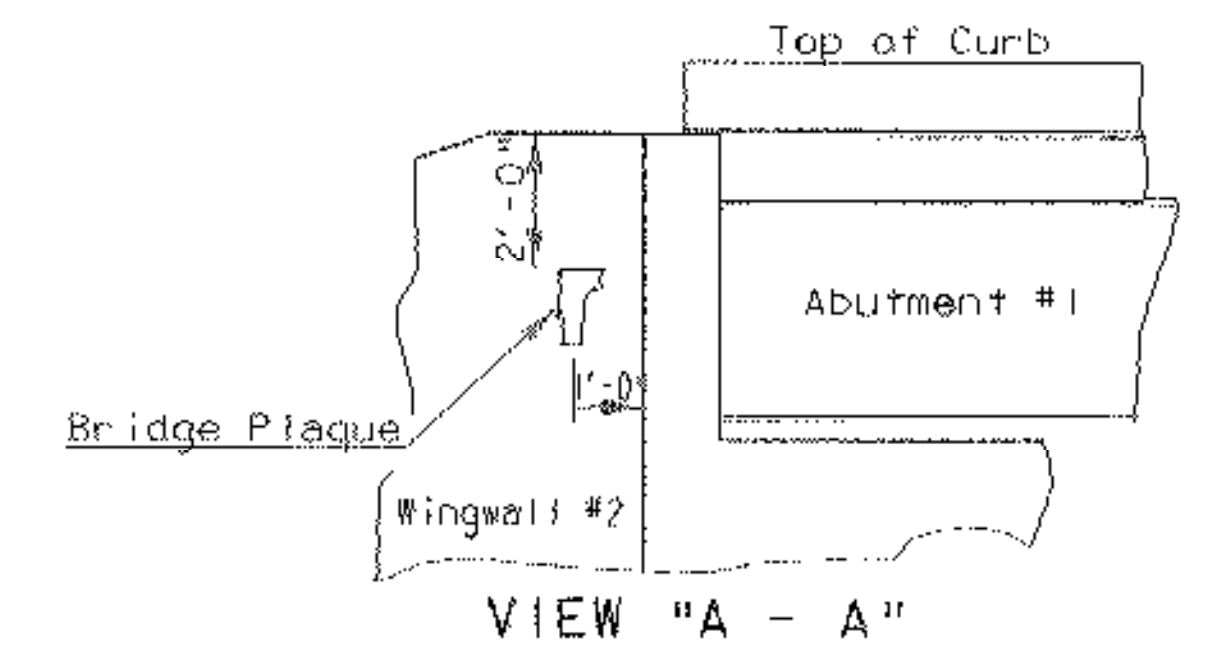

**LOCATE BRIDGE PLAQUE**

THE BRIDGE PLAQUE WILL BE SUPPLIED BY THE AGENCY OF TRANSPORTATION AND SHALL BE INSTALLED BY THE CONTRACTOR AT ABUTMENT #1 ON THE RIGHT SIDE AS SHOWN OR AS DIRECTED BY THE ENGINEER.

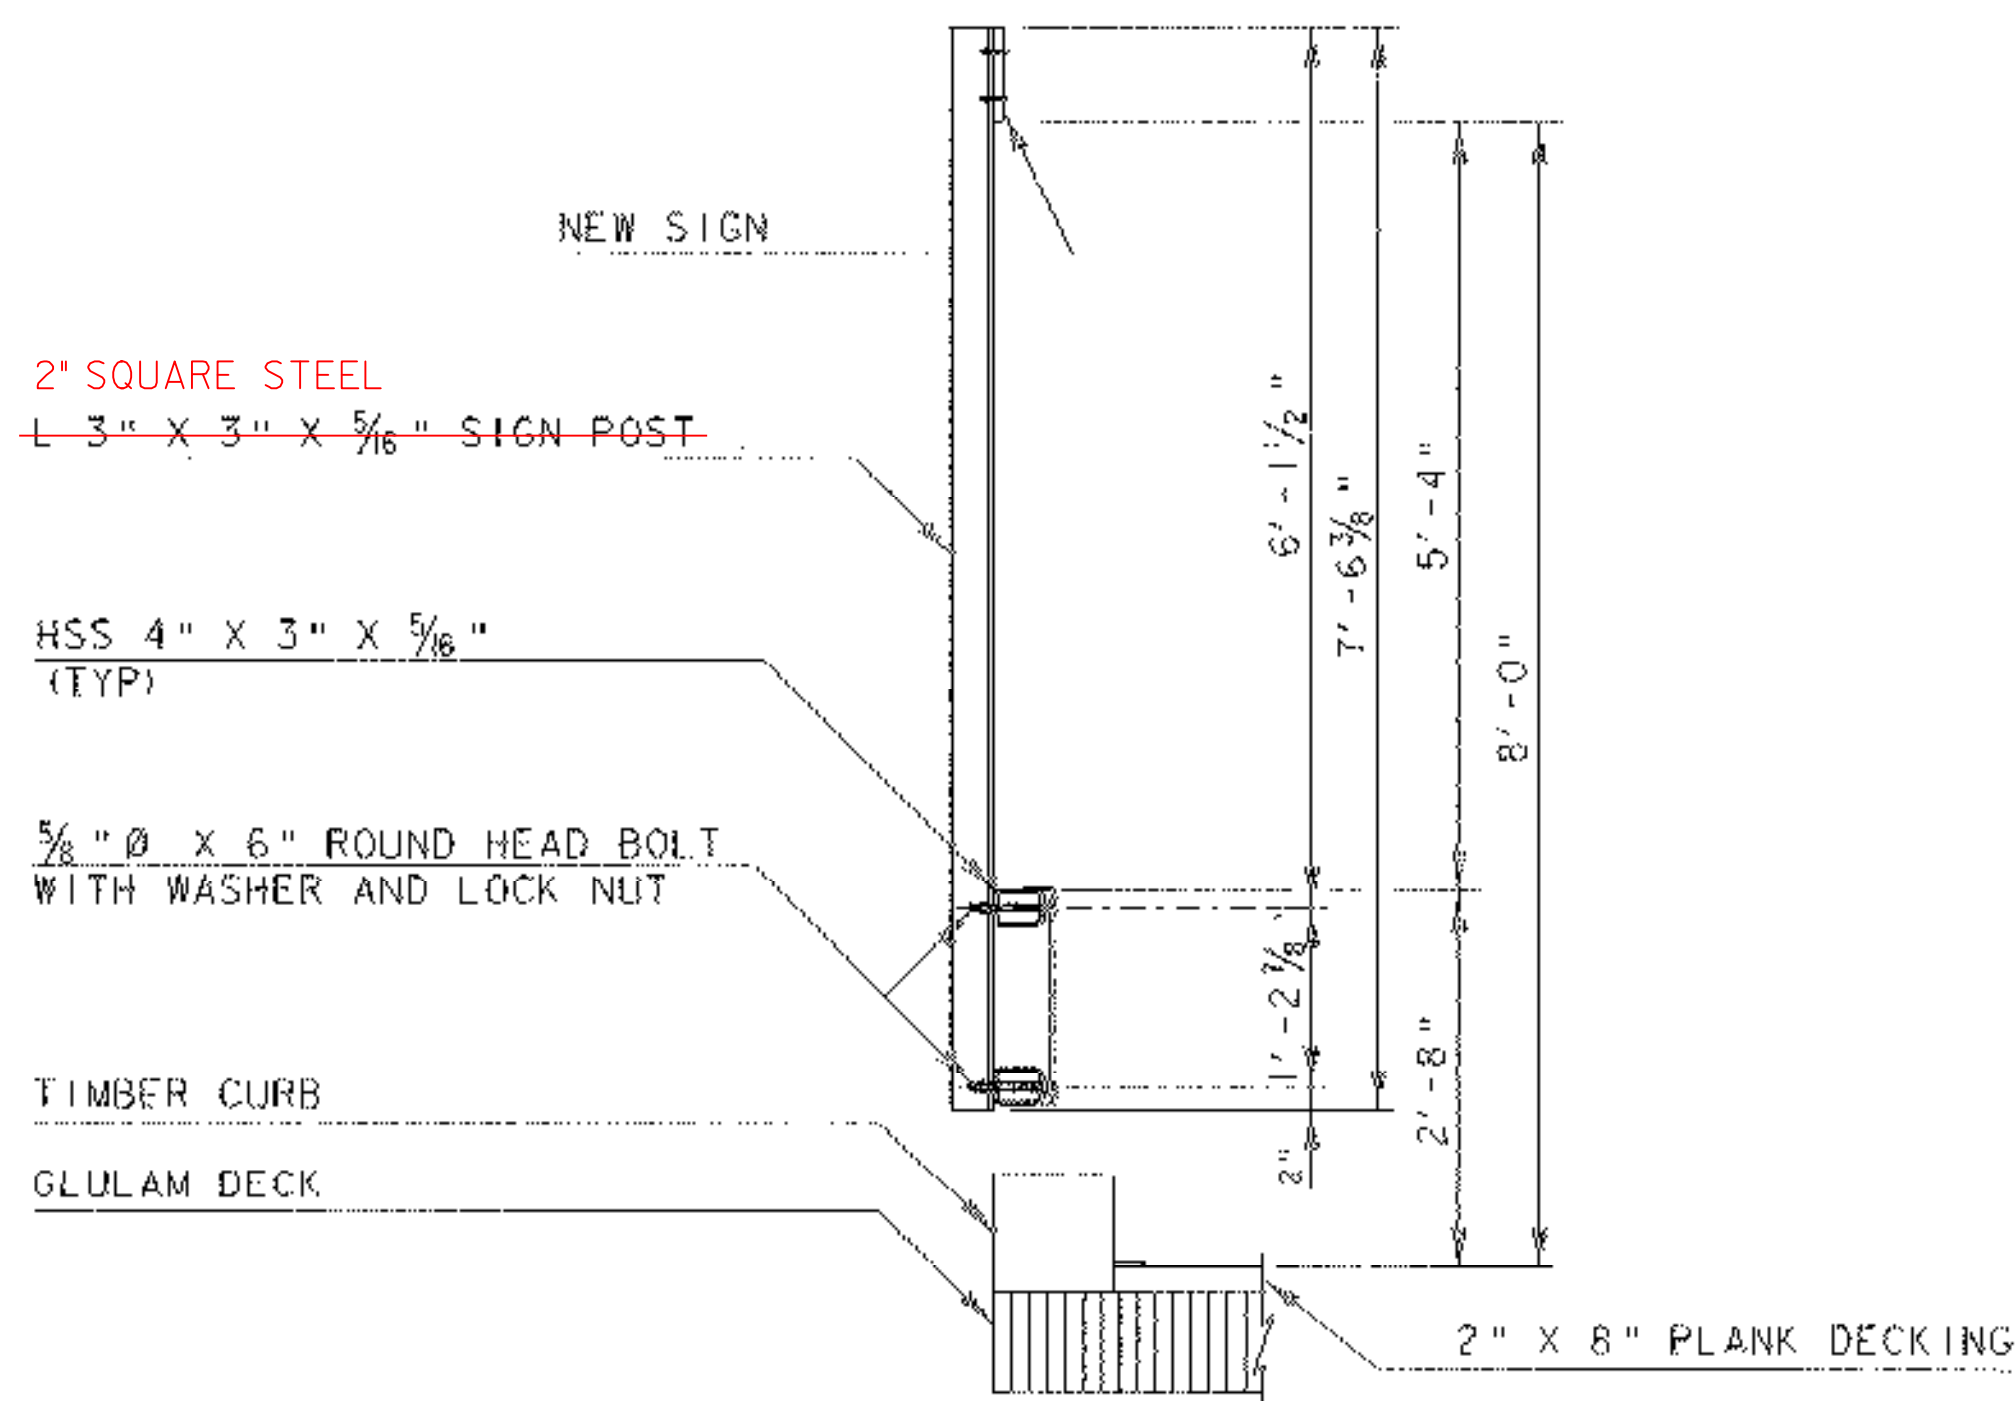



**TOWN LINE SIGN POST DETAIL**

(STA 13+03.00) RT

SCALE  $\frac{3}{4}$ " = 1'-0"



PROJECT: <b>NEW HAVEN - WEYBRIDGE</b>	PROJECT NO. #: <b>BHO-BTN 2005 (1)</b>
DESIGN FILE NAME: 89j081/structures/sj081bearing.dgn	PLOT DATE: 28-FEB-2007
IPARM FILE NAME: sj081bgnotesmisc.1	DESIGNED BY: R.S. YOUNG
SQUAD LEADER: C.P. WILLIAMS	DRAWN BY: M. LONGSTREET
BEARING NOTES/MISC DETAILS	CHECKED BY: R.S. YOUNG
	SHEET: 22 OF 53



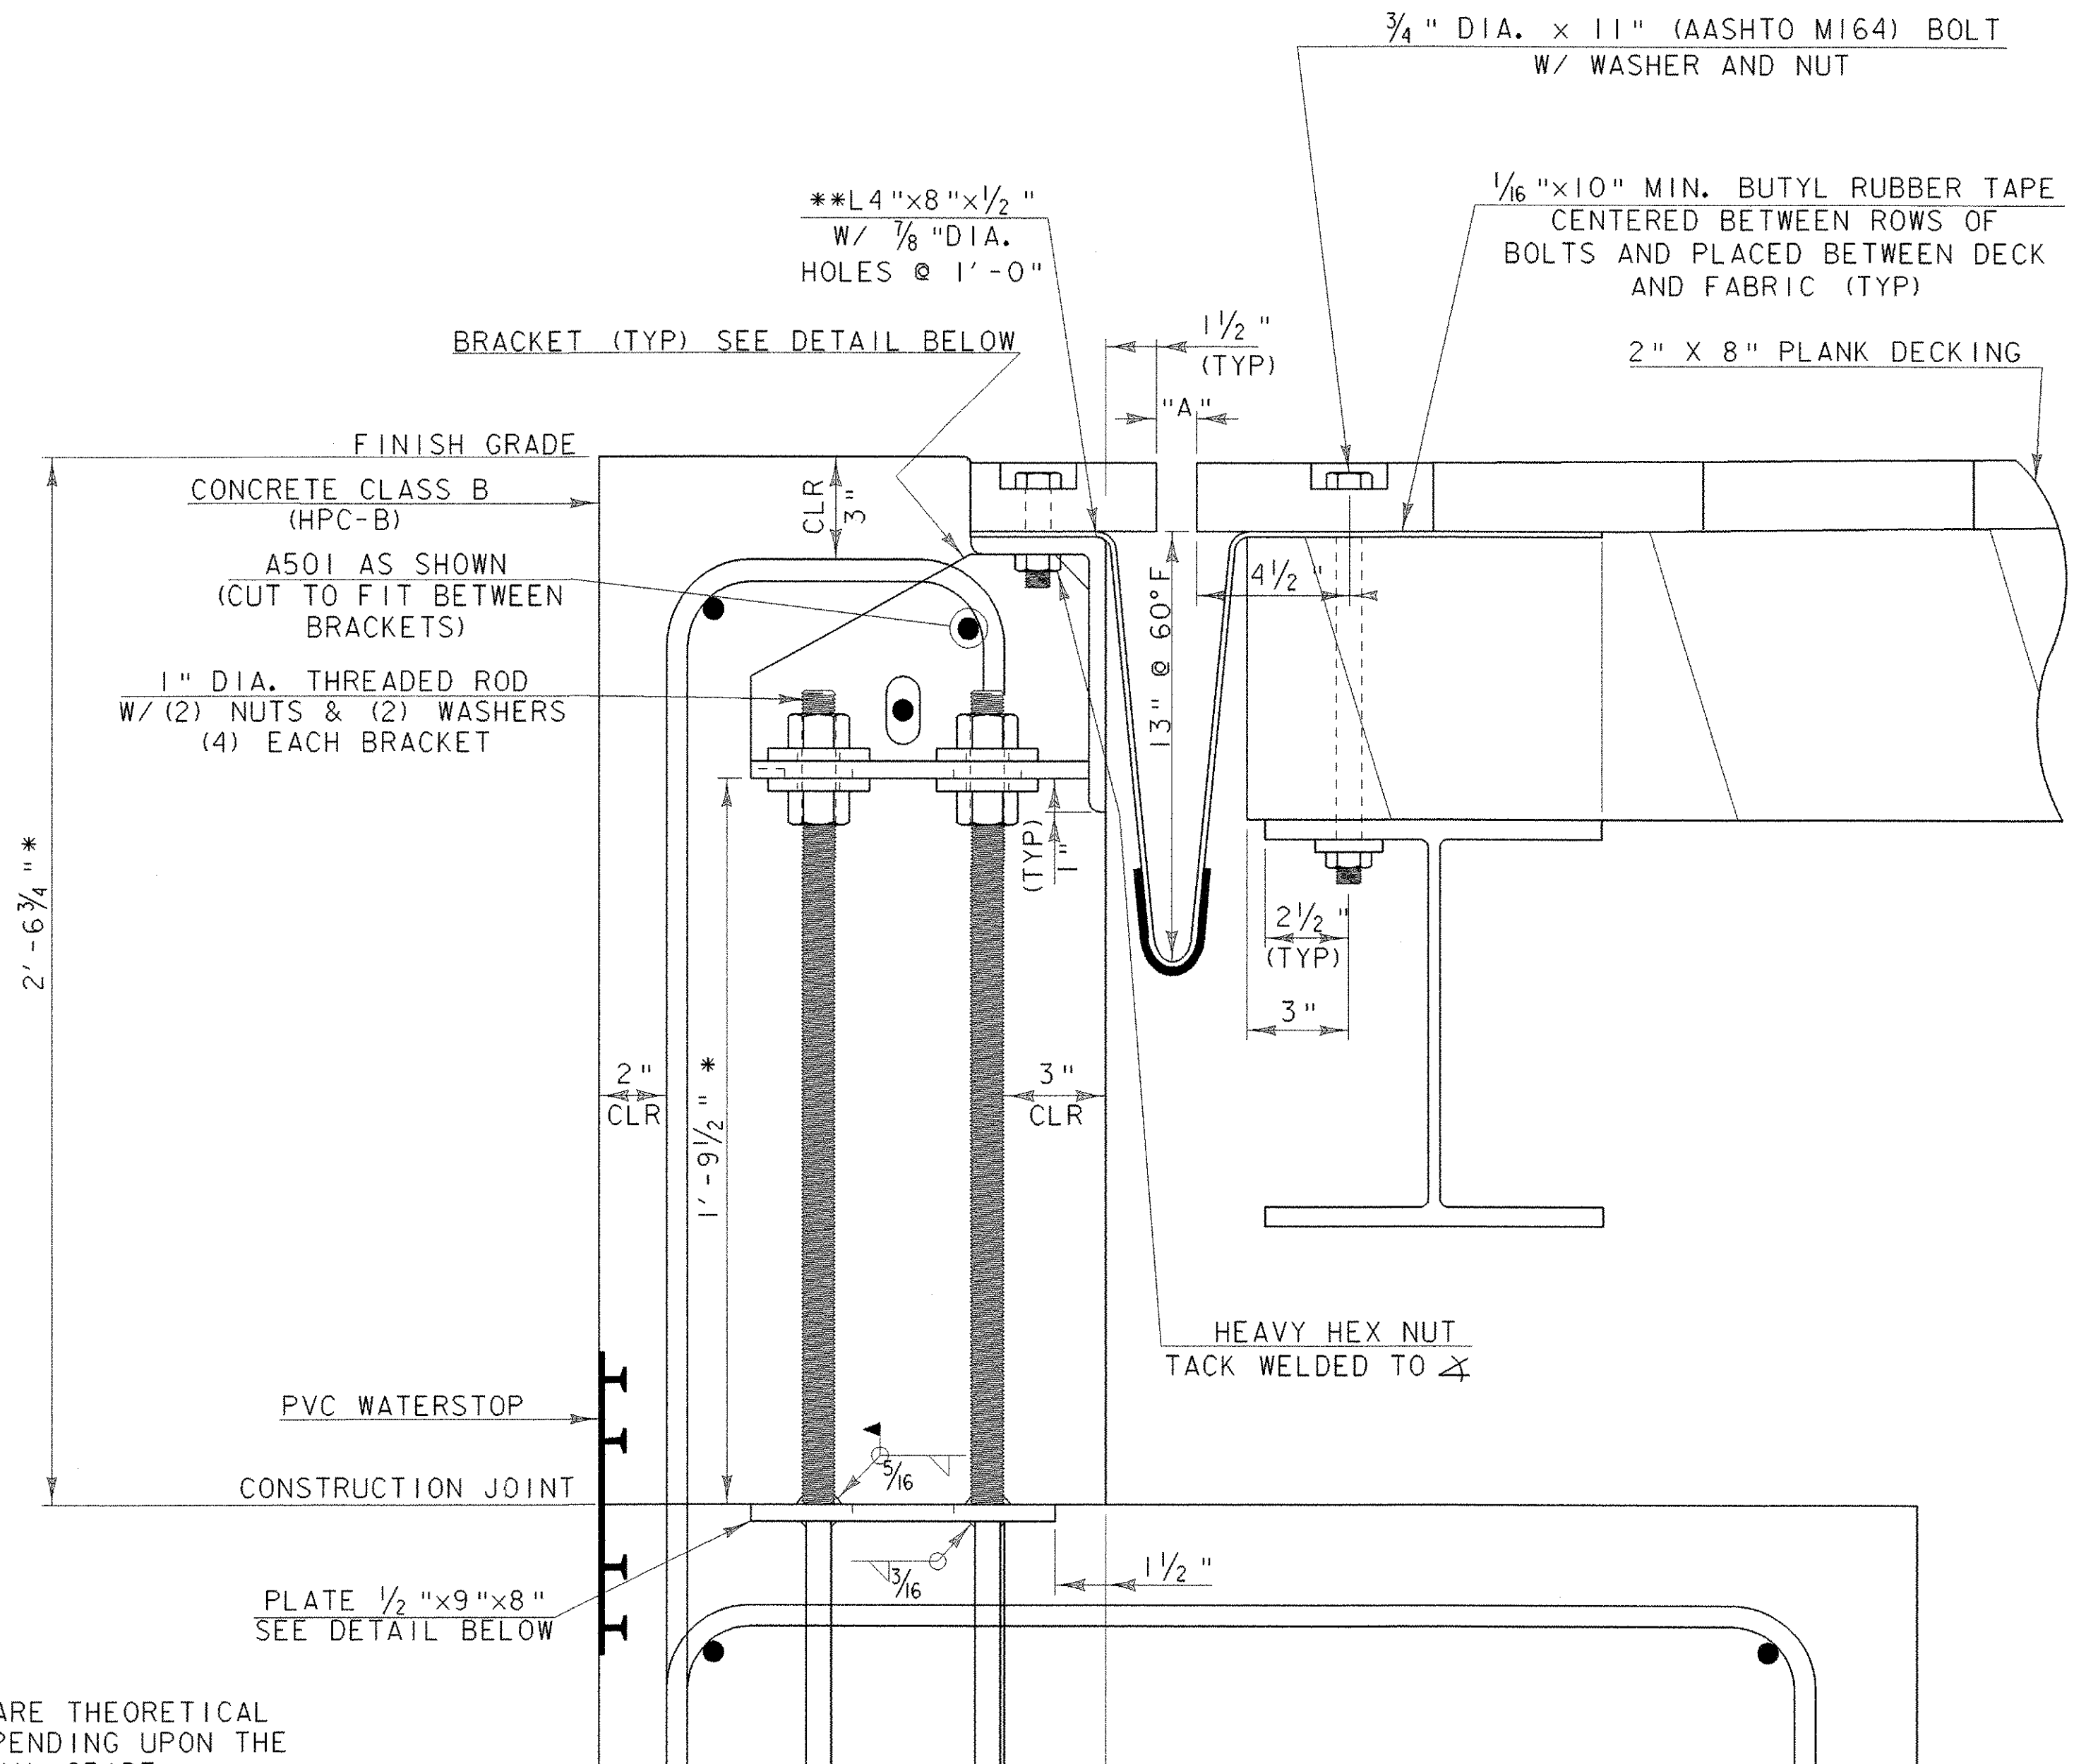
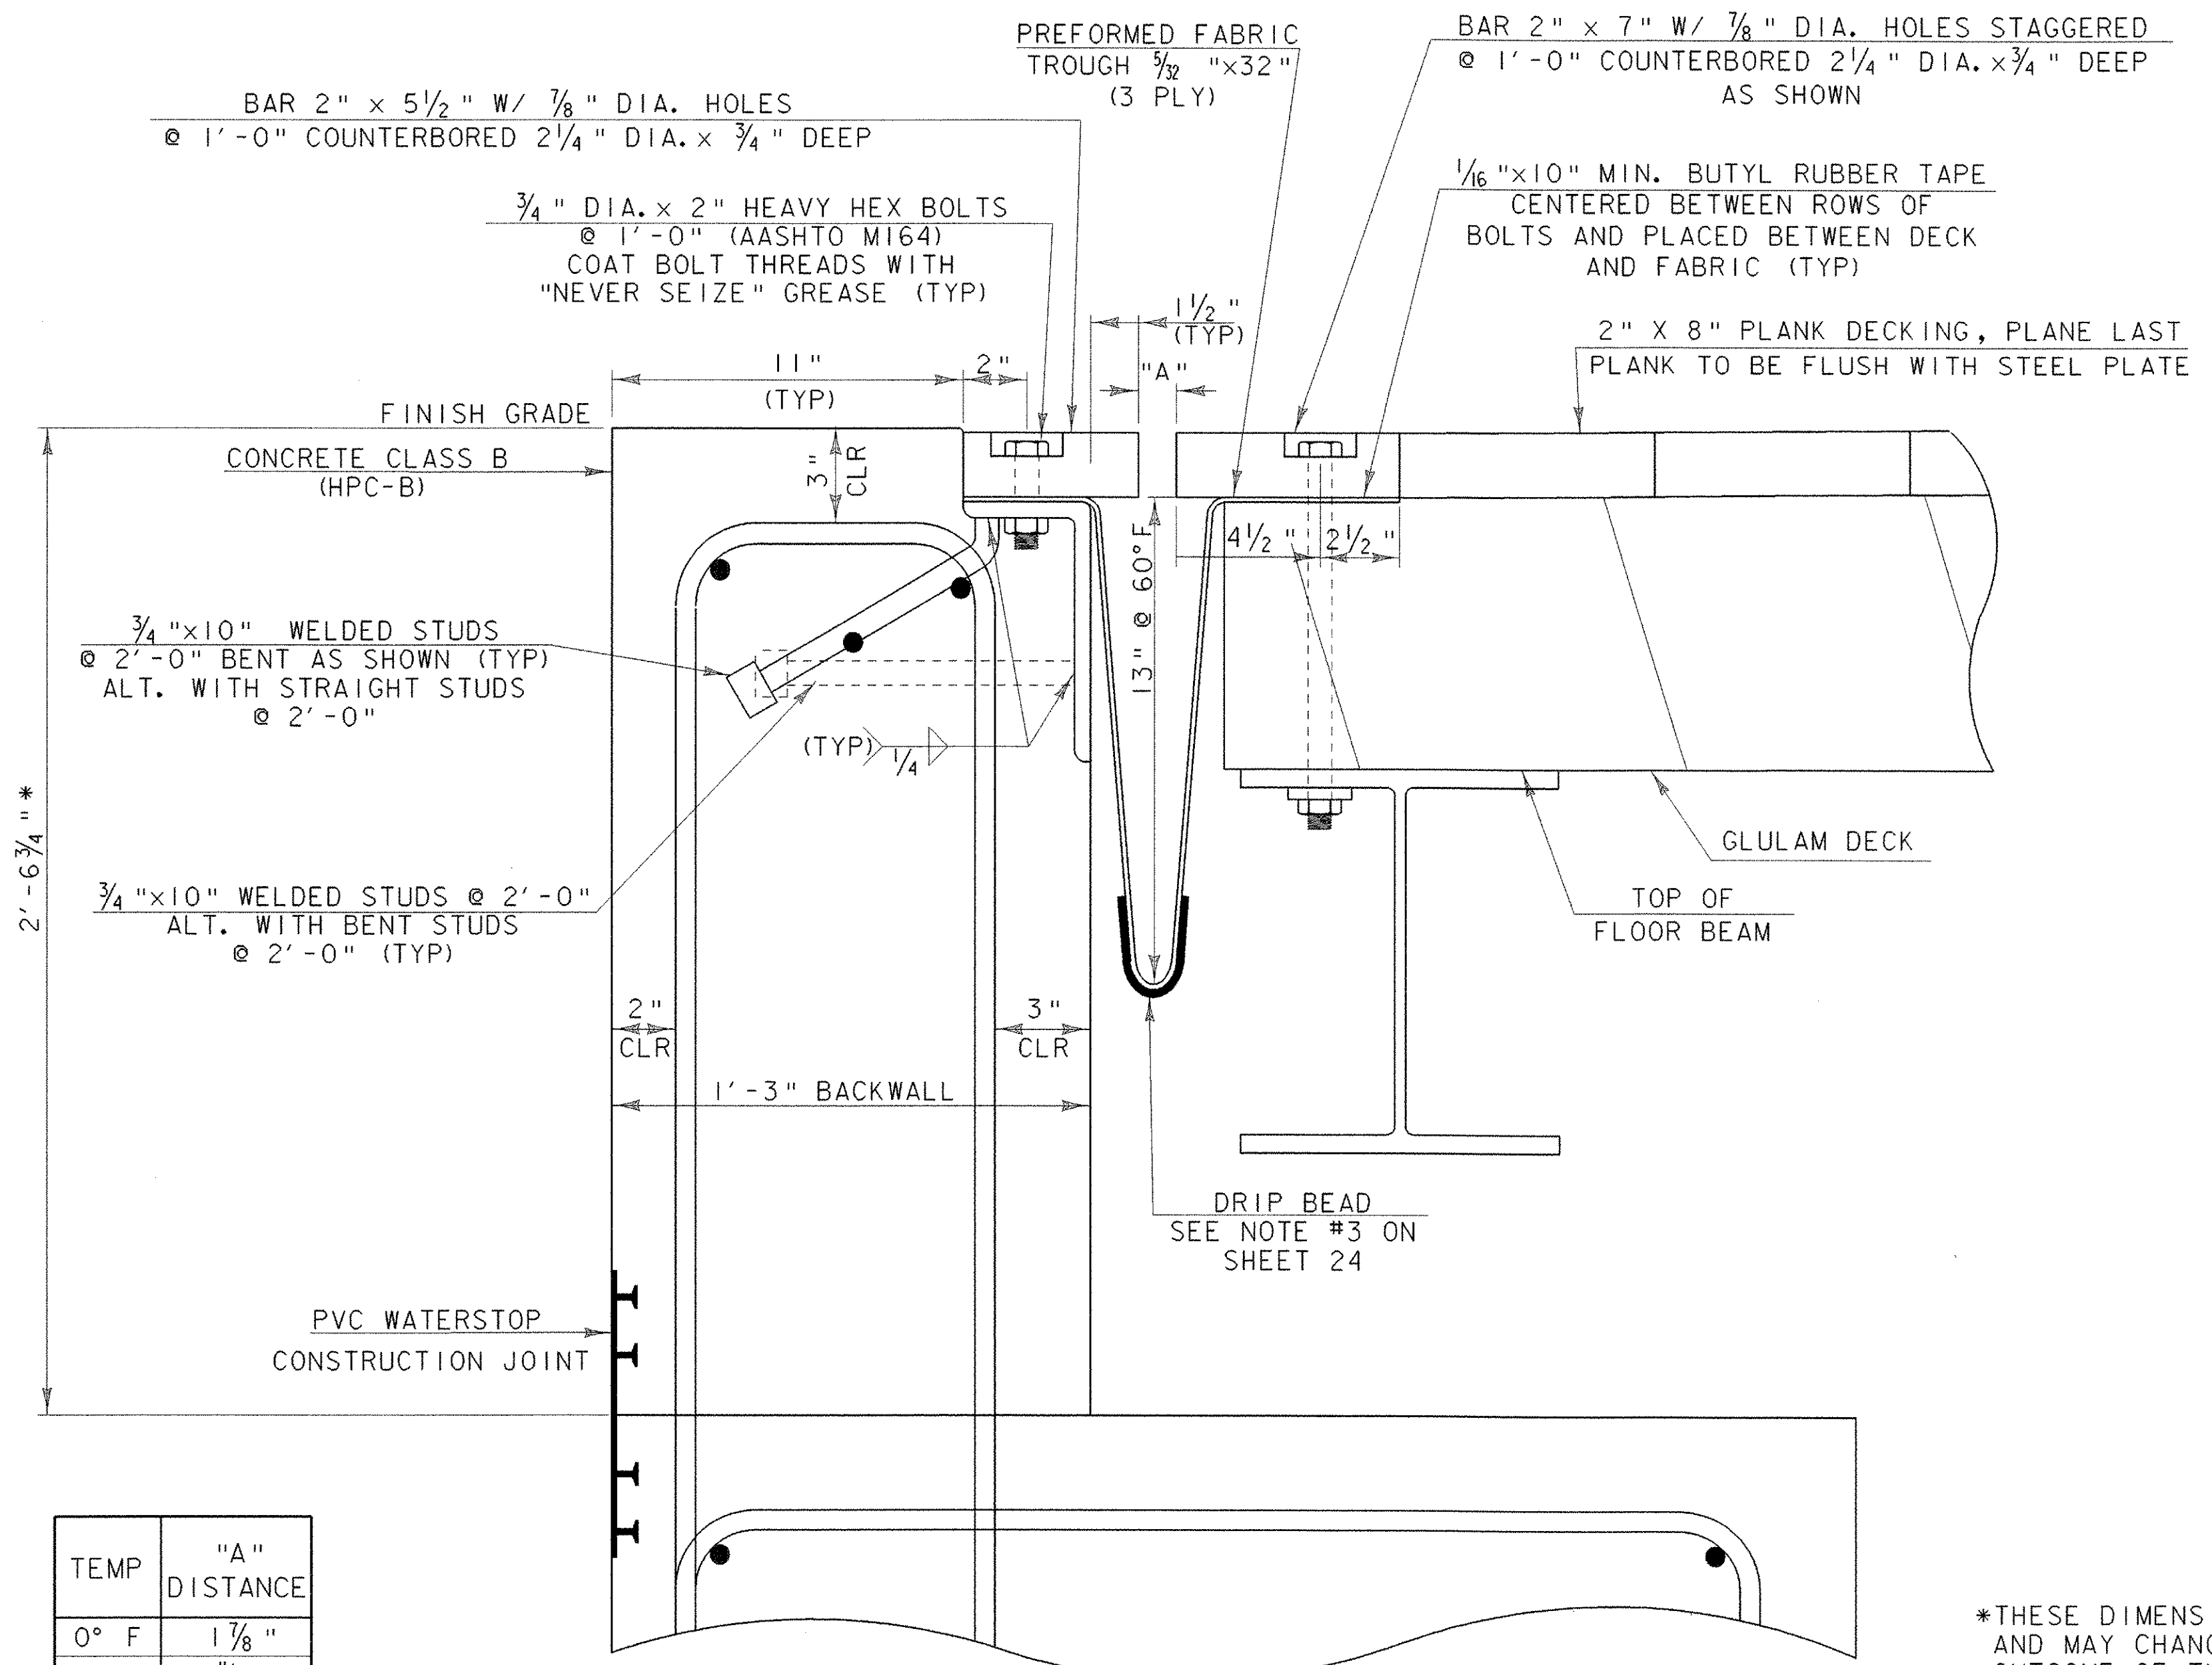


**TYPICAL SECTION BETWEEN BRACKETS**  
SCALE 3" = 1'-0"

**TYPICAL SECTION AT BRACKET**  
SCALE 3" = 1'-0"

TEMP	"A" DISTANCE
0° F	1 7/8"
15° F	1 11/16"
30° F	1 9/16"
45° F	1 3/8"
60° F	1 3/16"
75° F	1"
90° F	7/8"
105° F	11/16"

\*THESE DIMENSIONS ARE THEORETICAL AND MAY CHANGE DEPENDING UPON THE OUTCOME OF THE FINAL GRADE.  
\*\*GRIND OUTSIDE CORNER TO 1/4" RADIUS AS SHOWN.

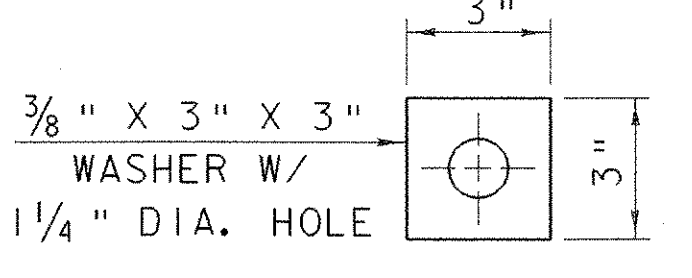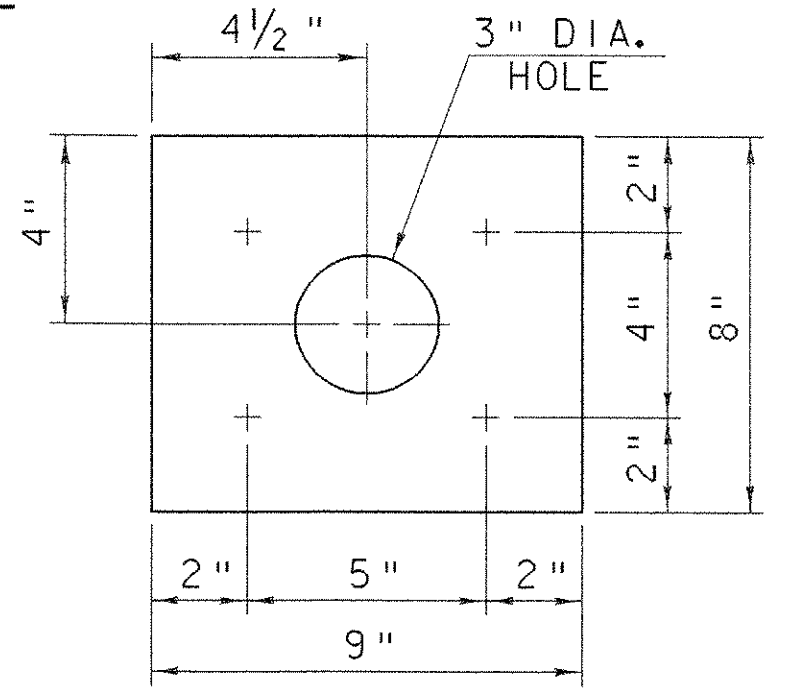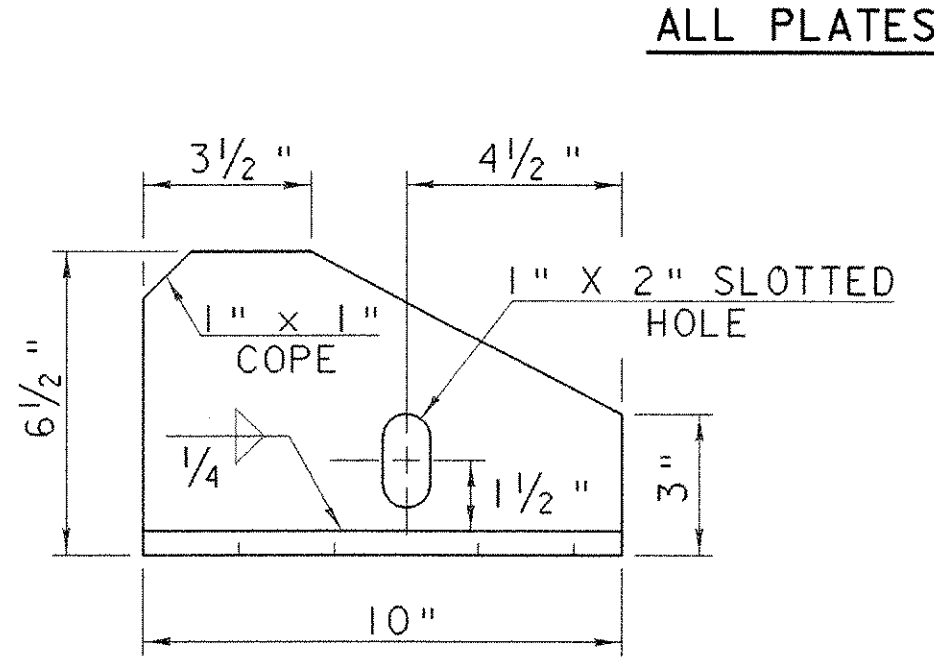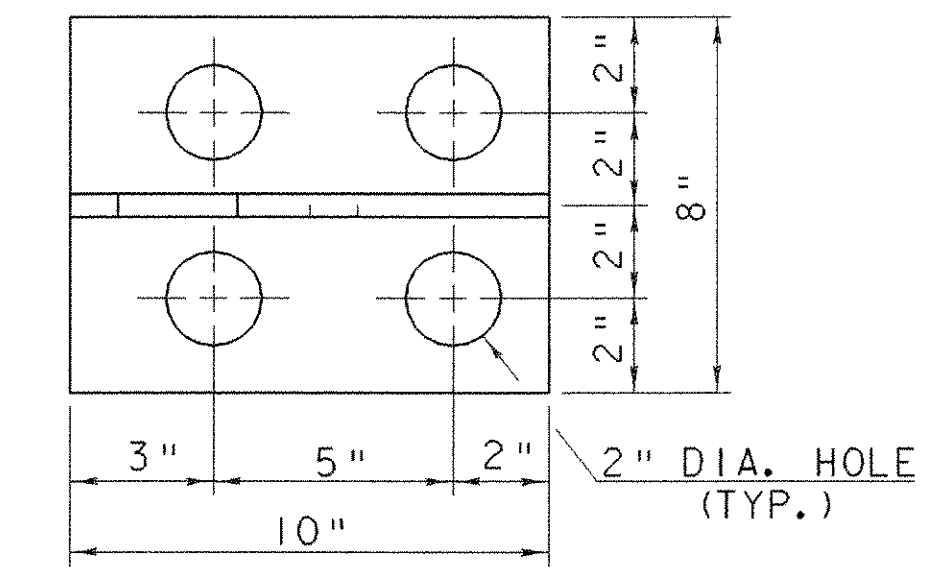

**BRACKET PLAN**  
SCALE 3" = 1'-0"


**BRACKET ELEVATION**  
SCALE 3" = 1'-0"

**PLATE PLAN**  
SCALE 3" = 1'-0"


**WASHER FOR BRACKET**  
SCALE 3" = 1'-0"



PROJECT: NEW HAVEN - WEYBRIDGE PROJECT NO.: BHO-BTN 2005 (1)  
 DESIGN FILE NAME: 89j081/structures/sj081joint.dgn  
 I/PARM FILE NAME: sj081joint.i PLOT DATE: 28-FEB-2007  
 DESIGNED BY: R.S. YOUNG DRAWN BY: R.S. YOUNG  
 SQUAD LEADER: C.P. WILLIAMS CHECKED BY: W.B. SYMONDS  
 EXPANSION JOINT DETAILS SHEET: 23 OF 53

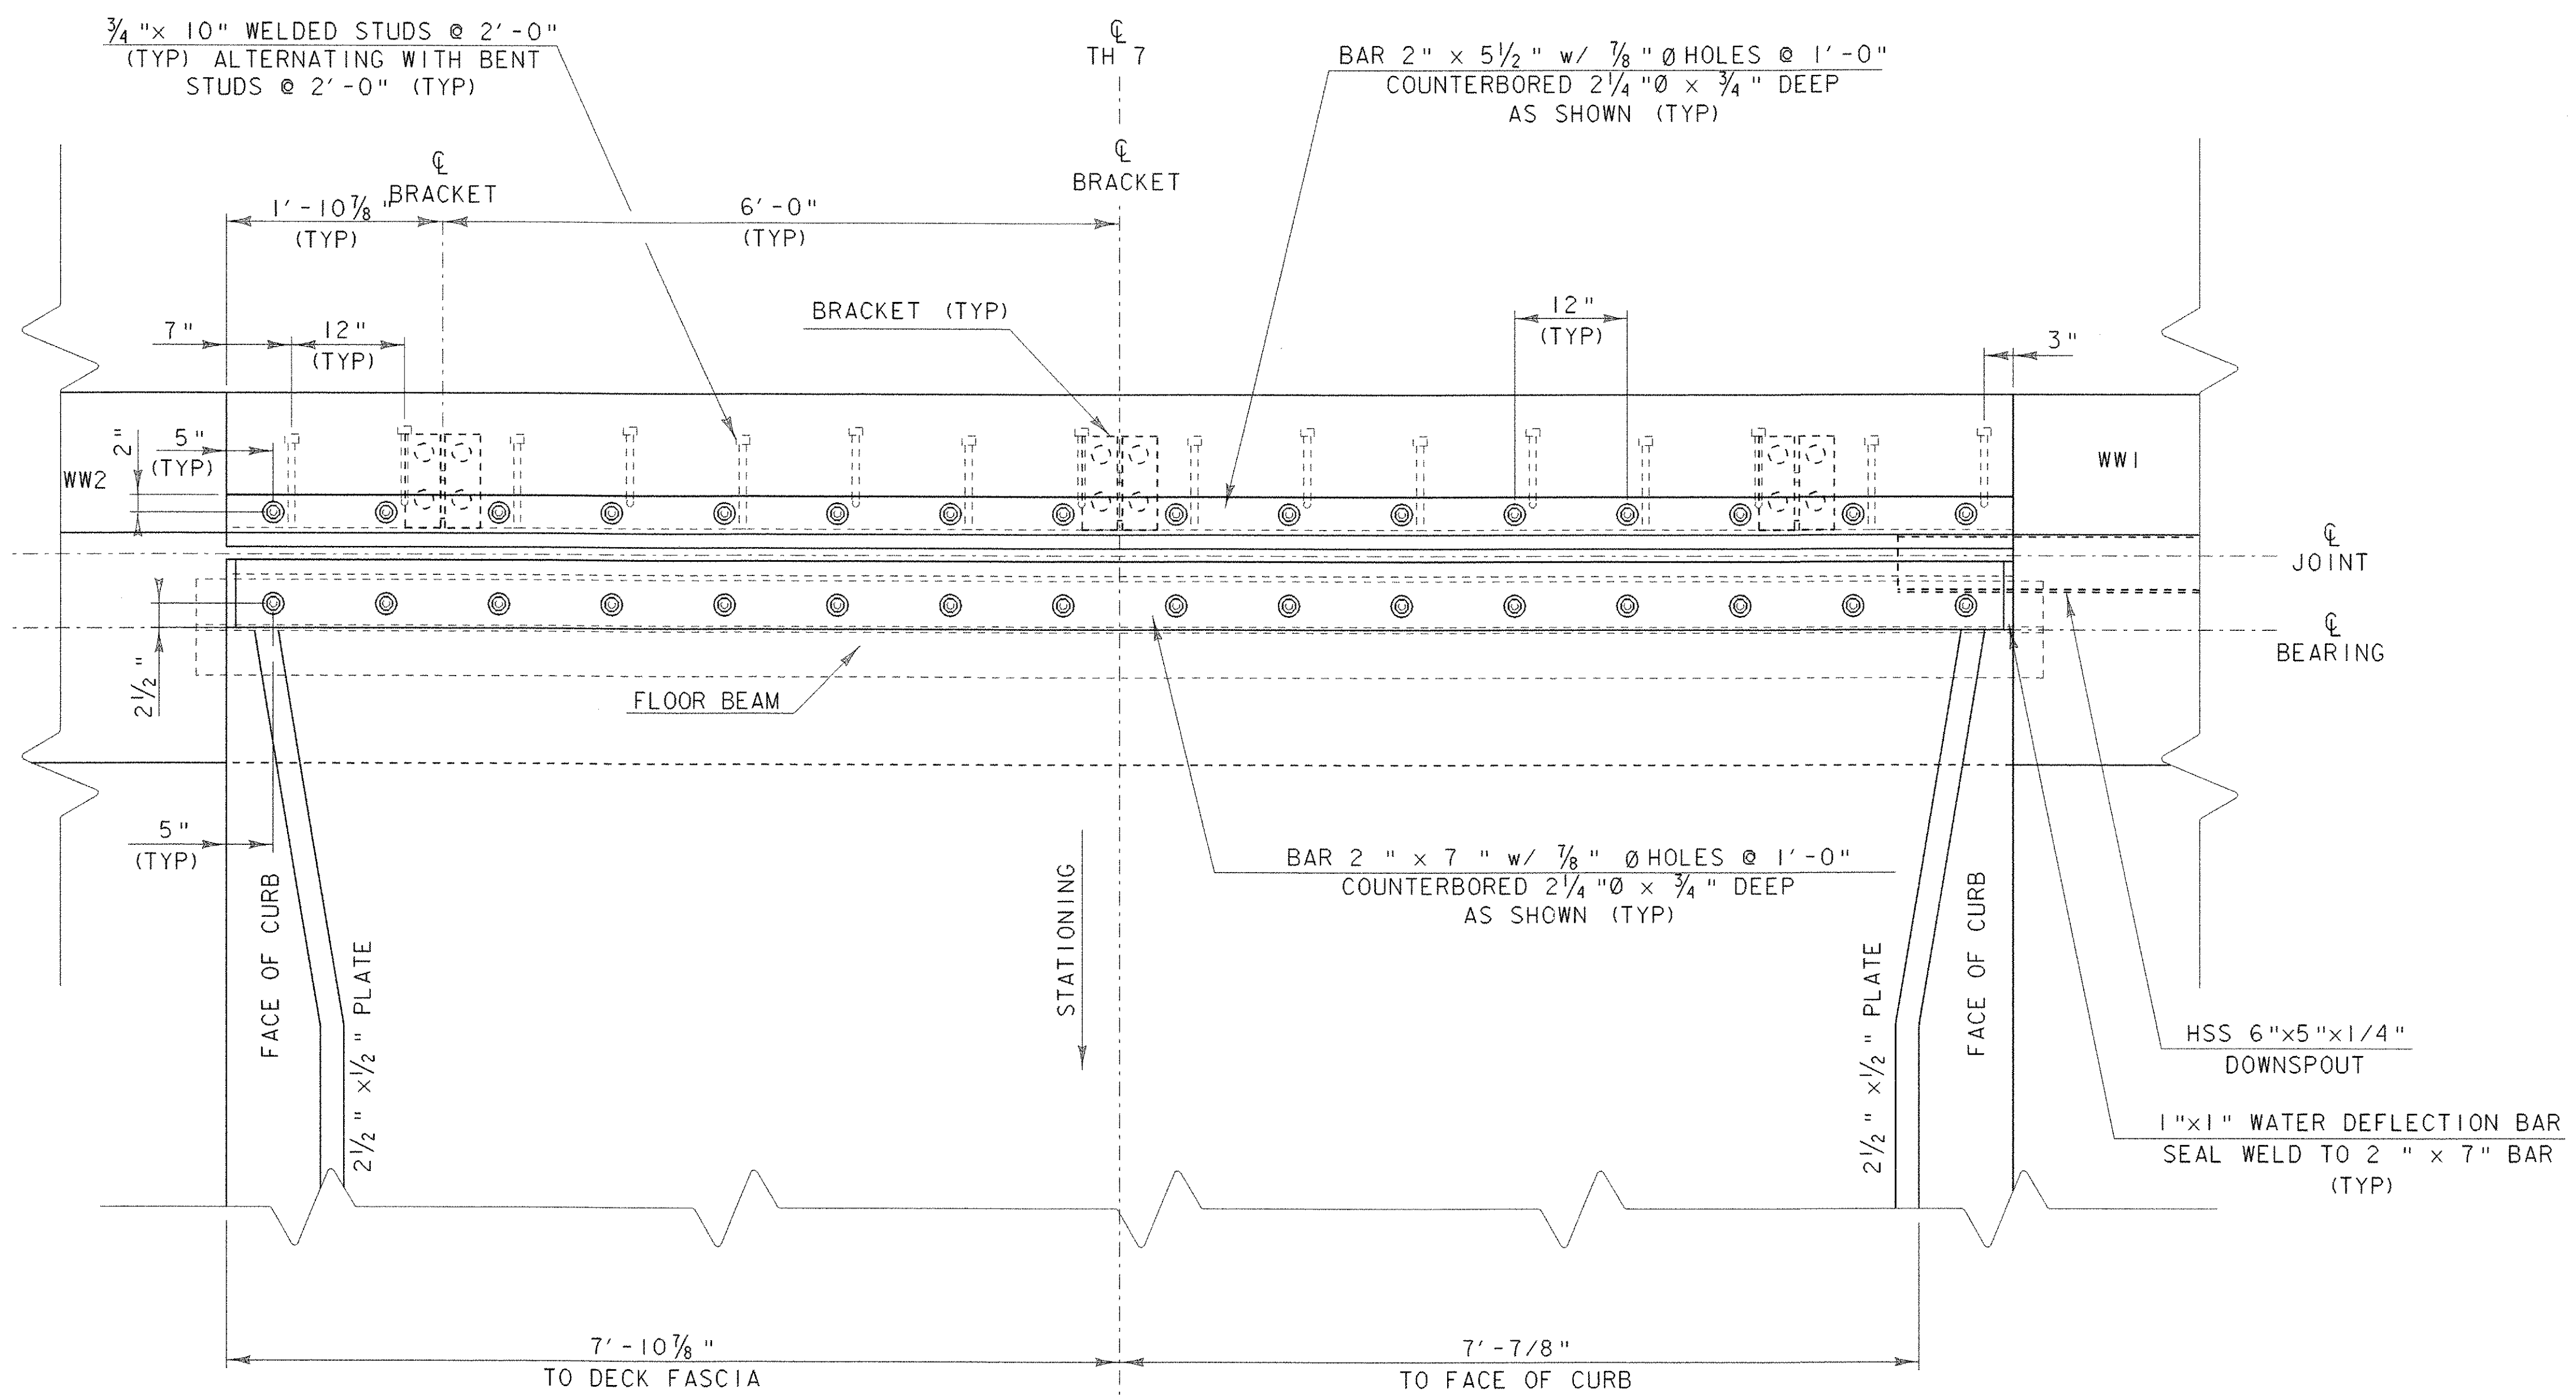


**EXPANSION JOINT PLAN**

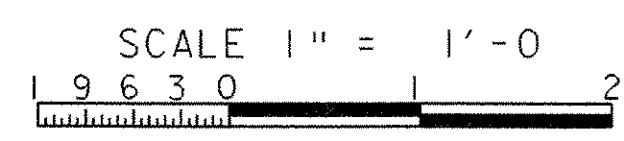

**EXPANSION JOINT NOTES:**


1. DETAILS ON SHEET 23 AND THIS SHEET ARE FOR ITEM 516.11 "BRIDGE EXPANSION JOINT, VERMONT".
2. PREFORMED FABRIC MATERIAL SHALL BE CONTINUOUS AND SHALL CONFORM TO SUBSECTION 707.07.
3. BUTYL RUBBER TAPE SHALL CONFORM TO AASHTO SPECIFICATION M-198, TYPE 11.
4. ALL STEEL COMPONENTS SHALL BE AASHTO M270 GRADE 36 GALVANIZED OR METALIZED AS PER SUBSECTION 516.04. THREADED RODS SHALL CONFORM TO ASTM A307, GRADE C. THE NUTS FOR THE THREADED RODS SHALL BE ASTM A 563.
5. THE ITEM "BRIDGE EXPANSION JOINT, VERMONT" SHALL INCLUDE THE FABRICATION AND ERECTION OF THE COMPLETE JOINT ASSEMBLY INCLUDING ALL STEEL PLATES, BOLTS, BRACKETS, ANGLES, WELDED STUDS OR RODS, PREFORMED FABRIC DRAIN TROUGH MATERIAL, BUTYL RUBBER TAPE AND ANY OTHER MISCELLANEOUS MATERIAL NECESSARY TO INSTALL JOINT.
6. PAYMENT FOR DRILLING HOLES IN THE GLULAM DECK AND FLOOR BEAM SHALL BE INCIDENTAL TO 522.40 "STRUCTURAL GLUED LAMINATED TIMBER", AND 506.60 "STRUCTURAL STEEL"
7. COAT CONCRETE CONTACT SURFACES WITH EPOXY BONDING COMPOUND MEETING THE REQUIREMENTS OF SUBSECTION 516.05. PAYMENT SHALL BE INCLUDED IN THE UNIT PRICE BID FOR ITEM 516.11 "BRIDGE EXPANSION JOINT, VERMONT".
8. FILL COUNTERBORED HOLES WITH HOT POURED JOINT SEALER (STD. SPEC. 707.04) AFTER BOLT INSTALLATION. PAYMENT FOR THE WORK SHALL BE INCIDENTAL TO ITEM 516.11.
9. PAYMENT FOR WATERSTOP SHALL BE INCIDENTAL TO THE CONCRETE PAY ITEM.
10. A DRIP BEAD OF 1/4"x7" STRIP OF PREFORMED MATERIAL SHALL BE CEMENTED TO THE BOTTOM OF THE FABRIC TROUGH USING AN ADHESIVE APPROVED BY THE MANUFACTURER. THE DRIP BEAD SHALL BE APPLIED 1" FROM THE DOWNSPOUT END OF THE TROUGH.
11. FABRIC TROUGH SHALL BE THOROUGHLY CLEANED AND FLUSHED AFTER PAVING OPERATION.

PROJECT: NEW HAVEN - WEYBRIDGE	PROJECT NO. : BHO-BTN 2005 (1)
DESIGN FILE NAME: 89j081/structures/sj081joint.dgn	
IPARM FILE NAME: sj081jointplan.i	PLOT DATE: 28-FEB-2007
DESIGNED BY: R.S. YOUNG	DRAWN BY: R.S. YOUNG
SQUAD LEADER: C.P. WILLIAMS	CHECKED BY: W.B. SYMONDS
EXPANSION JOINT PLAN/WATERSTOP	SHEET: 24 OF 53

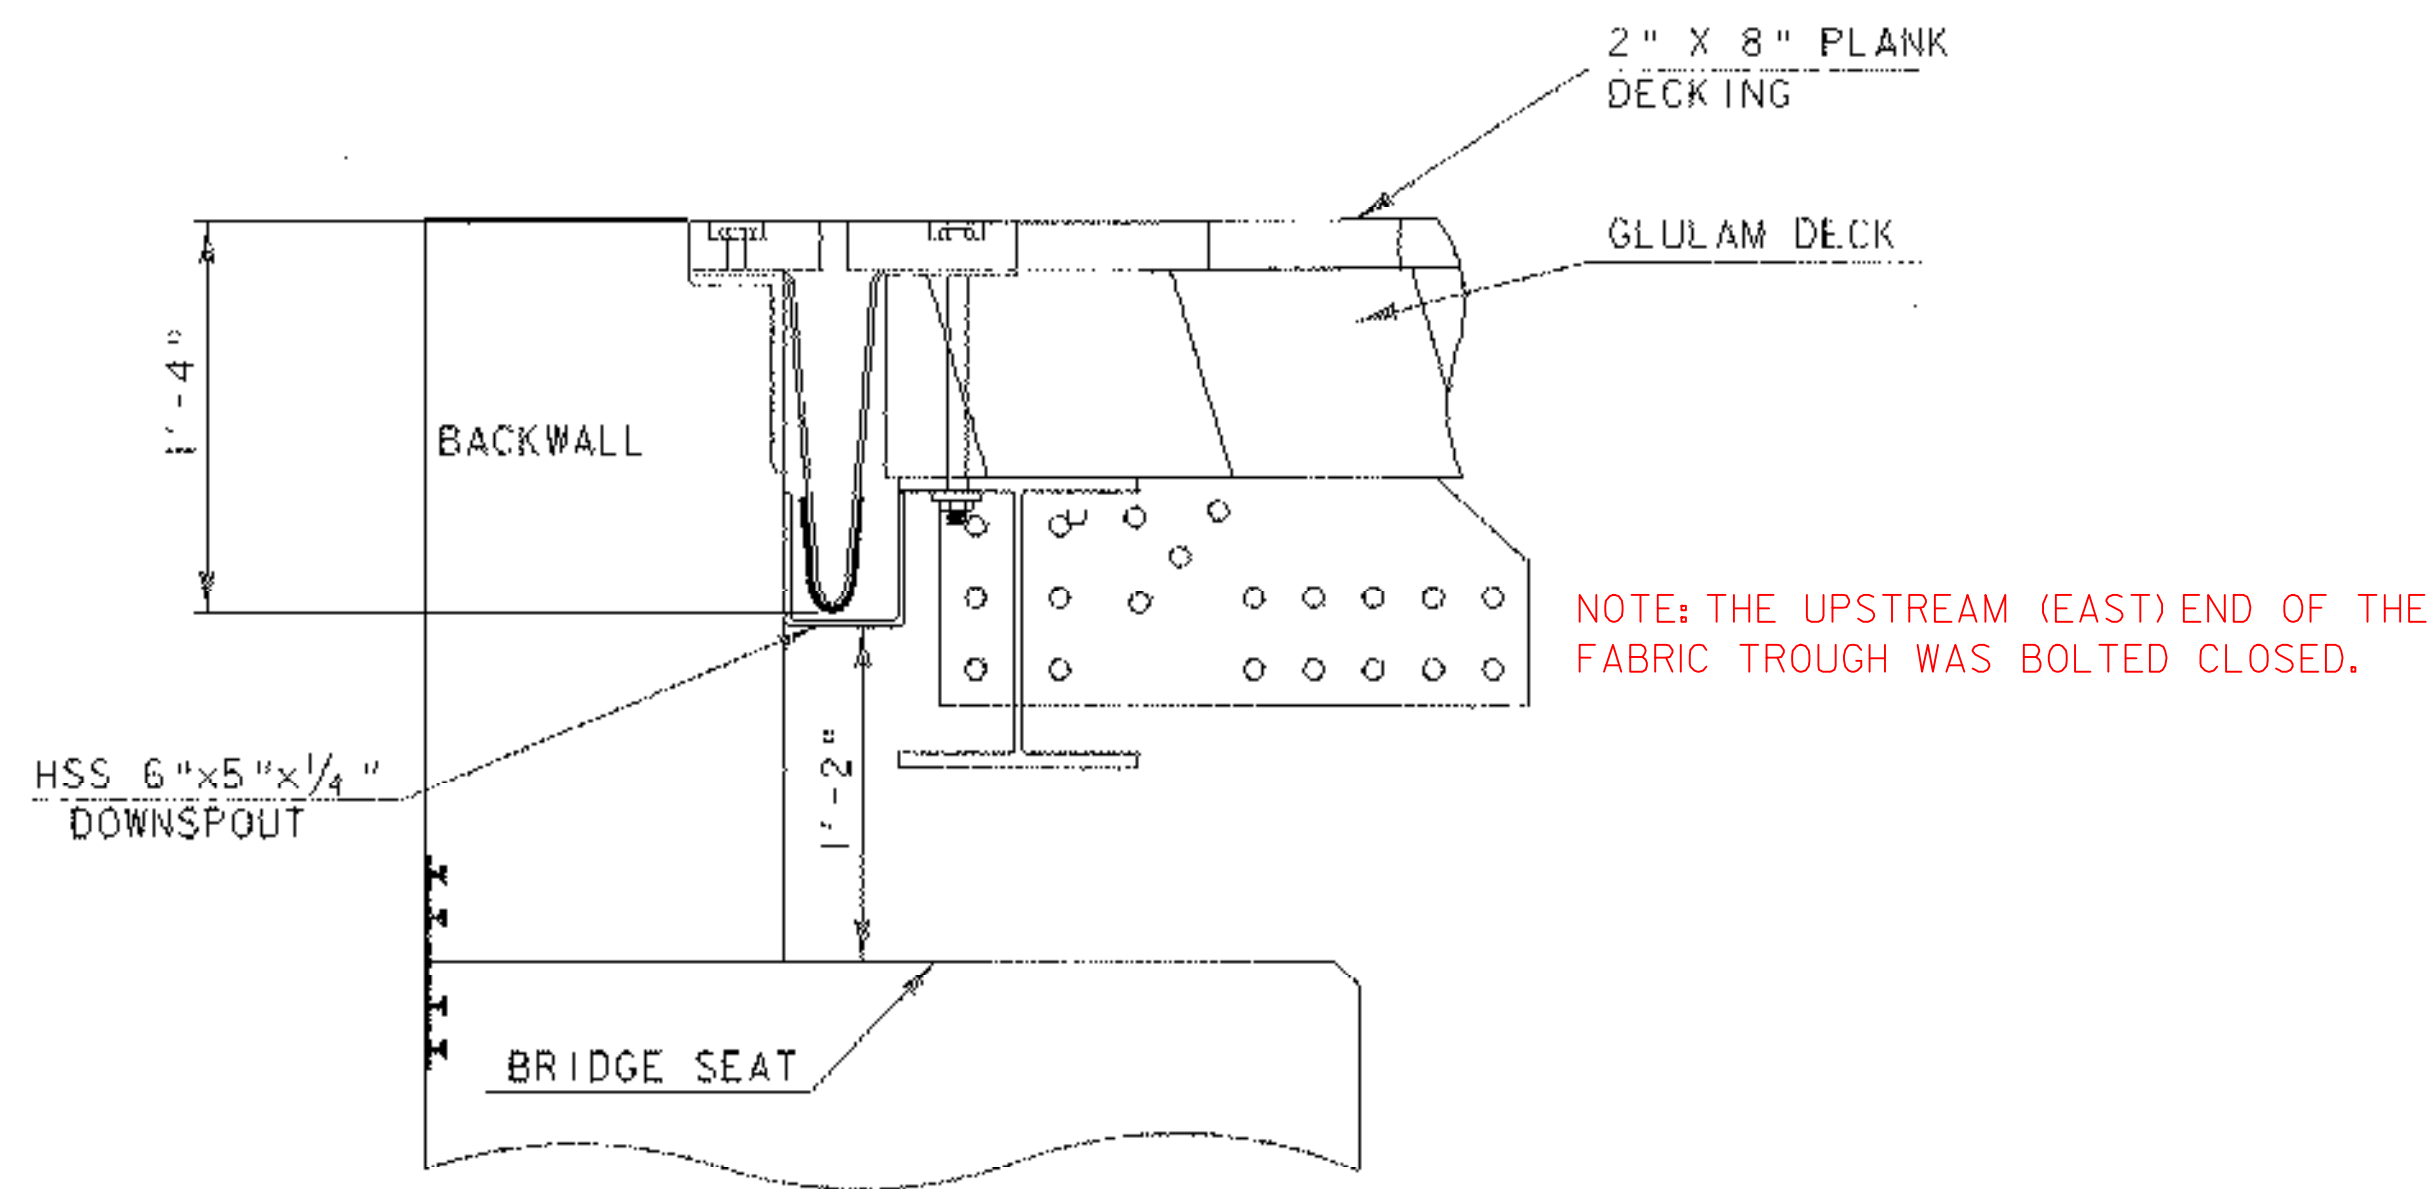



VIEW A - A

SCALE 1 1/2" = 1'-0"

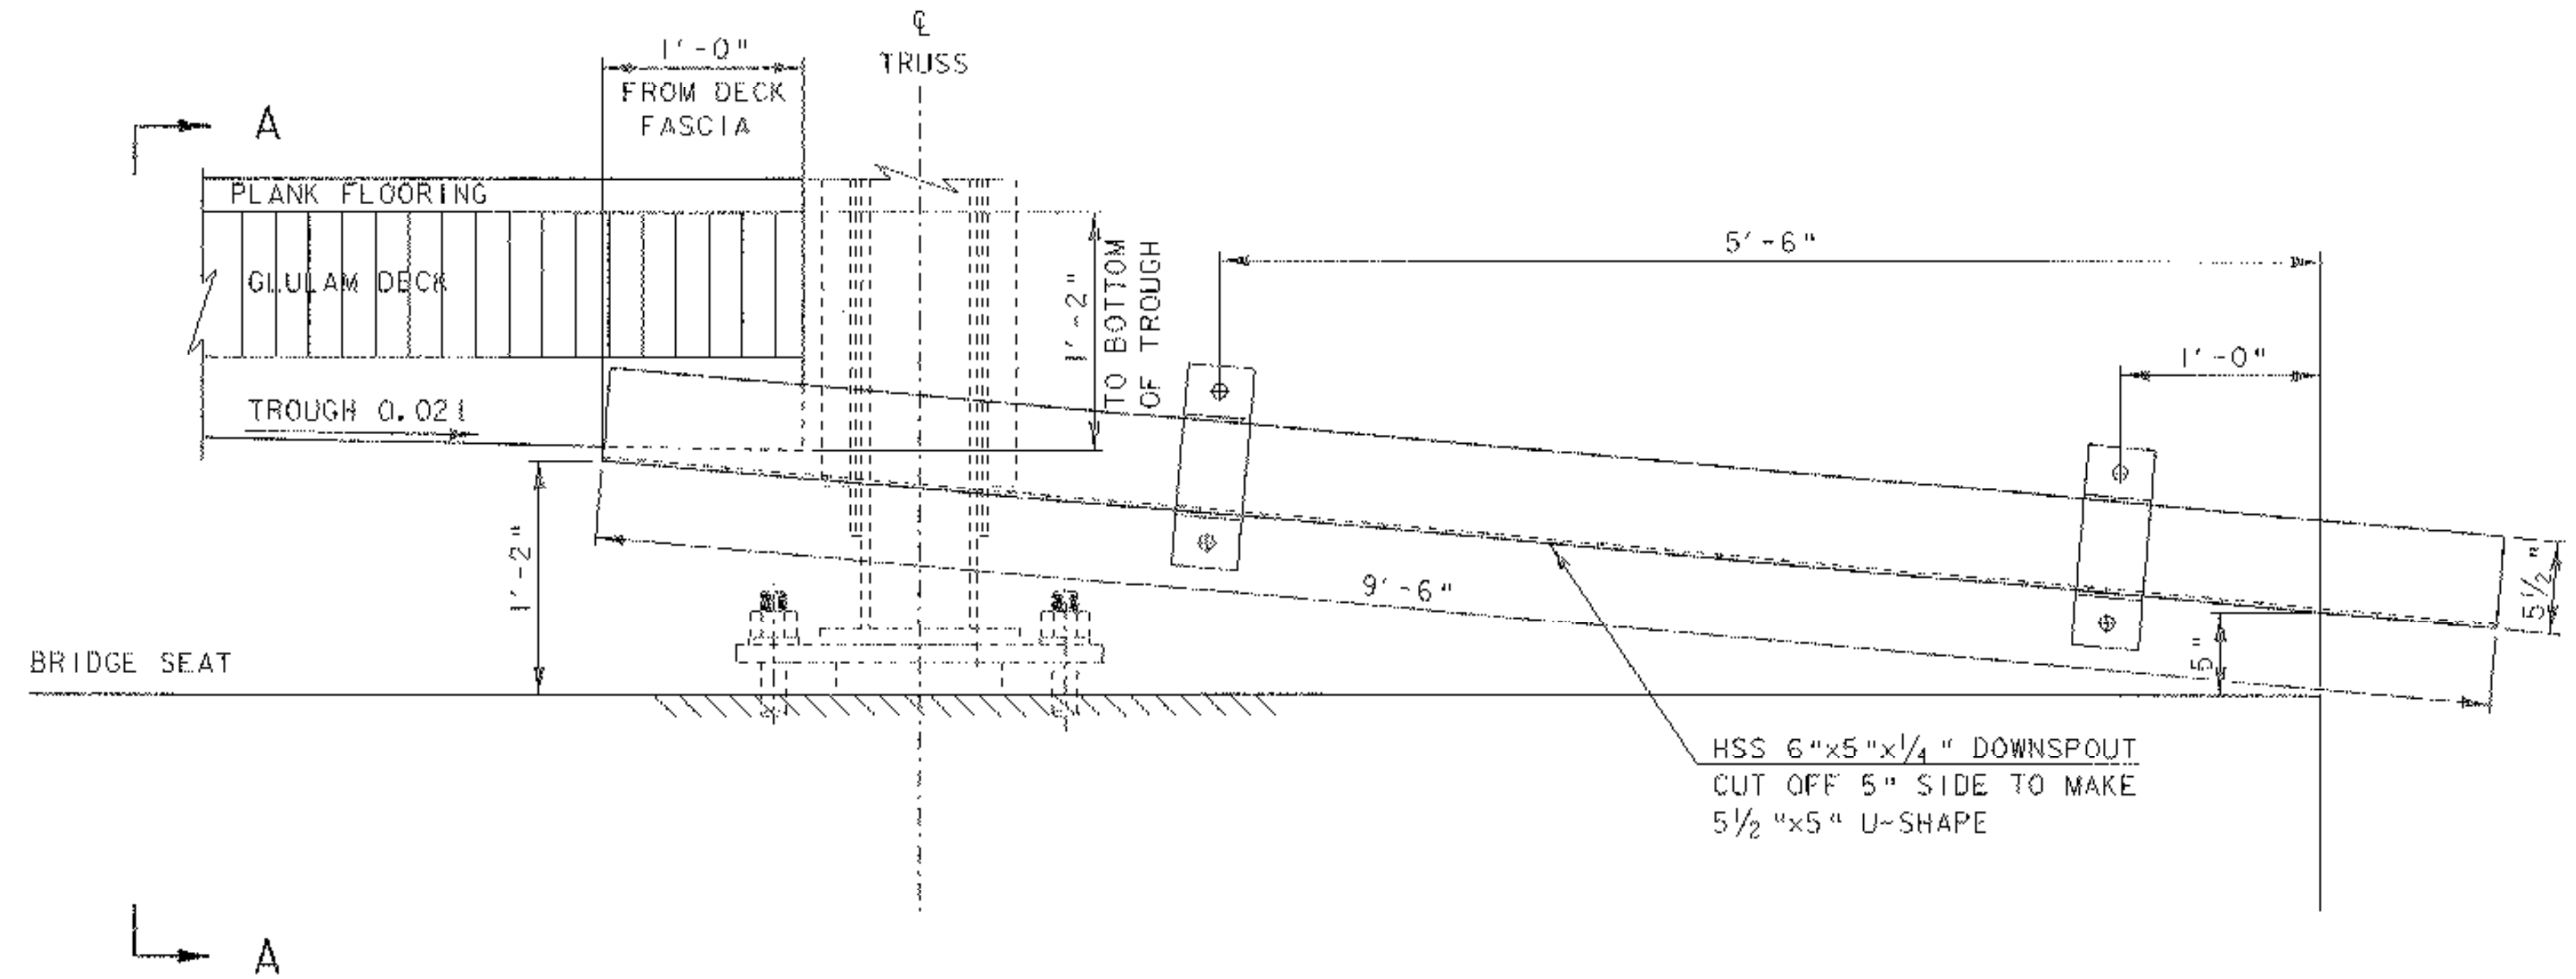

DOWNSPOUT ELEVATION

SCALE 1 1/2" = 1'-0"

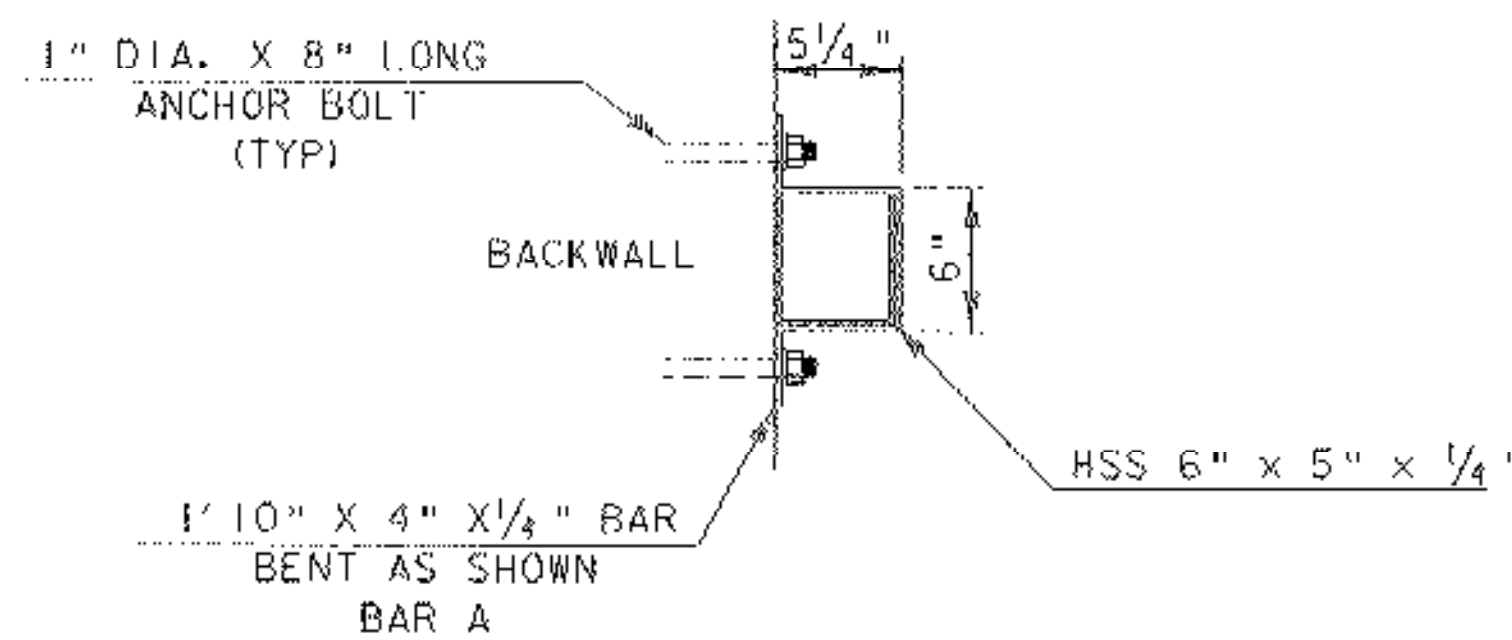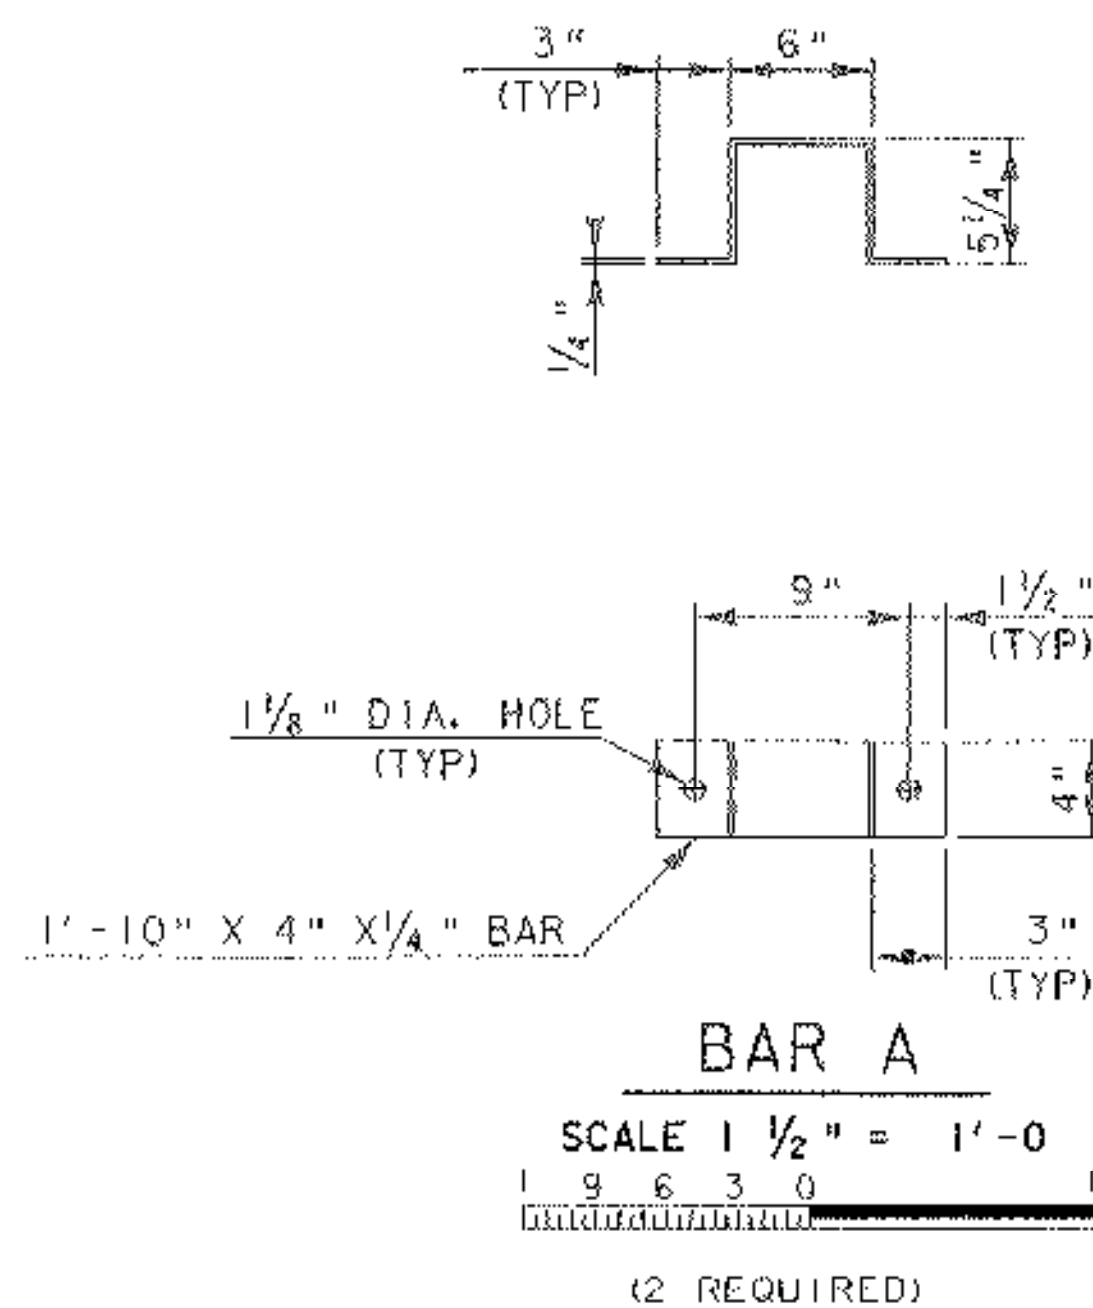


CROSS SECTION OF DOWNSPOUT AT BAR LOCATION

SCALE 1 1/2" = 1'-0"

DOWNSPOUT NOTES


1. STRUCTURAL STEEL TUBING SHALL CONFORM TO ASTM A-500 GRADE B.
2. ALL PLATES, BARS, AND ANGLES SHALL CONFORM TO AASHTO M270 GRADE 50.
3. DOWNSPOUT SHALL BE GALVANIZED IN ACCORDANCE WITH VAOT STANDARD SPECIFICATIONS FOR CONSTRUCTION SECTION 506.15.
4. ALL BOLTS AND RELATED HARDWARE SHALL BE ASTM A-307 AND SHALL BE GALVANIZED IN ACCORDANCE WITH AASHTO M 232/M 232.
5. ANY PLACE WHERE THE GALVANIZING HAS BEEN REMOVED FROM THE DOWNSPOUT EITHER BY CUTTING, BURNING, WELDING, PLACING, OR ANY OTHER MEANS, SHALL BE REPAIRED BY THOROUGHLY CLEANING THE DAMAGED AREAS WITH A WIRE BRUSH AND PAINTING THE DAMAGED AREAS WITH AN APPROVED SEALANT, PAYMENT SHALL BE INCIDENTAL TO ITEM 506.60 "STRUCTURAL STEEL".
6. PLATES, BARS, AND ANGLES SHALL BE PAID FOR UNDER THE ITEM 506.60 "STRUCTURAL STEEL".
7. GRIND ALL CORNERS TO A 1/16" RADIUS PRIOR TO GALVANIZING.

PROJECT: NEW HAVEN - WEYBRIDGE	PROJECT NO.: BHO-BTN 2005 (1)
DESIGN FILE NAME: 89J081/structures/sj081downsp.t.dgn	PLOT DATE: 28-FEB-2007
IPARM FILE NAME: sj0812downsp.t.1	DESIGNED BY: R. S. YOUNG
SQUAD LEADER: C. P. WILLIAMS	DRAWN BY: R. S. YOUNG
DOWN SPOUT DETAILS	CHECKED BY: R. S. YOUNG
	SHEET: 25 OF 53

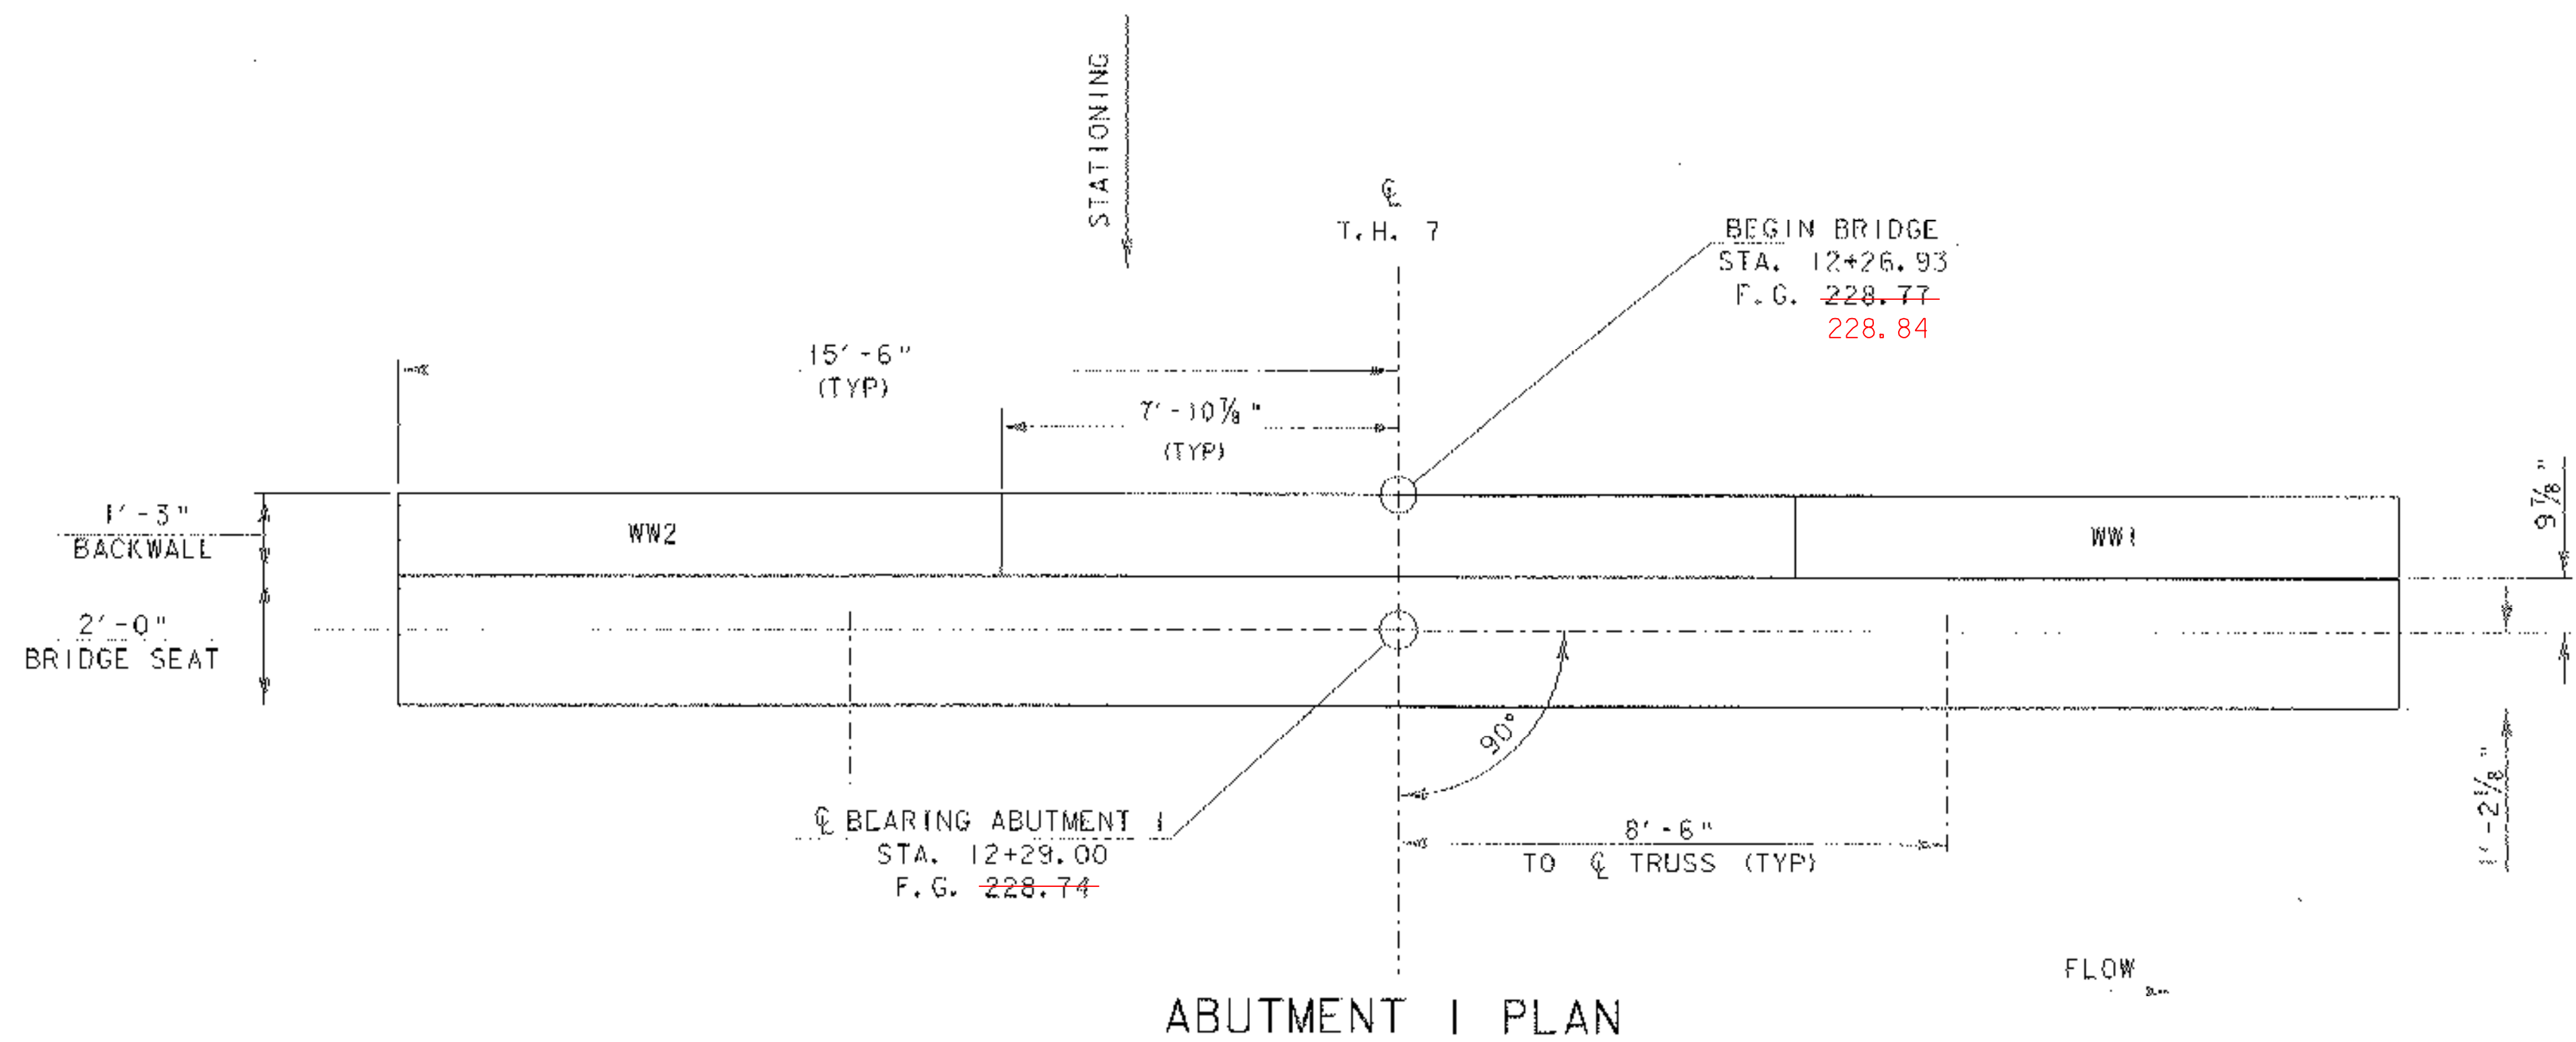


ABUTMENT I PLAN

SCALE 1/2" = 1'-0"

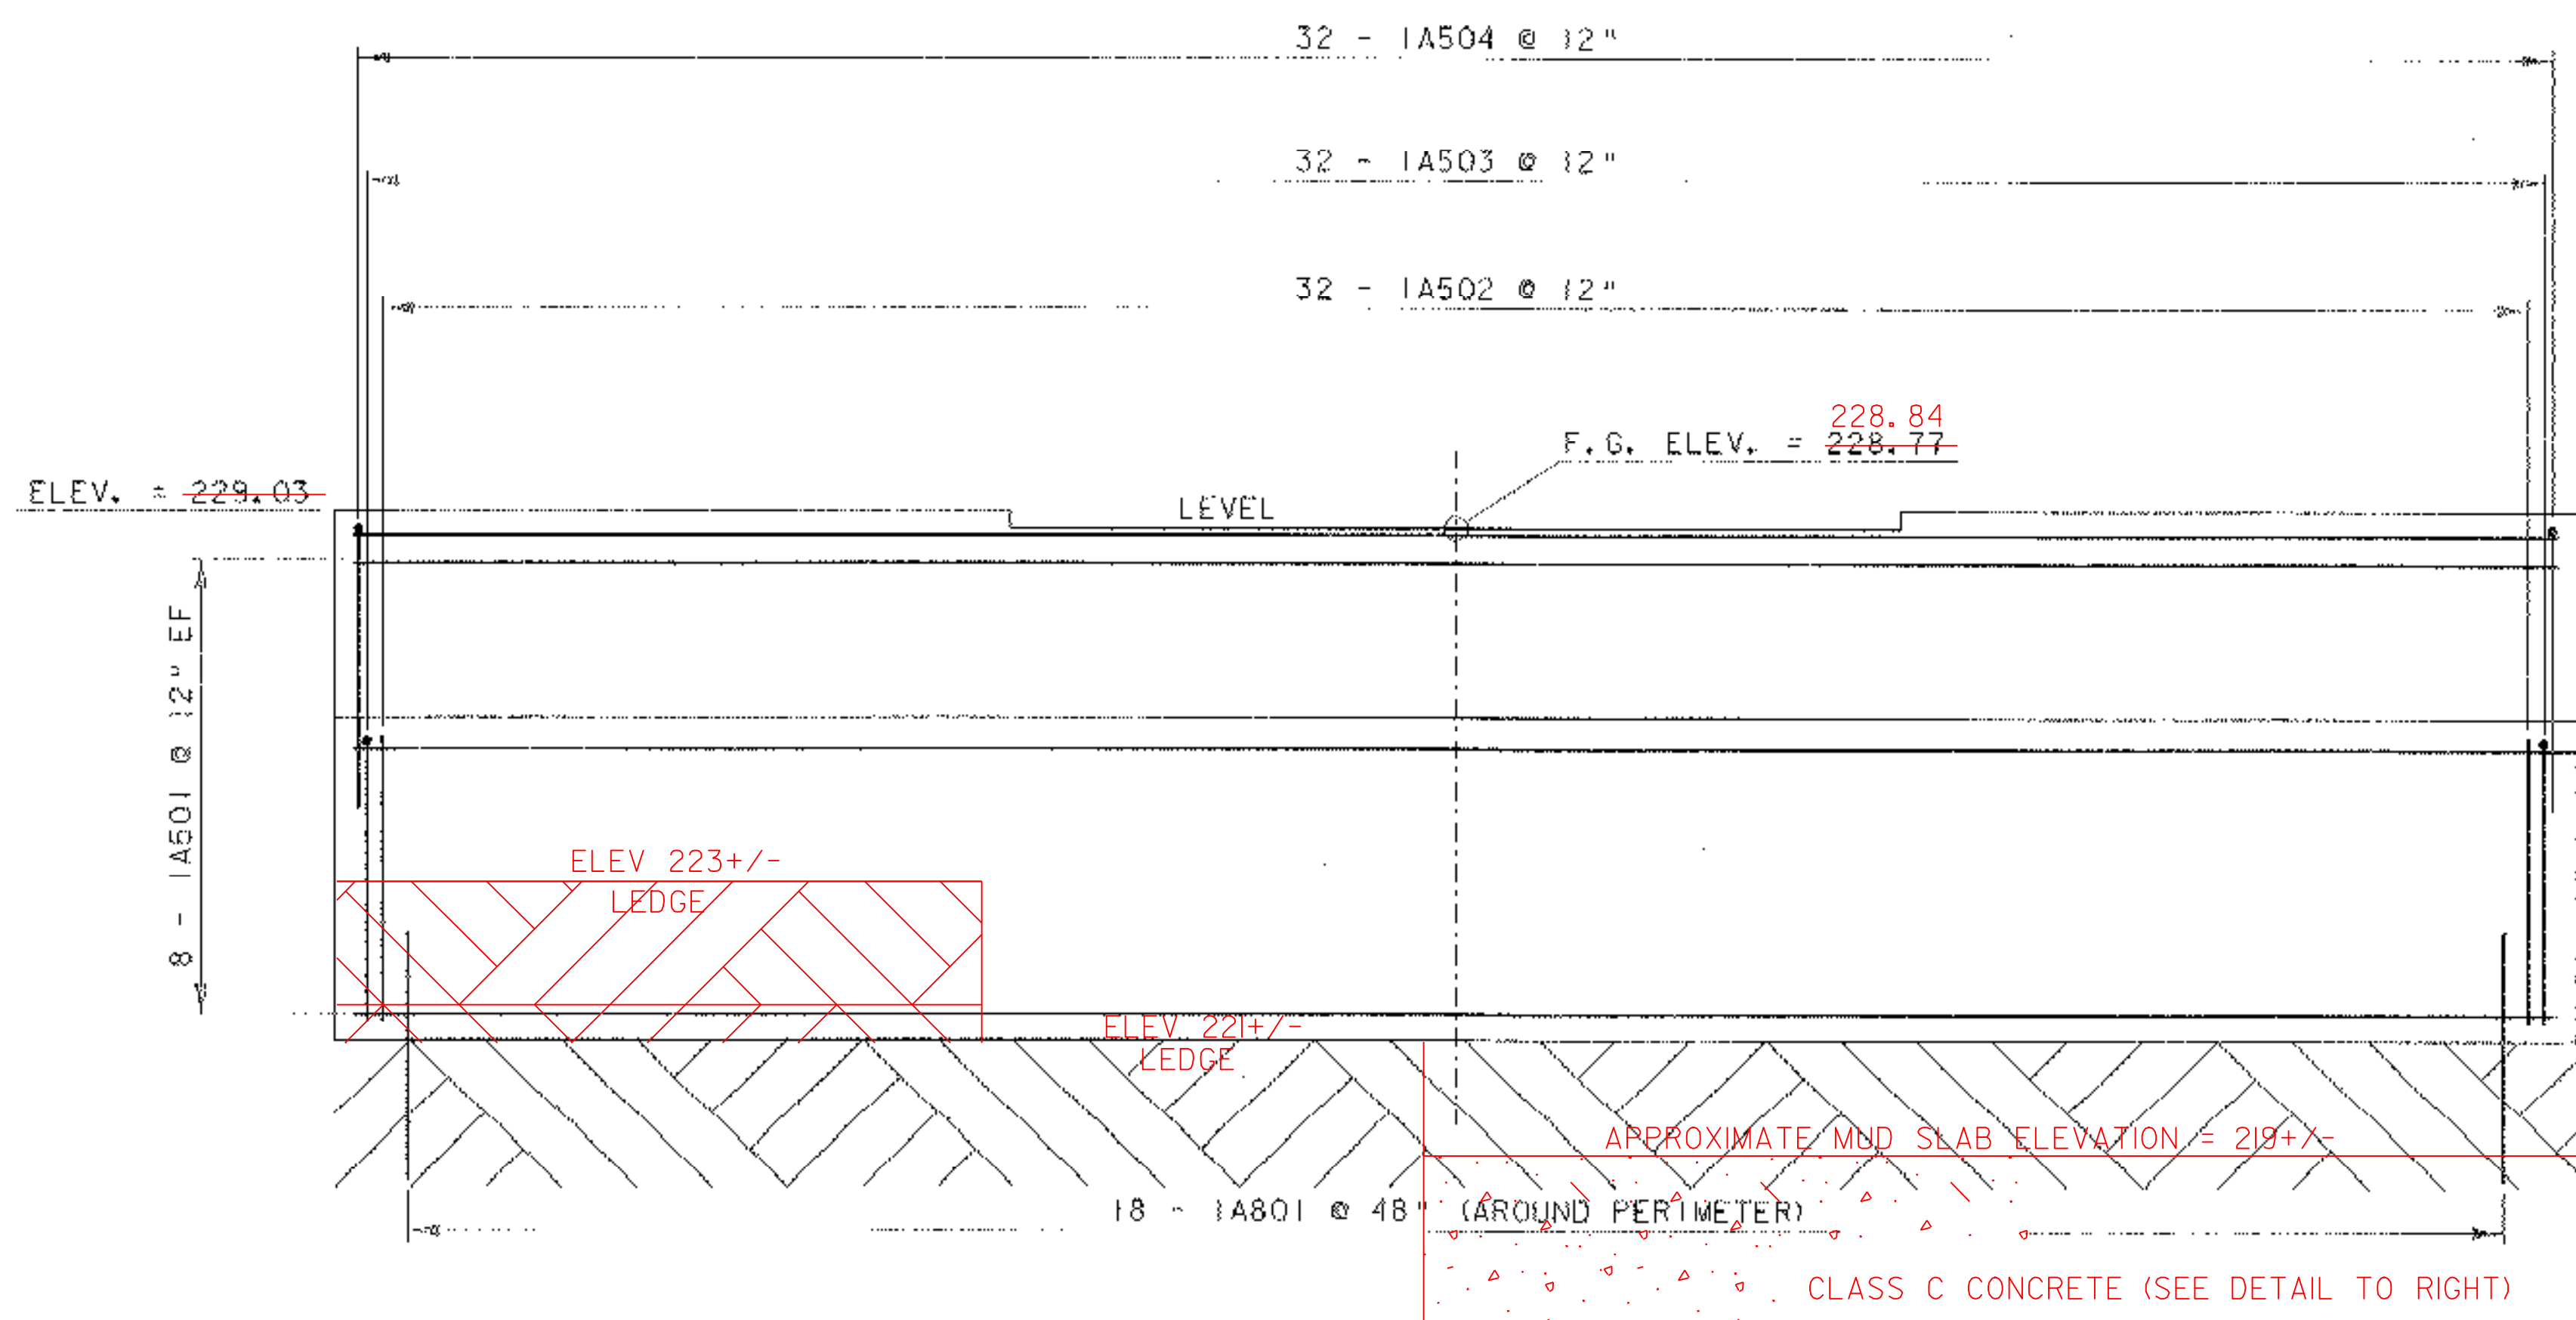


ABUTMENT I ELEVATION

SCALE 1/2" = 1'-0"

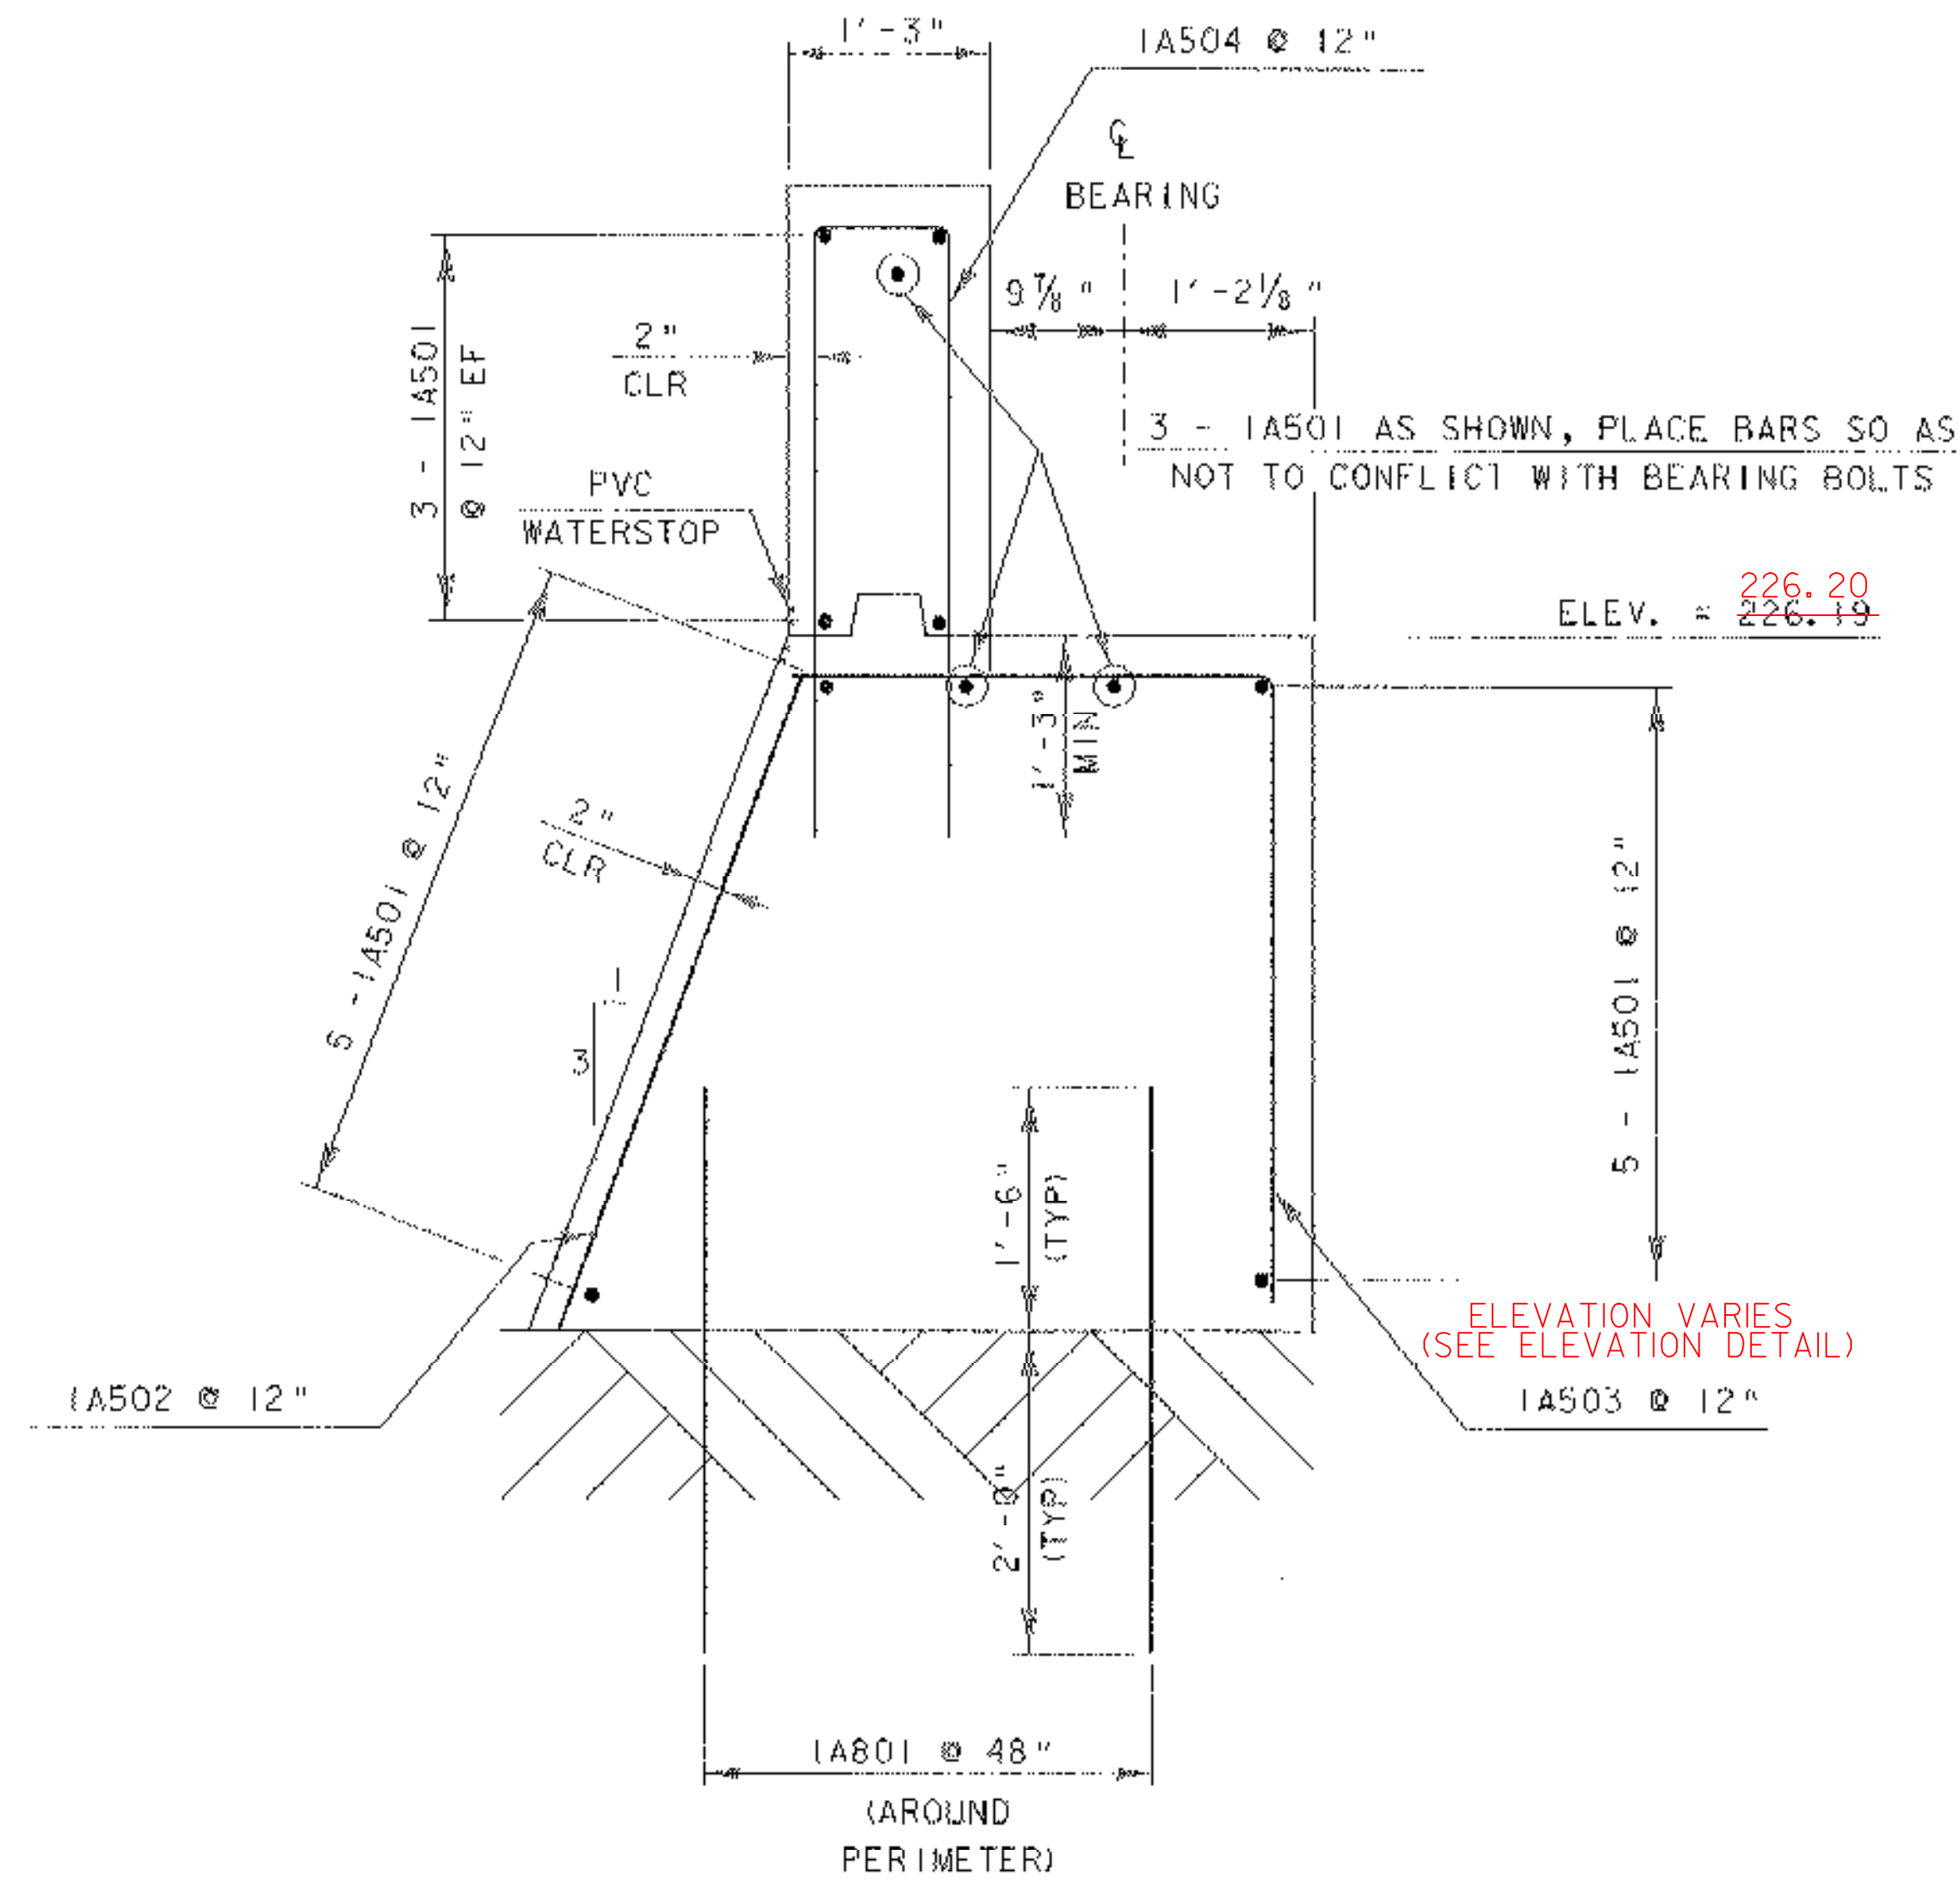

ABUTMENT I TYPICAL SECTION


SCALE 1" = 1'-0"

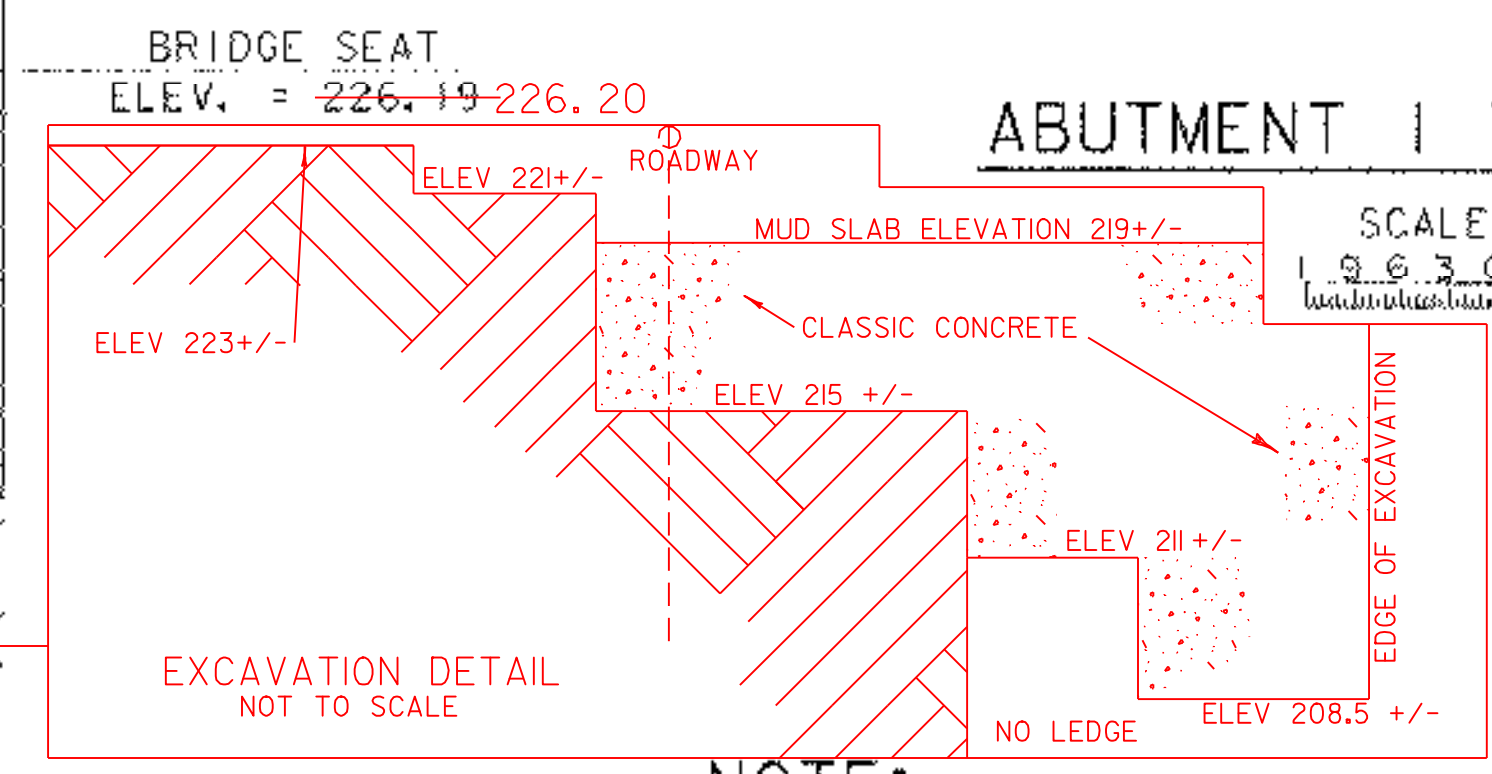

NOTE:


- NF = NEAR FACE
- FF = FAR FACE
- EF = EACH FACE
- ▲ = CUT TO FIT IN FIELD
- 3" CLR. UNLESS OTHERWISE SPECIFIED ON THE PLANS.

PROJECT: <b>NEW HAVEN-WEYBRIDGE</b>	PROJECT NO.: <b>BHO-BTN 2005 (1)</b>
DESIGN FILE NAME: 89J081/structures/sj081sub.dgn	PLOT DATE: 28-FEB-2007
IPARM FILE NAME: sj081ab1.i	DRAWN BY: R.S. YOUNG
DESIGNED BY: R. S. YOUNG	CHECKED BY: R.S. YOUNG
SQUAD LEADER: C. P. WILLIAMS	SHEET: 26 OF 53
ABUTMENT I DETAILS	

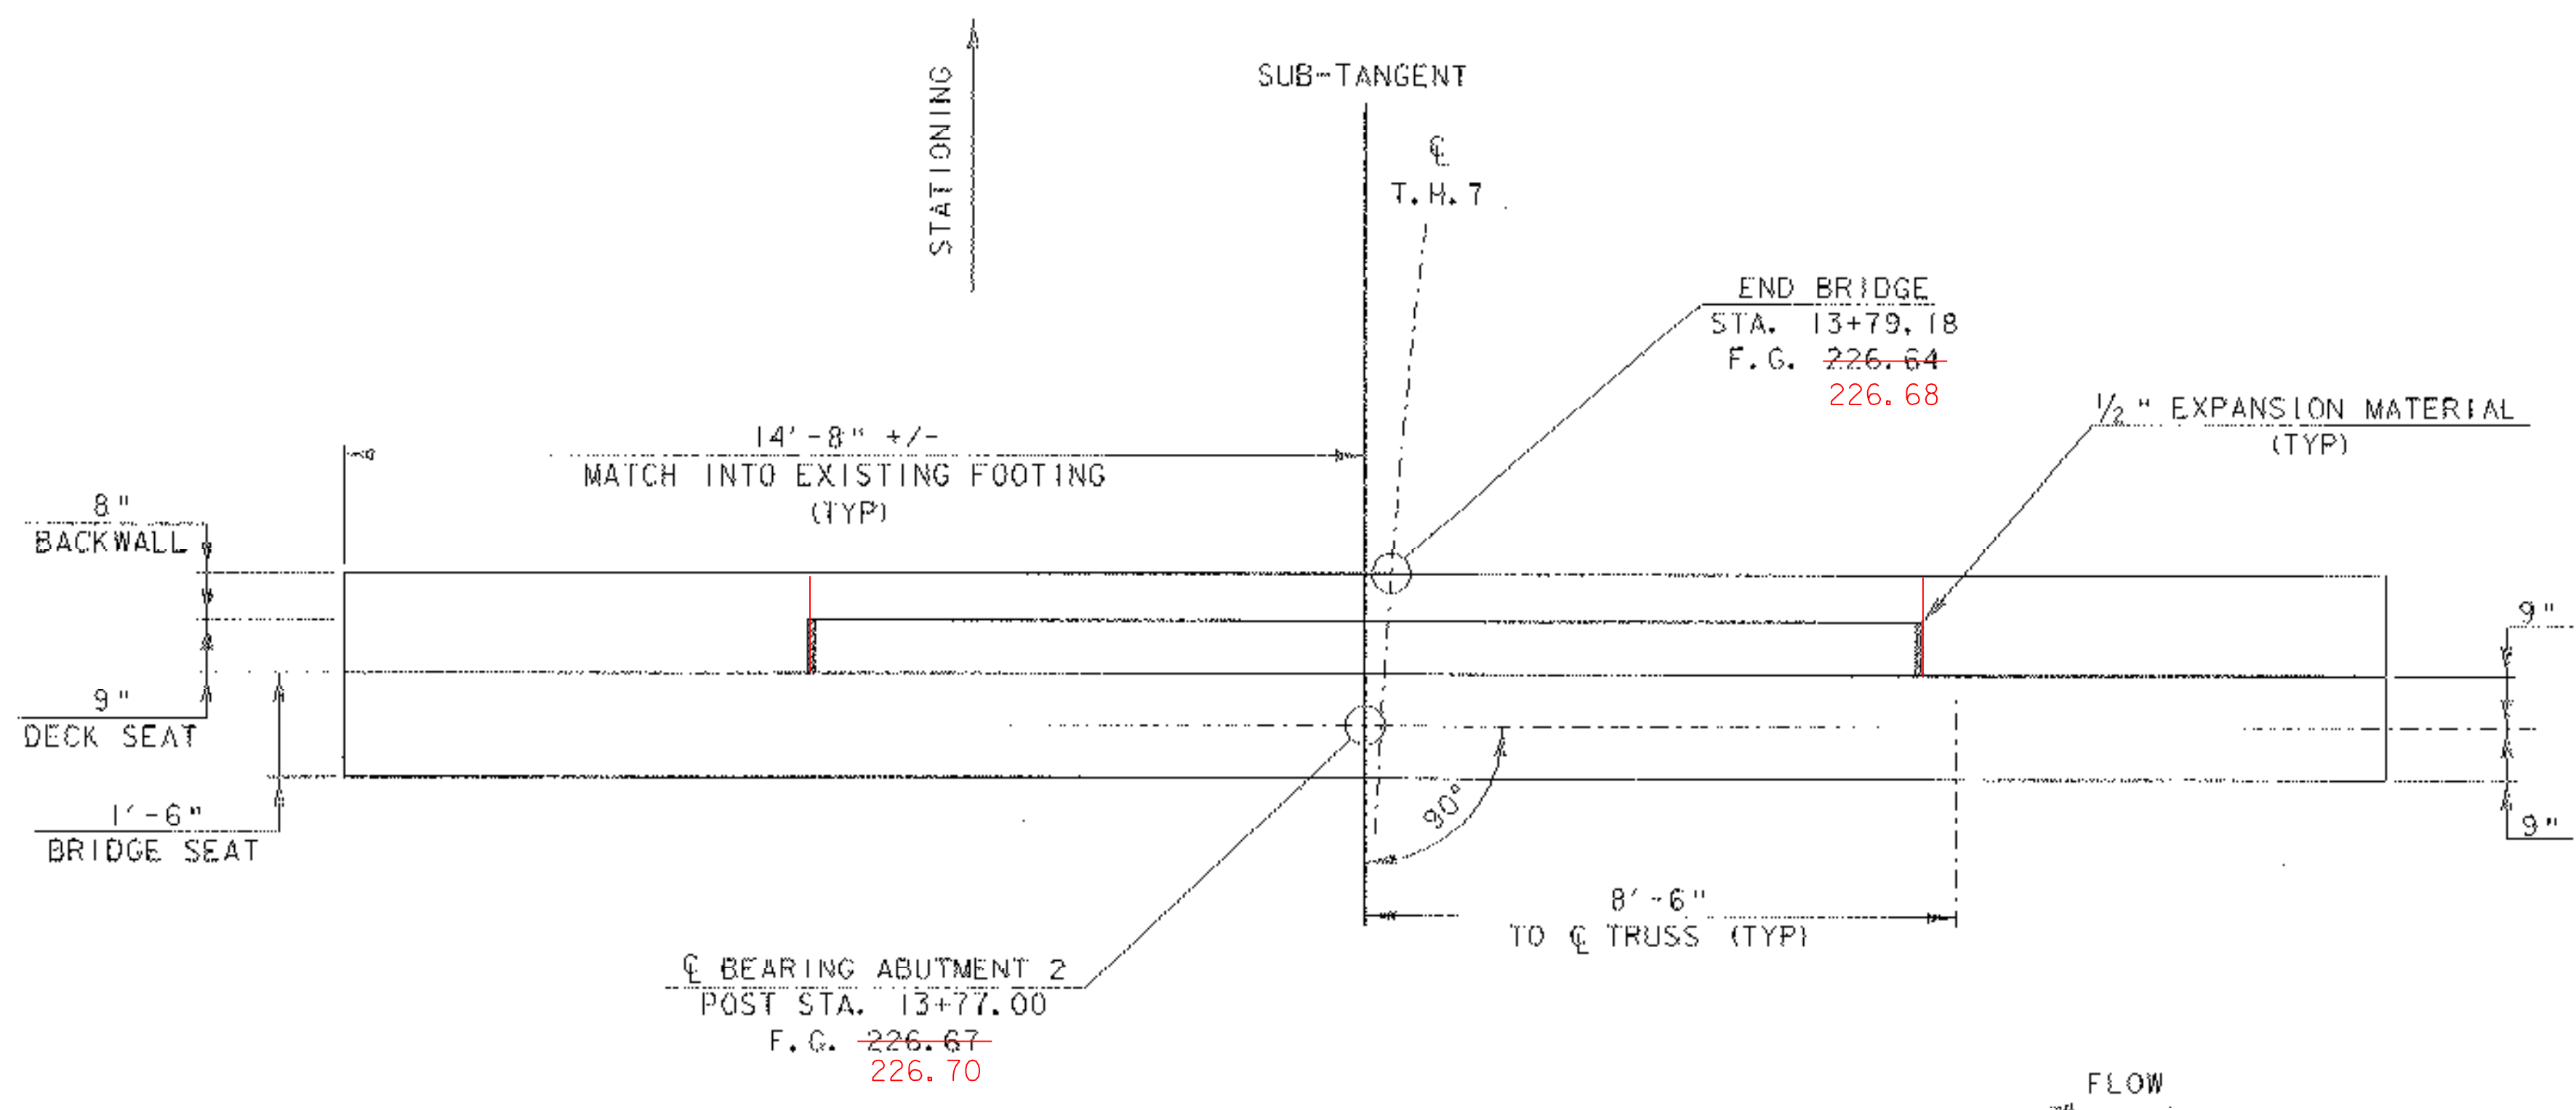


**ABUTMENT 2 PLAN**

SCALE 1/2" = 1'-0"  
 0 1 2

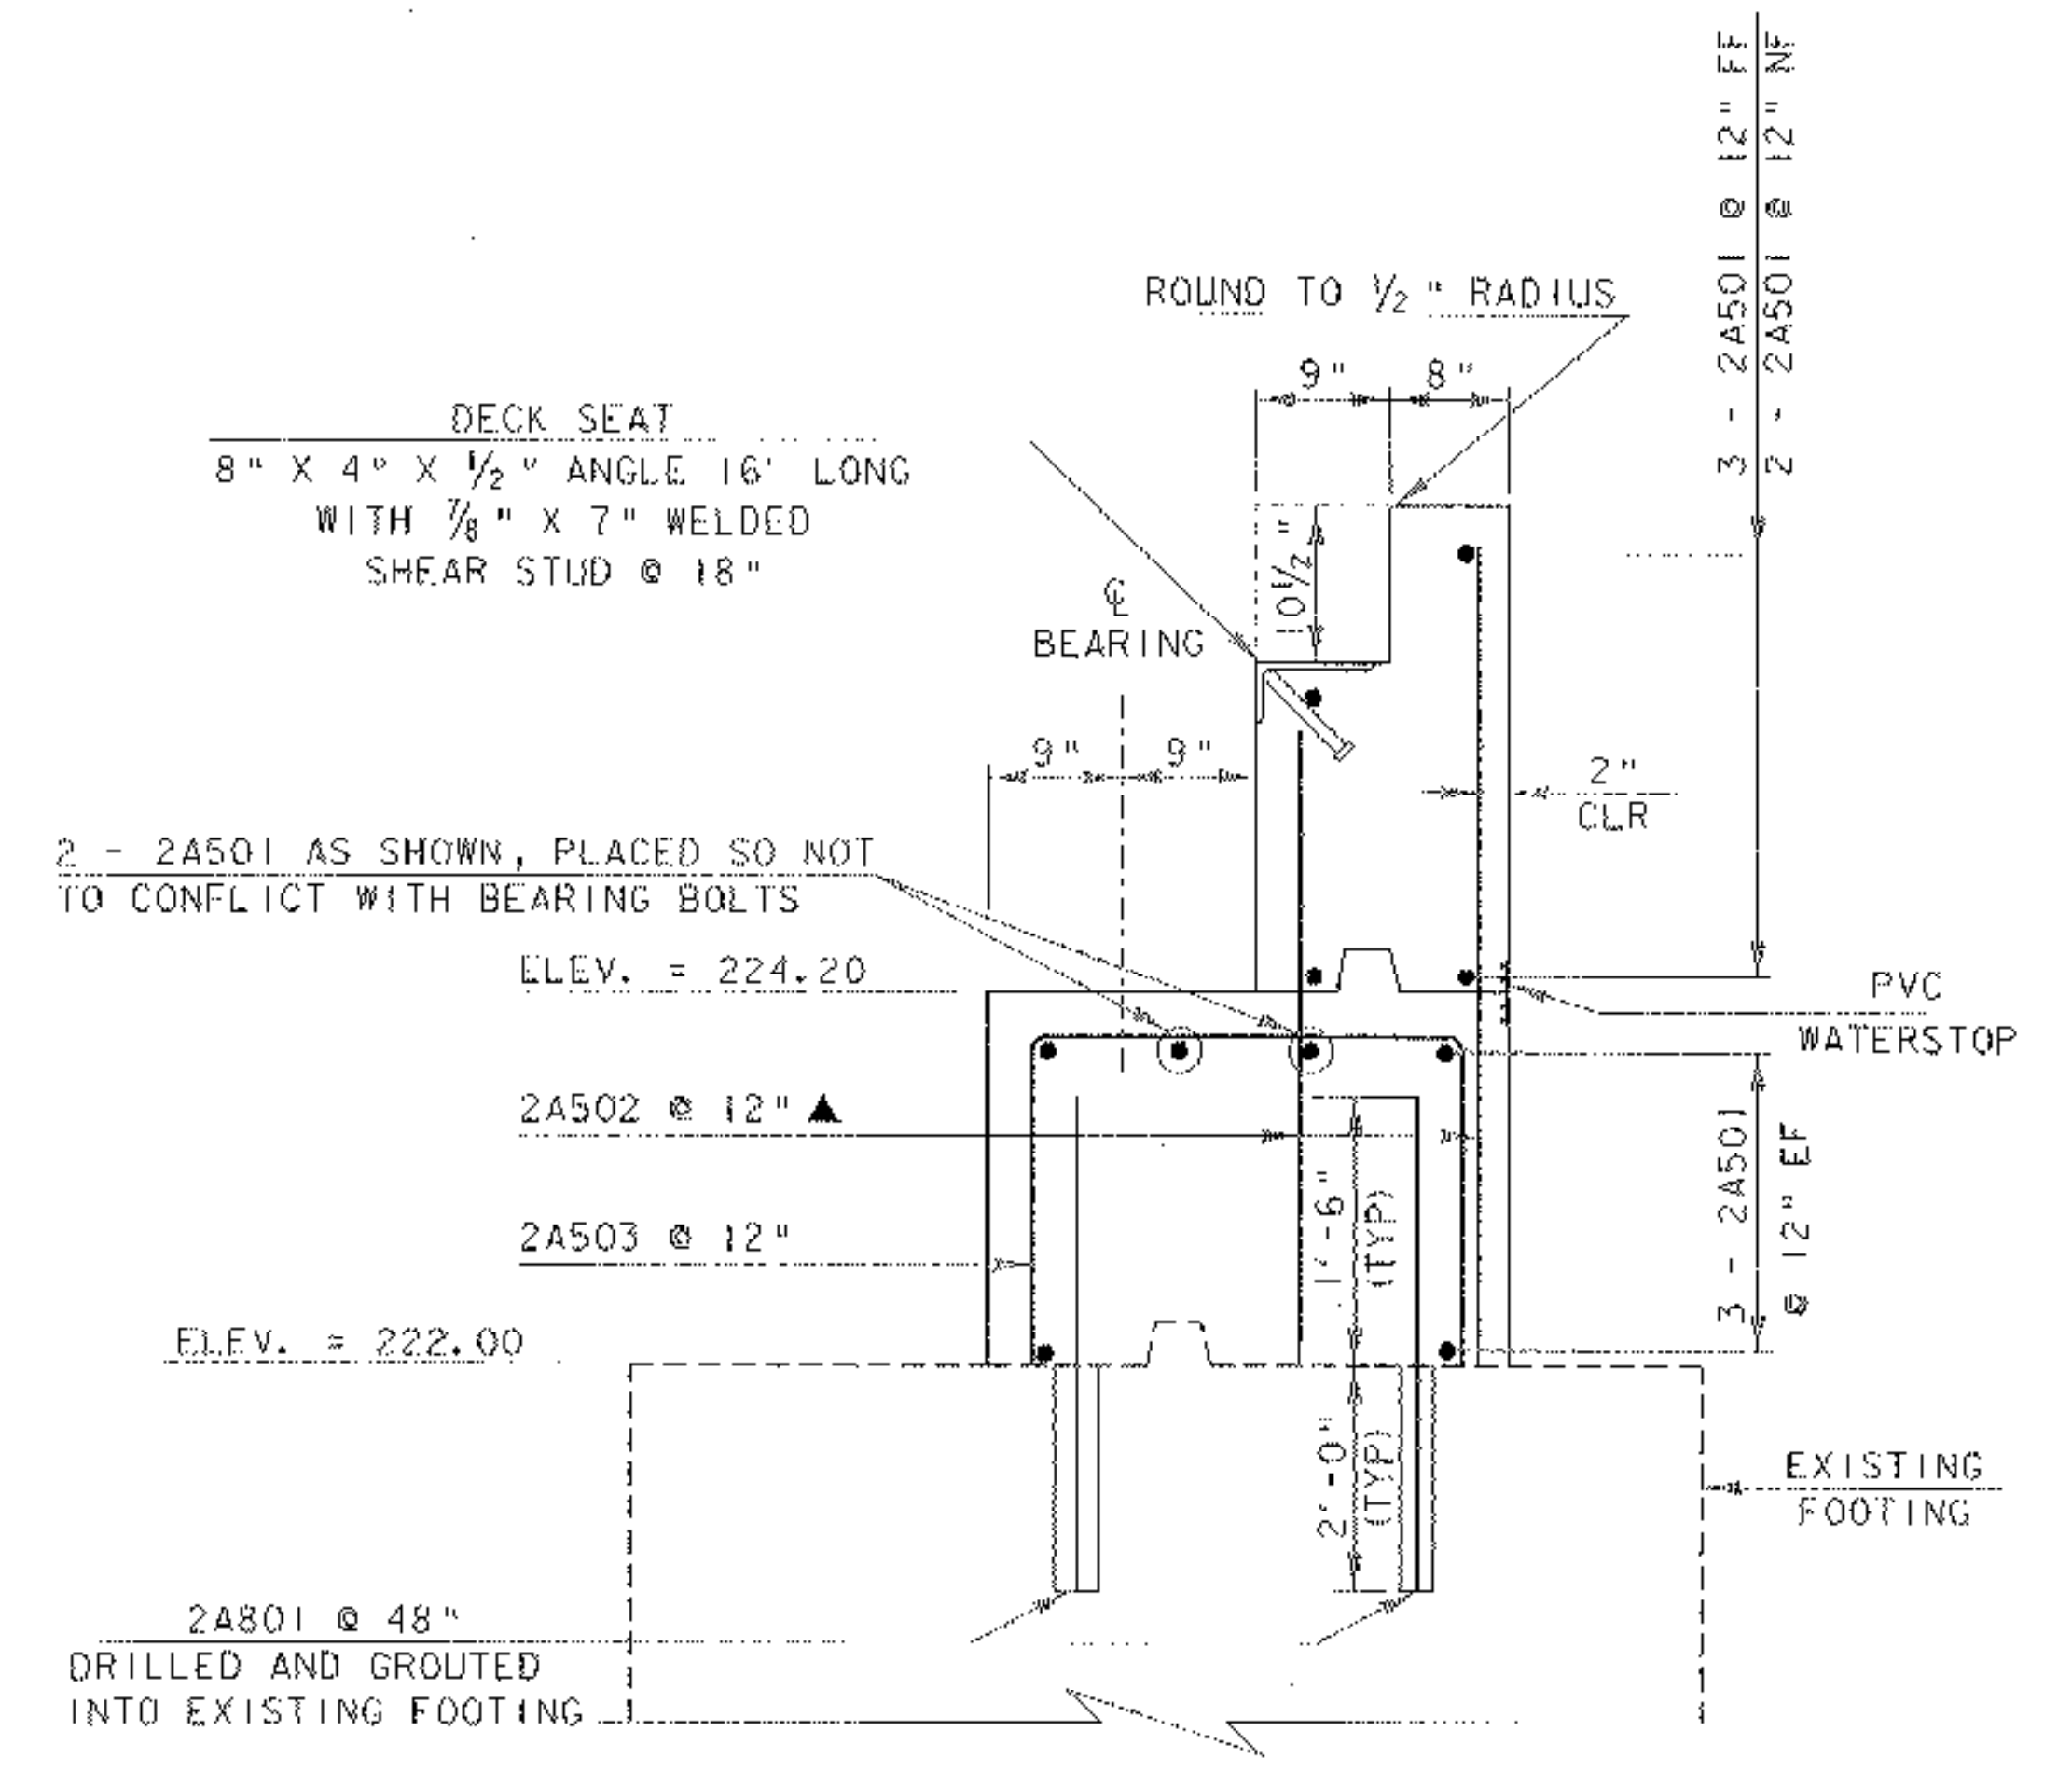

**ABUTMENT 2 TYPICAL SECTION**

SCALE 1" = 1'-0"  
 0 1 2

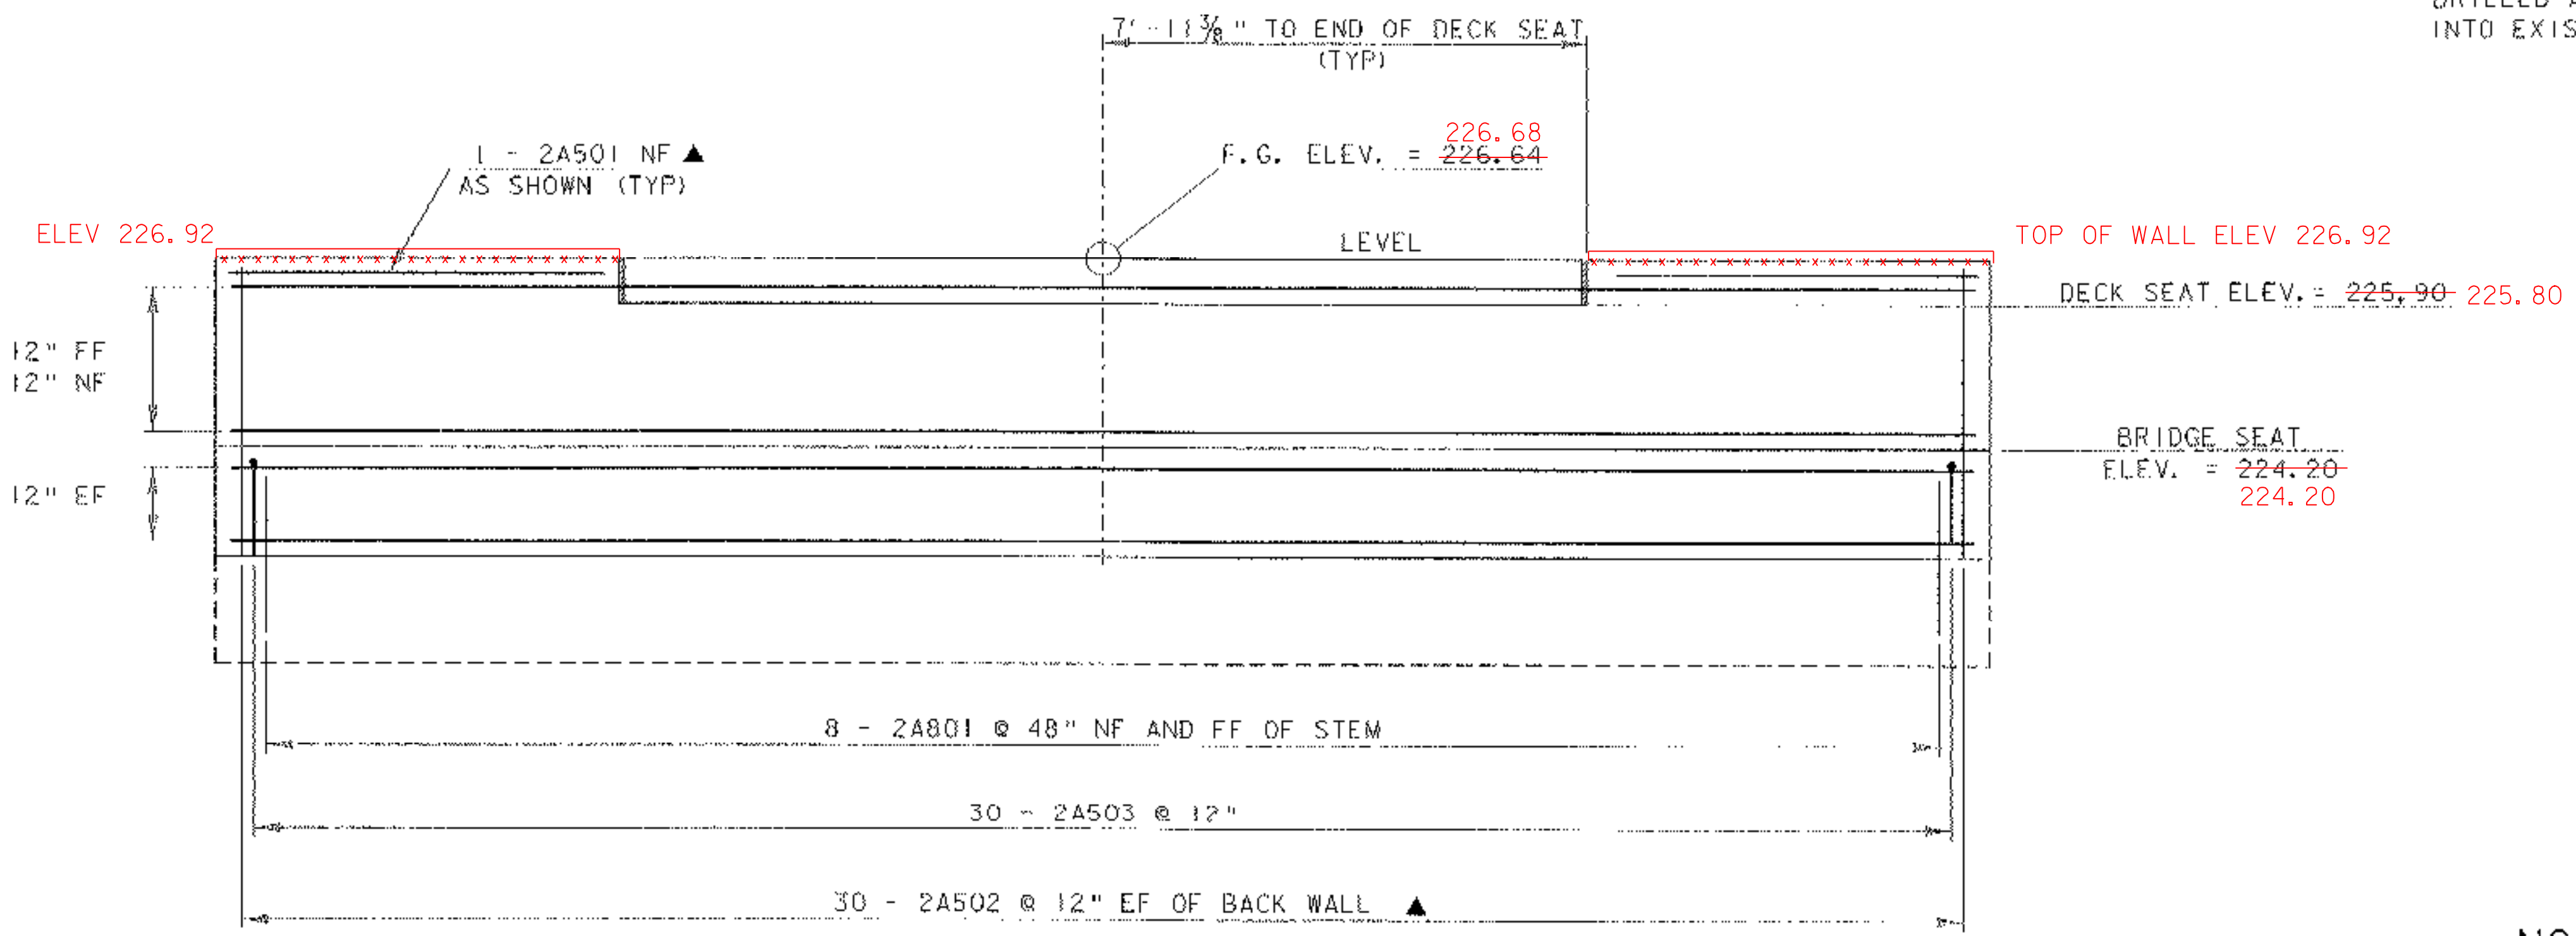

**ABUTMENT 2 ELEVATION**

SCALE 1/2" = 1'-0"  
 0 1 2


**NOTES:**

1. TRUSS SHALL BE PLACED ON NEW BEARINGS IN ITS FINAL POSITION BEFORE BACKWALL IS POURED.
2. REMOVE EXISTING ABUTMENT DOWN TO TOP OF THE EXISTING FOOTING AS SHOWN.


**NOTE:**

NF = NEAR FACE  
 FF = FAR FACE  
 EF = EACH FACE  
 ▲ = CUT TO FIT IN FIELD  
 3" CLR. UNLESS OTHERWISE SPECIFIED ON THE PLANS.


PROJECT: <b>NEW HAVEN-WEYBRIDGE</b>	PROJECT NO. # <b>BHQ-BTN 2005 (1)</b>
DESIGN FILE NAME: 89J081/structures/sj081sub.dgn	PLOT DATE: 28-FEB-2007
IPARM FILE NAME: sj081ab2.i	DRAWN BY: R. S. YOUNG
DESIGNED BY: R. S. YOUNG	CHECKED BY: R. S. YOUNG
SQUAD LEADER: C. P. WILLIAMS	SHEET: 27 OF 53
ABUTMENT 2 DETAILS	

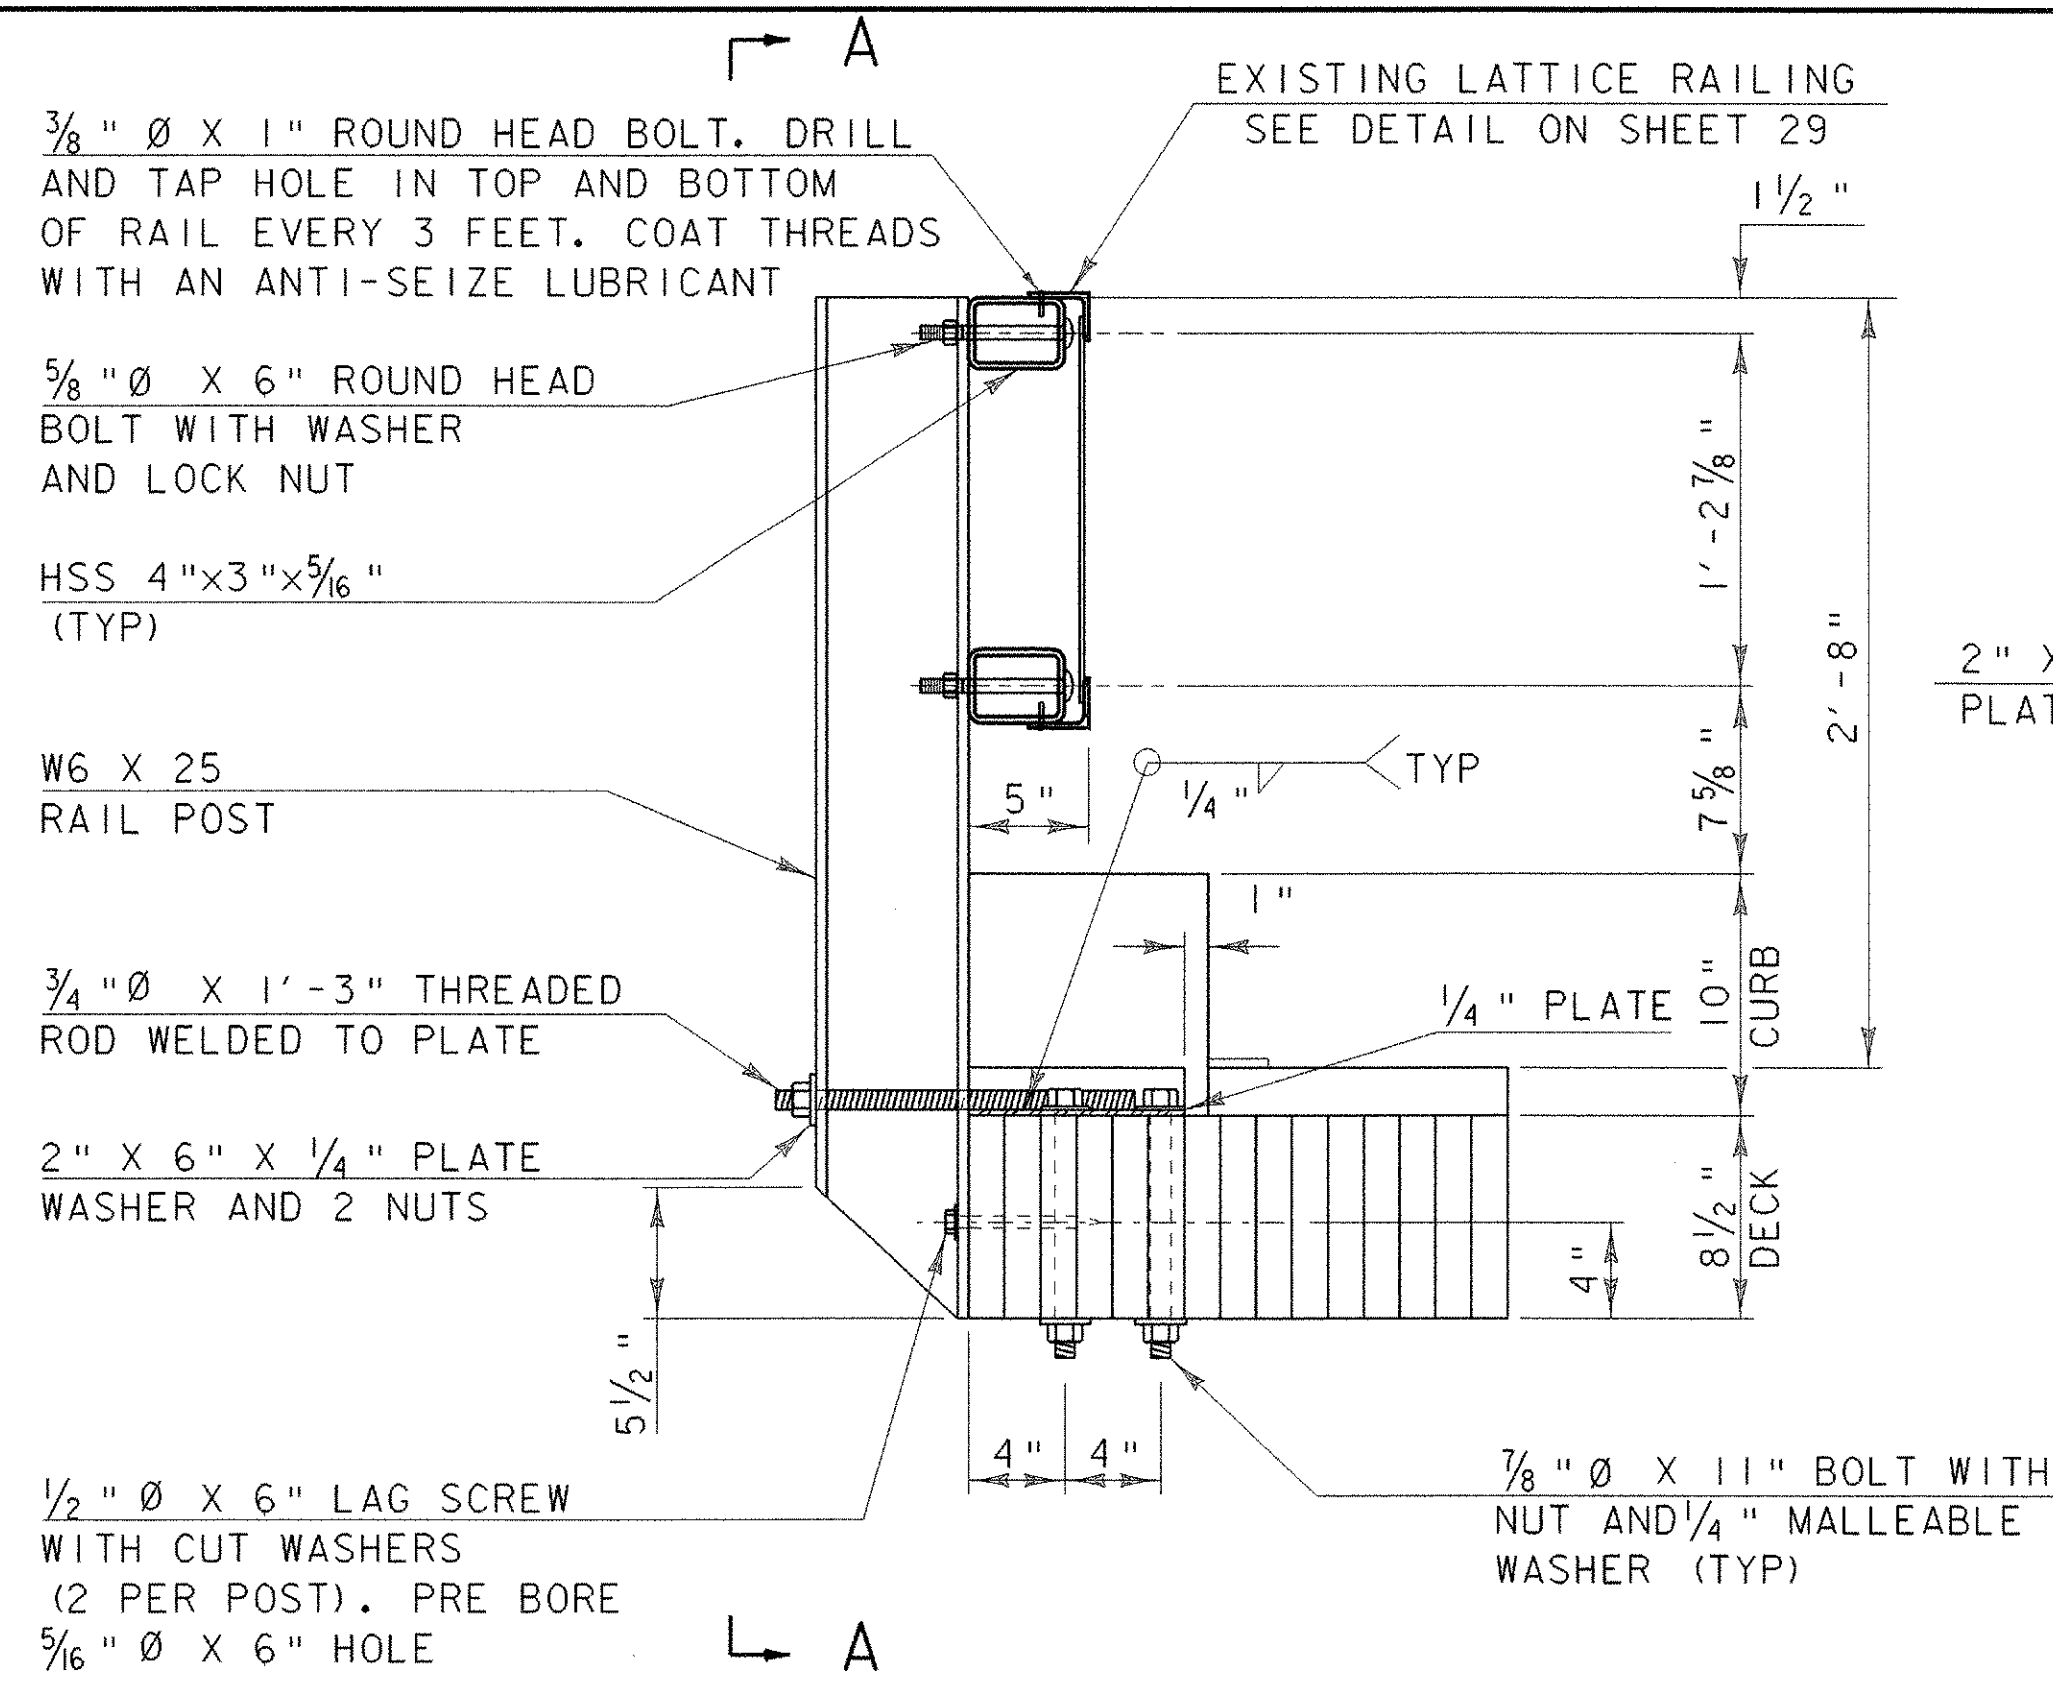


**RAILING TYPICAL SECTION**  
SCALE 1 1/2" = 1'-0"

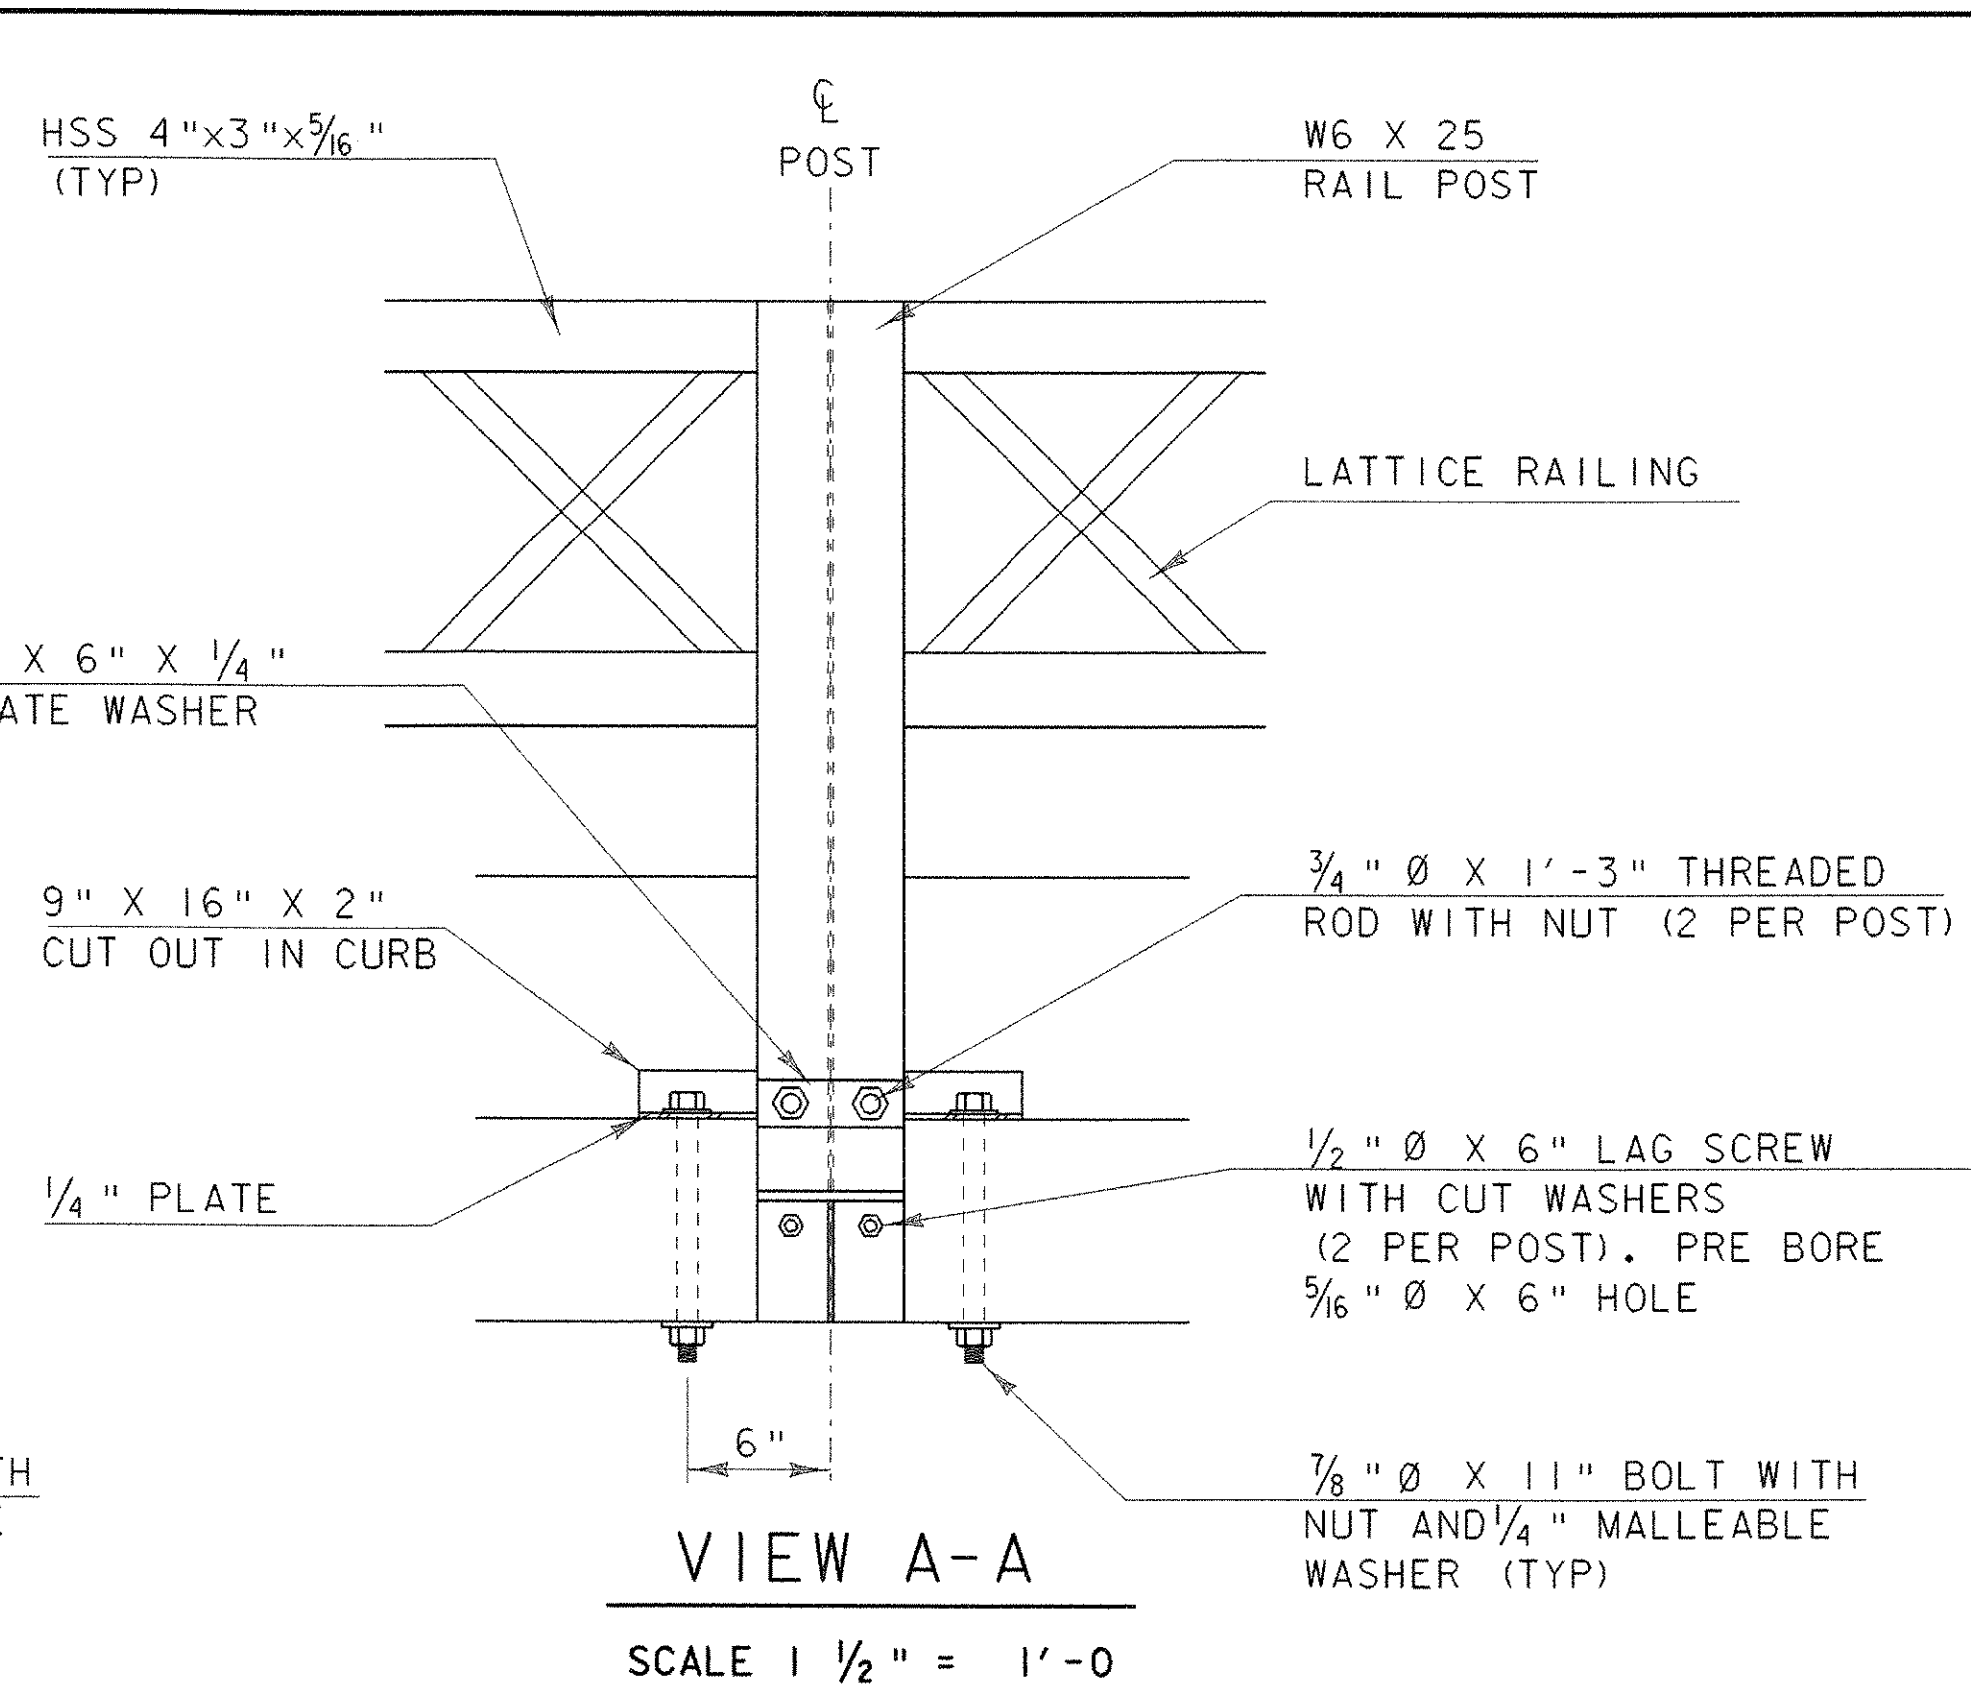

**VIEW A-A**  
SCALE 1 1/2" = 1'-0"

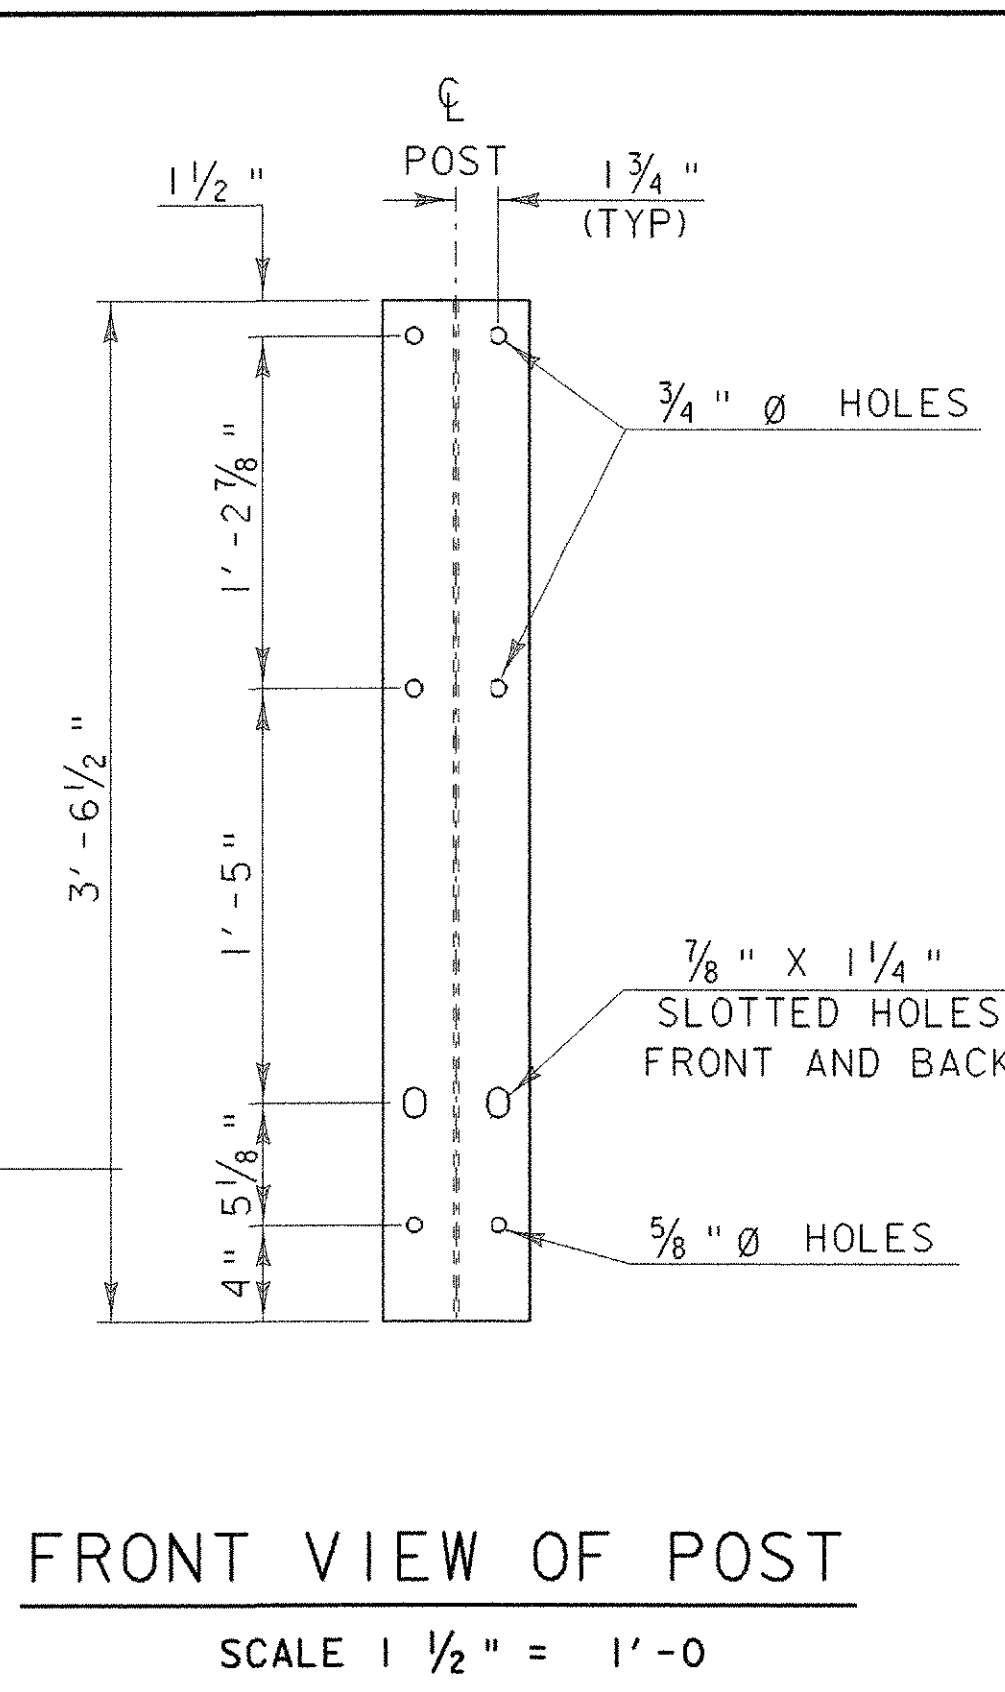


**FRONT VIEW OF POST**  
SCALE 1 1/2" = 1'-0"

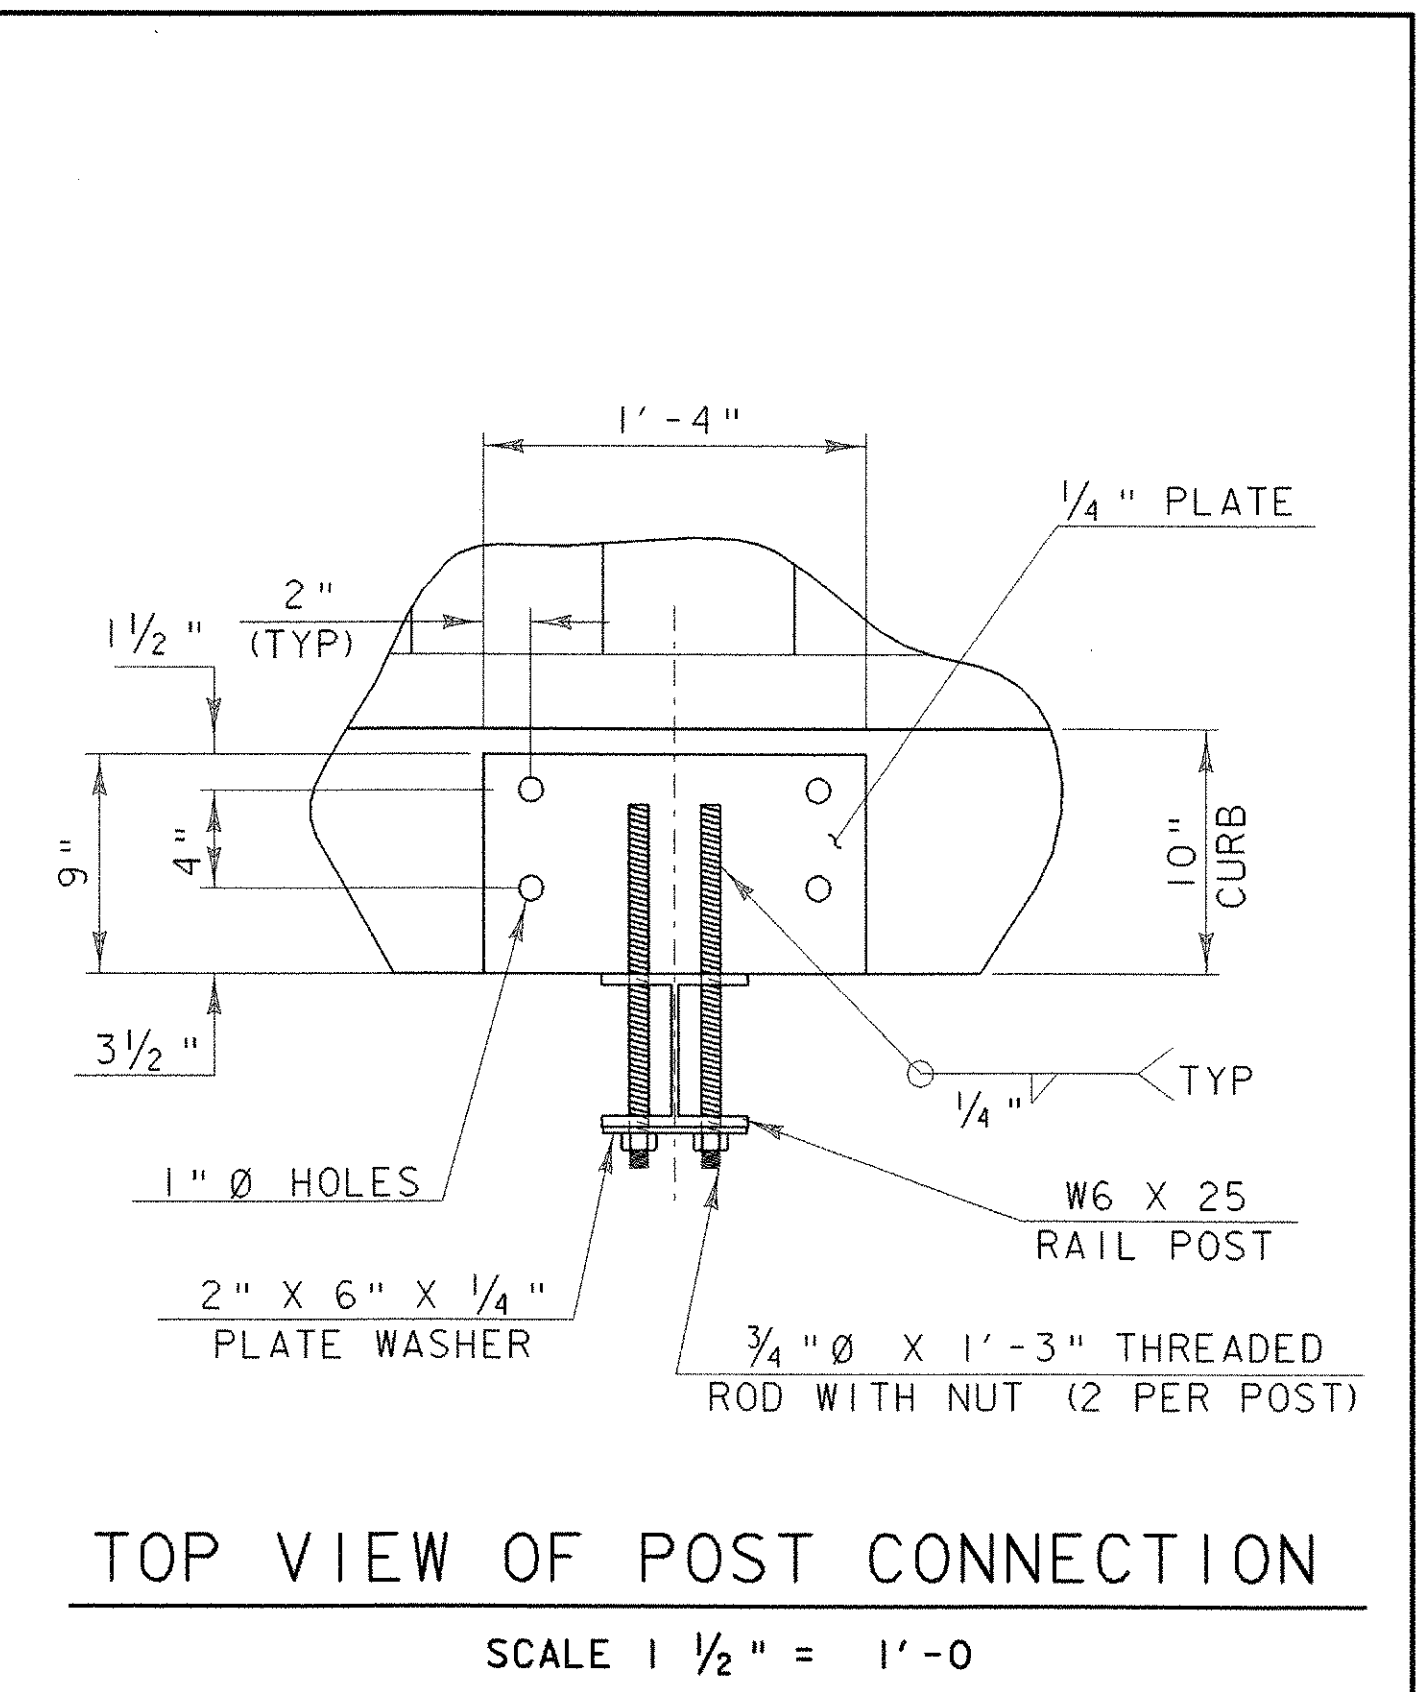


**TOP VIEW OF POST CONNECTION**  
SCALE 1 1/2" = 1'-0"

**RAILING NOTES :**


1. STEEL PLATES AND POSTS SHALL COMPLY WITH THE REQUIREMENTS OF ASTM A709, GRADE 50 STEEL. BOX BEAM RAIL SHALL BE ASTM A 500, GRADE B.
2. BOLTS AND LAG SCREWS SHALL COMPLY WITH THE REQUIREMENTS OF ASTM A307, EXCEPT FOR ROUND HEADED BOLTS IN RAILING SHALL BE 5/8" Ø ASTM A325. THREADED RODS SHALL BE ASTM A572, GRADE 50.
3. ALL HARDWARE SHALL BE GALVANIZED IN ACCORDANCE WITH AASHTO M232. BOX BEAM RAILING AND POSTS SHALL BE GALVANIZED IN ACCORDANCE WITH AASHTO M111.
4. HOLES IN RAILING MAY BE FIELD DRILLED.
5. NUTS FOR ASTM A307 AND A325 BOLTS SHALL COMPLY WITH ASTM A563.
6. BOX BEAM RAIL MAY ALTERNATIVELY BE ATTACHED USING 5/8" Ø AASHTO M164 (TYPE I) OR 3/4" Ø ASTM F568, CLASS 4.6 ROUND HEAD BOLTS INSERTED THROUGH THE FACE OF THE RAIL. HOLES IN POSTS SHALL BE 1/16" LARGER THAN THE BOLT SIZE.
7. ALL EXPOSED CUT OR SHEARED EDGES SHALL BE ROUNDED TO A 1/16" RADIUS AND BE FREE OF BURRS.
8. RAIL POSTS SHALL BE NORMAL TO GRADE
9. BOX BEAM RAIL EXPANSION JOINTS SHALL BE PROVIDED OVER THE SUPERSTRUCTURE EXPANSION JOINT.
10. THE HOLLOW STRUCTURAL STEEL, POSTS, PLATES, RODS, LAG SCREWS, AND BOLTS, SHALL BE INCLUDED UNDER ITEM 525.31 "BRIDGE RAILING - GALVANIZED 2 RAIL BOX BEAM."
11. DRILLING AND TAPPING HOLES FOR LATTICE RAILING ATTACHMENT SHALL BE INCLUDED UNDER ITEM 525.31 "BRIDGE RAILING, GALVANIZED 2 RAIL BOX BEAM".
12. RAIL SPACING SHALL BE AS SHOWN ON SHEET 11

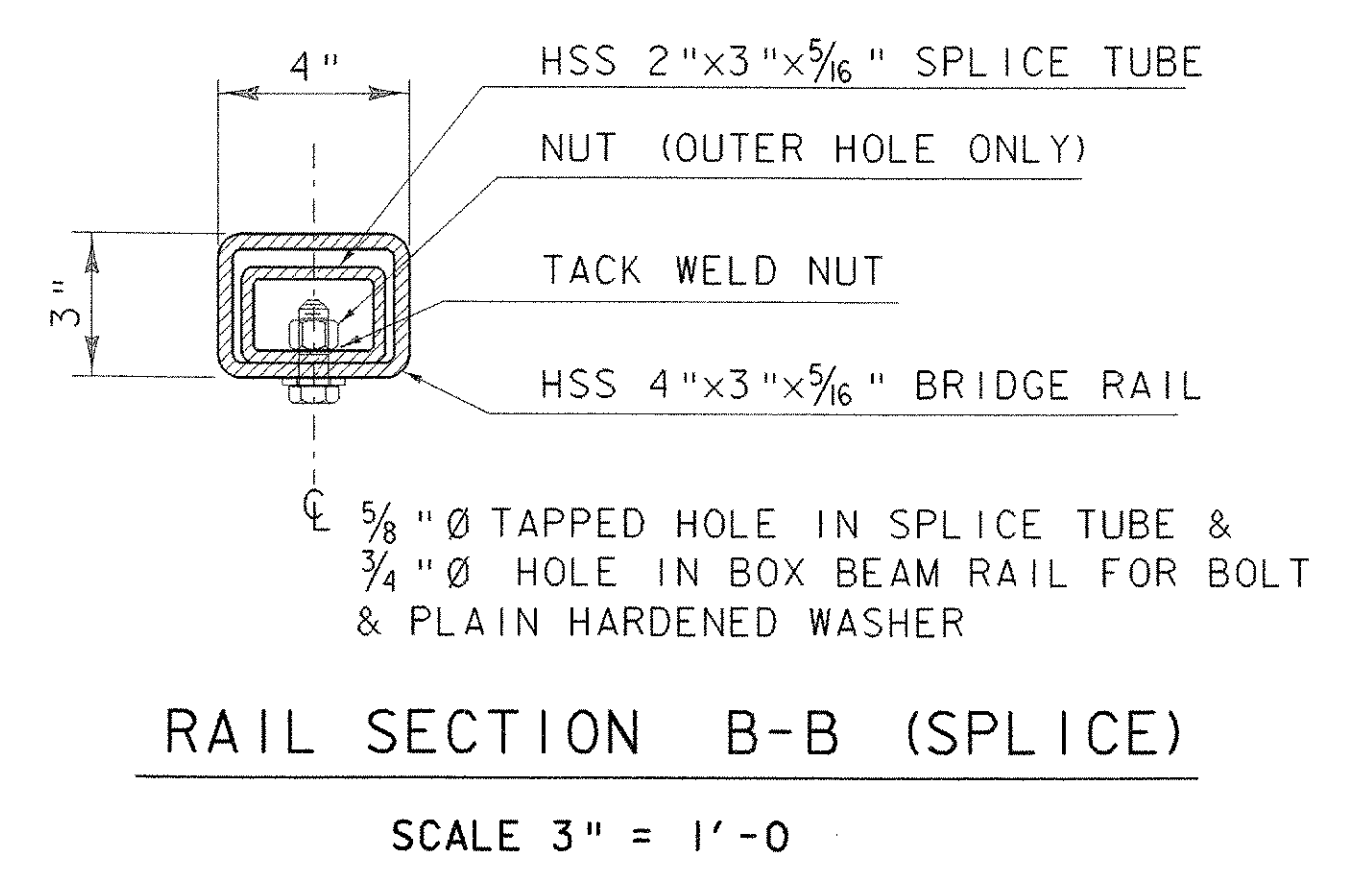

**RAIL SECTION B-B (SPlice)**  
SCALE 3" = 1'-0"

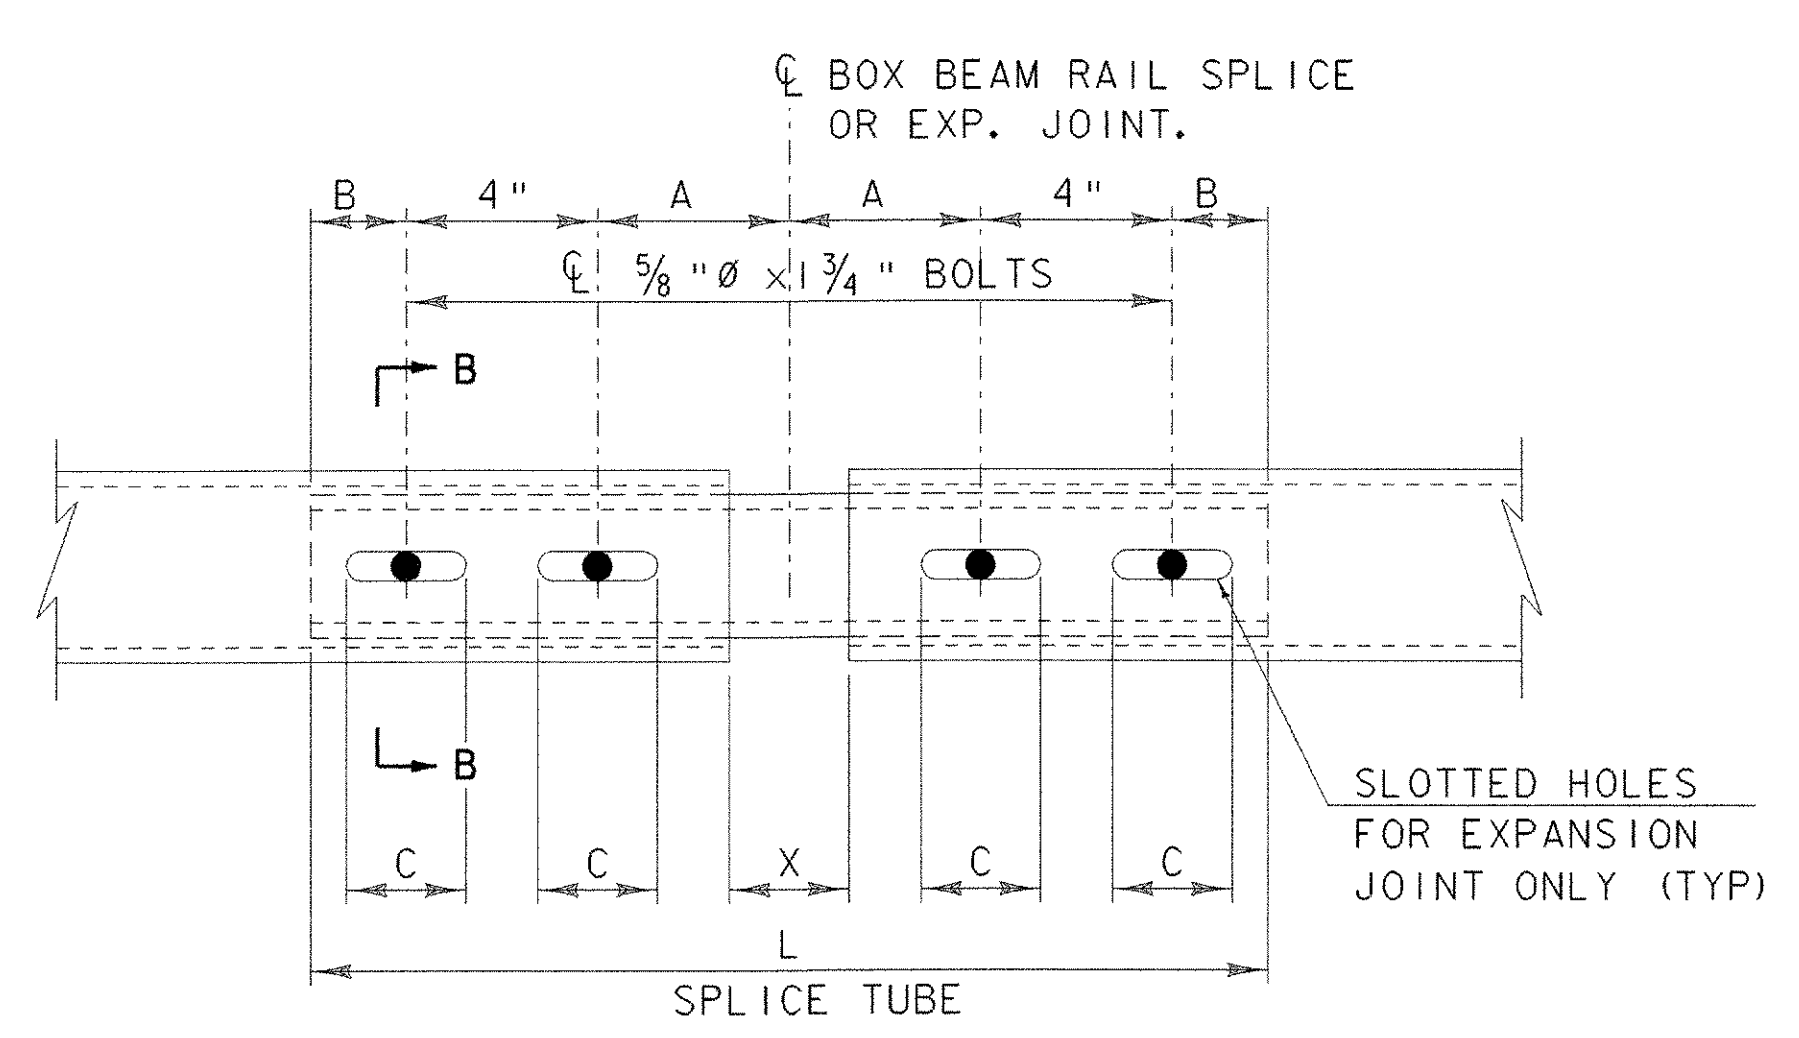


**BOX BEAM RAIL SPlice JOINT DETAIL**  
SCALE 3" = 1'-0"

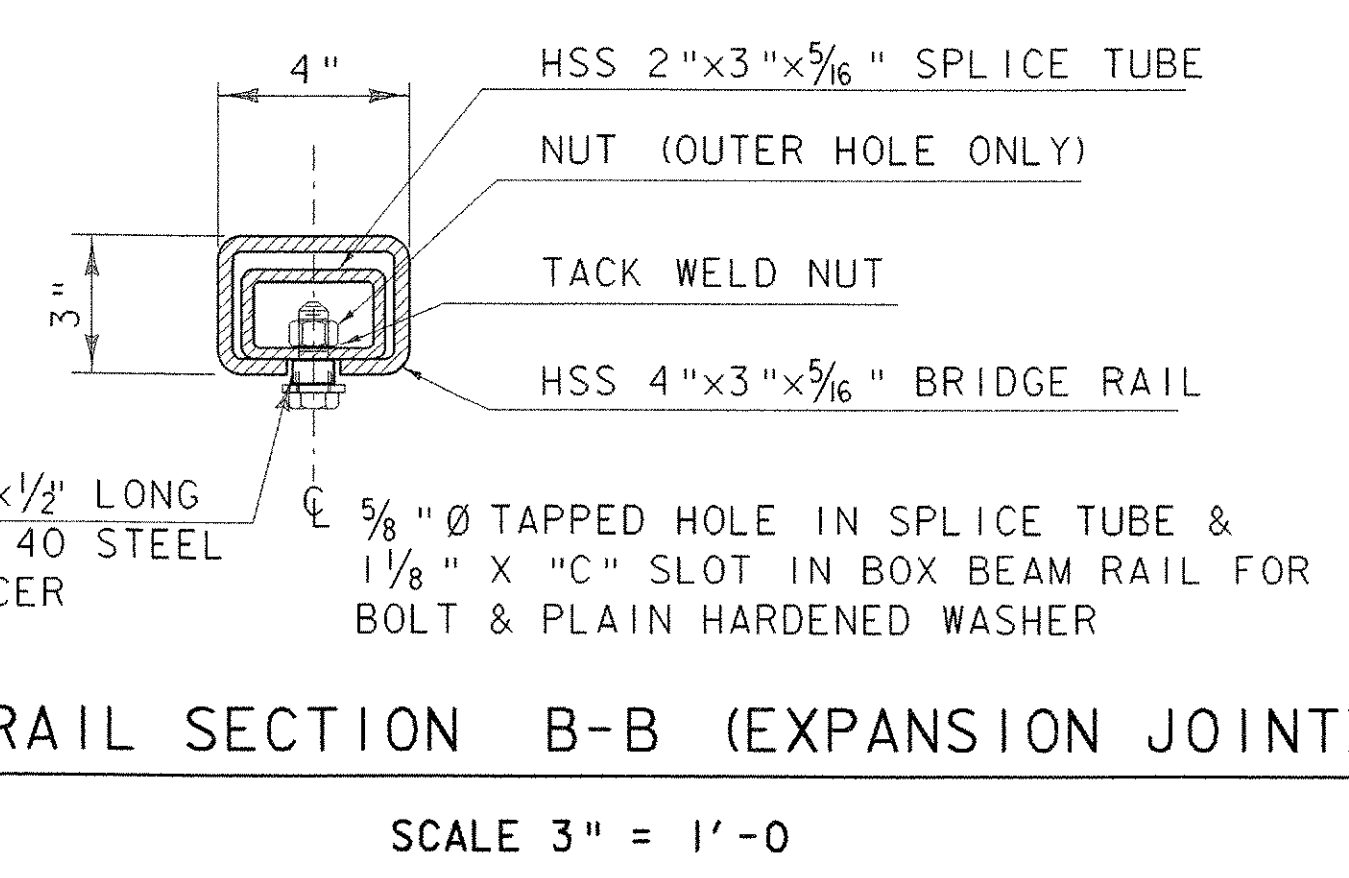

**RAIL SECTION B-B (EXPANSION JOINT)**  
SCALE 3" = 1'-0"


SPlice & EXPANSION JOINT TABLE					
T	A	T	C	L	X
SPlice	4"	2"	--	20"	3/4"
≤	4"	2"	2 1/2"	20"	2 1/2"

T = TOTAL REQUIRED MOVEMENT

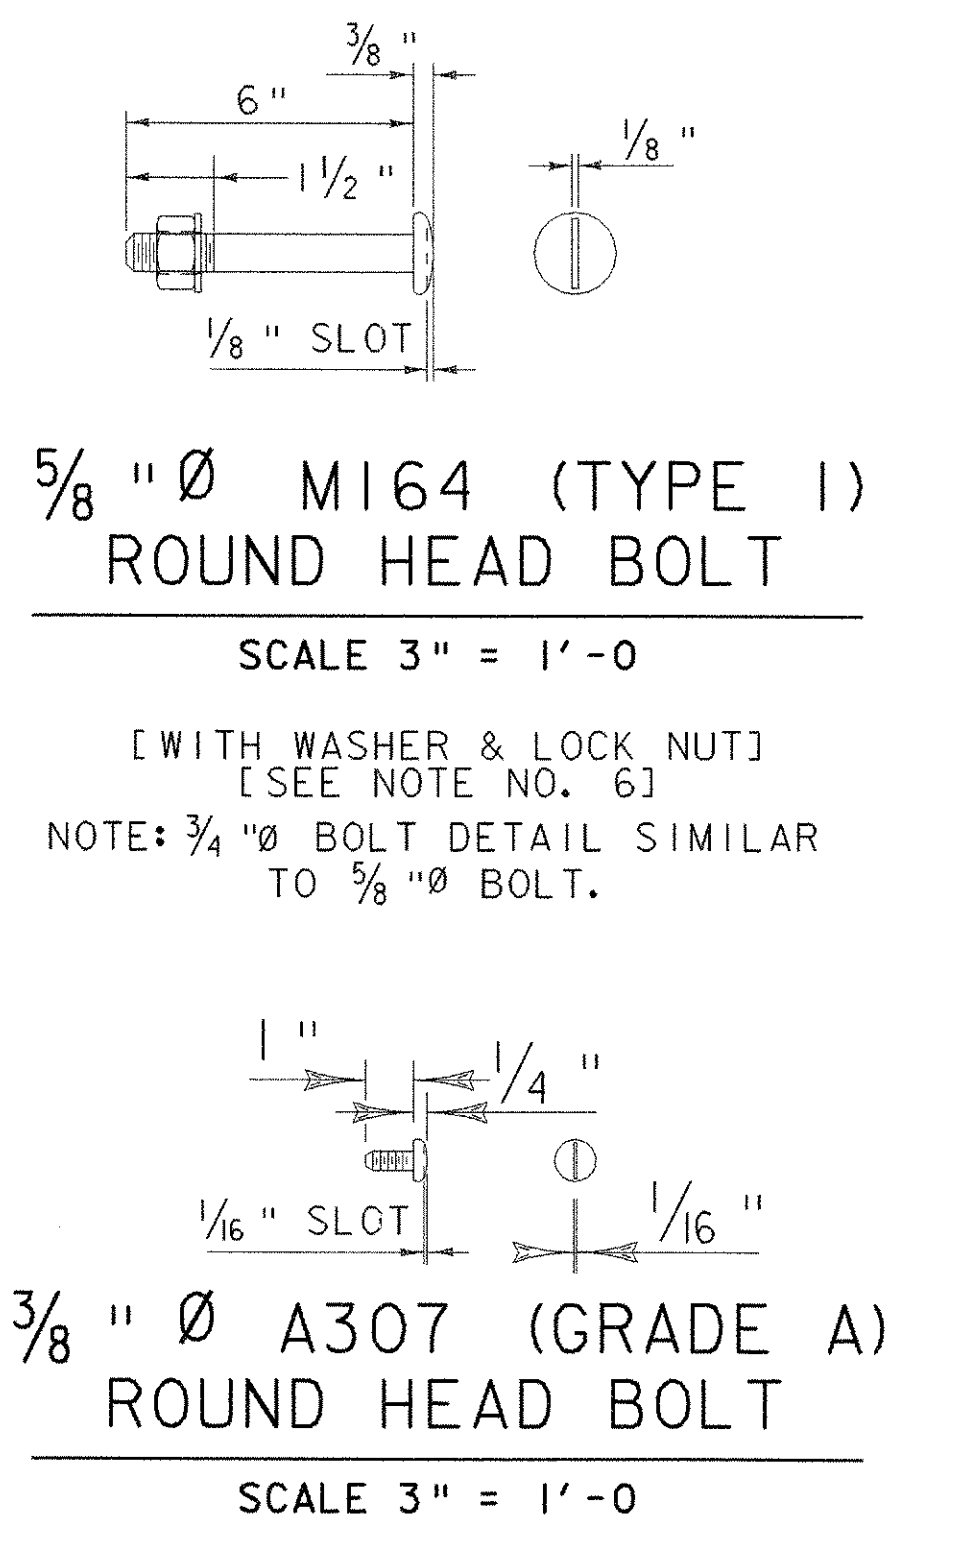


**5/8" Ø M164 (TYPE I) ROUND HEAD BOLT**  
SCALE 3" = 1'-0"


[WITH WASHER & LOCK NUT]  
[SEE NOTE NO. 6]  
NOTE: 3/4" Ø BOLT DETAIL SIMILAR TO 5/8" Ø BOLT.

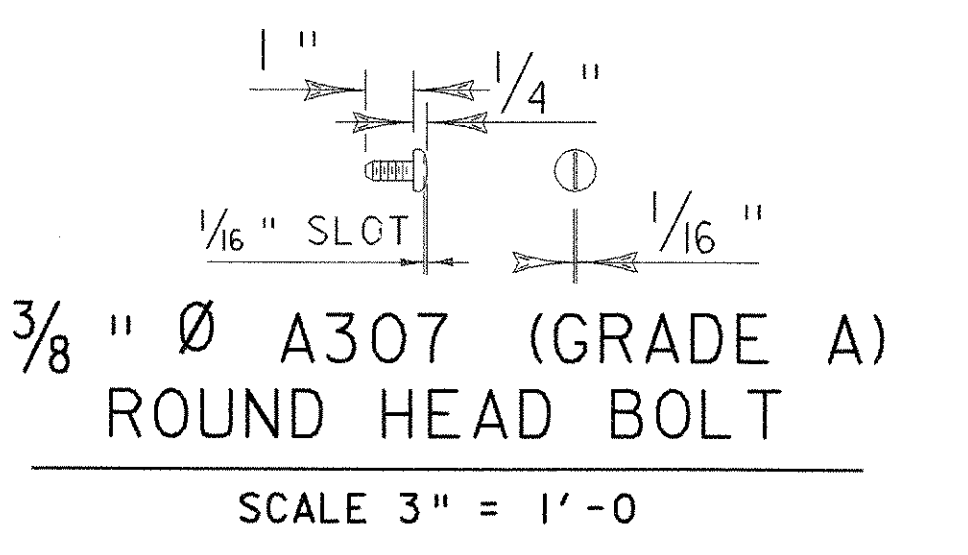

**3/8" Ø A307 (GRADE A) ROUND HEAD BOLT**  
SCALE 3" = 1'-0"

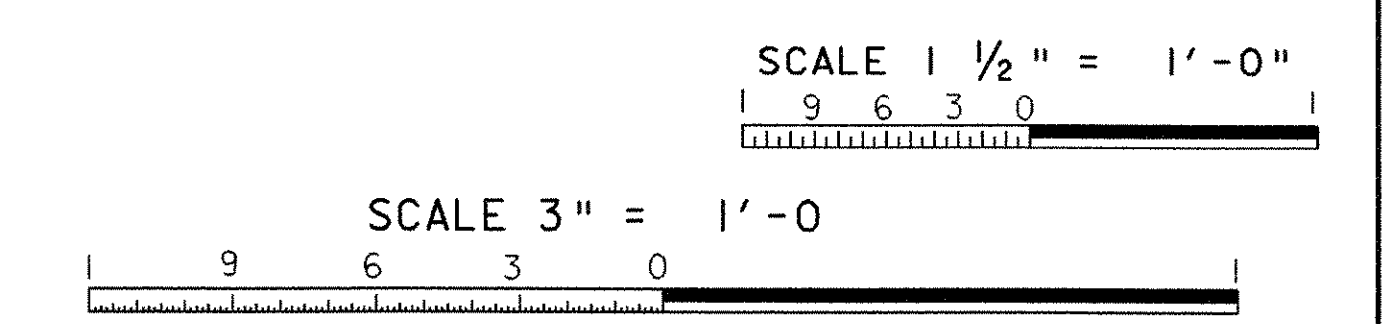


PROJECT: <b>NEW HAVEN - WEYBRIDGE</b>	PROJECT NO. : <b>BHO-BTN 2005 (1)</b>
DESIGN FILE NAME: 89j081/structures/sj081rail.dgn	PLOT DATE: 28-FEB-2007
IPARM FILE NAME: sj081rail.i	DRAWN BY: R.S. YOUNG
DESIGNED BY: R.S. YOUNG	CHECKED BY: R.S. YOUNG
SQUAD LEADER: C.P. WILLIAMS	SHEET: 28 OF 53
BRIDGE RAIL DETAILS	

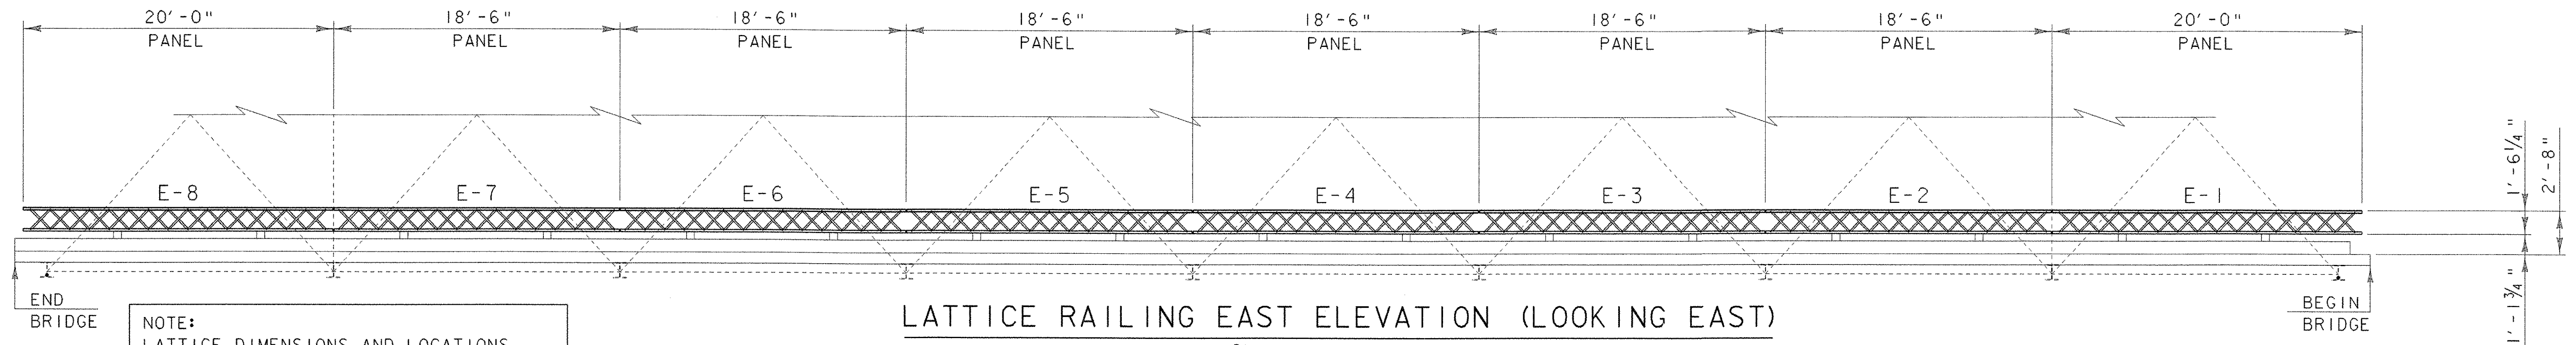

LATTICE RAILING EAST ELEVATION (LOOKING EAST)

SCALE 3/16" = 1'-0" (UP STREAM)

NOTE:  
LATTICE DIMENSIONS AND LOCATIONS  
ARE TYPICAL FOR BOTH SIDES OF BRIDGE

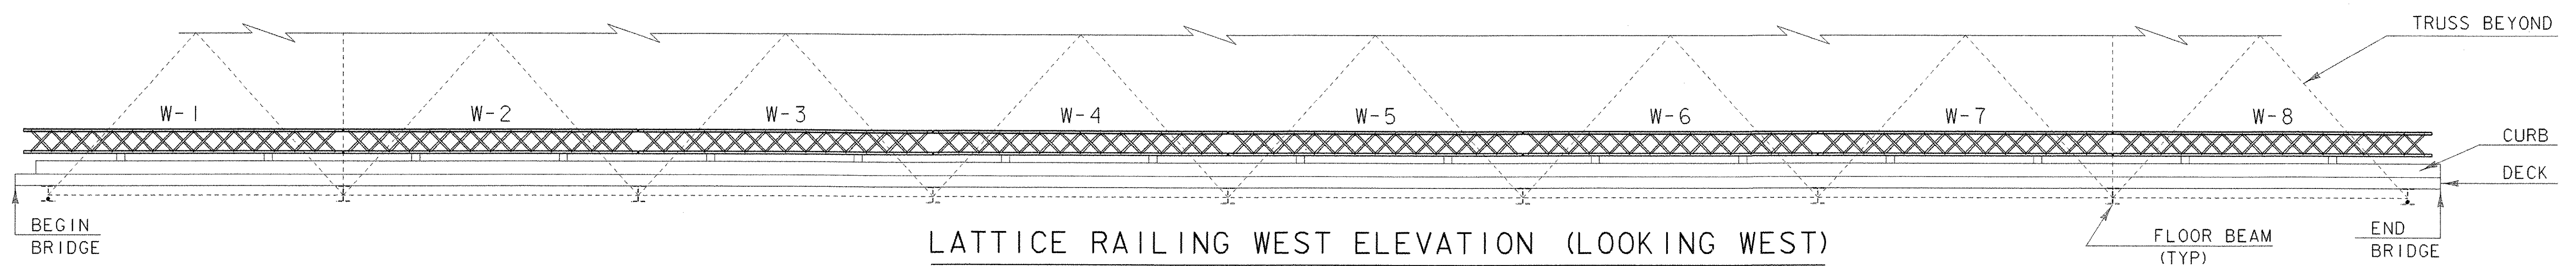


LATTICE RAILING WEST ELEVATION (LOOKING WEST)

SCALE 3/16" = 1'-0" (DOWN STREAM)

LATTICE RAILING NOTES:


1. THE EXISTING LATTICE RAILING SHALL BE REMOVED FROM THE TRUSS, AND EITHER REPLACED IN KIND OR STRAIGHTENED ACCORDING TO THE LATTICE RAILING SCHEDULE. THE NEW PANELS SHALL BE ASSEMBLED WITH 3/8" DIA. GALVANIZED ROUND HEAD BOLTS. STRAIGHTENING SHALL BE IN ACCORDANCE WITH STANDARD SPECIFICATION 506.21.
2. FABRICATION OF REPLACEMENT PANELS, STRAIGHTENING OF EXISTING PANELS, AND ATTACHMENT TO THE 2 RAIL GALVANIZED BOX BEAM SHALL BE PAID FOR UNDER THE ITEM 506.60 "STRUCTURAL STEEL". SEE ATTACHMENT DETAILS ON SHEET 28.
3. EXISTING POSTS SHALL NOT BE REPLACED.

LATTICE RAILING SCHEDULE	
PANEL #	ACTION REQUIRED
E-1	STRAIGHTEN/REUSE
E-2	STRAIGHTEN/REUSE
E-3	STRAIGHTEN/REUSE
E-4	STRAIGHTEN/REUSE
E-5	REPLACE IN KIND
E-6	REPLACE IN KIND
E-7	STRAIGHTEN/REUSE
E-8	REPLACE IN KIND
W-1	STRAIGHTEN/REUSE
W-2	STRAIGHTEN/REUSE
W-3	STRAIGHTEN/REUSE
W-4	STRAIGHTEN/REUSE
W-5	STRAIGHTEN/REUSE
W-6	STRAIGHTEN/REUSE
W-7	STRAIGHTEN/REUSE
W-8	REPLACE IN KIND

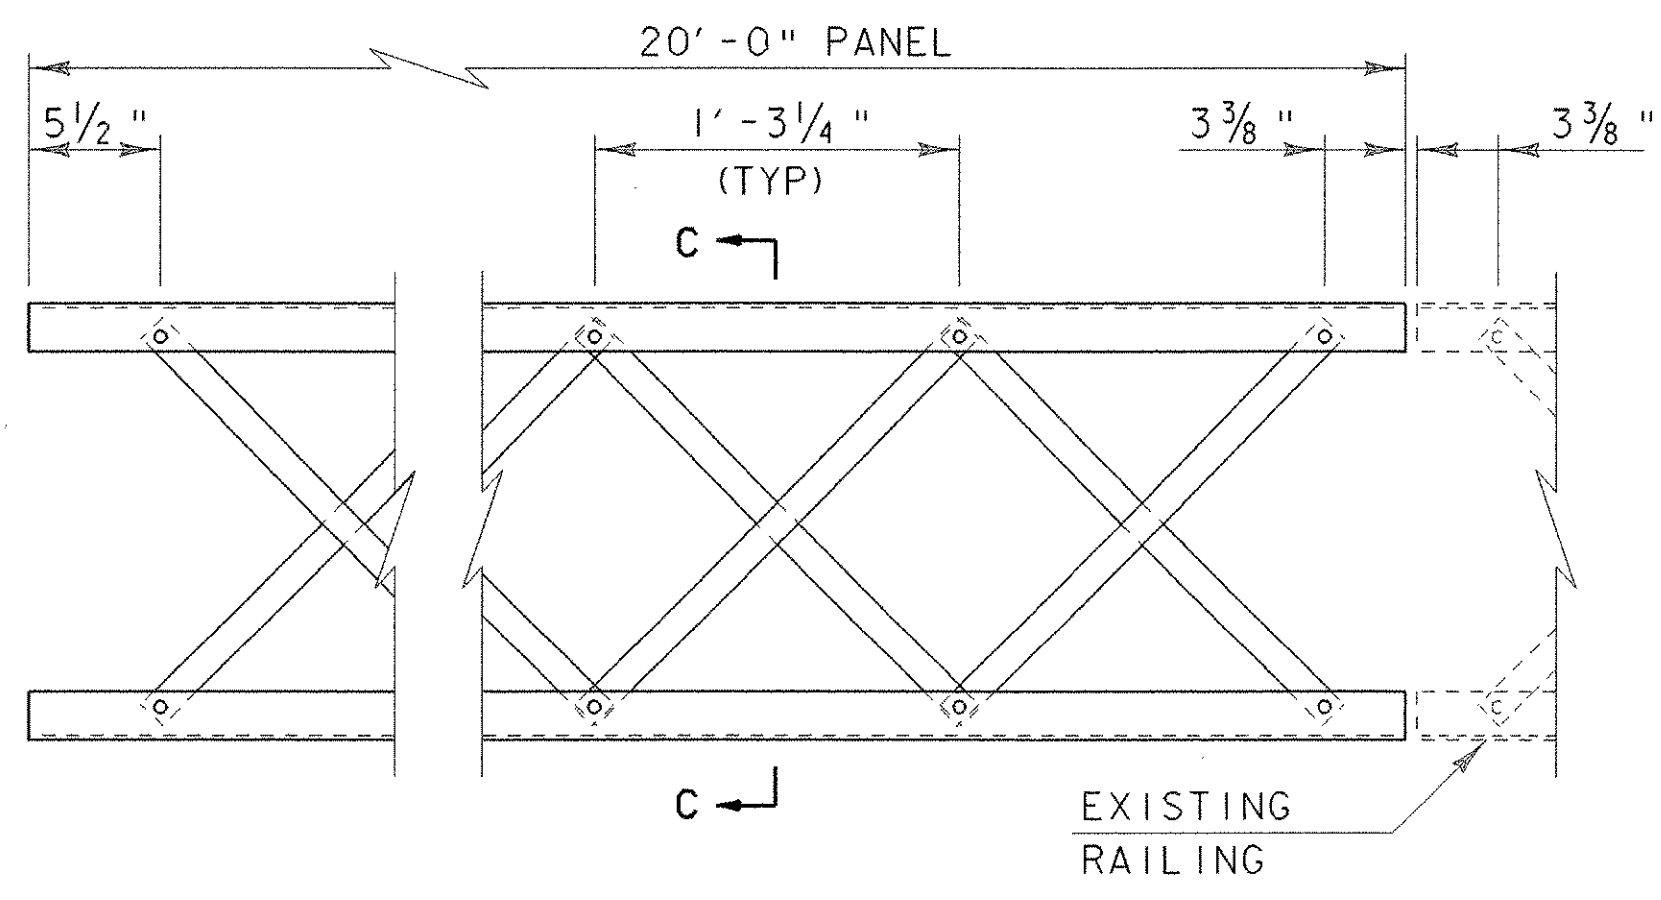


20'-0" LATTICE RAILING

SCALE 1 1/2" = 1'-0"

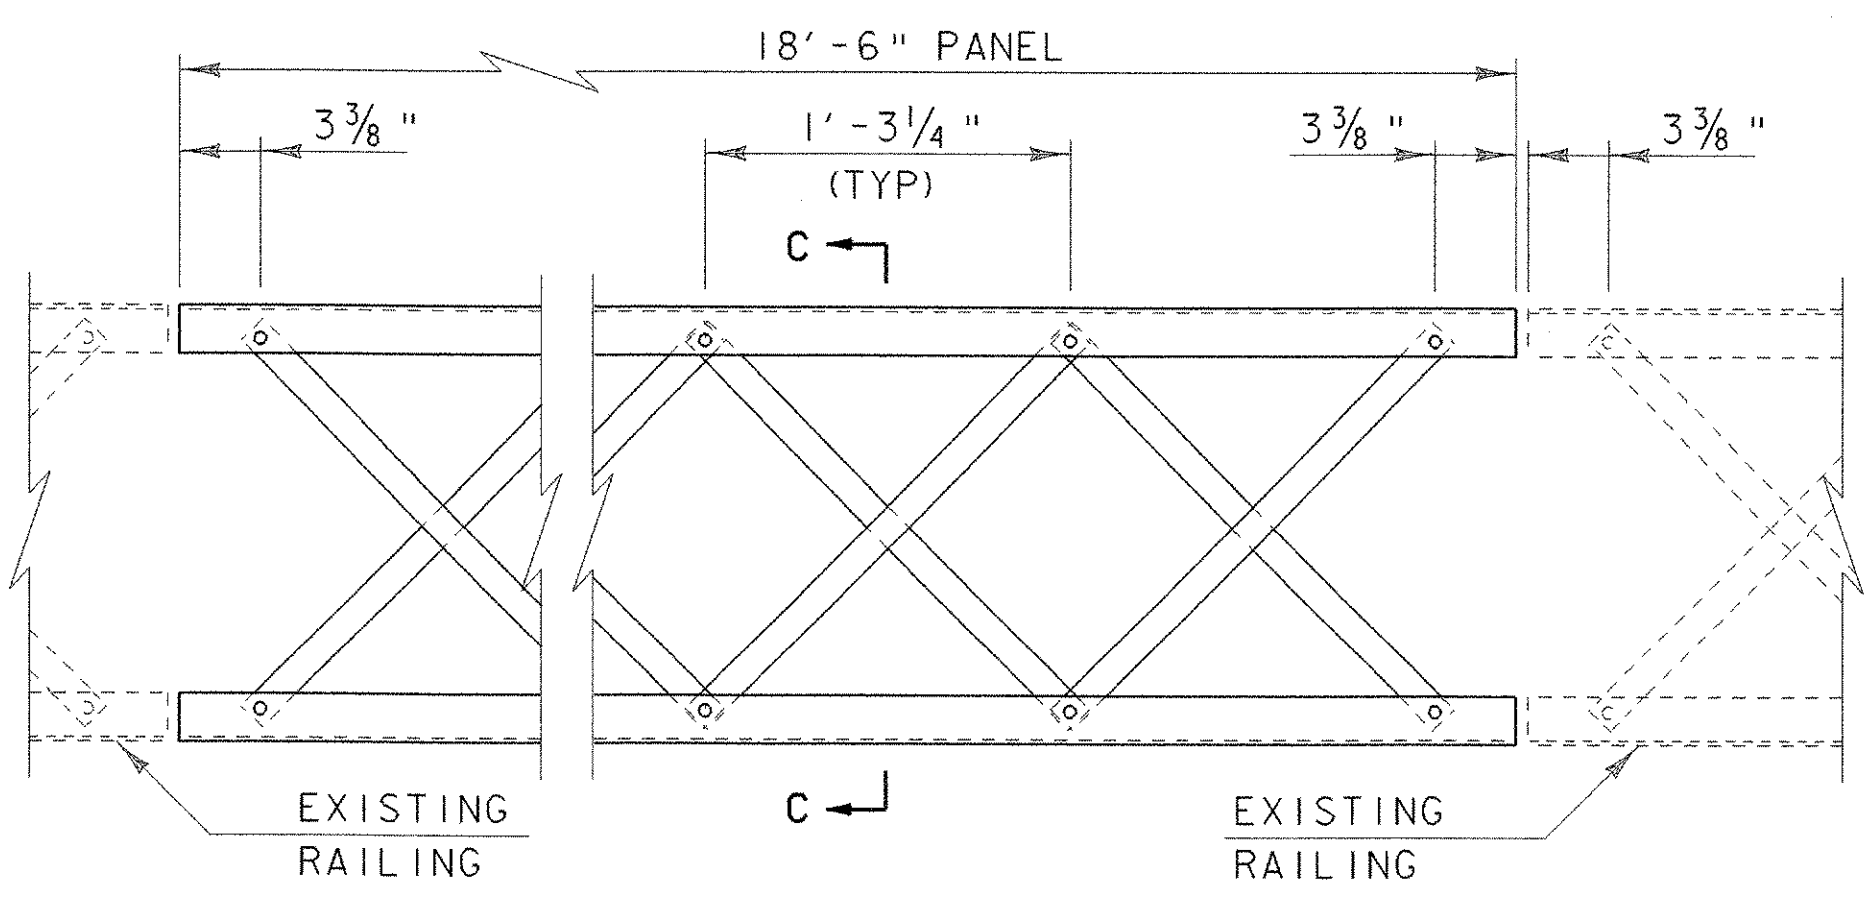

18'-6" LATTICE RAILING

SCALE 1 1/2" = 1'-0"

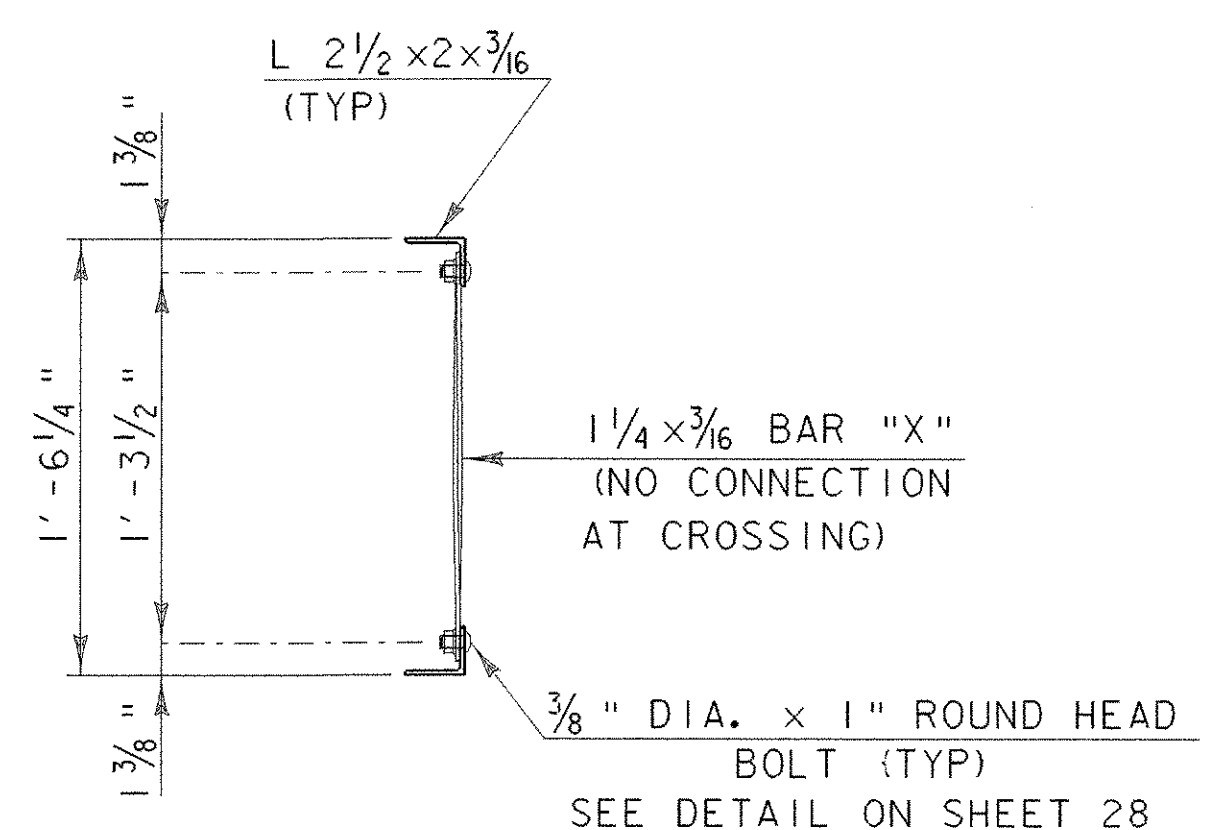

VIEW C-C (TYP)

SCALE 1 1/2" = 1'-0"

SCALE 3/16" = 1'-0"

SCALE 1 1/2" = 1'-0"


PROJECT: NEW HAVEN - WEYBRIDGE	PROJECT NO.: BHO-BTN 2005 (1)
DESIGN FILE NAME: 89j081/structures/sj081rail.dgn	PLOT DATE: 28-FEB-2007
IPARM FILE NAME: sj081railat.i	DRAWN BY: R.S. YOUNG
DESIGNED BY: R.S. YOUNG	CHECKED BY: R.S. YOUNG
SQUAD LEADER: C.P. WILLIAMS	SHEET: 29 OF 53
LATTICE RAIL DETAILS	

**APPROACH RAIL NOTES:**

1. SEE STANDARD DRAWING G-1 & G-1d FOR ADDITIONAL DETAILS OF STEEL BEAM GUARDRAIL.
2. POSTS AND OFFSET BLOCKS SHALL BE WOOD AND MEET THE REQUIREMENTS OF VAOT STANDARD SPECIFICATIONS FOR CONSTRUCTION 728.01.
3. POSTS SHALL BE TWO FEET LONGER THAN SPECIFIED IN STANDARDS G-1 & G-1d.
4. SPLICES SHALL LAP IN DIRECTION OF TRAFFIC FLOW.
5. SEE STANDARD SHEET G-1 FOR DELINEATOR DETAILS AND PLACEMENT.
6. ERECT DELINEATOR ON EVERY FIFTH POST OR APPROXIMATELY 30 FEET APART. PAYMENT SHALL BE INCIDENTAL TO OTHER ITEMS.
7. ANCHORAGE CONNECTOR AND ANCHORAGE PLATE SHALL BE ASTM A 36 STEEL GALVANIZED TO ASTM A 123 AFTER FABRICATION, AND PAID FOR UNDER ITEM 525.31 "BRIDGE RAILING - GALVANIZED 2 RAIL BOX BEAM".
8. ALLOWABLE DIMENSIONAL TOLERANCE FOR BENT SECTIONS IS +/- 1/16".


**BRIDGE APPROACH RAILING**

SCHEDULE 1		
POST NO.	SPACING	PAYMENT FACTOR
1	3' - 1 1/2"	1.4 X 12' - 6"
2	3' - 1 1/2"	
3	3' - 1 1/2"	
4	3' - 1 1/2"	
5	3' - 1 1/2"	
6	4' - 2"	1.2 X 12' - 6"
7	4' - 2"	
8	4' - 2"	
9	6' - 3" (TYP.)	1.0 (TYP.)

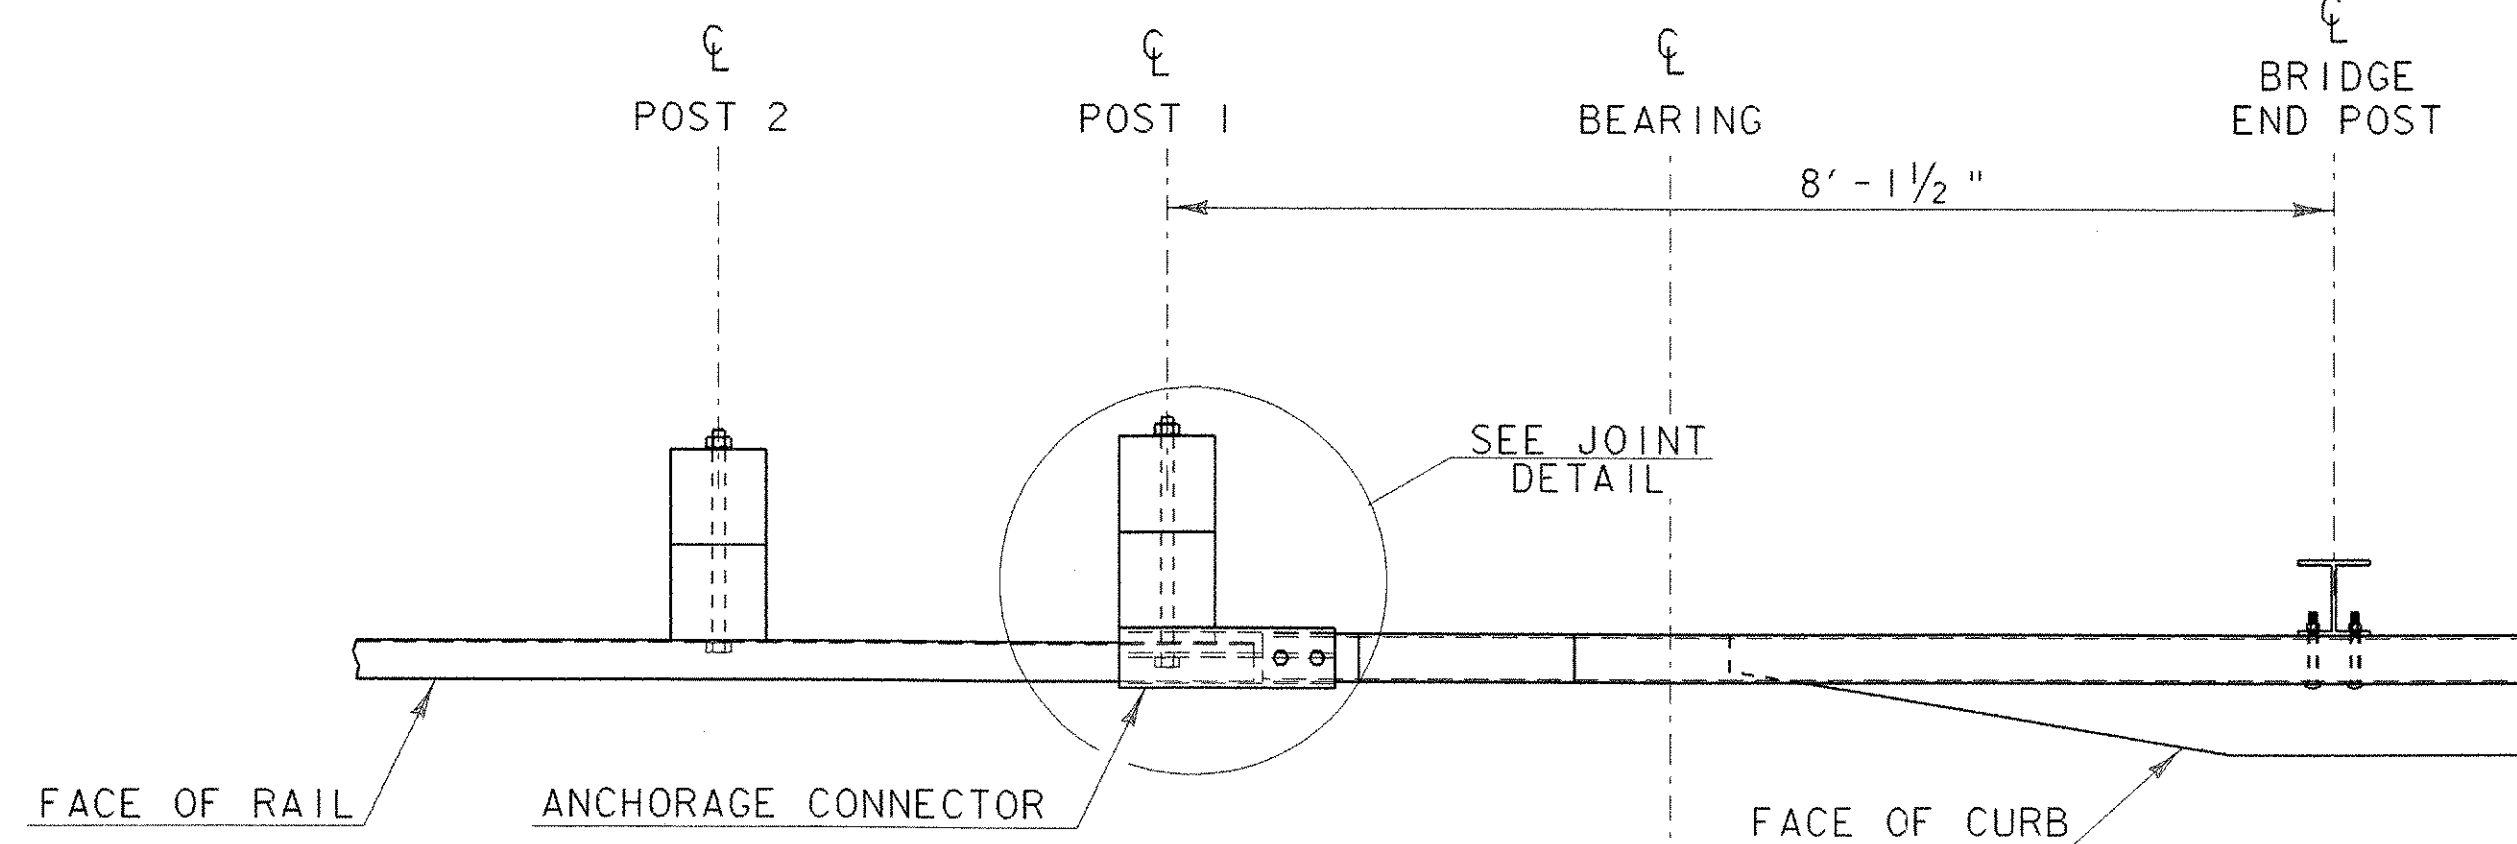


**BRIDGE APPROACH PLAN**

SCALE 3/4" = 1'-0"

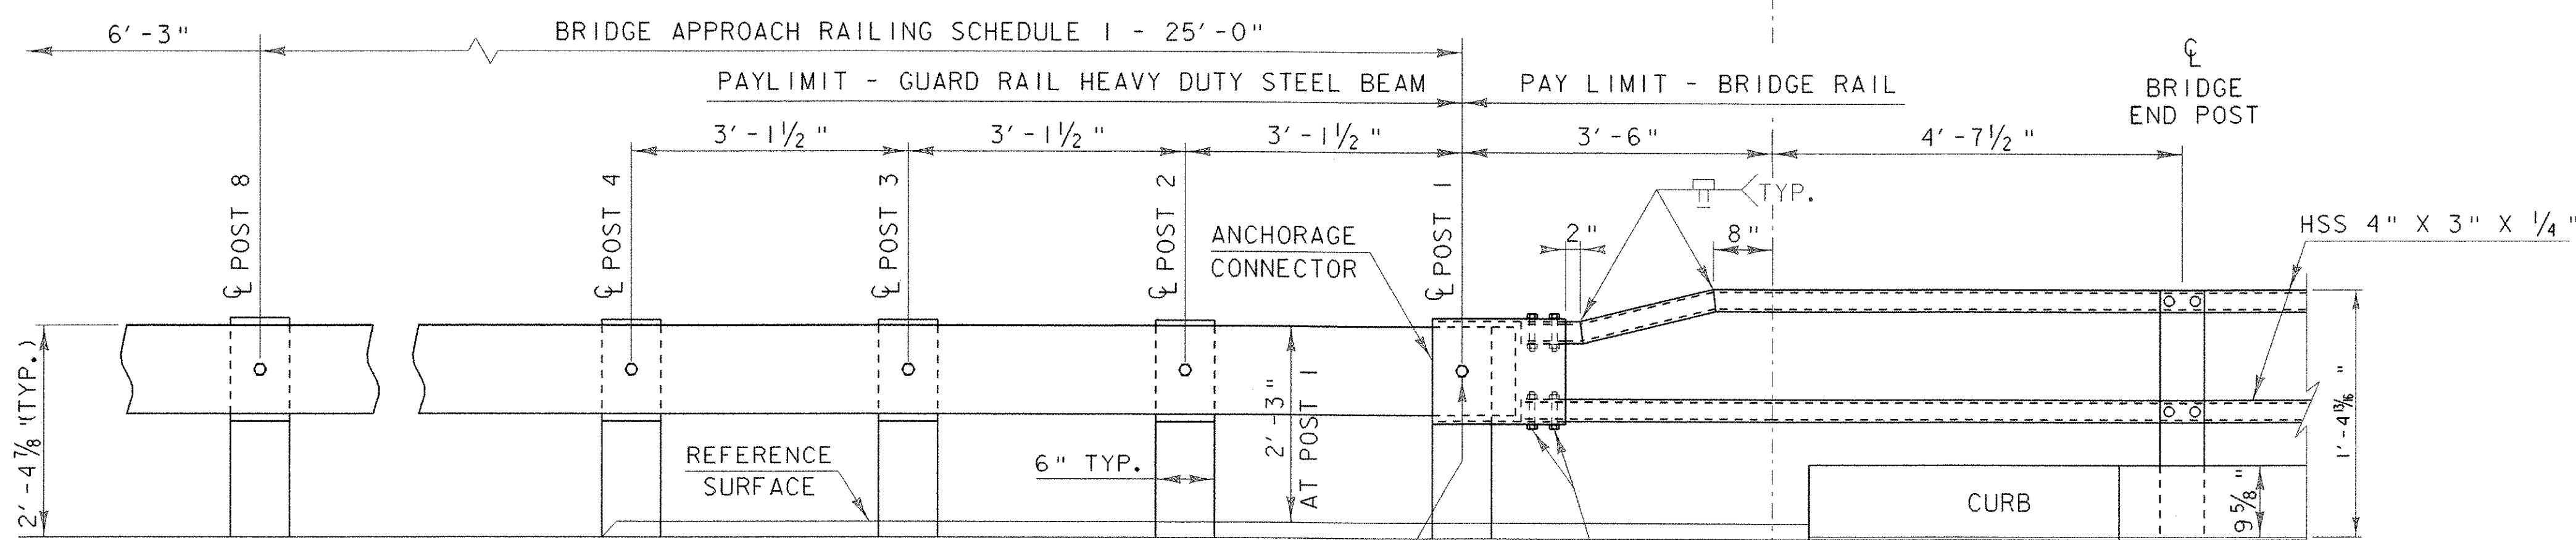


**BRIDGE APPROACH ELEVATION**

SCALE 3/4" = 1'-0"

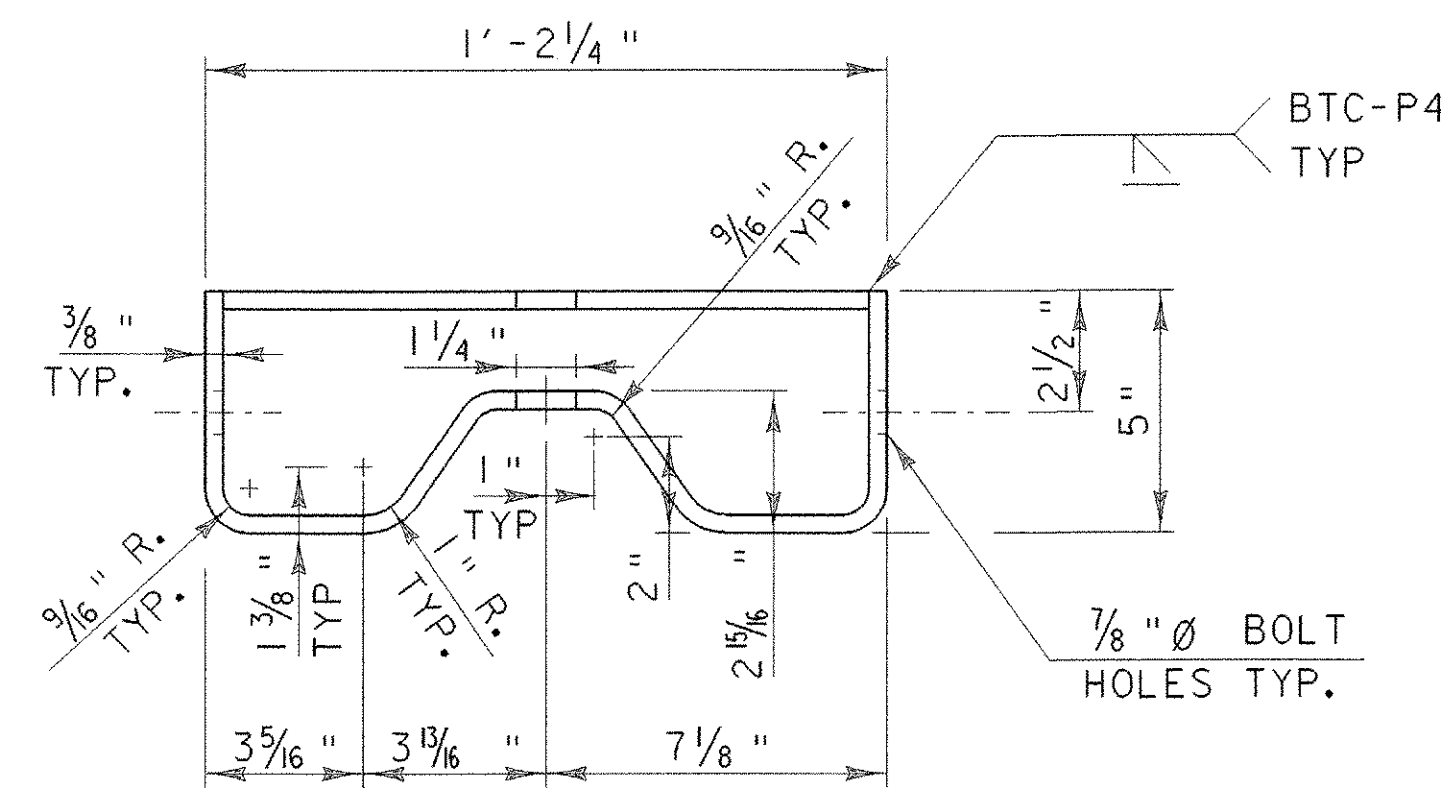

**ANCHORAGE CONNECTOR DETAIL**


SCALE 3" = 1'-0"

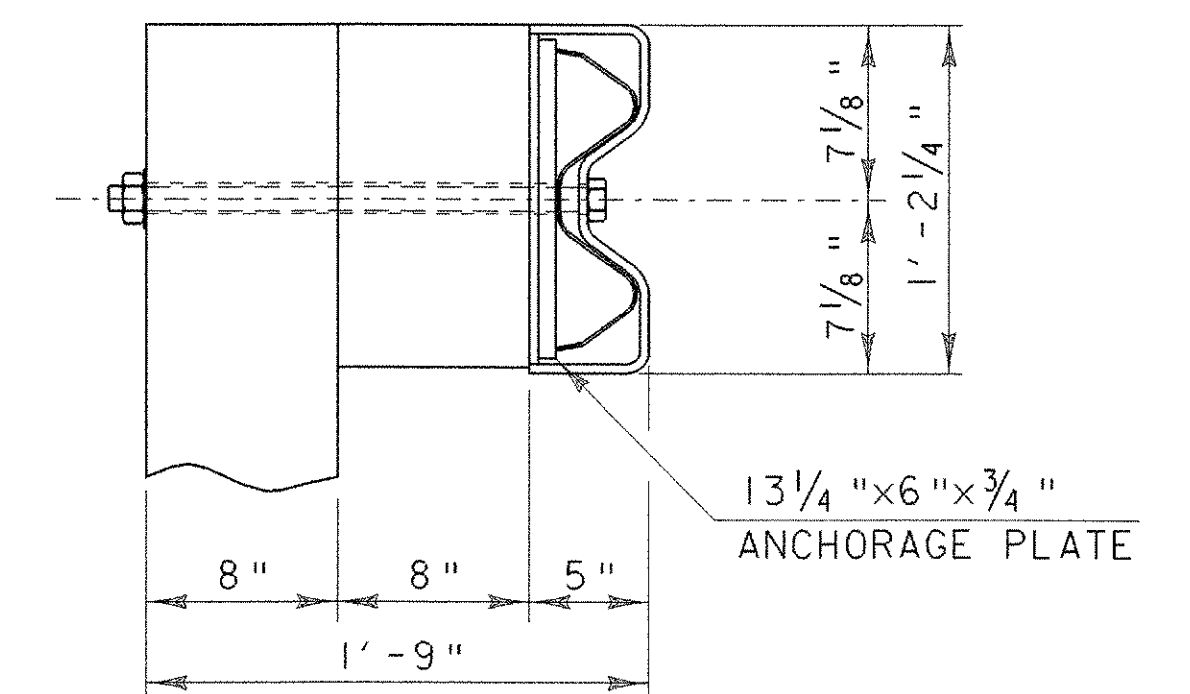

**VIEW B - B**


SCALE 1 1/2" = 1'-0"

ANCHORAGE CONNECTOR  
(1'-2 1/4" HIGH X 5" WIDE X  
1'-6" LONG (3/8" PLATE))

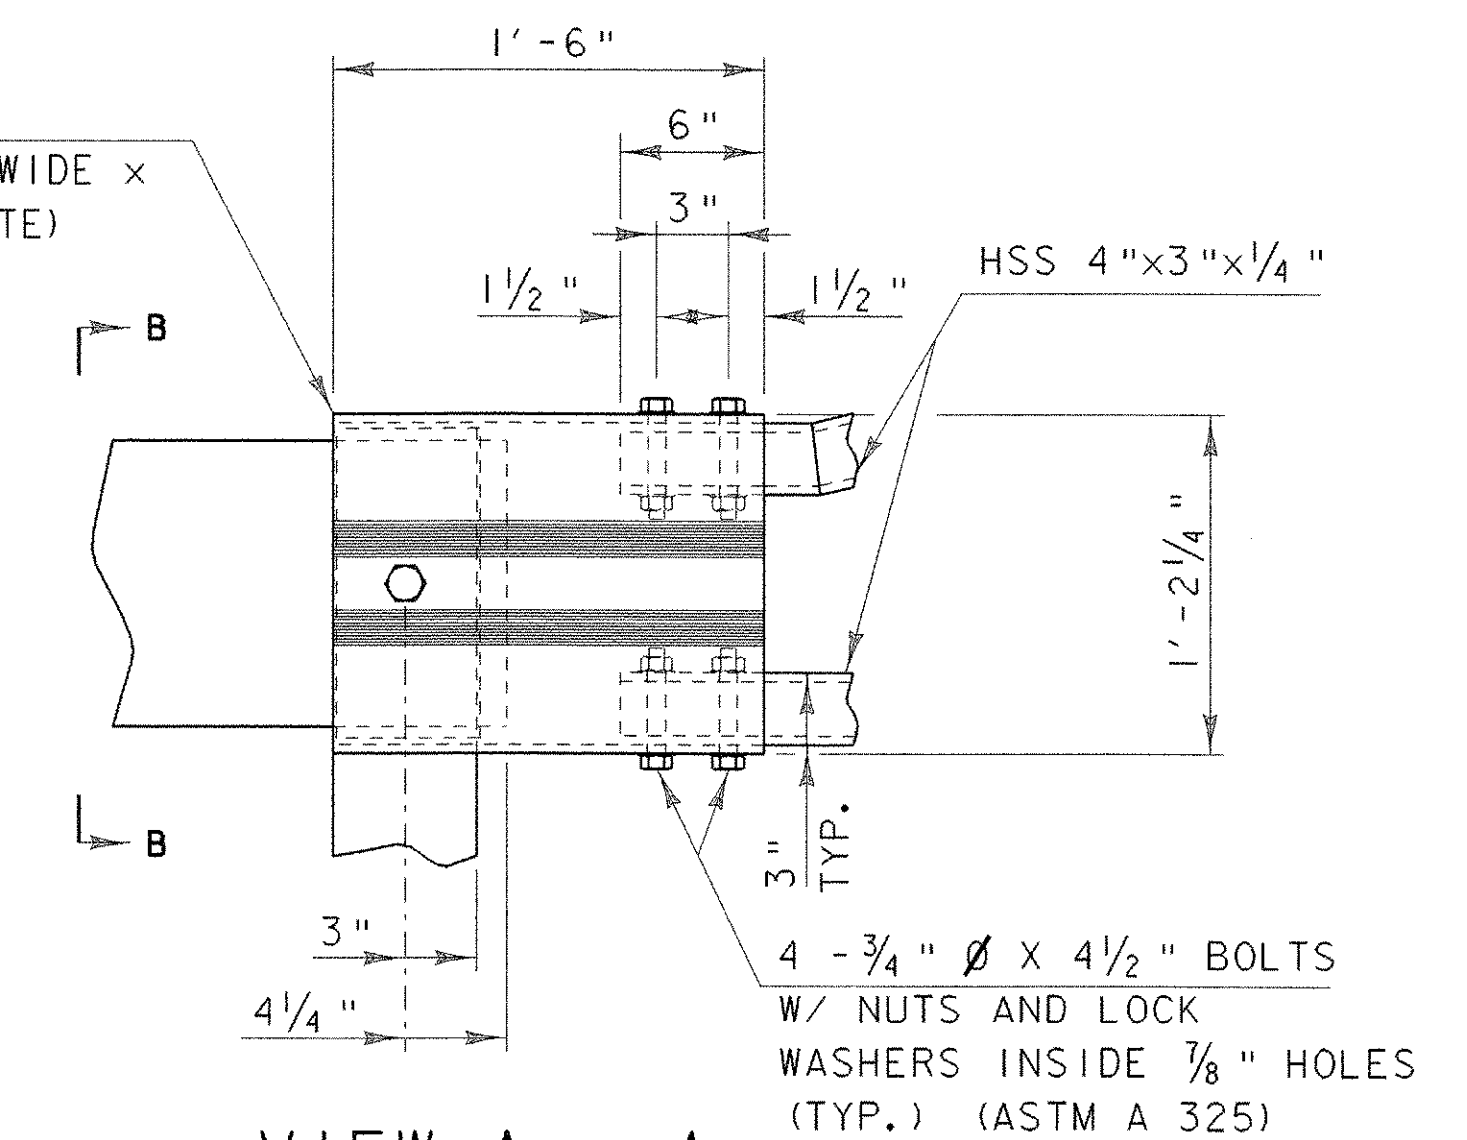




**VIEW A - A**

SCALE 1 1/2" = 1'-0"

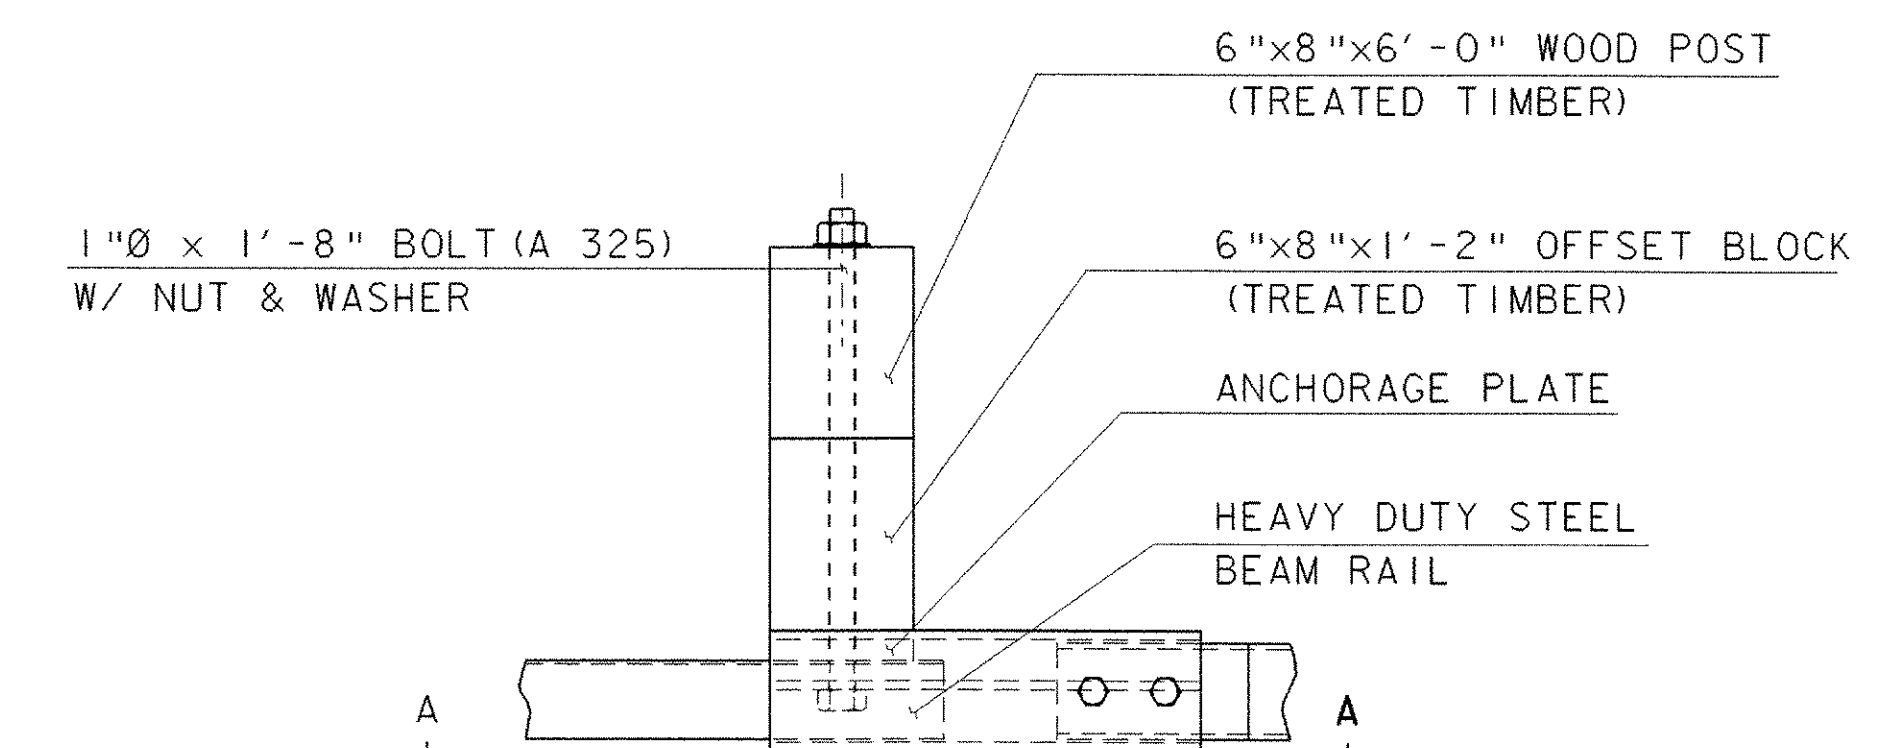


**JOINT DETAIL**

SCALE 1 1/2" = 1'-0"

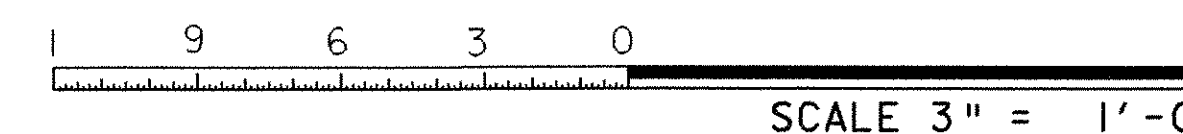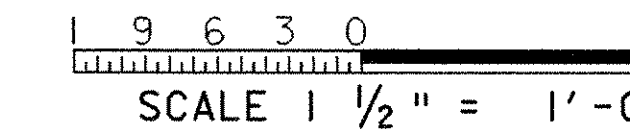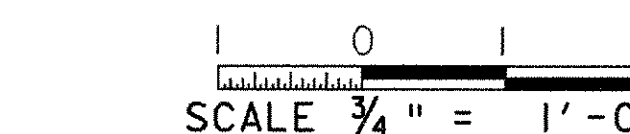

PROJECT: <b>NEW HAVEN-WEYBRIDGE</b>	PROJECT NO. : <b>BHO-BTN 2005 (1)</b>
DESIGN FILE NAME: 89i081/structures/sj081rail.dgn	PLOT DATE: 28-FEB-2007
IPARM FILE NAME: sj081apprail.i	DESIGNED BY: R. S. YOUNG
SQUAD LEADER: C. P. WILLIAMS	DRAWN BY: R. S. YOUNG
APPROACH RAIL DETAILS	CHECKED BY: R. S. YOUNG
	SHEET: 30 OF 53

\*SEE TOWN LINE SIGN POST  
DETAIL ON SHEET 22.

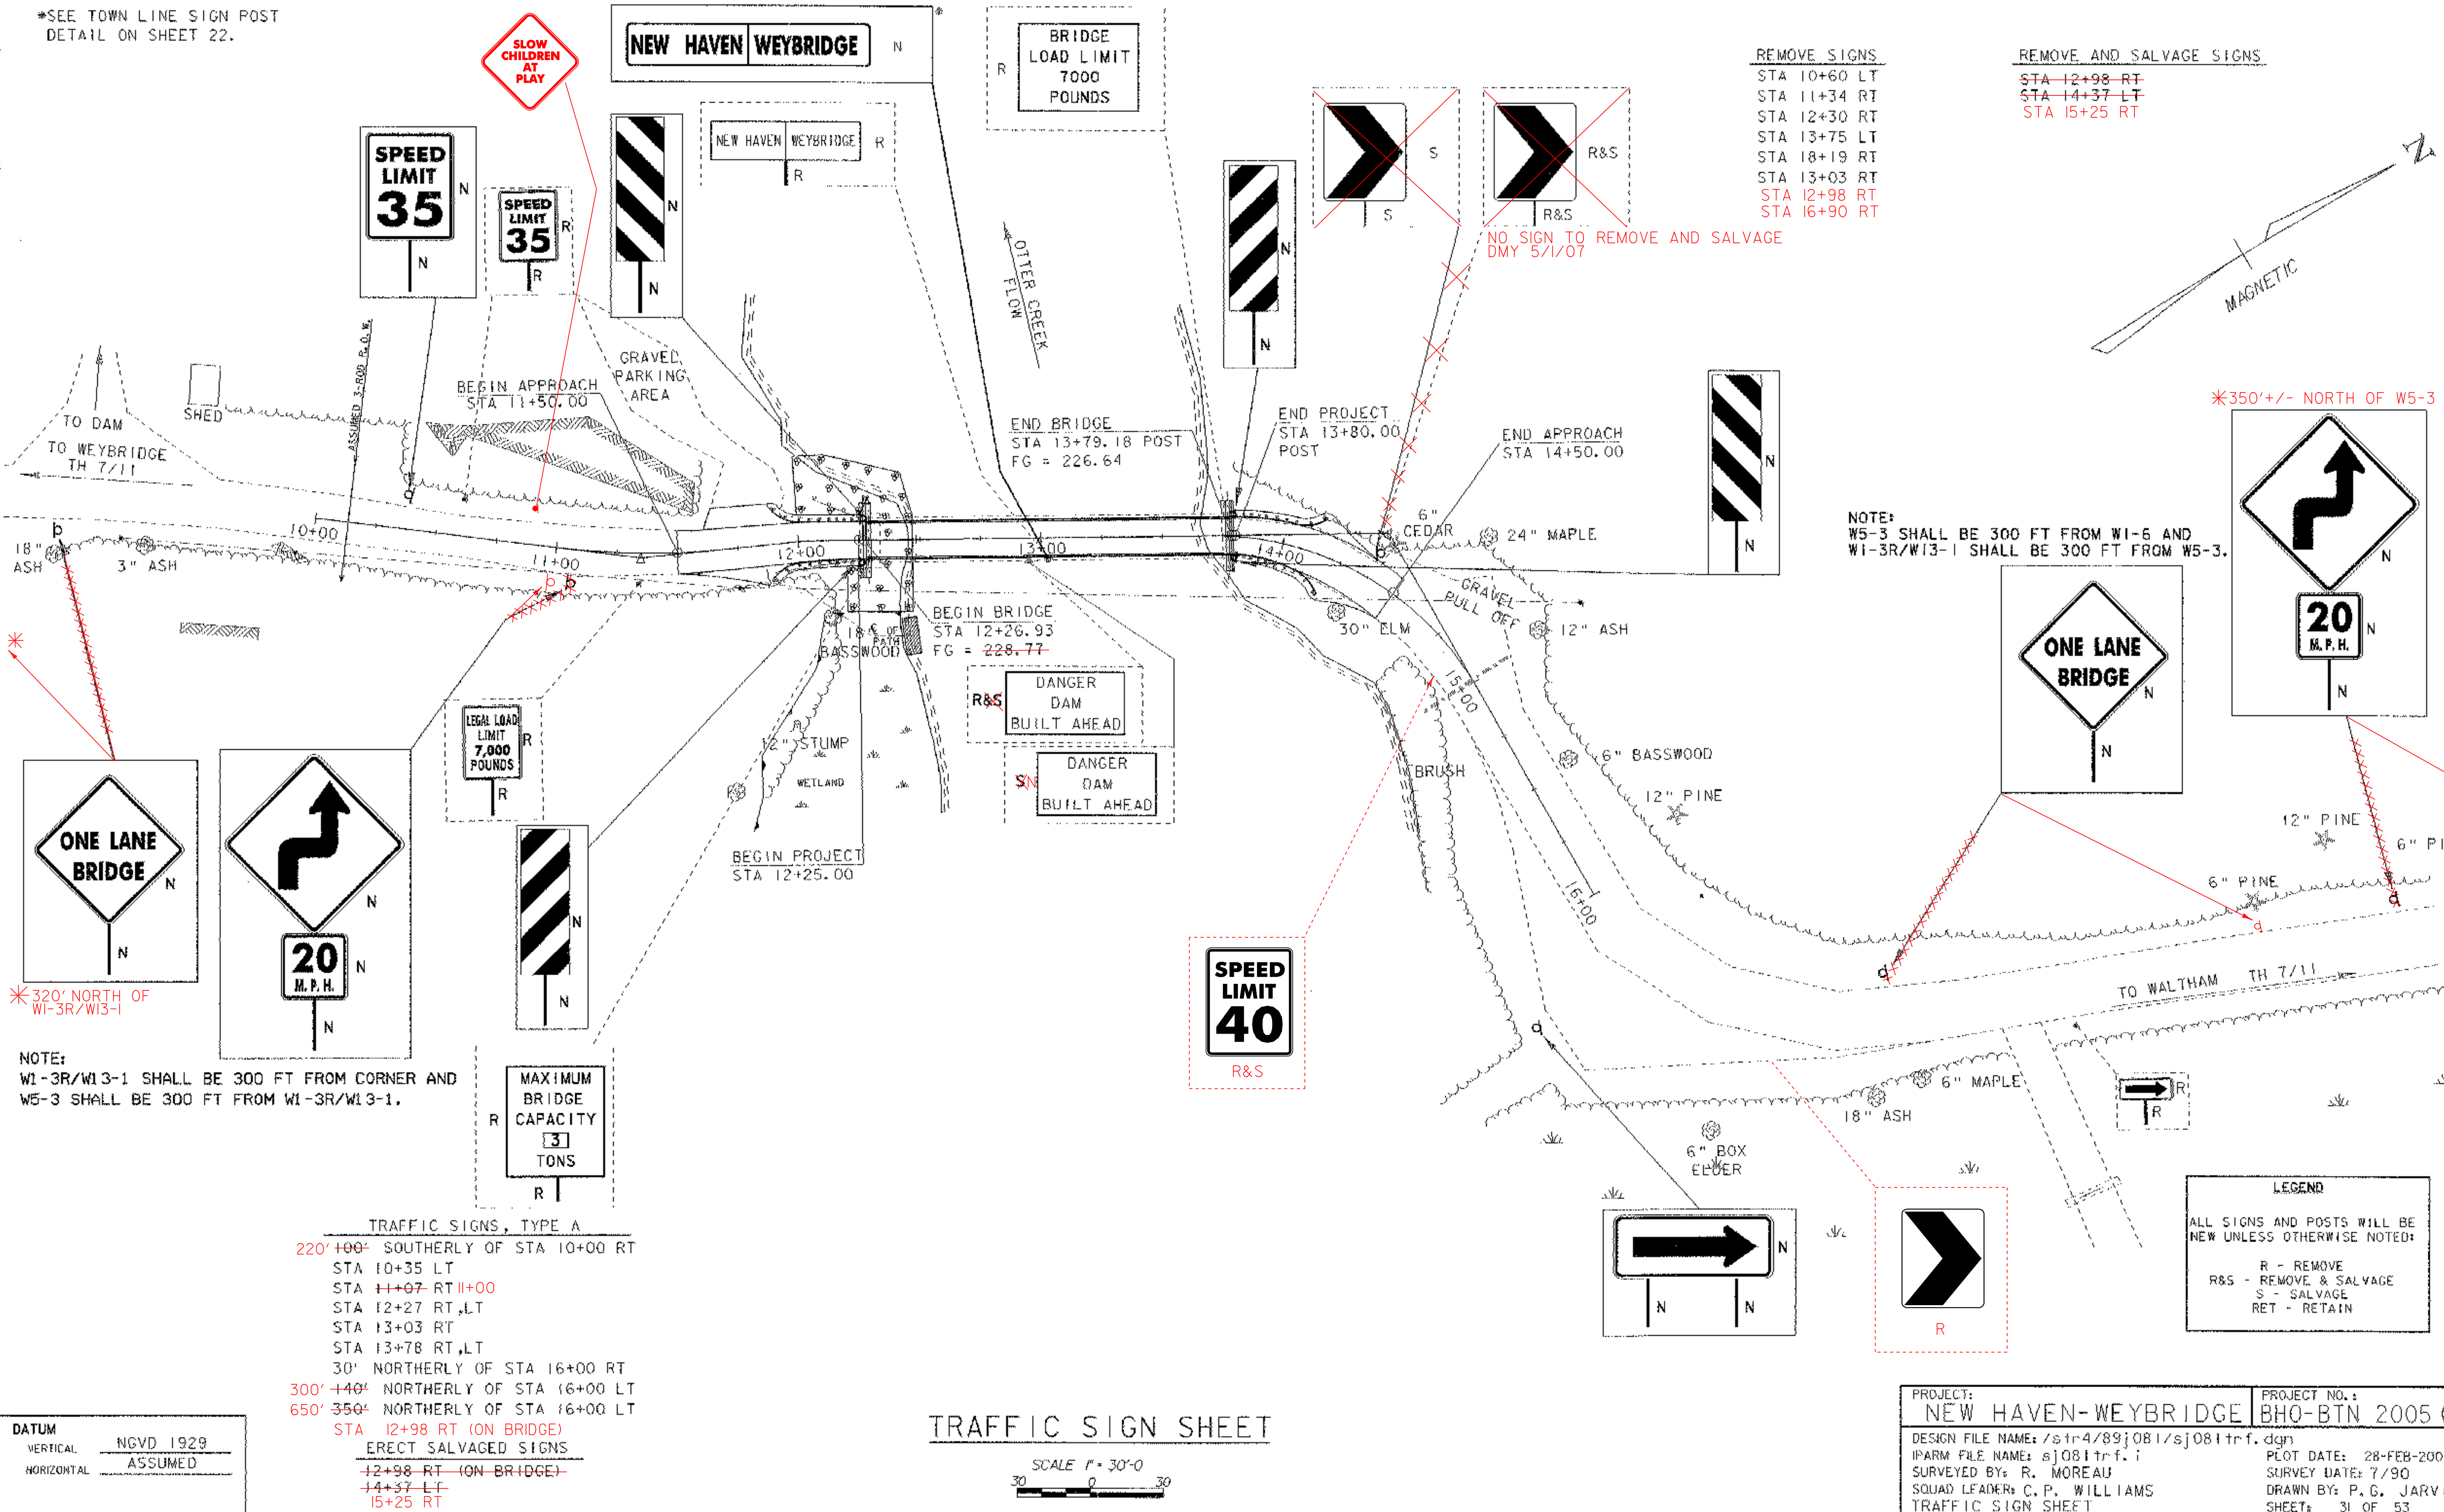

REMOVE SIGNS  
 STA 10+60 LT  
 STA 11+34 RT  
 STA 12+30 RT  
 STA 13+75 LT  
 STA 18+19 RT  
 STA 13+03 RT  
 STA 12+98 RT  
 STA 16+90 RT

REMOVE AND SALVAGE SIGNS  
 STA 12+98 RT  
 STA 14+37 LT  
 STA 15+25 RT

NO SIGN TO REMOVE AND SALVAGE  
 DMY 5/1/07

NOTE:  
 W5-3 SHALL BE 300 FT FROM W1-6 AND  
 W1-3R/W13-1 SHALL BE 300 FT FROM W5-3.

\*350' +/- NORTH OF W5-3


\*320' NORTH OF  
 W1-3R/W13-1

NOTE:  
 W1-3R/W13-1 SHALL BE 300 FT FROM CORNER AND  
 W5-3 SHALL BE 300 FT FROM W1-3R/W13-1.

DATUM	NGVD 1929
VERTICAL	ASSUMED
HORIZONTAL	

TRAFFIC SIGNS, TYPE A  
 220' +00' SOUTHERLY OF STA 10+00 RT  
 STA 10+35 LT  
 STA 11+07 RT 11+00  
 STA 12+27 RT,LT  
 STA 13+03 RT  
 STA 13+78 RT,LT  
 30' NORTHERLY OF STA 16+00 RT  
 300' +40' NORTHERLY OF STA 16+00 LT  
 650' 350' NORTHERLY OF STA 16+00 LT  
 STA 12+98 RT (ON BRIDGE)  
 ERECT SALVAGED SIGNS  
 12+98 RT (ON BRIDGE)  
 14+37 LT  
 15+25 RT


TRAFFIC SIGN SHEET

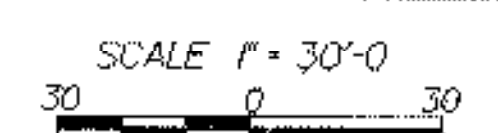

PROJECT: NEW HAVEN-WEYBRIDGE	PROJECT NO.: BHO-BTN 2005 (1)
DESIGN FILE NAME: /str4/89j081/sj081trf.dgn	PLOT DATE: 28-FEB-2007
IPARM FILE NAME: sj081trf.i	SURVEY DATE: 7/90
SURVEYED BY: R. MOREAU	DRAWN BY: P. G. JARVIS
SQUAD LEADER: C. P. WILLIAMS	SHEET: 31 OF 53
TRAFFIC SIGN SHEET	

LEGEND  
 ALL SIGNS AND POSTS WILL BE  
 NEW UNLESS OTHERWISE NOTED:  
 R - REMOVE  
 R&S - REMOVE & SALVAGE  
 S - SALVAGE  
 RET - RETAIN



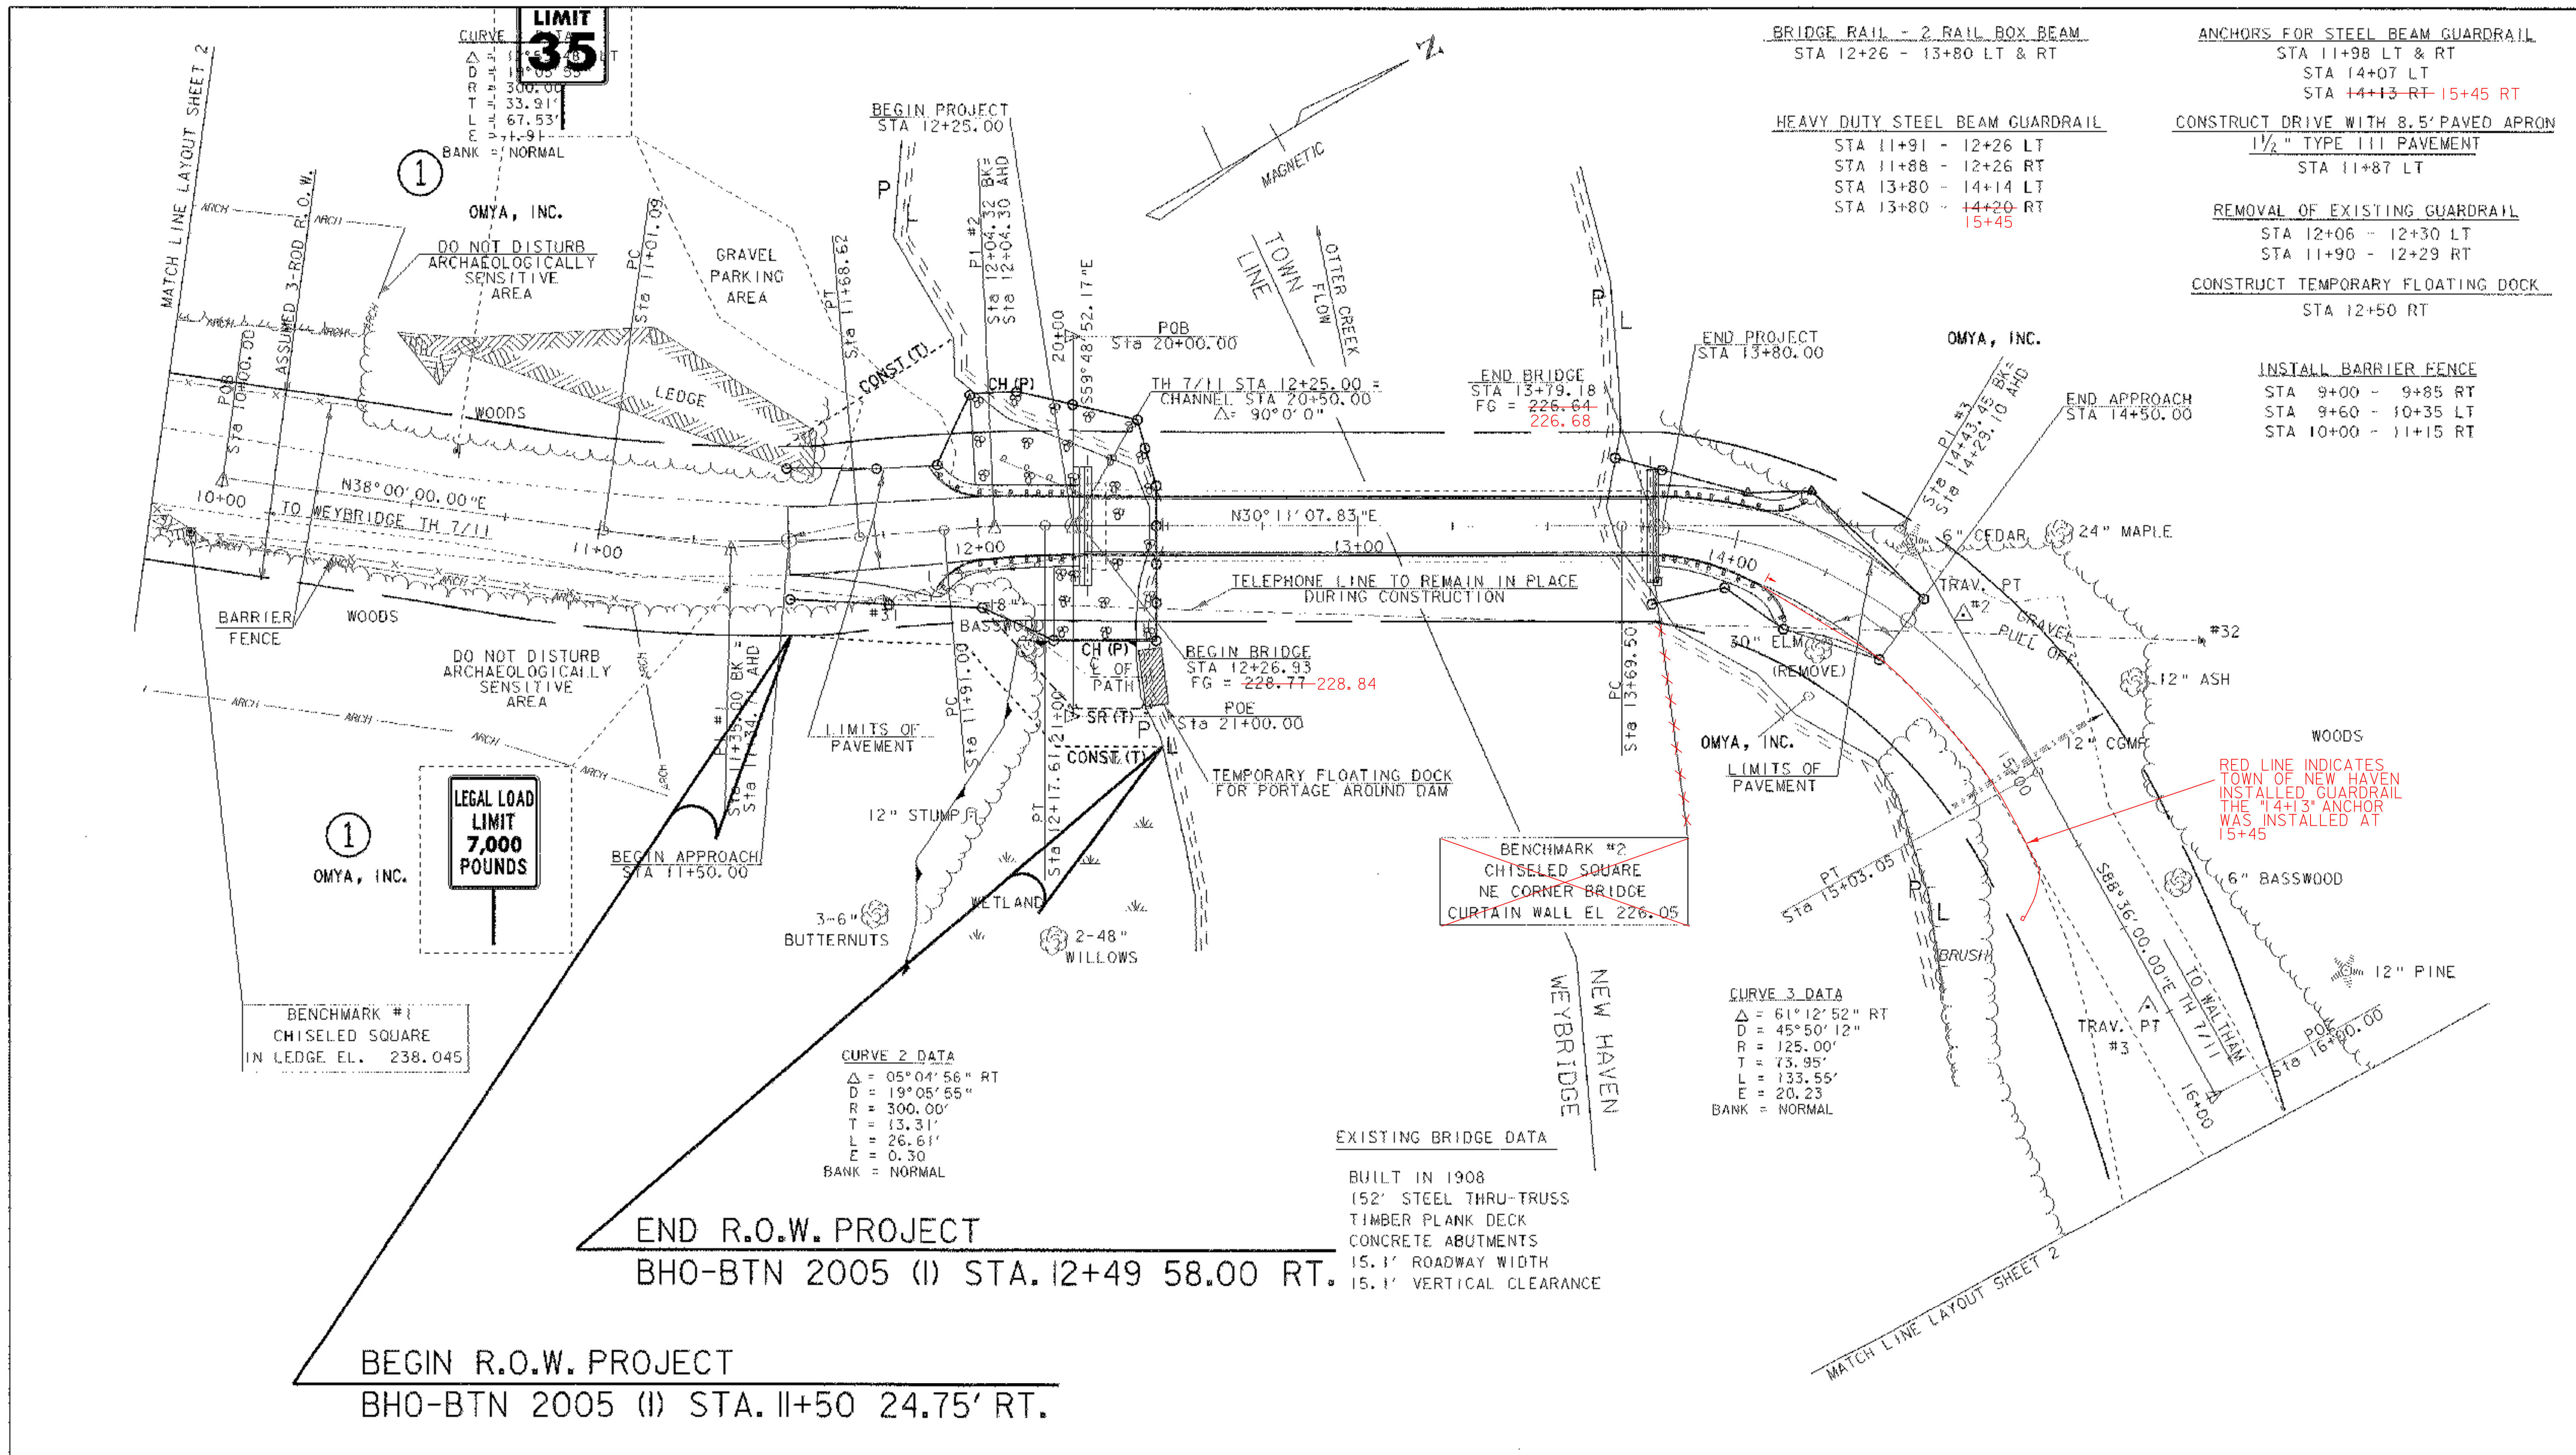

**LIMIT 35**

①

①  
**LEGAL LOAD LIMIT 7,000 POUNDS**

BENCHMARK #1  
CHISELED SQUARE  
IN LEDGE EL. 238.045

**CURVE 2 DATA**  
 $\Delta = 05^{\circ}04'56''$  RT  
 $D = 19^{\circ}05'55''$   
 $R = 300.00'$   
 $T = 13.31'$   
 $L = 26.61'$   
 $E = 0.30$   
 BANK = NORMAL

**CURVE 3 DATA**  
 $\Delta = 61^{\circ}12'52''$  RT  
 $D = 45^{\circ}50'12''$   
 $R = 125.00'$   
 $T = 73.95'$   
 $L = 133.55'$   
 $E = 20.23$   
 BANK = NORMAL

**EXISTING BRIDGE DATA**  
 BUILT IN 1908  
 152' STEEL THRU-TRUSS  
 TIMBER PLANK DECK  
 CONCRETE ABUTMENTS  
 15.1' ROADWAY WIDTH  
 15.1' VERTICAL CLEARANCE

**BRIDGE RAIL - 2 RAIL BOX BEAM**  
 STA 12+26 - 13+80 LT & RT

**HEAVY DUTY STEEL BEAM GUARDRAIL**  
 STA 11+91 - 12+26 LT  
 STA 11+88 - 12+26 RT  
 STA 13+80 - 14+14 LT  
 STA 13+80 - 14+20 RT  
 15+45

**ANCHORS FOR STEEL BEAM GUARDRAIL**  
 STA 11+98 LT & RT  
 STA 14+07 LT  
 STA 14+13 RT-15+45 RT

**CONSTRUCT DRIVE WITH 8.5' PAVED APRON**  
 1 1/2" TYPE III PAVEMENT  
 STA 11+87 LT

**REMOVAL OF EXISTING GUARDRAIL**  
 STA 12+06 - 12+30 LT  
 STA 11+90 - 12+29 RT

**CONSTRUCT TEMPORARY FLOATING DOCK**  
 STA 12+50 RT

**INSTALL BARRIER FENCE**  
 STA 9+00 - 9+85 RT  
 STA 9+60 - 10+35 LT  
 STA 10+00 - 11+15 RT

**LAYOUT SHEET 2**

SCALE 1" = 20'-0"  
 20 0 20

**DATUM**  
 VERTICAL NGVD 1929  
 HORIZONTAL ASSUMED

PROJECT: <b>NEW HAVEN WEYBRIDGE</b>	PROJECT NO.: <b>BHO-BTN 2005(1)</b>
DESIGN FILE NAME: /usr/str4/89j081/sj08lbr.dgn	PLOT DATE: 28-FEB-2007
IPARM FILE NAME: sj08lq2.i	SURVEY DATE: 7/90
SURVEYED BY: R. MOREAU	SQUAD LEADER: C.P. WILLIAMS
R.O.W. SHEET 7 OF 7 SHEETS	DRAWN BY: W.R. SYMONDS
	SHEET 33 OF 53

**STATE OF VERMONT  
AGENCY OF TRANSPORTATION  
RIGHT OF WAY PLANS  
DETAIL SHEET**

**TABLE OF PROJECT PROPERTY ACQUISITION**

ALL STATIONS ARE FROM THE REVISED  $\text{C}$

PARCEL NO.	GRANTOR	SHEET NO.	BEGINNING STATION	ENDING STATION	TAKING	REM.	RIGHTS	TITLE TAKEN	DATE	TOWN OR CITY RECORDED	BK.	PG.	REMARKS	REVISION NO.	SHEET	DESCRIPTION OF REVISION	DATE	MADE BY	APPROVED BY
1	OMYA, INC.	7	11+50 RT. 11+50 LT. 11+95 LT. 12+03 RT. 12+08 RT. 12+50 RT.	12+49 RT. 12+01 LT. 12+17 LT. 12+45 RT. 12+41 RT.			CONST. (T) CONST. (T) CH. (P) SLOPE (T) CH. (P) INSTALL (T)	WDOE	12-01-01	WEYBRIDGE	39	405-406	719 SF± 602 SF± 113 SF± 505 SF± 141 SF± OPTIONAL FLOATING CANOE LANDING			ELECTRONIC REPRODUCIBLES TO STRUCTURES	04-23-03		

ACCT.rdrawn  
M:\Projects\89\08\RightOfWay\08\d.dgn  
DATE PLOTTED 28-FEB-2007

DR. (P)- DRAINAGE RIGHT  
DIT. (P)- DITCHING RIGHT  
CH. (P)- CHANNEL RT.  
DRIVE (T)- DRIVE RIGHT  
CUL. (P)- CULVERT RIGHT  
[W]- WATER SOURCES

--- PRESENT R.O.W.  
 /// TAKING WITHOUT ACCESS  
 /// P TAKING WITHOUT ACCESS ALONG PROPERTY LINE  
 --- L TAKING WITH ACCESS  
 ( P ) PERMANENT EASEMENT  
 ( T ) TEMPORARY EASEMENT

LEGEND --- C&T (P) --- CLEARING & TRIMMING  
 ... C Z (P) ... CLEAR ZONE  
 --- CONST. (T) --- CONSTRUCTION EASEMENT  
 SR SR SLOPE RIGHTS  
 P PROPERTY LINE  
 L TOP OF CUT  
 O TOE OF SLOPE

APPROVED: ROGER P. DUMAS DATE: 3-31-00  
AGENT D. PLANS & TITLES

R. O. W. PLANS


NEW HAVEN-WEYBRIDGE  
BHO-BTN, 2005(1)  
6 7  
SHEET 34 OF 53

# REINFORCING STEEL SCHEDULE

EACH	SIZE	LENGTH	MARK	TYPE	A	B	C	D	E	F	G	H	J	K	R	O	ITEM	EACH	SIZE	LENGTH	MARK	TYPE	A	B	C	D	E	F	G	H	J	K	R	O						
<b>ABUTMENT #1</b>																																								
△	21	5	30'- 6"	1A501	STR																																			
	32	5	4'- 3"	1A502	STR																																			
△	20	8	3'- 6"	1A801	STR																																			
	32	5	6'- 10"	1A503	17																																			
	32	5	8'- 0"	1A504	17																																			
<b>ABUTMENT #2</b>																																								
△	15	5	28'- 10"	2A501	STR																																			
▲	80	5	4'- 4"	2A502	STR																																			
△	18	8	3'- 6"	2A801	STR																																			
	30	5	6'- 4"	2A503	17																																			

~ NOTES ~





- UNLESS OTHERWISE DESIGNATED, ALL BAR REINFORCEMENT FOR CONCRETE IN SIZES UP TO AND INCLUDING NO. 18 SHALL CONFORM TO THE REQUIREMENTS OF THE "SPECIFICATIONS FOR DEFORMED BILLET-STEEL BARS FOR CONCRETE REINFORCEMENT", AASHTO M 31 (ASTM A 615-S). ALL BARS SHALL BE GRADE 60, UNLESS OTHERWISE DESIGNATED.
- FOR TYPICAL BENDING DETAILS, RECOMMENDED PIN DIAMETER "D" OF BENDS AND HOOKS, AND OTHER STANDARD PRACTICE, SEE CURRENT CONCRETE REINFORCING STEEL INSTITUTE "MANUAL OF STANDARD PRACTICE".
- BARS WHICH REQUIRE MORE ACCURATE BENDING THAN STANDARD PRACTICES SHOULD HAVE LIMITS INDICATED.
- ALL DIMENSIONS ARE OUT TO OUT OF BAR EXCEPT "A" AND "G" ON STANDARD 180 DEGREE AND 135 DEGREE HOOKS.
- "J" DIMENSION ON 180 DEGREE HOOKS TO BE SHOWN ONLY WHERE NECESSARY TO RESTRICT HOOK SIZE. OTHERWISE, STANDARD HOOKS ARE TO BE USED.
- "H" DIMENSION ON STIRRUPS TO BE SHOWN ONLY WHEN NECESSARY TO MAINTAIN CLEARANCES.
- WHERE SLOPE DIFFERS FROM 45 DEGREES, DIMENSIONS "H" AND "K" MUST BE SHOWN.
- ▲ DENOTES BARS TO BE CUT IN FIELD.
- + DENOTES ONE EXTRA BAR ADDED FOR TESTING PURPOSES.
- △ DENOTES TWO EXTRA BARS ADDED FOR TESTING PURPOSES.
- "E" IN PREFIX DENOTES EPOXY COATED REINFORCING STEEL.

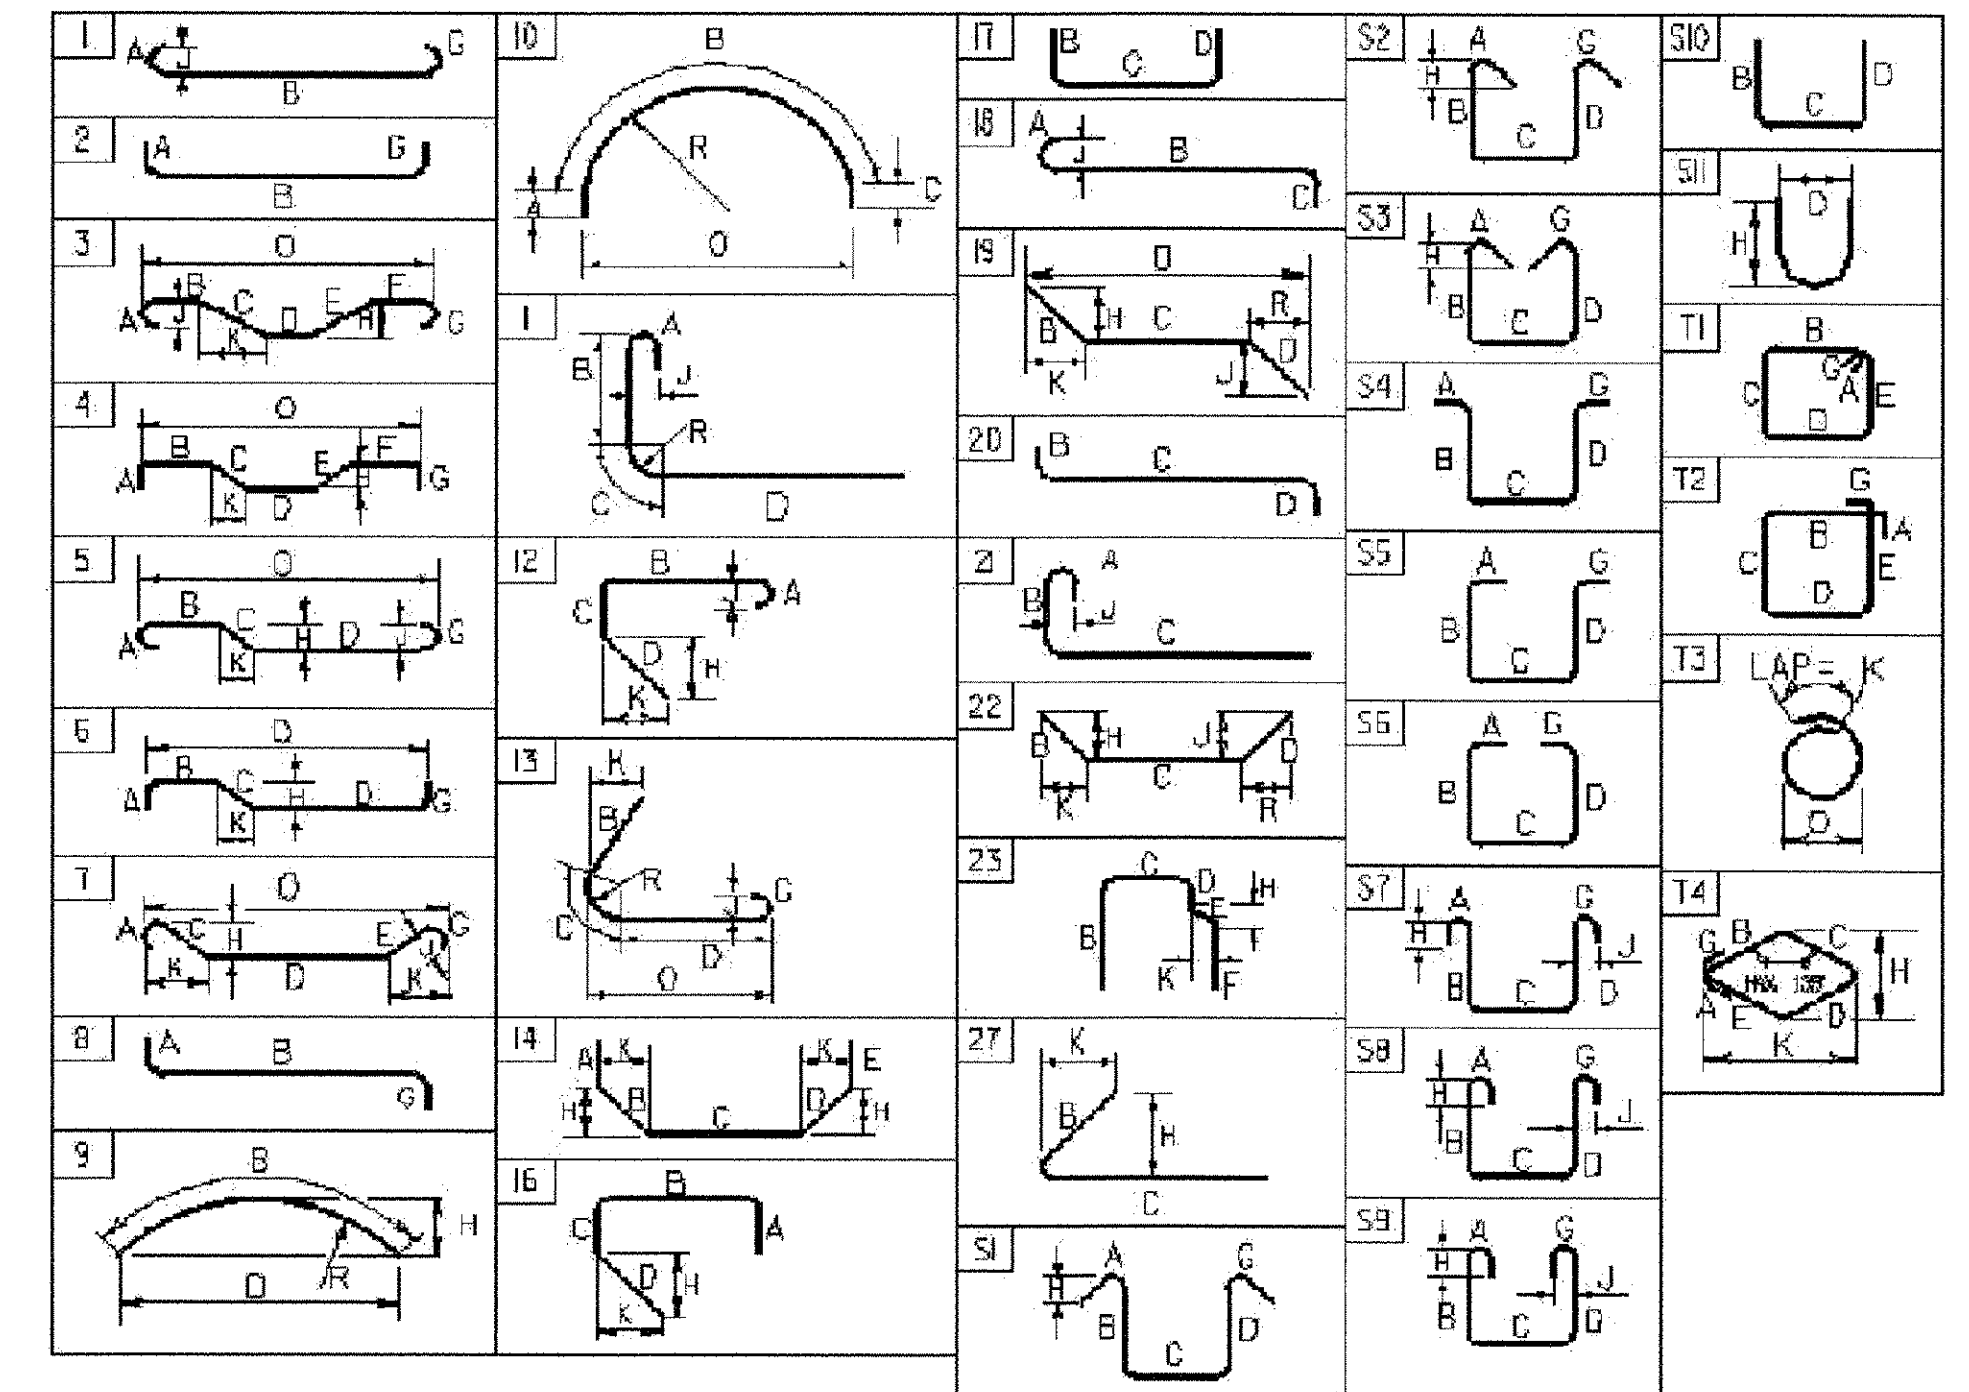

**ASTM STANDARD REINFORCING BARS**

BAR SIZE DESIGNATION	WEIGHT POUNDS PER FOOT	NOMINAL DIMENSIONS ROUND SECTION		
		DIAMETER INCHES	AREA INCHES <sup>2</sup>	PERIMETER INCHES
#3	0.376	0.375	0.11	1.178
#4	0.668	0.500	0.20	1.571
#5	1.043	0.625	0.31	1.963
#6	1.502	0.750	0.44	2.356
#7	2.044	0.875	0.60	2.749
#8	2.670	1.000	0.79	3.142
#9	3.400	1.128	1.00	3.544
#10	4.303	1.270	1.27	3.990
#11	5.313	1.410	1.56	4.430
#14	7.65	1.693	2.25	5.32
#18	13.60	2.257	4.00	7.09





PROJECT NAME: **NEW HAVEN - WEYBRIDGE**  
 PROJECT NUMBER: **BHO - BTN 2005 (1)**  
 FILE NAME: sj081reinf.xls  
 PROJECT LEADER: C. P. WILLIAMS  
 DESIGNED BY: R. S. YOUNG  
 PLOT DATE: 3/17/2003  
 DRAWN BY: R. S. YOUNG  
 CHECKED BY: J. L. SCHULTZ  
 REINFORCING STEEL SCHEDULE SHEET #1 SHEET 35 OF 53

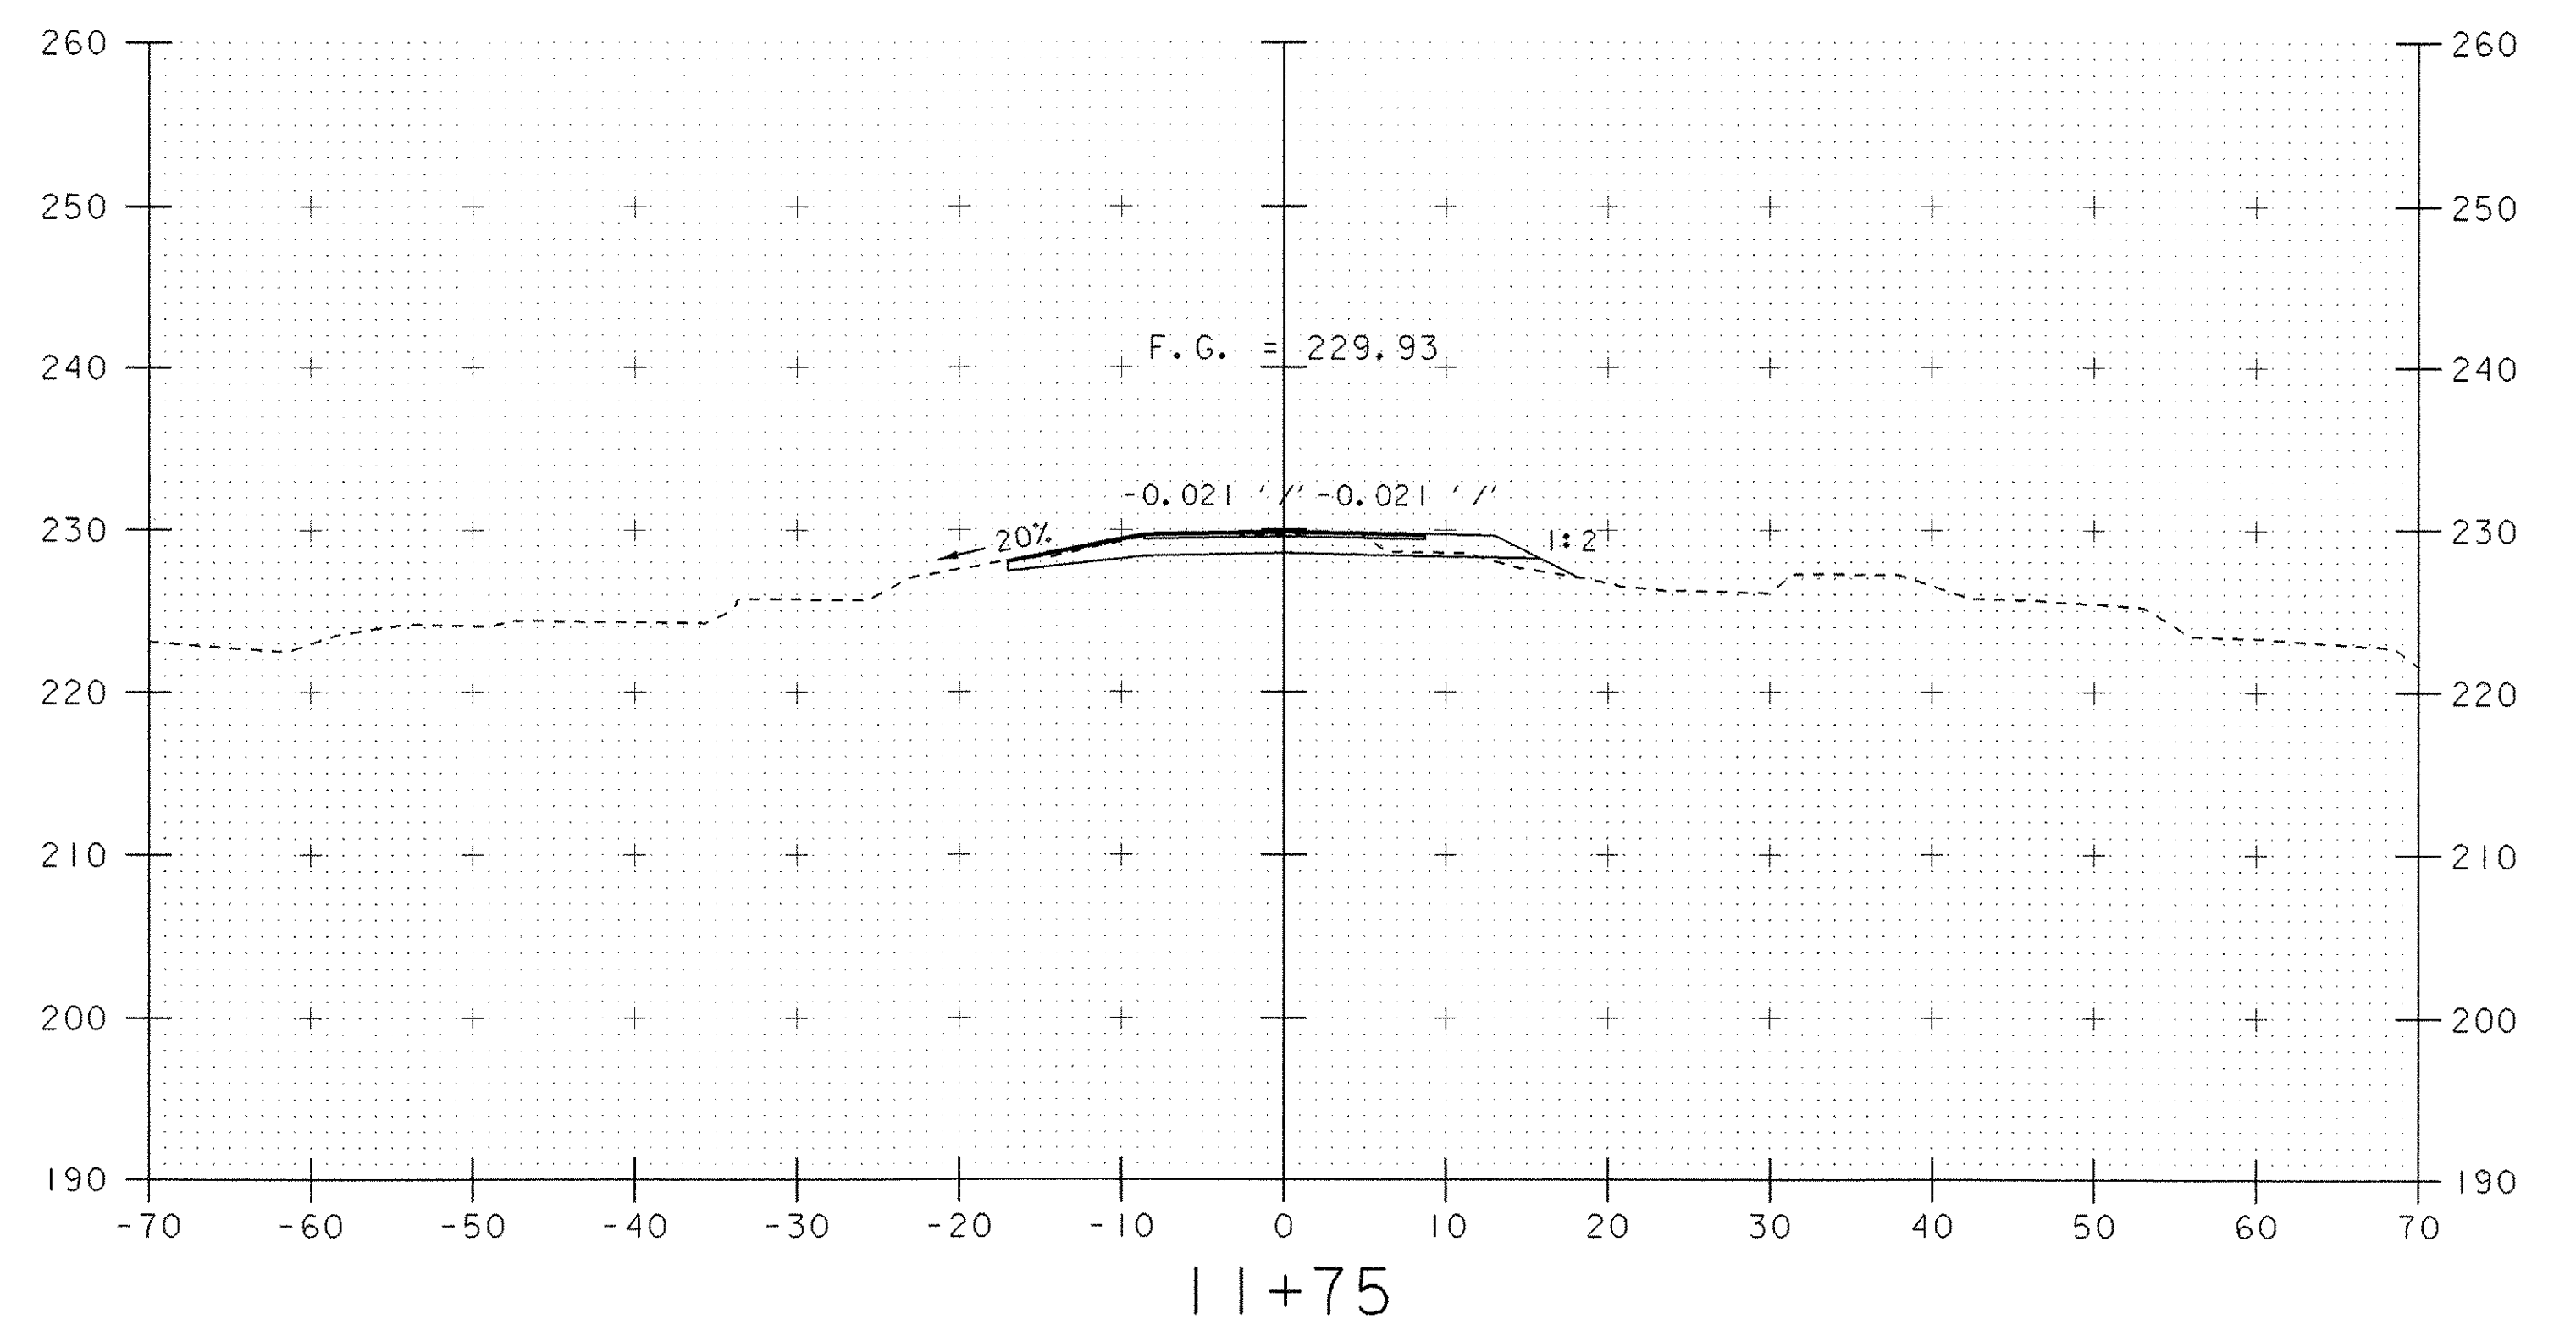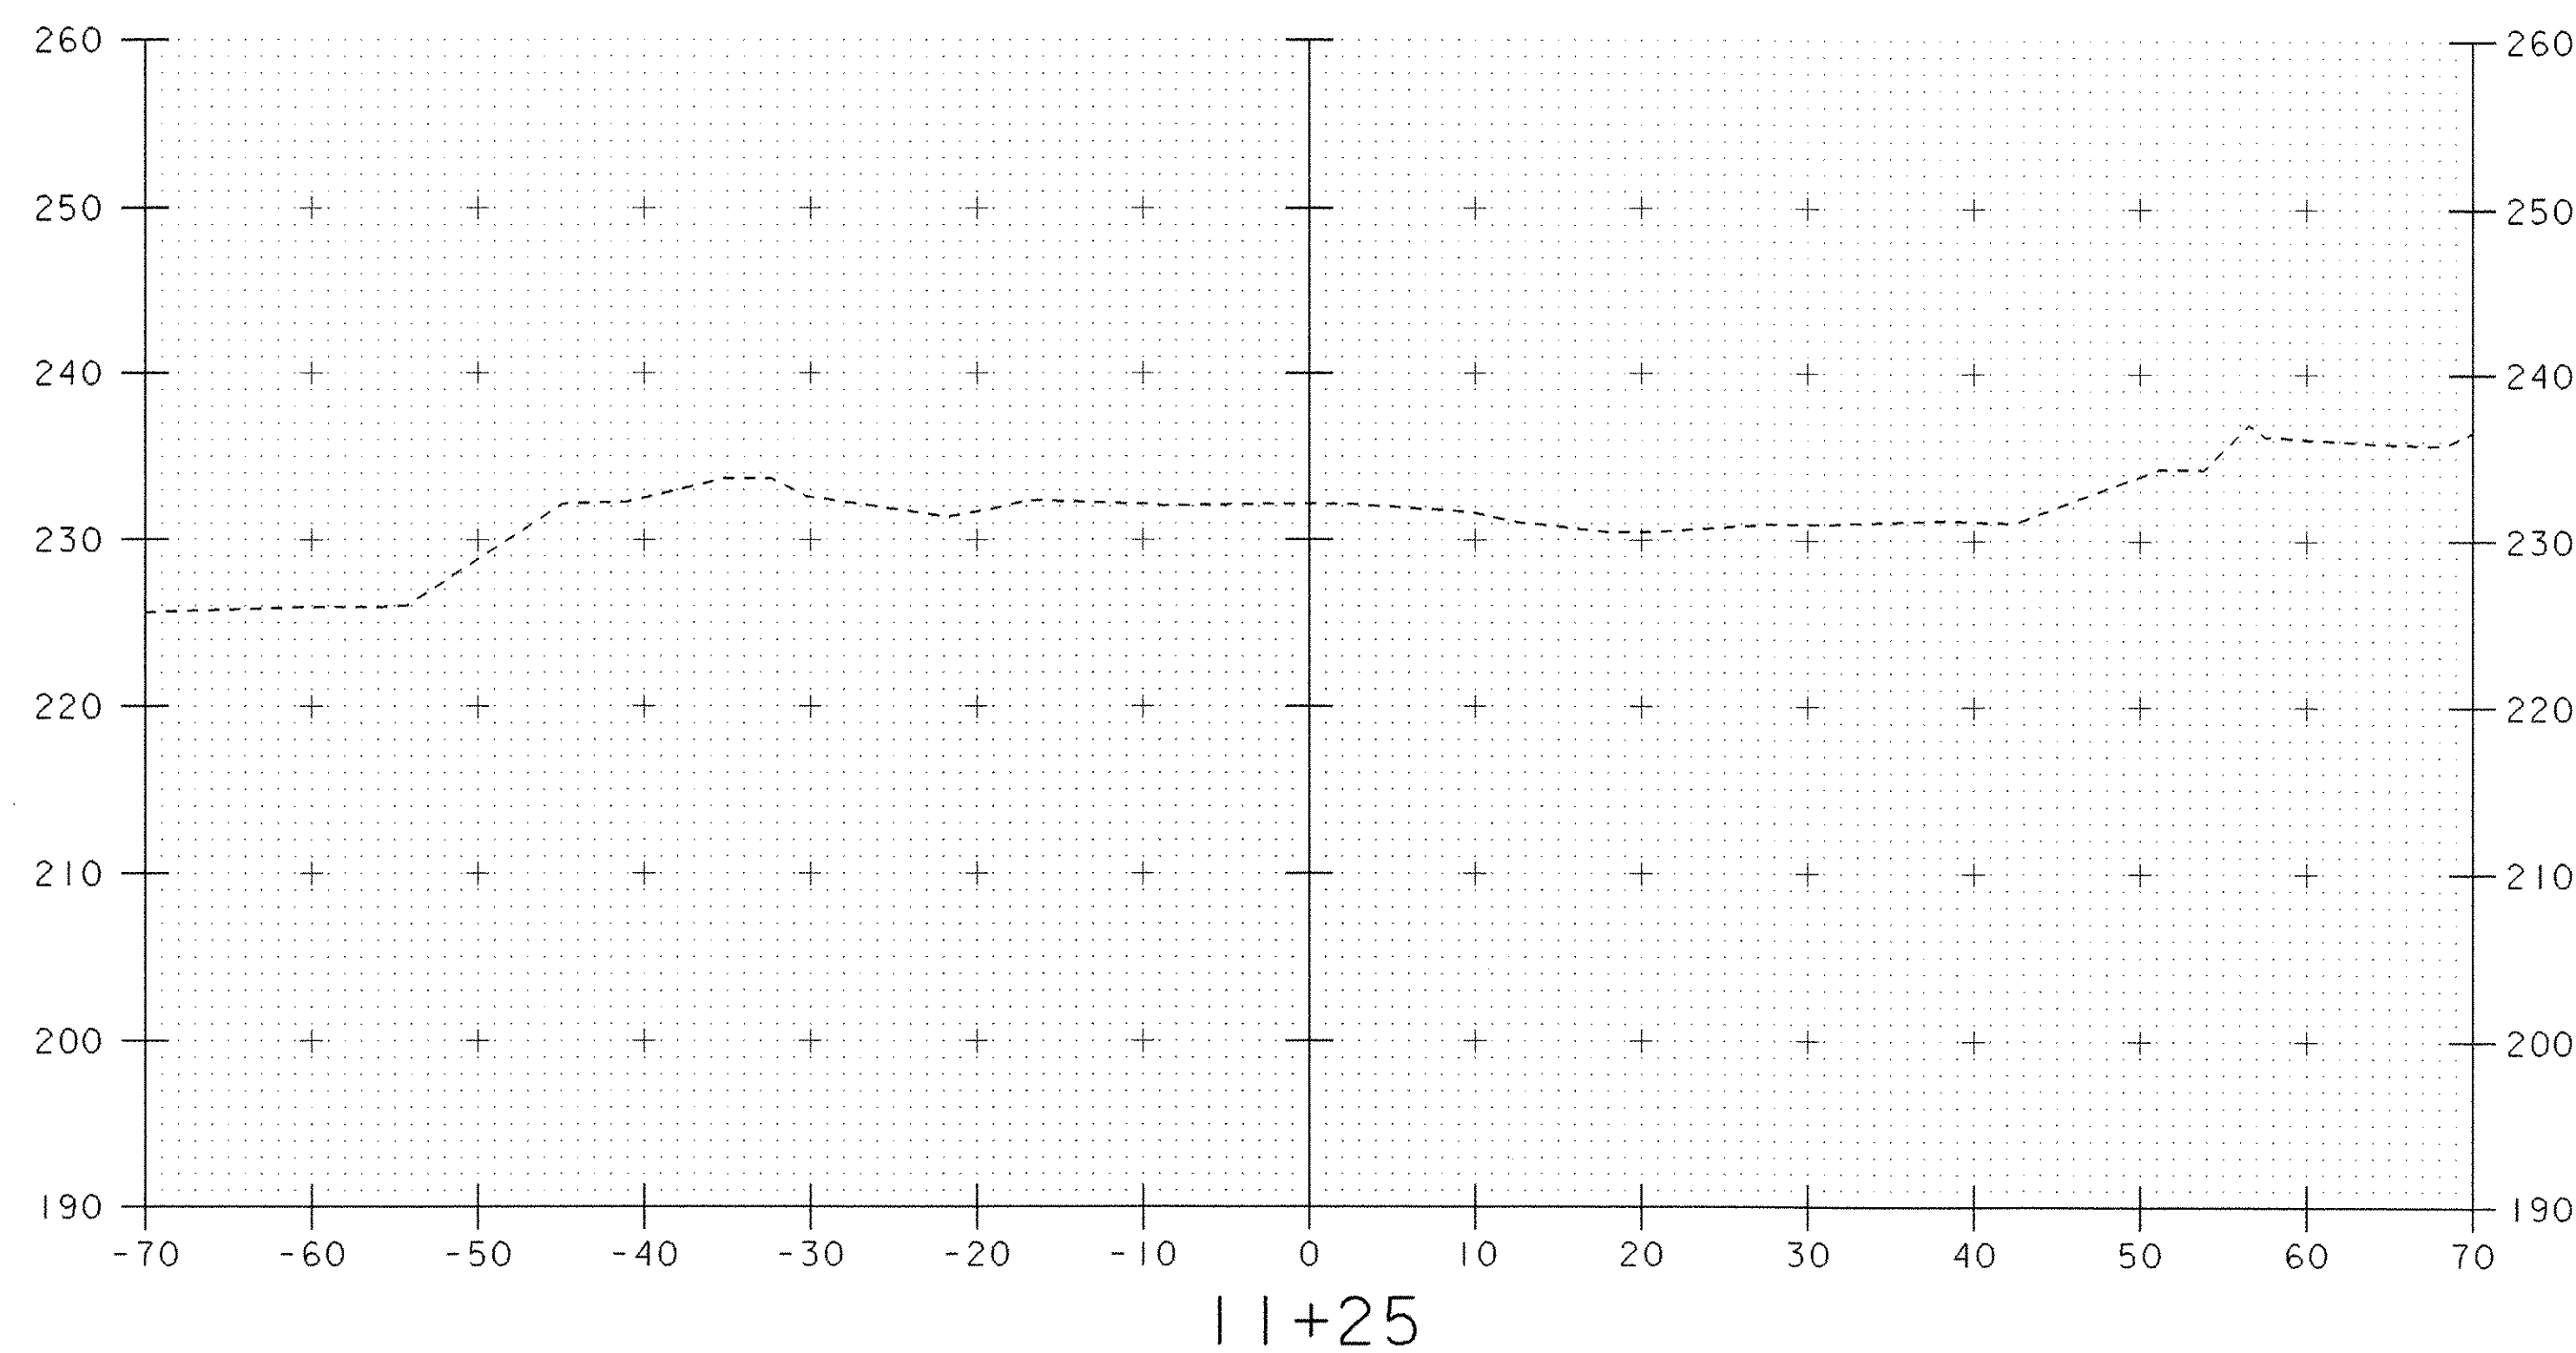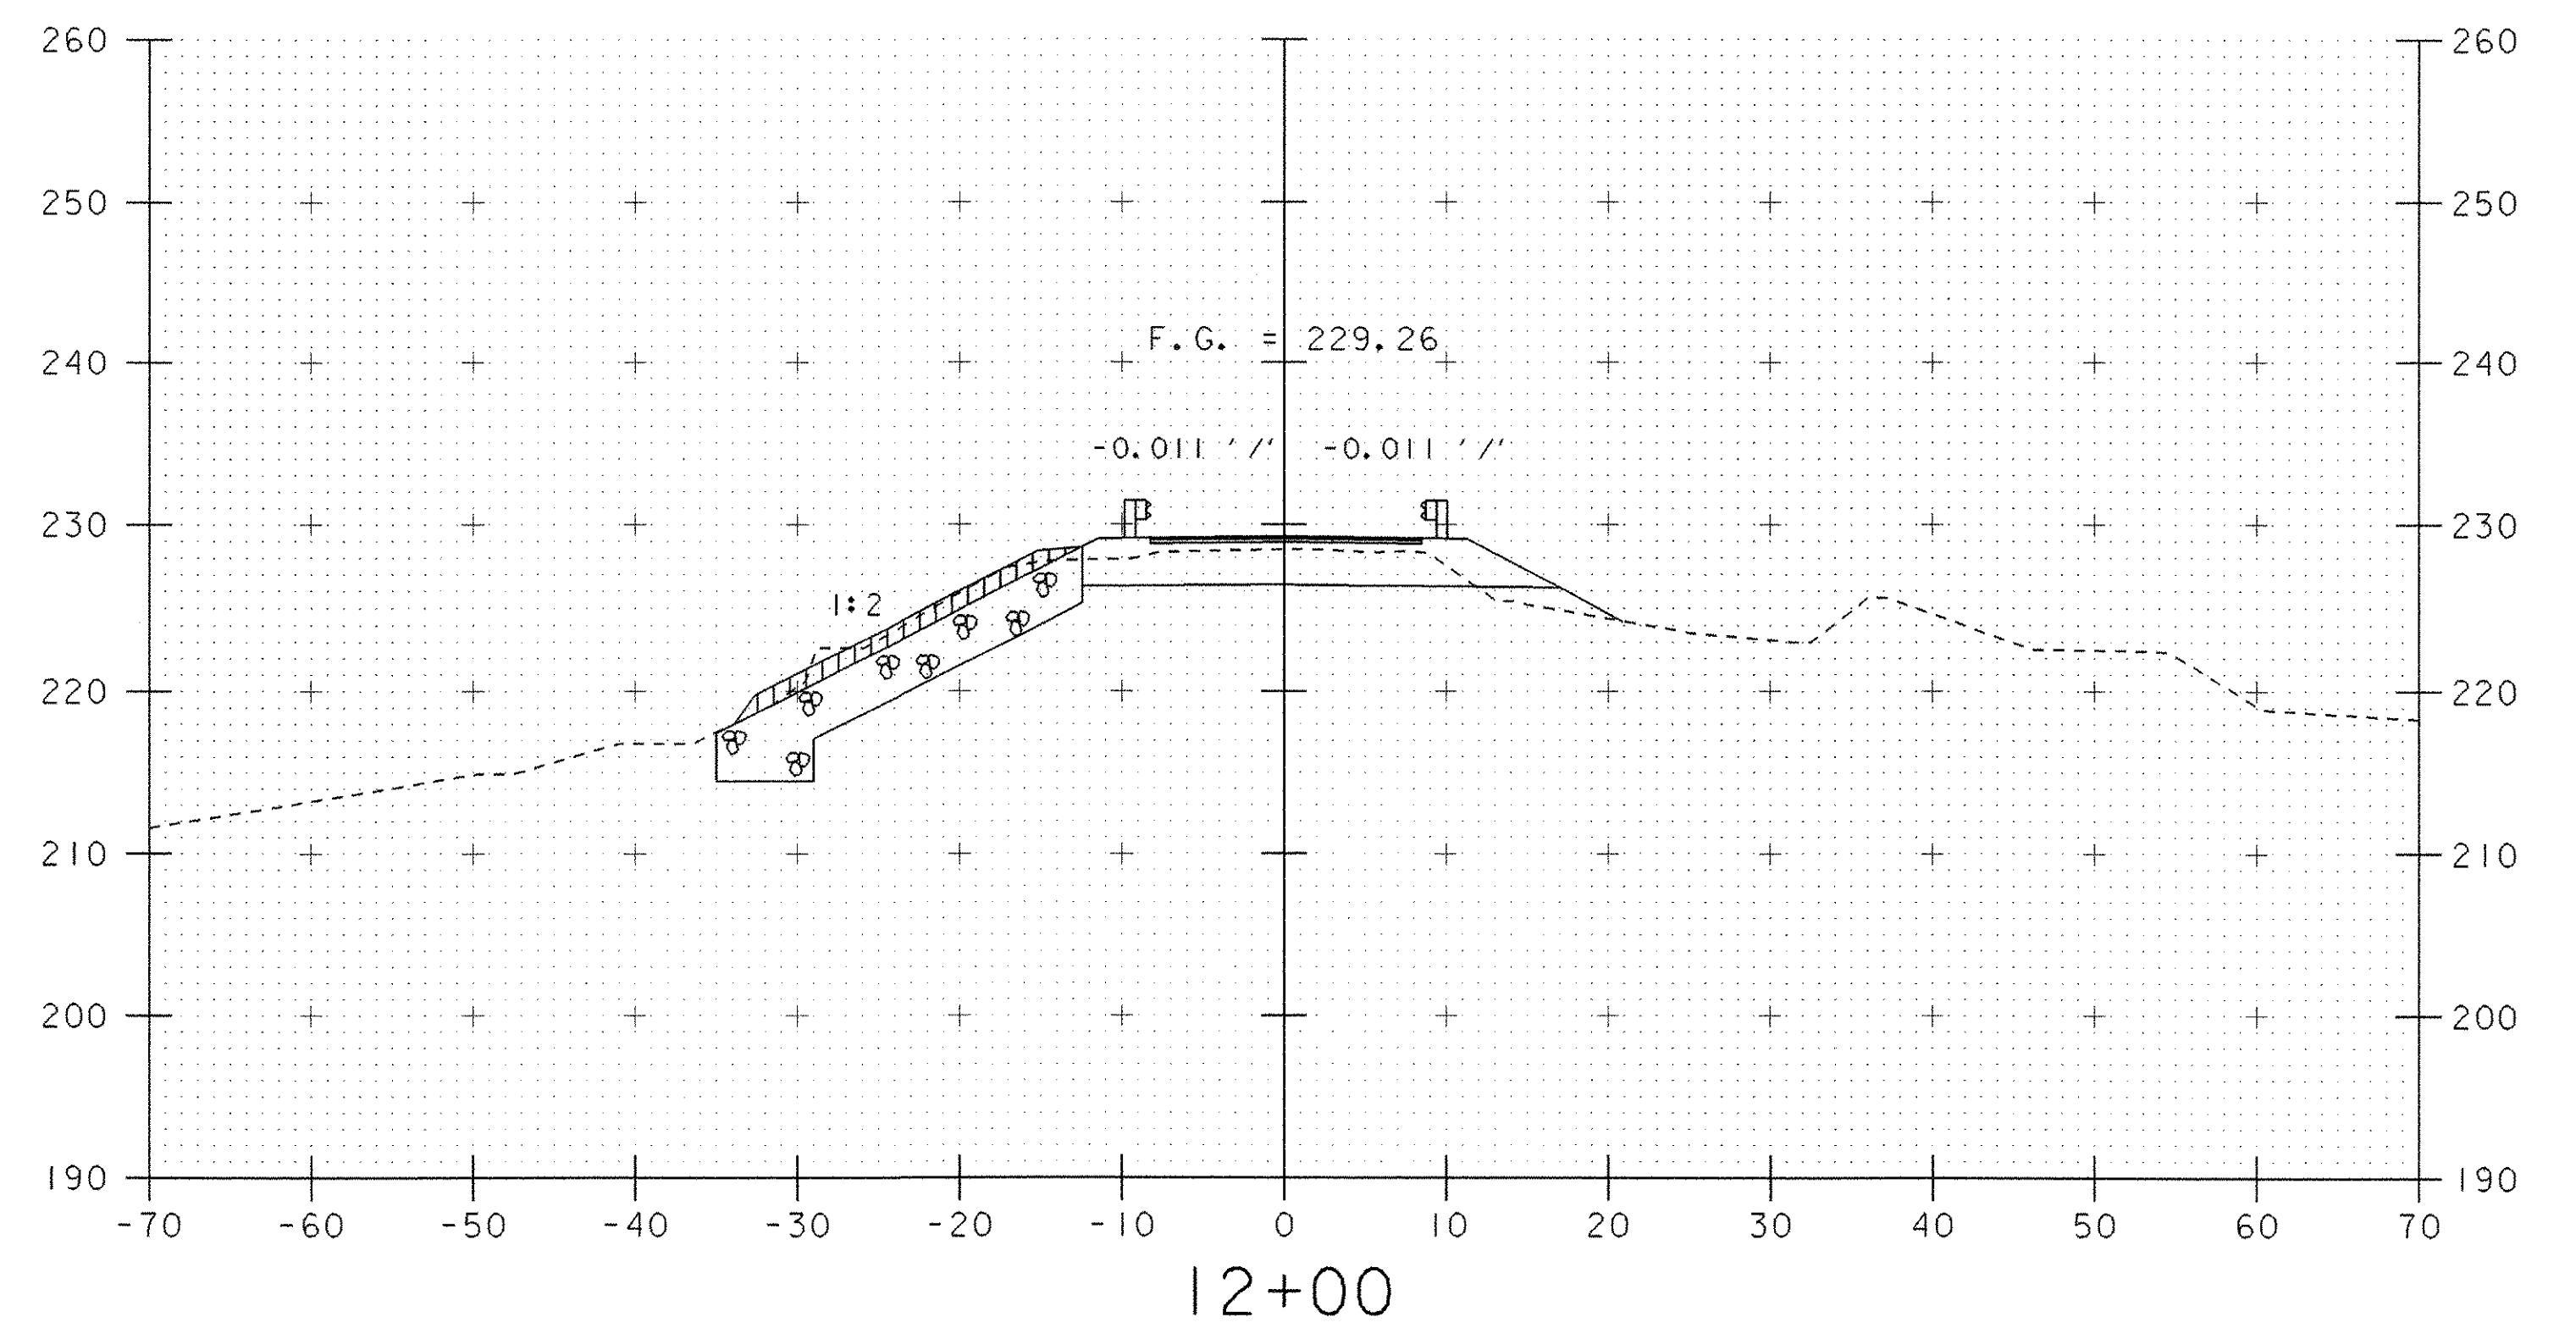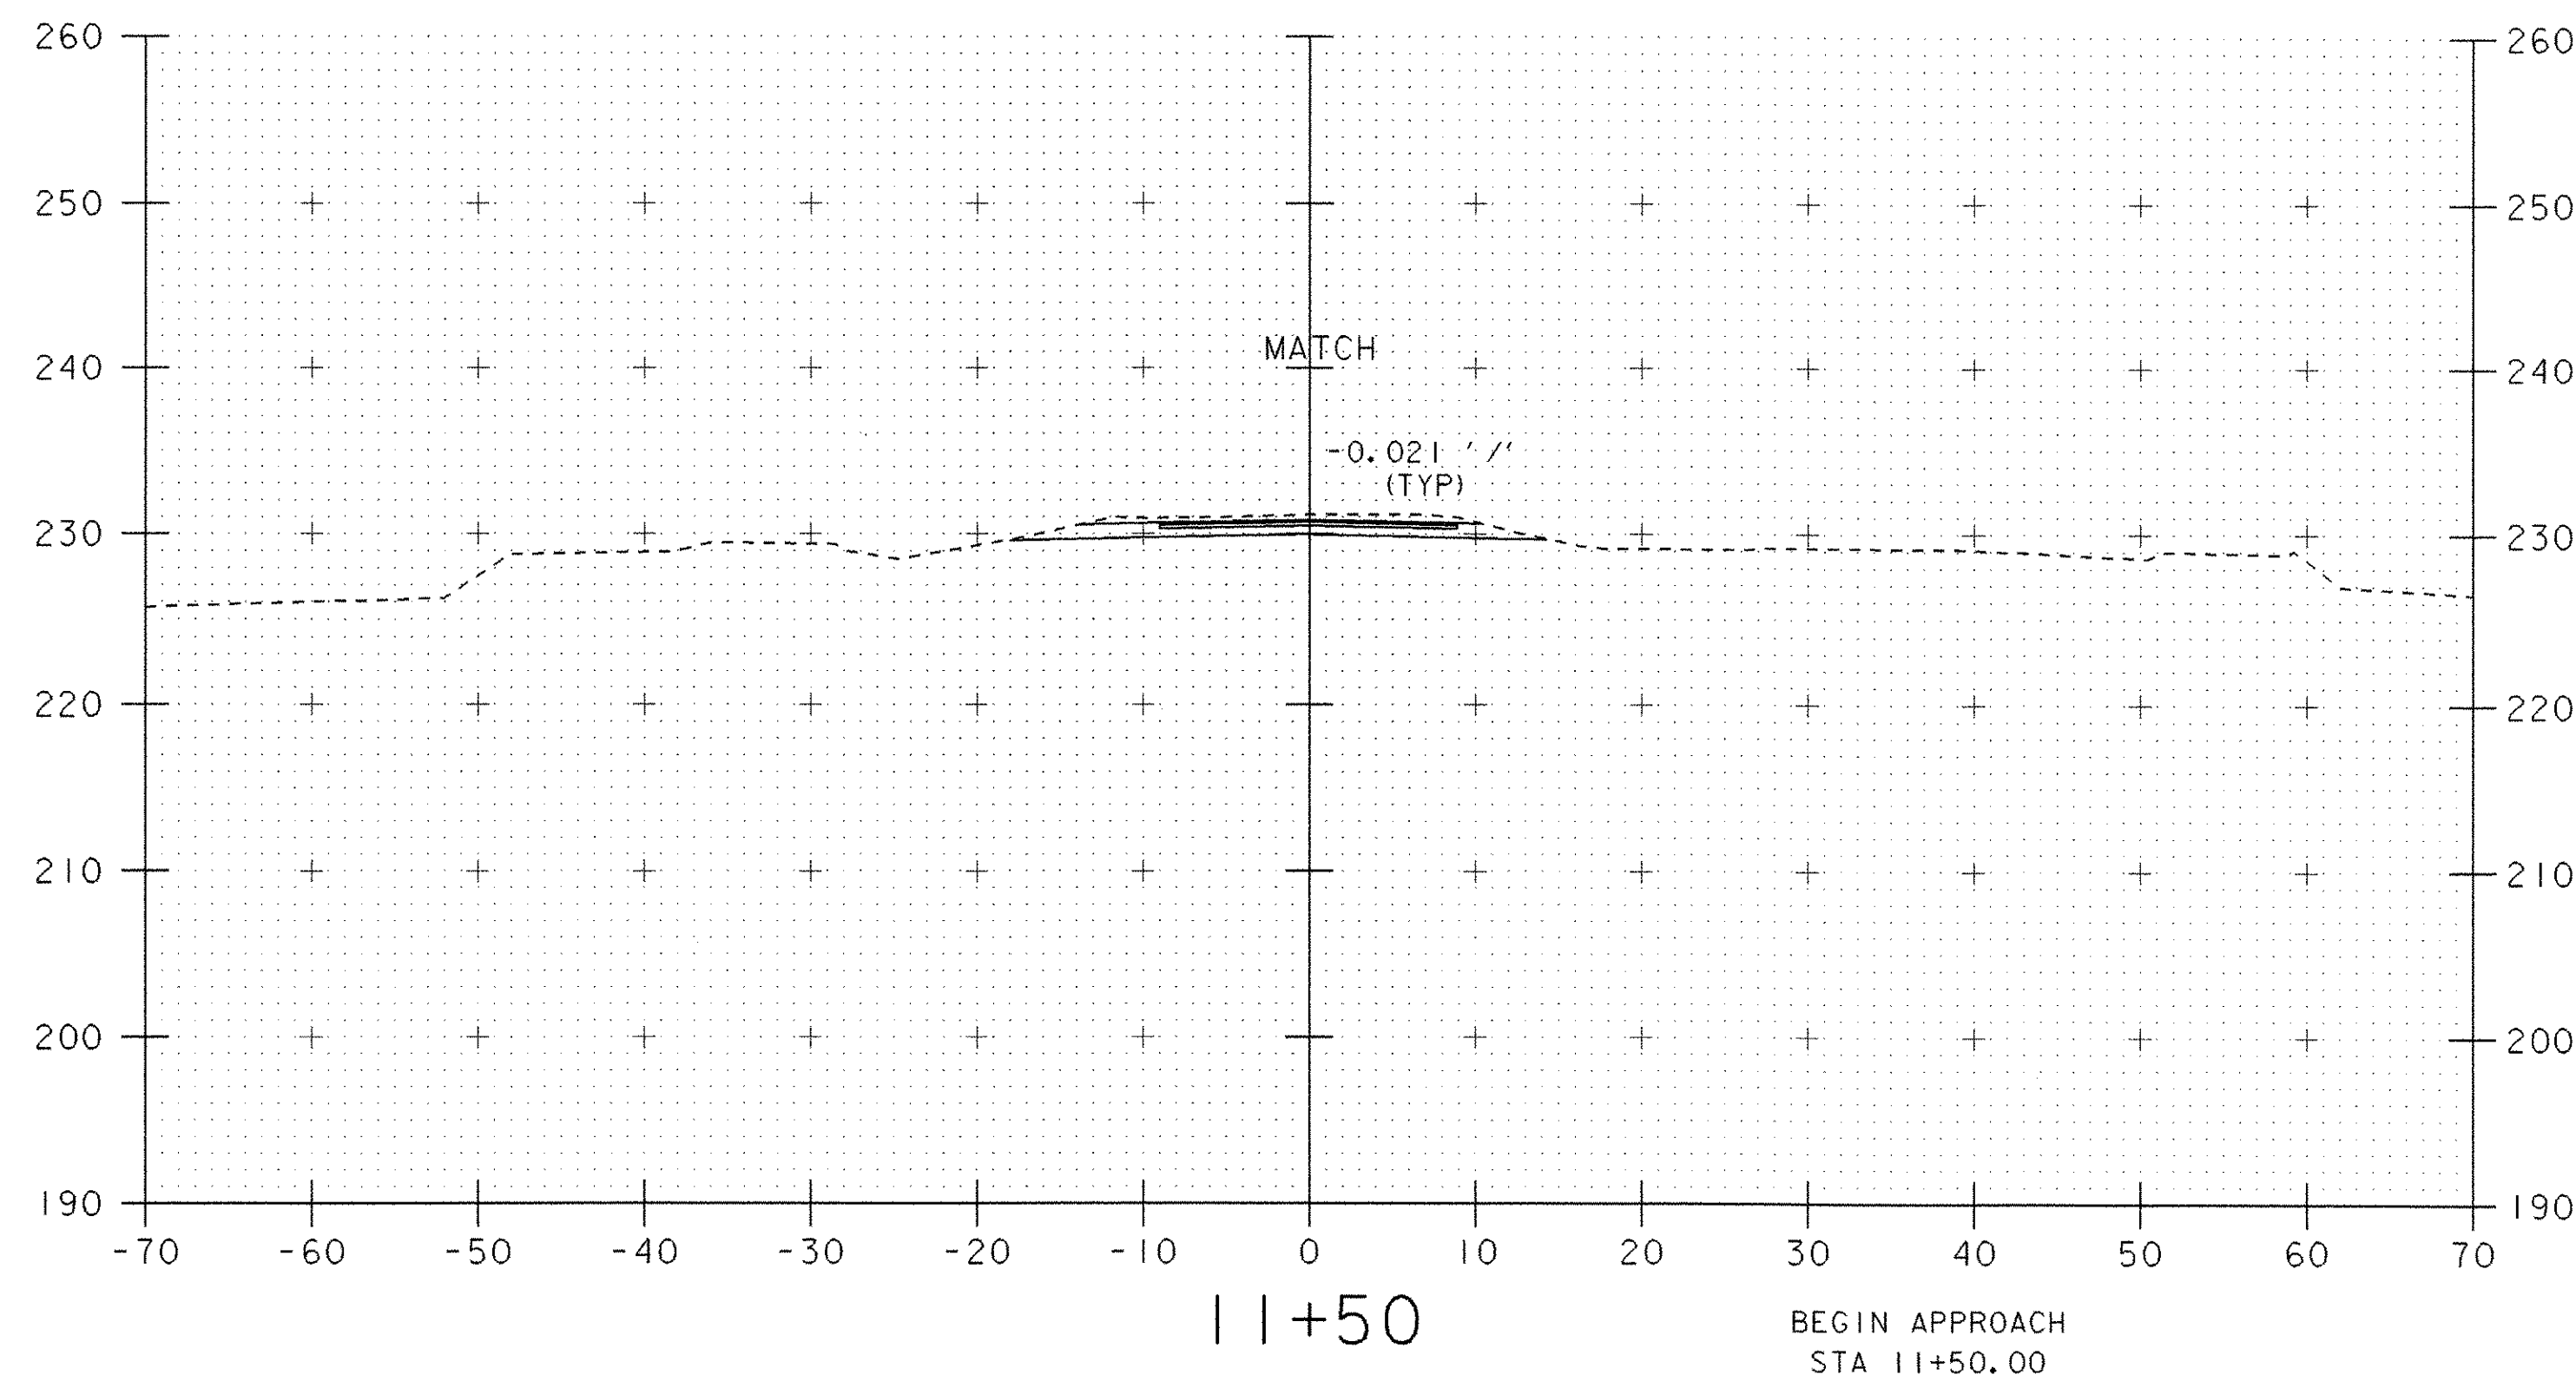

DATUM  
 VERTICAL        NGVD  
 HORIZONTAL        ASSUMED

SCALE 1" = 10'-0"





PROJECT: NEW HAVEN - WEYBRIDGE	PROJECT NO.: BHO-BTN 2005 (1)
DESIGN FILE NAME: /str4/89j081/sj081xs1.dgn	PLOT DATE: 28-FEB-2007
IPARM FILE NAME: sj081m11.i	SURVEY DATE: 7/90
SURVEYED BY: R. MOREAU	DRAWN BY: P.G. JARVIS
SQUAD LEADER: C.P. WILLIAMS	
MAINLINE SECTIONS STA. 11+25 - STA. 12+00 SHEET: 36 OF 53	

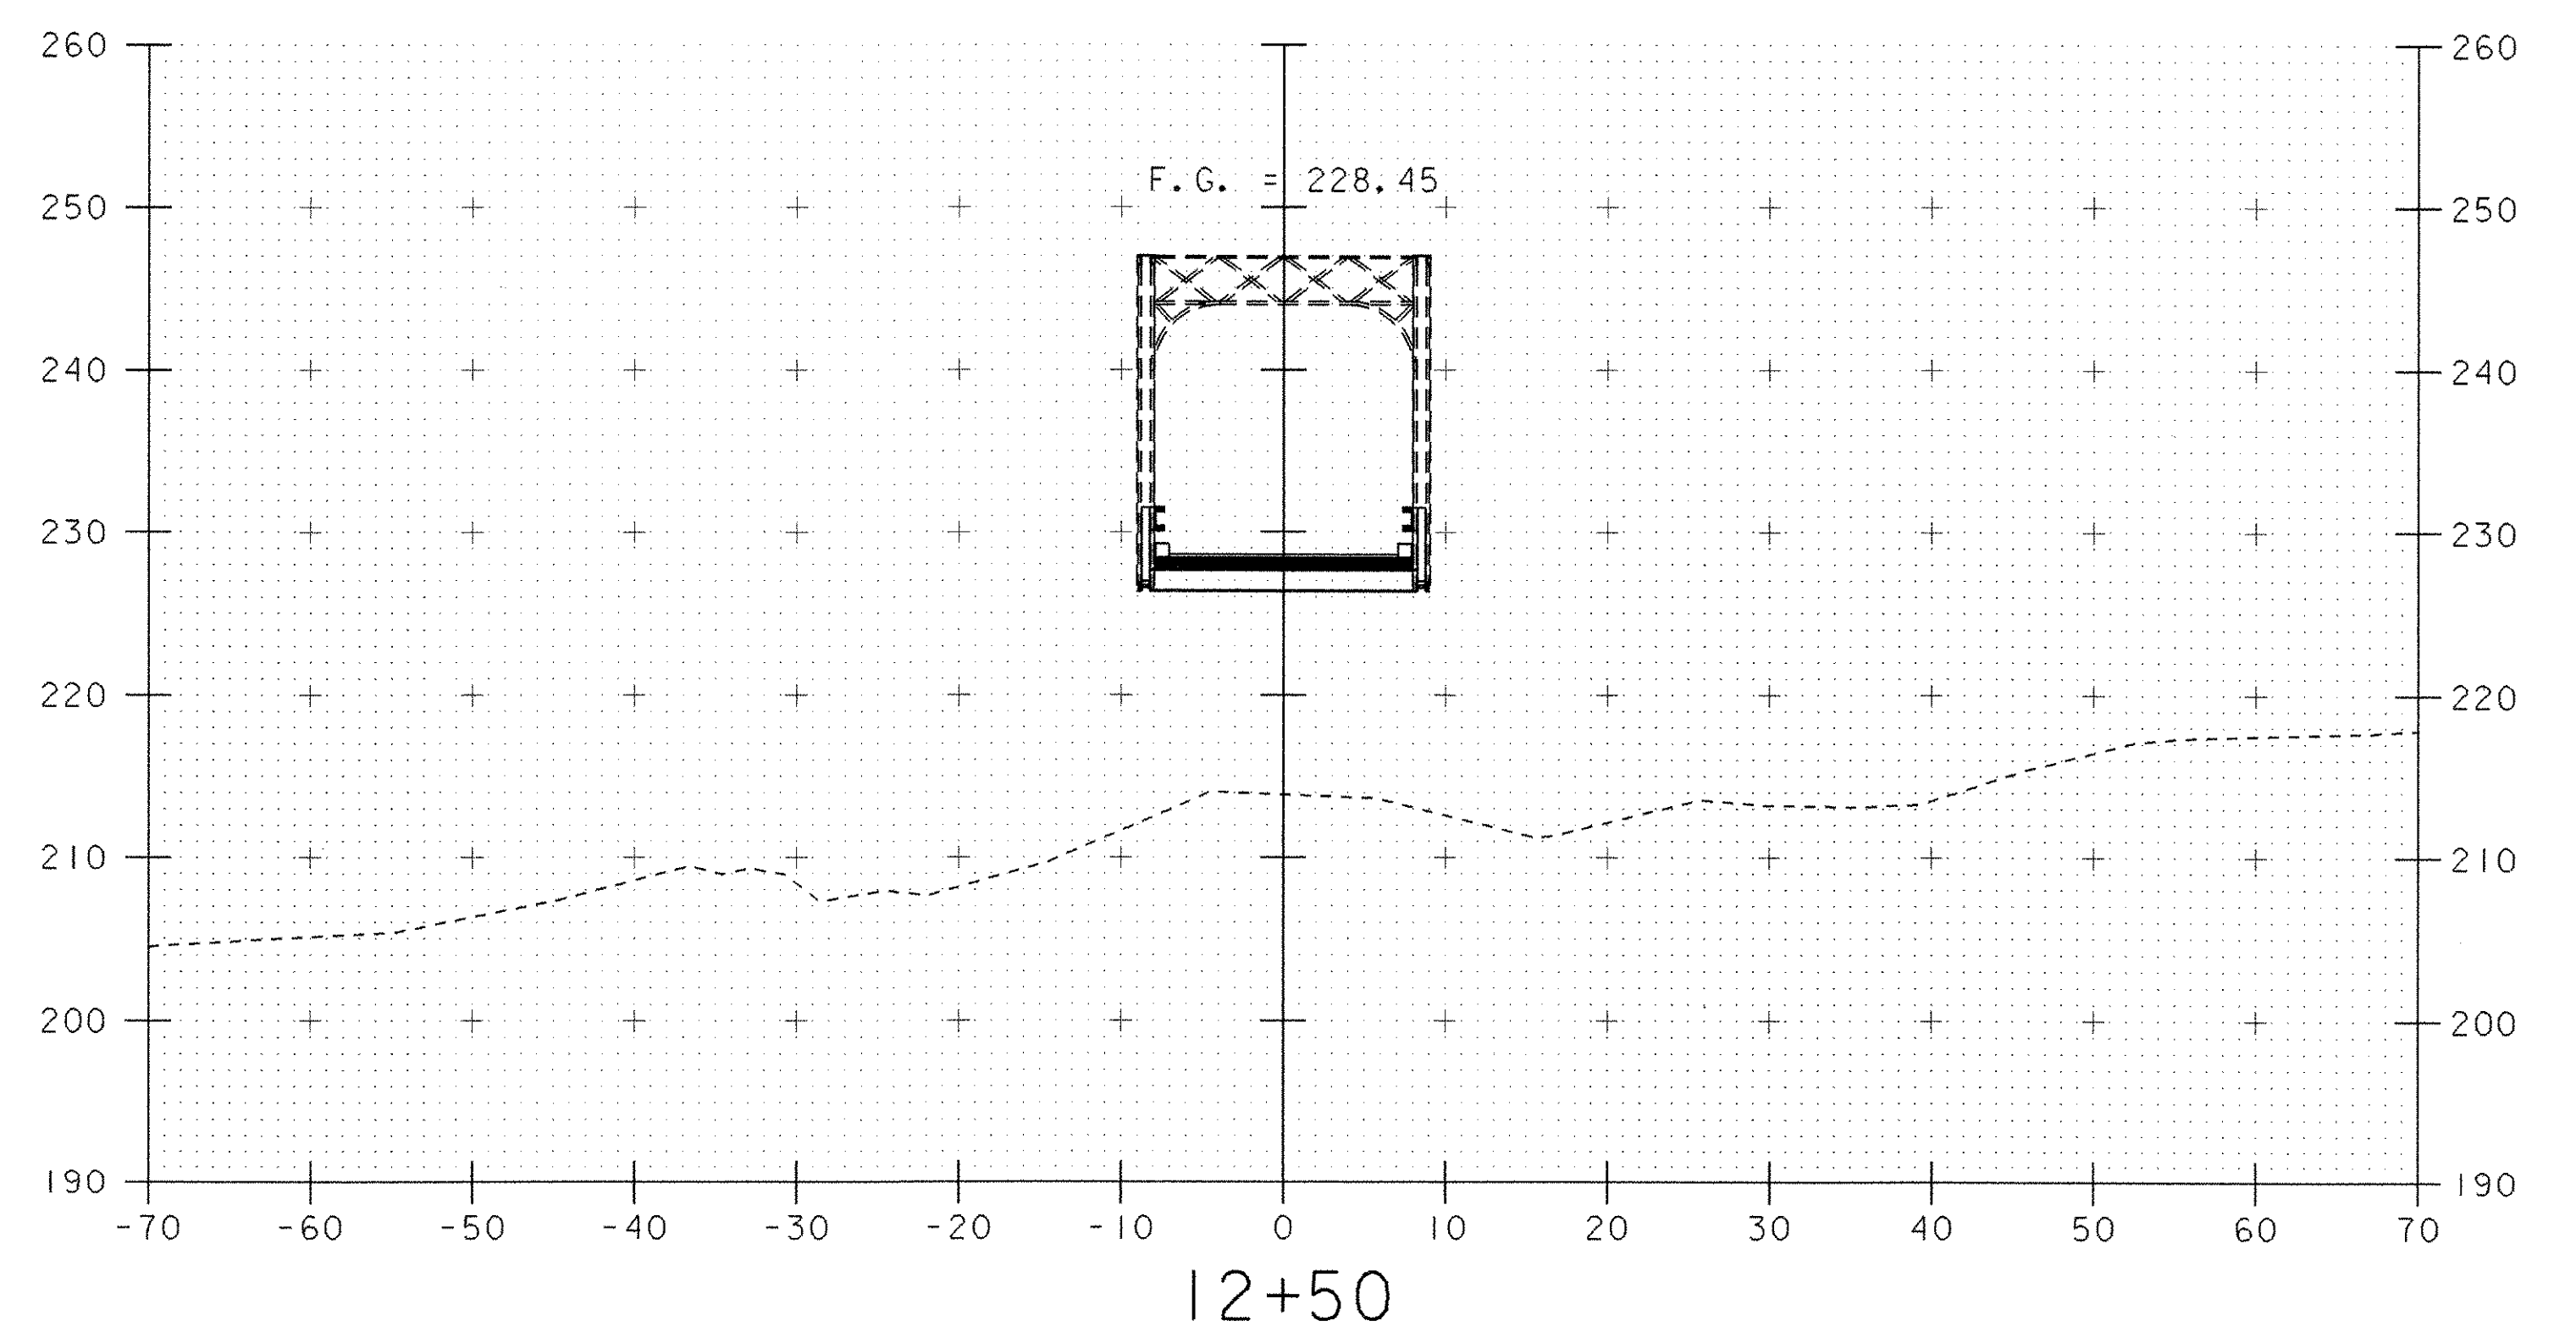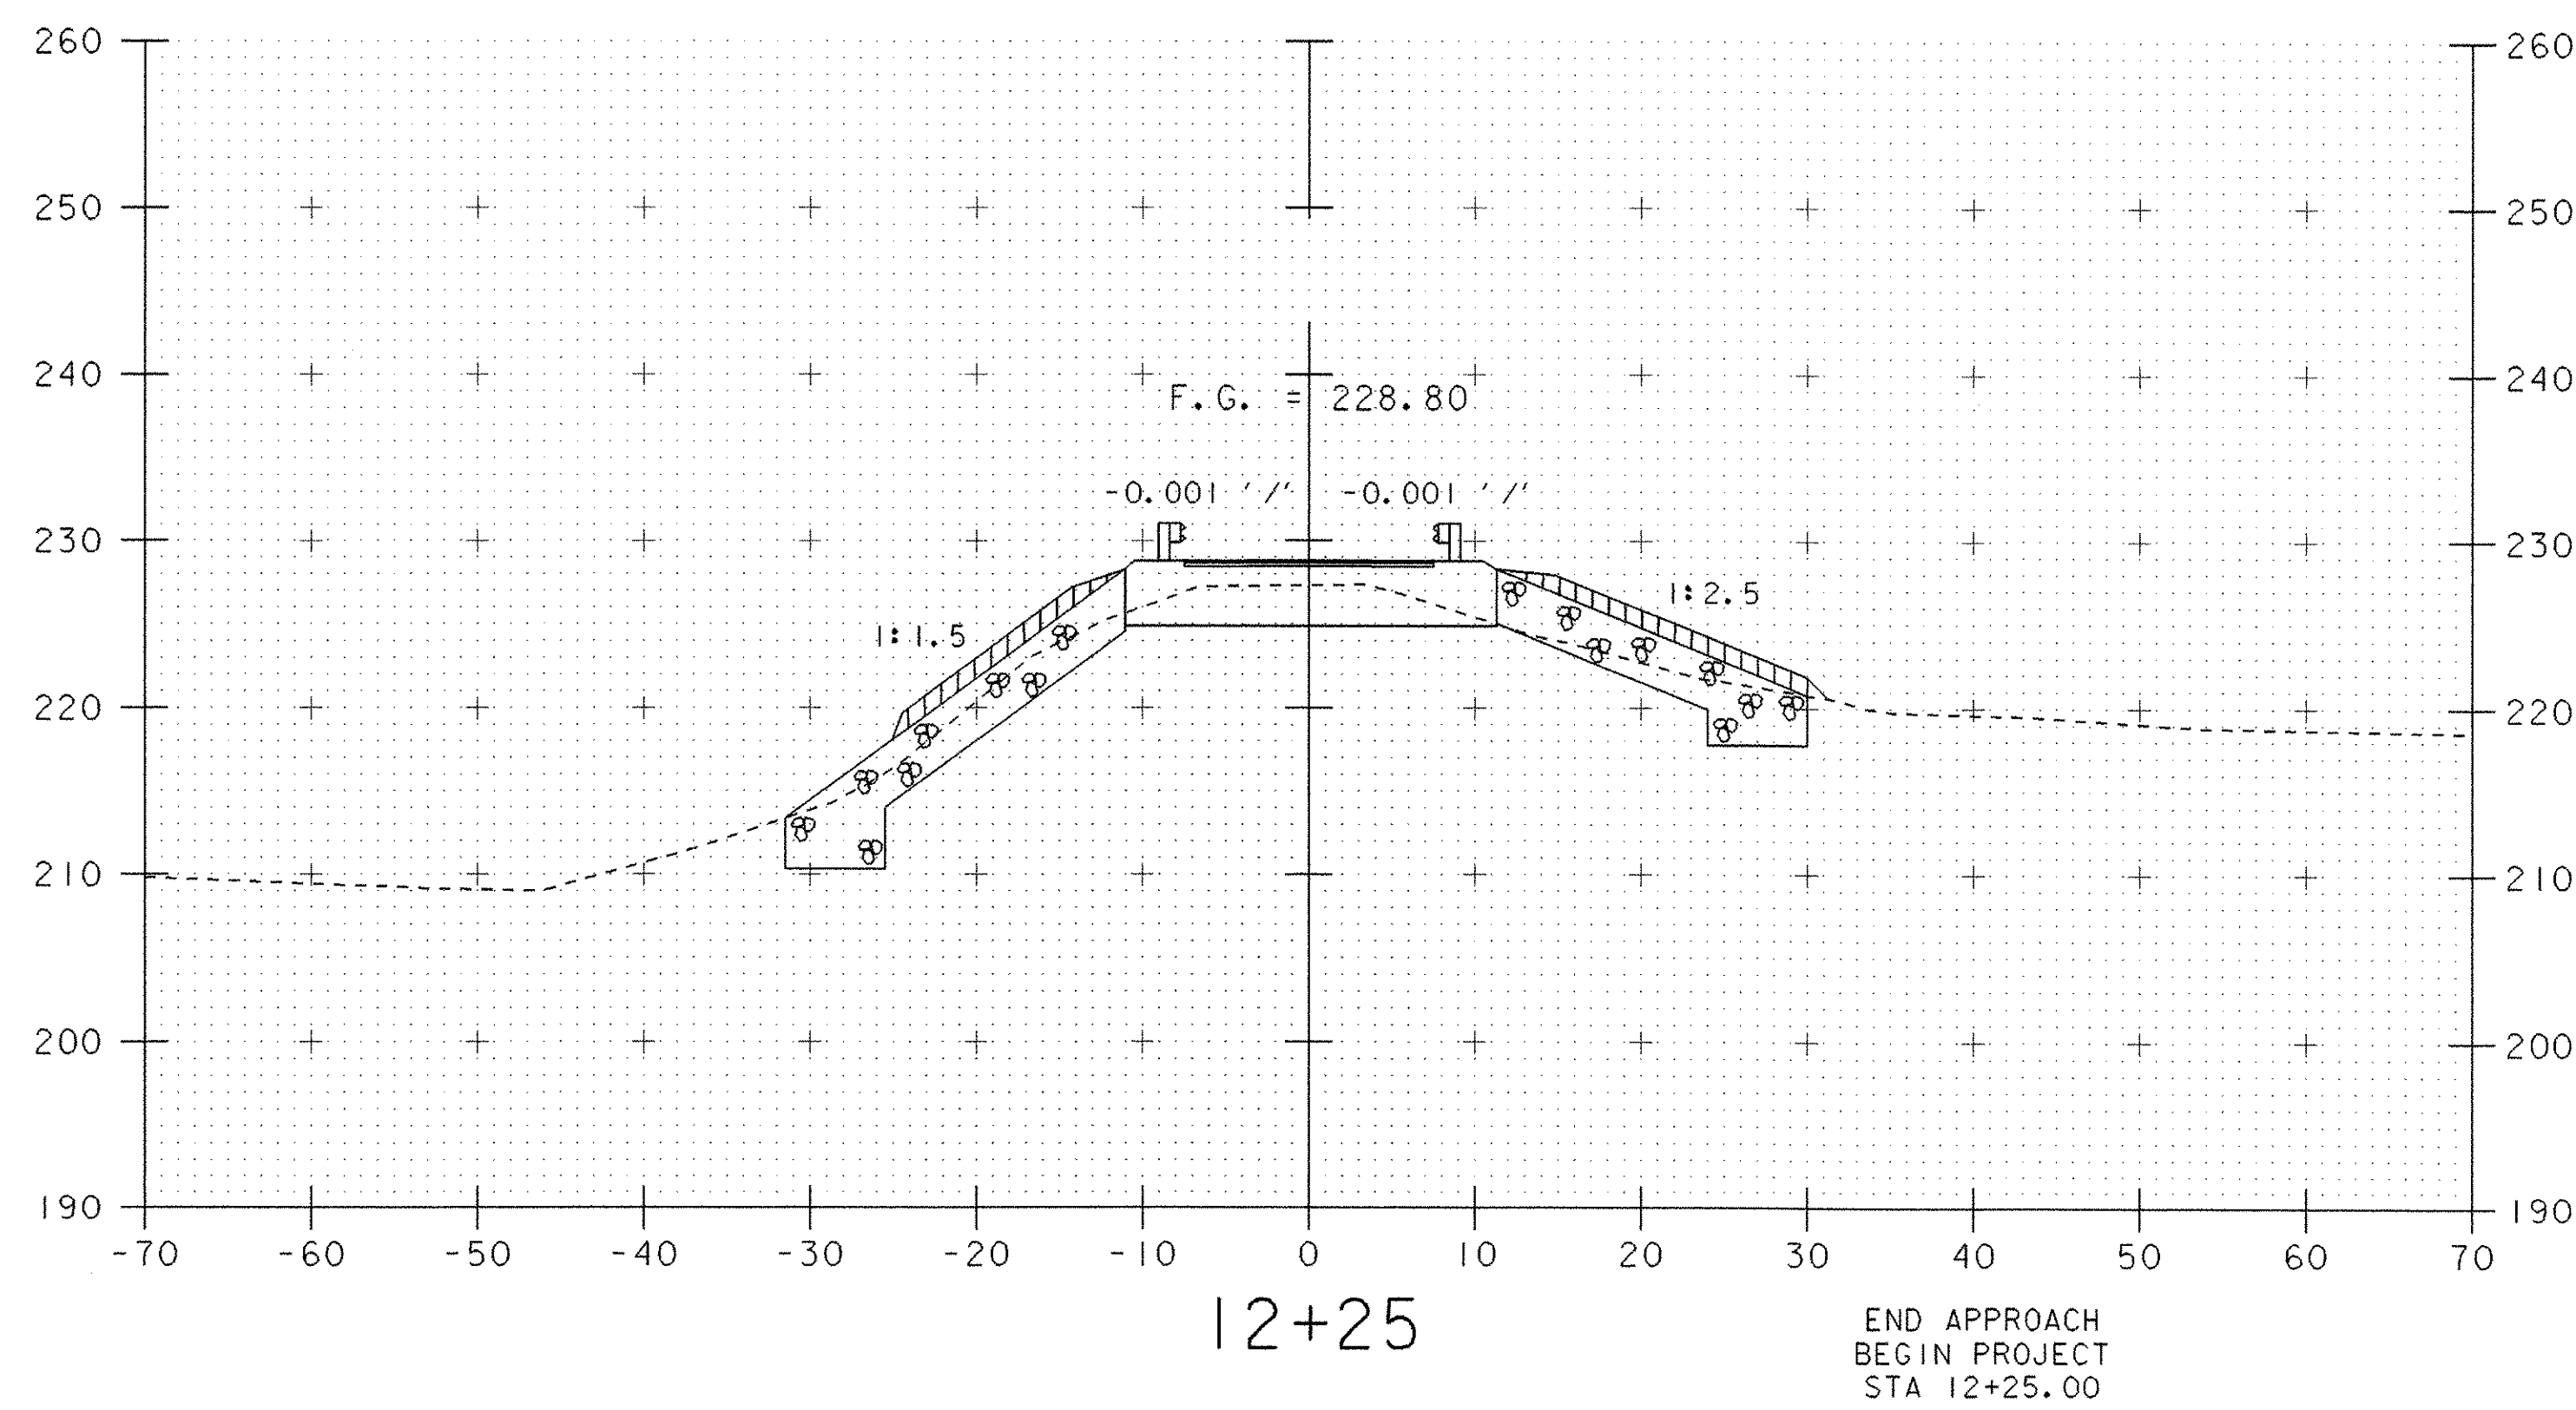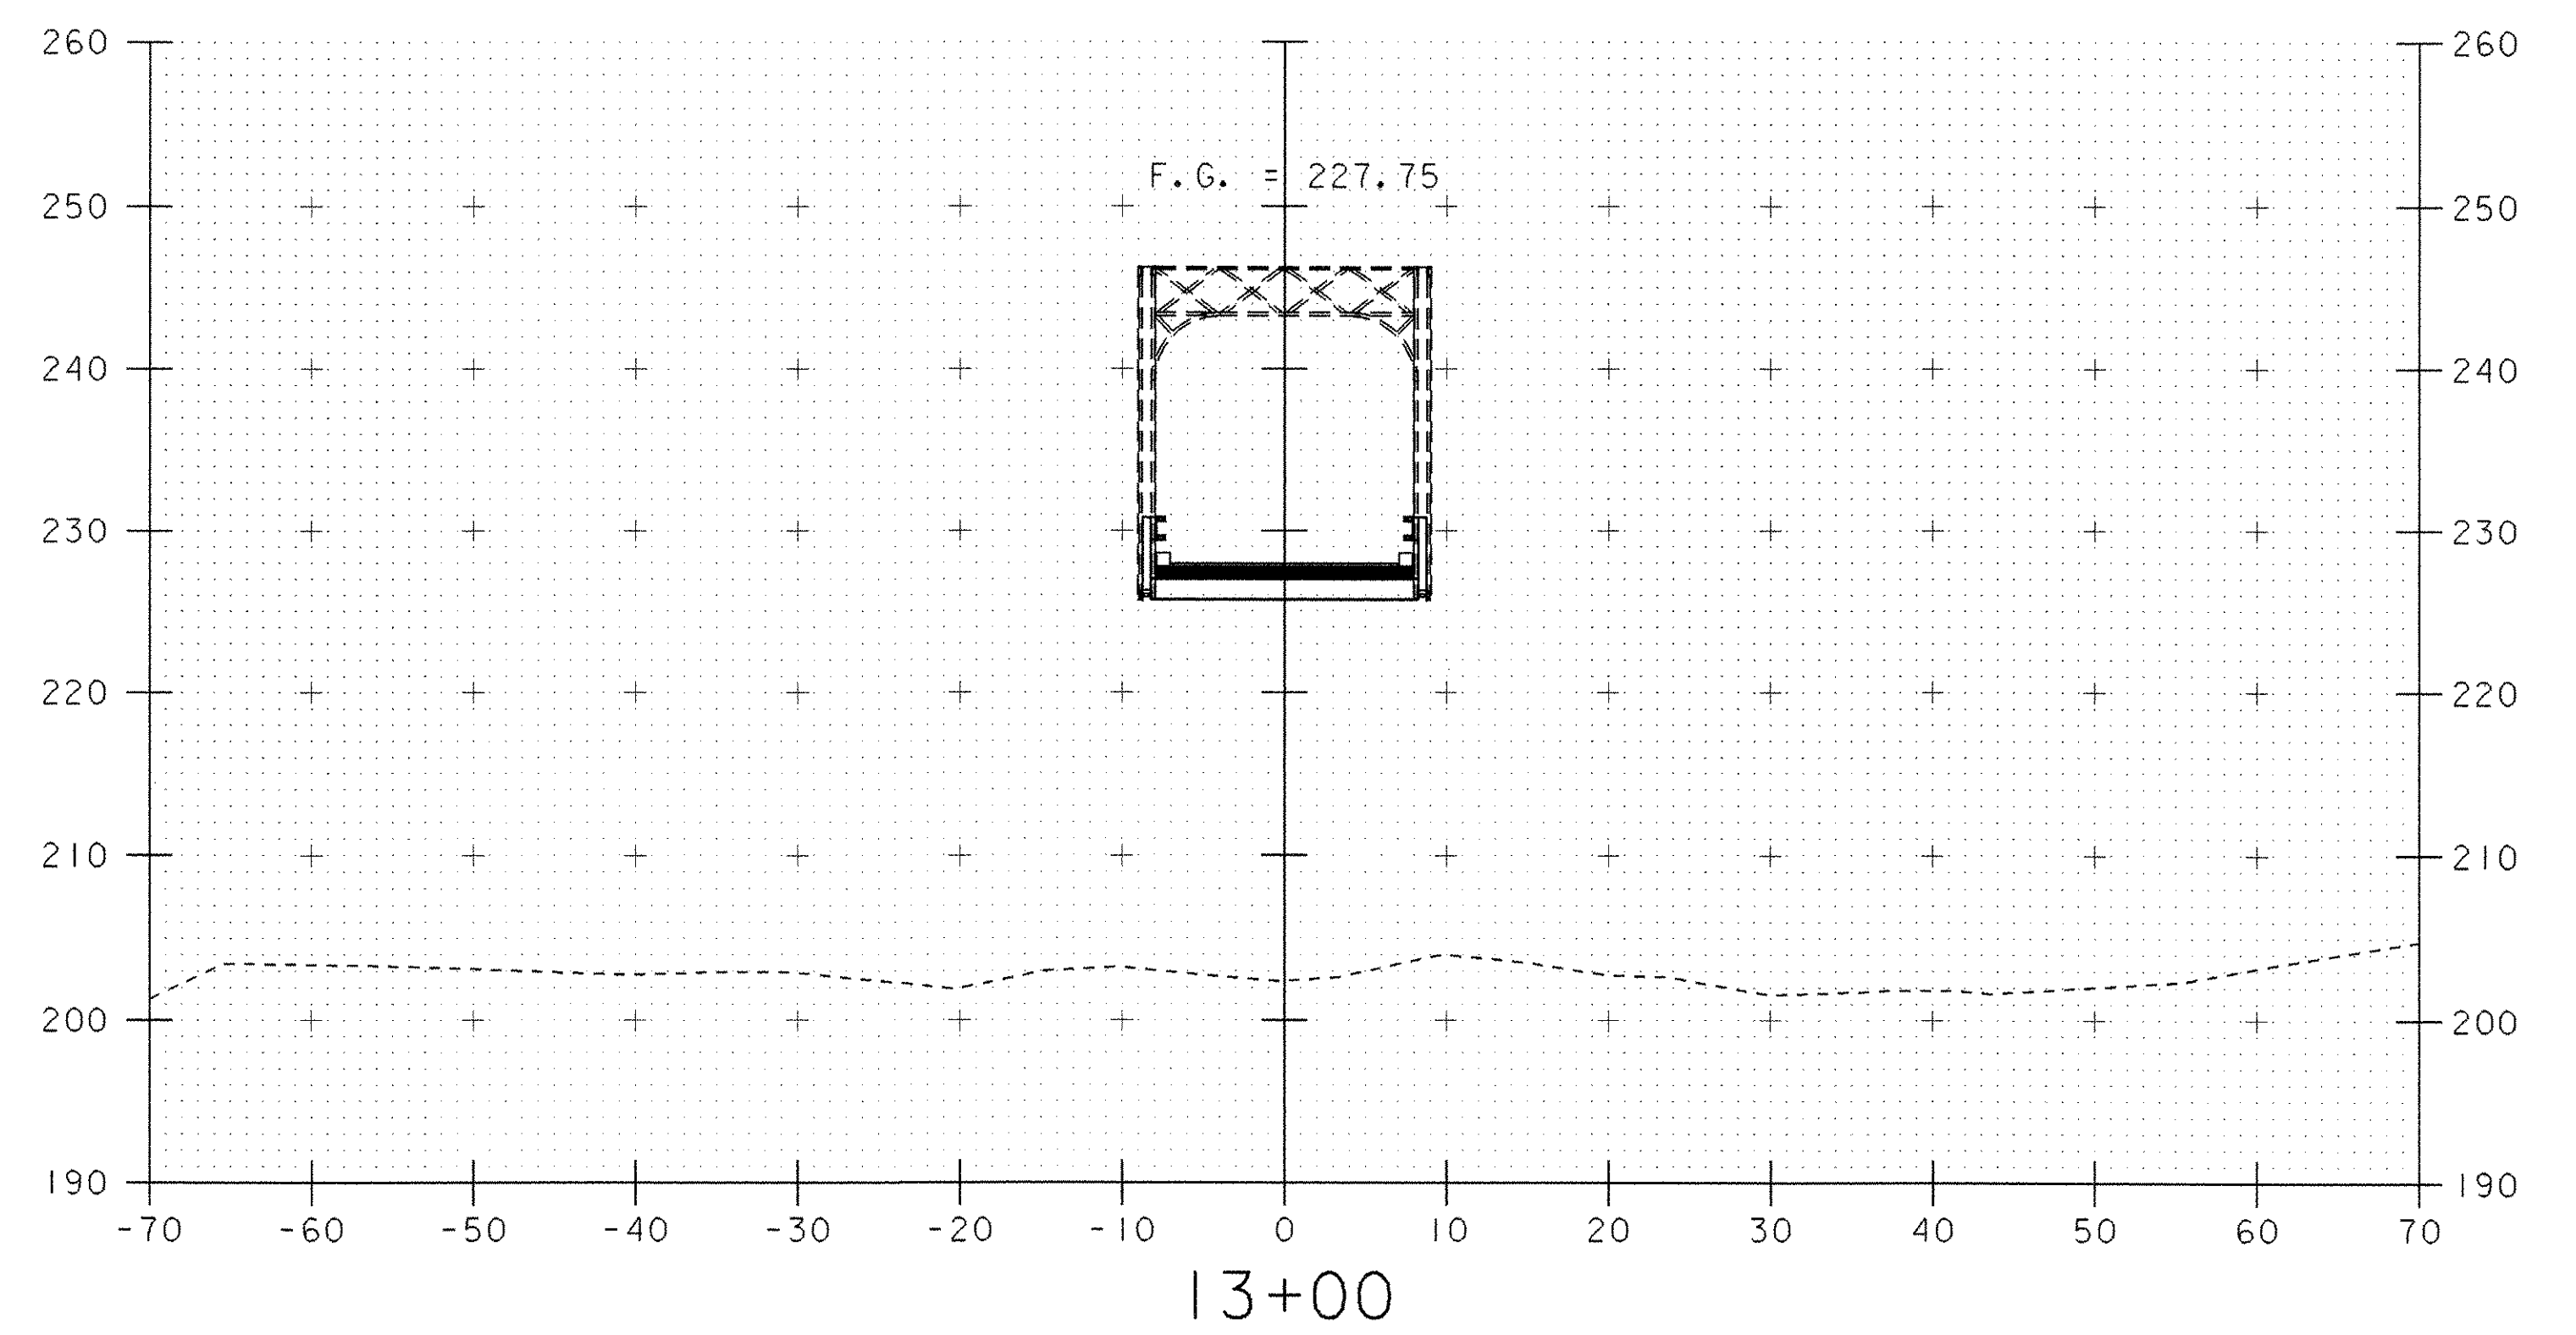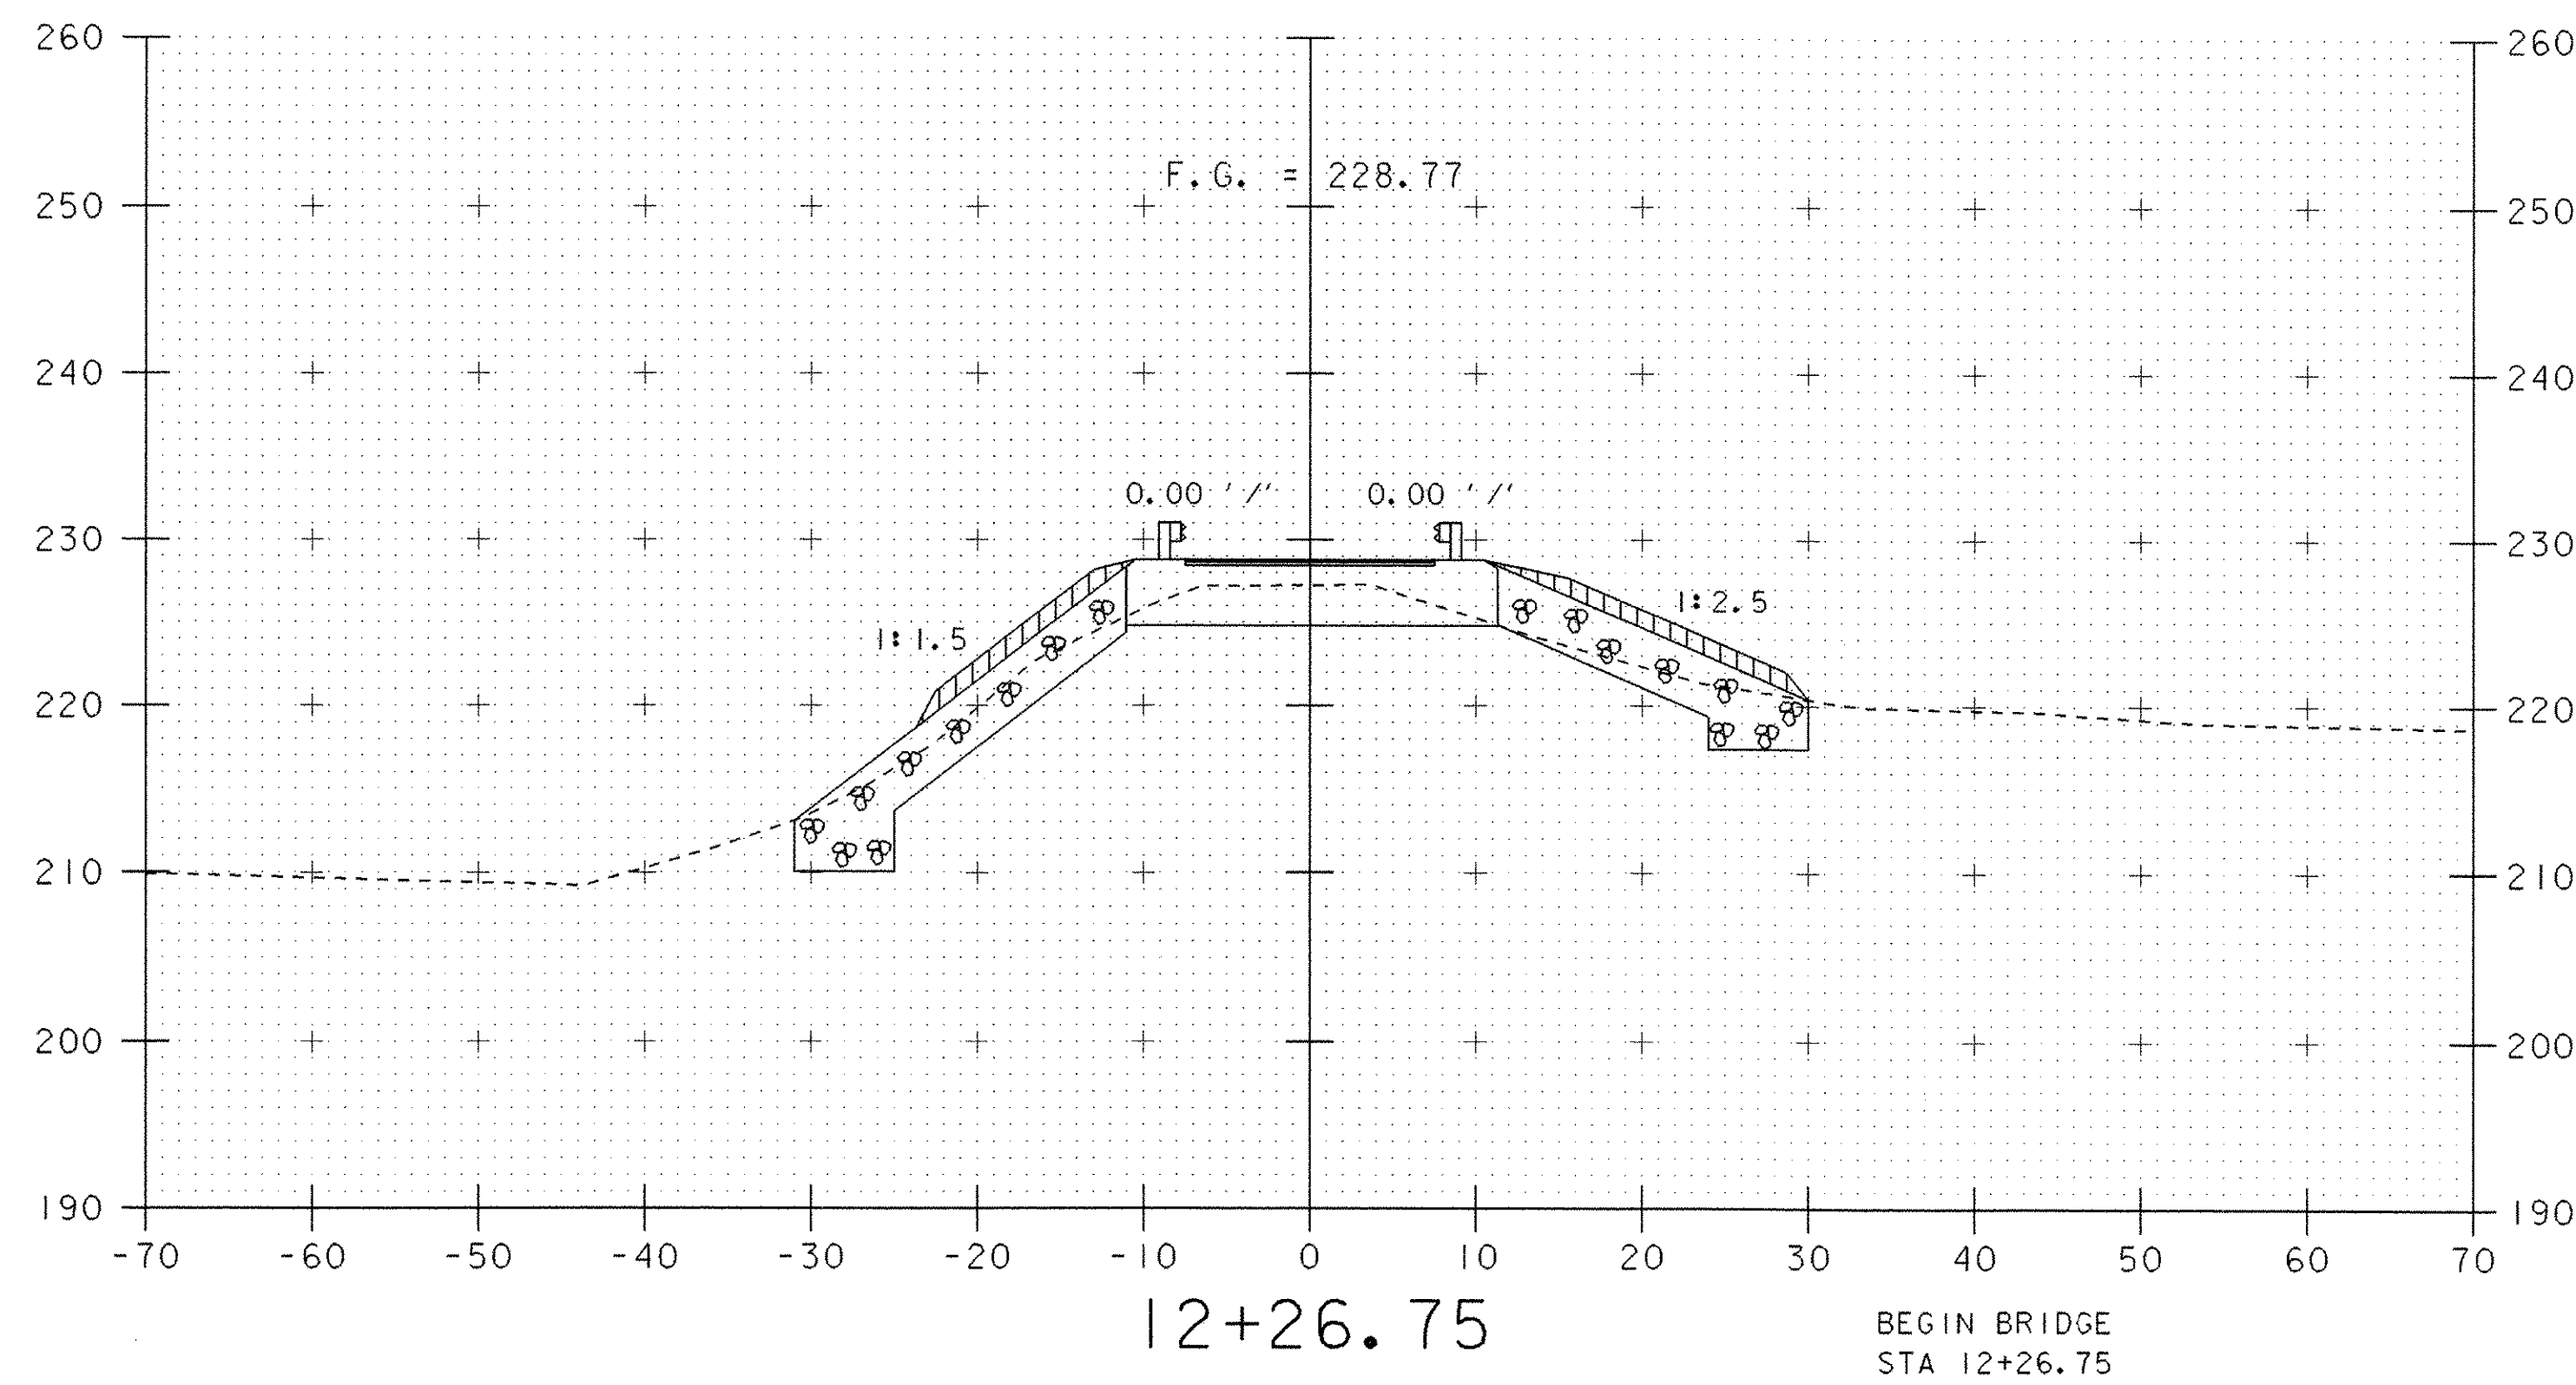

DATUM  
VERTICAL NGVD  
HORIZONTAL ASSUMED

SCALE 1" = 10'-0"  
0 10


PROJECT: NEW HAVEN - WEYBRIDGE	PROJECT NO.: BHO-BTN 2005 (1)
DESIGN FILE NAME: /str4/89j081/sj081xs1.dgn	PLOT DATE: 28-FEB-2007
IPARM FILE NAME: sj081m12.i	SURVEY DATE: 7/90
SURVEYED BY: R. MOREAU	DRAWN BY: P. G. JARVIS
SQUAD LEADER: C. P. WILLIAMS	MAINLINE SECTIONS STA. 12+25 - STA. 13+00 SHEET: 37 OF 53

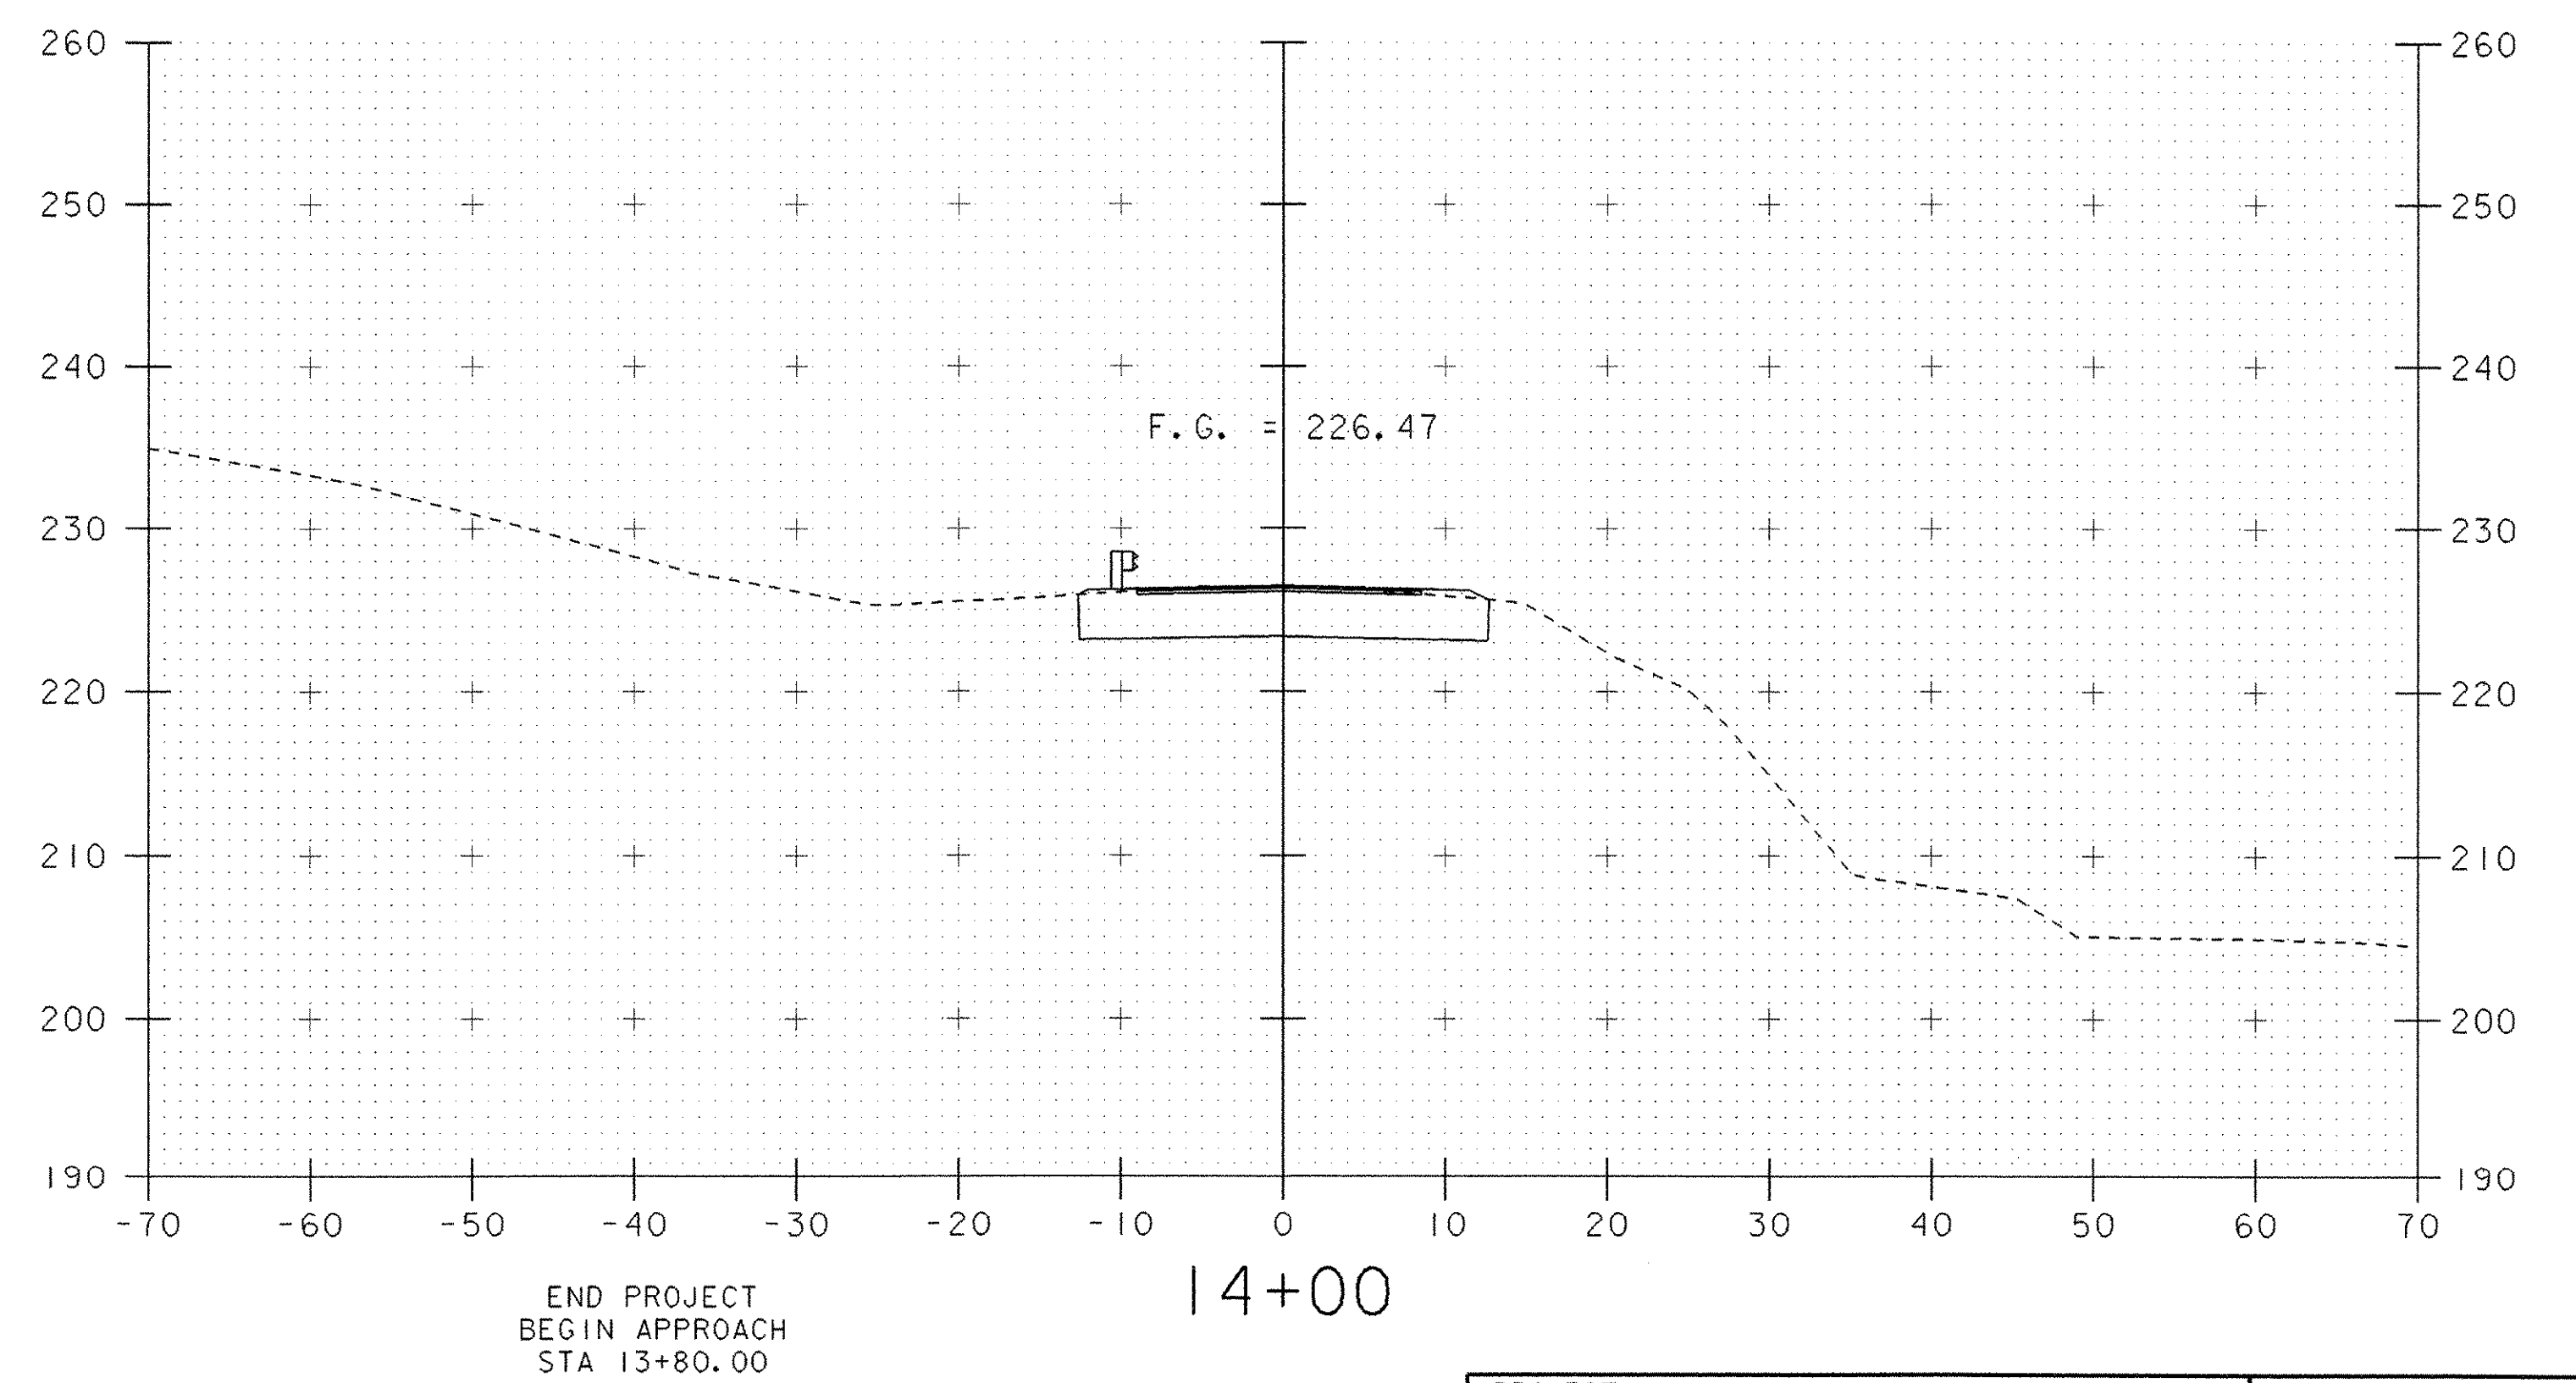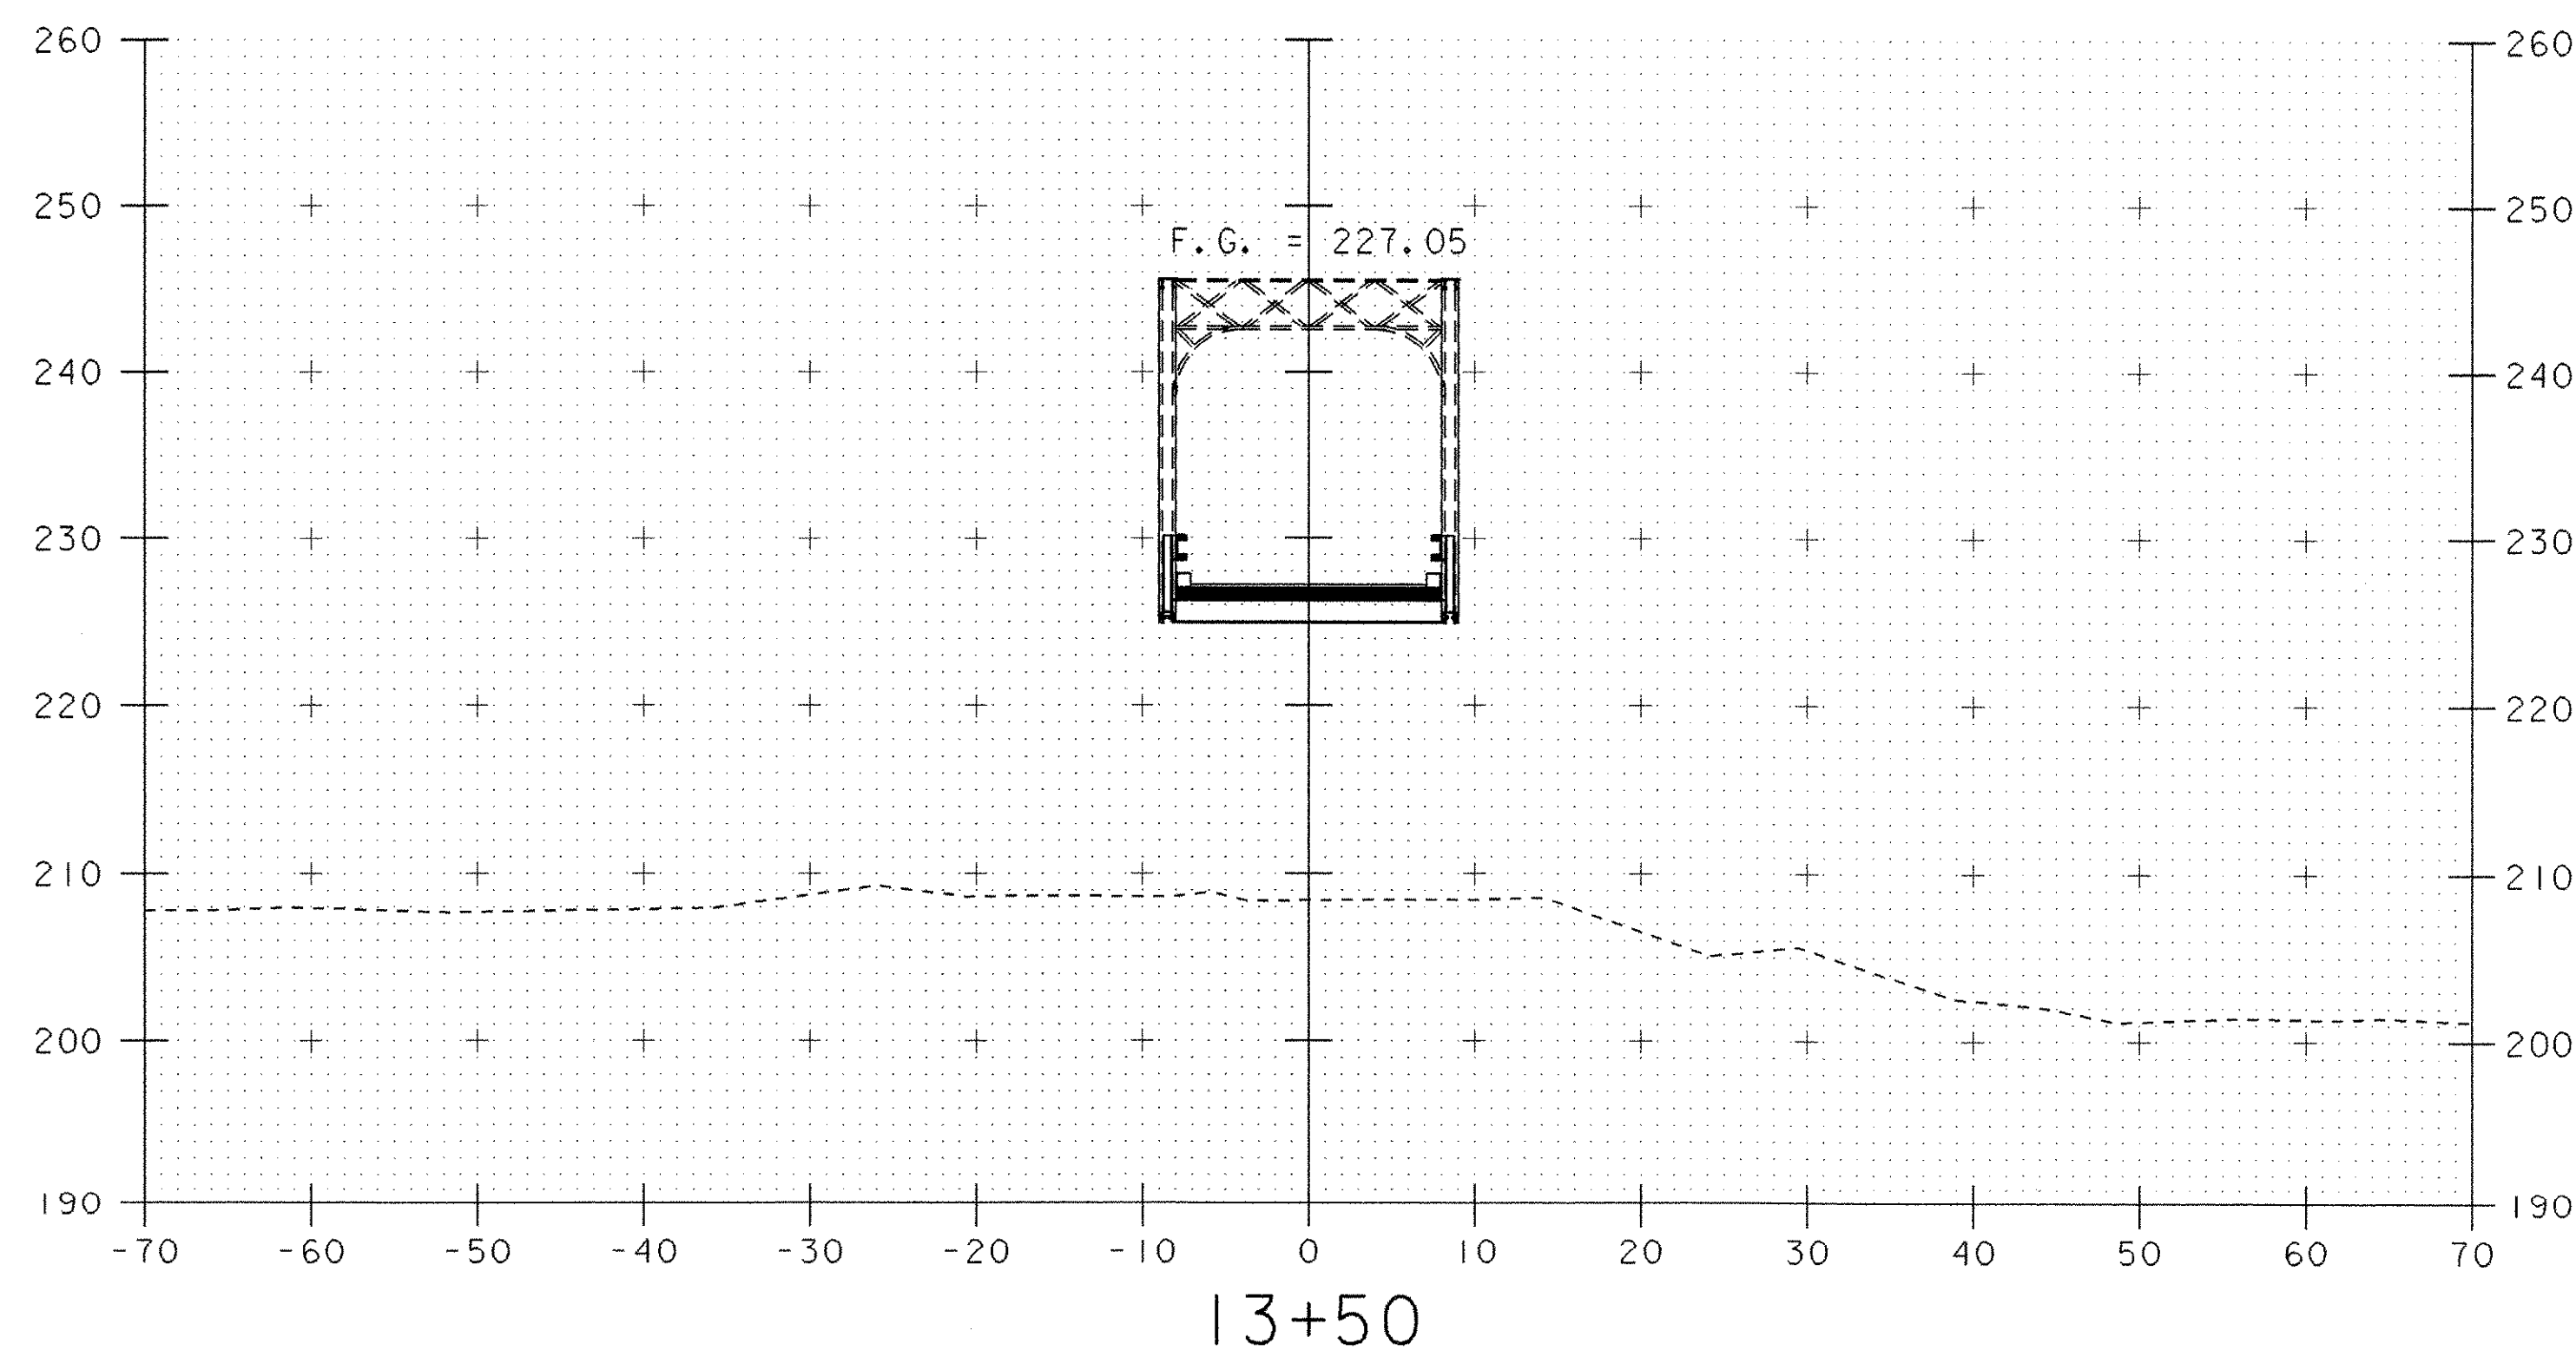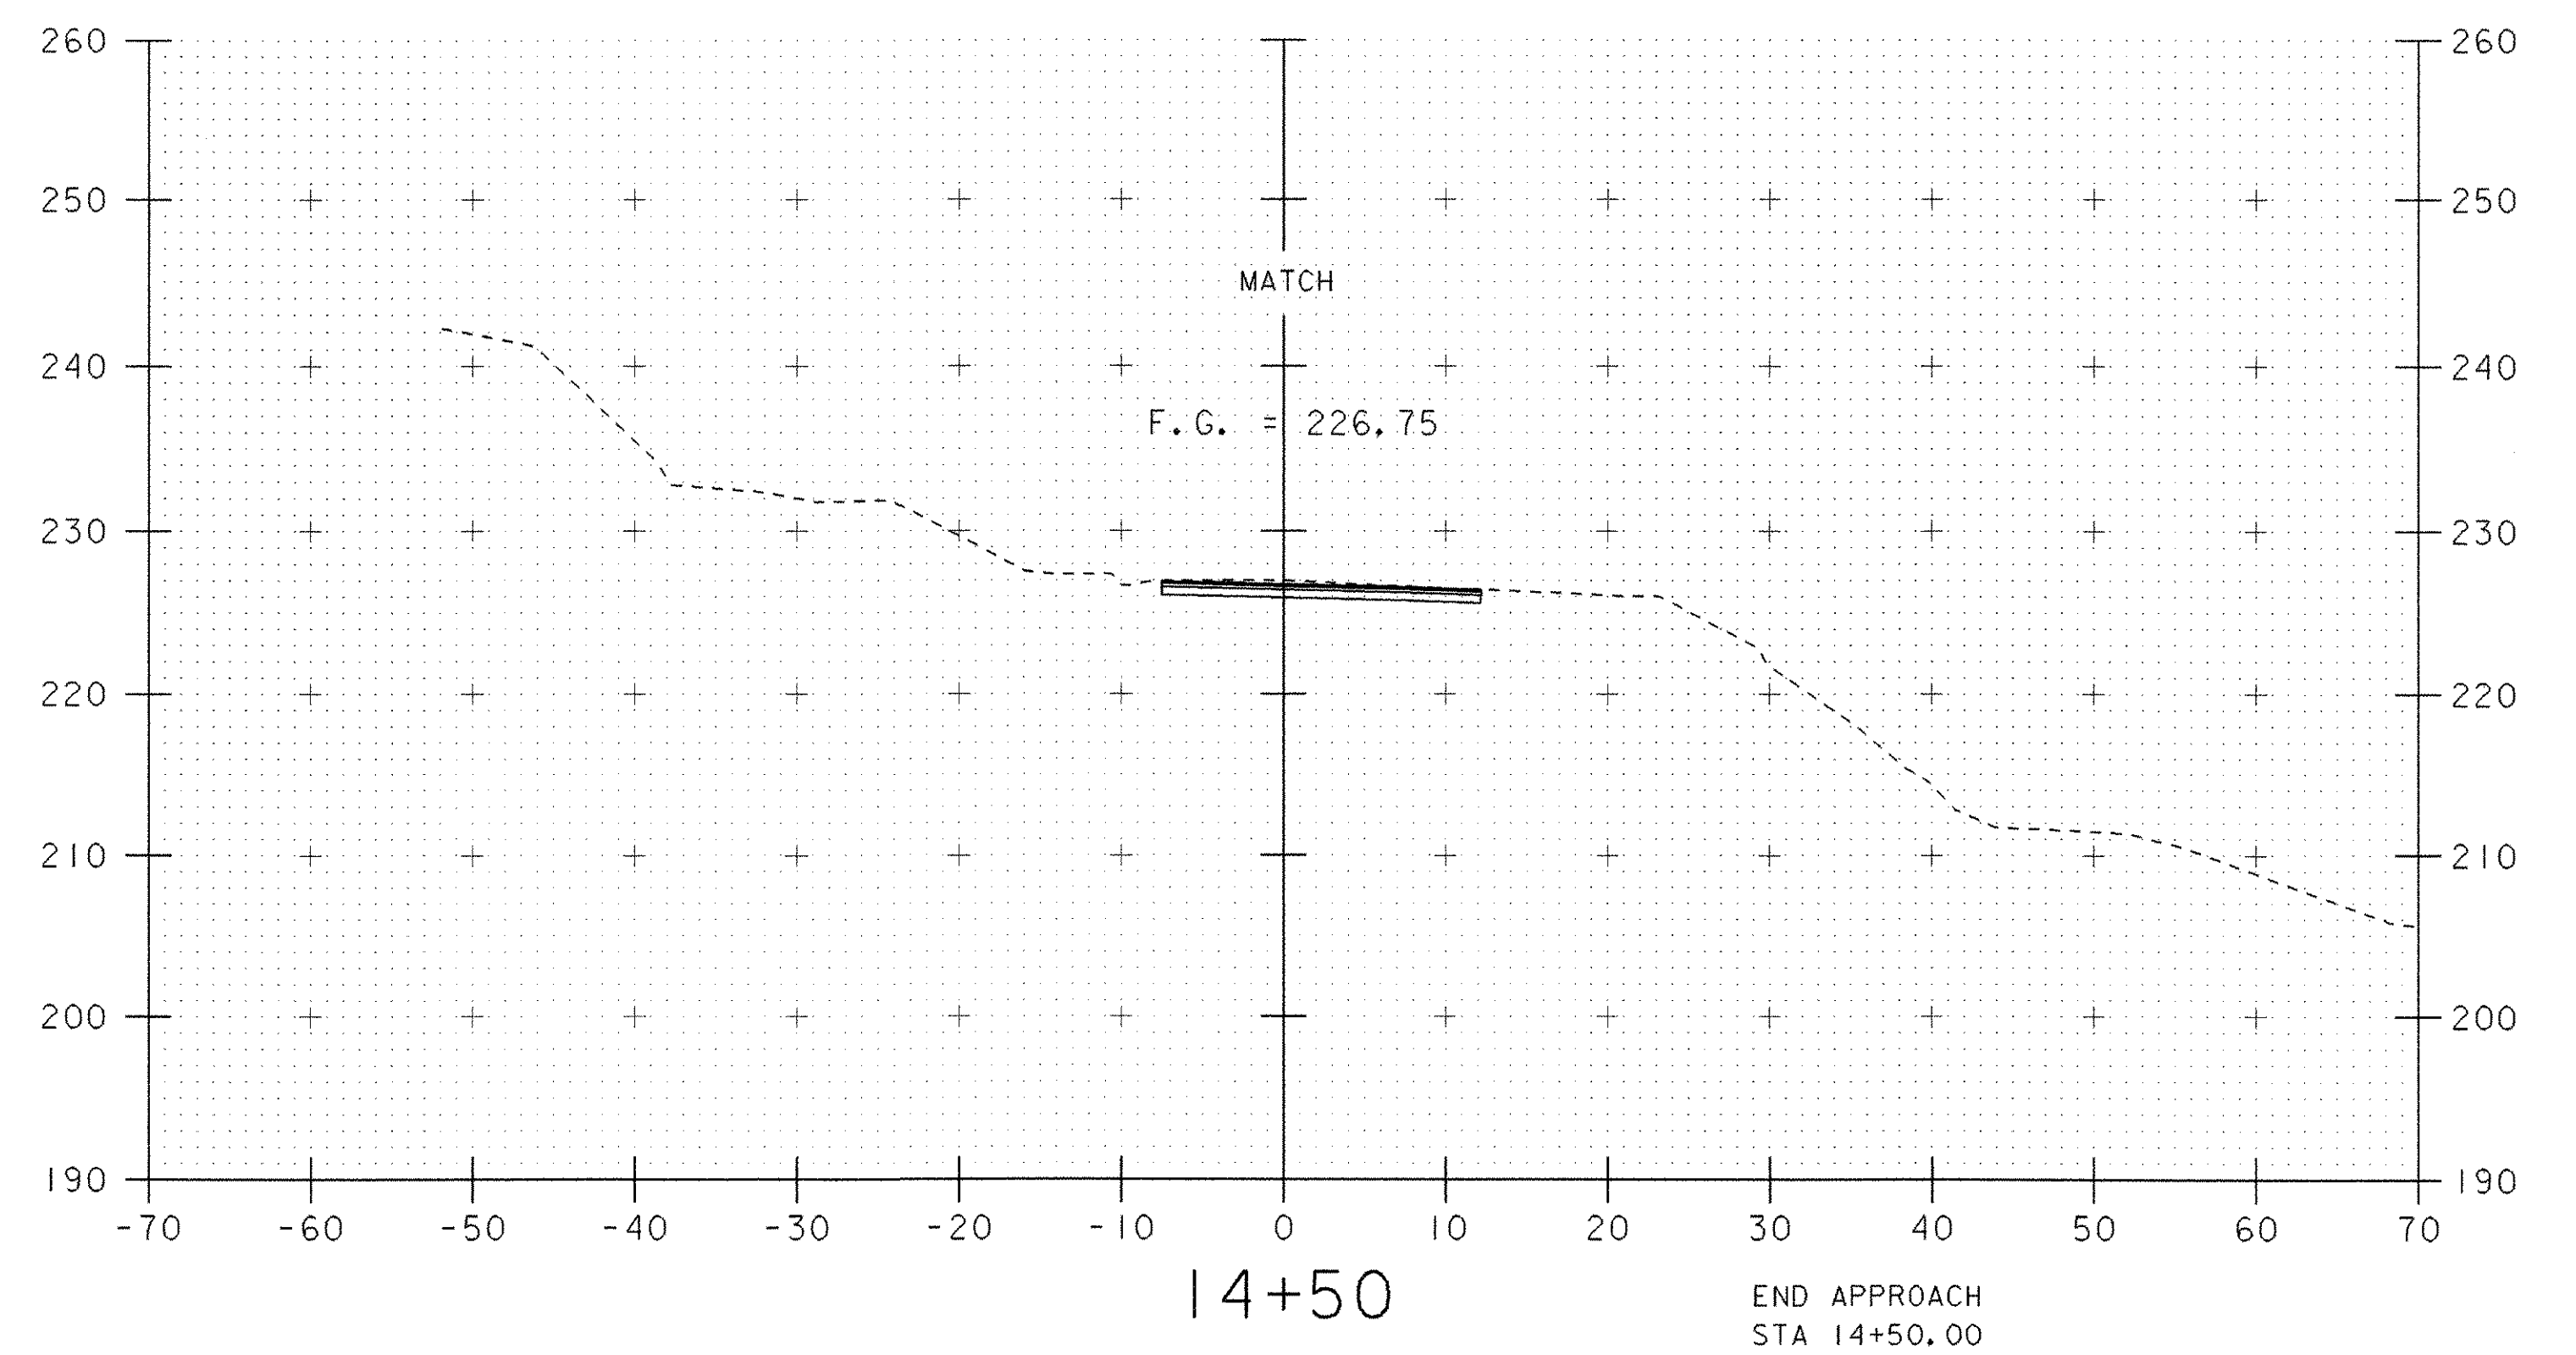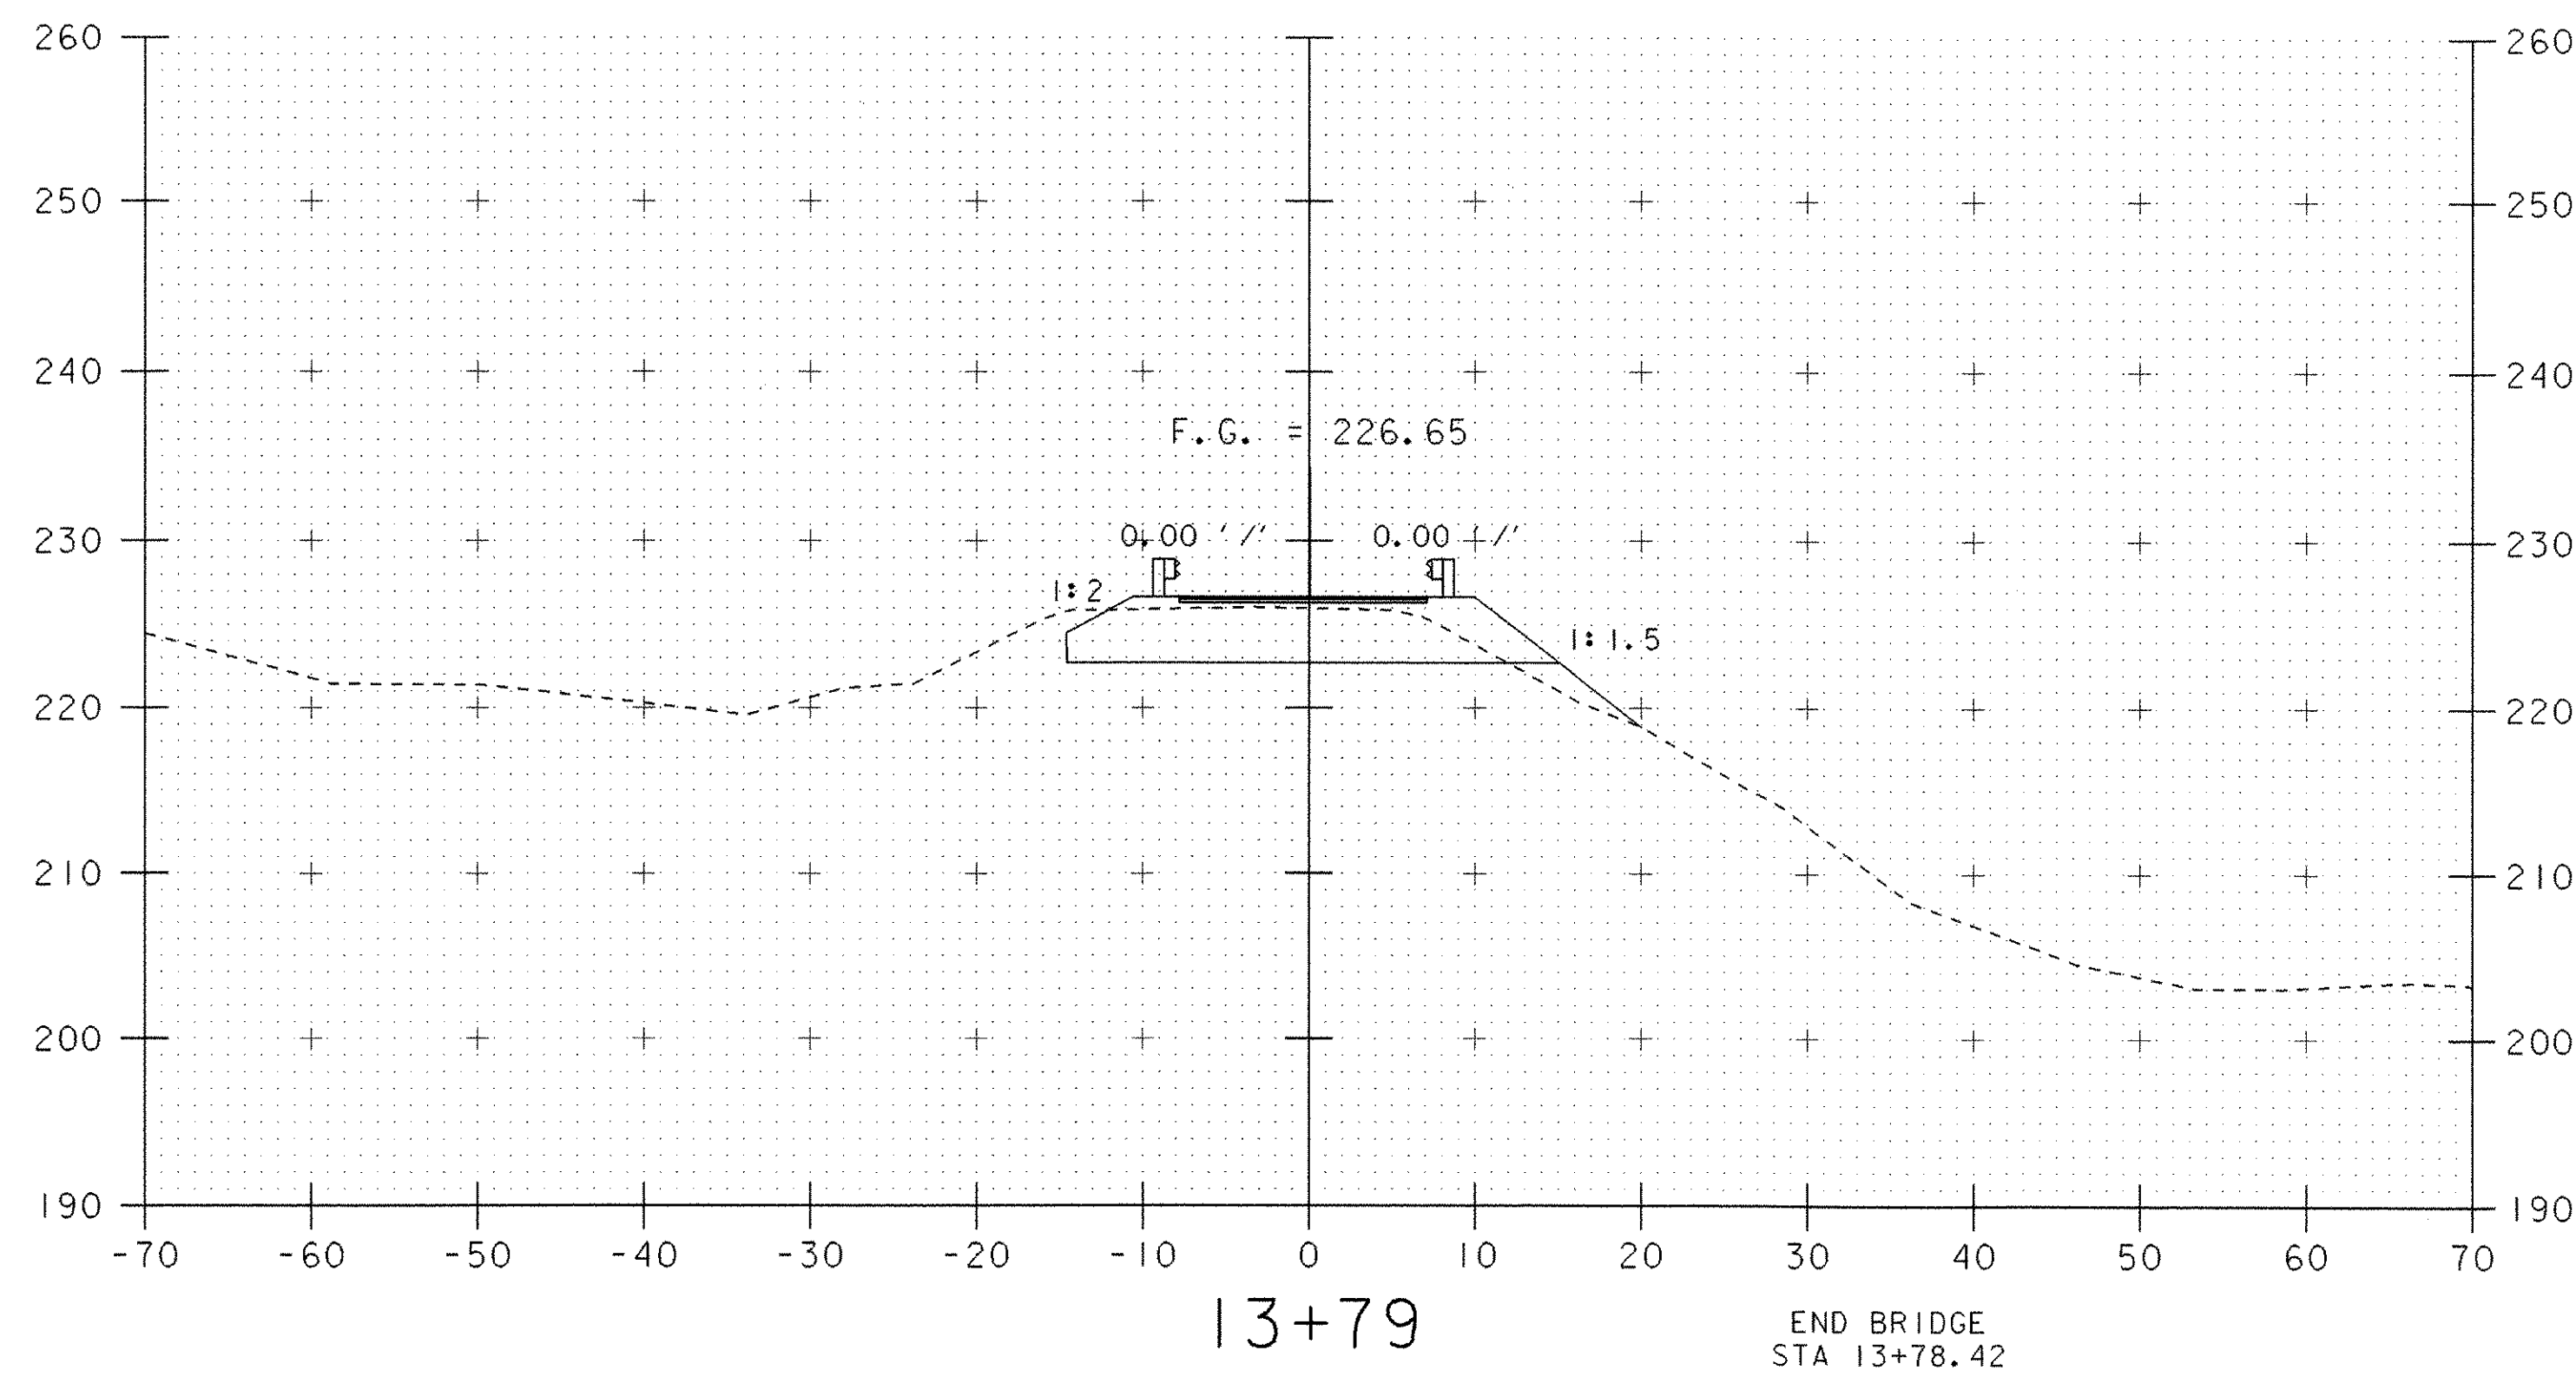


DATUM  
VERTICAL NGVD  
HORIZONTAL ASSUMED

SCALE 1" = 10'-0"



PROJECT: NEW HAVEN - WEYBRIDGE	PROJECT NO. : BHO-BTN 2005 (1)
DESIGN FILE NAME: /str4/89j081/sj081xs1.dgn	PLOT DATE: 28-FEB-2007
IPARM FILE NAME: sj081m13.i	SURVEY DATE: 7/90
SURVEYED BY: R. MOREAU	DRAWN BY: P. G. JARVIS
SQUAD LEADER: C. P. WILLIAMS	
MAINLINE SECTIONS STA. 13+50 - STA. 14+50 SHEET: 38 OF 53	

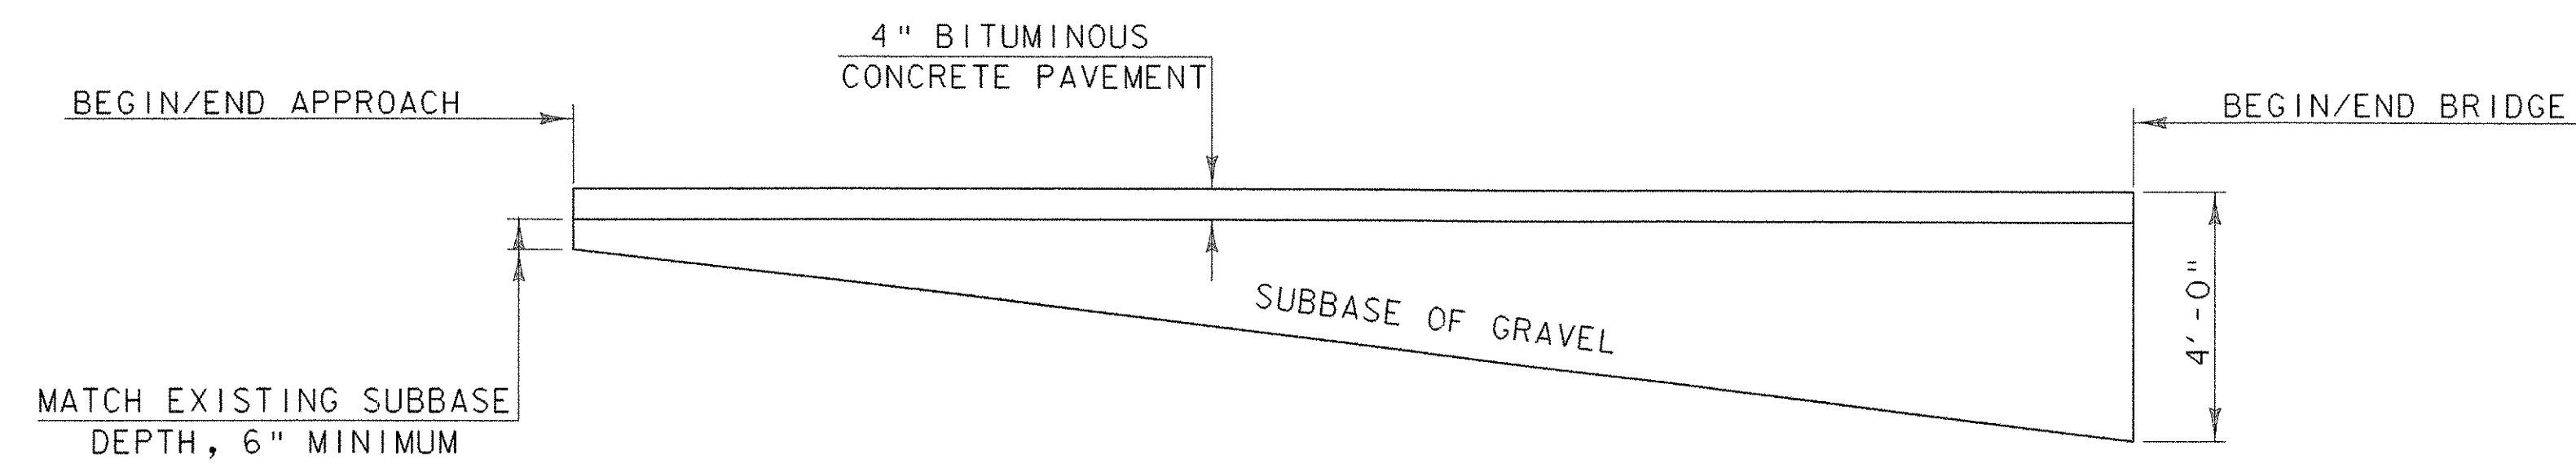

**TAPER SUBBASE DETAIL**  
NTS

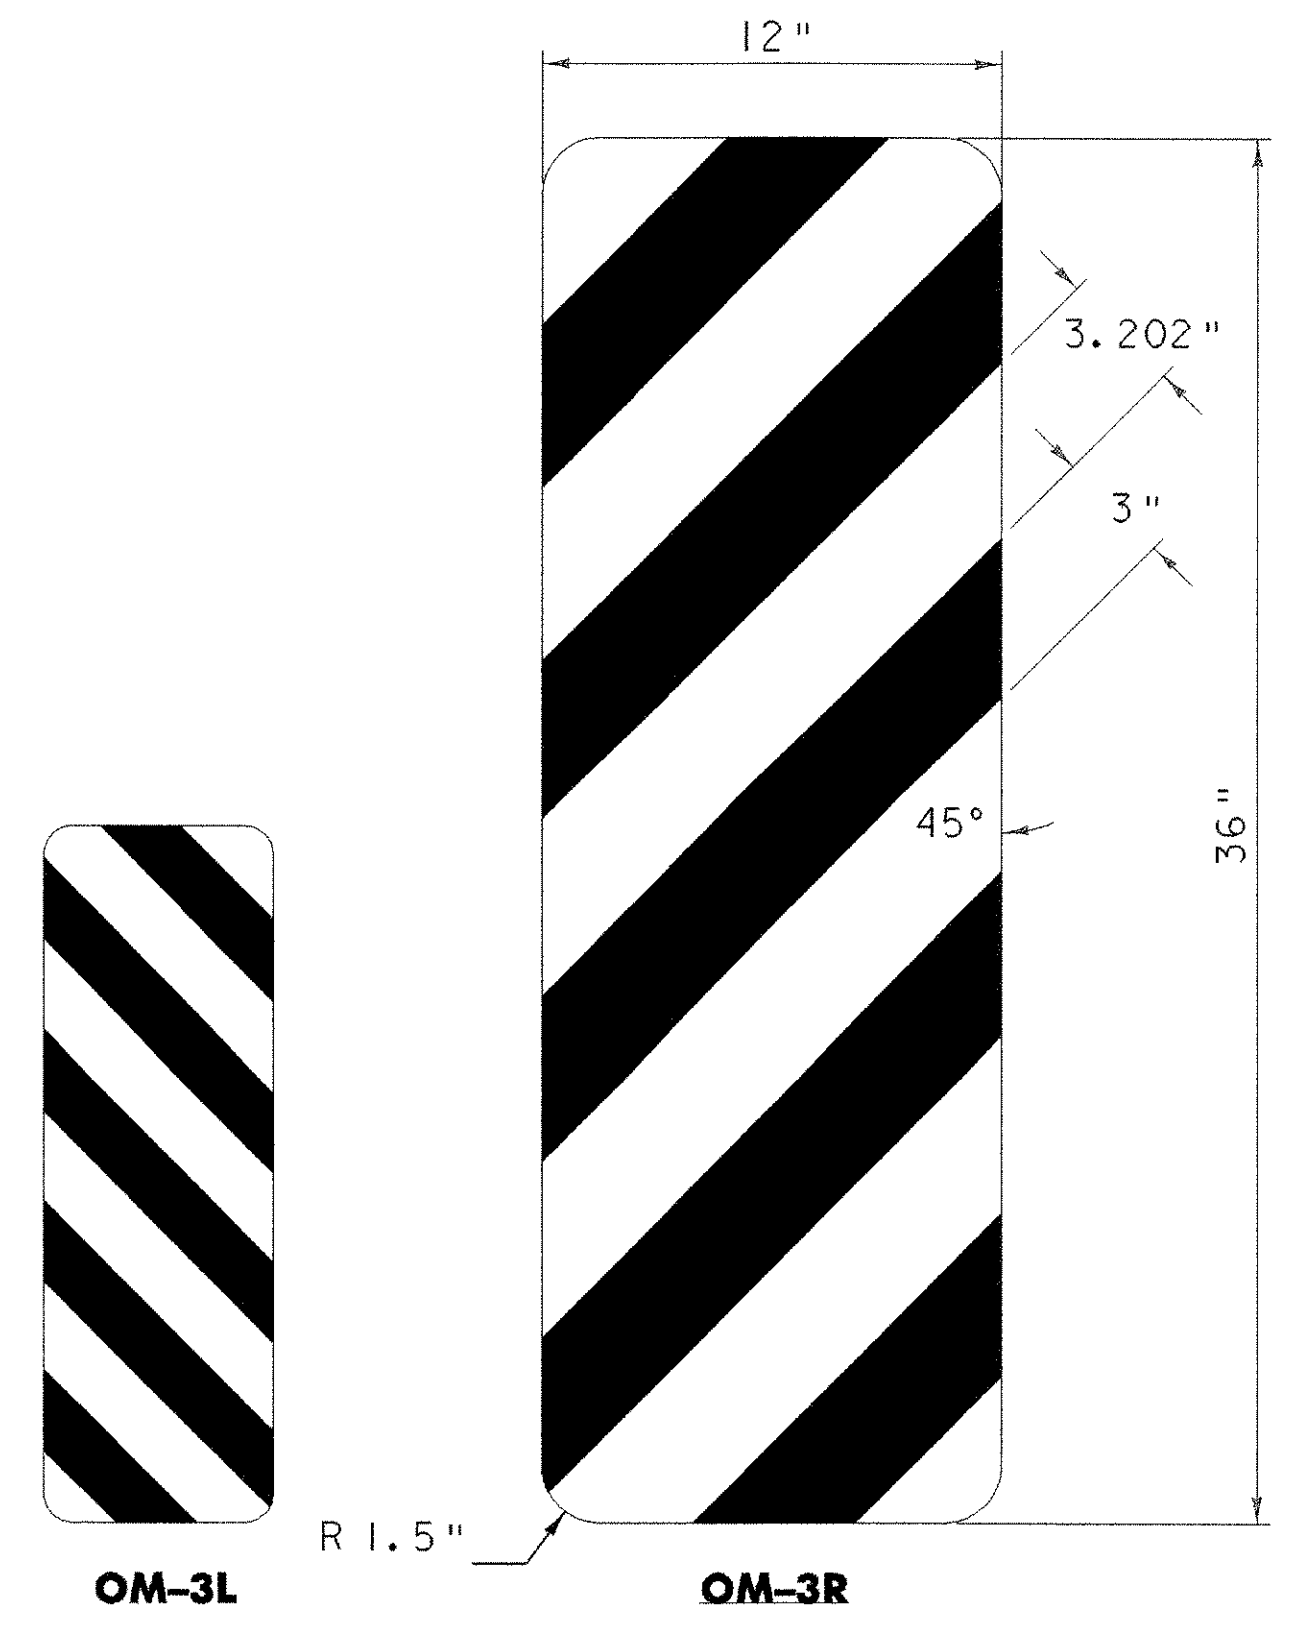

**OM-3R**  
COLORS  
STRIPES-BLACK (NON - REFL)  
BACKGROUND - YELLOW (RETROREFLECTIVE)

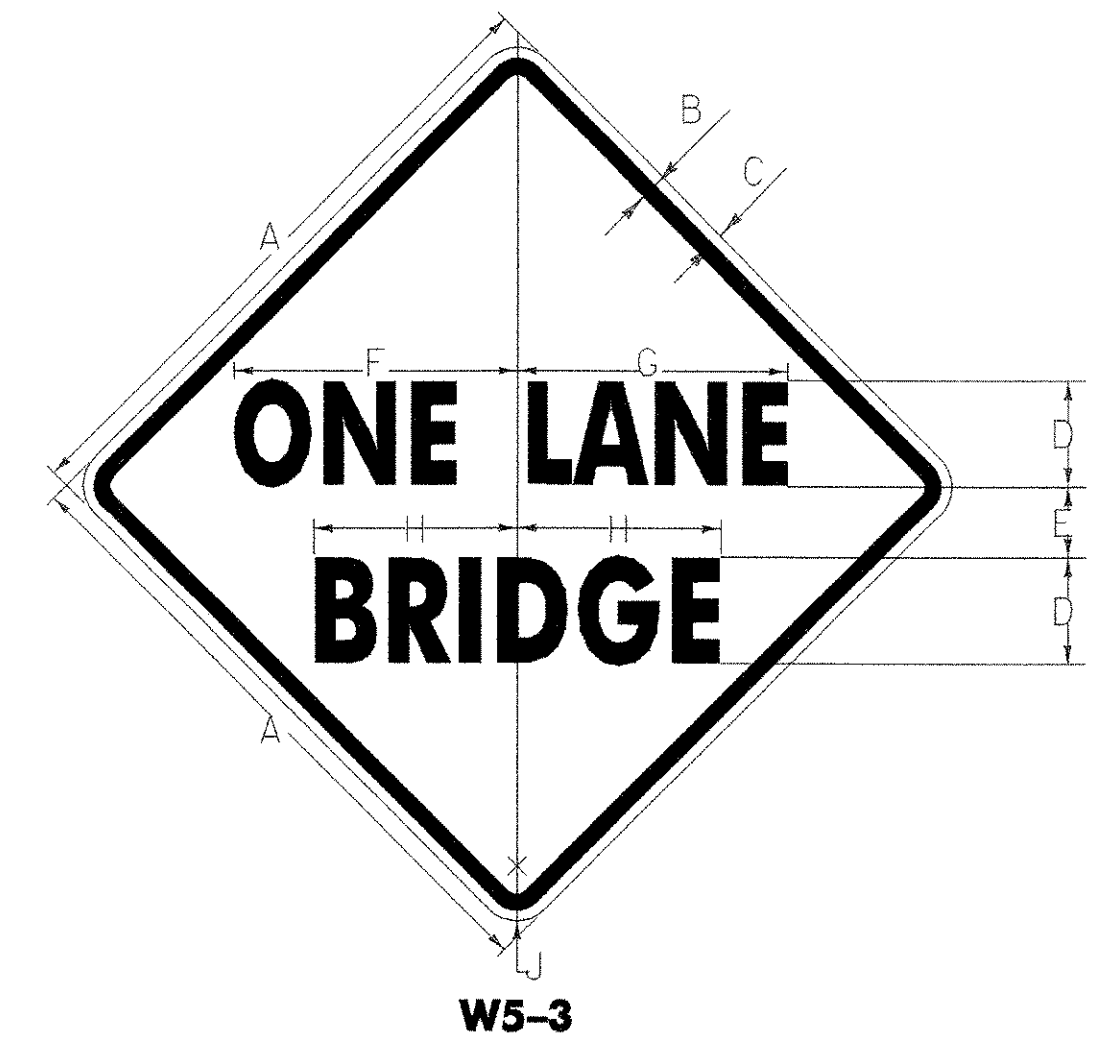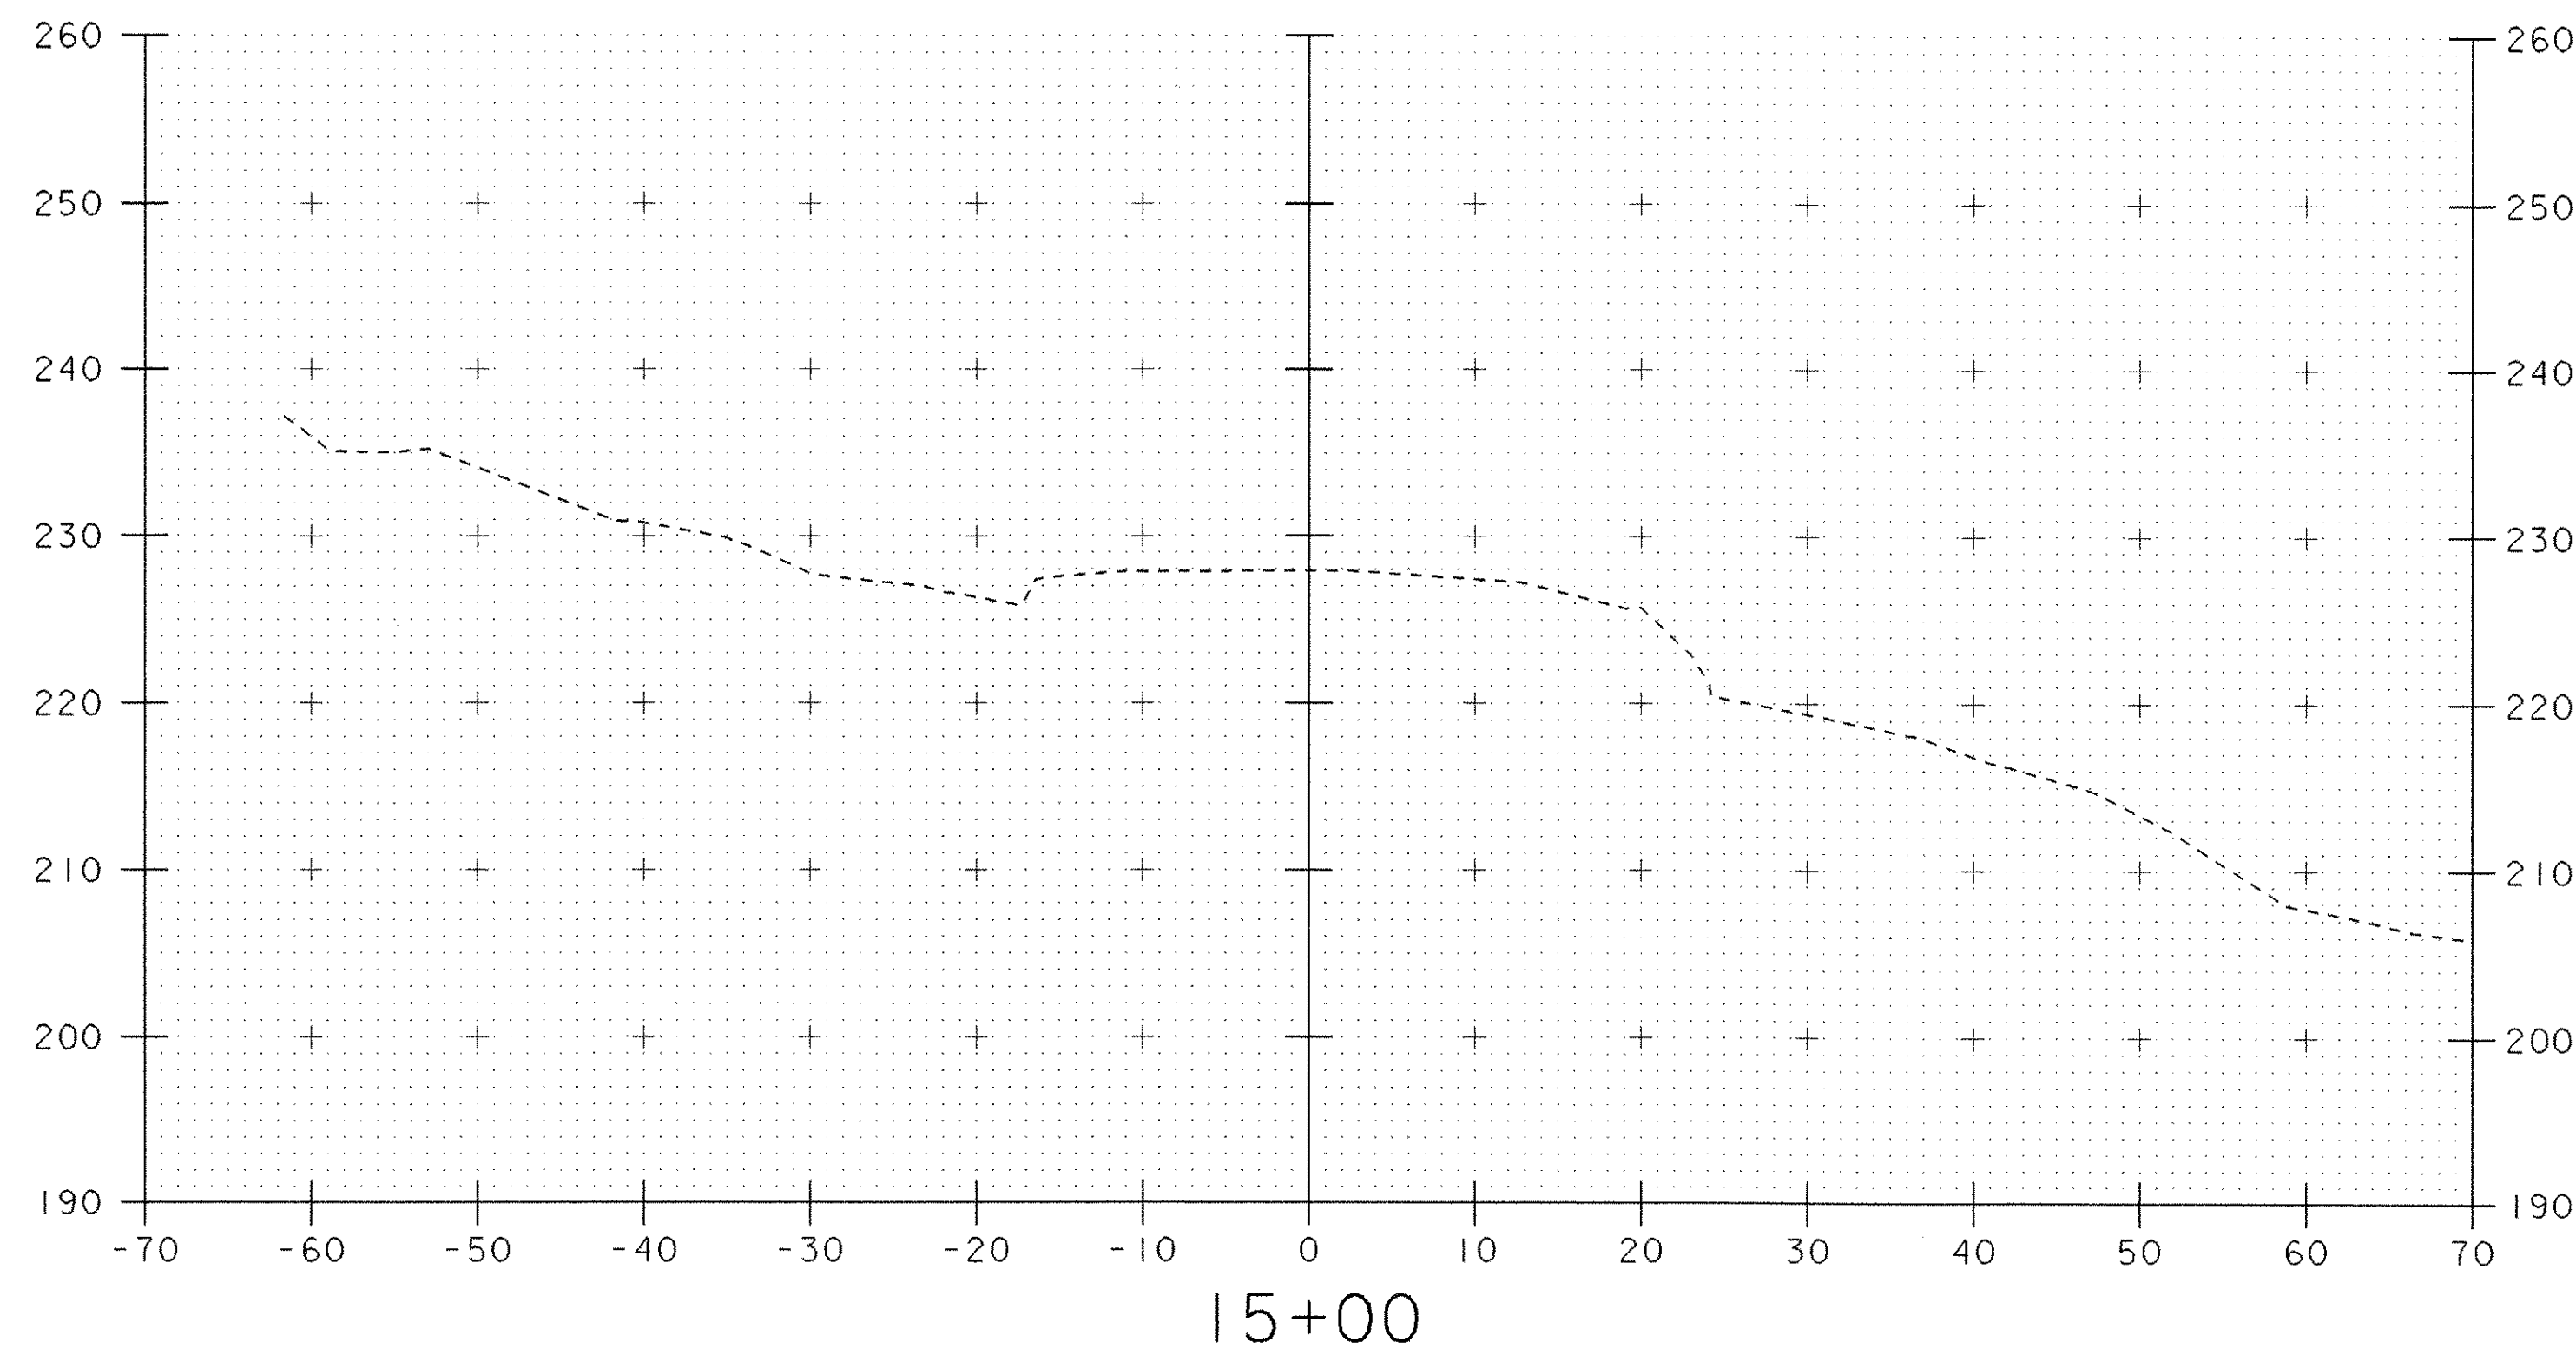



SIGN	DIMENSIONS (INCHES)								
	A	B	C	D	E	F	G	H	J
MIN.	30	1/2	3/4	5C	3 1/4	13 5/16	12 11/16	9 1/8	1 7/8
STD.	36	5/8	7/8	6C	4	16	15 1/4	11 1/2	2 1/4
SPECIAL	48	3/4	1 1/4	8C	5	21 1/4	20 1/4	15 3/8	3

**W5-3**  
COLORS  
LEGEND- BLACK (NON - REFL)  
BACKGROUND - YELLOW (RETROREFLECTIVE)

**DATUM**  
VERTICAL        NGVD  
HORIZONTAL        ASSUMED

SCALE 1" = 10'-0"  
10 0 10



PROJECT:	NEW HAVEN - WEYBRIDGE	PROJECT NO.:	BHO-BTN 2005 (1)
DESIGN FILE NAME:	/str4/89j081/sj081xs1.dgn		
IPARM FILE NAME:	sj081m14.i		
SURVEYED BY:	R. MOREAU	PLOT DATE:	28-FEB-2007
SQUAD LEADER:	C.P. WILLIAMS	SURVEY DATE:	7/90
MAINLINE SECTION STA.	15+00	DRAWN BY:	P.G. JARVIS
		SHEET:	39 OF 53

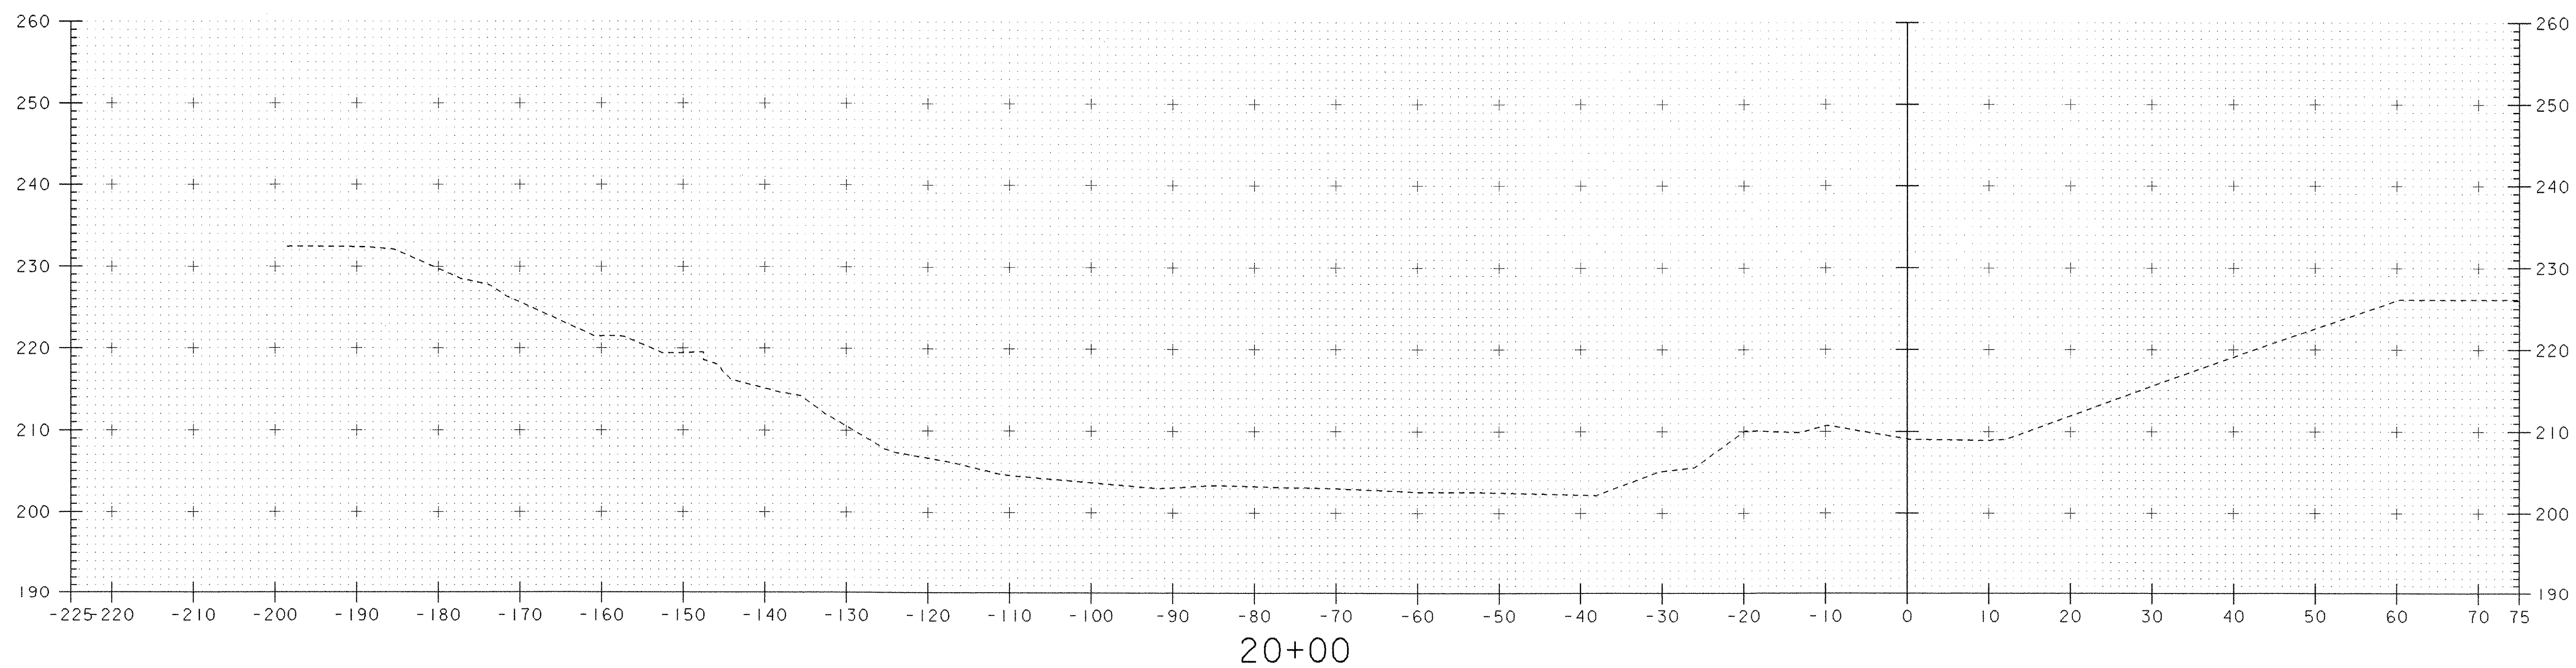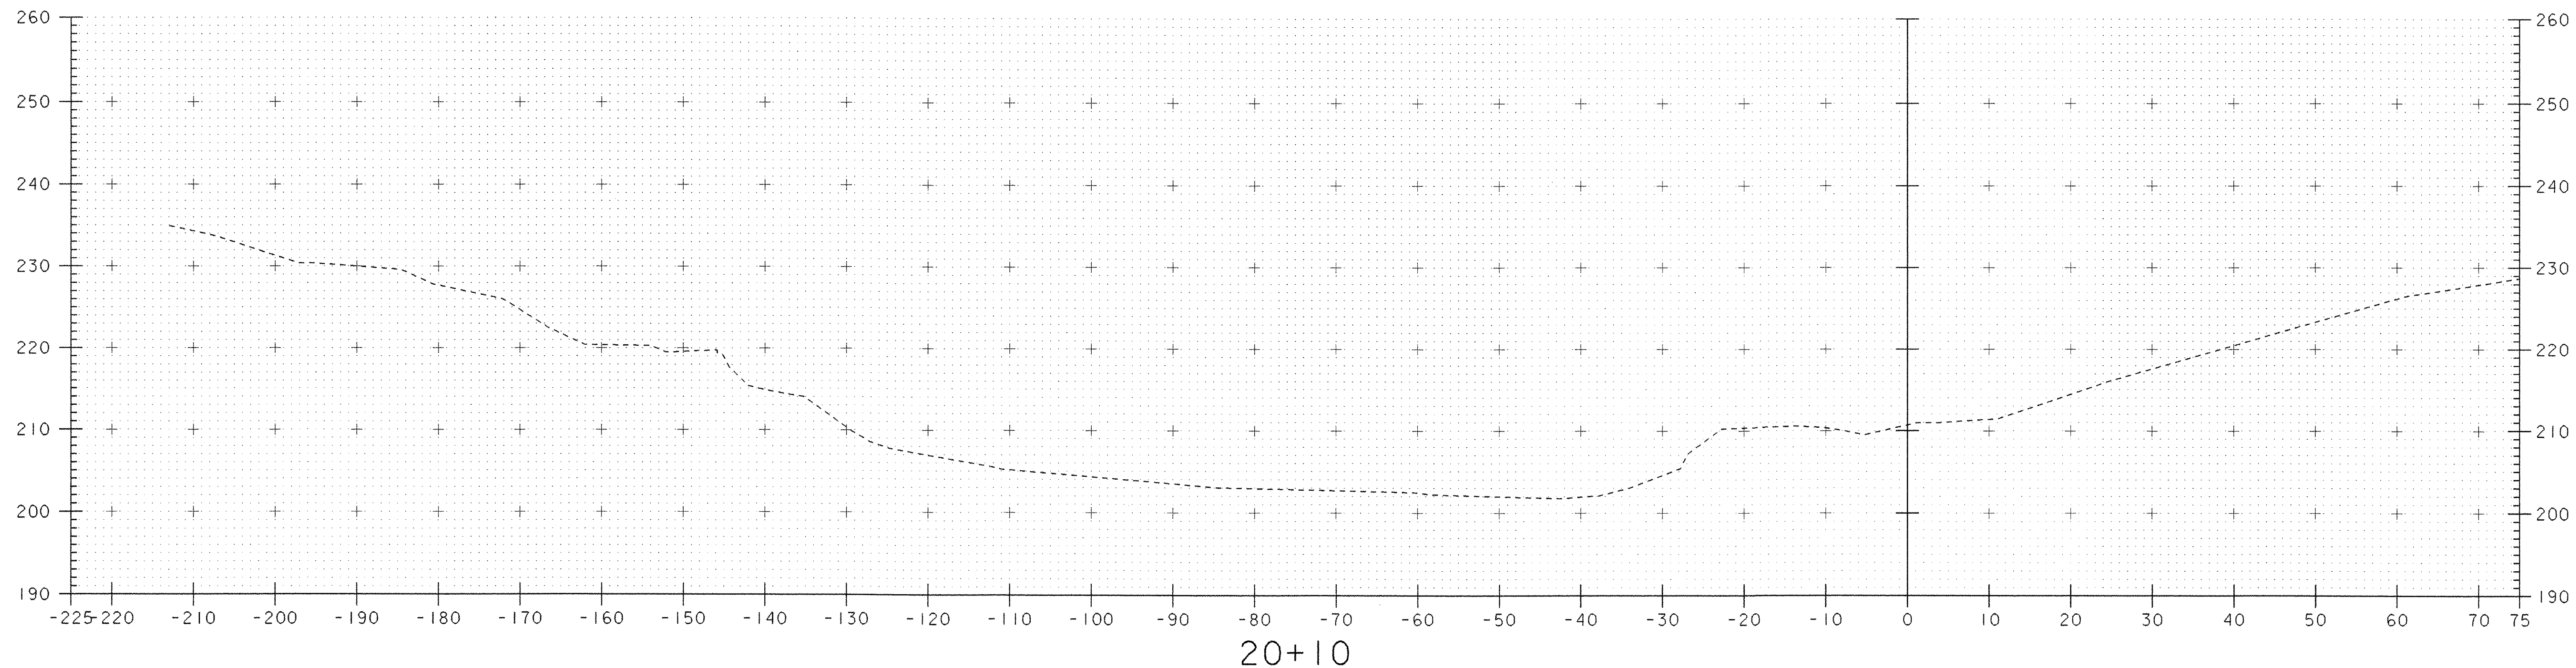

DATUM  
 VERTICAL        NGVD  
 HORIZONTAL        ASSUMED

SCALE 1" = 10'-0"

PROJECT: NEW HAVEN - WEYBRIDGE	PROJECT NO.: BHO-BTN 2005 (1)
DESIGN FILE NAME: /str4/89j081/sj081xs1.dgn	PLOT DATE: 28-FEB-2007
IPARM FILE NAME: sj081c11.i	SURVEY DATE: 7/90
SURVEYED BY: R. MOREAU	DRAWN BY: P. G. JARVIS
SQUAD LEADER: C. P. WILLIAMS	CHANNEL SECTIONS STA. 20+00 - STA. 20+10
SHEET: 40 OF 53	

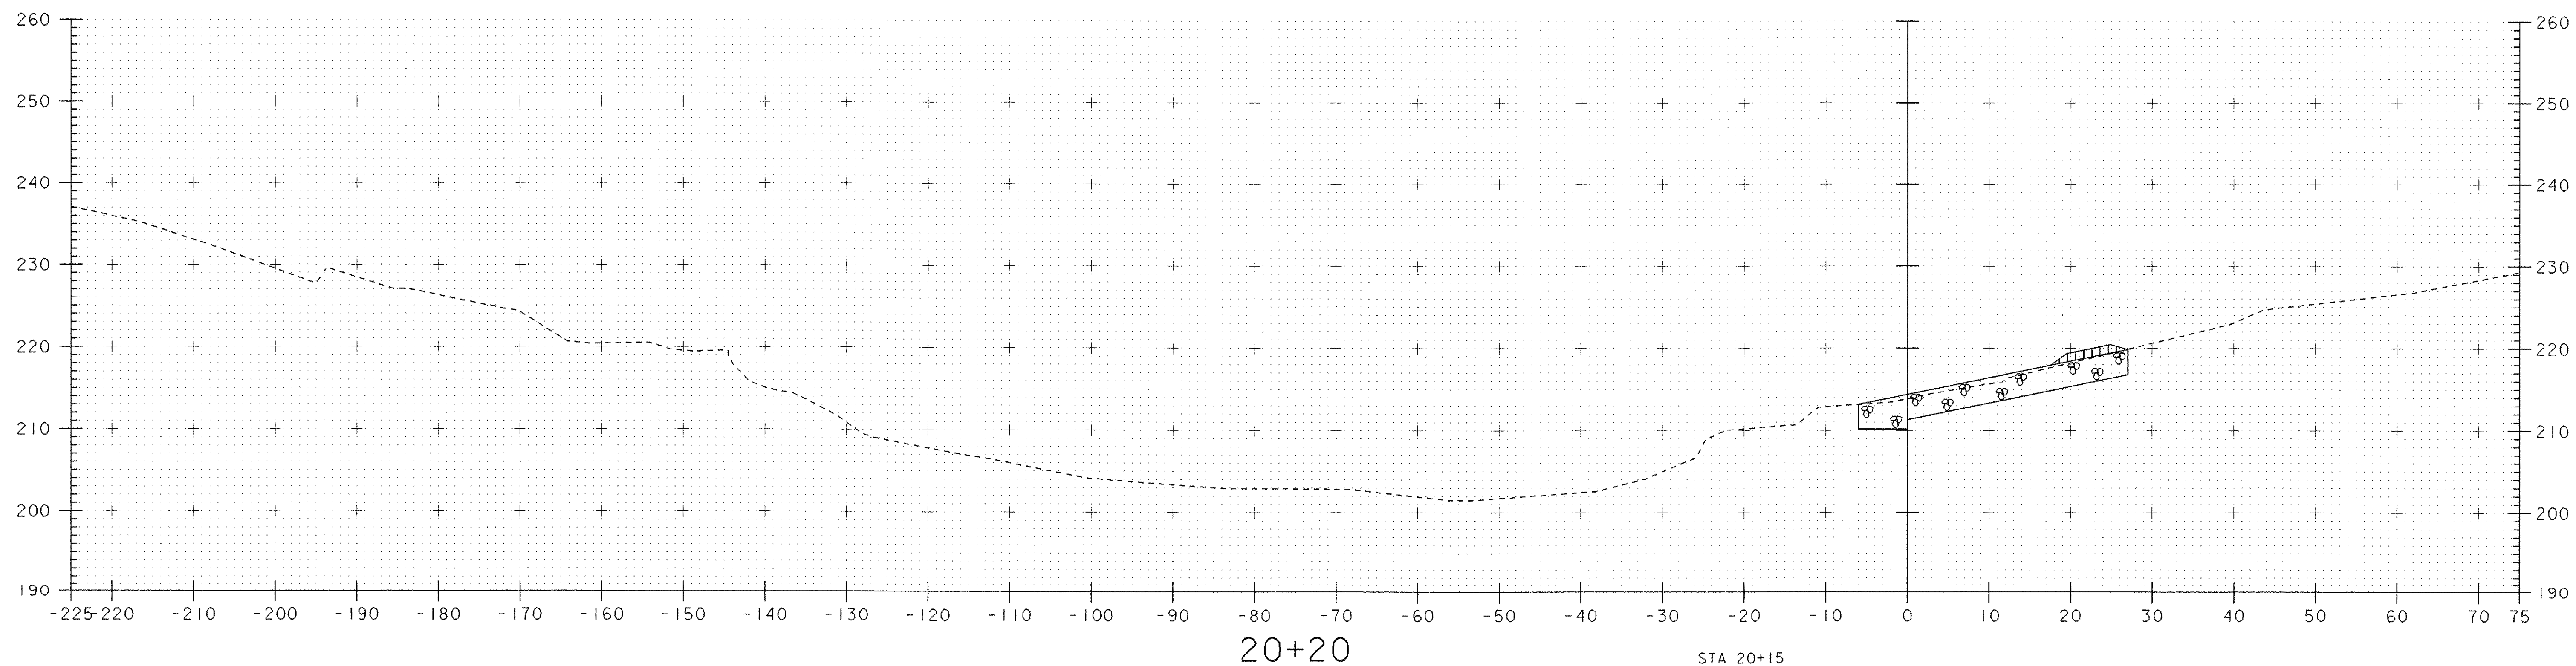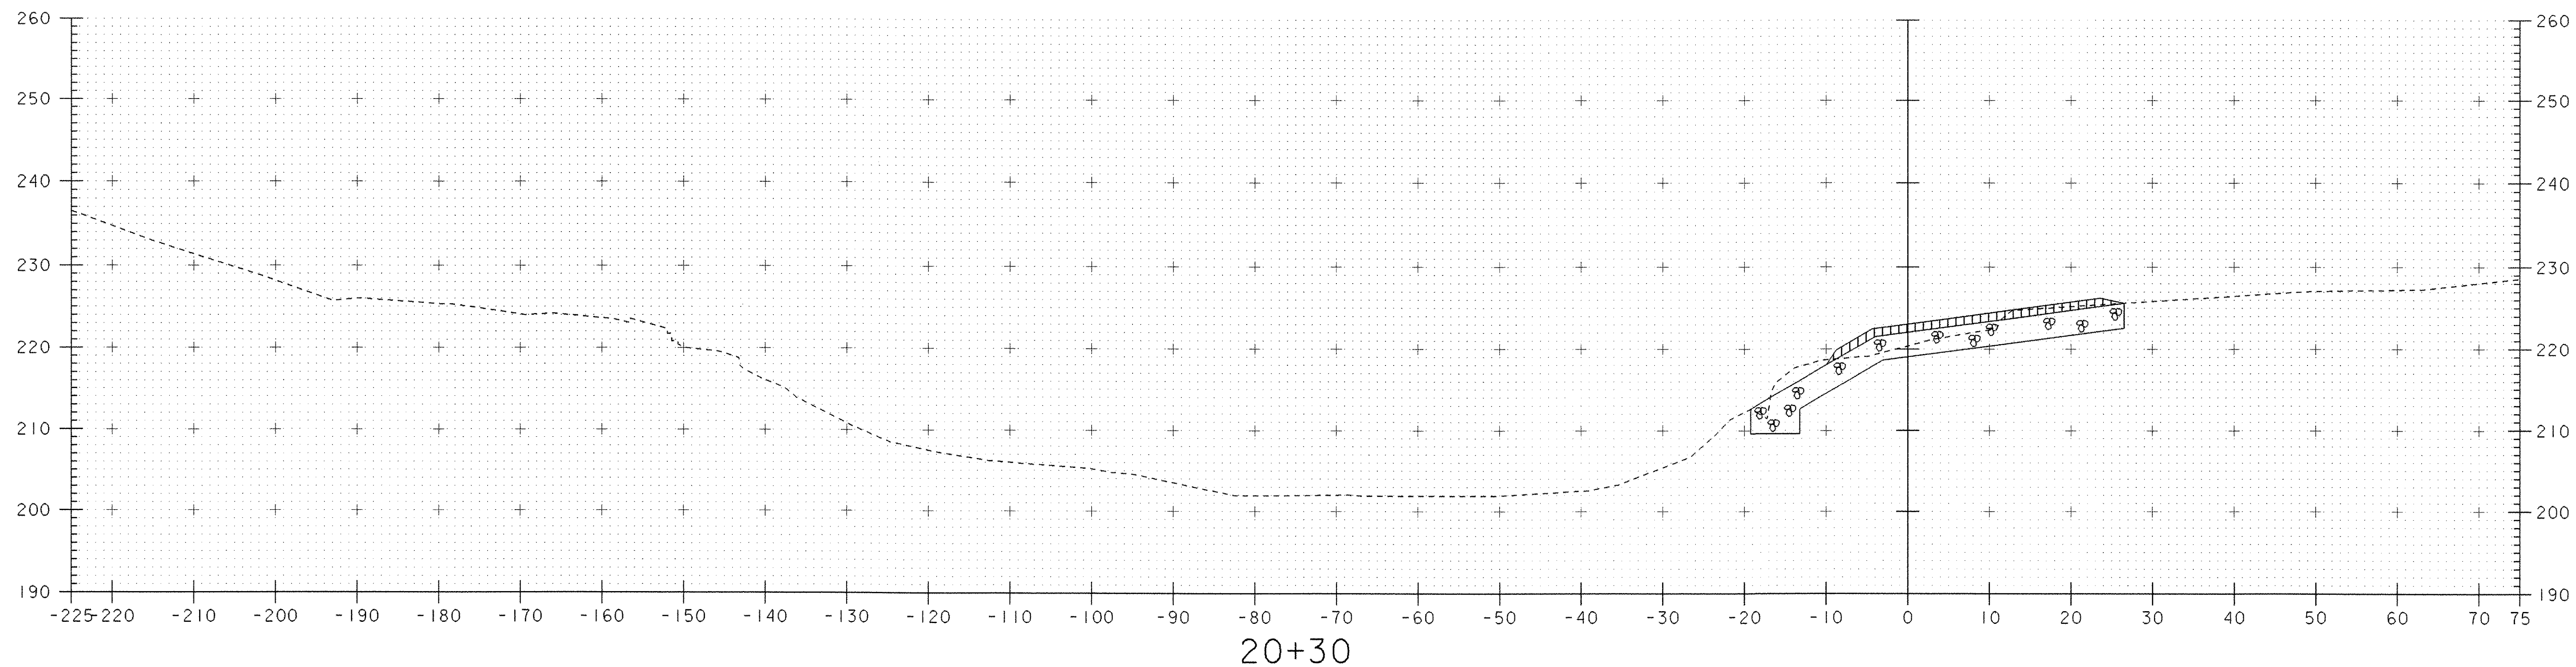


STA 20+15  
 (ABUTMENT No. 1)  
 BEGIN STONE FILL TYPE III  
 BEGIN GEOTEXTILE UNDER STONE FILL  
 BEGIN GRUBBING MATERIAL  
 BEGIN UNCLASSIFIED CHANNEL EXCAVATION


SCALE 1" = 10'-0"

DATUM  
 VERTICAL NGVD  
 HORIZONTAL ASSUMED

PROJECT: NEW HAVEN - WEYBRIDGE	PROJECT NO.: BHO-BTN 2005 (1)
DESIGN FILE NAME: /str4/89j081/sj081xs1.dgn	PLOT DATE: 28-FEB-2007
IPARM FILE NAME: sj081c12.i	SURVEY DATE: 7/90
SURVEYED BY: R. MOREAU	DRAWN BY: P. G. JARVIS
SQUAD LEADER: C. P. WILLIAMS	CHANNEL SECTIONS STA. 20+20 - STA. 20+30
SHEET: 41 OF 53	

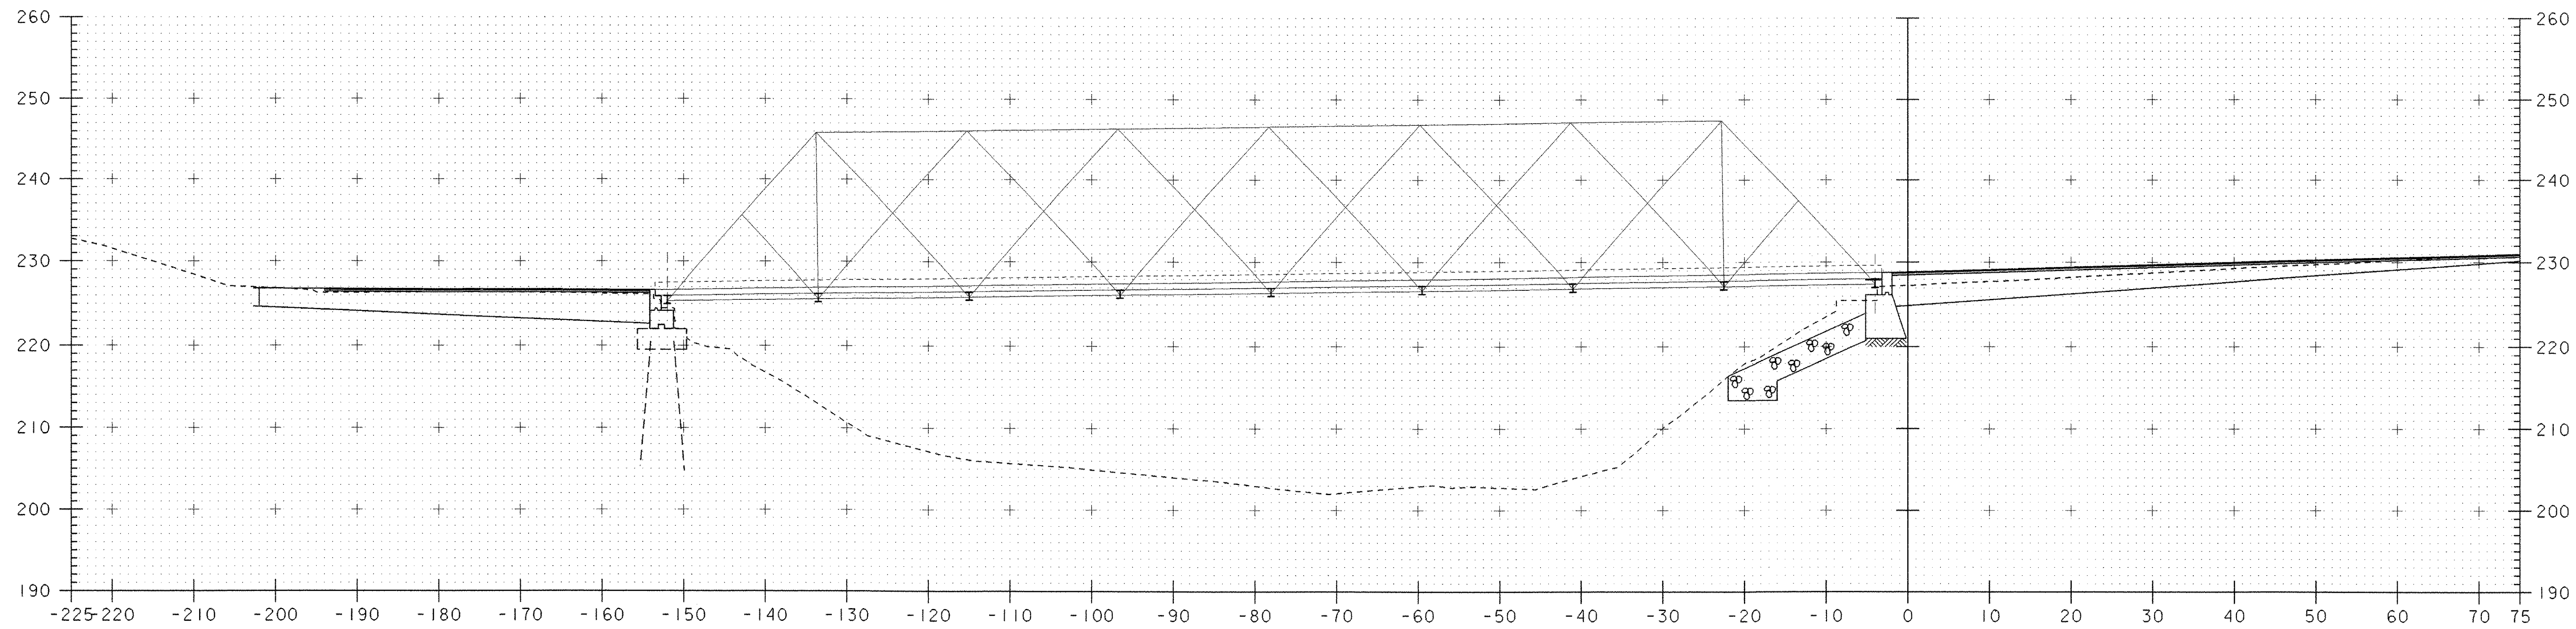

20+50


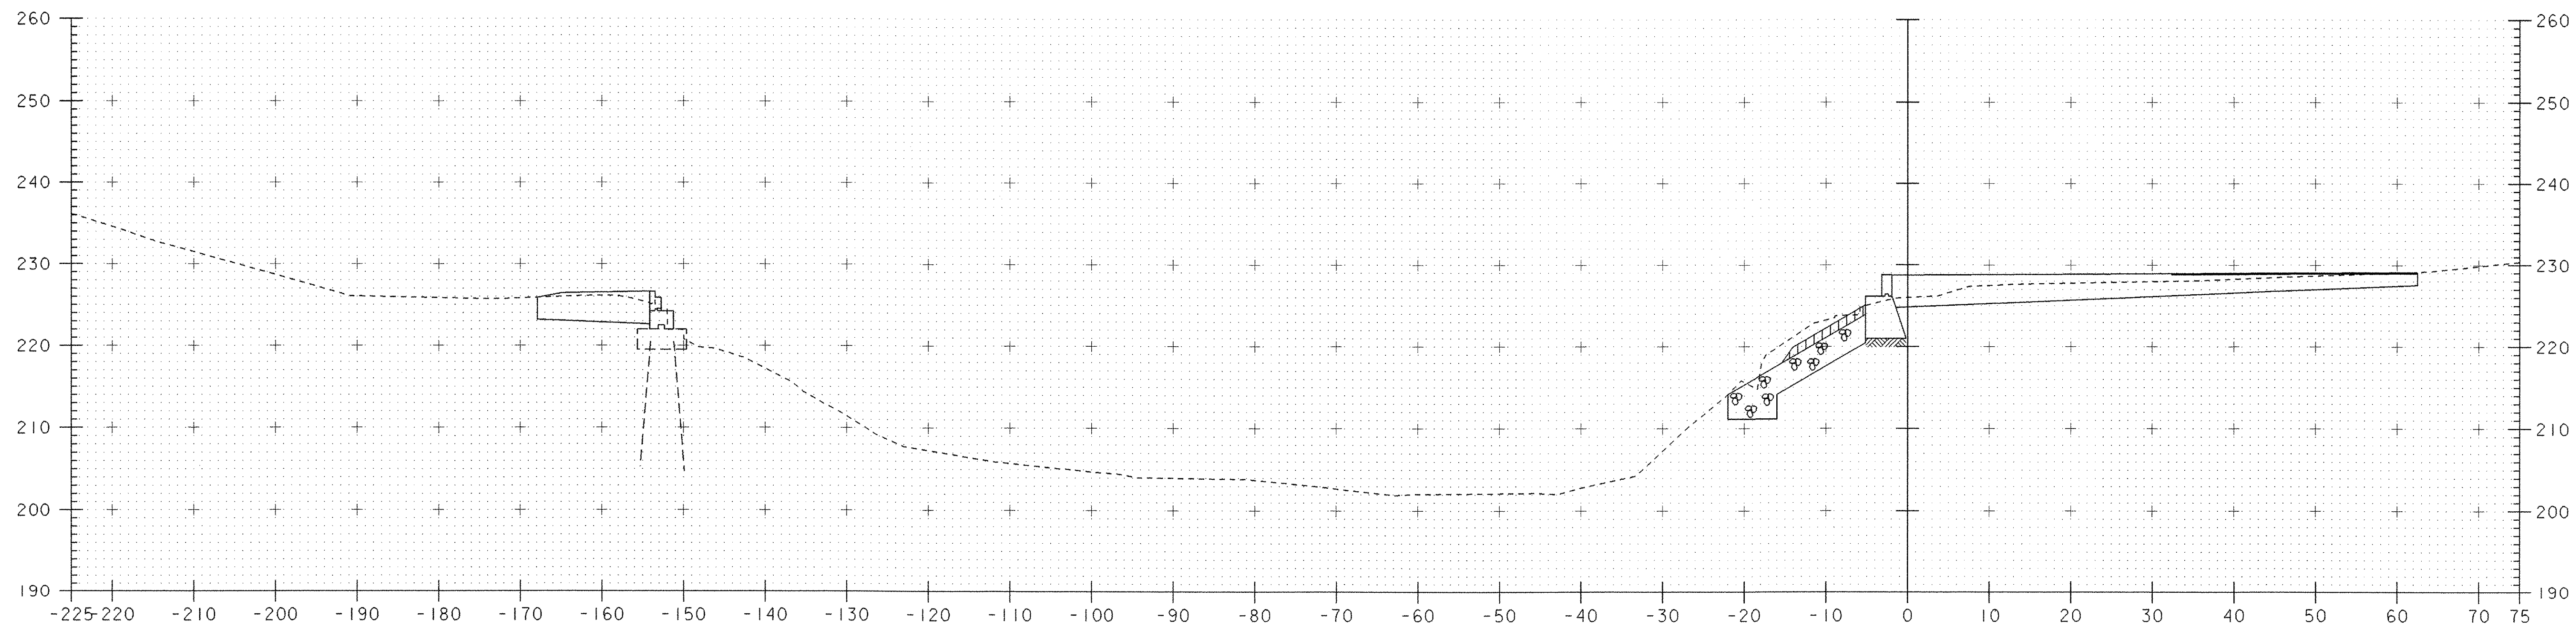


20+40

DATUM  
 VERTICAL        NGVD  
 HORIZONTAL        ASSUMED

SCALE 1" = 10'-0"



PROJECT: NEW HAVEN - WEYBRIDGE	PROJECT NO.: BHO-BTN 2005 (1)
DESIGN FILE NAME: /str4/89j081/sj081xs1.dgn	PLOT DATE: 28-FEB-2007
IPARM FILE NAME: sj081c13.i	SURVEY DATE: 7/90
SURVEYED BY: R. MOREAU	DRAWN BY: P.G. JARVIS
SQUAD LEADER: C.P. WILLIAMS	
CHANNEL SECTIONS STA. 20+40 - STA. 20+50	SHEET: 42 OF 53

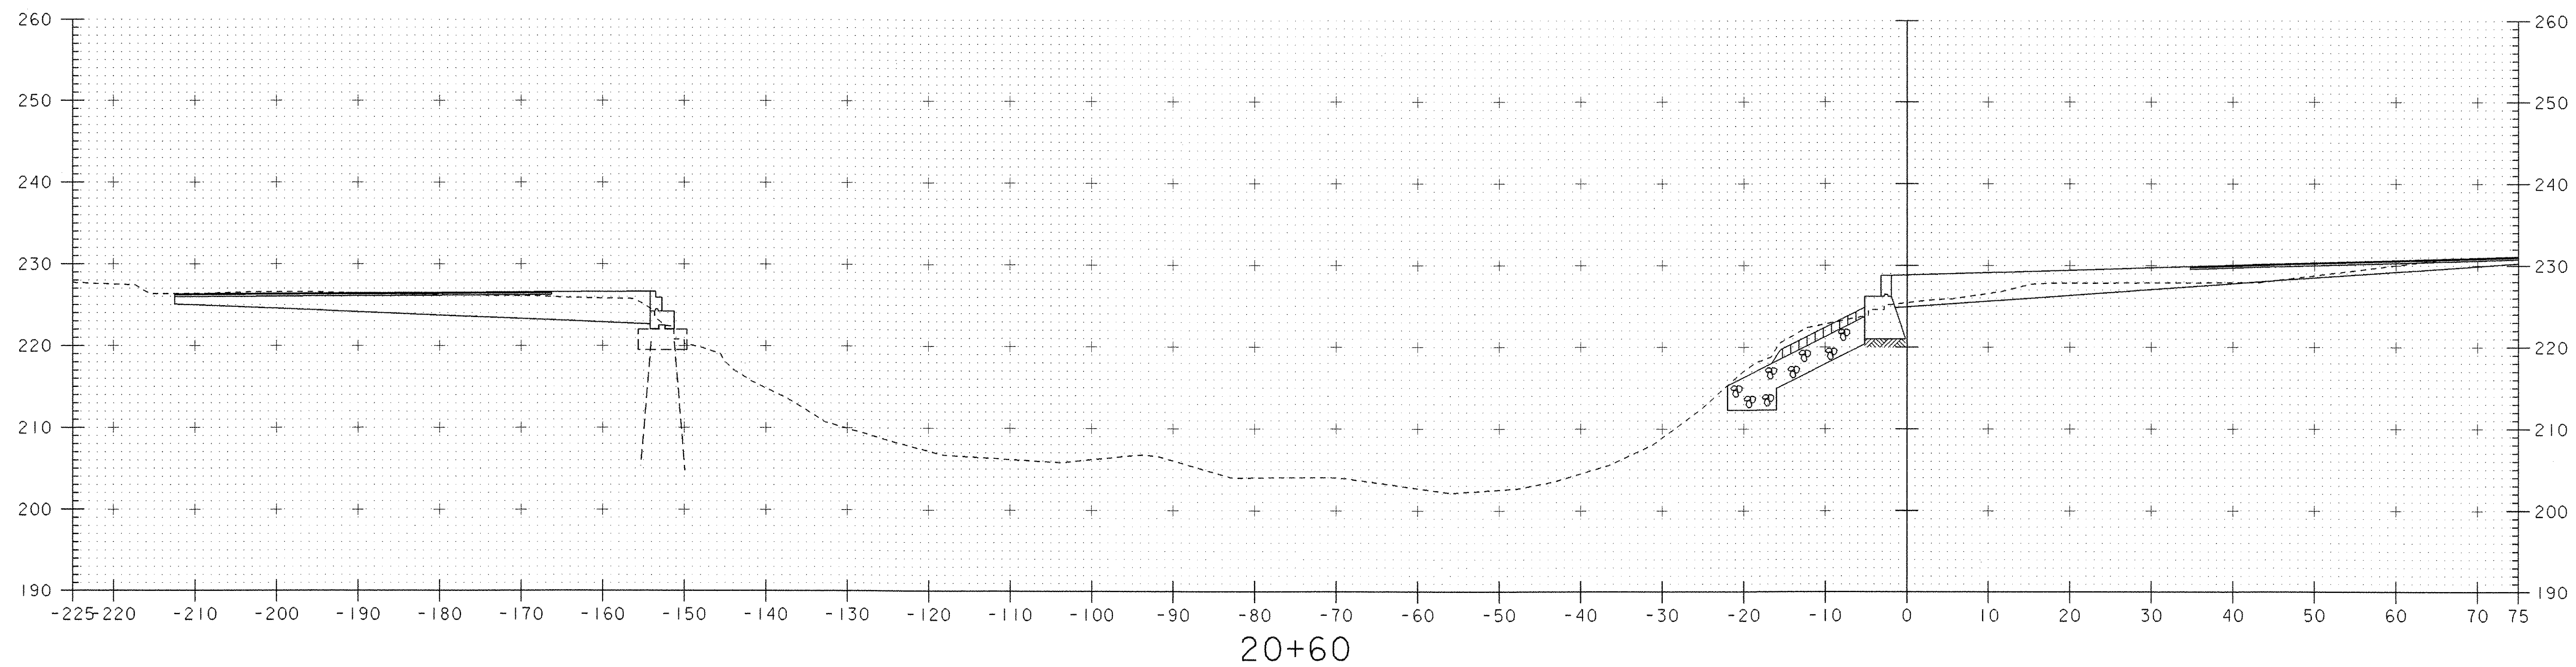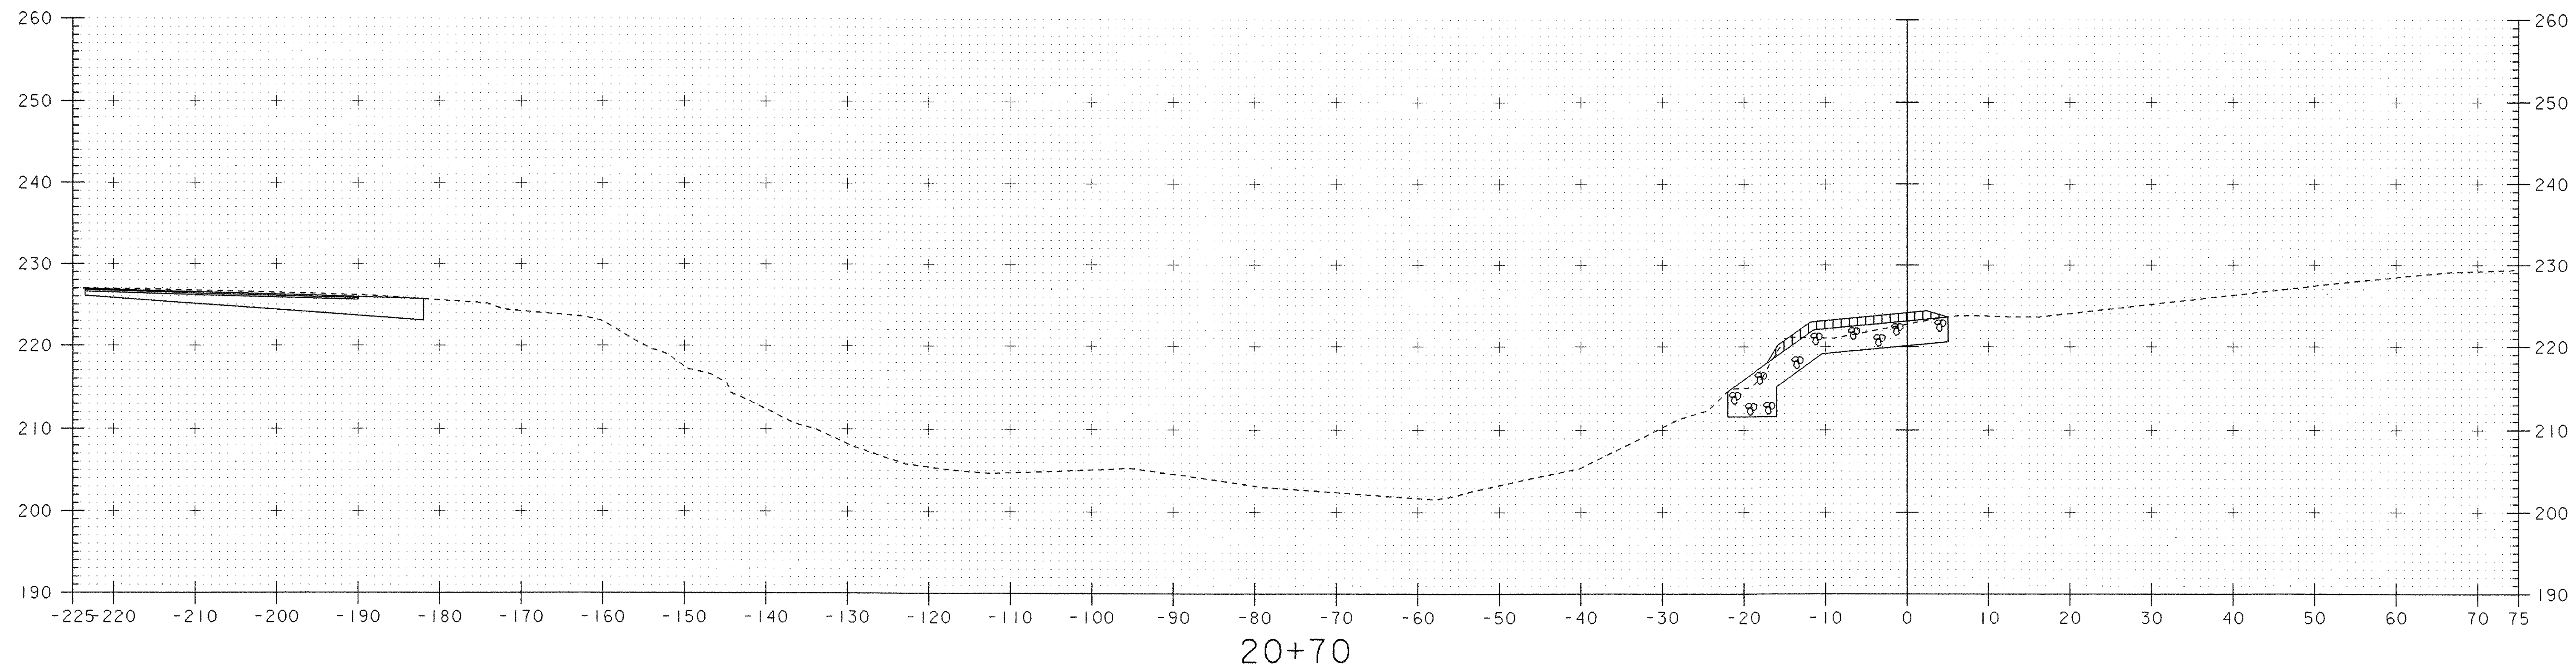

DATUM  
 VERTICAL        NGVD  
 HORIZONTAL        ASSUMED


SCALE 1" = 10'-0"

PROJECT: NEW HAVEN - WEYBRIDGE	PROJECT NO.: BHO-BTN 2005 (1)
DESIGN FILE NAME: /str4/89j081/sj081xs1.dgn	PLOT DATE: 28-FEB-2007
IPARM FILE NAME: sj081c14.i	SURVEY DATE: 7/90
SURVEYED BY: R. MOREAU	DRAWN BY: P.G. JARVIS
SQUAD LEADER: C.P. WILLIAMS	
CHANNEL SECTIONS STA. 20+60 - STA. 20+70 SHEET: 43 OF 53	

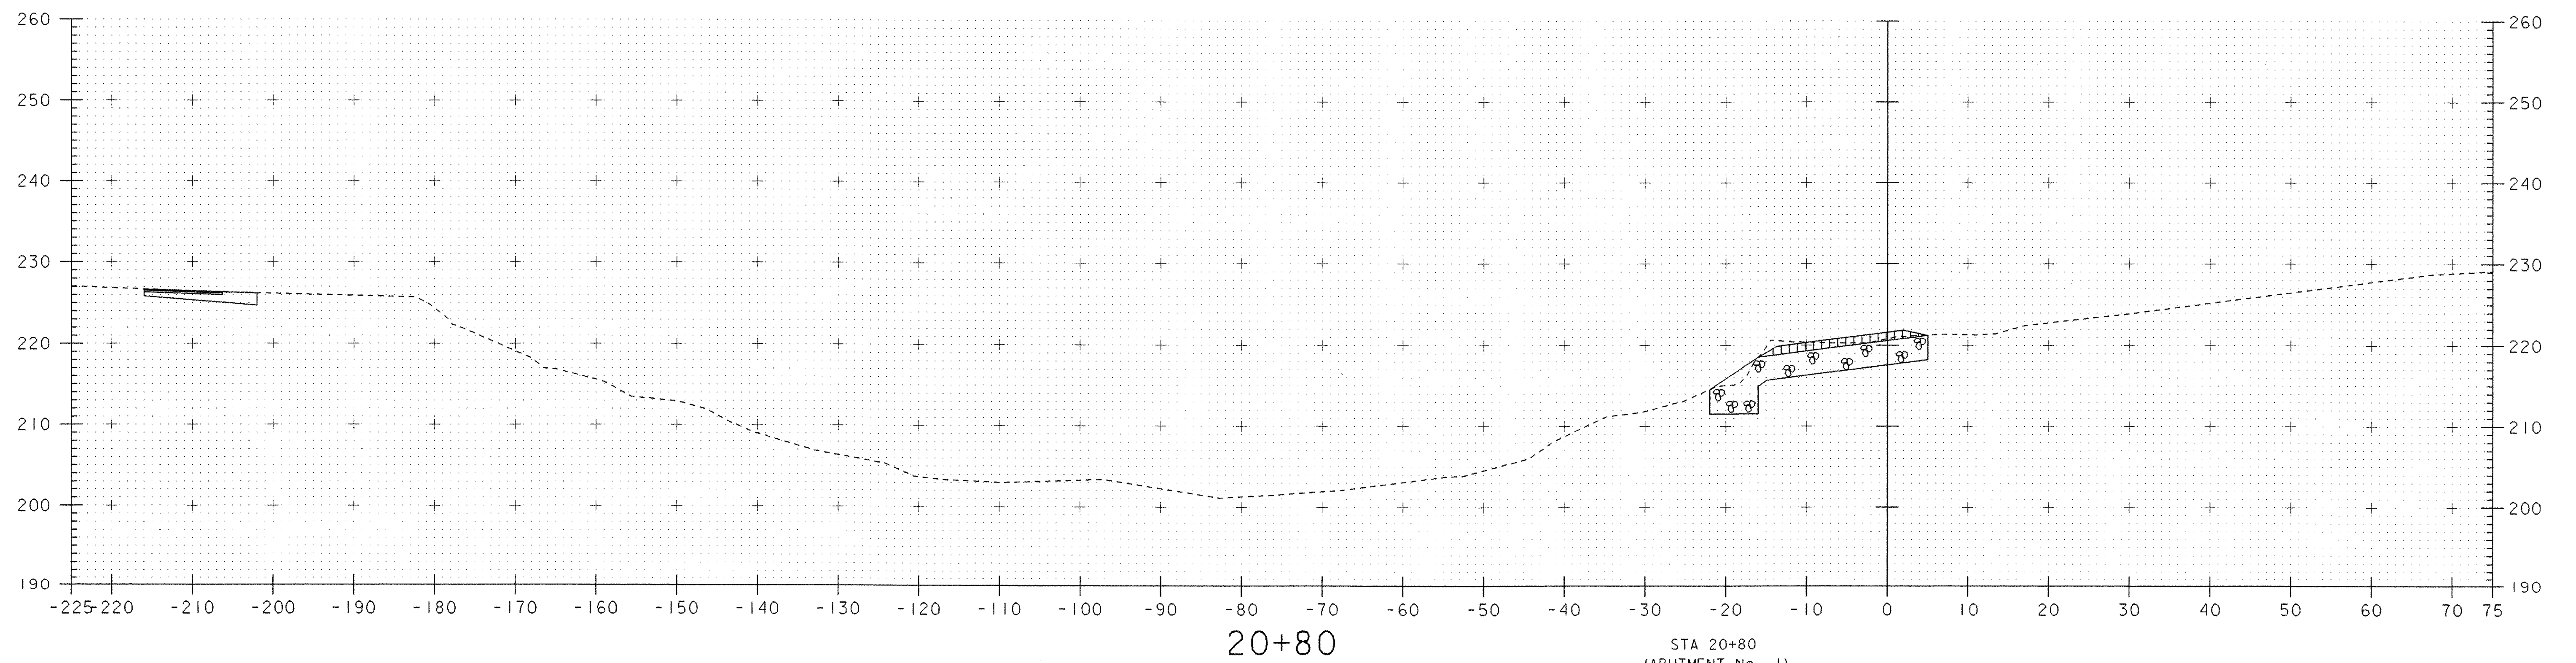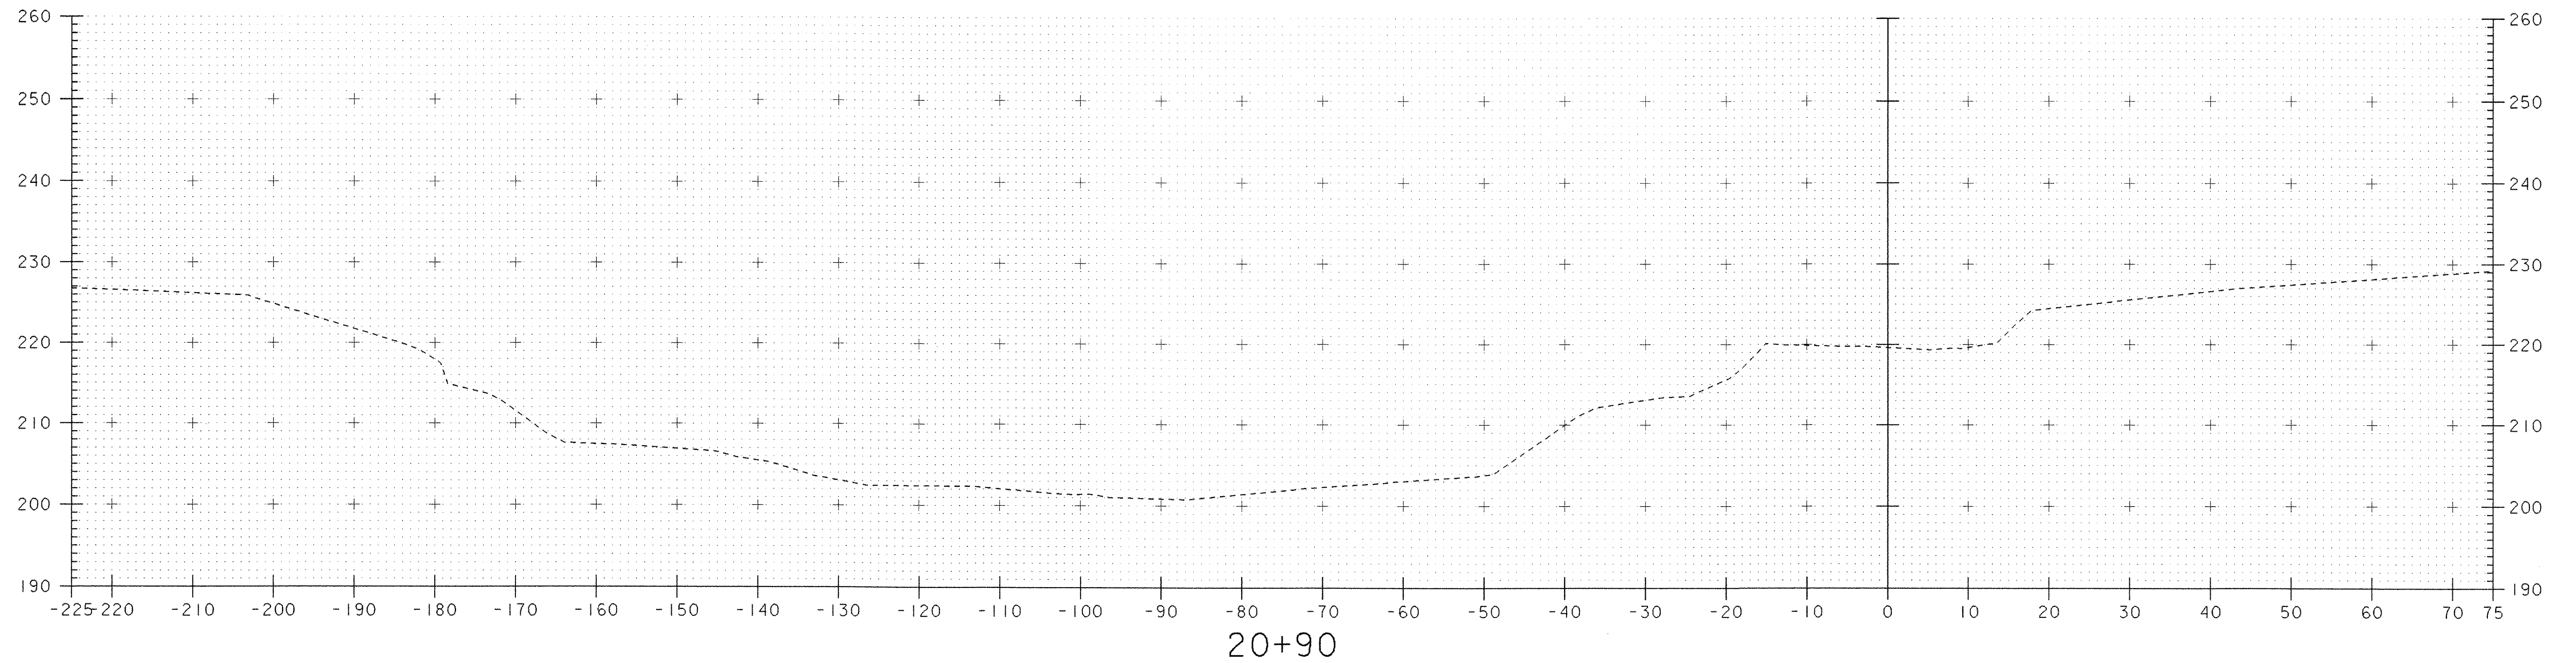


STA 20+80  
(ABUTMENT No. 1)

END STONE FILL TYPE III  
 END GEOTEXTILE UNDER STONE FILL  
 END GRUBBING MATERIAL  
 END UNCLASSIFIED CHANNEL EXCAVATION

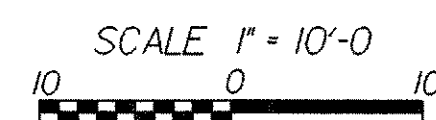

DATUM  
 VERTICAL        NGVD  
 HORIZONTAL        ASSUMED

PROJECT: NEW HAVEN - WEYBRIDGE	PROJECT NO. : BHO-BTN 2005 (1)
DESIGN FILE NAME: /str4/89j081/sj081xs1.dgn	PLOT DATE: 28-FEB-2007
IPARM FILE NAME: sj081c15.i	SURVEY DATE: 7/90
SURVEYED BY: R. MOREAU	DRAWN BY: P.G. JARVIS
SQUAD LEADER: C.P. WILLIAMS	
CHANNEL SECTIONS STA. 20+80 - STA. 20+90 SHEET: 44 OF 53	

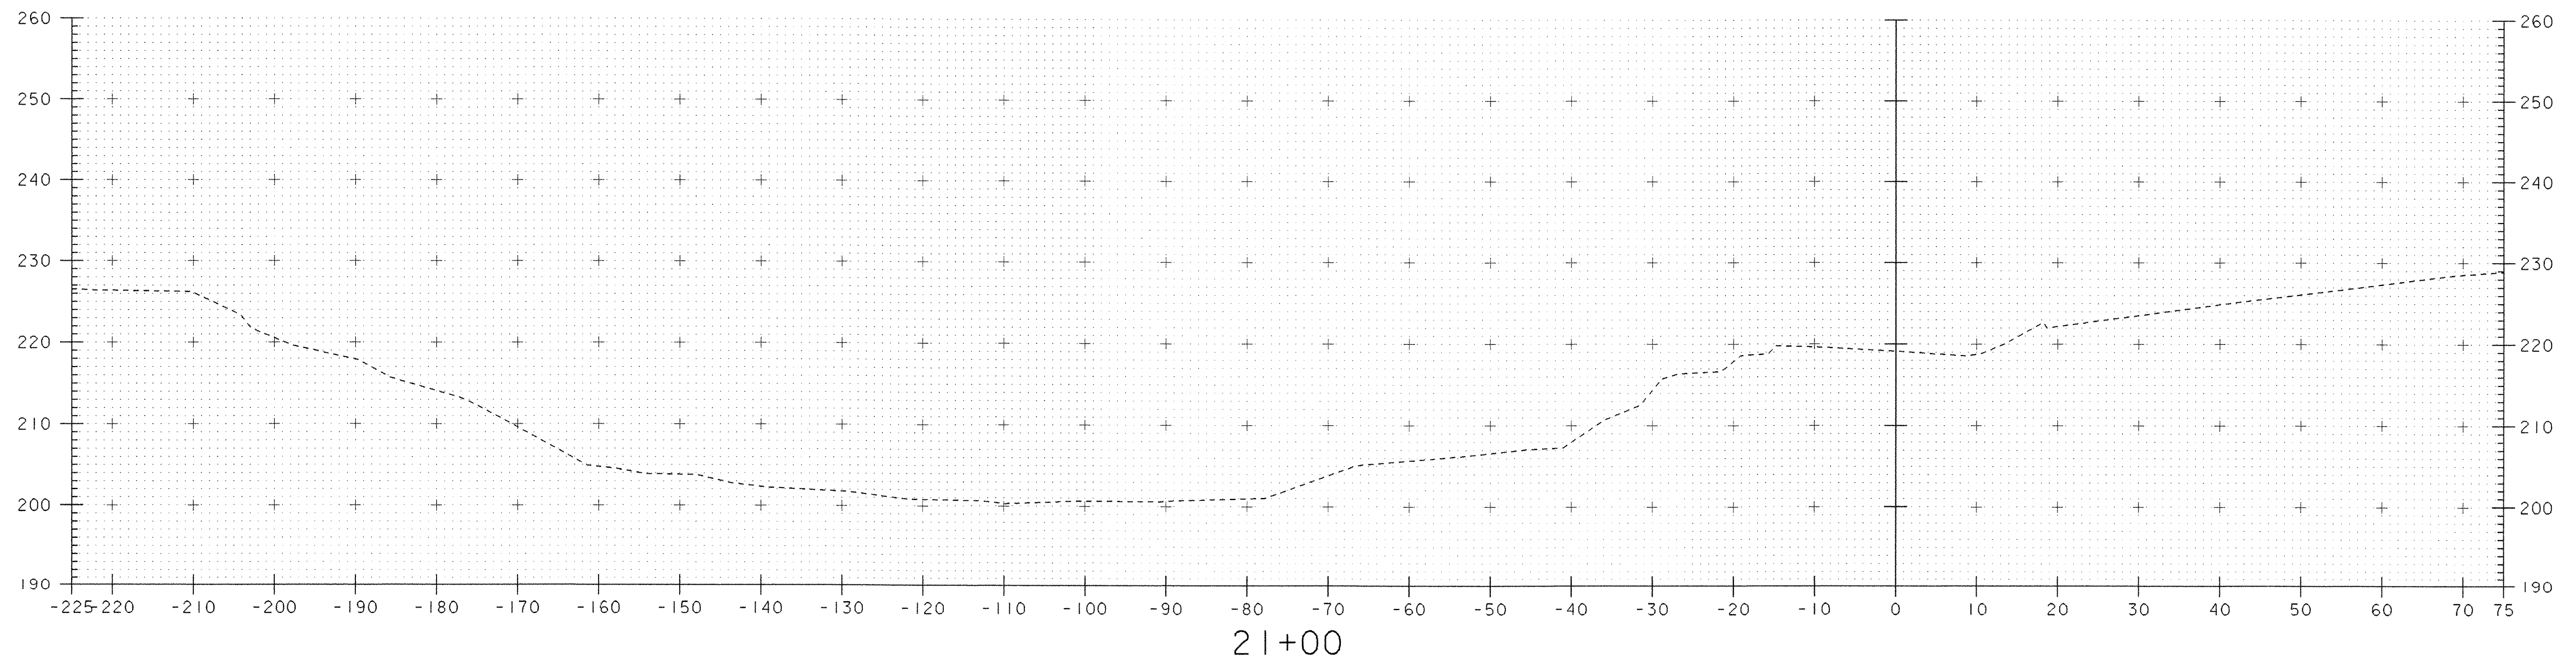

**DATUM**  
 VERTICAL        NGVD  
 HORIZONTAL        ASSUMED

SCALE 1" = 10'-0"

PROJECT: NEW HAVEN - WEYBRIDGE	PROJECT NO.: BHO-BTN 2005 (1)
DESIGN FILE NAME: /str4/89j081/sj081xs1.dgn	PLOT DATE: 28-FEB-2007
IPARM FILE NAME: sj081c16.i	SURVEY DATE: 7/90
SURVEYED BY: R. MOREAU	DRAWN BY: P.G. JARVIS
SQUAD LEADER: C.P. WILLIAMS	SHEET: 45 OF 53
CHANNEL SECTION STA. 21+00	

# EROSION CONTROL NARRATIVE

**DESCRIPTION OF PROJECT**

This project involves the removal and replacement of both abutments and the rehabilitation of bridge number 26. Bridge 26 is a steel thru truss bridge spanning the Otter Creek from New Haven to Weybridge for a distance of 140 feet. The bridge is a single span, single lane bridge located in a rural area on TH 7/11. Because the project is a rehabilitation it will be located on the same alignment and require only minor approach work. Traffic will be maintained by using one of the two alternate routes that make it possible to bypass the bridge while it is closed for the rehabilitation project. The only utility is an overhead phone line that is remaining in place. The limits of construction do not approach any building or structure but there is a dam located 350 feet downstream of the bridge. A temporary floating canoe dock will be built for portage around the dam during construction. There are no 'Threatened & Endangered Species', or Historic Resources on site but there are two archeologically sensitive areas located on the Weybridge side of the project area near stations 10+00 - 11+40.

It is anticipated that this project will last one construction season.

The area of disturbance is .1719 Acres = 832 square yards

**SITE INVENTORY & ANALYSIS**

**OFF SITE DRAINAGE CHARACTERISTICS:**

The property surrounding the project site consists of well established vegetation, mostly flat with slopes at the rivers edge ranging from moderate to steep. The surrounding properties are made up of fields and wooded areas. Due to the nature of the surrounding terrain, runoff water entering the project site will be primarily limited to that which is conveyed along roadway ditches.

**DRAINAGE, WATERWAYS, BODIES OF WATER:**

Otter Creek is the main water source in the area and a dam downstream has created a small pond. The river is classified as sinuous, semi-alluvial, probably incised, and not braided or anabranching. The river bed is sand, gravel, cobbles, and ledge. The contributing drainage area at the bridge crossing is about 749 sq. miles.

**TOPOGRAPHY, EXISTING ROADS, BUILDINGS, UTILITIES:**

The topography of the project site is moderate rolling wooded slopes with a steeply sloped wooded area in the northwest corner of the project area. Development along TH 7/11 consists of a few residents and a dam. There is also an overhead utility running along side of the bridge.

**VEGETATION:**

The vegetation in the area is open with some wooded areas and patches of brush. The impact to vegetation in the area will be limited to that which is effected by construction of the new abutments. After the project is completed the slopes will be stabilized with stone fill and vegetation will be reestablished with standard seed & mulch practices.

**SOILS:**

All soil data came from the U.S. Department of Agriculture Soil Conservation of Addison County. There are two types of soils found at the project site. On the northeast corner and the south end of the project site the soil is classified as Vergennes Clay with slopes of 12-25% and a K-value of 0.49. In the northwest part of the project area the soil is classified as Farmington soil. This is an extremely rocky silty loam with slopes ranging from 20-50% and a K-value of 0.32.

Note: Generally, K-values indicate the following: 0.0 - 0.23 = low erodibility; 0.24 - 0.36 = moderate erodibility; 0.37 and higher = higher erodibility.

**SENSITIVE RESOURCE AREAS:**

No 'Threatened & Endangered Species' have been identified within the project limits and there will be no adverse effect to Historic or Archeological features. However, Otter Creek, the dam, and two archeologically sensitive sites area all located in the general project area.

**PROXIMITY TO NATURAL OR MAN-MADE WATER FEATURES:**

Disturbance of soils near natural or made-made waterways consists of that which is necessary to the removal and replacement of the abutments and minor work to the roadway approaches. Stabilization of disturbance to the stream banks will be accomplished with Stone Fill, Type III.

**TEMPORARY EROSION PREVENTION & SEDIMENT CONTROL**

Temporary erosion prevention measures to be utilized include:

"Project Demarcation Fencing," denoted -PDF- on the plans, to delineate

the limits the contractor can access with construction equipment. This measure limits the area that can be disturbed and exposed to erosion.

Seeding, mulching, and biodegradable erosion control matting or an equivalent product shall be utilized on all slopes greater than 1:3 that are not lined with stone fill. These slopes shall be stabilized within 48 hours of reaching final grade or during intermittent phases of construction activity.

Tracking of all exposed slopes, combined with temporary mulching, will also be utilized on a regular basis. Any slopes to be exposed for several days prior to final grading shall be tracked and mulched. The forecast of rainfall events shall also trigger protection of exposed slopes.

**Temporary measures to control sediment transport include:**

Silt fence will be installed a distance of 5'-10' from the toe of slopes to prevent sediment transport to down gradient areas. Each line of silt fence will be placed along the contour with ends turned slightly uphill to create a ponding effect should water try to run along the fencing and around the ends. The maximum slope length between separate runs of silt fence is 100'. Silt fence shall be installed prior to any upslope earthwork.

Measures such as temporary stone check dams, silt fence, and sand bags shall be checked regularly for accumulation of sediment. Sediment build-up shall be removed when the level of sediment reaches one-half the height of the control measure. Sediments shall be disposed of in an approved area such that they will not be subject to erosion.

Temporary sediment settling basins may or may not be utilized on this project. If a sediment settling basin is to be used for dewatering a cofferdam, it should be sized based upon the following criteria: (See Sediment Settling Basin Sizing Criteria.)

**PERMANENT EROSION CONTROL MEASURES**

Several permanent erosion control measures will be utilized:

Stone lining of the stream banks with Stone Fill, Type III as specified by VTrans Hydraulics personnel is specified. This stone will protect from stream bank erosion during design storm events.

Stone Fill, Type I will be utilized at culvert outlets to dissipate water velocities and reduce erosion potential.

Grass or other suitable ground cover will be established outside of the roadway limits where stone lining has not been specified. Slopes greater than 1 on 3 shall be seeded and mulched promptly upon achieving final grade.

**GENERAL EROSION & SEDIMENT CONTROL GUIDELINES**

The Erosion Control Plans are meant as a guideline for preventing erosion and controlling sediment transport. The work outlined in this narrative consists of applying measures throughout the life of the project to control erosion and minimize the sedimentation of receiving waters. The measures include stabilization and structural practices, storm water controls and other pollution prevention controls.

Coordinate the installation, use, and removal of erosion and sediment control measures with construction activities to ensure economical, effective and continuous erosion and sediment control. Employ temporary stabilization practices in incremental stages as construction proceeds. The contractor will use additional erosion control measures as necessitated by the sequence of construction and as directed by the Engineer. See section 105.23 of the Vermont AOT Standard Specifications for Construction, dated 2006.

Install all erosion and sediment control measures as shown in the Erosion Control Plan or as directed by the Engineer. Do not modify the type, size or location of any control or practice without approval of the Engineer. Any changes shall be noted on the plans, in the weekly inspection report, and reported to the appropriate authority in a timely manner. Inspect all

control measures weekly and after each rainfall event. Repair measures shall be taken as needed.

Preventing initial soil erosion is much more effective than treating eroded sediment. Therefore, stabilize all disturbed areas promptly after construction activity has temporarily or permanently ceased. Temporary vegetation shall be established if the area is to be without construction activity for a period of 14 days. Perimeter control measures shall be installed following clearing, but prior to the start of any grubbing or grading activity, install other temporary controls in incremental stages as construction proceeds.

Maintaining vegetated buffers along stream banks, wetlands or other sensitive areas is a crucial erosion and sediment control measure that should be established wherever possible.

Control only sediment-laden runoff generated by the project site. Collect and route clean offsite runoff around or through the project site using diversion berms, diversion channels, culverts and/or temporary pipes.

Do not allow construction equipment to operate on the down slope side of perimeter control measures.

**SEDIMENT SETTLING BASIN SIZING CRITERIA**

PUMP FLOW RATE		REQUIRED SURFACE AREA		LENGTH WIDTH = 2:1			
Q (gpm)	Q (m <sup>3</sup> /s)	(ft <sup>2</sup> )	(m <sup>2</sup> )	L (ft)	W (ft)	L (m)	W (m)
50	0.0032	595	55	35.0	17.0	10.6	5.3
100	0.0063	1200	111	49.0	24.5	15.0	7.5
150	0.0095	1776	165	59.6	29.8	18.2	9.1
200	0.0126	2368	220	68.8	34.4	21.0	10.5
250	0.0158	2970	276	77.0	38.5	23.4	11.7
300	0.0189	3560	330	84.4	42.2	25.8	12.9
350	0.0221	4155	386	91.2	45.6	27.8	13.9

PROJECT NAME:	New Haven-Weybridge		
PROJECT NUMBER:	89j081		
FILE NAME:	89j081/Str/s89j081ecnotes.dgn	PLOT DATE:	1/23/2007
PROJECT LEADER:	C.P. WILLIAMS	DRAWN BY:	H.I. SALLS
DESIGNED BY:	H.I. SALLS	CHECKED BY:	R.S. YOUNG
EROSION NARRATIVE		SHEET	46 OF 53

EROSION AND SEDIMENT CONTROL NOTES:

- 1) THE AREA OF DISTURBANCE IS 0.171 ACRES.
- 2) AN UPGRADED TEMPORARY EROSION PREVENTION AND SEDIMENT CONTROL PLAN SHALL BE SUBMITTED BY THE CONTRACTOR FOR APPROVAL BY THE AGENCY OF TRANSPORTATION.
- 3) ANY CHANGES MADE TO THE EROSION PREVENTION AND SEDIMENT CONTROL PLAN DURING CONSTRUCTION SHALL BE APPROVED BY THE RESIDENT ENGINEER AND DOCUMENTED.
- 4) TIME ALL GRADING TO MINIMIZE SOIL EXPOSURE.
- 5) RETAIN EXISTING VEGETATION WHENEVER FEASIBLE.
- 6) AT THE END OF EACH DAY'S GRADING OPERATIONS, SHAPE EARTHWORK TO MINIMIZE THE EROSION FROM STORM RUNOFF.
- 7) TEMPORARILY MULCH AND SURFACE ROUGHEN ALL DISTURBED AREAS WHICH WILL NOT RECEIVE FURTHER DISTURBANCE FOR A PERIOD OF 7 DAYS OR MORE.
- 8) TEMPORARILY SEED AND MULCH ALL DISTURBED AREAS WHICH WILL NOT RECEIVE FURTHER DISTURBANCE FOR A PERIOD OF 30 DAYS OR MORE.
- 9) FINAL SEED AND COVER SHALL BE APPLIED WITHIN 48 HOURS OF FINAL GRADING.
- 10) ALL AREAS DISTURBED DURING CONSTRUCTION SHALL BE RETURNED TO THEIR ORIGINAL CONDITION INCLUDING SEEDING AND MULCHING.
- 11) KEEP RUNOFF VELOCITIES LOW. CONSTRUCT CHECK DAMS AS REQUIRED.
- 12) PREPARE TEMPORARY DRAINAGE WAYS TO HANDLE CONCENTRATED FLOW UNTIL PERMANENT DRAINAGE IS CONSTRUCTED AND STABILIZED.
- 13) ALL DISTURBED AREAS WITH SLOPES GREATER THAN 1:3 WILL REQUIRE EROSION MATTING (SEE EROSION AND SEDIMENT CONTROL DETAIL SHEET 52).
- 14) SPECIAL CONSIDERATION MUST BE GIVEN TO THE FIRST PUMP-DOWN OF THE COFFERDAMS. THIS WILL CONTAIN THE GREATEST VOLUME OF WATER WITH A HIGH SEDIMENT LOAD. THE CONTRACTOR MAY PROVIDE ADDITIONAL SEDIMENT TRAPS WITHIN THE RIGHT-OF-WAY IF REQUIRED OR CONTROL THE RATE OF DRAW-DOWN. ADDITIONAL SEDIMENT TRAPS MUST BE APPROVED BY THE RESIDENT ENGINEER.
- 15) CLEAN SEDIMENT CONTROL MEASURES (SEDIMENT TRAPS, SILT FENCE, ETC.) WHEN HALF FULL OF SEDIMENT.
- 16) AFTER COMPLETION OF THE SUBSTRUCTURE, THE SEDIMENT IN THE TRAPS SHALL BE REMOVED AND THE GROUND RESTORED TO ITS ORIGINAL SLOPES OR GRADED AS SHOWN ON THE CONSTRUCTION DRAWINGS.
- 17) THE CONTRACTOR WILL USE OTHER TEMPORARY OR PERMANENT EROSION CONTROL MEASURES AS NECESSITATED BY THE SEQUENCE OF CONSTRUCTION AND AS DIRECTED BY THE RESIDENT ENGINEER. SEE SECTION 105.23 OF THE VERMONT AGENCY OF TRANSPORTATION STANDARD SPECIFICATIONS FOR CONSTRUCTION DATED 2006.
- 18) MONITOR AND MAINTAIN ALL EROSION AND SEDIMENT CONTROL MEASURES DAILY AND AFTER EACH RAIN STORM.
- 19) SEE SHEETS 48 - 53 FOR EROSION AND SEDIMENT CONTROL DETAILS.
- 20) ASK FOR ASSISTANCE AND RECOMMENDATIONS AS NEEDED.

**SEEDING FORMULA  
RURAL AREAS**

% WT.	LBS./A.	NAME	PUR %	GERM %
37.5	22.5	CREEPING RED FESCUE	98	85
37.5	22.5	TALL FESCUE	95	90
5.0	3.0	RED TOP	95	90
15.0	9.0	BIRDSFOOT TREFOLI	98	85
5.0	3.0	ANNUAL RYEGRASS	95	85
100.0	60.0			

**GENERAL NOTES**

SEED MIXTURE: SHALL NOT HAVE A WEED CONTENT EXCEEDING 0.40% BY WEIGHT AND SHALL BE FREE OF ALL NOXIOUS SEED.

SEED: TO BE APPLIED PER SEEDING FORMULAS OR AS DIRECTED BY THE ENGINEER.

FERTILIZER: FORMULA 10-20-10, TO BE USED WITH SEED, APPLIED AT THE RATE OF 500 LBS./ACRE. (HYDRO SEEDERS MAY USE 19-19-19 FORMULA).

AGRICULTURAL LIMESTONE: TO BE APPLIED AT THE RATE OF 2 TONS/ACRE, OR AS DIRECTED BY THE ENGINEER.

HAY MULCH: TO BE PLACED ON EARTH SLOPES AT THE RATE OF 2 TONS/ACRE, OR AS DIRECTED BY THE ENGINEER.

TOPSOIL: TO BE USED WITH SEED AS INDICATED ON THE PLANS, OR AS DIRECTED BY THE ENGINEER.

GENERAL NOTES:


- 1) PRIOR TO CONSTRUCTION, THE CONTRACTOR SHALL PROVIDE THE FOLLOWING ADDITIONAL INFORMATION FOR APPROVAL AND INCLUSION IN THE COMPLETE EROSION AND SEDIMENT CONTROL PLANS:
  - LOCATION OF WASTE, BORROW AND STAGING AREAS, MATERIAL STOCKPILES, REFUELING AND MAINTENANCE AREAS AND CONCRETE TRUCK WASHOUT LOCATION (ATTACH MAP IF NECESSARY). A DISCUSSION AND ADDITIONAL DETAILS NEEDED FOR PROTECTION AND STABILIZATION OF THESE AREAS SHALL BE INCLUDED AS WELL.
  - MODIFICATIONS REQUIRED TO THESE EROSION AND SEDIMENT CONTROL PLANS.
  - GRADING PLAN / CONSTRUCTION SEQUENCE (INCLUDING PROPOSED DATES ASSOCIATED WITH JOB MILESTONES AS INDICATED ON THE SEQUENCE CONSISTENT WITH PROJECT CRITICAL PATH METHOD SCHEDULE.)
  - REVISED NARRATIVE MATCHING THE GRADING PLAN AND CONSTRUCTION SEQUENCE (RE: TEMPORARY SEEDING AND MULCHING / STABILIZATION).
  - NAME, ADDRESS, PHONE NUMBER AND BASIC QUALIFICATIONS OF "ON-SITE COORDINATOR".
- 2) WORK SHALL BE GENERALLY CONSISTENT WITH GUIDANCE PROVIDED IN THE LATEST REVISION OF THE VERMONT HANDBOOK FOR SOIL EROSION AND SEDIMENT CONTROL ON CONSTRUCTION SITES AND THE ASSOCIATED GENERAL CONTRACTORS OF VERMONT FIELD HANDBOOK.

PERIMETER CONTROL NOTES:

- 1) IDENTIFY SENSITIVE AREAS AND AREAS PRONE TO EROSION BASED ON SITE EVALUATION.
- 2) CLEARLY DEMARCAT SENSITIVE AREAS TO AVOID DISTURBANCE USING BRIGHTLY COLORED SNOW FENCE, MIN 8" WIDE FLAGGING OR SIMILAR.
- 3) PROTECT ALL SENSITIVE AREAS AND WATER FEATURES FROM SEDIMENT.
- 4) DIVERT OR OTHERWISE KEEP ALL CONCENTRATED OFF-SITE "RUN-ON" FROM AREAS TO BE DISTURBED.
- 5) PERIMETER CONTROLS (SILT FENCE, FILTER CURTAIN, ETC.) TO BE INSTALLED PRIOR TO SOIL DISTURBANCE AND MAINTAINED UNTIL SITE IS PERMANENTLY STABILIZED TO THE SATISFACTION OF THE ENGINEER AND ON-SITE COORDINATOR.
- 6) SEED AND MULCH SHALL BE APPLIED IMMEDIATELY TO ALL LAWNS DISTURBED BEYOND THE WORK AREA DELINEATED ON THESE PLANS.
- 7) PREVENT SEDIMENT FROM LEAVING THE SITE BY MAINTAINING AND MODIFYING PERIMETER CONTROLS AS NEEDED.

DATUM  
VERTICAL NGVD 1929  
HORIZONTAL ASSUMED

PROJECT: <b>NEW HAVEN-WEYBRIDGE</b>	PROJECT NO.: <b>BHO-BTN2005 (1)</b>
DESIGN FILE NAME: pw89j081/s89j081ecnotes.dgn	PLOT DATE: 28-FEB-2007
IPARM FILE NAME: sj081ecnotes.i	SURVEY DATE: 7/90
SURVEYED BY: R. MOREAU	DRAWN BY: J. WHITE
SQUAD LEADER: C.P. WILLIAMS	SHEET: 47 OF 53
EROSION CONTROL NOTE SHEET	

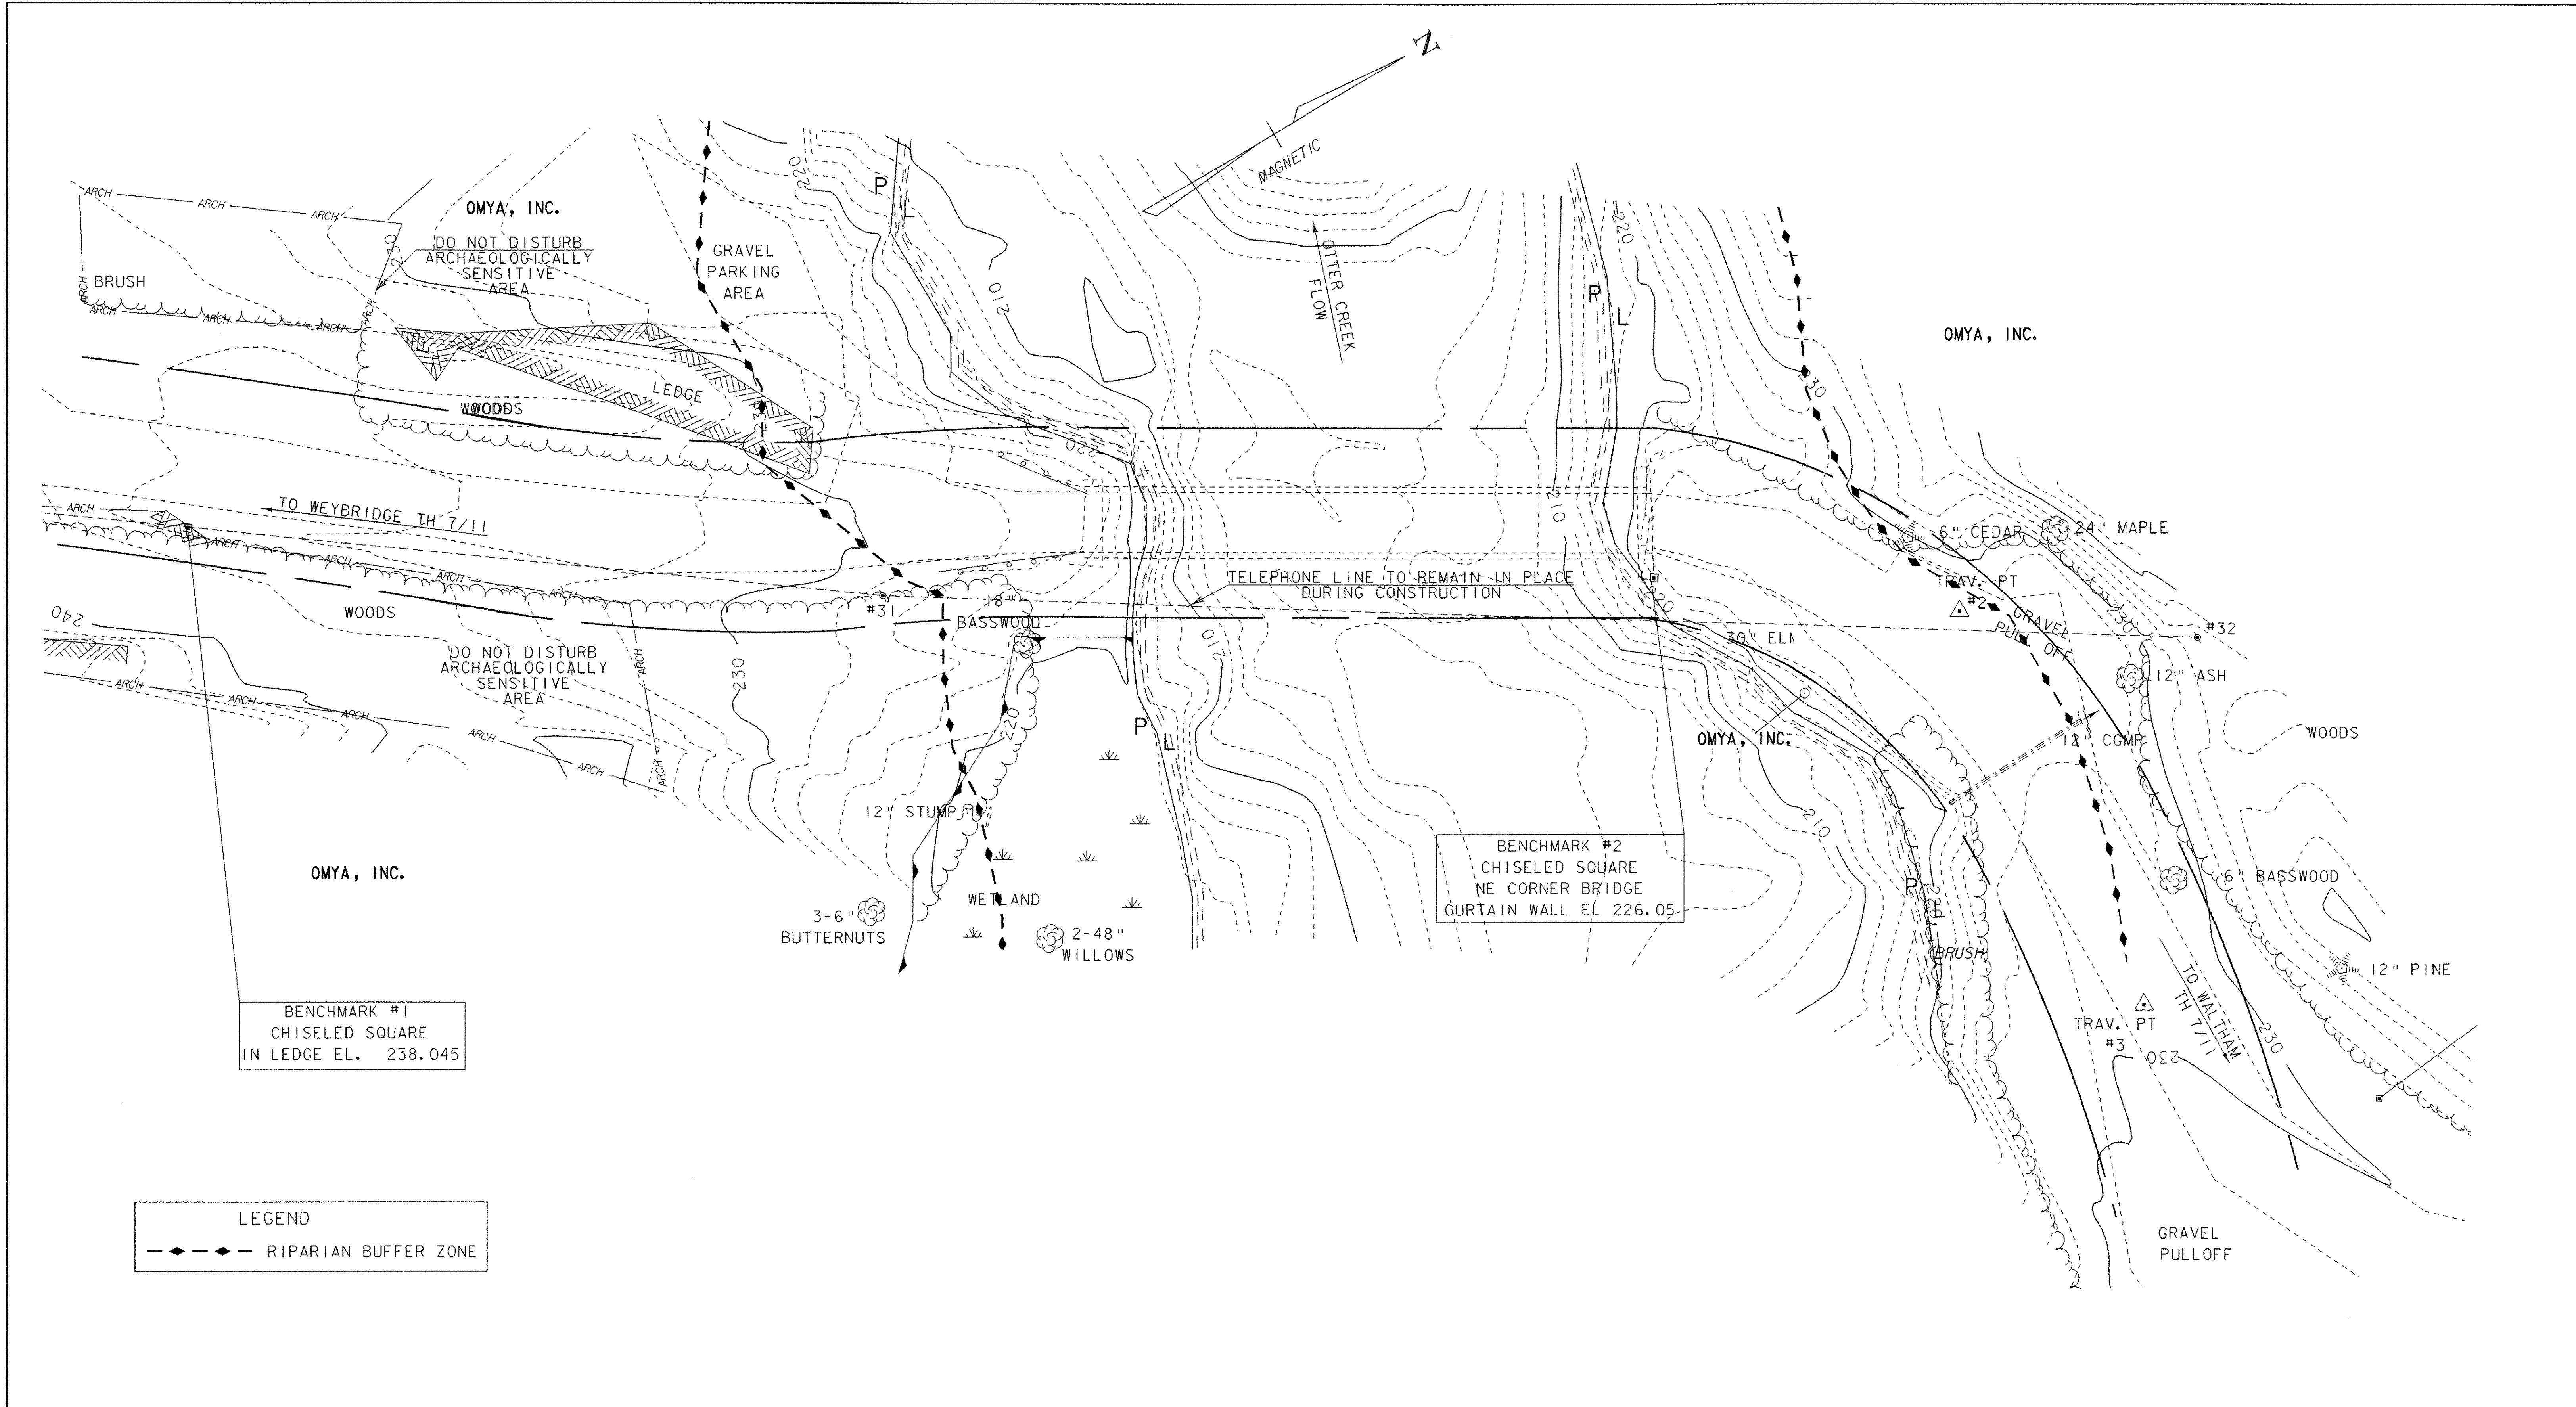

EXISTING CONDITIONS

SCALE 1" = 20'-0"  
 20 0 20

DATUM  
 VERTICAL NGVD 1929  
 HORIZONTAL ASSUMED

LEGEND  
 -◆-◆- RIPARIAN BUFFER ZONE

PROJECT: NEW HAVEN-WEYBRIDGE	PROJECT NO.: BHO-BTN 2005(I)
DESIGN FILE NAME: /usr/str4/89j081/sj08lbr.dgn	PLOT DATE: 28-FEB-2007
IPARM FILE NAME: sj08lexcond.i	SURVEY DATE: 7/90
SURVEYED BY: R. MOREAU	DRAWN BY: M.FESSEL
SQUAD LEADER: C.P. WILLIAMS	SHEET: 48 OF 53
EXISTING CONDITIONS	

**SOIL CLASSIFICATION**  
 SOIL TYPE - FARMINGTON EXTREMELY ROCKY SILT LOAM  
 SLOPES - 20-50 %  
 "K FACTOR" 0.32  
 CLASSIFIED - HIGHLY ERODIBLE

**SOIL CLASSIFICATION**  
 SOIL TYPE - VERGENNES CLAY  
 SLOPES - 12-25 %  
 "K FACTOR" 0.49  
 CLASSIFIED - HIGHLY ERODIBLE

**SOIL CLASSIFICATION**  
 SOIL TYPE - VERGENNES CLAY  
 SLOPES - 12-25 %  
 "K FACTOR" 0.49  
 CLASSIFIED - HIGHLY ERODIBLE

**BENCHMARK #1**  
 CHISELED SQUARE  
 IN LEDGE EL. 238.045

**BENCHMARK #2**  
 CHISELED SQUARE  
 NE CORNER BRIDGE  
 CURTAIN WALL EL 226.05

IF NECESSARY - APPROXIMATE LOCATION  
 TO CONSTRUCT SEDIMENT BASIN TO TRAP  
 SEDIMENT PUMPED FROM STRUCTURE  
 EXCAVATION.

- NOTES:**
1. THESE PLANS SHOW A CONCEPTUAL EROSION CONTROL PLAN, THE CONTRACTOR MUST SUBMIT A TEMPORARY EROSION CONTROL PLAN FOR APPROVAL.
  2. TEMPORARY EROSION CONTROL MEASURES ARE CONCEPTUALLY SHOWN. THE CONTRACTOR MAY RELOCATE TEMPORARY MEASURES TO IMPROVE EROSION CONTROL WITH APPROVAL OF THE RESIDENT ENGINEER AND ON SITE COORDINATOR. SILT FENCE SHALL NOT BE INSTALLED ACROSS CONTOURS.
  3. THE CONTRACTOR SHALL USE OTHER TEMPORARY EROSION CONTROL MEASURES AS NECESSITATED BY THE SEQUENCE OF CONSTRUCTION OR AS DIRECTED BY THE RESIDENT ENGINEER AND ON SITE COORDINATOR.
  4. REFER TO TEMPORARY EROSION CONTROL DETAIL SHEETS FOR ADDITIONAL DETAILS.

**LEGEND**

—x—x—x—	BARRIER FENCE
— — — —	FILTER CURTAIN
— — — —	SILT FENCE
PDF	PROJECT DEMARCATION FENCE
—♦—♦—♦—	RIPARIAN BUFFER ZONE
▨	EROSION MATTING
■	SEED AND STRAW MULCH


**DATUM**  
 VERTICAL NGVD 1929  
 HORIZONTAL ASSUMED

20 0 20  
 SCALE 1" = 20' - 0

**EROSION PREVENTION AND SEDIMENT CONTROL PLAN**

SEE CROSS SECTIONS FOR  
 PROPOSED CONTOURS.

PROJECT: NEW HAVEN-WEYBRIDGE	PROJECT NO.: BHO-BTN 2005(1)
DESIGN FILE NAME: /usr/str4/89j081/sj081bdr.dgn	PLOT DATE: 28-FEB-2007
IPARM FILE NAME: sj081eroplan.i	SURVEY DATE: 7/90
SURVEYED BY: R. MOREAU	DRAWN BY: M.FESSEL
SQUAD LEADER: C.P. WILLIAMS	
EROSION PREVENTION AND SEDIMENT CONTROL PLANS SHEET: 49 OF 53	

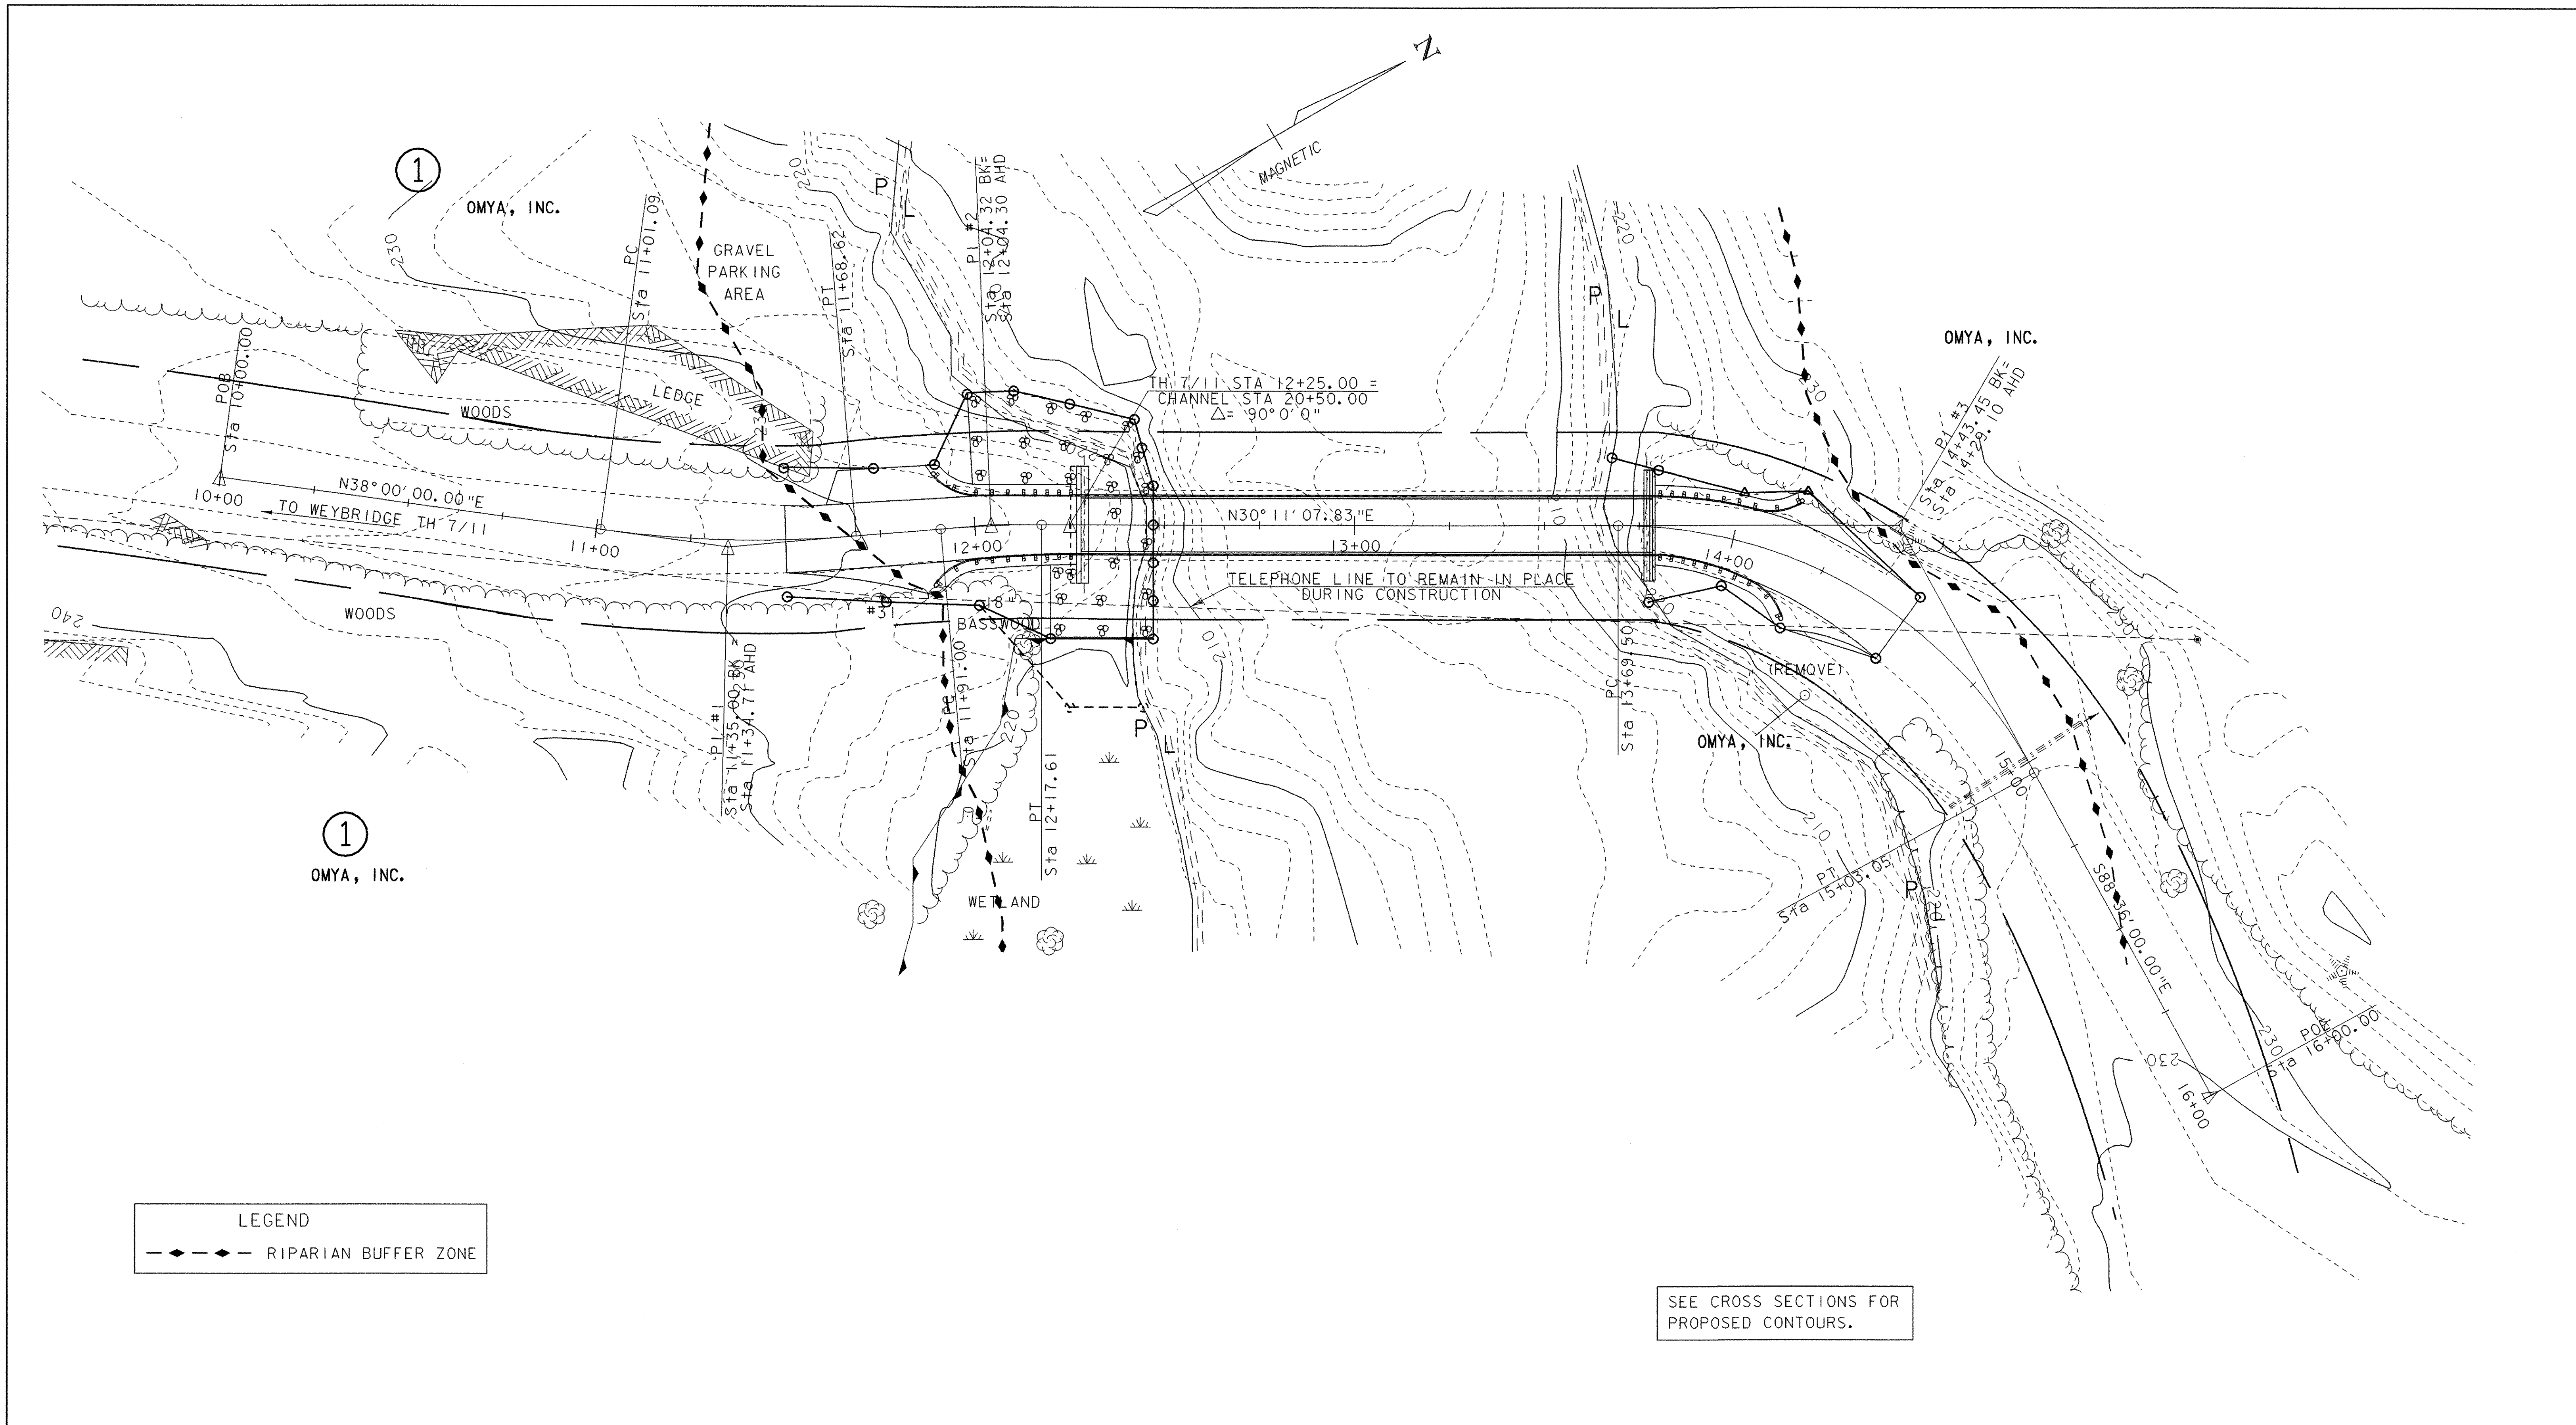

①  
OMYA, INC.

①  
OMYA, INC.

LEGEND  
 -◆-◆- RIPARIAN BUFFER ZONE

SEE CROSS SECTIONS FOR  
 PROPOSED CONTOURS.



FINAL CONDITIONS

SCALE 1" = 20'-0"  
 20 0 20

DATUM  
 VERTICAL NGVD 1929  
 HORIZONTAL ASSUMED

PROJECT: NEW HAVEN-WEYBRIDGE	PROJECT NO.: BHO-BTN 2005(I)
DESIGN FILE NAME: /usr/str4/89j081/sj08lbr.dgn	PLOT DATE: 28-FEB-2007
IPARM FILE NAME: sj08lfincond.i	SURVEYED BY: R. MOREAU
SQUAD LEADER: C.P. WILLIAMS	SURVEY DATE: 7/90
FINAL CONDITIONS	DRAWN BY: H.J. SALLS
	SHEET: 50 OF 53

# SILT FENCE

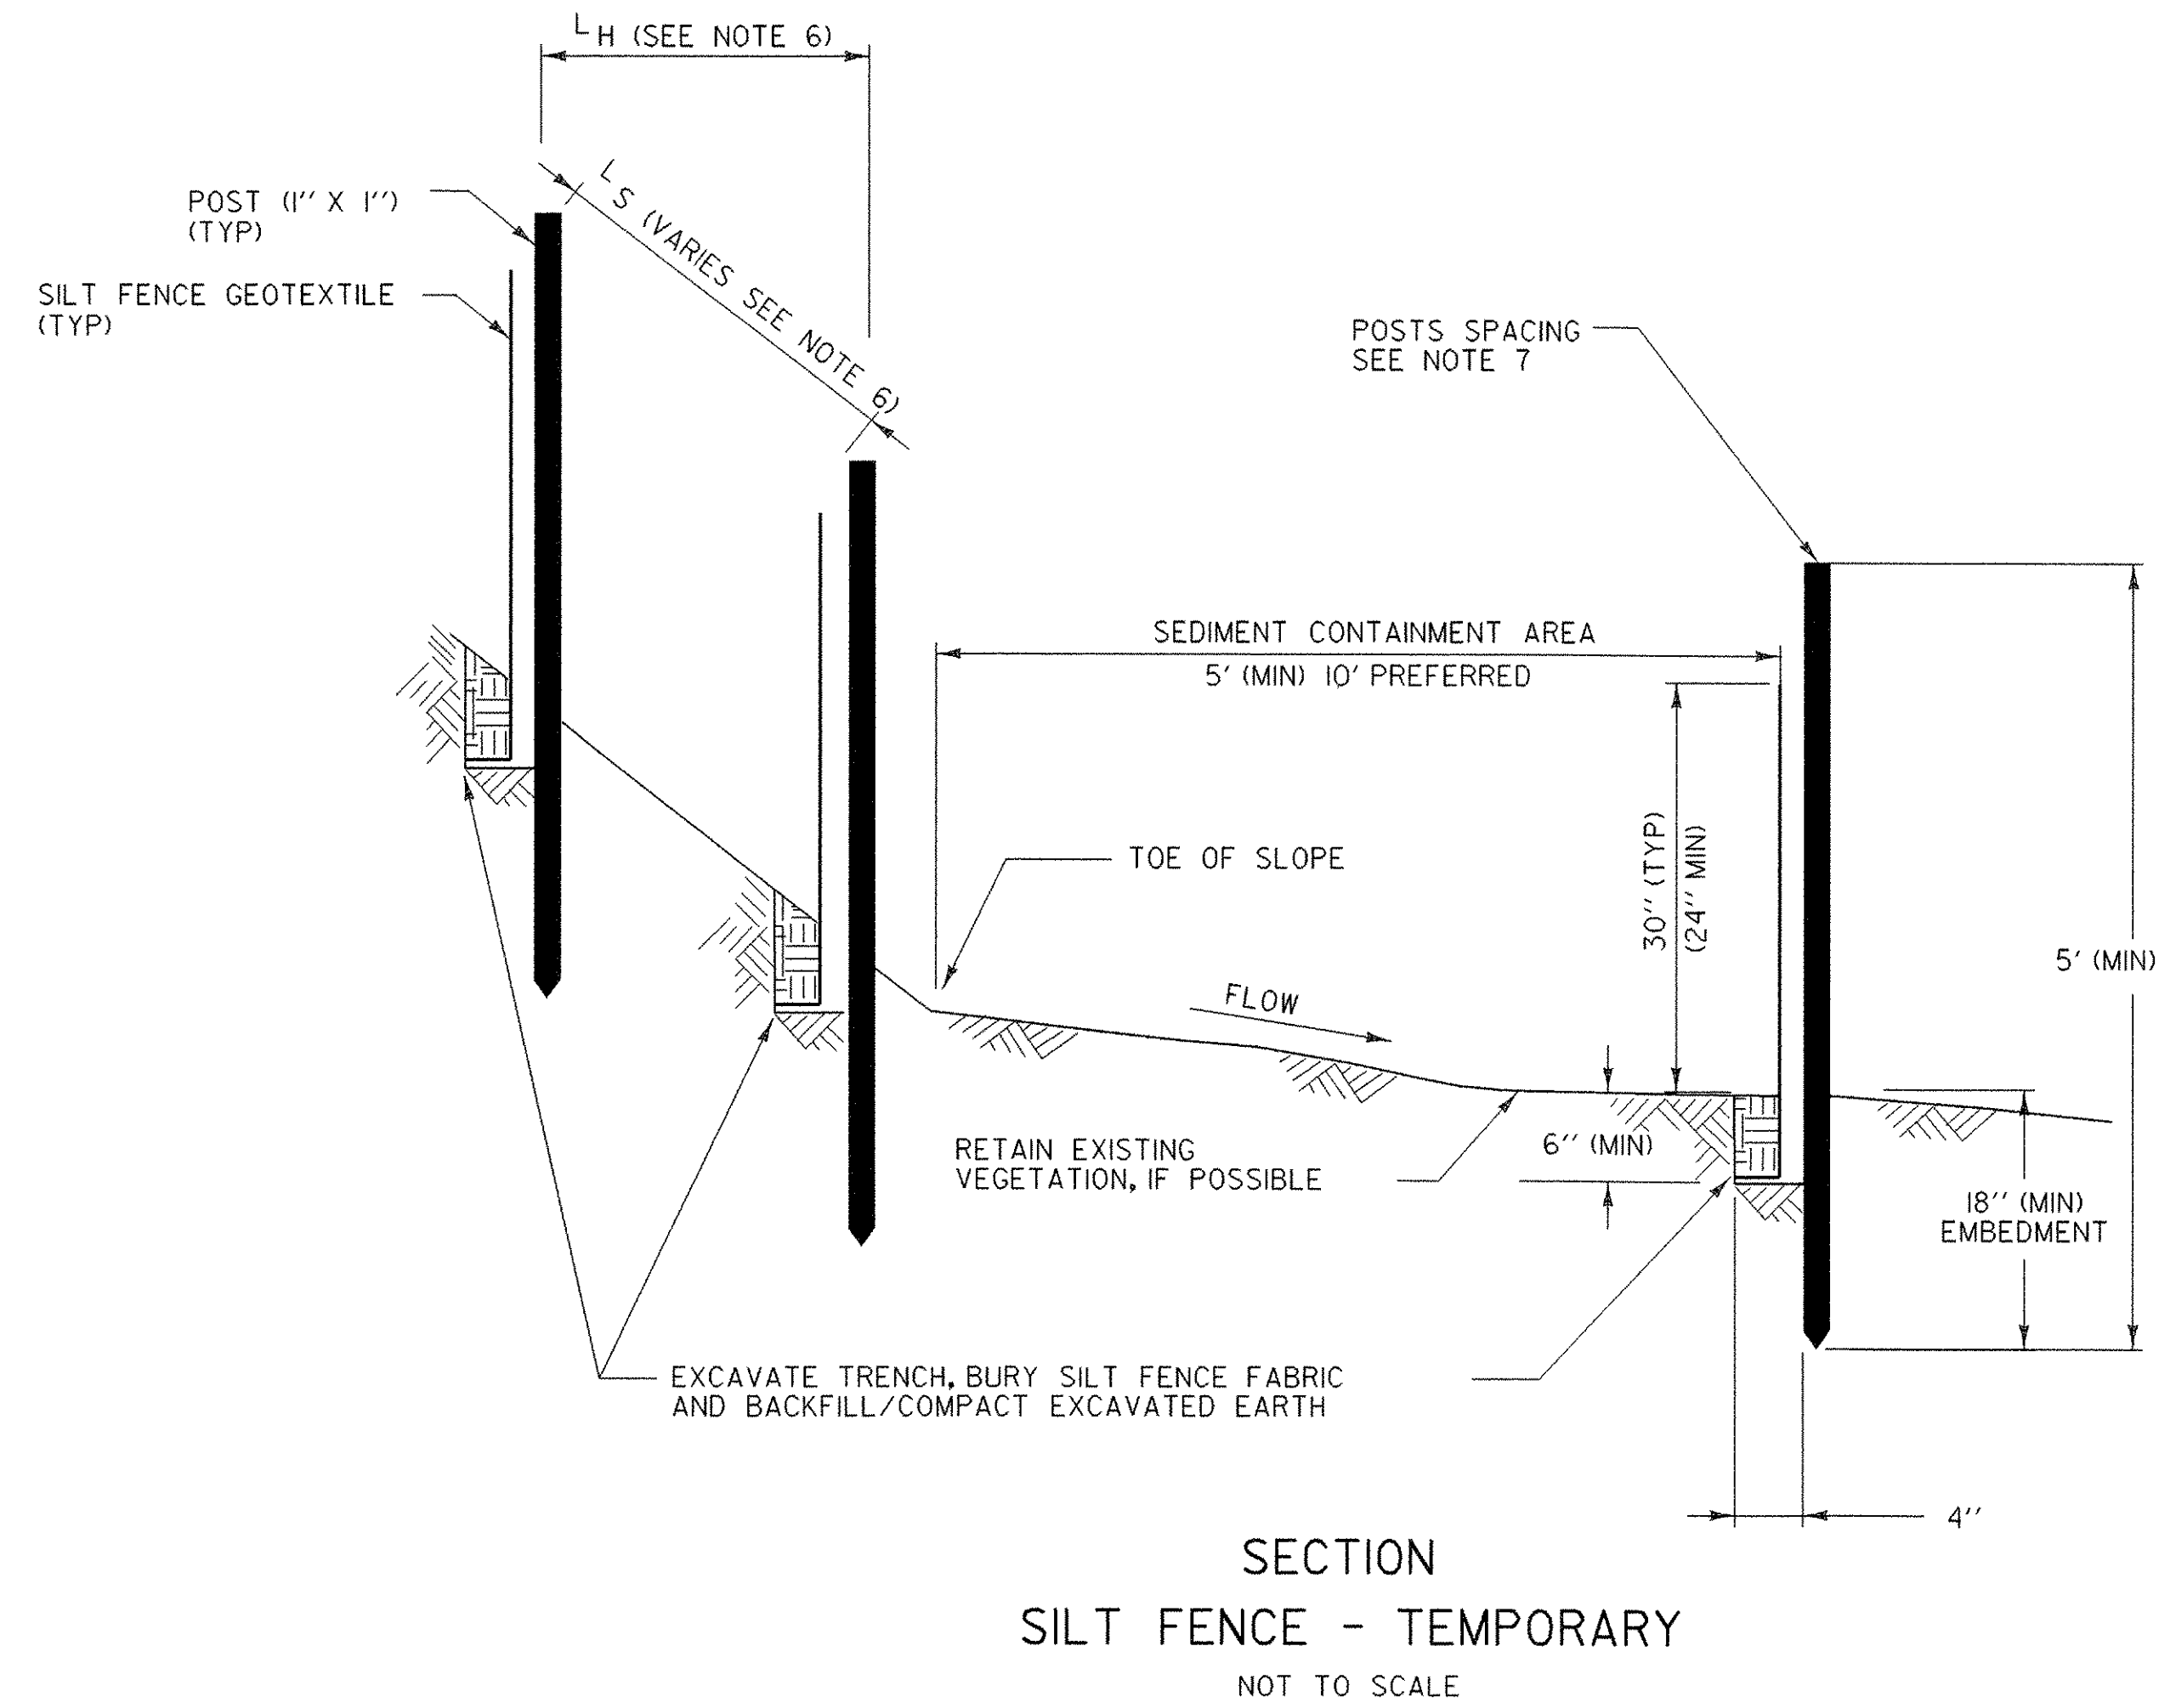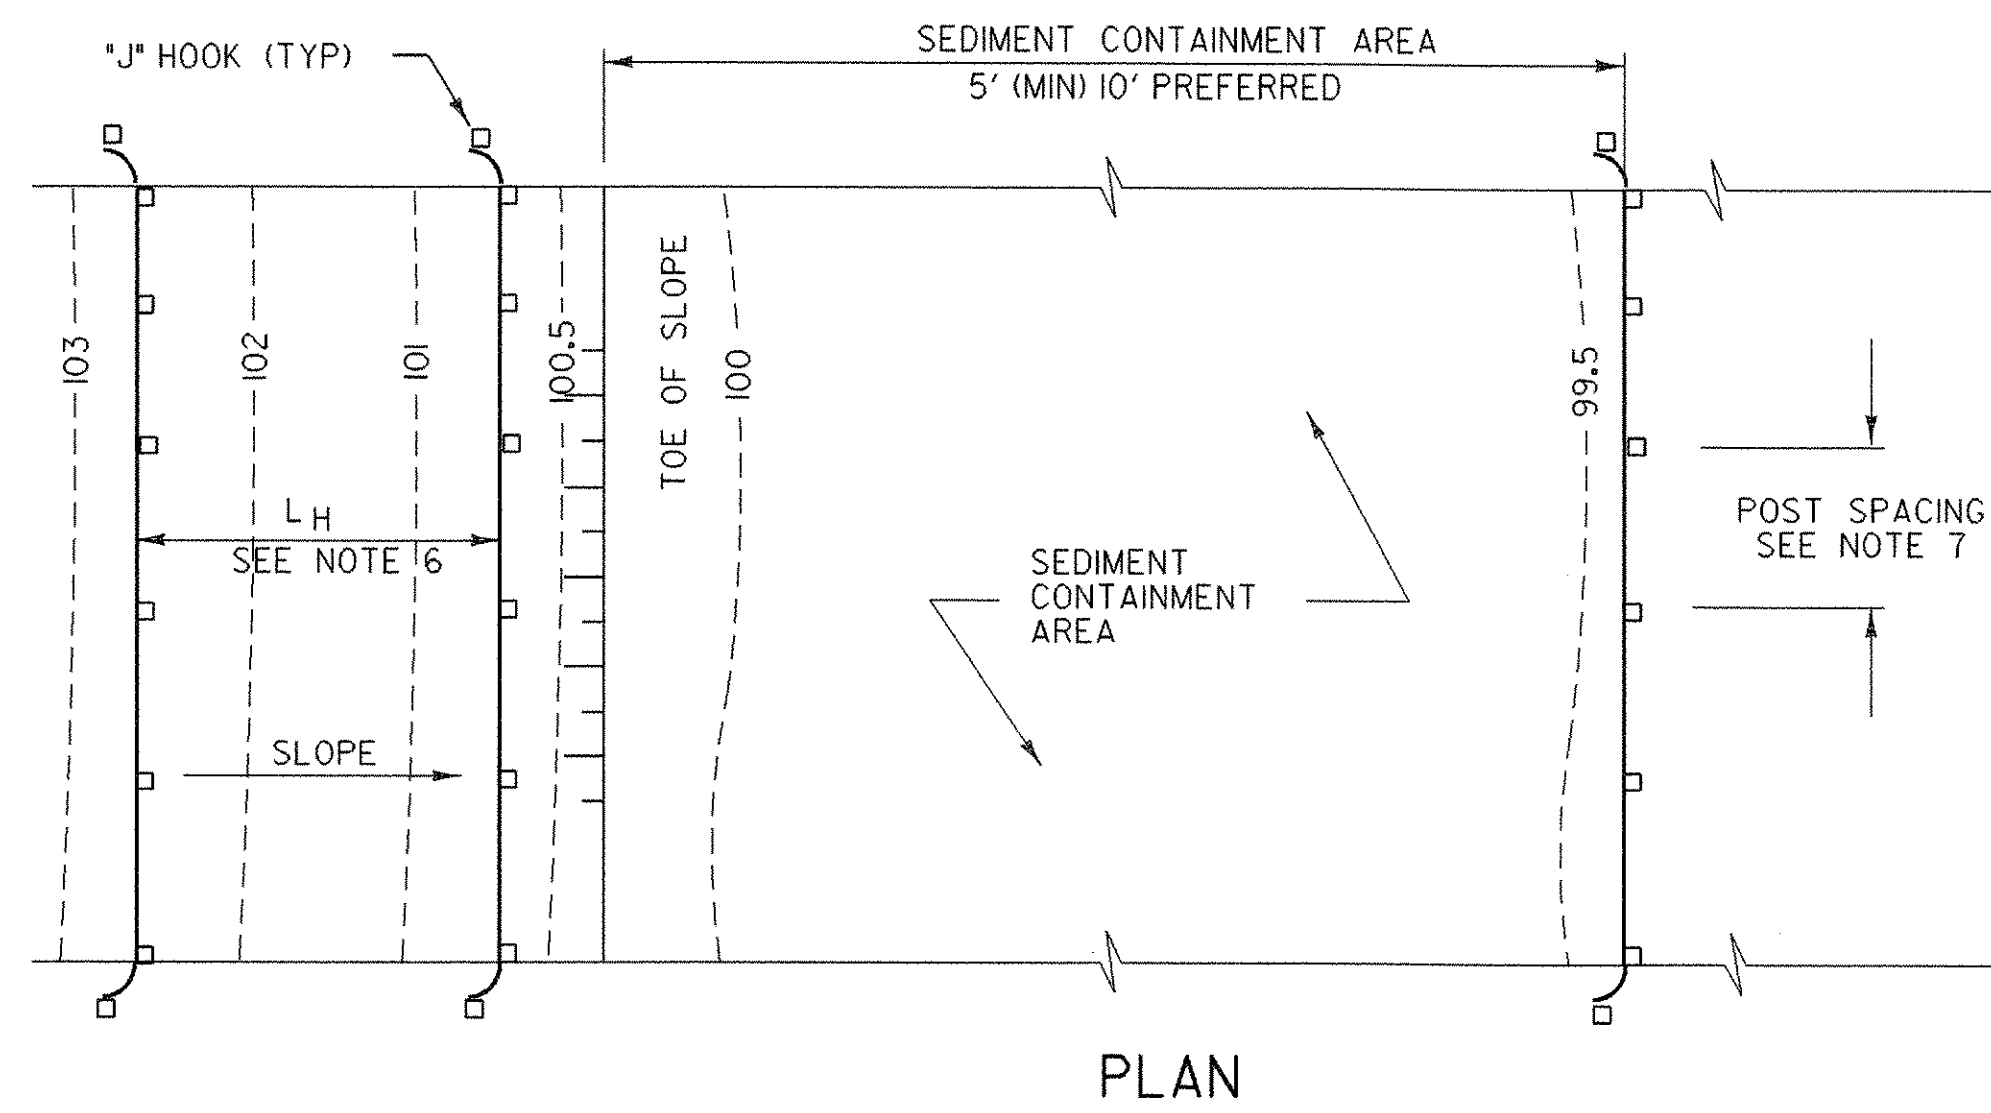

## APPLICATION NOTES:


- A. THE PRIMARY PURPOSE OF SILT FENCE IS TO REDUCE RUNOFF VELOCITY AND TRAP SEDIMENT. VELOCITY IS REDUCED, WATER IS IMPOUNDED BEHIND THE MEASURE, AND SEDIMENT FALLS OUT OF SUSPENSION.
- B. SILT FENCE SHALL NOT BE USED ACROSS CONCENTRATED FLOW.

## GENERAL NOTES:

1. SILT FENCE SHALL GENERALLY BE PLACED A MINIMUM OF 5 FEET BEYOND TOE OF SLOPE, 10 FEET PREFERRED, TO PROVIDE ADEQUATE AREA FOR SEDIMENT STORAGE AND FACILITATE MAINTENANCE OF SEDIMENT CONTAINMENT AREA.
2. SILT FENCE SHALL BE INSTALLED ON A LINE OF EQUAL ELEVATION (CONTOUR). IT MAY BE INSTALLED AT INTERMEDIATE POINTS UP SLOPES AS WELL AS AT THE BOTTOM, AS SHOWN IN THE DETAIL.
3. ALL ENDS SHALL BE "J" HOOKED TO TRAP SEDIMENT.
4. IN AREAS WITH TWO SLOPES, SILT FENCE SHALL BE USED TO ERECT A DAM AND TRAP SEDIMENT AT THE BASE OF THE STEEPER SLOPE.
5. THE BOTTOM EDGE OF SILT FENCE SHALL BE BURIED A MINIMUM OF 6 INCHES BELOW GROUND, AND KEYED IN 4 INCHES. THE FENCE SHALL BE INSTALLED WITH THE POSTS ON THE DOWNSTREAM SIDE OF THE FABRIC.
6. MAXIMUM DRAINAGE AREA TRIBUTARY TO 100 FEET OF SILT FENCE SHALL BE 0.25 ACRES.
7. THE FOLLOWING ARE MAXIMUM LENGTHS FOR SILT FENCE INSTALATIONS:

CONSTRUCTED SLOPE	SLOPE LENGTH (LS) FT	HORIZONTAL LENGTH (LH) FT
3H : 4V	80	75
4H : 4V	130	125
5H : 4V	200	200
> 5H : 4V	250	250

8. WHERE ELONGATION IS >50%, POST SPACING SHALL NOT EXCEED 4 FEET. WHERE ELONGATION IS <50%, POST SPACING SHALL NOT EXCEED 6 FEET.
9. SILT FENCE SHALL BE INSPECTED EVERY SEVEN (7) CALENDAR DAYS AND WITHIN 24 HOURS OF A STORM EVENT GREAT ENOUGH TO CAUSE WATER TO LEAVE THE CONSTRUCTION SITE.
10. SILT FENCE SHALL BE CLEANED AND REPAIRED AS NEEDED. SEDIMENT SHALL BE REMOVED WHEN ACCUMULATION REACHES ONE-HALF OF THE MEASURE HEIGHT. SEDIMENT SHALL BE DISPOSED OF AT AN APPROVED WASTE SITE.
11. SILT FENCE SHALL BE REMOVED WHEN THE AREA HAS BEEN STABILIZED. AT TIME OF REMOVAL OF THE SILT FENCE, THE DISTURBED AREA SHALL BE REPAIRED AND STABILIZED.

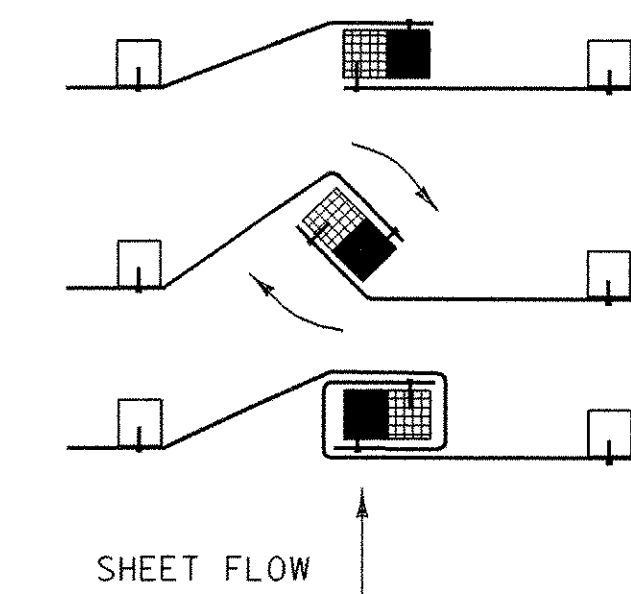


1. PLACE THE END POST OF ONE FENCE INSIDE THE END POST OF THE OTHER FENCE.
2. ROTATE BOTH POSTS AT LEAST 180 DEGREES IN A CLOCKWISE DIRECTION TO CREATE A TIGHT SEAL WITH THE FABRIC MATERIAL.
3. DRIVE BOTH POSTS 18 INCHES INTO THE GROUND AND BURY THE FLAP IN THE TRENCH.

SPlicing DETAIL  
NOT TO SCALE

## EROSION PREVENTION & SEDIMENT CONTROL DETAILS SILT FENCE

PROJECT: NEW-HAVEN WEYBRIDGE	PROJECT NO.: BHO BTN2005 (1)
DESIGN FILE NAME: 89j081\structures\sj081erodef.dgn	PLOT DATE: 28-FEB-2007
IPARM FILE NAME: sj081epscl.i	DESIGNED BY: CONST. ENV. SECTION
SQUAD LEADER: C.P. WILLIAMS	CHECKED BY: A. CABRAL
SILT FENCE	SHEET: 51 OF 53

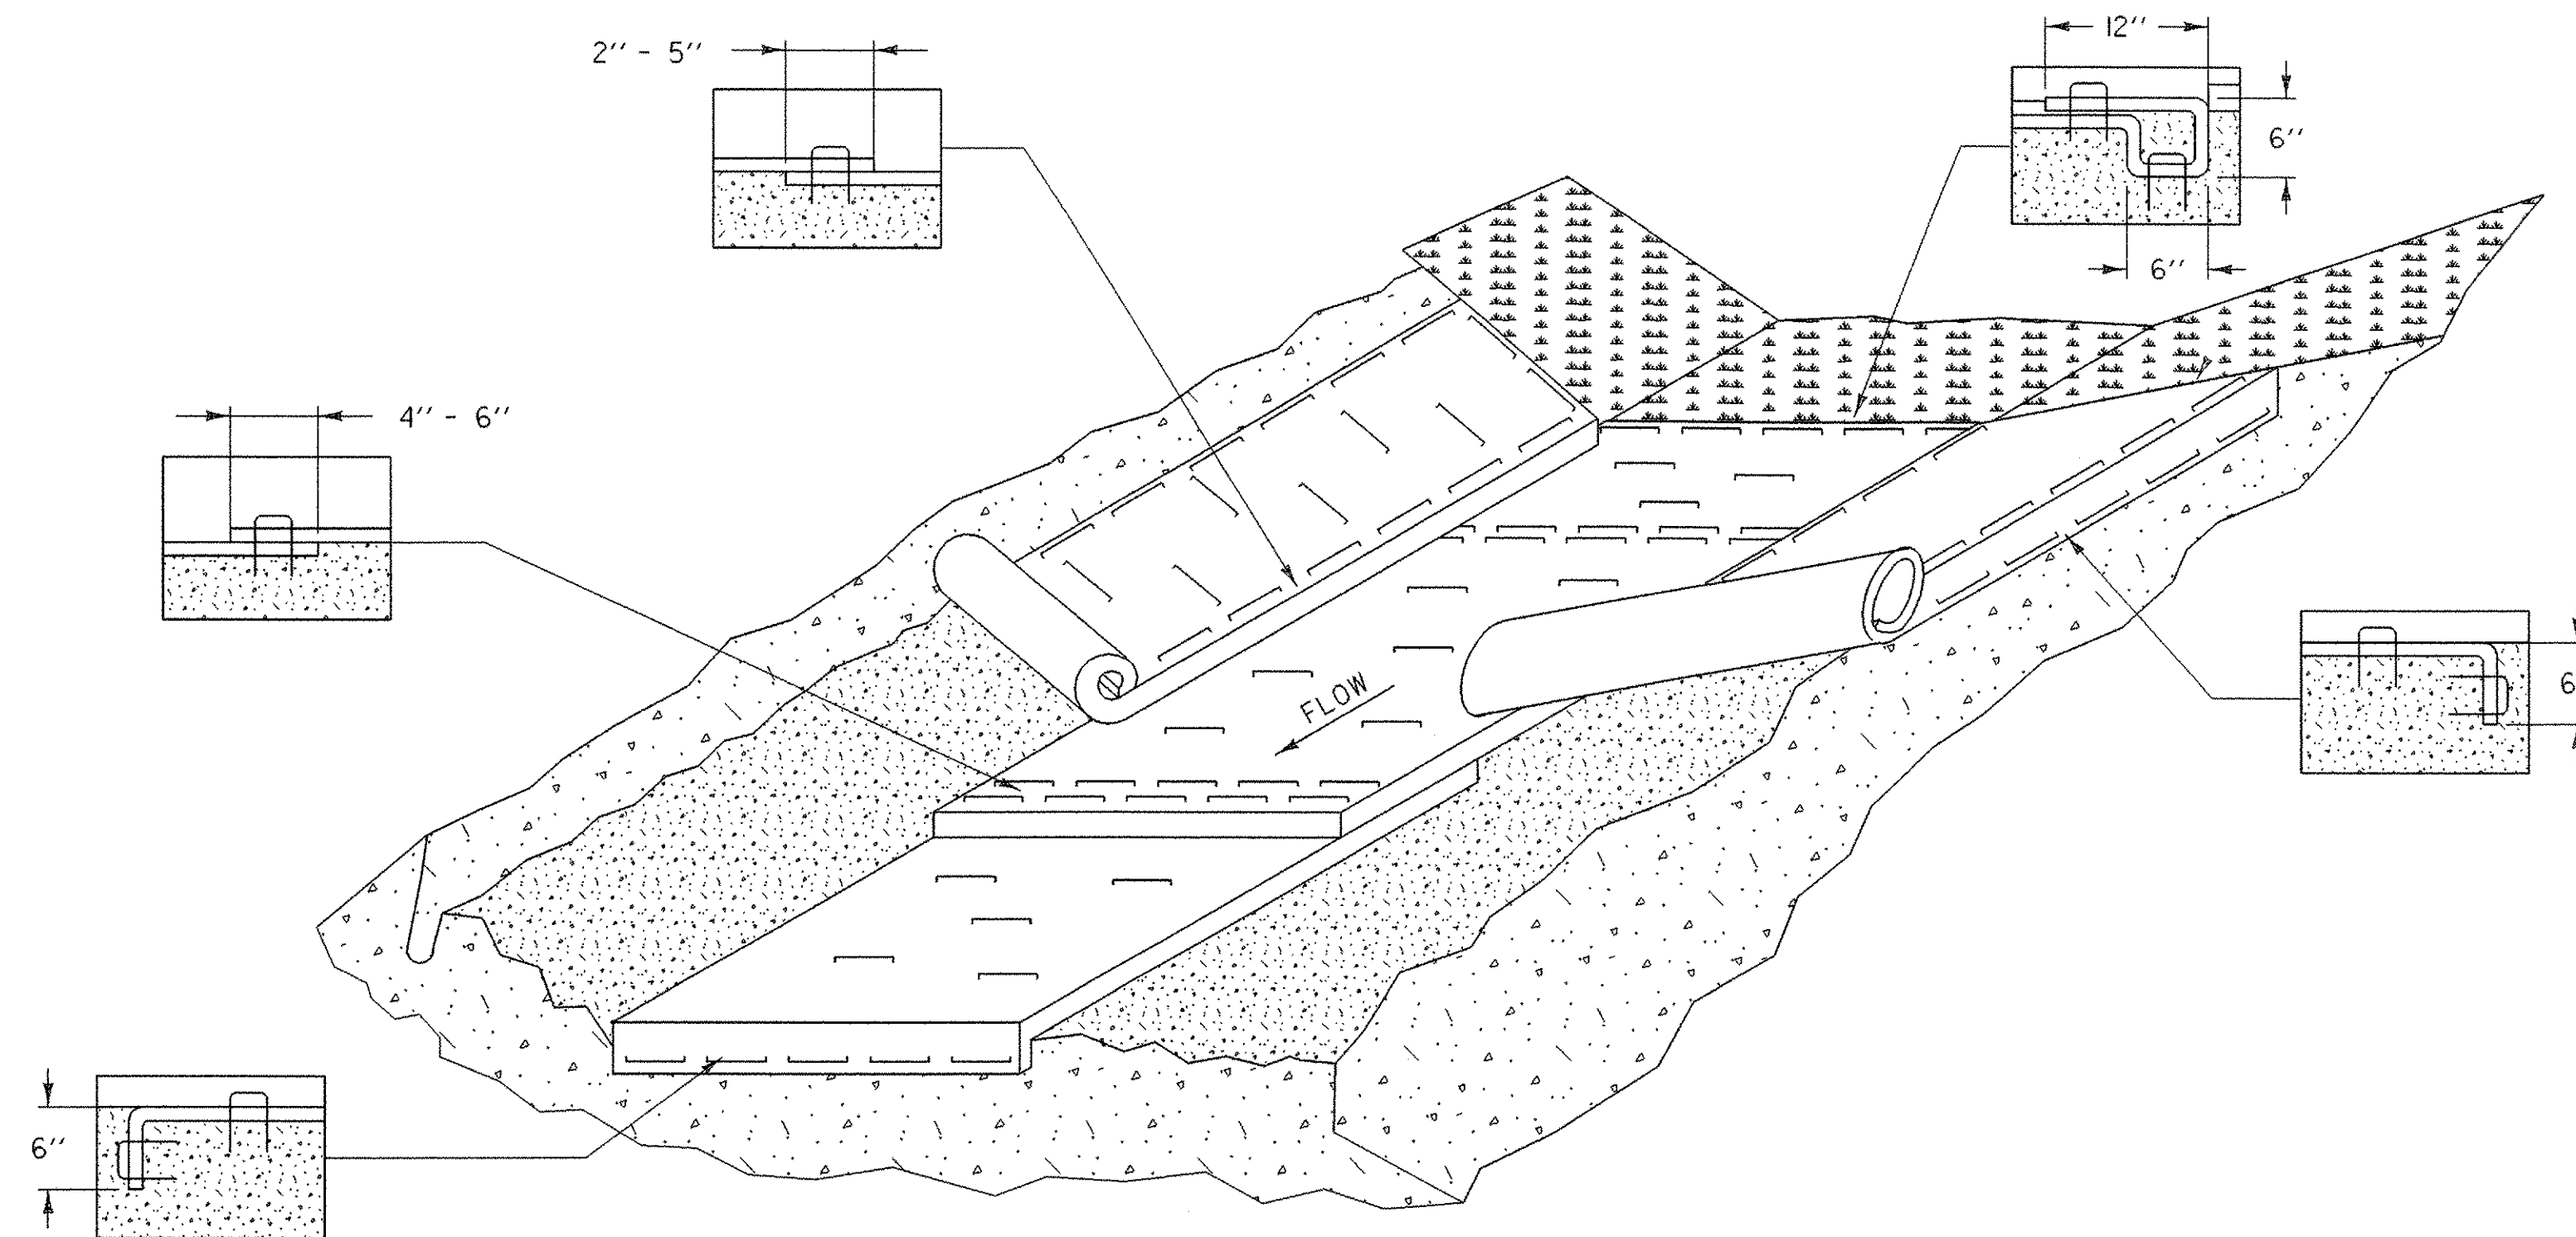


### EROSION MATTING FOR DITCHES

#### APPLICATION NOTES:

- A. THE PURPOSE OF LINING THE DITCH WITH EROSION MATTING IS TO REDUCE EROSION AND AID THE ESTABLISHMENT OF VEGETATION AT LOW VELOCITIES.
- B. TYPE OF EROSION MATTING TO BE USED SHOULD BE BASED ON FACTORS SPECIFIC TO EACH APPLICATION. SEE SPECIFICATIONS AND PRODUCT RECOMMENDATIONS FOR SUITABILITY.

#### GENERAL NOTES:

1. WATER MAY NEED TO BE DIVERTED TO ALLOW PROPER MATTING INSTALLATION.
2. GRADE AND SMOOTH CHANNEL TO PROVIDE GOOD MATTING TO SOIL SURFACE CONTACT.
3. APPLY FERTILIZER, LIME, AND SEED PRIOR TO PLACING MATTING.
4. INSTALL MATTING IN THE CENTER OF THE CHANNEL, IN THE DIRECTION OF THE WATER FLOW.
5. INSTALL MATTING ON THE SIDE SLOPES OF THE CHANNEL, OVERLAPPING THE CENTER MAT.
6. ANCHOR MATTING AS SHOWN, UTILIZING ANCHOR STAPLES. STAPLE PLACEMENT SHALL BE DETERMINED BY THE MANUFACTURER'S INSTALLATION INSTRUCTIONS.
7. EROSION MATTING SHALL BE INSPECTED EVERY SEVEN (7) CALENDAR DAYS AND WITHIN 24 HOURS OF A STORM EVENT GREAT ENOUGH TO CAUSE WATER TO LEAVE THE CONSTRUCTION SITE.
8. EROSION MATTING SHALL BE REPAIRED AND RESTAPLED AS NECESSARY TO ENSURE PROPER FUNCTION.

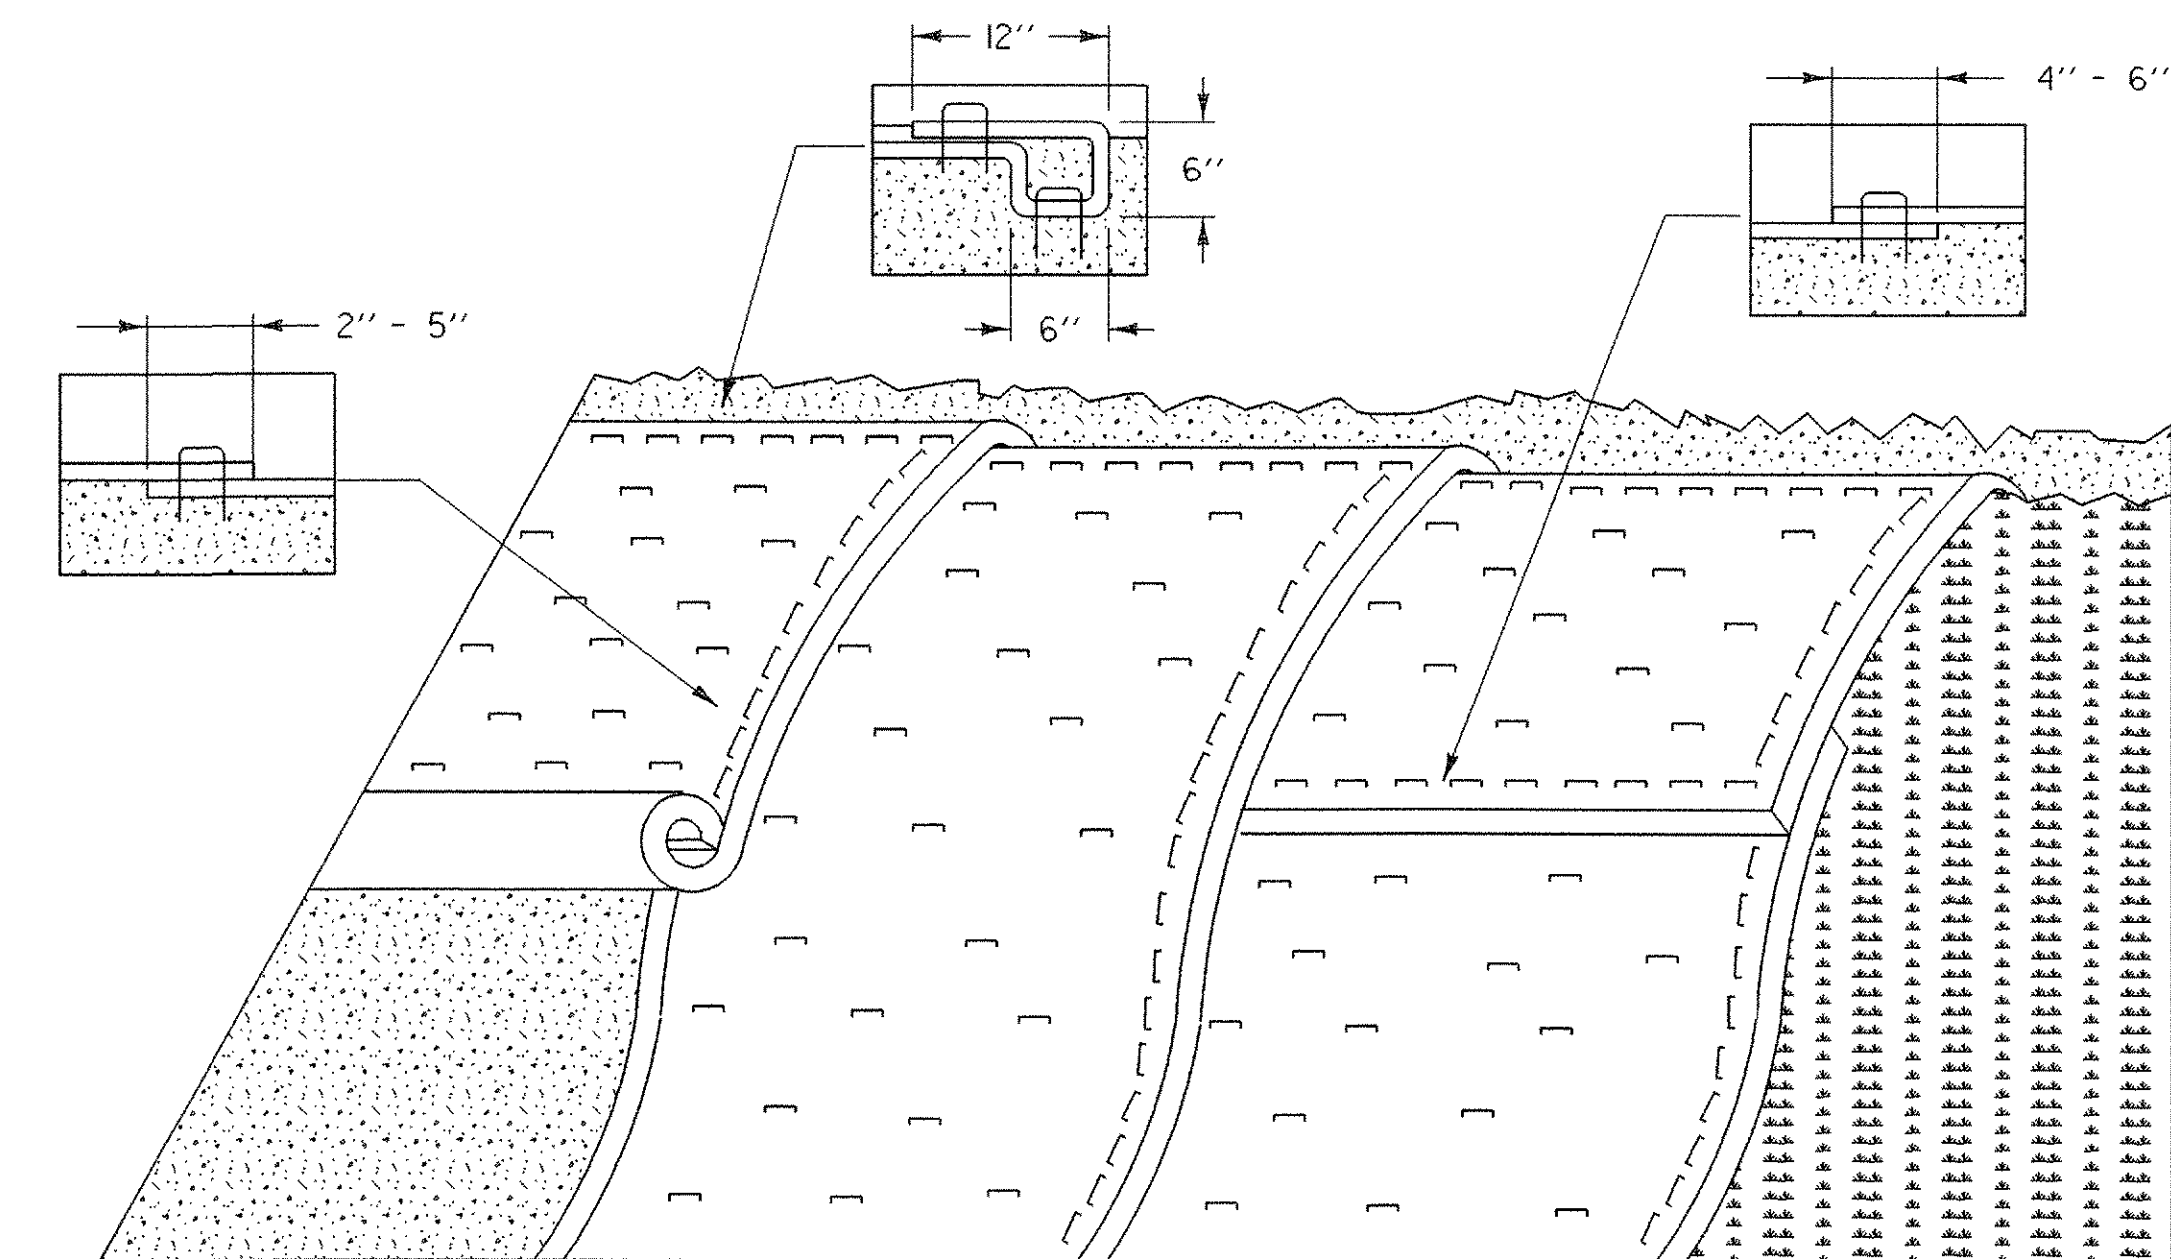

### EROSION MATTING FOR SLOPES

#### APPLICATION NOTES:


- A. THE PURPOSE OF EROSION MATTING ON SLOPES IS TO REDUCE EROSION AND AID THE ESTABLISHMENT OF VEGETATION
- B. EROSION CONTROL MATTING SHALL BE USED FOR THE FOLLOWING REASONS:
  - SLOPES > 3H:1V
  - AREAS WHERE SEED AND MULCH WILL NOT STAY IN PLACE ALONE
  - WHERE SEEDING IS OUTSIDE THE GROWING SEASON.

#### GENERAL NOTES:

1. GRADE AND SMOOTH THE SLOPE TO PROVIDE GOOD MATTING TO SOIL SURFACE CONTACT.
2. APPLY FERTILIZER, LIME, AND SEED PRIOR TO PLACING MATTING.
3. ANCHOR MATTING AS SHOWN, UTILIZING ANCHOR STAPLES. STAPLE PLACEMENT SHALL BE DETERMINED BY THE MANUFACTURER'S INSTALLATION INSTRUCTIONS.
4. UNROLL EROSION MATTING VERTICALLY DOWN SLOPE IN THE DIRECTION OF WATER FLOW.
5. OVERLAP UPPER MATTING OVER LOWER MATTING AS SHOWN.
6. OVERLAP ADJACENT MATTING AS SHOWN.
7. CUT EXCESS MATTING AT END OF SLOPE AND ANCHOR THE END.
8. EROSION MATTING SHALL BE INSPECTED EVERY SEVEN (7) CALENDAR DAYS AND WITHIN 24 HOURS OF A STORM EVENT GREAT ENOUGH TO CAUSE WATER TO LEAVE THE CONSTRUCTION SITE.
9. EROSION MATTING SHALL BE REPAIRED AND RESTAPLED AS NECESSARY TO ENSURE PROPER FUNCTION.


## EROSION PREVENTION & SEDIMENT CONTROL DETAILS EROSION MATTING FOR DITCHES & SLOPES

PROJECT: NEW-HAVEN WEYBRIDGE	PROJECT NO.: BHO BTN2005 (1)
DESIGN FILE NAME: 89j081\structures\sj081erodef.dgn	PLOT DATE: 28-FEB-2007
IPARM FILE NAME: sj081epsc5.i	DESIGNED BY: CONST. ENV. SECTION
SQUAD LEADER: C. P. WILLIAMS	DRAWN BY: CONST. ENV. SECTION
EROSION MATTING FOR DITCHES & SLOPES	CHECKED BY: A. CABRAL
	SHEET: 52 OF 53

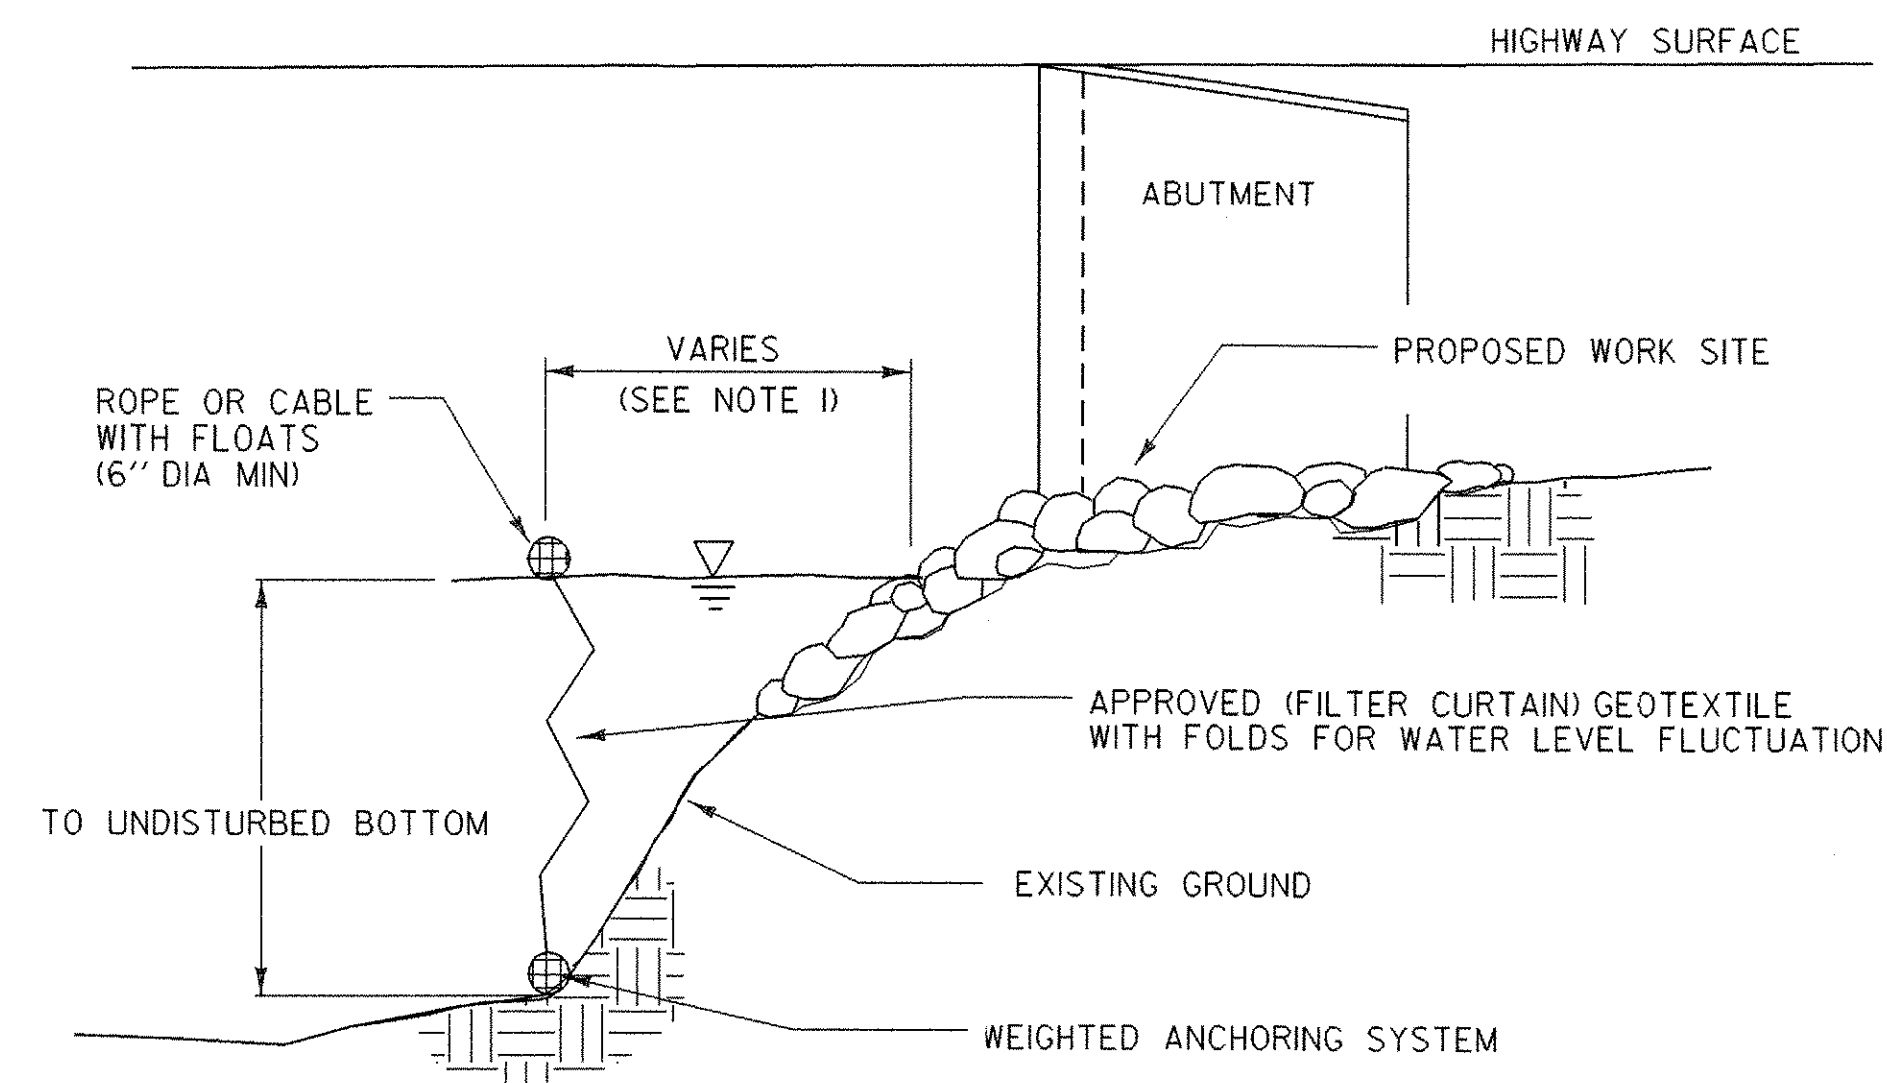

SECTION A-A

NOT TO SCALE

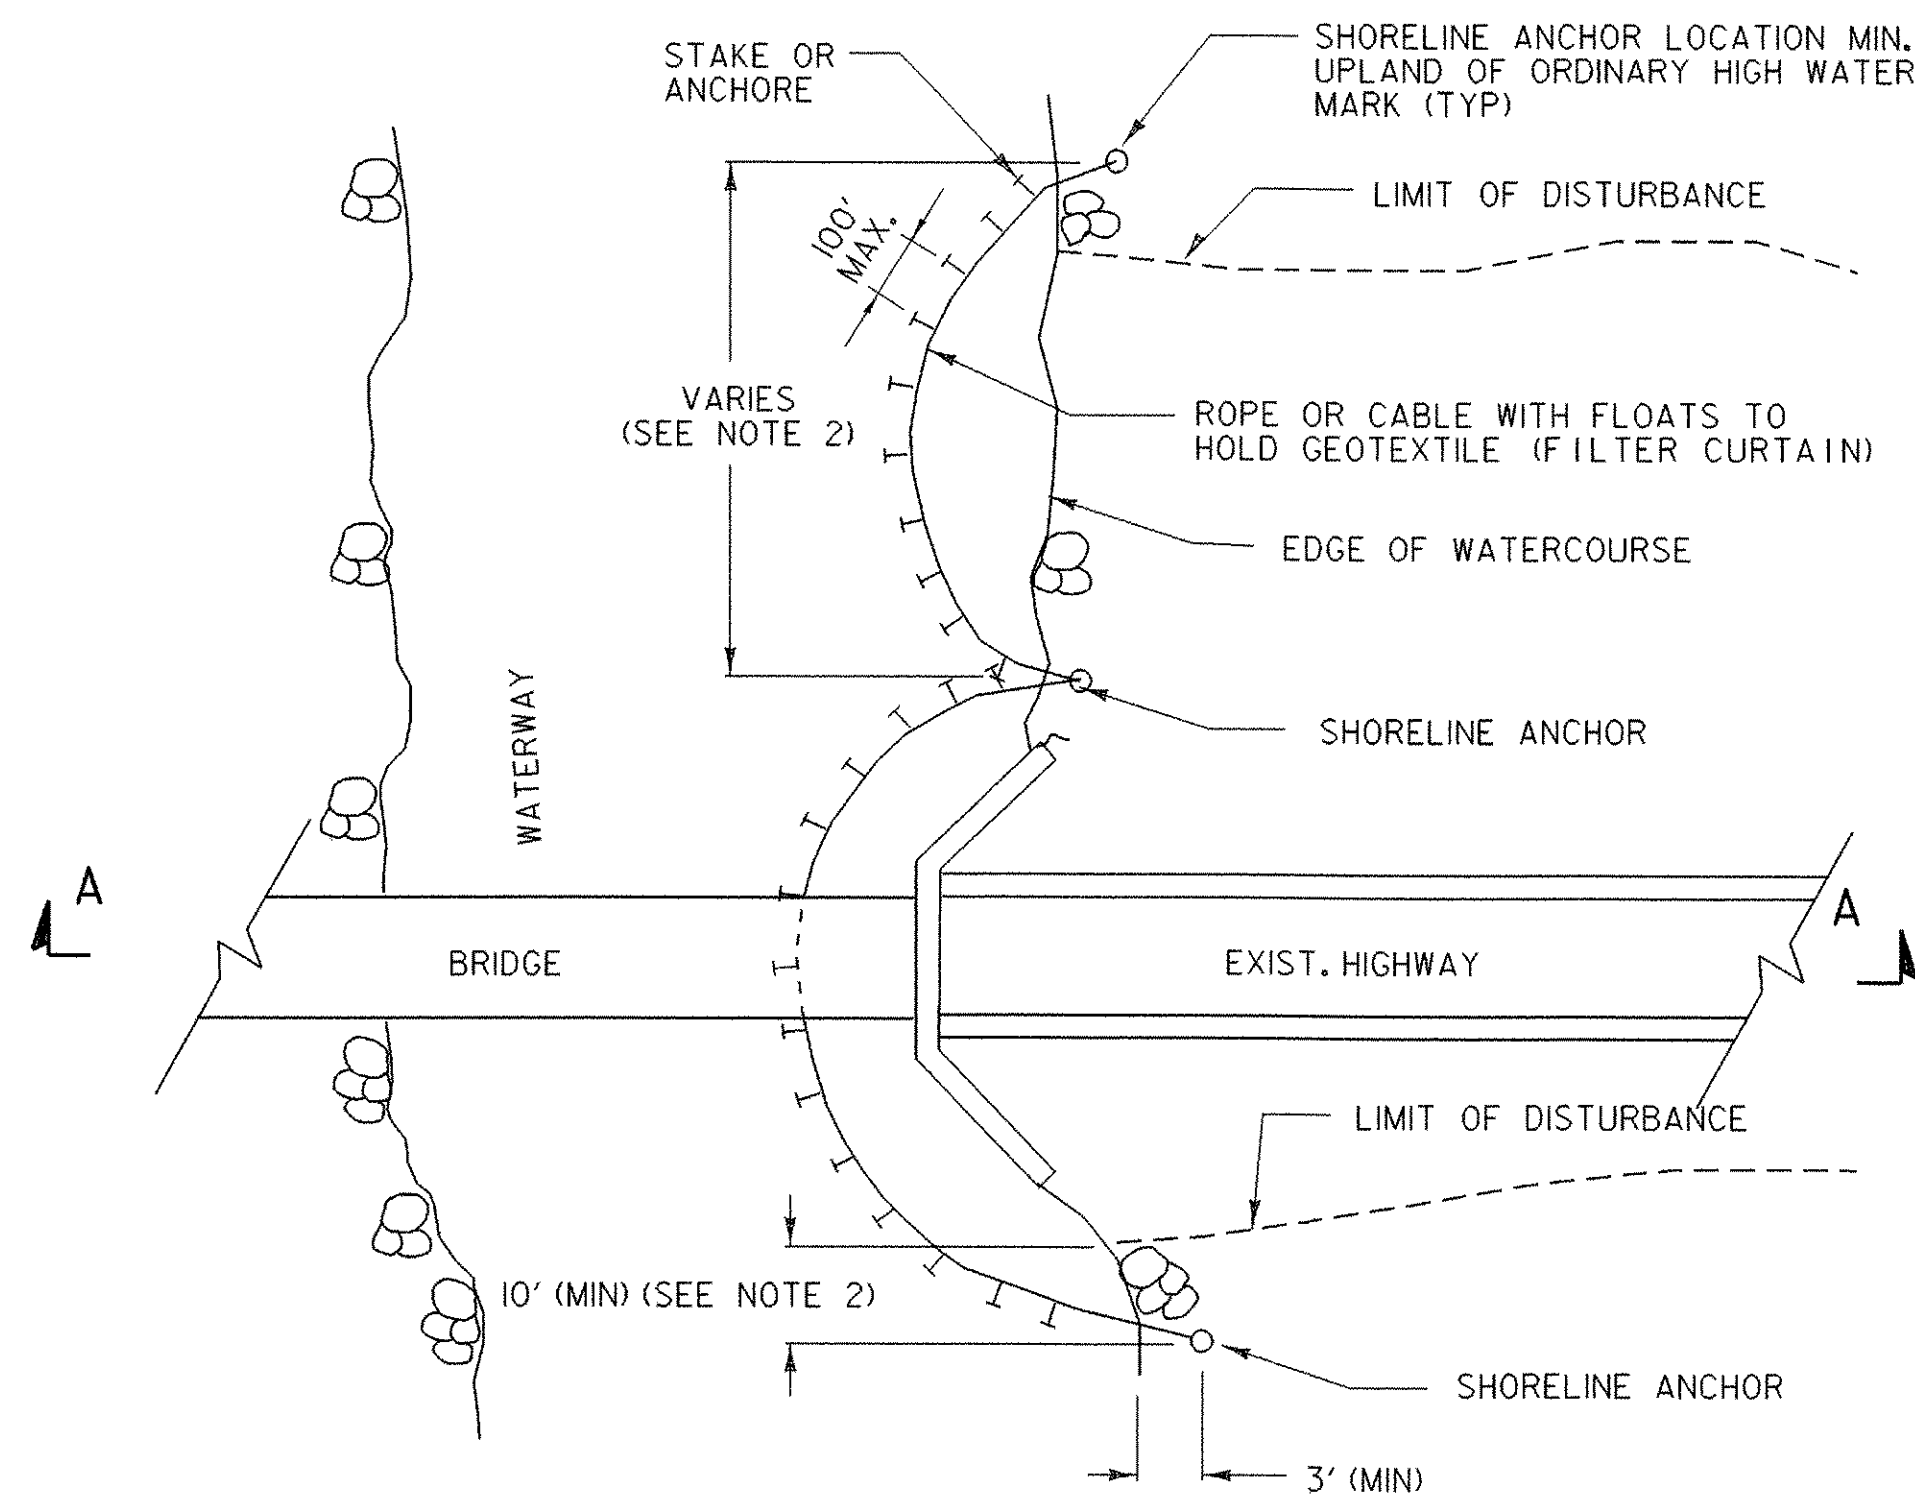

PLAN

FILTER CURTAIN

NOT TO SCALE

## FILTER CURTAIN

### APPLICATION NOTES:

- A. THE PRIMARY PURPOSE OF A FILTER CURTAIN IS TO PROVIDE SEDIMENTATION PROTECTION FOR A WATERCOURSE FROM UP-SLOPE LAND DISTURBANCE OR FROM DREDGING OR FILLING WITHIN WATERCOURSE.
- B. FILTER CURTAINS SHALL NOT BE PLACED ACROSS A FLOWING WATERWAY, OR IN A WATERWAY WITH VELOCITIES GREATER THAN MANUFACTURER'S RECOMMENDATIONS.
- C. FILTER CURTAINS SHOULD NOT BE PLACED AT THE OUTLET OF A CULVERT OR DITCH UNLESS THE VELOCITY DOES NOT EXCEED 1.5 FT/SEC.
- D. DETAILS DEPICT WORK AT A BRIDGE LOCATION, BUT FILTER CURTAINS MAY BE APPLIED AT OTHER LOCATIONS.

### GENERAL NOTES:

1. FILTER CURTAINS SHALL BE PLACED AS CLOSE TO THE WORK AS POSSIBLE WITHOUT INTERFERING WITH CONSTRUCTION OPERATIONS.
2. FILTER CURTAINS SHALL BE A MAXIMUM OF 100 FEET LONG BETWEEN SHORELINE ANCHORS. LAST SECTION SHALL TERMINATE A MINIMUM OF 10 FEET BEYOND THE LIMIT OF DISTURBANCE.
3. THE CONTRACTOR SHALL MONITOR THE FILTER CURTAIN, TAKING INTO ACCOUNT WEATHER PATTERNS AND PREVAILING WIND DIRECTIONS THAT MAY AFFECT WATER LEVELS, VELOCITY AND MOVEMENT OF THE FILTER CURTAIN.
4. SEAMS IN THE FILTER CURTAIN FABRIC SHALL BE EITHER VULCANIZED WELDED OR SEWN, AND SHALL DEVELOP THE FULL STRENGTH OF THE FABRIC.
5. SOIL PARTICLES TRAPPED BY THE FILTER CURTAIN SHOULD ONLY BE REMOVED IF THERE HAS BEEN A SIGNIFICANT CHANGE IN THE ORIGINAL CONTOURS OF THE AFFECTED AREA IN THE WATERCOURSE.
6. SOIL PARTICLES SHALL BE ALLOWED 6-12 HOURS TO SETTLE PRIOR TO THEIR REMOVAL OR THE REMOVAL OF THE FILTER CURTAIN.
7. FILTER CURTAINS SHALL BE REMOVED BY SLOWLY PULLING TOWARDS THE SHORE TO MINIMIZE ESCAPE OF SEDIMENTS INTO THE WATERWAY.

# EROSION PREVENTION & SEDIMENT CONTROL DETAILS FILTER CURTAIN

PROJECT: NEW-HAVEN WEYBRIDGE	PROJECT NO. : BHO BTN2005 (1)
DESIGN FILE NAME: 89j081\structures\sj081erodef.dgn	PLOT DATE: 28-FEB-2007
IPARM FILE NAME: sj081epsct7.i	DRAWN BY: CONST. ENV. SECTION
DESIGNED BY: CONST. ENV. SECTION	CHECKED BY: A. CABRAL
SQUAD LEADER: C.P. WILLIAMS	SHEET: 53 OF 53
FILTER CURTAIN	


STATE OF VERMONT  
DEPT. OF TRANSPORTATION  
RTE. NO. 174/1, CL3 BRIDGE NO. 26  
E. W. AVENUE & WETHERIDGE  
DODSON COUNTY

COSMEC INC.  
CONTRACTOR: COSMEC INC.  
138 Munson Avenue  
Morrisville, VT 05661  
Ph: 802-888-7701 F: 802-888-4746

**WELDING PROCEDURE SPECIFICATION**

SPECIFICATIONS AND CODE: D1.6  
MATERIAL SPECIFICATION: ASTM A240 TYPE 304 TO ASTM A709 GR 50W  
WELDING PROCESS: GTAW  
MANUAL OR MACHINE: MANUAL  
POSITION OF WELDING: 1F & 2F  
FILLER METAL SPECIFICATION: ER309L  
MANUFACTURER: HARRIS WELCO  
FLUX: INTERNAL  
SHIELDING GAS: ARGON  
SINGLE OR MULTIPLE PASSES: SINGLE  
SINGLE OR MULTIPLE ARC: SINGLE  
WELDING CURRENT: DC  
POLARITY: REVERSE (EN)  
WELDING PROGRESSION: \_\_\_\_\_  
ROOT TREATMENT: CLEANED & PREPARED BRIGHT METAL  
PREHEAT AND INTERPASS TEMPERATURE: SEE BELOW  
POSTHEAT TEMPERATURE: N/A  
HEAT INPUT: MIN. \_\_\_\_\_ MAX. \_\_\_\_\_

CLASSIFICATION: A5.9  
TRADENAME:  
FLOW RATE: 45 CFH

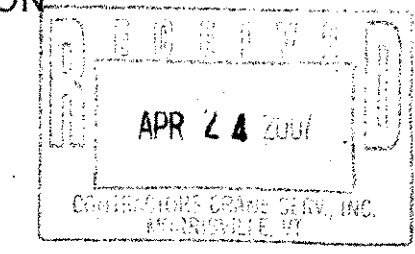

**WELDING PROCEDURE**

PASS NO.	ELECTRODE SIZE	WELDING CURRENT AMPERES	TRAVEL SPEED VOLTS	JOINT DETAIL
ALL	3/32"	130-155	14-17	LAP JOINT

16 GA THRU 10 GA  
BM THICKNESS


**PREHEAT TEMPS.** \*\*\*PREHEAT UNTIL NO MOISTURE PRESENT  
THICKNESS | TEMP.  
UP TO 3/4" | 100 DEG.  
OVER 3/4" TO 1 1/2" | 100 DEG.  
OVER 1 1/2" TO 2 1/2" | 100 DEG.  
OVER 2 1/2" | 100 DEG.

THIS PROCEDURE MAY VARY DUE TO FABRICATION SEQUENCE, FIT-UP, PASS SIZE, ETC.  
WITHIN THE LIMITATION OF VARIABLES GIVEN IN SECTION 5.  
SUPPORTING POR: GTAW-WF-05  
PROCEDURE NO. GTAW-WF

CONTRACTOR: COSMEC INC.  
AUTHORIZED BY: DONALD VOSE  
CW# 01100651

REVISION NO. 1  
DATE: 2/1/2005

TRADES RECEIVED  
OK'D BY: JWC  
APR 25 2007  
RESUBMIT APPROVED  
BY: DATE 5-3-07

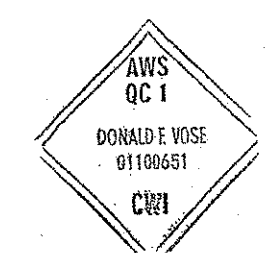

054-BBWP

STATE OF VERMONT  
AGENCY OF TRANSPORTATION  
PROJ. NO. EHO-BTN 2005(1)  
T.C. NO. TR-11, ICL 3 BRIDGE NO. 26  
ISH HAVEN WEYBROOK  
WADSWORTH COUNTY


EMS-QC-110

RECEIVED  
OK'D BY: JJC  
APR 2 5 2007  
RESUBMIT APPROVED  
BY: DATE 5-3-07

COSMEC, INC.  
70 SOUTH STREET  
WALPOLE, MA 02081  
PH# 508-668-6600  
FAX# 508-660-1022

CBS Constructors LLC  
138 Munson Avenue  
Morrisville, VT 05661  
Ph: 802-888-7701 f: 802-888-4746

ENGINEERING AND MANUFACTURING STANDARD  
PTFE FACING AND STEEL  
OR PREFORMED FABRIC SUBSTRATE  
SURFACE PREPARATION AND ADHESIVE PROCEDURE

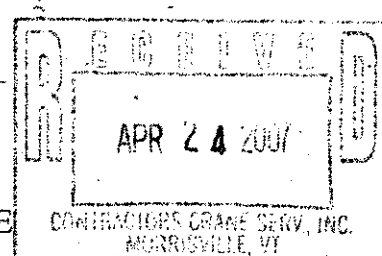

The PTFE facing shall be prepared for bonding to a substrate material by chemically etching the face to be bonded using the sodium ammonia process.

The mating surface of the substrate shall be prepared for bonding using a three-step process as follows:

1. preliminary degrease using methyl ethyl ketone.
2. mechanically roughen to approx. 125 RMS and thoroughly brush and clean for final degreasing.
3. final degrease using methyl ethyl ketone

The PTFE and substrate mating surfaces shall be clean and dry with final degreasing performed within 30 minutes of bonding. Adhesive shall consist of a two-part epoxy adhesive system conforming to Military Specification MMM-A-134

The adhesive shall be applied to the full area of the contact surface in an even manner so as to establish a glue line not less than .002 inch nor more than .010 inch thick. Surfaces being bonded are to be assembled immediately with open assembly time not to exceed 20 minutes.

The PTFE material shall be greater in width and length than the substrate material by at least 1/4 inch when bonded. The PTFE shall be applied with contact starting at one edge and with contact progressing across entire bonded surface to eliminate air entrapment. The PTFE is to be in full contact with the steel or preformed fabric substrate. Curing of the bond shall be done under pressure of approx. 2-100 psf for 10-12 hours at approx. 70°F or other schedules as established by the manufacturer of the adhesive.

The PTFE shall be carefully trimmed to the same size as the substrate after bond curing and all bonds shall be visually inspected for bond retention.

055-BBWP



State of Vermont  
 Agency of Transportation  
 National Life Building  
 Drawer 33  
 Montpelier, VT  
 05633-5001



May 3, 2007


Cosmec, Inc.  
 70 South Street  
 Walpole, MA 02081

**Re: New Haven – Weybridge BRO BTN 2005(1) – TH 7/11, Bridge 26**

The following Bearing details [Item #531.10, Bearing Device Assembly] and weld procedures and bonding procedures for the above project (Vendor's Job #60734) that were received in this office on April 25, have been reviewed and are being returned herewith.

All sheets are approved as noted. Please see comments on attached sheets. Weld procedures and bonding procedures are approved.


You must provide written notice to this office as to the date fabrication represented by these drawings will begin. That notice must be received at least seven days prior to that date, as per Specification 506.03. Any material fabricated prior to the notification date is subject to rejection without further cause.

Sincerely,  
  
 Christopher P. Williams, P.E.  
 Structures Project Manager


**Attachments**

- cc:  – Resident Engineer
- CCS Constructors - Contractor
- Steel Inspector - Jeff Clark
- Construction Section - letter only
- Materials & Research (C&I Unit) - letter only
- Project Files

056-BB WP

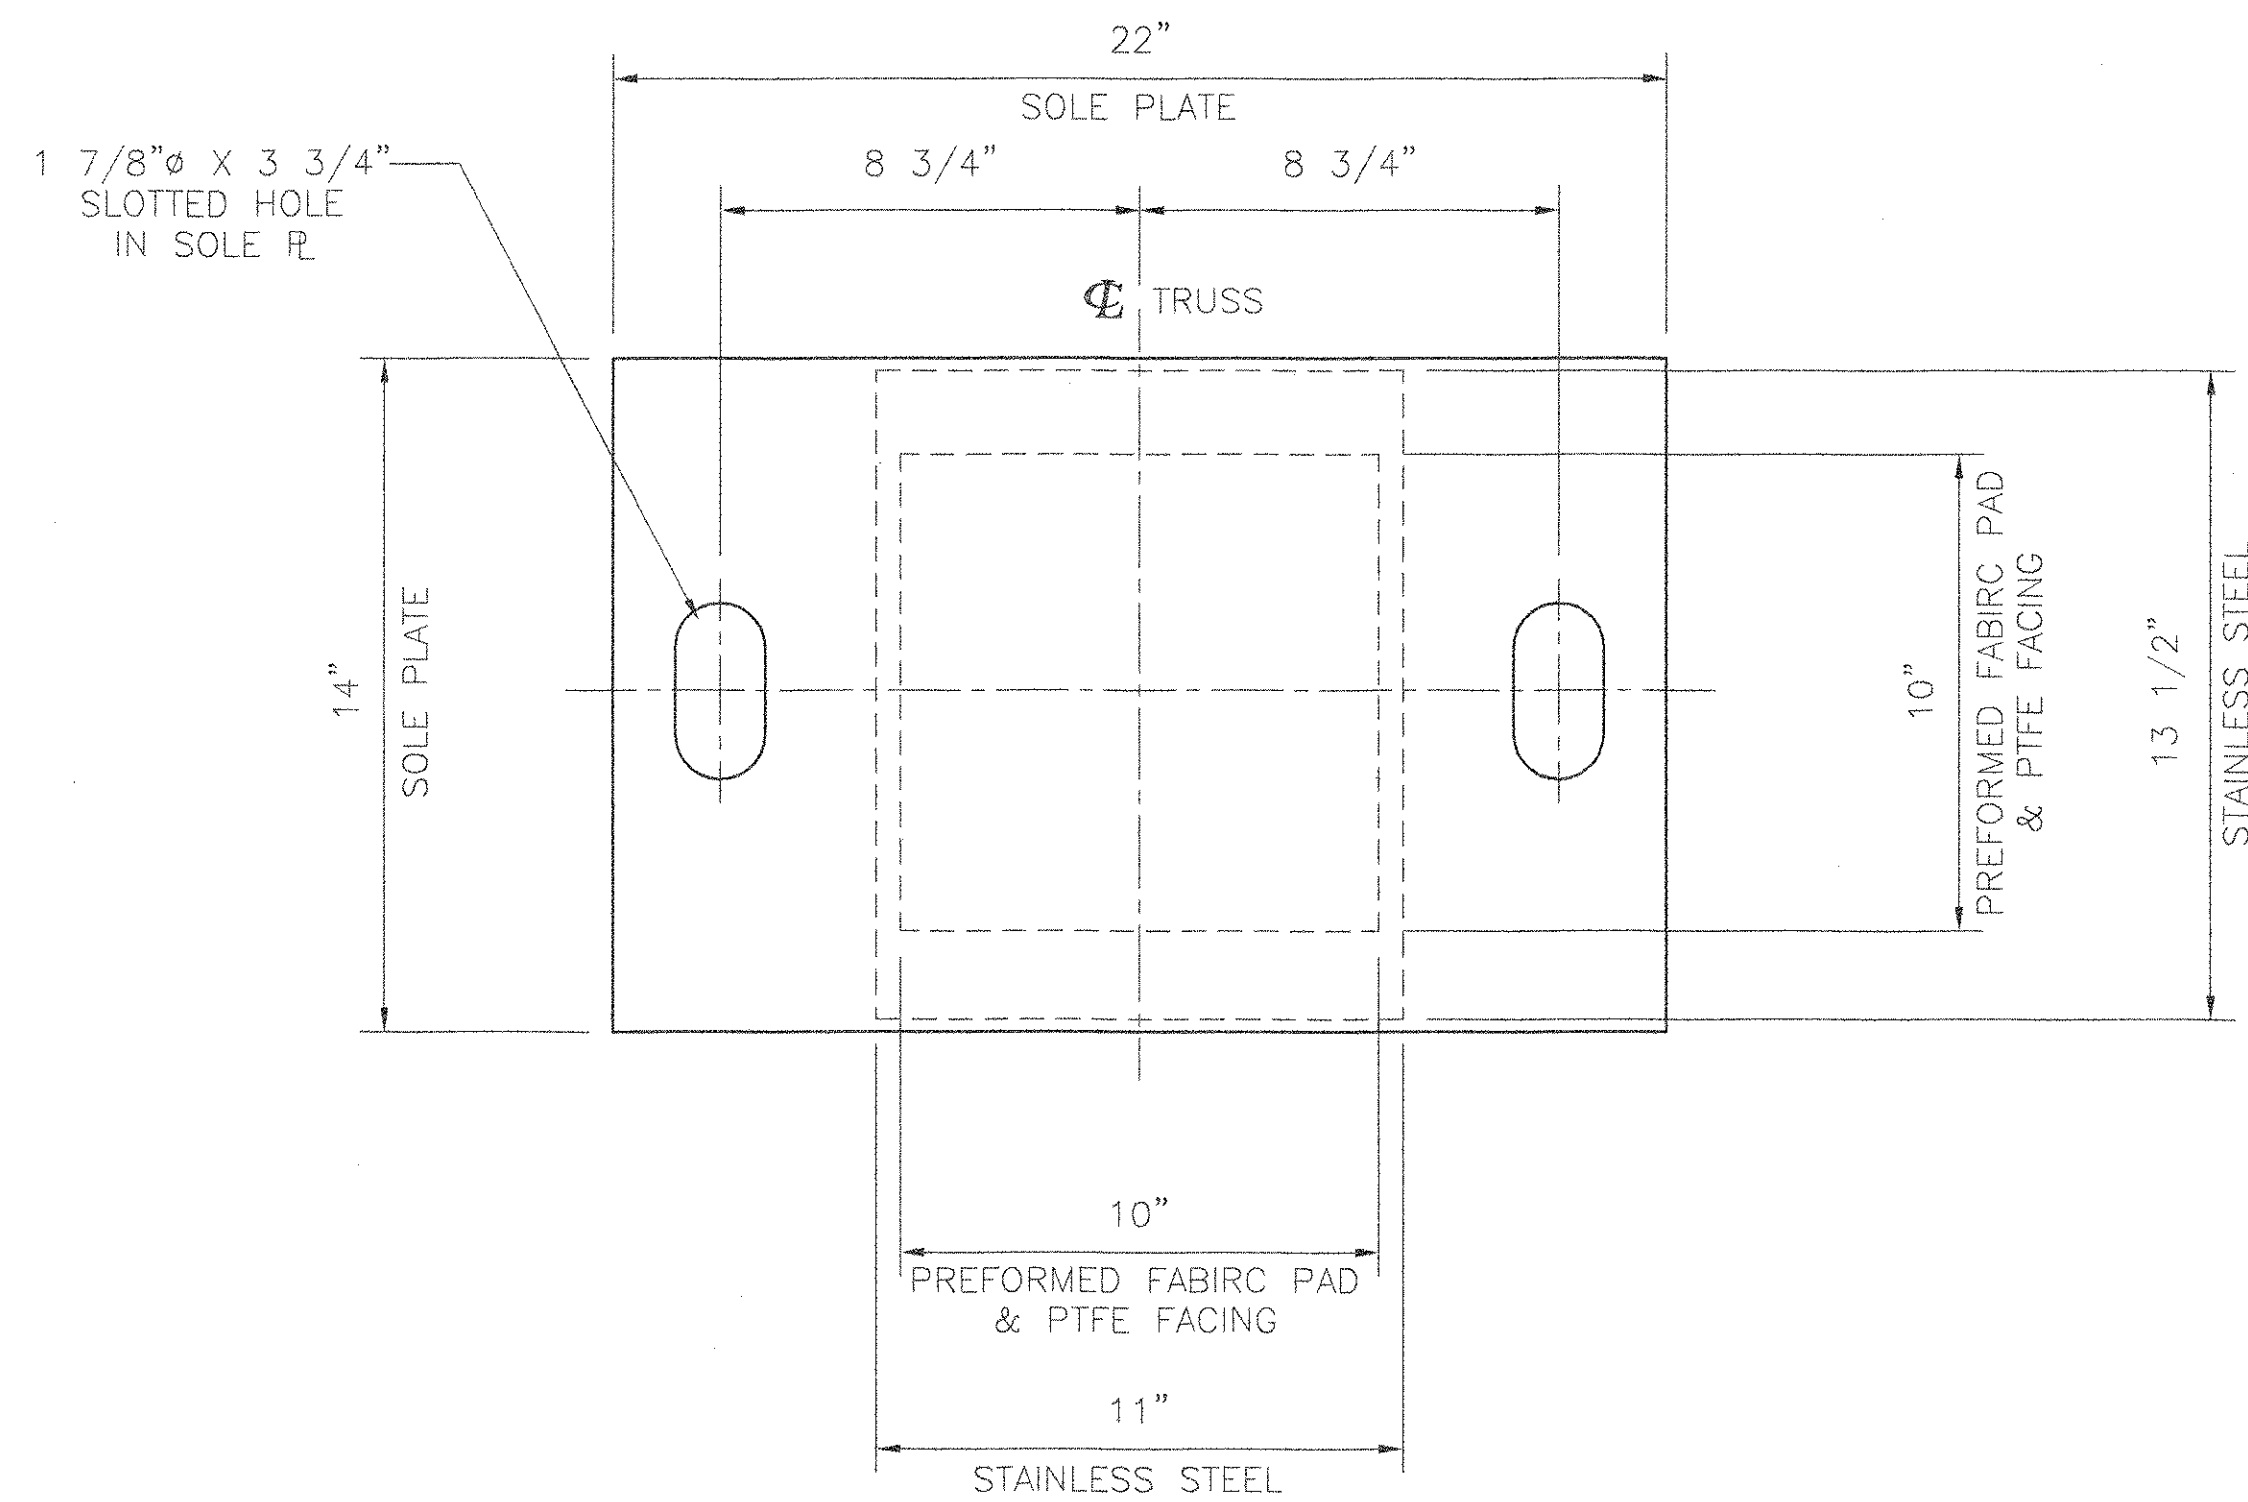

PLAN

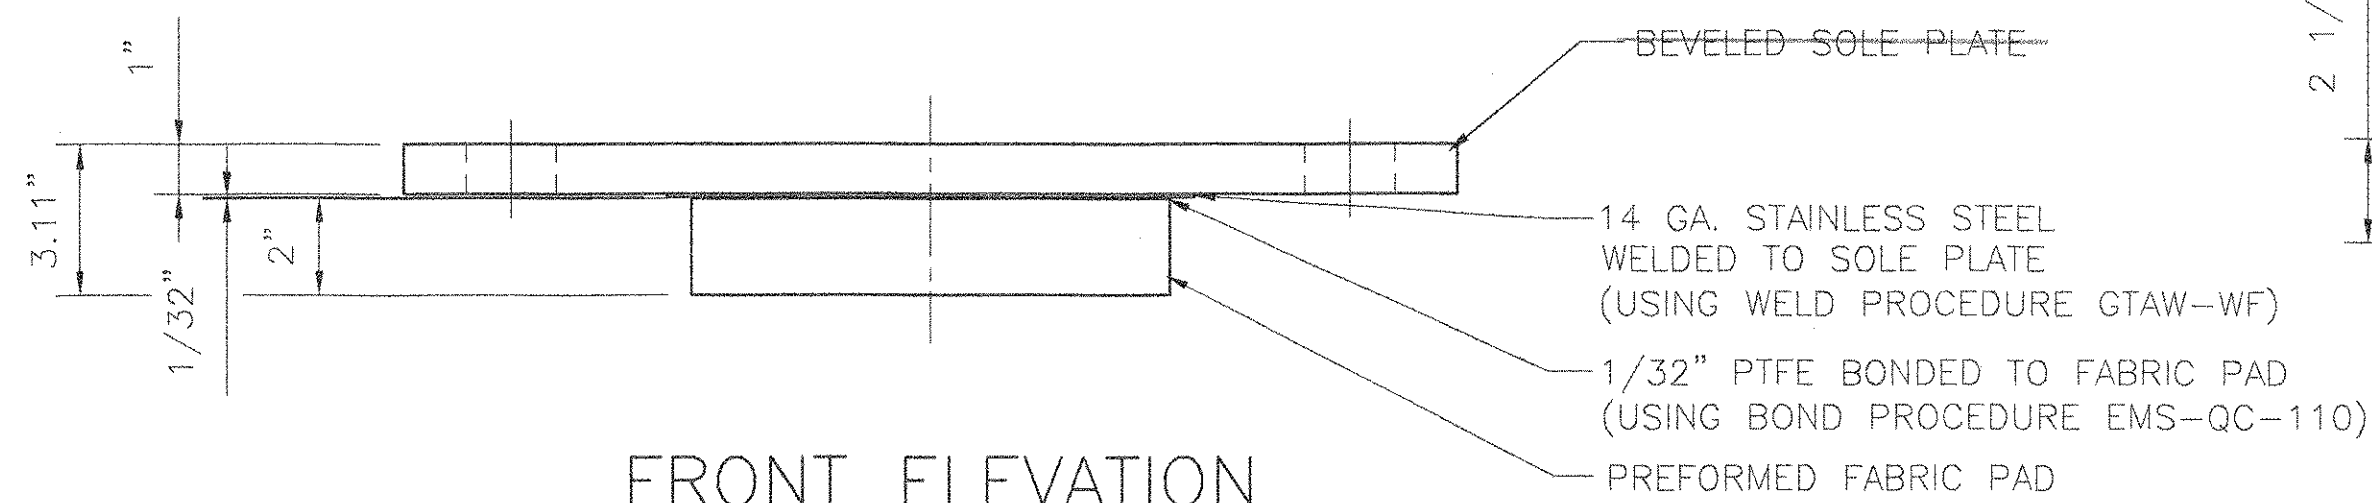


FRONT ELEVATION

EXPANSION PREFORMED FABRIC PAD BEARING


LOCATION: ABUTMENT 1  
QUANTITY: 2

BEARING NOTES

- ALL MATERIALS USED IN THE FABRICATION OF THESE BEARINGS SHALL BE MADE IN THE U.S.A.
- BEARINGS ARE TO BE SHIPPED AS COMPLETE UNITS, STEEL BANDED, AND SHALL BE WRAPPED TO PROTECT FROM MOISTURE AND DIRT DURING TRANSIT AND STORAGE.
- LOCATION OF FABRICATION PLANT - 70 SOUTH STREET WALPOLE, MA 02081
- COSMEC, INC. REPRESENTATIVE - MR. MATT McANDREWS (508) 668-6600
- BEARINGS SHALL BE STORED IN A CLEAN, DRY, LEVEL UPRIGHT POSITION.
- ALL EDGES OF STEEL PLATES SHALL HAVE 1/16" MINIMUM RADIUS.
- ⊗ MARKS THE THICK END OF BEVELED PLATE.
- A. ALLOWABLE BEARING PRESSURE ON CONCRETE = 1,000 P.S.I.  
B. MINIMUM ALLOWABLE DESIGN ROTATION = 0.015 RADIANS.  
C. HORIZONTAL CAPACITY SHALL BE A MINIMUM OF 10% OF THE VERTICAL LOAD.  
D. DESIGN LOAD PER BEARING = 82 KIPS (DEAD LOAD + LIVE LOAD).

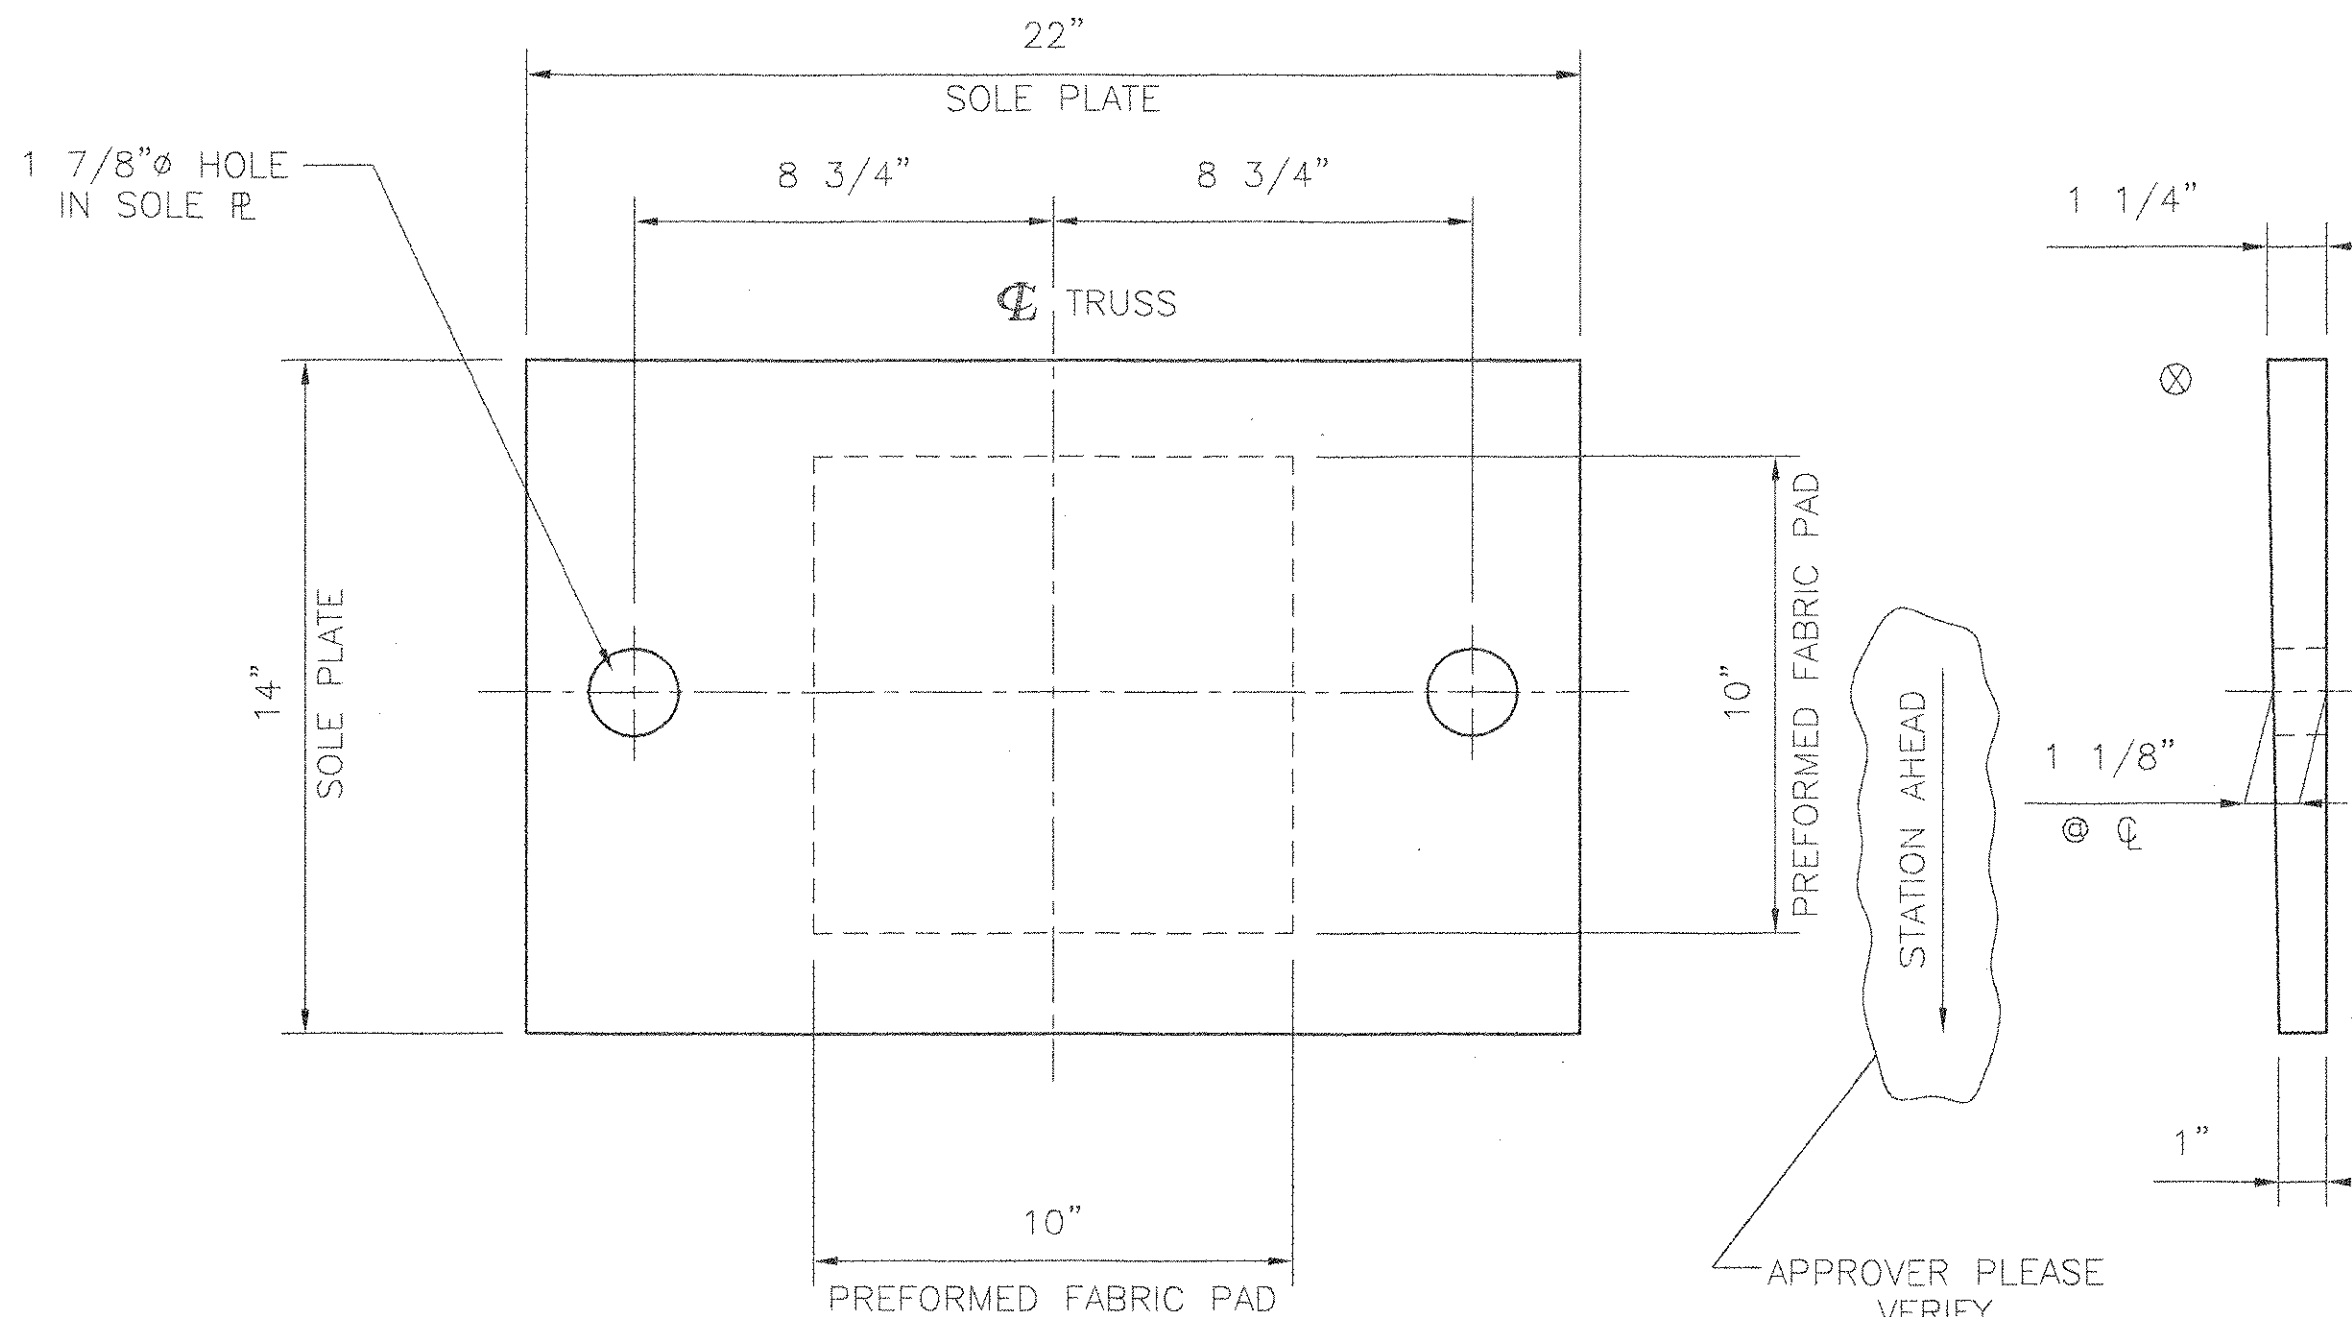

PLAN

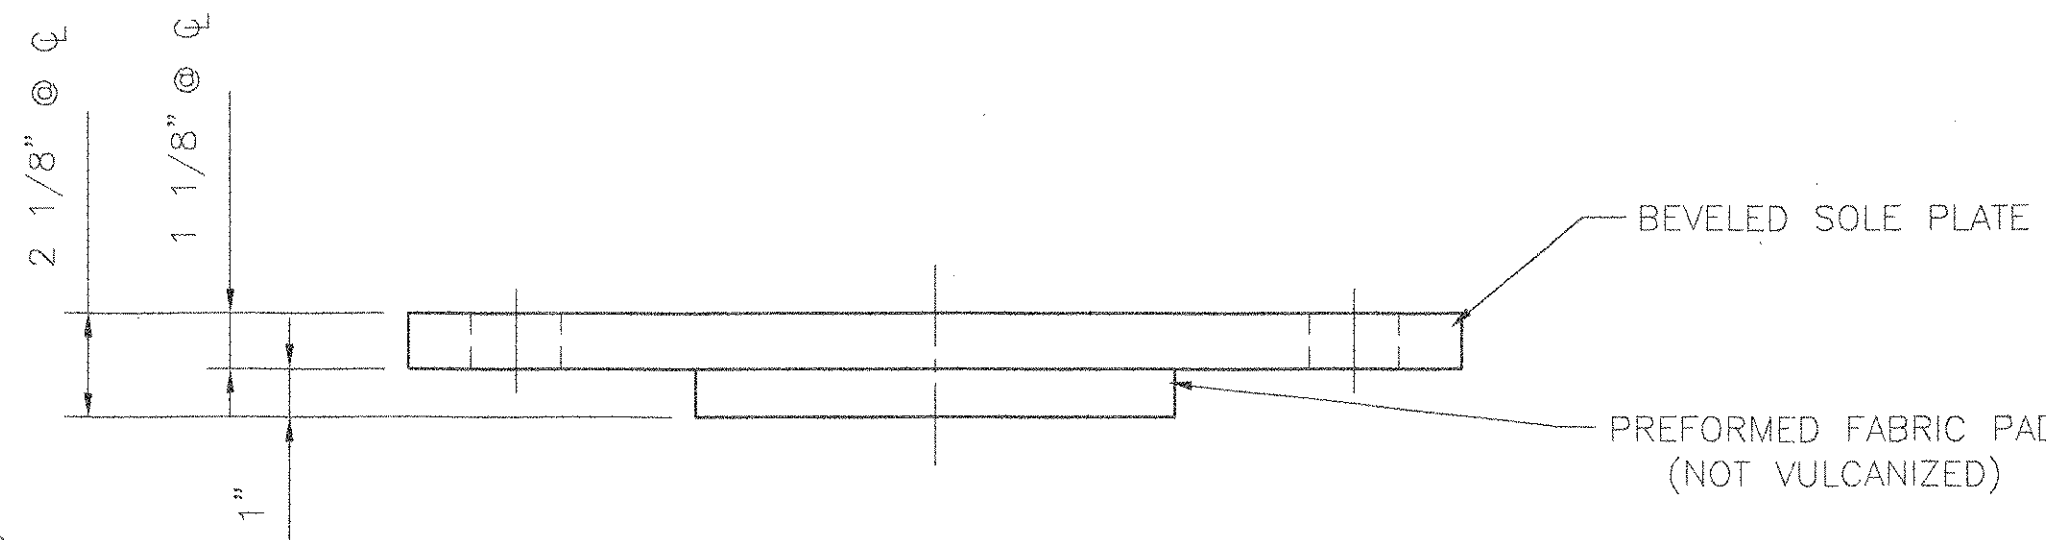


FRONT ELEVATION

FIXED PREFORMED FABRIC PAD BEARING

LOCATION: ABUTMENT 2  
QUANTITY: 2


MATERIALS

STEEL - ASTM A709 GR. 50 ZINC METALLIZED AND SEALED.  
STAINLESS STEEL - ASTM A.240 TYPE 304, WITH 10 RMS FINISH OR LESS ON SLIDING SURFACE  
PREFORMED FABRIC PAD - AASHTO DIV. II SPEC. 18.4.9.1  
PTFE - ASTM D4894 VIRGIN UNFILLED  
ANCHOR BOLTS, NUTS & WASHERS - SEE DETAIL  
ALL BEARINGS DEVICES SHALL BE METALIZED AS PER SUBSECTIONS 531.04(b) AND 506.15(b). BEARINGS SHALL BE SEALED WITH AN APPROVED SEALER AS SPECIFIED IN STANDARD SPEC. SUBSECTION 506.15(b). AREAS OF METALIZING DAMAGED BY FIELD WELDING OR HANDLING SHALL BE PAINTED WITH AN APPROVED SEALANT IN ACCORDANCE WITH STANDARD SPEC. SUBSECTION 708.02(d).  
512.08 (F)

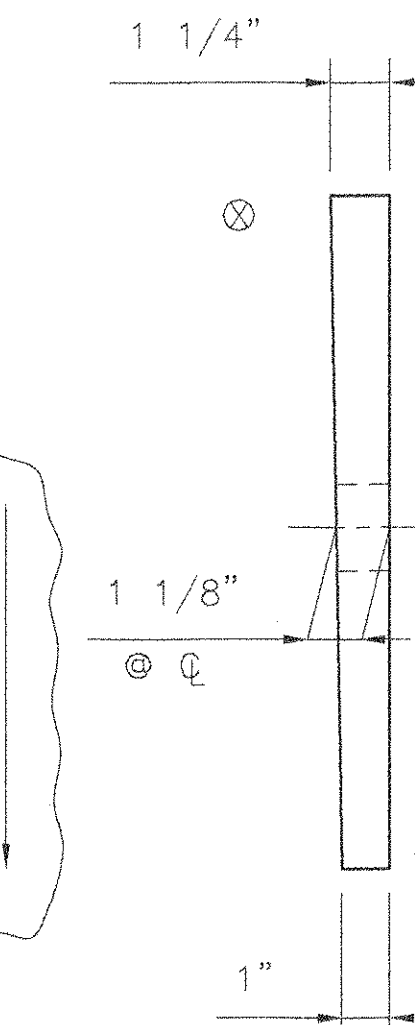

SIDE ELEVATION


BEVELED SOLE PLATE ONLY

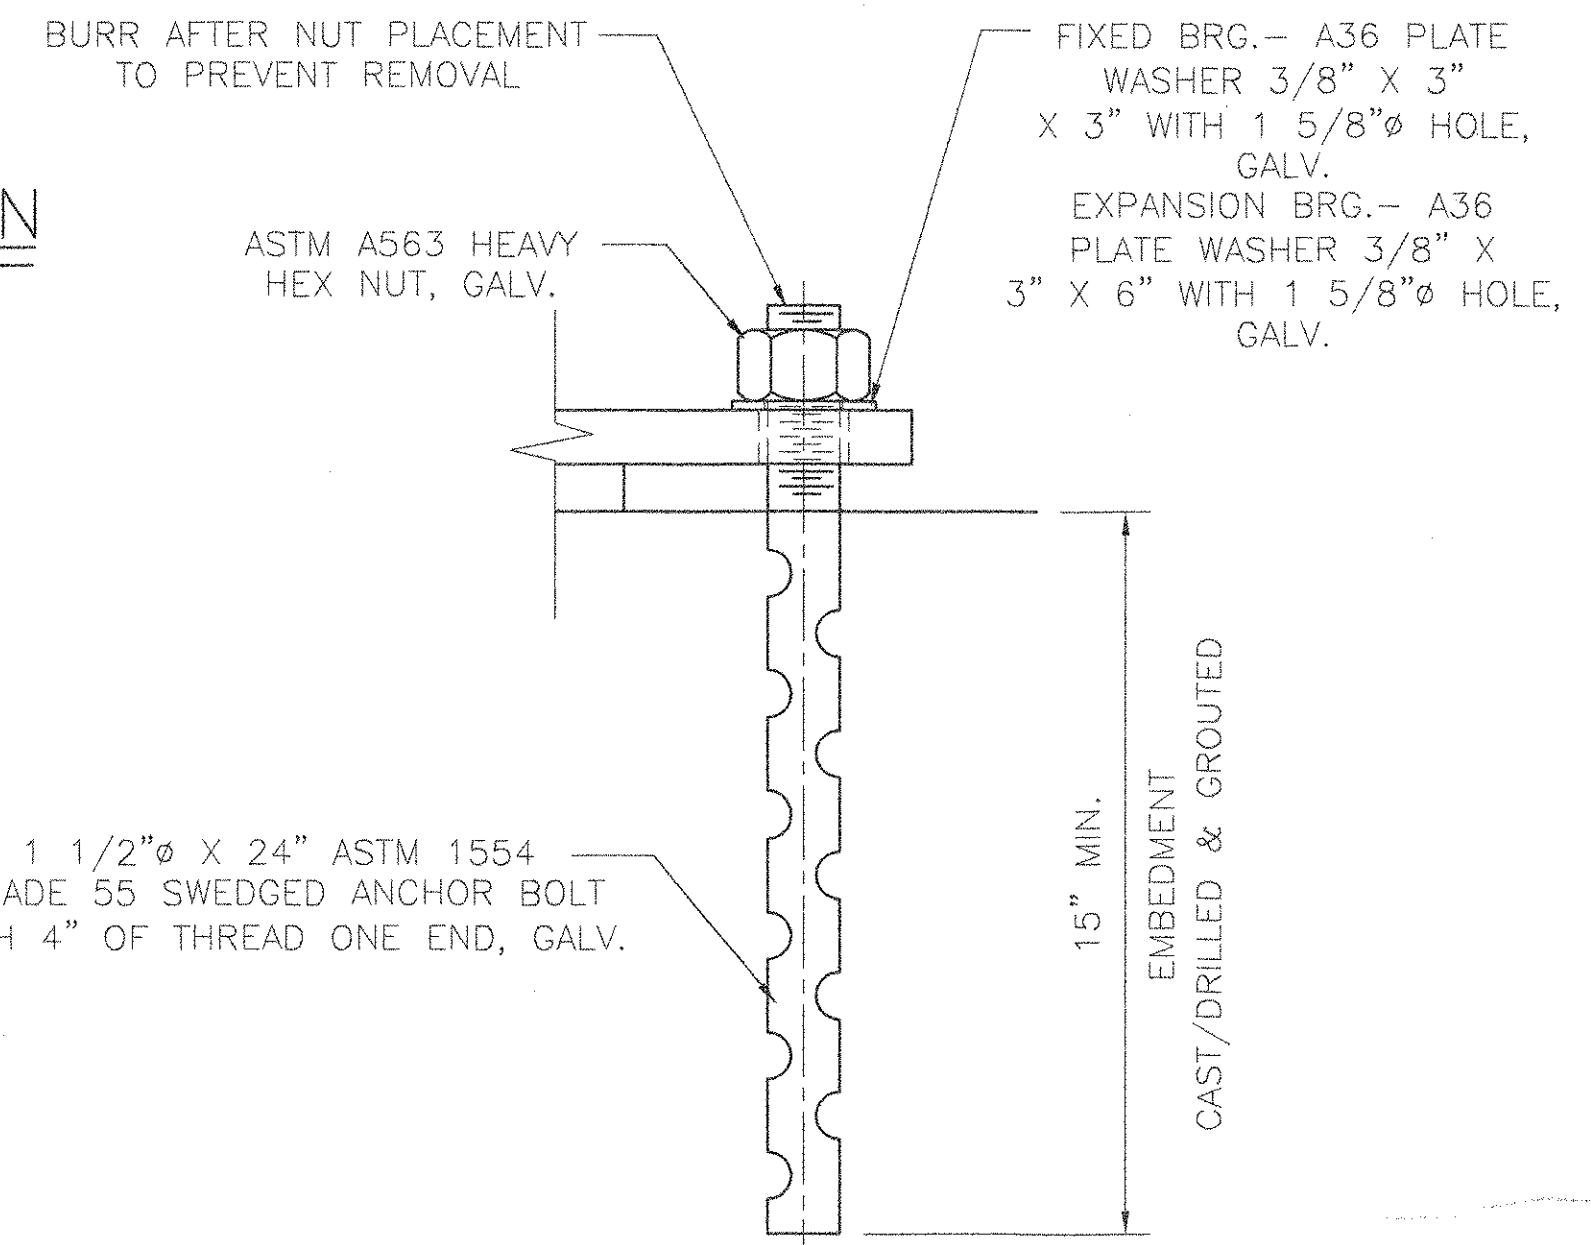

ANCHOR BOLT DETAIL

RECEIVED  
APR 25 2007  
RESUBMIT APPROVED BY GAW DATE 5/3/07

Structures copy

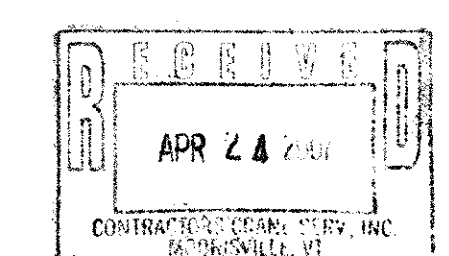

CCS Constructors LLC  
138 Munson Avenue  
Morrisville, VT 05661  
Ph: 802-888-7701 f: 802-888-4746

STATE OF VERMONT  
AGENCY OF TRANSPORTATION  
PROJECT NO. BHO-BTN 2005 (1)  
RTE. NO. TH 7/11, CL 3 BRIDGE NO. 26  
TOWNS OF NEW HAVEN & WEYBRIDGE  
ADDISON COUNTY

COSMEC, INC.		70 SOUTH STREET WALPOLE, MA 02081	
SCALE: 1/4"=1"	DRAWN BY: MRR	CHECKED BY: MCM	
	DATE: 4/19/07	DATE: 4/20/07	
COSMEC FABRIC PAD BEARINGS			
CUSTOMER: CCS CONSTRUCTORS	S.D. NUMBER: 60734	DRAWING NUMBER: 5234	REV.

REV.	BY:	DATE	OK'D BY:	DATE



State of Vermont  
 Agency of Transportation  
 National Life Building  
 Drawer 33  
 Montpelier, VT  
 05633-5001

**VTrans** *Working to Get You There*

July 11, 2007

Casco Bay Steel Structures  
 75 Spring Hill road  
 Saco, Maine 04072

**Re: New Haven – Weybridge BHO BTN 2005(1) – TH 7, Bridge 26**

The following Structural Steel details (Sheet S1) [Item #506.50/60, Structural Steel] for the above project (Vendor's Job #329) that were received in this office on July 9, have been reviewed and are being returned herewith. The expansion joint details (Sheet J1) [Item 516.11 Bridge Expansion Joint, Vermont] that were received on June 11 have also been reviewed and are being returned.

Sheet S1 and J1 are both approved as noted. Please see comments in red on the attached sheet. Weld procedures are also approved.

You must provide written notice to this office as to the date fabrication represented by these drawings will begin. That notice must be received at least seven days prior to that date, as per Specification 506.03. Any material fabricated prior to the notification date is subject to rejection without further cause.

Sincerely,

Christopher P. Williams, P.E.  
 Structures Project Manager

Attachments

- cc: [ X ] Dale Norton – Resident Engineer
- [ X ] CCS Constructors - Contractor
- [ X ] Steel Inspector – Jeff Clark
- [ X ] Construction Section - letter only
- [ X ] Materials & Research (C&A Unit) - letter only
- [ X ] Project Files

058-SSWP

**Casco Bay Steel Structures, Inc.**

5 Industry Road  
South Portland, Maine 04106

Phone: (207) 772-2533

Fax: (207) 772-0580

**WELDING PROCEDURE SPECIFICATION**

Welding specification: ASTM A109-87 1/8" x 3/8" x 5/8" (250-245-245W)  
 Welding process: Shielded Metal Arc Welding (SMAW)  
 Material or machine: Manual  
 Position of welding: Flat (FE) Horizontal (HF)  
 Filler metal specification: AWS E7018 AWS A5.1 - A5.8  
 Filler metal classification: E7018 - R018 5/62 - T02B  
 Flux: NA  
 Shielding gas: NA Flow rate: NA  
 Single or multiple pass: Single and multiple  
 Single or multiple arc: Single  
 Welding current: A.C. D.C.  
 Polarity: Reverse  
 Welding progression: Straight / Reverse  
 Root treatment: None  
 Preheat and interpass temperature: 350 (175) 500 (260) 550 (260) 600 (270) 650 (300)  
 Postheat temperature: None  
 Heat input: NA Max: NA

RECEIVED  
 JUN 11 2007  
 DATE 6/26/07

New Haven Weybridge VT  
 Proj. No. BHO-BTA-2008 U  
 C.B.S.S. No 329

Pass no.	Electrode size	Welding current		Travel speed	AWS D1.5 Joint detail
		Amperes	Volts		
AS	7018 1/8 (4-2)	70-100	22-26	AS	1F
	5/32 (3-7)	120-225	22-26		
	3/16 (4-8)	170-300	24-27		
REQ	7018 1/8 (3-2)	90-160	22-26	REQ	2F
	5/32 (3-7)	120-225	22-26		
	3/16 (4-8)	180-290	24-27		
REQ	7018 5/32 (3-7)	170-270	22-26	REQ	3/16 to 3/8 (5 to 8)
	3/16 (4-8)	180-290	24-27		
	7018 5/32 (3-7)	210-330	24-27		

This procedure may vary due to fabrication sequence, fit-up, pass size, etc., within the limitation of variables given in applicable codes or contract specifications.

Procedure no. 401  
 Revision no. 0  
 Contractor: Casco Bay Steel  
 Authorized By: Paul E. Hoodale  
 Date: 3/2/00

05955WP

**Casco Bay Steel Structures, Inc.**

75 Spring Hill Road  
Saco, Maine 04072

Phone: (207) 282-7360

Fax: (207) 282-1179

**WELDING PROCEDURE SPECIFICATION**

Material specification ASTM A 36 Gr 36-50-52W / A 209M Gr 250-345-345W  
 Welding process Flux Cored Arc welding (FCAW)  
 Manual or machine Semi AUTO  
 Position of welding Flat - Horizontal  
 Filler metal specification AWS A5-23  
 Filler metal classification E 81T-11-R4 ESAB  
 Flux EA  
 Shielding gas 75% Ar - 25% CO<sub>2</sub> Flow rate 35 CFH ± 4  
 Single or multiple pass Single / Multiple Elec Ex 3/8" = W  
 Single or multiple arc Single  
 Welding current DCP  
 Polarity DCP  
 Welding progression See detail  
 Root treatment Wire brush - area to be free of loose scale, slag, rust & moisture  
 Preheat and interpass temperature 20 (34) 100 (200) 60 (34) 70 (130) 200 (400) 400 (750) 600 (1100) 650 (1200)  
 Postheat temperature EA  
 Heat input Min 27.7 kJ/in Max 43.6 kJ/in PQR FCM # 8 59.6 kJ/in  
 Proj No. BHO-BTA-2005 U  
 New Haven Way Saco VT  
 C.B.S.S. No 329

**WELDING PROCEDURE**

Pass no.	Electrode size	Welding current		Travel speed
		Amps	Volts	
		287	29	13
1/16		258	26.8	11.4
		315	31	14

Joint detail: AV5 D1-5 Joint detail: Fillet

OK'D BY: \_\_\_\_\_ DATE: JUN 1 12007

RESUBMIT BY: \_\_\_\_\_ DATE: 6/16/07

APPROVED: \_\_\_\_\_


Stamp: **APPROVED**  
DATE: 6/16/07

This procedure may vary due to fabrication sequence, fit-up, pass size, etc., within the limitation of variables given in applicable A.W.S. codes or contract specifications


Procedure no. 101 Contractor Casco Bay Steel  
 Revision no. \_\_\_\_\_ Authorized By Paul G. Stoddole  
 Form W-2 Date 12-6-06

060-SS WP


ABM INFO		SHOP BILL				JOB NO.	DRG. NO.
PAGE	LINE	NO.	DESCRIPTION	FT	IN	329	51
	7		W12x53	16	3/2	FB1	(CVN)
	2		DO	16	3/2	FB2	DO
			30-5x3x3/8	9	K1		
			90 3/4" BOLTS 3/4" DIA. 1/2" THICK 4325-GALV.	2 1/2	SHOP		
	16		L32x32x7/16	23	1/4	LB1	(CVN)
	4		ASS'Y	1	3/2	BC1	
	4		R1"x10	1	0	PC	(506.60)
	4		R2x6/4	1	2/2	PC	(EXTRA)
	8		R2x6/2	1	2/2	PC	
	2		L22x22x4	26	6	L25	(CVN)
	4		L3x22x4	26	6	L29	(CVN)
	2		L32x22x4	13	6	L17	(CVN)
	4		L3x22x4	19	10	L18	(CVN)
	4		DO	19	10	L31	
	8		L22x22x4	18	6	L7	
	4		DO	18	6	L14	
	4		L3x22x4	26	6	L20	(CVN)
	8		L32x32x7/16	18	6	L10	
	8		DO (CC)	18	6	L11	
	4		DO	18	6	L12	
			4 (CC)				

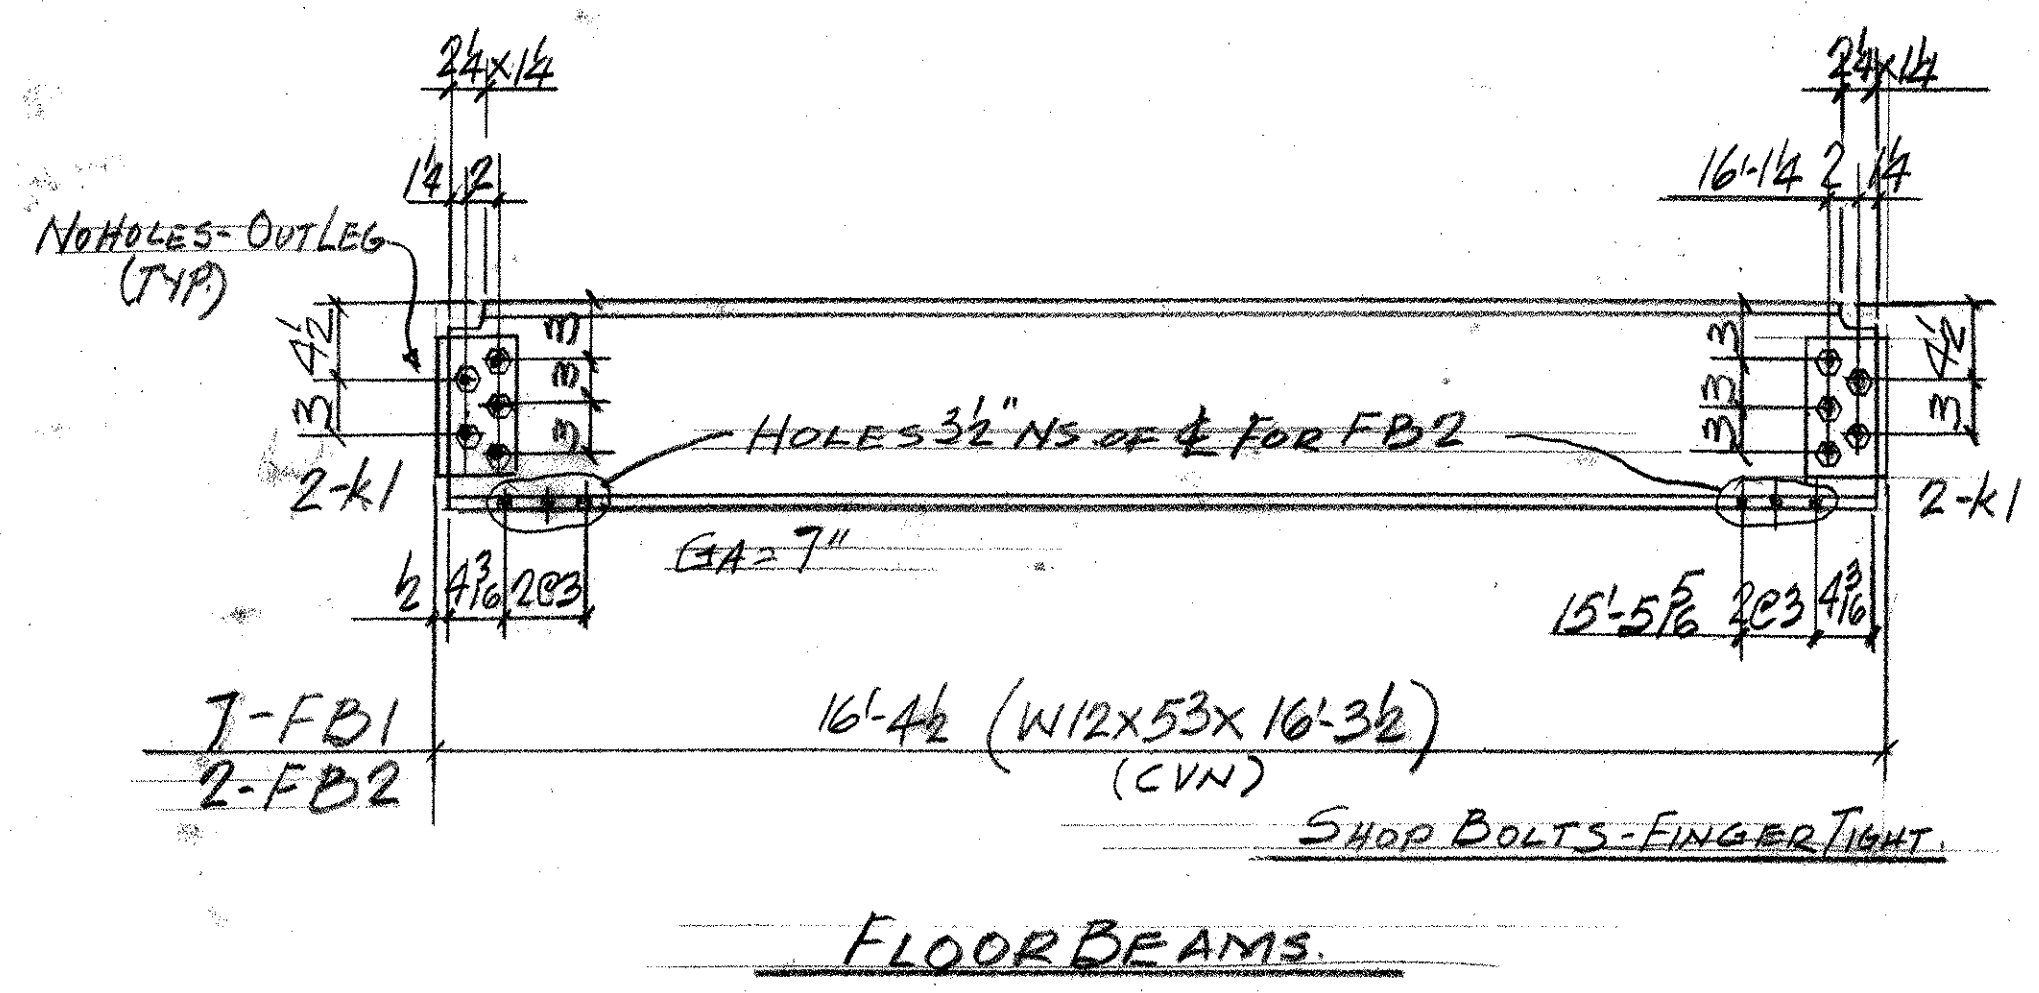

FLOOR BEAMS

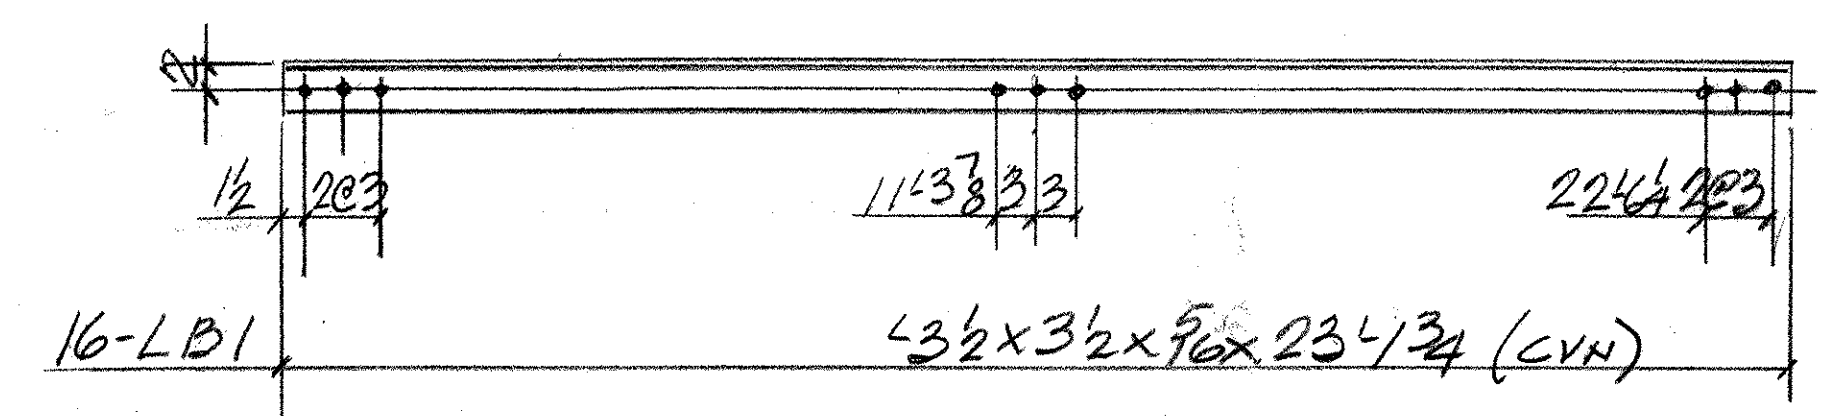

LATERAL BRACING

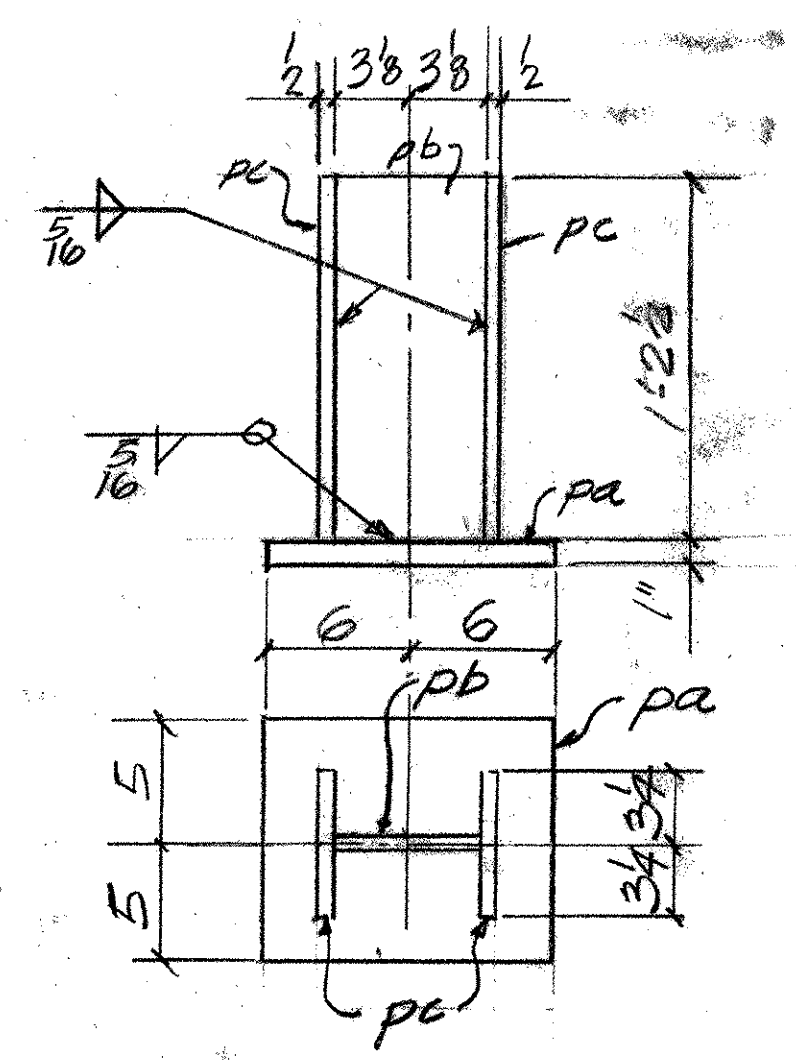

BEARING COLUMN

2-L25	L22x22x4x26-6 (CVN)
4-L29	L3x22x4x26-6
2-L17	L32x22x4x13-6
4-L18	L3x22x4x19-10
4-L31	L3x22x4x19-10
8-L7	L22x22x4x18-6
4-L14	L22x22x4x18-6 (CVN)
4-L20	L3x22x4x26-6
8-L10	L32x32x7/16x18-6
8-L11	DO 3 (CC) x18-6
4-L12	DO x18-6 (CVN)

Structures Copy


PAY ITEM 506.50 - U.N.

OUT FOR APPROVAL	6-7-07
OUT FOR APPROVAL	6-28-07
ISSUED TO SHOP	
FIELD & OFFICE	

REV.	REMARKS	DATE	DWN	CHK	APP	Q.A.	NO.	DIA.	LGT	TYPE	WASHER
PROJECT NO. BHO-BTN 2005 (1) STATE PROJECT NO.											
MATERIAL: AASHTO M270-68SD ELECTRODES: SEE PROC. HOLES: 1/8" Ø SHOP BOLTS: 3/4" Ø											
SURFACE PREP. & PAINT: PRIMER ONLY											

DESCRIPTION: STRUCTURAL DETAILS	DRAWN BY: JPF	DATE: 6-07
JOB: BRIDGE IMPROVEMENTS	CHKD BY: EJ	
NEW HAVEN & WEYBRIDGE, VT.	APPROV BY:	
CUSTOMER: CCS	Q.A.	
CASCO BAY STEEL STRUCTURES, INC.	JOB NO. 329	DRG. NO. 51
75 SPRING HILL ROAD SACO, MAINE 04072	PHONE (207) 282-7360	FAX (207) 282-1179

RECEIVED  
 JUL 09 2007  
 BY: GPN DATE 7/11/07

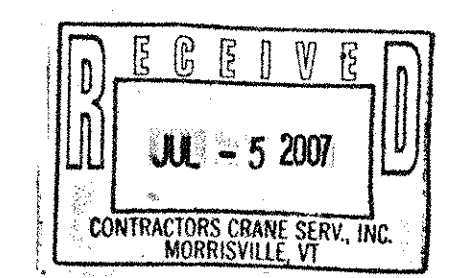

CCS Constructors LLC  
 138 Munson Avenue  
 Morrisville, VT 05661  
 Ph: 802-888-7701 F: 802-888-4746





State of Vermont  
 Agency of Transportation  
 National Life Building  
 Drawer 33  
 Montpelier, VT  
 05633-5001



July 12, 2007

Casco Bay Steel Structures  
 75 Spring Hill road  
 Saco, Maine 04072


**Re: New Haven – Weybridge BHO BTN 2005(1) – TH 7, Bridge 26**

The following Downspout details (Sheet D1) [Item #506.60, Structural Steel] for the above project (Vendor's Job #329) that were received in this office on June 26, have been reviewed and are being returned herewith.

Sheet D1 is approved.

You must provide written notice to this office as to the date fabrication represented by these drawings will begin. That notice must be received at least seven days prior to that date, as per Specification 506.03. Any material fabricated prior to the notification date is subject to rejection without further cause.

Sincerely,


  
 Christopher P. Williams, P.E.  
 Structures Project Manager

Attachments



- cc:  Dale Norton – Resident Engineer  
 CCS Constructors - Contractor  
 Steel Inspector – Jeff Clark  
 Construction Section - letter only  
 Materials & Research (C&IA Unit) - letter only  
 Project Files

063-DS


JOB NO.		DRG. NO.							
329		D1							
PAGE	LINE	NO.	DESCRIPTION	FT	IN	ASSEM. MARK	SHIPPING MARK	REMARKS	WEIGHT
	1		TSGx5x4	9	6			DSI	ASTM A36-B
	2		BAR 4x4	1	10 1/2			BK	BEND.
	4		1" EXP. BOLTS	3				FIELD	
PAY ITEM 506.60									

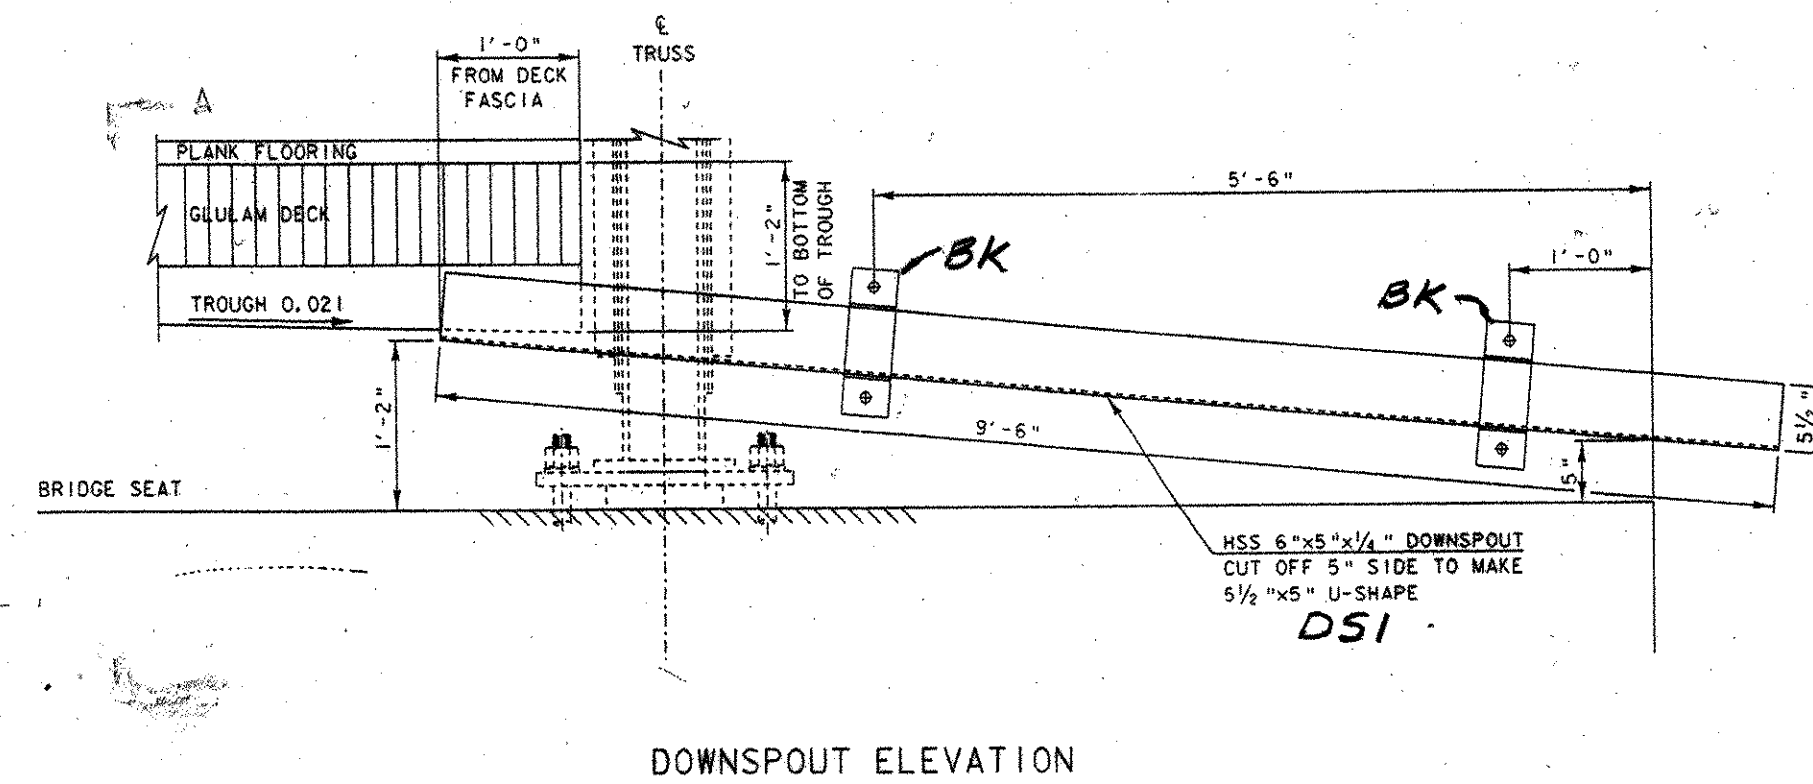

DOWNSPOUT ELEVATION

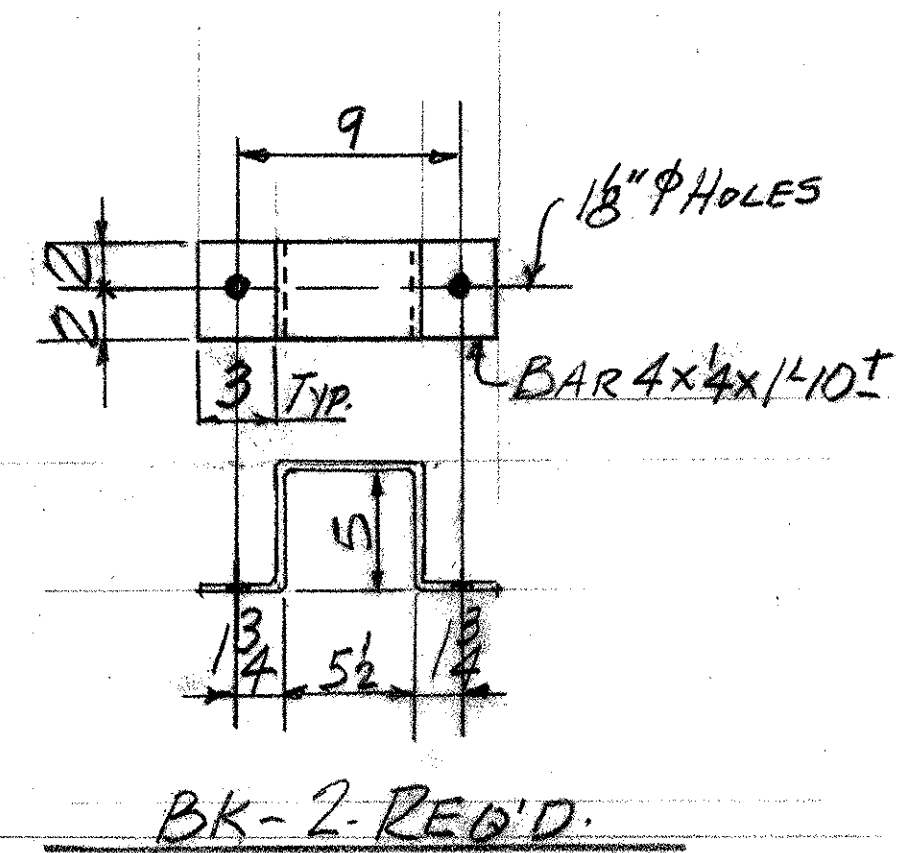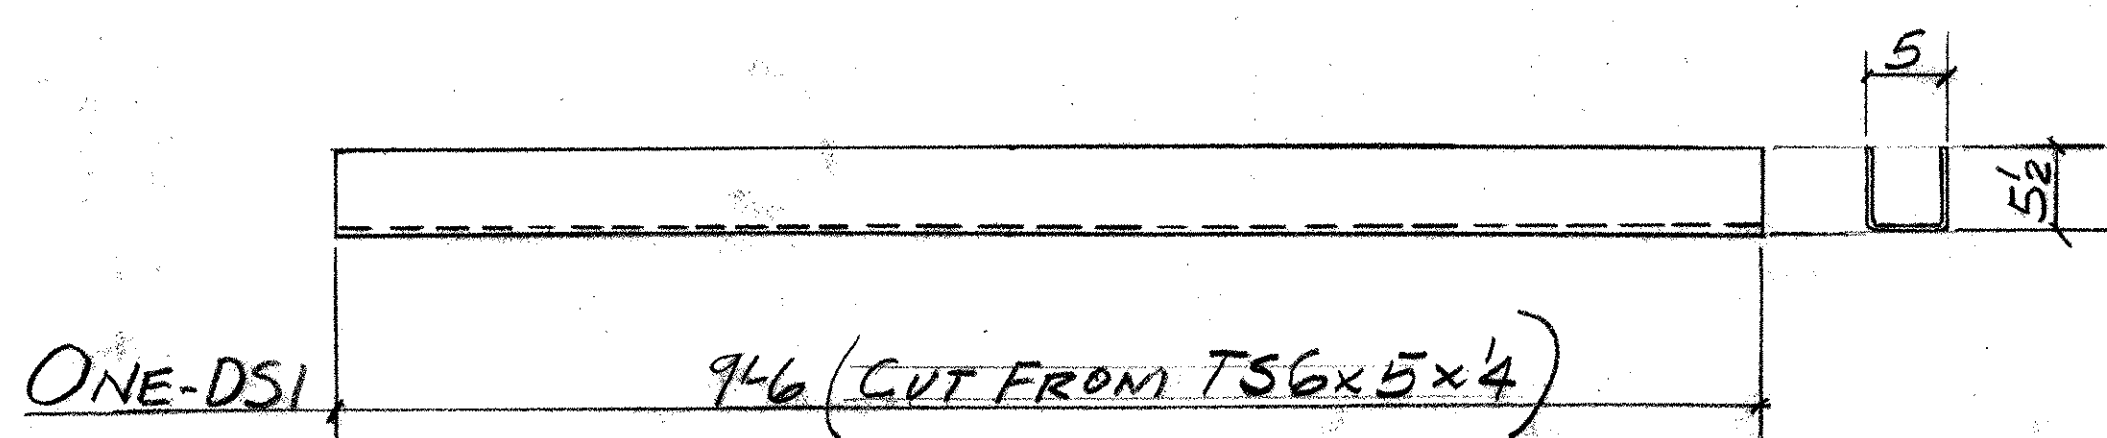

STRUCTURES COPY

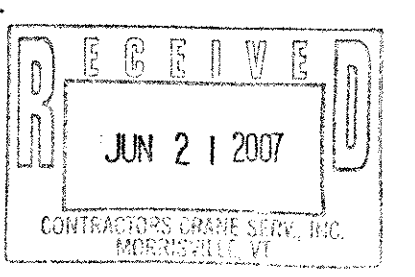

CCS Constructors LLC  
138 Munson Avenue  
Morrisville, VT 05661  
Ph: 802-888-7701 f: 802-888-4748

OUT FOR APPROVAL	6-20-07								
OUT FOR APPROVAL									
ISSUED TO SHOP									
FIELD & OFFICE									

REV.	REMARKS	DATE	DWN	CHK	APP	Q.A.	NO.	DIA.	LGT	TYPE	WASHER
PROJECT NO. 340-BTN-2005(1) STATE PROJECT NO.											
MATERIAL: <u>ASTM A36</u> ELECTRODES: <u>---</u> HOLES: <u>---</u> SHOP BOLTS: <u>---</u>											
SURFACE PREP. & PAINT:											

GALV. AFTER FAB (ASTM-A123)

DESCRIPTION: <u>DOWNSPOUT</u>	DRAWN BY: <u>JPF</u>	DATE: <u>6-07</u>
JOB: <u>BRIDGE IMPROVEMENTS</u>	CHKD BY: <u>EJ.</u>	APPROV BY: <u>---</u>
<u>NEW HAVEN &amp; WEYBRIDGE VT.</u>	Q.A.	

CUSTOMER: <u>CCS</u>	JOB NO. <u>329</u>	DRG. NO. <u>D1</u>
<b>CASCO BAY STEEL STRUCTURES, INC.</b>	75 SPRING HILL ROAD SACO, MAINE 04072	PHONE (207) 282-7360 FAX. (207) 282-1179

RECEIVED  
CHK'D BY: --- OK'D BY: RSY  
JUN 26 2007  
RESUBMIT: --- APPROVED: ---  
BY: JPW DATE: 7/2/07



State of Vermont  
 Agency of Transportation  
 National Life Building  
 Drawer 33  
 Montpelier, VT  
 05633-5001



August 1, 2007

Laminated Concepts, Inc.  
 P.O. Box 369  
 3310 State Rte. 352  
 Big Flats, NY 14814

**Re: New Haven – Weybridge BHO BTN 2005(1) – TH 7, Bridge 26**

The following Glulam Deck details [Item #522.40, Structural Glued Laminated Timber] for the above project (Vendor's Job #2107-150-LT) that were received in this office on July 27, have been reviewed and are being returned herewith.

**Please note that these plans reflect field-verified dimensions provided by the contractor. These plans supersede the previous plans that were approved and distributed in my letter of July 20.**

All sheets are approved.

There shall be no fabrication done until all drawings and welding procedures are approved. You must provide written notice to this office as to the date fabrication represented by these drawings will begin. That notice must be received at least seven days prior to that date. Any material fabricated prior to the notification date is subject to rejection without further cause.


Sincerely,

Christopher P. Williams, P.E.  
 Structures Project Manager


Attachments

- cc:  Dale Norton – Resident Engineer
- CCS Constructors - Contractor
- Construction Section - letter only
- Materials & Research (C&IA Unit) - letter only
- Project Files


065-6D

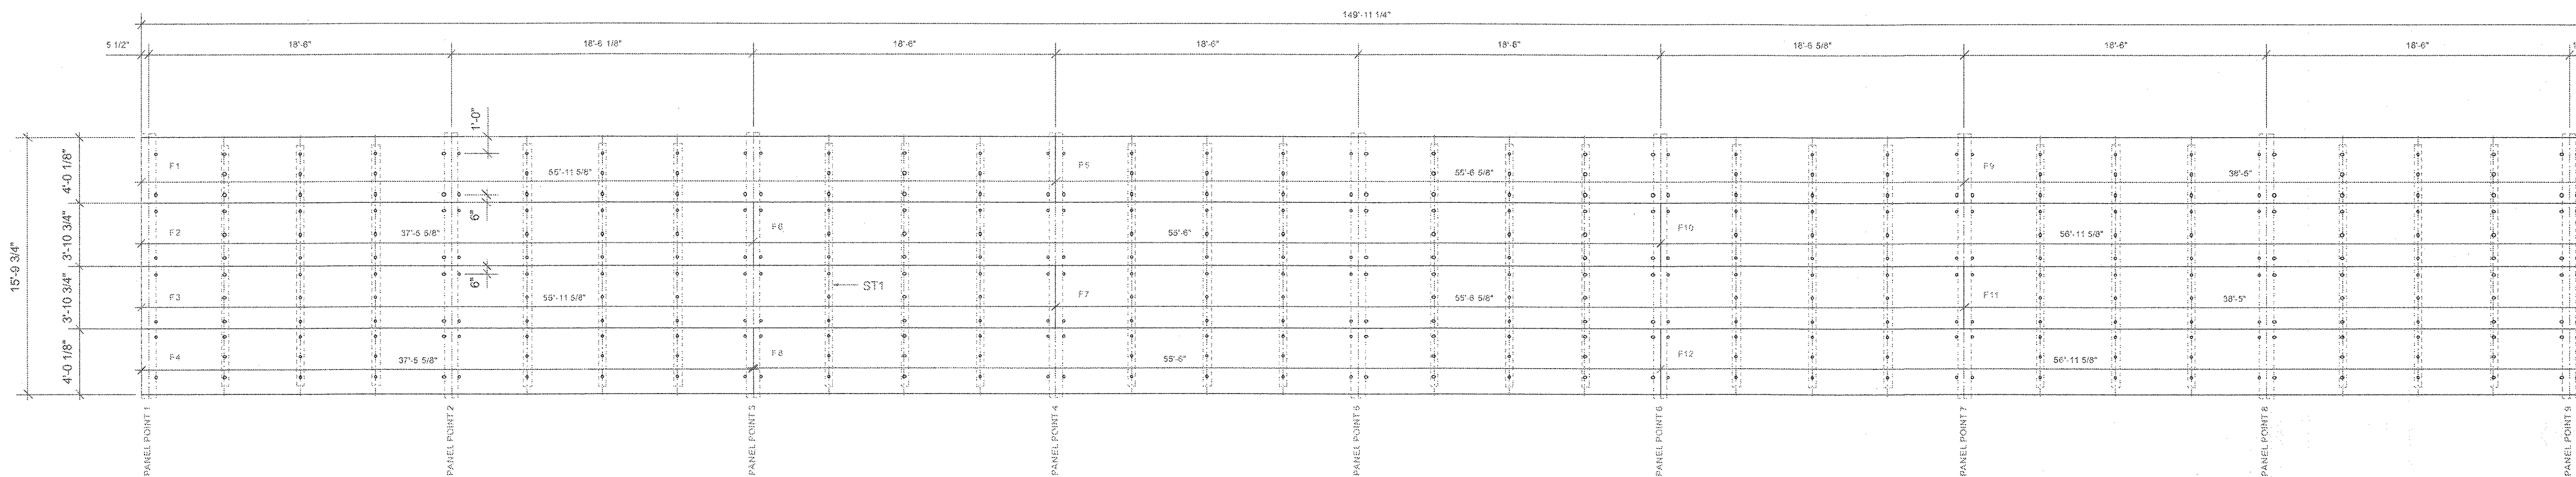

DECKING PLAN

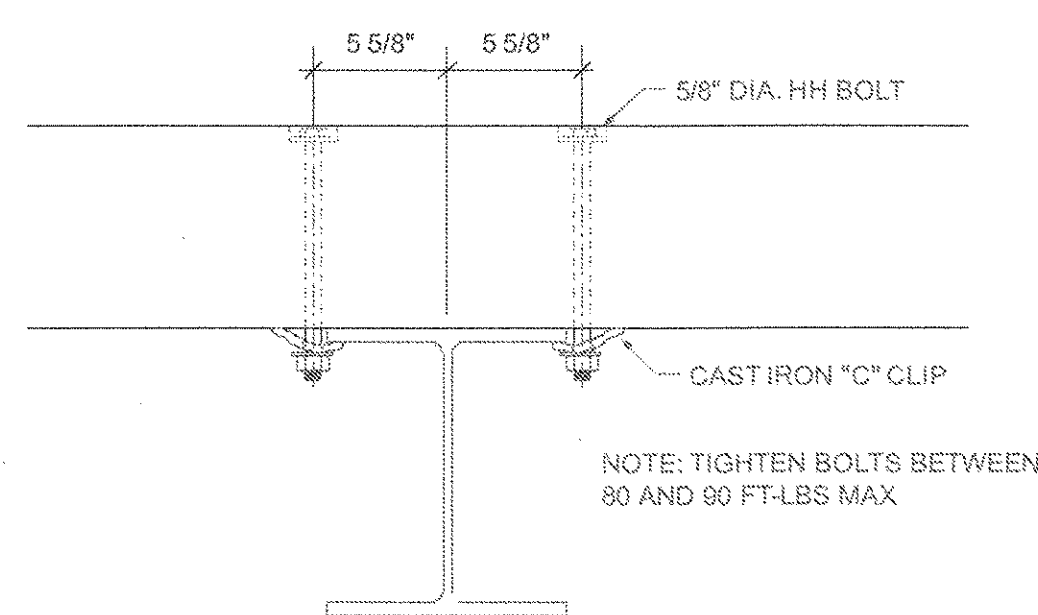

DECK TO STEEL DETAIL

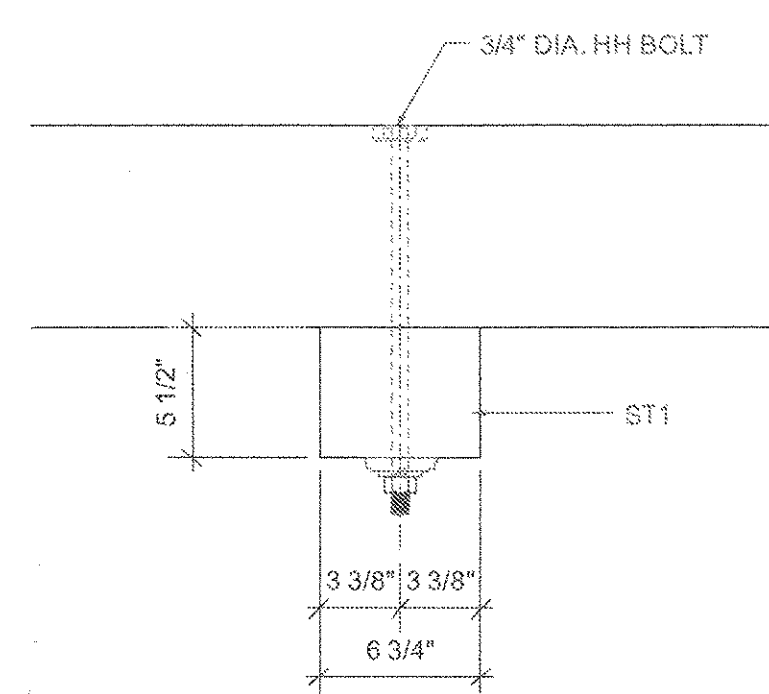

TYPICAL DECK TO STIFFENER DETAIL

**SCOPE**

This standard is intended to augment, or support, design requirements that may be issued by the owner.

**2. DEFINITIONS AND ABBREVIATIONS**

**AITC** American Institute of Timber Construction; **APA/EWS** American Wood Systems members, a related Corp. of the American Plywood Association; **AWPA** American Wood Preservers Association, **NDS** National Design Specifications. **TTE** tag this end **UNO** unless noted otherwise **DAC** Dimensions are cumulative **NIC** not in contract

**3. CODES AND STANDARDS**

In addition to complying with all pertinent codes and regulations, materials shall comply with the following:

- 3.1 American Association of State Highway and Transportation Officials (AASHTO)
- 3.2 American National Standard for Wood Products-Structural Glued Laminated Timber ANSI A190.1-1992
- 3.3 Proof-loading system for laminated finger joints to be in accordance with ANSI A190.1

**4. CERTIFICATIONS**

- 4.1 Certifications required by the laminator:
  - 4.1.1 The AITC or APA/EWS Certificate of Conformance with ANSI A190.1-1992
  - 4.2 Preservative treatment certification required (if applicable)
    - 4.2.1 Certificate of treatment furnished by a certified AWPA treating facility

**5. STRUCTURAL DESIGN**

The structure shall be designed to carry the following loads:

- 5.1 Dead Load
- 5.2 Live Load H-20

**6. MATERIALS**

- 6.1 Lumber-intended for structural use with design stress shall be graded in conformance with accepted standards for allowable unit stresses (See AASHTO Section 13)
- 6.2 Grade-Industrial Appearance Grade as per AITC 110.
- 6.3 All lumber to be Incised Southern Yellow Pine. Glulam as per AITC 117-98.
- 6.4 Adhesive: all members bonded with exterior "wet-use" conforming to ASTM D 2559

**7. PRESERVATIVE TREATMENT**

7.1 All GLU-lam material to be treated with the preservative Pentachlorophenol in Type A oil conforming to AWPA Standard C-28,C-14, P-8 and P-9. Retention level shall be 0.60 PCF. Final steaming and vacuuming shall be performed.

**8. HARDWARE**

- 8.1 All bolts and nuts shall galvanized (A-153) steel ASTM A307, unless noted otherwise.
- 8.2 Timber Washers to be galvanized cast iron or malleable iron.
- 8.3 "C" Clips shall be galvanized cast iron Grade 30

**9. MISC**

- 9.1 LCI is not responsible for materials or manufacturing not shown on these drawings.
- 9.2 Contractor is responsible for verification of all sizes, quantities and dimensions shown on shop drawings
- 9.3 For wearing surface information, refer to the USDA Forest Service manual "Timber bridges -Design, Construction, Inspection and Maintenance" Chapter 11, for types and applications.

LAMINATED CONCEPTS INC. LIST OF HARDWARE MATERIALS

21	07	150	LT	VT AOT	description	qty	dia.	lgt	wh	wn	n	type
					Deck to steel	136	5/8"	10"	F	F	1	Hex Head Bolts
					Deck to stiffener	288	3/4"	16"	F	T	1	Hex Head Bolts
						280	5/8"					Flat Washers
						290	3/4"					Flat Washers
						290	3/4"					Timber Washers
						140	5/8"					Hex Nuts
						290	3/4"					Hex Nuts

LAMINATED CONCEPTS INC. LIST OF LAMINATED TIMBER MATERIALS


21	07	150	LT	VT AOT	description	qty	mk#	width	depth	length	grade	species	remarks	bl tot
1	F1	8.5	48.125	55	11.625	COMB. 50	SYP						FAB. REQ'D	1907.89
1	F2	8.5	46.75	37	5.625	COMB. 50	SYP						FAB. REQ'D	1240.76
1	F3	8.5	46.75	55	11.625	COMB. 50	SYP						FAB. REQ'D	1953.38
1	F4	8.5	48.125	37	5.625	COMB. 50	SYP						FAB. REQ'D	1277.26
1	F5	8.5	48.125	55	6.625	COMB. 50	SYP						FAB. REQ'D	1893.69
1	F6	8.5	46.75	55	6	COMB. 50	SYP						FAB. REQ'D	1837.86
1	F7	8.5	46.75	55	6.625	COMB. 50	SYP						FAB. REQ'D	1839.58
1	F8	8.5	48.125	55	6	COMB. 50	SYP						FAB. REQ'D	1891.91
1	F9	8.5	48.125	38	5	COMB. 50	SYP						FAB. REQ'D	1309.57
1	F10	8.5	46.75	56	11.625	COMB. 50	SYP						FAB. REQ'D	1886.50
1	F11	8.5	46.75	38	5	COMB. 50	SYP						FAB. REQ'D	1272.15
1	F12	8.5	48.125	56	11.625	COMB. 50	SYP						FAB. REQ'D	1941.98
24	ST1	6.75	5.5	14	9.75	COMB. 50	SYP						FAB. REQ'D	1099.83

NOTE: wh = washer type at bolt head, wn = washer type at nut, n = nuts -washer type (T=Timber / F=Flat / P=Plate / D=Deck)

steel	description	qty	thk	width	length	type

attachments	description	qty	type	thk	width	length
	135 CAST IRON "C" CLIPS		neo.			

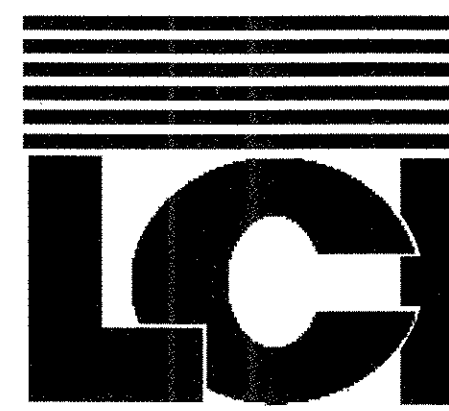

P.O. BOX 369  
3310 STATE RTE 352  
BIG FLATS, NEW YORK 14814  
PHONE: 607.562.8110  
FAX: 607.562.8105


DRAWN	DATE	REVISIONS			
MSS	6/4/07	NO.	DATE	BY	REVISIONS
CHKD	DATE	1	7/17/07	ss	revise panels
APPD	DATE	2	7/24/07	ss	revise panels
SCALE					

PROJECT NAME	PROJECT JOB NO.
BHO-BTN 2005 (1) BRIDGE NO. 26 TOWNS OF NEW HAVEN AND WEYBRIDGE COUNTY OF ADDISON, VERMONT	2107-150-LT
PREPARED FOR	SHEET NO.
CCS CONSTRUCTORS, LLC MORRISVILLE, VT	1 OF 4


RECEIVED  
CHKD BY *ELK* OK'D BY *RSY*  
JUL 27 2007  
RESUBMIT \_\_\_\_\_ APPROVED   
BY *CPW* DATE *7/31/07*

*STRUCTURES*  
*COPY*


*066-6D*

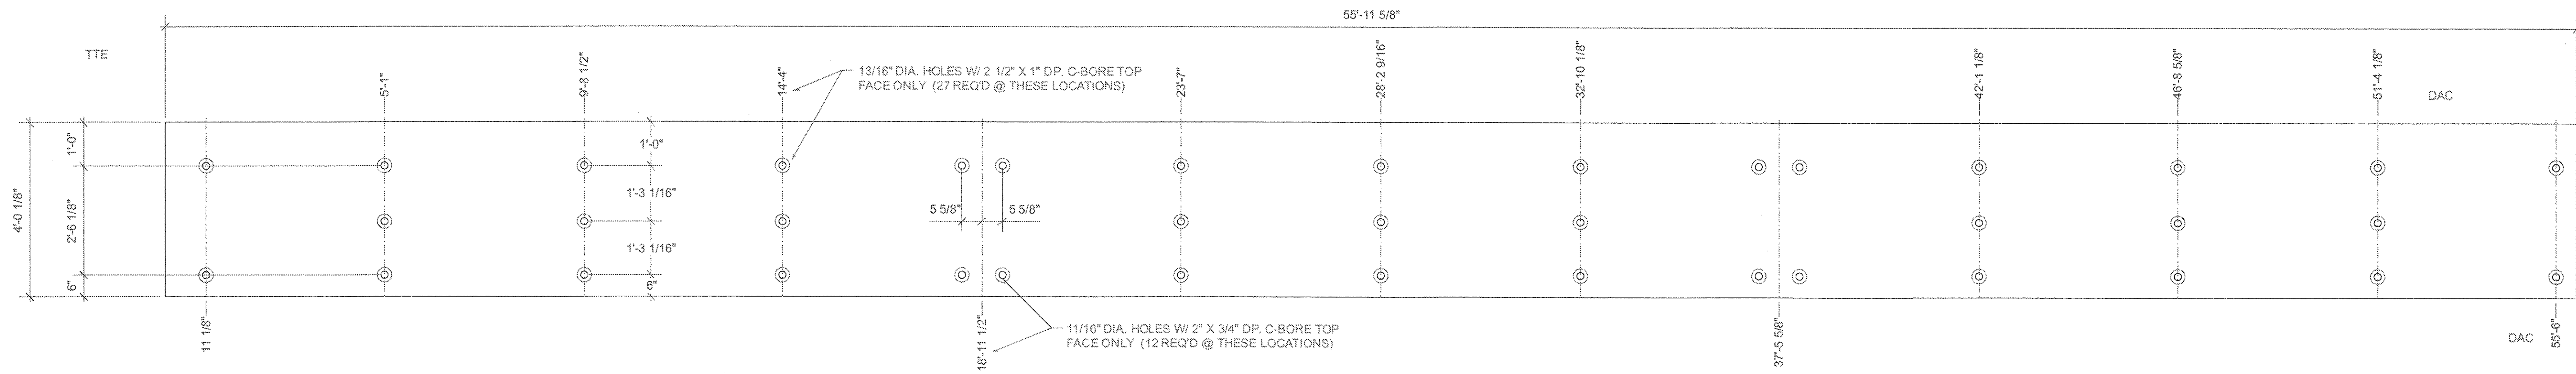


MK-F1 8 1/2" X 48 1/8" X 55'-11 5/8" 1 REQ'D COMB. 50 APPROX. WT. = 7210#

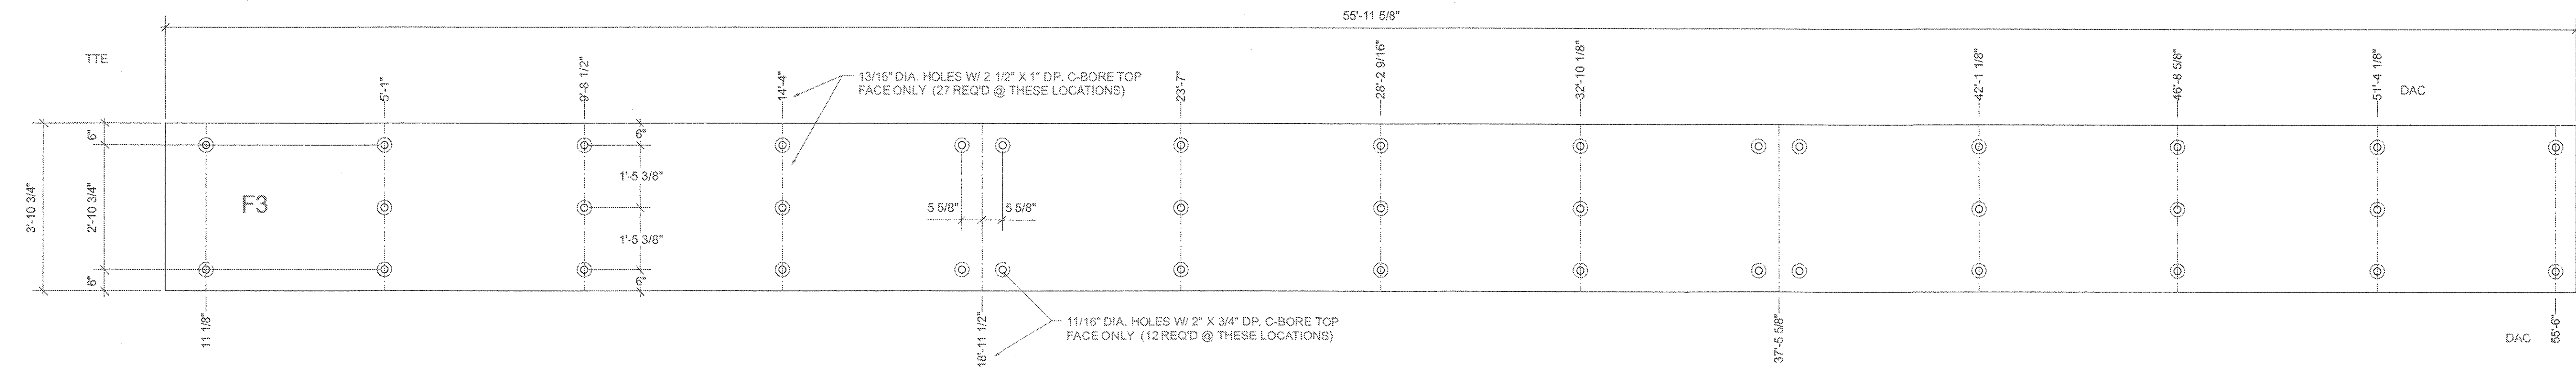

MK-F3 8 1/2" X 46 3/4" X 55'-11 5/8" 1 REQ'D COMB. 50 APPROX. WT. = 6860#

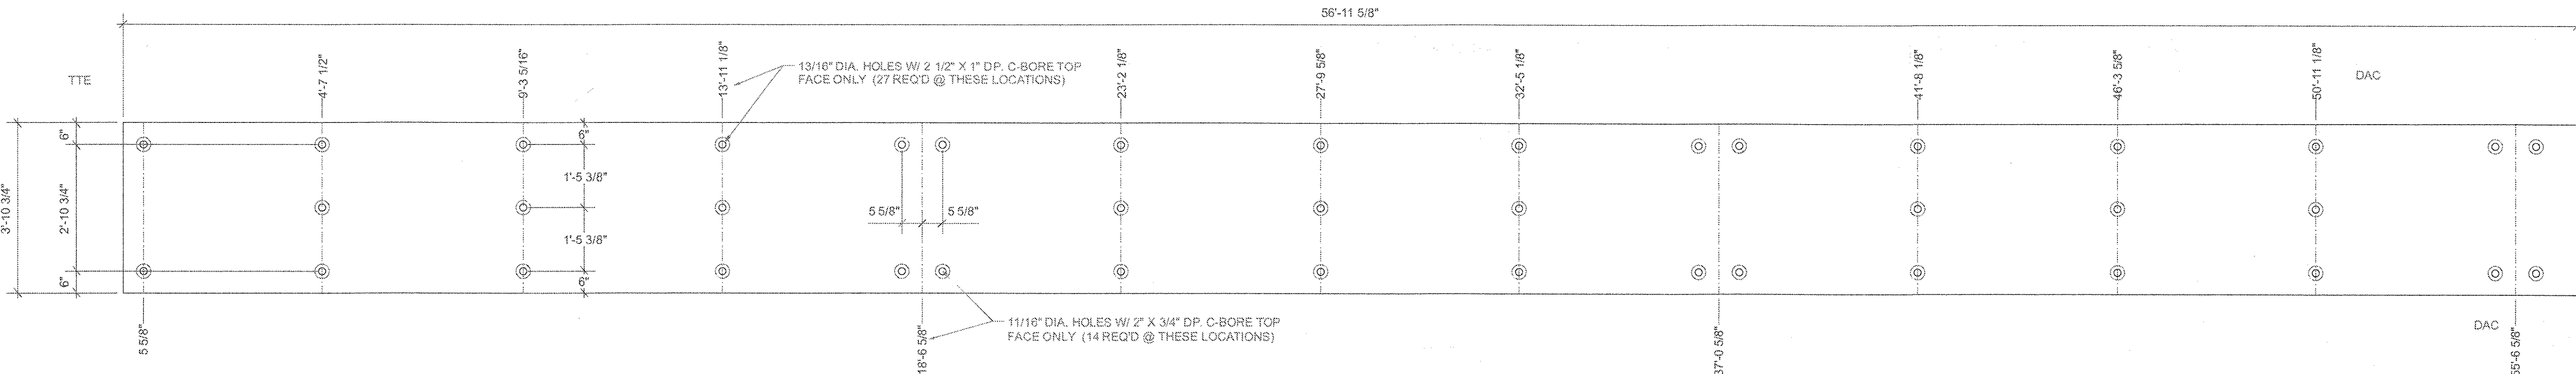

MK-F10 8 1/2" X 46 3/4" X 56'-11 5/8" 1 REQ'D COMB. 50 APPROX. WT. = 6970#

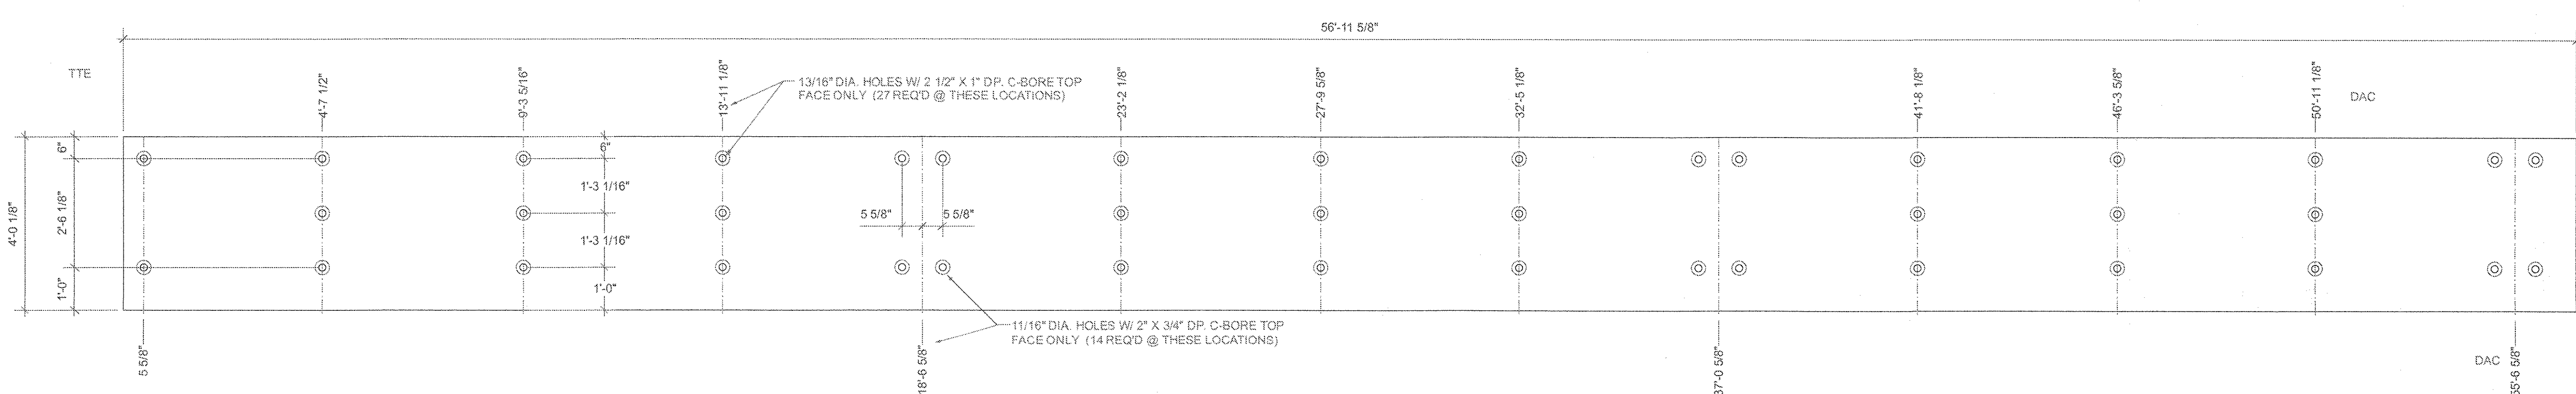

MK-F12 8 1/2" X 48 1/8" X 56'-11 5/8" 1 REQ'D COMB. 50 APPROX. WT. = 7340#

RECEIVED  
 OK'D BY: *ELC* OK'D BY: *RSR*  
 JUL 27 2007  
 RESUBMIT: \_\_\_\_\_ APPROVED: \_\_\_\_\_  
 BY: *CPW* DATE: 7/31/07




P.O. BOX 369  
 3310 STATE RTE 352  
 BIG FLATS, NEW YORK 14814  
 PHONE: 607.562.8110  
 FAX: 607.562.8105

DRAWN	DATE	REVISIONS			
		NO.	DATE	BY	REVISIONS
MSS	6/4/07				
CHKD		1	7/17/07	ss	revise panels
APPD		2	7/24/07	ss	revise panels
SCALE					


PROJECT NAME	BHO-BTN 2005 (1) BRIDGE NO. 26 TOWNS OF NEW HAVEN AND WEYBRIDGE COUNTY OF ADDISON, VERMONT	PROJECT JOB NO.	2107-150-LT
PREPARED FOR	CCS CONSTRUCTORS, LLC MORRISVILLE, VT	SHEET NO.	2 OF 4

LAMINATED CONCEPTS INC.


067-6D

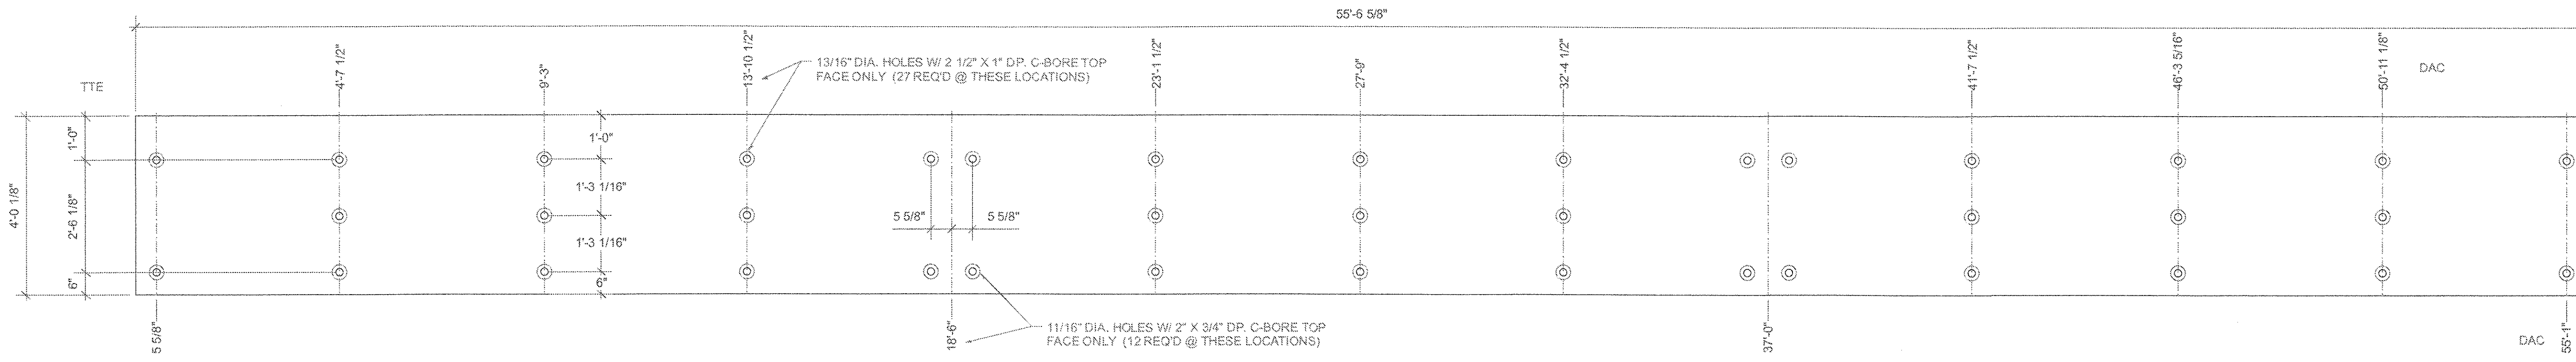


MK-F5 8 1/2" X 48 1/8" X 55'-6 5/8" 1 REQ'D COMB. 50 APPROX. WT. = 7150#

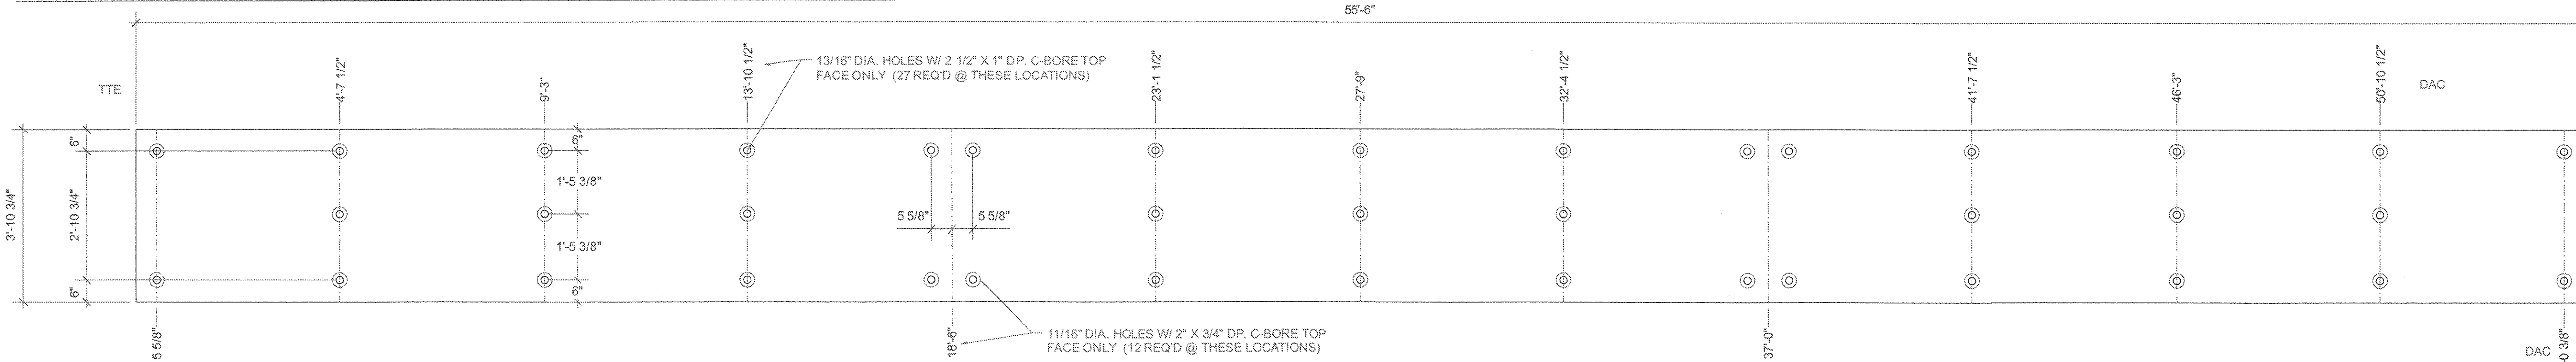

MK-F6 8 1/2" X 46 3/4" X 55'-6" 1 REQ'D COMB. 50 APPROX. WT. = 6800#

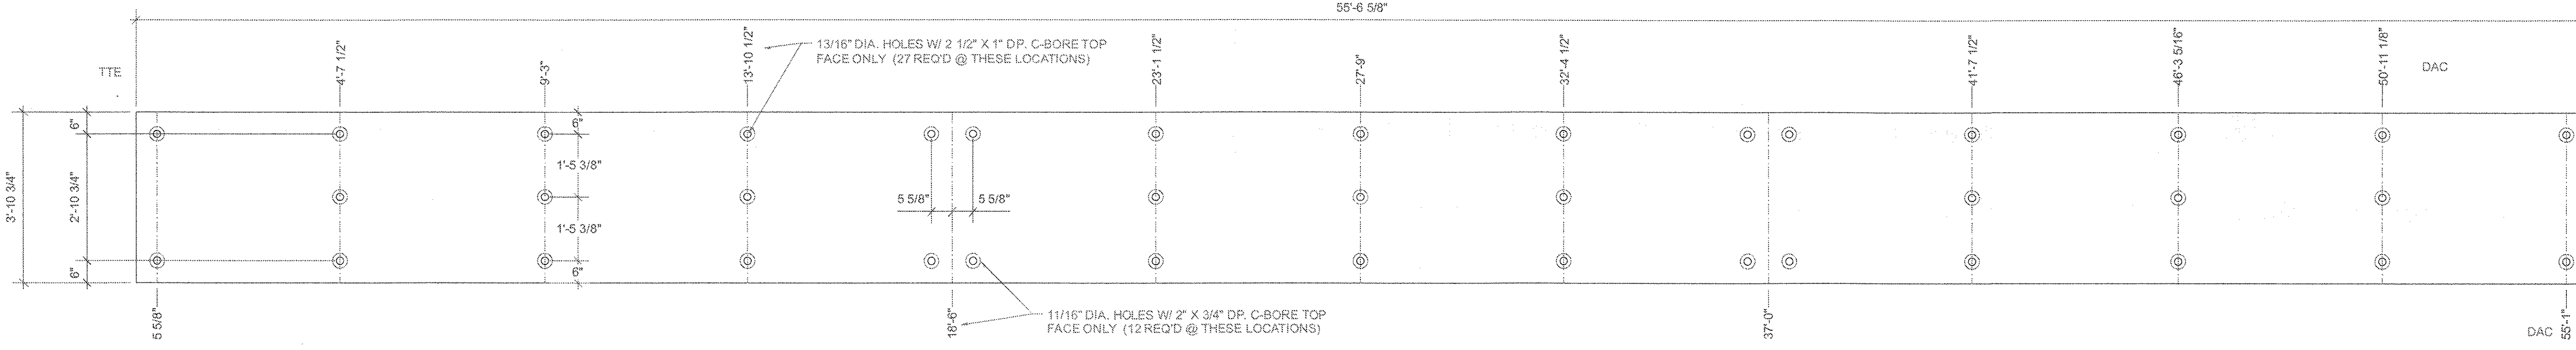


MK-F7 8 1/2" X 46 3/4" X 55'-6 5/8" 1 REQ'D COMB. 50 APPROX. WT. = 6800#

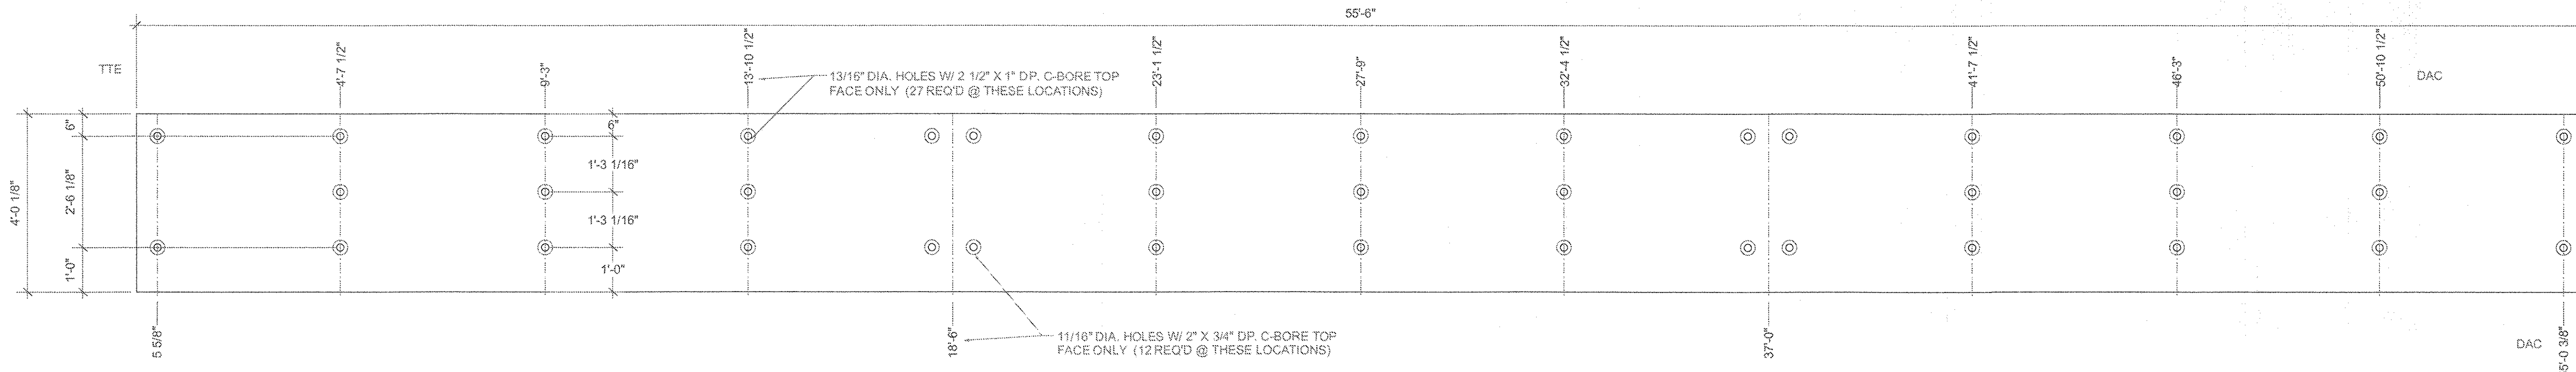

MK-F8 8 1/2" X 48 1/8" X 55'-6" 1 REQ'D COMB. 50 APPROX. WT. = 7150#

RECEIVED  
 CK'D BY *EL* OK'D BY *RSY*  
 JUL 27 2007  
 RESUBMIT \_\_\_\_\_ APPROVED \_\_\_\_\_  
 BY *CPW* DATE 7/31/07

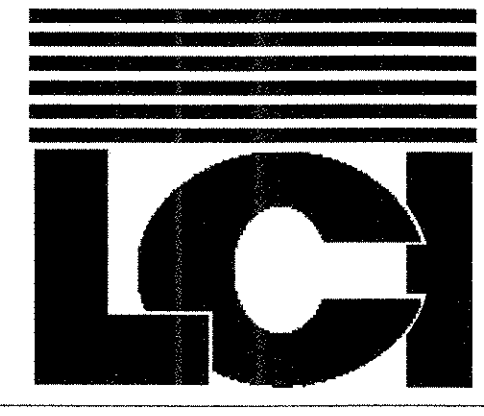


P. O. BOX 369  
 3310 STATE RTE 352  
 BIG FLATS, NEW YORK 14814  
 PHONE: 607.562.8110  
 FAX: 607.562.8105

DRAWN	DATE	REVISIONS			
		NO.	DATE	BY	REVISIONS
MSS	6/4/07				
CHKD		1	7/17/07	ss	revise panels
APPD		2	7/24/07	ss	revise panels
SCALE					


PROJECT NAME	BHO-BTN 2005 (1) BRIDGE NO. 26 TOWNS OF NEW HAVEN AND WEYBRIDGE COUNTY OF ADDISON, VERMONT	PROJECT JOB NO.	2107-150-LT
PREPARED FOR	CCS CONSTRUCTORS, LLC MORRISVILLE, VT	SHEET NO.	3 OF 4

LAMINATED CONCEPTS INC.


068-6D

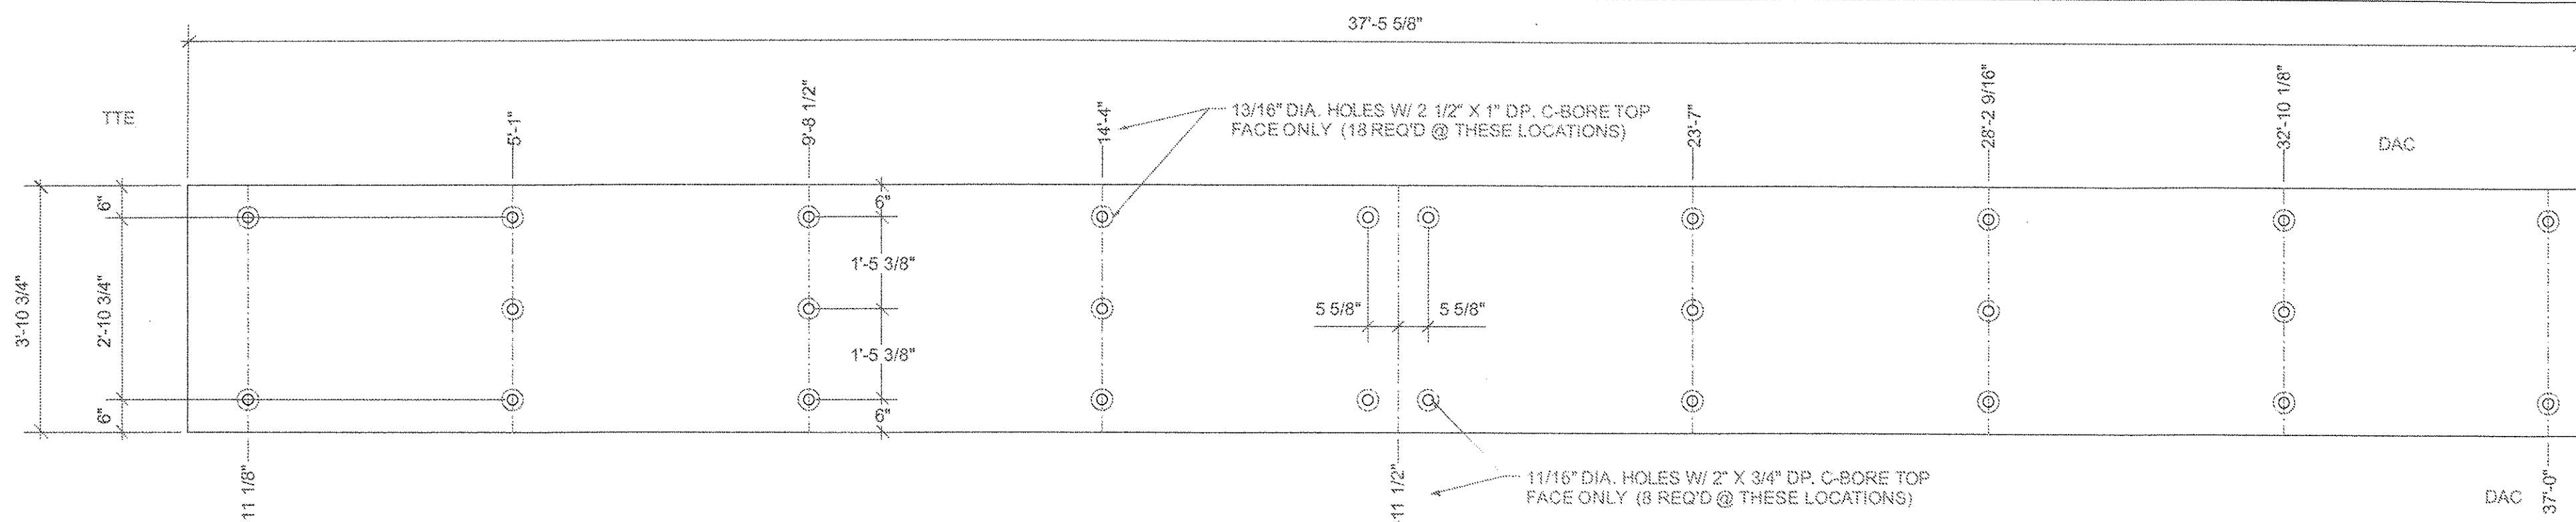


MK-F2 8 1/2" X 46 3/4" X 37'-5 5/8" 1 REQ'D COMB. 50 APPROX. WT. = 4590#

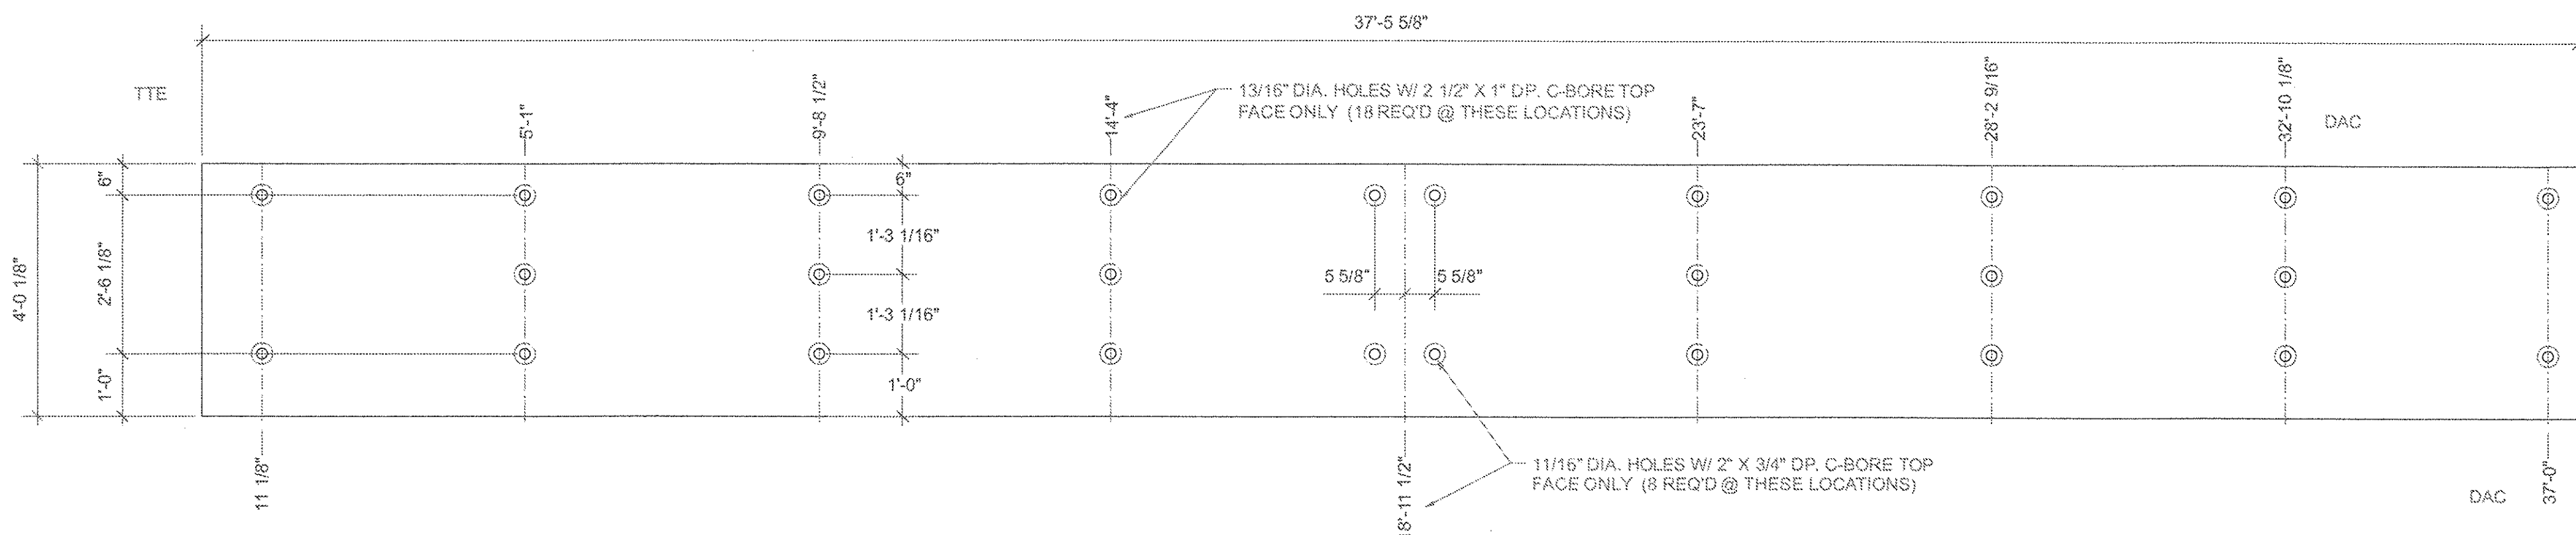


MK-F4 8 1/2" X 48 1/8" X 37'-5 5/8" 1 REQ'D COMB. 50 APPROX. WT. = 4830#

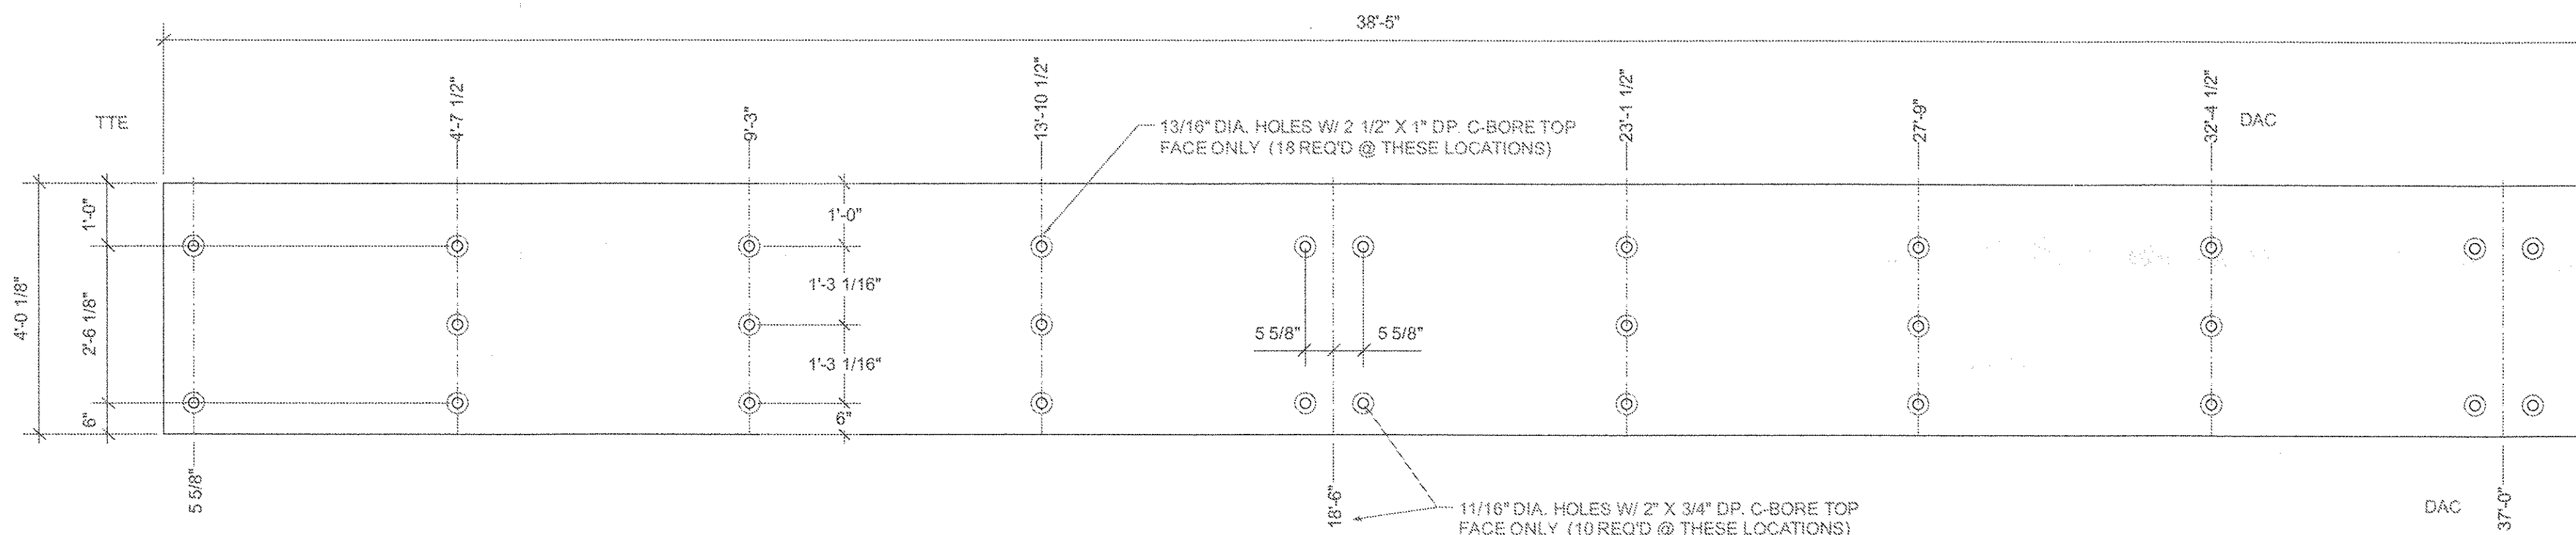

MK-F9 8 1/2" X 49 1/8" X 38'-5" 1 REQ'D COMB. 50 APPROX. WT. = 4830#

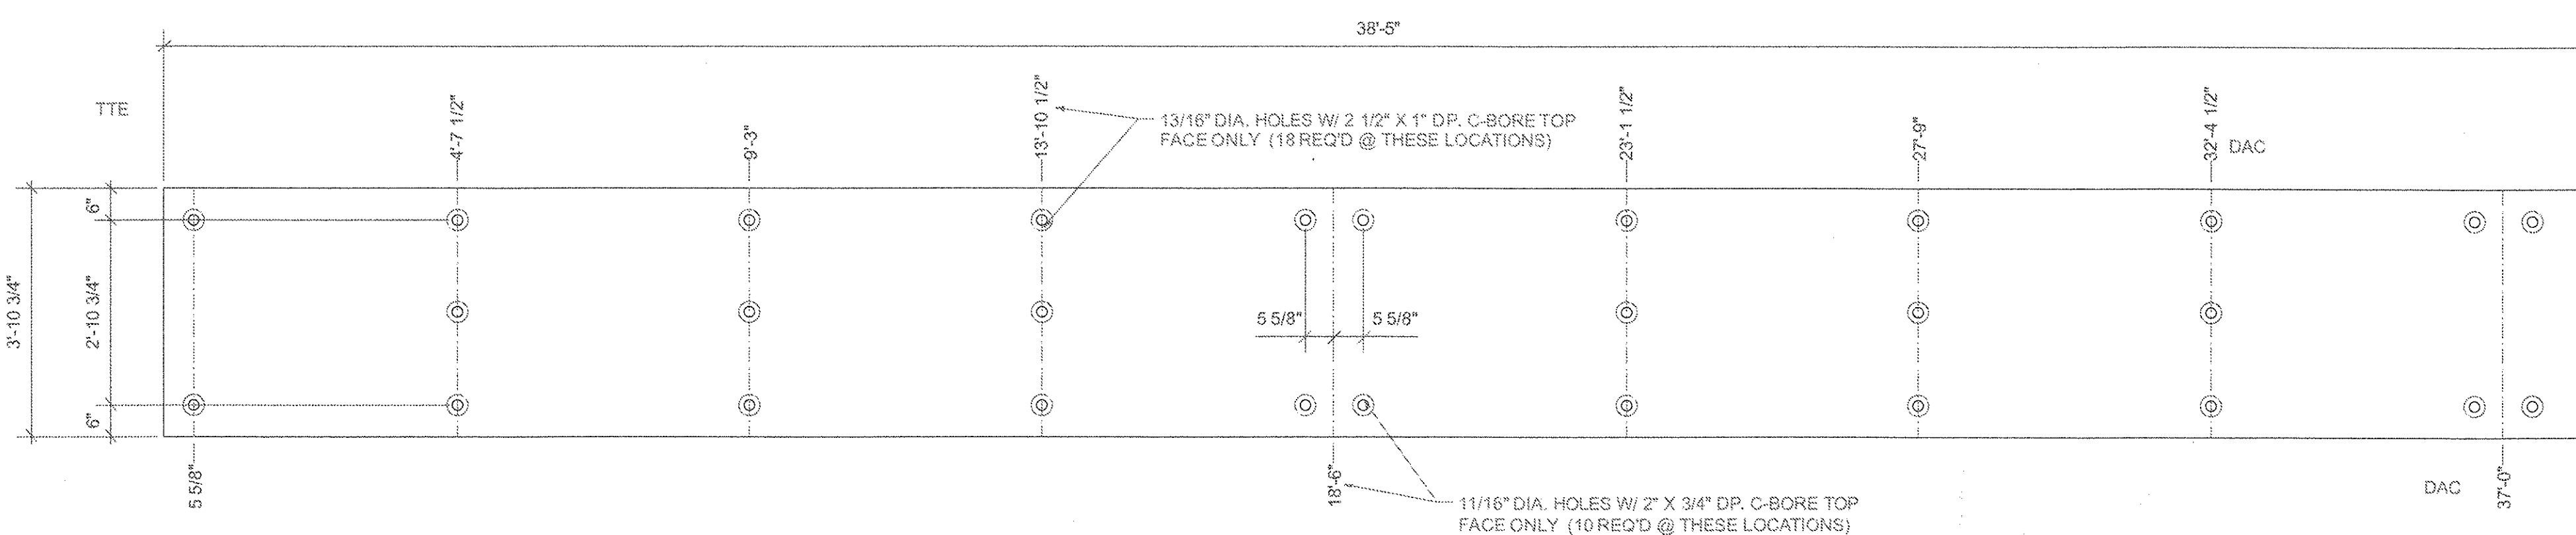


MK-F11 8 1/2" X 46 3/4" X 38'-5" 1 REQ'D COMB. 50 APPROX. WT. = 4600#

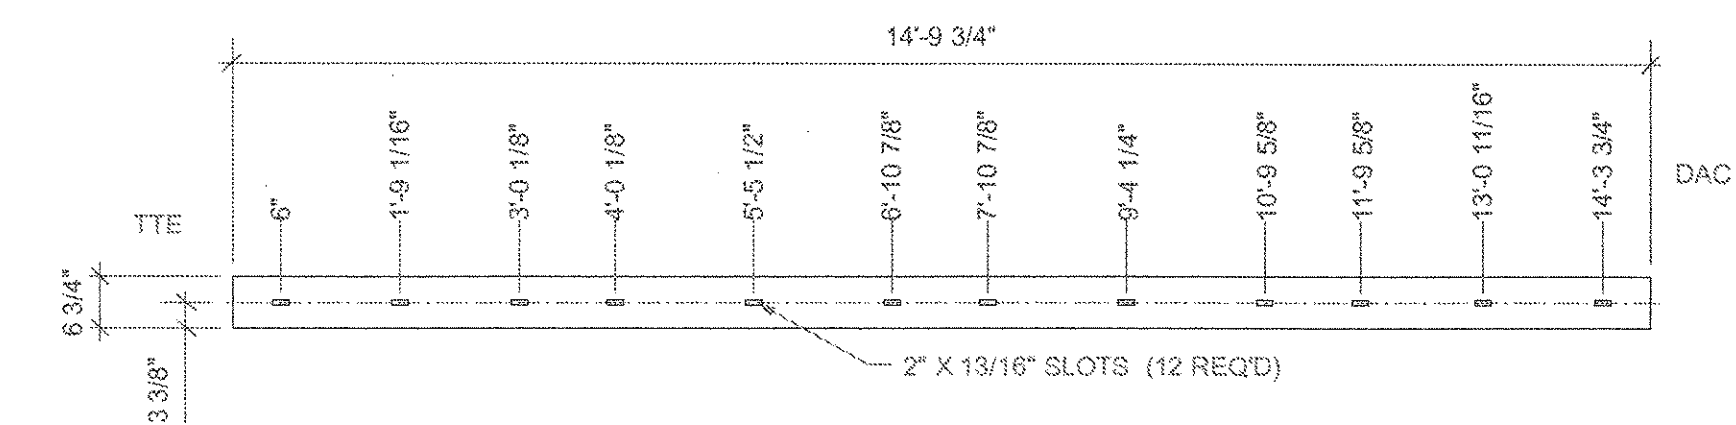

MK-ST1 6 3/4" X 5 1/2" X 14'-9 3/4" 24 REQ'D COMB. 50 APPROX. WT. = 172#

RECEIVED  
 OK'D BY *EJK* OK'D BY *RSY*  
 JUL 27 2007  
 RESUBMIT \_\_\_\_\_ APPROVED \_\_\_\_\_  
 BY *CPW* DATE 7/31/07

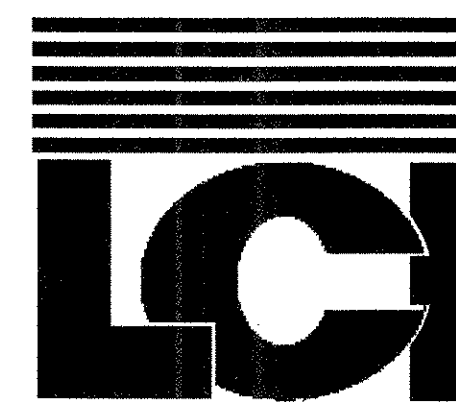

LAMINATED CONCEPTS INC.

P.O. BOX 369  
 3310 STATE RTE 352  
 BIG FLATS, NEW YORK 14814  
 PHONE: 607.562.8110  
 FAX: 607.562.8105

DRAWN	DATE	REVISIONS			
		NO.	DATE	BY	REVISIONS
MSS	6/4/07				
CHKD	DATE	1	7/17/07	ss	revise panels
APPD	DATE	2	7/24/07	ss	revise panels
SCALE					

PROJECT NAME	BHO-BTN 2005 (1) BRIDGE NO. 26 TOWNS OF NEW HAVEN AND WEYBRIDGE COUNTY OF ADDISON, VERMONT	PROJECT JOB NO.	2107-150-LT
PREPARED FOR	CCS CONSTRUCTORS, LLC MORRISVILLE, VT	SHEET NO.	4 OF 4

0696D



**RFI**

DATE: 10/19/07  
RFI #: NCR-04

**FROM:** John Bettin  
DS Brown Co  
300 East Cherry Street  
North Baltimore, Ohio 45872  
[jbettin@dsbrown.com](mailto:jbettin@dsbrown.com)

**TO:** Andy White  
CCS Constructors  
138 Munson Ave  
Morrisville, VT 05661  
[awhite@contractorscranesvc.com](mailto:awhite@contractorscranesvc.com)

**Direct Dial:** 952-693-1099  
**FAX:** 419-257-0332

**PHONE:**  
**FAX:**

**REFERENCE:** New Haven-Weybridge  
Non-Conformance to Post Base Plate

**DSB JOB #:** 20388-1206

**INFORMATION REQUESTED:**

**Ref. Attached sketch SK-NC04-01 & DSB shop drawing sheet 01**  
A mistake was made to the length of the 1/2" thick anchor plates 1a1 on assembly 1B shown on DSB shop drawing sheet 01. The length of these plates were inadvertently changed in BOM after the initial approval and we fabricated them to 1'-3" in lieu of the 1'-4" shown on the detail. Since the rods and holes were dimensionally worked off the center of the plate, unfortunately this error was not discovered until after they were fabricated and set to ship. Since the timing of this project has become critical we are asking for acceptance of the anchors as shown on attached sketch SK-NC04-01.

Please call if you have any questions.

- Thank You

**REPLY:**

---

---

**FROM:**

---

---


Approved  
CPW  
10/19/07

070-BR

The D.S. Brown Company  
300 E. Cherry Street  
North Baltimore, Ohio 45872  
419.257.3561  
Fax: 419.257.2200  
Engineering Fax: 419.257.0332  
E-mail: [dsb@dsbrown.com](mailto:dsb@dsbrown.com)  
[www.dsbrown.com](http://www.dsbrown.com)

Chaska Operations  
4201 Norex Drive  
Chaska, Minnesota 55318  
952.368.3000  
Fax: 952.448.7000

International Division  
7 Temasek Boulevard  
#16-03 Suntec Tower One  
Singapore 038987  
+65.333.0911  
Fax: +65.333.0922  
E-mail: [dsbrown@mbx2.singnet.com.sg](mailto:dsbrown@mbx2.singnet.com.sg)

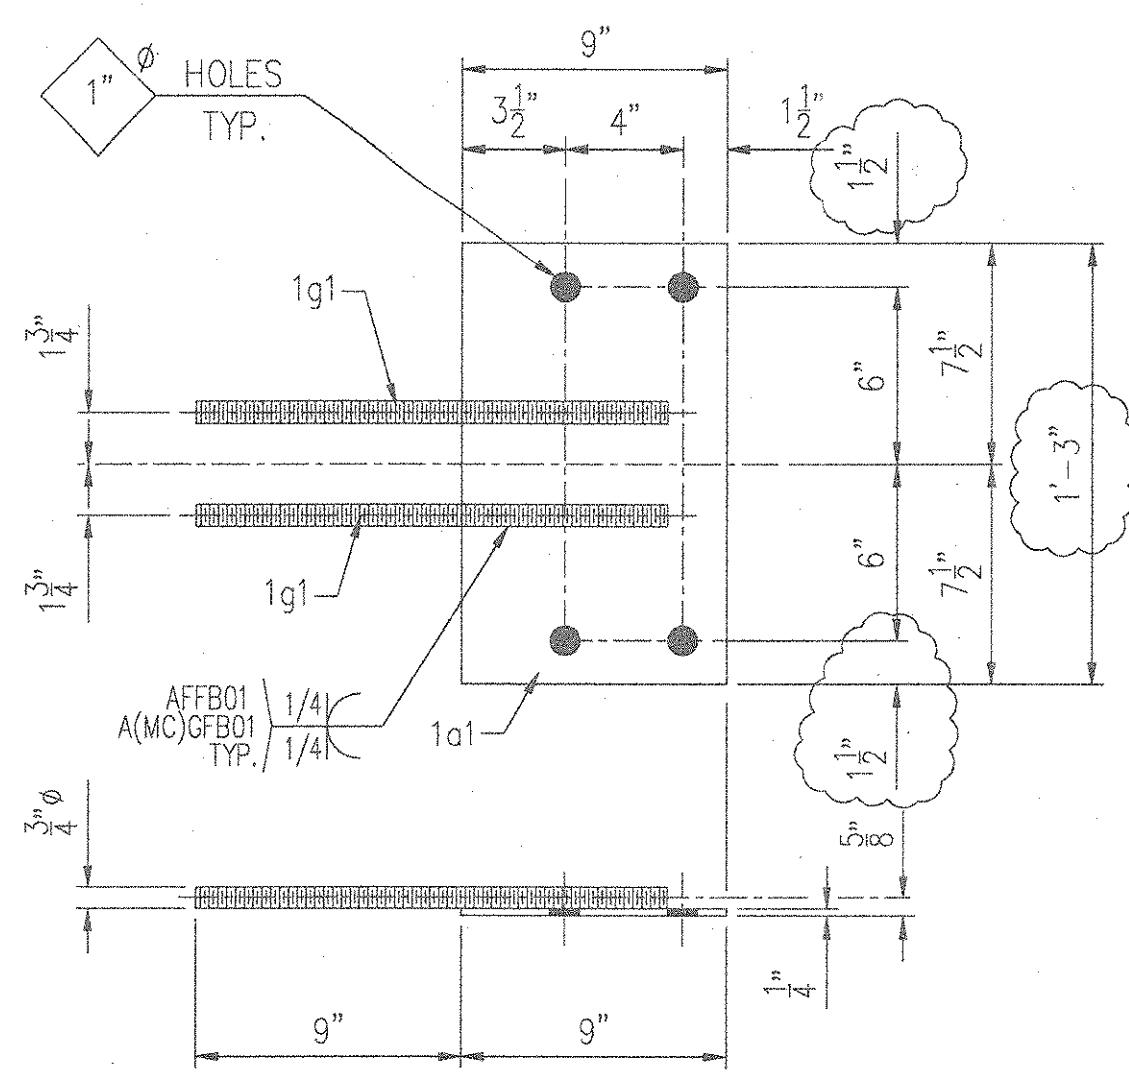

32 - ANCHORS - 1B


SHEET: SK-NC04-01

PDF created with pdfFactory trial version [www.pdffactory.com](http://www.pdffactory.com)


071-BR

NO.	REV.	DESCRIPTION	DATE	BY	CHKD.
1		ISSUED FOR CONSTRUCTION	10/20/07	...	...
2		...	...	...	...
3		...	...	...	...

32 - SIDERAIL POSTS - 1A.

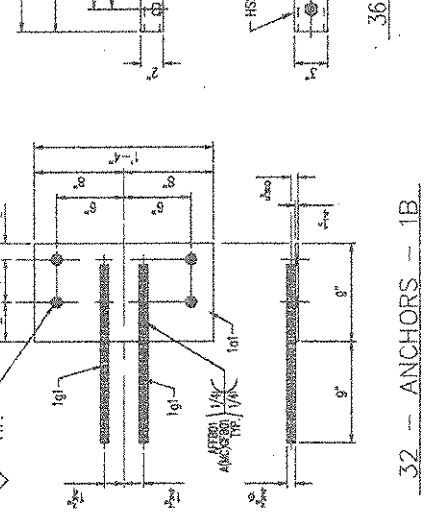

32 - PLATE WASHERS - 1C.

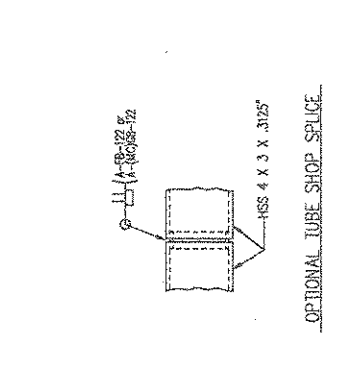

32 - INSERTS - 1H.

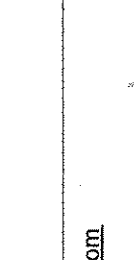

32 - ANCHORS - 1B.




GENERAL NOTES:

1. DIMENSIONS SHALL BE AS SHOWN UNLESS OTHERWISE NOTED. ALL DIMENSIONS SHALL BE IN UNITS OF INCHES UNLESS OTHERWISE NOTED.
2. DIMENSIONS SHALL BE AS SHOWN UNLESS OTHERWISE NOTED. ALL DIMENSIONS SHALL BE IN UNITS OF INCHES UNLESS OTHERWISE NOTED.
3. DIMENSIONS SHALL BE AS SHOWN UNLESS OTHERWISE NOTED. ALL DIMENSIONS SHALL BE IN UNITS OF INCHES UNLESS OTHERWISE NOTED.
4. DIMENSIONS SHALL BE AS SHOWN UNLESS OTHERWISE NOTED. ALL DIMENSIONS SHALL BE IN UNITS OF INCHES UNLESS OTHERWISE NOTED.
5. DIMENSIONS SHALL BE AS SHOWN UNLESS OTHERWISE NOTED. ALL DIMENSIONS SHALL BE IN UNITS OF INCHES UNLESS OTHERWISE NOTED.
6. DIMENSIONS SHALL BE AS SHOWN UNLESS OTHERWISE NOTED. ALL DIMENSIONS SHALL BE IN UNITS OF INCHES UNLESS OTHERWISE NOTED.
7. DIMENSIONS SHALL BE AS SHOWN UNLESS OTHERWISE NOTED. ALL DIMENSIONS SHALL BE IN UNITS OF INCHES UNLESS OTHERWISE NOTED.
8. DIMENSIONS SHALL BE AS SHOWN UNLESS OTHERWISE NOTED. ALL DIMENSIONS SHALL BE IN UNITS OF INCHES UNLESS OTHERWISE NOTED.
9. DIMENSIONS SHALL BE AS SHOWN UNLESS OTHERWISE NOTED. ALL DIMENSIONS SHALL BE IN UNITS OF INCHES UNLESS OTHERWISE NOTED.
10. DIMENSIONS SHALL BE AS SHOWN UNLESS OTHERWISE NOTED. ALL DIMENSIONS SHALL BE IN UNITS OF INCHES UNLESS OTHERWISE NOTED.

ALL DIMENSIONS SHALL BE AS SHOWN UNLESS OTHERWISE NOTED. ALL DIMENSIONS SHALL BE IN UNITS OF INCHES UNLESS OTHERWISE NOTED.

NO.	REV.	DESCRIPTION	DATE	BY	CHKD.
1		ISSUED FOR CONSTRUCTION	10/20/07	...	...
2		...	...	...	...
3		...	...	...	...
NECESSARY FOR INSPECTION - TURN 27 AUG 2007 - 919

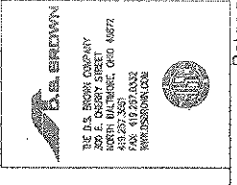



State of Vermont  
PDD/Structures Design Section  
One National Life Drive  
Montpelier, VT 05633-5001  
www.aot.state.vt.us

(phone) 802-828-2621  
(fax) 802-828-3566  
(tdd) 800-253-0191

Agency of Transportation

August 17, 2007


D. S. Brown Co.  
300 E. Cherry Street  
North Baltimore, OH 45872

**Re: New Haven – Weybridge BHO BTN 2005(1) – TH 7, Bridge 26**

The following Railing details (2 Tube and Lattice Railing) [Item #525.31, Bridge Railing, Galvanized 2 Rail Box Beam] for the above project (Vendor's Job #20388) that were received in this office on August 7, have been reviewed and are being returned herewith.


Sheets 2 and 3 for the 2 Tube Railing are approved as noted. Please see comments in red on these sheets. All other sheets and the weld procedures are approved.

There shall be no fabrication done until all drawings and welding procedures are approved. You must provide written notice to this office as to the date fabrication represented by these drawings will begin. That notice must be received at least seven days prior to that date, as per Specification 506.03. Any material fabricated prior to the notification date is subject to rejection without further cause.

Sincerely,  
  
Christopher P. Williams, P.E.  
Structures Project Manager

Attachments


cc: [ X ] Dale Norton – Resident Engineer  
[ X ] CCS Constructors - Contractor  
[ X ] Steel Inspector – Jeff Clark  
[ X ] Construction Section - letter only  
[ X ] Materials & Research (C&IA Unit) - letter only  
[ X ] Project Files

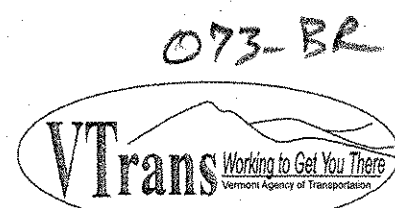

**DSBROWN Production Joint Welding Procedure Specification (D1.5-02)**

Procedure No: A-(MC)GB-122 Date Issued: 11-30-04 Revision No: 0 Rev. Date: \_\_\_\_\_  
 Contractor (Fabricator) D. S. Brown Company Prepared by: James R. Connor, Quality Assurance Manager  
 2. Qualified in accordance with: AWS D1.5:2002 (5.12.1)  
 Referenced PQR No(s): PQR-(MC)GMAW-01(04)  
 Referenced FWST No(s): N/A  
 3. Material specification(s) ASTM A709 Gr. 36, 50, 50W, A500B Tube For DOT Approval  
 4. Material Thickness (es) Unlimited  
 5. Welding process GMAW  
 6. Manual , machine , or semiautomatic   
 7. Position(s) of welding 1G  
 8. Filler metal specification AWS A5.18  
 9. Filler metal class and brand name E70C-6M Corex Metal-Core Maxim  
 10. Flux class & brand N/A, Type N/A  
 11. Shielding gas 75% Ar / 25% CO2 Flow rate 45 CFH  
 12. Single pass  Or multiple pass   
 13. Single arc  Or multiple arc   
 14. Welding Current DCEP  
 15. Polarity Reverse  
 16. Welding progression stringers  
 17. Root treatment Clean to bright sound metal or per AWS D1.5 (3.2.1 & 3.11)  
 18. Postheat treatment N/A  
 19. Calculated Heat Input (KJ/in) Min 30.6 KJ/in Max 51.1 KJ/in  
 20. Electrode extension (electrical stickout) 3/4"

TRAVIS  
RECEIVED  
 JUN 21 2007  
 OK'D BY: JRC  
 APPROVED: [Signature]  
 DATE: 7-23-07

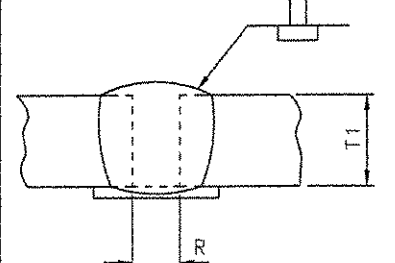Weld size (in)	Pass (No.)	Electrode Size (in)	Welding Process Variables		Travel Speed (in)	Joint Detail (Groove) Show all dimensions, weld sizes, passes, and AWS symbols
			AMPS/WFS*	VOLTS		
CJP	ALL	.052"	265-320	31-34.5	13-16	 <p>Notes:                      T1 = 3/8" (10mm) MAX                      R = 1/8" (3mm) MIN T1 MAX</p>
DO NOT REMOVE BACKING FROM TUBE SPLICES  CCS Constructors LLC 138 Munson Avenue Morrisville, VT 05661 Ph: 802-888-7701 f: 802-888-4746						

\* Wire feed speed may be used along with amperage (include chart)

Preheat and Interpass Temperature Chart		
Base Metal Thickness range	Minimum Preheat (°F)	Max Preheat & Interpass (°F)
≤ 3/4"	50°F	450°F
> 3/4" to ≤ 1.5"	70°F	450°F
> 1.5" to ≤ 2.5"	150°F	450°F
> 2.5"	225°F	450°F

Prepared By: James R. Connor DSB QA Manager  
 Project: Route No. TH 7/11, CL3  
 DSB Job: 20388-1206

Note: When this procedure is used for A709Gr50W materials, it shall be limited to 5/16" single pass or material be coated.

074-BRW

**DSBROWN Production Joint Welding Procedure Specification (D1.5-02)**

Procedure No: A-(MC)GFB-01 Date Issued: 8-14-06 Revision No: 0 Rev. Date: \_\_\_\_\_  
 Contractor (Fabricator) D. S. Brown Company Prepared by: James R. Connor, Quality Assurance Manager  
 1. Non-Fracture Critical  Fracture Critical  WPS Expiration Date: \_\_\_\_\_  
 2. Qualified in accordance with: AWS D1.5-2002 (5.12.1)  
 Referenced PQR No(s): PQR-(MC)GMAW-01(04)  
 Referenced FWST No(s): PQR-(MC)GMAW-FWST-01A(04), PQR-(MC)GMAW-FWST-01B(04)  
 3. Material specification(s) ASTM A709 Gr. 36, 50, 50W, CF1018, CF1040, A615 For DOT Approval  
 4. Material Thickness (es) Unlimited  
 5. Welding process GMAW  
 6. Manual , machine , or semiautomatic   
 7. Position(s) of welding 1G, 2G  
 8. Filler metal specification AWS A5.18  
 9. Filler metal class and brand name E70C-6M Corex Metal-Core Maxim  
 10. Flux class & brand N/A, Type N/A  
 11. Shielding gas 75% Ar / 25% CO2 Flow rate 45 CFH  
 12. Single pass  Or multiple pass   
 13. Single arc  Or multiple arc   
 14. Welding Current DCEP  
 15. Polarity Reverse  
 16. Welding progression stringers  
 17. Root treatment Clean to bright sound metal or per AWS D1.5 (3.2.1 & 3.11)  
 18. Postheat treatment N/A  
 19. Calculated Heat Input (KJ/in) Min 30.6 KJ/in Max 51.1 KJ/in  
 20. Electrode extension (electrical stickout) 3/4"

TRAVIS  
RECEIVED  
JUN 21 2007  
RESUBMIT APPROVED  
DATE 7-23-07

Weld Size (in)	Pass No(s)	Eutectic Shield (in)	Welding Process Variables		Travel Speed (IPM)	Tapered Bevel
			AMPS/WFS*	VOLTS		
**1/4"	1	.052"	265-320	31-34.5	13-16	<p>Joint Detail (Flare Bevel) Show all dimensions, weld sizes, passes, and AWS symbols</p> <p>T<sub>1</sub> = UNLIMITED T<sub>2</sub> = RB (Type and Dia. per dwg.) R = 0 Bevel = NATURAL S = WELD SIZE</p>
5/16"	1	.052"	265-320	31-34.5	13-16	
3/8"	1-3	.052"	265-320	31-34.5	13-16	
7/16"	2-4	.052"	265-320	31-34.5	13-16	
1/2"	4-6	.052"	265-320	31-34.5	13-16	
5/8"	5-7	.052"	265-320	31-34.5	13-16	
3/4"	6-8	.052"	265-320	31-34.5	13-16	

\* Wire feed speed may be used along with amperage (include chart)

Prepared By: <u>James R. Connor</u> DSB QA Manager	Preheat and Interpass Temperature Chart		
	Base Metal Thickness range	Minimum Preheat (°F)	Max Preheat & Interpass (°F)
Project: <u>Route No. TH 7/11, CL3</u>	≤ 3/4"	50°F	450°F
	>3/4" to ≤1.5"	70°F	450°F
	>1.5" to ≤2.5"	150°F	450°F
	>2.5"	225°F	450°F

DSB Job: 20388-1206

Note: When this procedure is used for A709Gr50W materials, it shall be limited to 5/16" single pass or material be coated.

075-RLWP

**DSBROWN Production Joint Welding Procedure Specification (D1.1-04)**

Procedure No: A-(MC)GSB-11(AK) Date Issued: 12-7-04 Revision No: 0 Rev. Date: \_\_\_\_\_  
 Contractor (Fabricator) D. S. Brown Company Prepared by: James R. Connor, Quality Assurance Manager

1. Non-Fracture Critical  Fracture Critical  WPS Expiration Date: \_\_\_\_\_  
 2. Qualified in accordance with: AWS D1.1-2004  
 Referenced PQR No(s): PQR-(MC)GMAW-01(04)  
 Referenced FWST No(s): PQR-(MC)GMAW-FWST-01A(04), PQR-(MC)GMAW-FWST-01B(04)  
 3. Material specification(s) ASTM A709 Gr. 36, 50, 50W, ASTM A500B, A53 pipe For DOT Approval  
 4. Material Thickness (es) Unlimited  
 5. Welding process GMAW  
 6. Manual , machine , or semiautomatic   
 7. Position(s) of welding 1G, 2G, 1F, 2F  
 8. Filler metal specification AWS A5.18  
 9. Filler metal class and brand name E70C-6M Corex Metal-Core Maxim  
 10. Flux class & brand N/A, Type N/A  
 11. Shielding gas 75% Ar / 25% CO2 Flow rate 45 CFH  
 12. Single pass  Or multiple pass   
 13. Single arc  Or multiple arc   
 14. Welding Current DCEP  
 15. Polarity Reverse  
 16. Welding progression stringers  
 17. Root treatment Clean to bright sound metal or per AWS D1.1  
 18. Postheat treatment N/A  
 19. Calculated Heat Input (KJ/in) Min 30.6 KJ/in Max 51.1 KJ/in  
 20. Electrode extension (electrical stickout) 3/4"

RECEIVED  
 JUN 21 2007  
 APPROVED  
 DATE 7-23-07

Stick Size (in)	PDA No(s)	Pass No(s)	Electrode Diameter (in)	Welding Process Variables			Travel Speed (in/d)	Joint Detail (TC-P4-GF) Show all dimensions, weld sizes, passes, and AWS symbols
				AMPS/WFS*	VOLTS	(in/d)		
1/4"	1	.052"	265-320	31-34.5	13-16		<p>T1 = 1/4" min.                      T2 = Varies                      (E) = S-1/8"                      f = 1/8" min.                      R = 0                      alpha = 45°                      S = size groove                      (S) = size of reinforcing fillet (if required) not to exceed 1/2" in corner &amp; T.Js.</p>	
5/16"	1	.052"	265-320	31-34.5	13-16			
3/8"	1-2	.052"	265-320	31-34.5	13-16			
1/2"	3-4	.052"	265-320	31-34.5	13-16			
5/8"	4-6	.052"	265-320	31-34.5	13-16			
3/4"	5-7	.052"	265-320	31-34.5	13-16			
7/8"	6-9	.052"	265-320	31-34.5	13-16			
1"	7-10	.052"	265-320	31-34.5	13-16			

\* Wire feed speed may be used along with amperage (include chart)

Prepared By: James R. Connor DSB QA Manager  
 Project: Route No. TH 7/11, CL3

DSB Job: 20388-1206

Note: When this procedure is used for A709Gr50W materials, it shall be limited to 5/16" single pass or material be coated.

Base Metal Thickness range	Minimum Preheat (°F)	Max Preheat & Interpass (°F)
≤ 3/4"	50°F	450°F
>3/4" to ≤1.5"	70°F	450°F
>1.5" to ≤2.5"	150°F	450°F
>2.5"	225°F	450°F

076-BRWP

**DSBROWN Production Joint Welding Procedure Specification (D1.5-02)**

Procedure No: **A-FB-122** Date Issued: **11-24-03** Revision No: **0** Rev. Date: \_\_\_\_\_

Contractor (Fabricator) **D. S. Brown Company** Prepared by: **James R. Connor, Quality Assurance Manager**

1. Non-Fracture Critical  Fracture Critical  WPS Expiration Date: \_\_\_\_\_

2. Qualified in accordance with: **AWS D1.5: 2002 (5.12.1)**

Referenced PQR No(s): **PQR-FCAW-01-03**

Referenced FWST No(s): **N/A**

3. Material specification(s) **ASTM A709 Gr. 36, 50, 50W, 500 B Tube** For DOT Approval

4. Material Thickness (es) **Unlimited**

5. Welding process **FCAW**

6. Manual , machine , or semiautomatic

7. Position(s) of welding **1G**

8. Filler metal specification **AWS A5.20**

9. Filler metal class and brand name **E71T-1, Lincoln Outershield Elite**

10. Flux class & brand **N/A**, Type **N/A**

11. Shielding gas **100% CO2** Flow rate **45 CFH**

12. Single pass  Or multiple pass

13. Single arc  Or multiple arc

14. Welding Current **DCEP**

15. Polarity **Reverse**

16. Welding progression **Stringers**

17. Root treatment **Clean to bright sound metal or per AWS D1.5 (3.2.1 & 3.11)**


18. Postheat treatment **N/A**

19. Calculated Heat Input (KJ/in) Min **31.20 KJ/in** Max **50.72 KJ/in**

20. Electrode extension (electrical stickout) **3/4"**

TRAVIS  
RECEIVED  
JUN 21 2007  
RESUBMIT APPROVED  
BY DATE 7-23-07

Weld size (in)	Pass	Electrode Size (in)	Welding Process Variables		Travel Speed (IPM)
			AMPS/WFS*	VOLTS	
CJP	All	1/16"	260-310	26-30	11-13
DO NOT REMOVE BACKING FROM TUBE SPLICES					

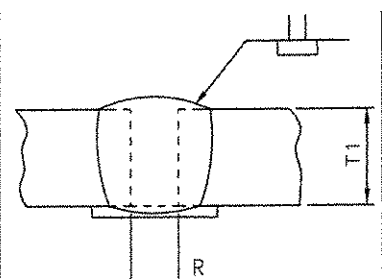

Notes:  
T<sub>1</sub> = 3/8" (10mm)  
MAX  
R = 1/8" (3mm)  
MIN T<sub>1</sub> MAX

Prepared By: <i>James R. Connor</i> DSB QA Manager	Preheat and Interpass Temperature Chart		
	Base Metal Thickness range	Minimum Preheat (°F)	Max Preheat & Interpass (°F)
Project: <b>Route No. TH 7/11, CL3</b>	≤ 3/4"	50°F	450°F
DSB Job: <b>20388-1206</b>	>3/4" to ≤1.5"	70°F	450°F
	>1.5" to ≤2.5"	150°F	450°F
	>2.5"	225°F	450°F

DSBROWN

**DSBROWN Production Joint Welding Procedure Specification (D1.5-02)**


Procedure No: **A-FPB-01** Date Issued: **8-14-06** Revision No: **0** Rev. Date: \_\_\_\_\_

Contractor (Fabricator) **D.S. Brown Company** Prepared by: **James R. Connor, Quality Assurance Manager**

1. Non-Fracture Critical  Fracture Critical  WPS Expiration Date: \_\_\_\_\_
2. Qualified in accordance with: **AWS D1.5-2002 (S.12.1)**  
 Referenced PQR No(s): **PQR-FCAW-01-03**  
 Referenced FWST No(s): **PQR-FCAW-FWST-01(03)**, **PQR-FCAW-FWST-01A(03)**
3. Material specification(s) **ASTM A709 Gr. 36, 50, 50W, A500b to CF1018, CF1040, A615 (Rebar)** For DOT Approval
4. Material Thickness (es) **Unlimited**
5. Welding process **FCAW**
6. Manual , machine , or semiautomatic
7. Position(s) of welding **1G,2G,1F,2F**
8. Filler metal specification **AWS A5.20**
9. Filler metal class and brand name **E71T-1 Lincoln Outershield Elite**
10. Flux class & brand **N/A**, Type **N/A**
11. Shielding gas **100% CO2** Flow rate **45 CFH**
12. Single pass  Or multiple pass
13. Single arc  Or multiple arc
14. Welding Current **DCEP**
15. Polarity **Reverse**
16. Welding progression **stringers**
17. Root treatment **Clean to bright sound metal or per AWS D1.5 (3.2.1 & 3.11)**
18. Postheat treatment **N/A**
19. Calculated Heat Input (KJ/in) Min **31.20 KJ/in** Max **50.72 KJ/in**
20. Electrode extension (electrical stickout) **3/4"**

TRAINS RECEIVED  
 JUN 21 2007  
 APPROVED BY: \_\_\_\_\_  
 DATE: **7-23-07**

Weld size (in)	Pass No(s)	Electrode Size (in)	Welding Process Variables		Travel Speed (IPM)
			AMPS/WFS*	VOLTS	
**1/4"	1	1/16"	260-310	26-30	11-13
5/16"	1	1/16"	260-310	26-30	11-13
3/8"	2-3	1/16"	260-310	26-30	11-13
7/16"	3-5	1/16"	260-310	26-30	11-13
1/2"	4-6	1/16"	260-310	26-30	11-13
5/8"	5-7	1/16"	260-310	26-30	11-13
3/4"	6-8	1/16"	260-310	26-30	11-13

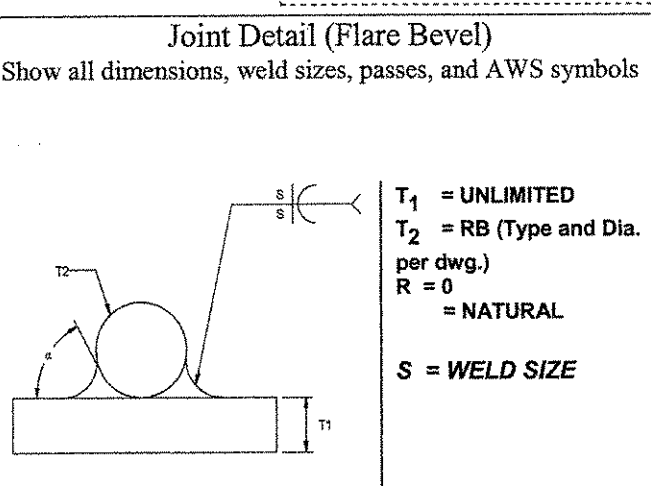

\* Wire feed speed may be used along with amperage (include chart)

Base Metal Thickness range	Preheat and Interpass Temperature Chart	
	Minimum Preheat (°F)	Max Preheat & Interpass (°F)
≤ 3/4"	50°F	450°F
>3/4" to ≤1.5"	70°F	450°F
>1.5" to ≤2.5"	150°F	450°F
>2.5"	225°F	450°F

Prepared By: **James R. Connor** DSB QA Manager  
 Project: **Route No. TH 7/11, CL3**  
 DSB Job: **20388-1206**

Note: When this procedure is used for A709Gr50W materials, it shall be limited to 5/16" single pass or material be coated.

078-BRWTF

**DSBROWN Production Joint Welding Procedure Specification (D1.5-02)**

Procedure No: A-FSB-13 Date Issued: 12-11-03 Revision No: 0 Rev. Date: \_\_\_\_\_

Contractor (Fabricator) D. S. Brown Company Prepared by: James R. Connor, Quality Assurance Manager

1. Non-Fracture Critical  Fracture Critical  WPS Expiration Date: \_\_\_\_\_

2. Qualified in accordance with: AWS D1.5-2002 (5.12.1)

Referenced PQR No(s): PQR-FCAW-01-03

Referenced FWST No(s): PQR-FCAW-FWST-01(03), PQR-FCAW-FWST-01A(03)

3. Material specification(s) Gr. 36, 50, 50W, ASTM A500B For DOT Approval

4. Material Thickness (es) Unlimited

5. Welding process FCAW

6. Manual , machine , or semiautomatic

7. Position(s) of welding 1G, 2G, 1F, 2F

8. Filler metal specification AWS A5.20

9. Filler metal class and brand name E71T-1 (Lincoln Outershield Elite)

10. Flux class & brand N/A, Type N/A

11. Shielding gas 100% CO2 Flow rate 45 CFH

12. Single pass  Or multiple pass

13. Single arc  Or multiple arc

14. Welding Current DCEP

15. Polarity Reverse

16. Welding progression Stringers

17. Root treatment Clean to bright sound metal or per AWS D1.5 (3.2.1 & 3.11)

18. Postheat treatment N/A

19. Calculated Heat Input (KJ/in) Min 31.20 KJ/in Max 50.72 KJ/in

20. Electrode extension (electrical stickout) 3/4"

Weld Size (EAS)	Weld Pass	Electrode Size (in)	Welding Process Variables		Travel Speed (ft/min)	Travel	
			AMPS/WFS*	VOLTS			
							Joint Detail (TC-P4-GF)
1/4"	1	1/16"	260-310	26-30	11-13		
5/16"	1	1/16"	260-310	26-30	11-13		
3/8"	2-3	1/16"	260-310	26-30	11-13		
1/2"	3-4	1/16"	260-310	26-30	11-13		
5/8"	4-6	1/16"	260-310	26-30	11-13		
3/4"	5-7	1/16"	260-310	26-30	11-13		
7/8"	6-8	1/16"	260-310	26-30	11-13		
1"	7-9	1/16"	260-310	26-30	11-13		
* Wire feed speed may be used along with amperage (include chart)							
Preheat and Interpass Temperature Chart							

Prepared By: James R. Connor DSB QA Manager

Project: Route No. TH 7/11, CL3

DSB Job: 20388-1206

Note: When this procedure is used for A709Gr50W materials, it shall be limited to 5/16" single pass or material be coated.


VITRANS RECEIVED  
JUN 21 2007  
APPROVED  
DATE 7-23-07

079-BRW P

**Production Joint Welding Procedure Specification (D1.5-02)**

Procedure No: A-(MC)CSB-01 Date Issued: 9-28-04 Revision No: 0 Rev. Date: \_\_\_\_\_  
 Contractor (Fabricator) D. S. Brown Company Prepared by: James R. Connor, Quality Assurance Manager  
 1. Non-Fracture Critical  Fracture Critical  WPS Expiration Date: \_\_\_\_\_  
 2. Qualified in accordance with: AWS D1.5-2002 (5.12.1)  
 Referenced PQR No(s): PQR-(MC)GMAW-01(04)  
 Referenced FWST No(s): PQR-(MC)GMAW-FWST-01A(04), PQR-(MC)GMAW-FWST-01B(04)  
 3. Material specification(s) ASTM A709 Gr. 36, 50, 50W For DOT Approval  
 4. Material Thickness (es) Unlimited  
 5. Welding process GMAW  
 6. Manual , machine , or semiautomatic   
 7. Position(s) of welding 1G, 2G, 1F, 2F  
 8. Filler metal specification AWS A5.18  
 9. Filler metal class and brand name E70C-6M Corex Metal-Core Maxim OK'D BY: \_\_\_\_\_ OK'D BY: JW  
 10. Flux class & brand N/A, Type N/A  
 11. Shielding gas 75% Ar / 25% CO2 Flow rate 45 CFH AUG 14 2007  
 12. Single pass  Or multiple pass  RESUBMIT \_\_\_\_\_ APPROVED \_\_\_\_\_  
 13. Single arc  Or multiple arc  BY \_\_\_\_\_ DATE 8-15-07  
 14. Welding Current DCEP  
 15. Polarity Reverse  
 16. Welding progression stringers  
 17. Root treatment Clean to bright sound metal or per AWS D1.5 (3.2.1 & 3.11)  
 18. Postheat treatment N/A  
 19. Calculated Heat Input (KJ/in) Min 30.6 KJ/in Max 51.1 KJ/in  
 20. Electrode extension (electrical stickout) 3/8"

Welding Process Variables	Welding Process Variables			Joint Detail (TC-P4-GF)		
	AMPS/WFS*	VOLTS	(inches) (mm)	Welding Process	Welding Process	Welding Process
1/4"	1	.052"	265-320	31-34.5	13-16	
5/16"	1	.052"	265-320	31-34.5	13-16	
3/8"	1-2	.052"	265-320	31-34.5	13-16	
1/2"	3-4	.052"	265-320	31-34.5	13-16	
5/8"	4-6	.052"	265-320	31-34.5	13-16	
3/4"	5-7	.052"	265-320	31-34.5	13-16	
7/8"	6-9	.052"	265-320	31-34.5	13-16	
1"	7-10	.052"	265-320	31-34.5	13-16	

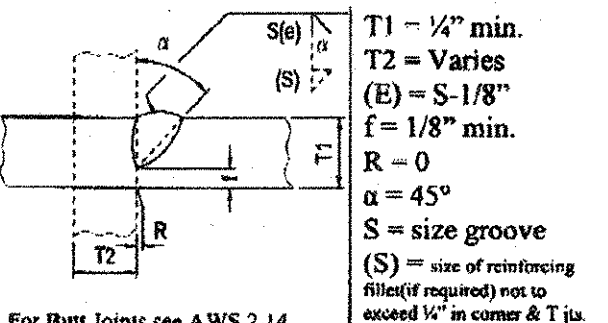

\* Wire feed speed may be used along with amperage (include chart)  
 Prepared By: James R. Connor DSB QA Manager

Base Metal Thickness range	Preheat and Interpass Temperature Chart	
	Minimum Preheat (°F)	Max. Preheat & Interpass (°F)
≤ 3/4"	50°F	450°F
>3/4" to ≤1.5"	70°F	450°F
>1.5" to ≤2.5"	150°F	450°F
>2.5"	225°F	450°F

Project: \_\_\_\_\_  
 DSB Job: 20388-1206  
 Note: When this procedure is used for A709Gr50W materials, it shall be limited to 5/16" single pass or material be coated.


DSB-BRW

**DSBROWN Production Joint Welding Procedure Specification (D1.5-02)**

Procedure No: A-FSB-01 Date Issued: 8-12-03 Revision No: 0 Rev. Date: \_\_\_\_\_  
 Contractor (Fabricator): D. S. Brown Company Prepared by: James R. Connor, Quality Assurance Manager  
 1. Non-Fracture Critical  Fracture Critical  WPS Expiration Date: \_\_\_\_\_  
 2. Qualified in accordance with: AWS D1.5:2002 (S.12.1)  
 Referenced PQR No(s): PQR-PCAW-01-03  
 Referenced FWST No(s): PQR-PCAW-FWST-01(03), PQR-PCAW-FWST-01A(03)  
 3. Material specification(s): ASTM A709 Gr. 36, 50, 50W For DOT Approval  
 4. Material Thickness (es): Unlimited  
 5. Welding process: FCAW  
 6. Manual , machine , or semiautomatic   
 7. Position(s) of welding: 1G, 2G, (1F, 2F)  
 8. Filler metal specification: AWS A5.20  
 9. Filler metal class and brand name: E71T-1, E71T-9 Lincoln Outershield Elite  
 10. Flux class & brand: N/A, Type: N/A  
 11. Shielding gas: 100% CO2 Flow rate: 45 CFH  
 12. Single pass  Or multiple pass   
 13. Single arc  Or multiple arc   
 14. Welding Current: DCEP  
 15. Polarity: Reverse  
 16. Welding progression: Stringers  
 17. Root treatment: Clean to bright sound metal per AWS D1.5 (3.2.1 & 3.11)  
 18. Postheat treatment: N/A  
 19. Calculated Heat Input (KJ/in) Min: 31.20 KJ/in Max: 50.72 KJ/in  
 20. Electrode extension (electrical stickout): 3/4"

VTRANS RECEIVED  
 OK'D BY: \_\_\_\_\_ OK'D BY: \_\_\_\_\_  
 AUG 14 2007  
 RESUBMIT \_\_\_\_\_ APPROVED \_\_\_\_\_  
 BY: \_\_\_\_\_ DATE: 8/14/07

Weld Size (in) (E)(A)(S)	Tack	Electrode Size (in) (N)(S)	Welding Process Variables		Travel Speed (IPM)	Travel Distance (in)
			AMPS/WFS*	VOLTS		
1/4"	1	1/16"	260-310	26-30	11-13	
5/16"	1	1/16"	260-310	26-30	11-13	
3/8"	2-3	1/16"	260-310	26-30	11-13	
1/2"	3-4	1/16"	260-310	26-30	11-13	
5/8"	4-6	1/16"	260-310	26-30	11-13	
3/4"	5-7	1/16"	260-310	26-30	11-13	
7/8"	6-8	1/16"	260-310	26-30	11-13	
1"	7-9	1/16"	260-310	26-30	11-13	

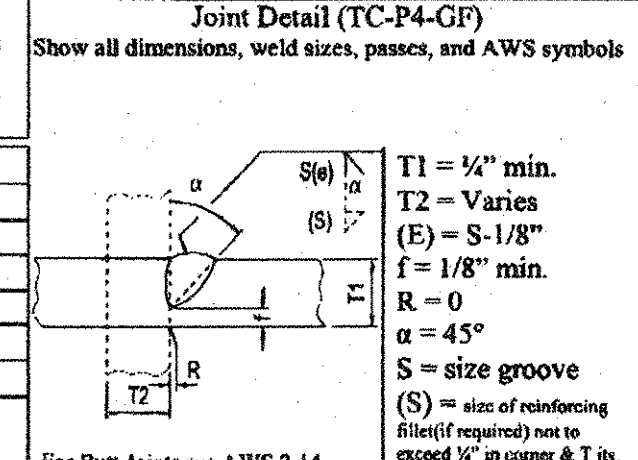


\* Wire feed speed may be used along with amperage (include chart)

Base Metal Thickness range	Preheat and Interpass Temperature Chart	
	Minimum Preheat (°F)	Max Preheat & Interpass (°F)
≤ 3/4"	50°F	450°F
>3/4" to ≤1.5"	70°F	450°F
>1.5" to ≤2.5"	150°F	450°F
>2.5"	225°F	450°F


Prepared By: James R. Connor DSB QA Manager  
 Project: \_\_\_\_\_  
 DSR Job: 20388-1206

Note: When this procedure is used for A709Gr50W materials, it shall be limited to 5/16" single pass or material be coated.


057-BLWP

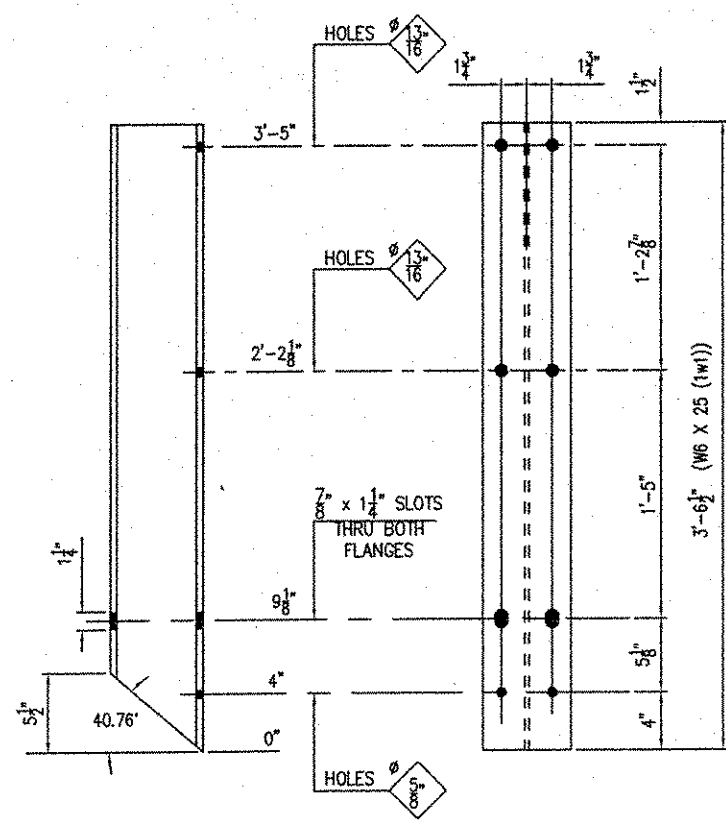


32 - SIDERAIL POSTS - 1A

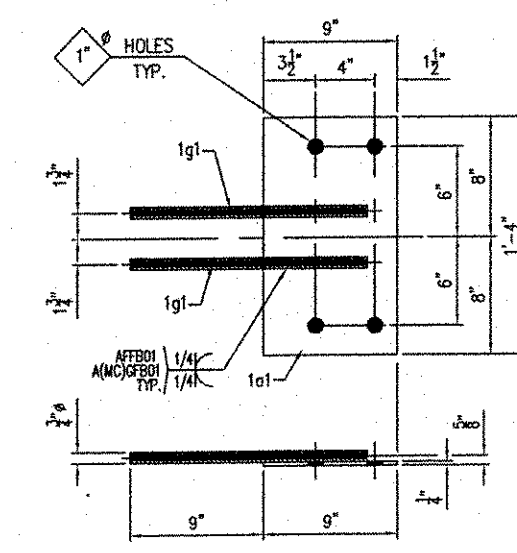


32 - ANCHORS - 1B

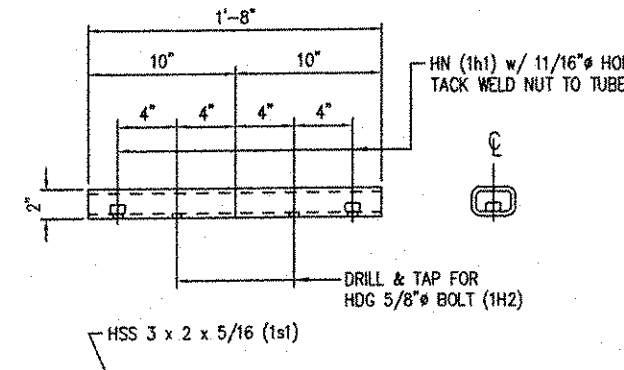

36 - INSERTS - 1H

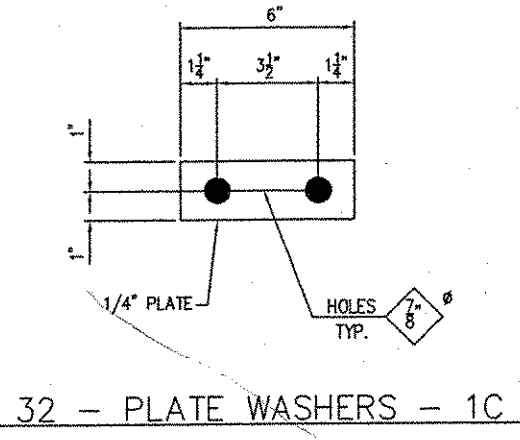

32 - PLATE WASHERS - 1C

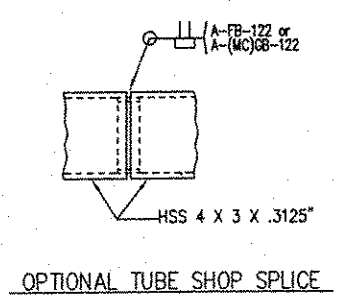

OPTIONAL TUBE SHOP SPLICE

GENERAL NOTES:

- 1.) MATERIALS AND WORKMANSHIP SHALL BE IN ACCORDANCE WITH THE STATE OF VERMONT AGENCY OF TRANSPORTATION "STANDARD SPECIFICATIONS FOR CONSTRUCTION, DATED 2000" AS AMENDED BY THE LATEST REVISIONS, THE AASHTO STANDARD SPECIFICATIONS FOR HIGHWAY CONSTRUCTION, SEVENTEENTH EDITION.
- 2.) FABRICATION SHALL BE PERFORMED IN ACCORDANCE WITH AASHTO STANDARD SPECIFICATIONS FOR HIGHWAY CONSTRUCTION, AND/AASHTO/AASHTO/MS DLS AND THE CURRENT INTERIM SPECIFICATIONS AS MODIFIED BY VIRIANS SPEC. 506.03.
- 3.) RAILING MATERIALS SHALL BE ASTM A709 OR 50, UNLESS NOTED OTHERWISE. PER VIRIANS SPECIFICATION 732.03(4), (W6 X 25 POSTS SHALL BE C/W TESTED PER 25 FT. LBS. @ 40°F)
  - HOLLOW STRUCTURAL SHAPES TO CONFORM WITH ASTM A500, GRADE B IN ACCORDANCE WITH VIRIANS SPECIFICATION 732.03(4), (HSS SHALL BE C/W TESTED PER 15 FT. LBS. @ 40°F).
  - PIPE SHALL BE ASTM A53, GRADE B.
  - HARDWARE TO BE IN ACCORDANCE WITH ASTM F568M, CLASS 4.6 (ASTM A307), UNLQ.
  - HIGH STRENGTH HARDWARE SHALL BE IN ACCORDANCE WITH AASHTO M184 TYPE 1 (ASTM A325 OR ASTM A440) AND SHALL BE SUPPLIED IN ACCORDANCE TO VIRIANS SPEC. 714.05, WHICH INCLUDES PROOF, PROOF AND WEDGE TESTING.
  - THREADED ROD FOR POST ANCHORAGE SHALL CONFORM TO ASTM F 1554 GRADE 55 "MILDABLE STEEL".
- 4.) ALL HARDWARE SHALL BE GALVANIZED IN ACCORDANCE WITH AASHTO M-232 (ASTM A-153).
- 5.) RAILING COMPONENTS SHALL BE GALVANIZED IN ACCORDANCE WITH AASHTO M-111 (ASTM A153), UNLESS NOTED OTHERWISE. FINISH ALL EDGES 1/4" AND BLAST CLEAN PER SSPC-SP-8 PRIOR TO GALVANIZING AND REPAIR GALVANIZING PER ASTM A780.
- 6.) FABRICATION SHALL TAKE PLACE IN A FACILITY WITH A MINIMUM AWS CATEGORY III CERTIFICATION OR BE APPROVED BY VIRIANS. NON-CERTIFIED FACILITIES MUST SATISFY THE REQUIREMENTS OF VIRIANS SPEC. 506.03.

THE CONTRACTOR SHALL VERIFY ALL DIMENSIONS PRIOR TO FABRICATION TO ENSURE ACCURACY OF DESIGN PLANS. STAMPED APPROVED DRAWINGS ASSUME DIMENSIONS HAVE BEEN VERIFIED BY CONTRACTOR.

NO.	QTY.	DESCRIPTION	MATERIAL	LENGTH	REMARKS	PART NO.
1A	1	SIDERAIL POSTS		15'-4 1/2"		
1B	2	ANCHORS		1 1/2"		
1C	32	PLATE WASHERS		1 1/2"		
1D	36	INSERTS		1 1/2"		
1E	1	OPTIONAL TUBE SHOP SPLICE		1 1/2"		
1F	1	OPTIONAL TUBE SHOP SPLICE		1 1/2"		
RECEIVED  
 CK'D BY ELR CK'D BY R14  
 AUG 07 2007  
 RESUBMIT  APPROVED   
 BY CPW DATE 8/1/07

NO.	DESCRIPTION	DATE	BY	QTY.
1	PER APPROVAL	7/20/07	EB	1
2	REV. DESCRIPTION		DET.	0.00

LOCATION - TOWNS OF NEW HAVEN & WETHERS  
 BRIDGE - 28  
 PROJECT - ROUTE NO. 107/71, CLS  
 F.A.P. NO. - BHO-2006(1)  
 P.O. NO. -  
 DESIGNER - VERMONT DEPARTMENT OF TRANSPORTATION  
 CUSTOMER - CONTRACTORS CRANE SERVICE, LLC

POST DETAILS & GENERAL NOTES  
 ADDISON COUNTY, VT  
 20388 1206  
 002-68



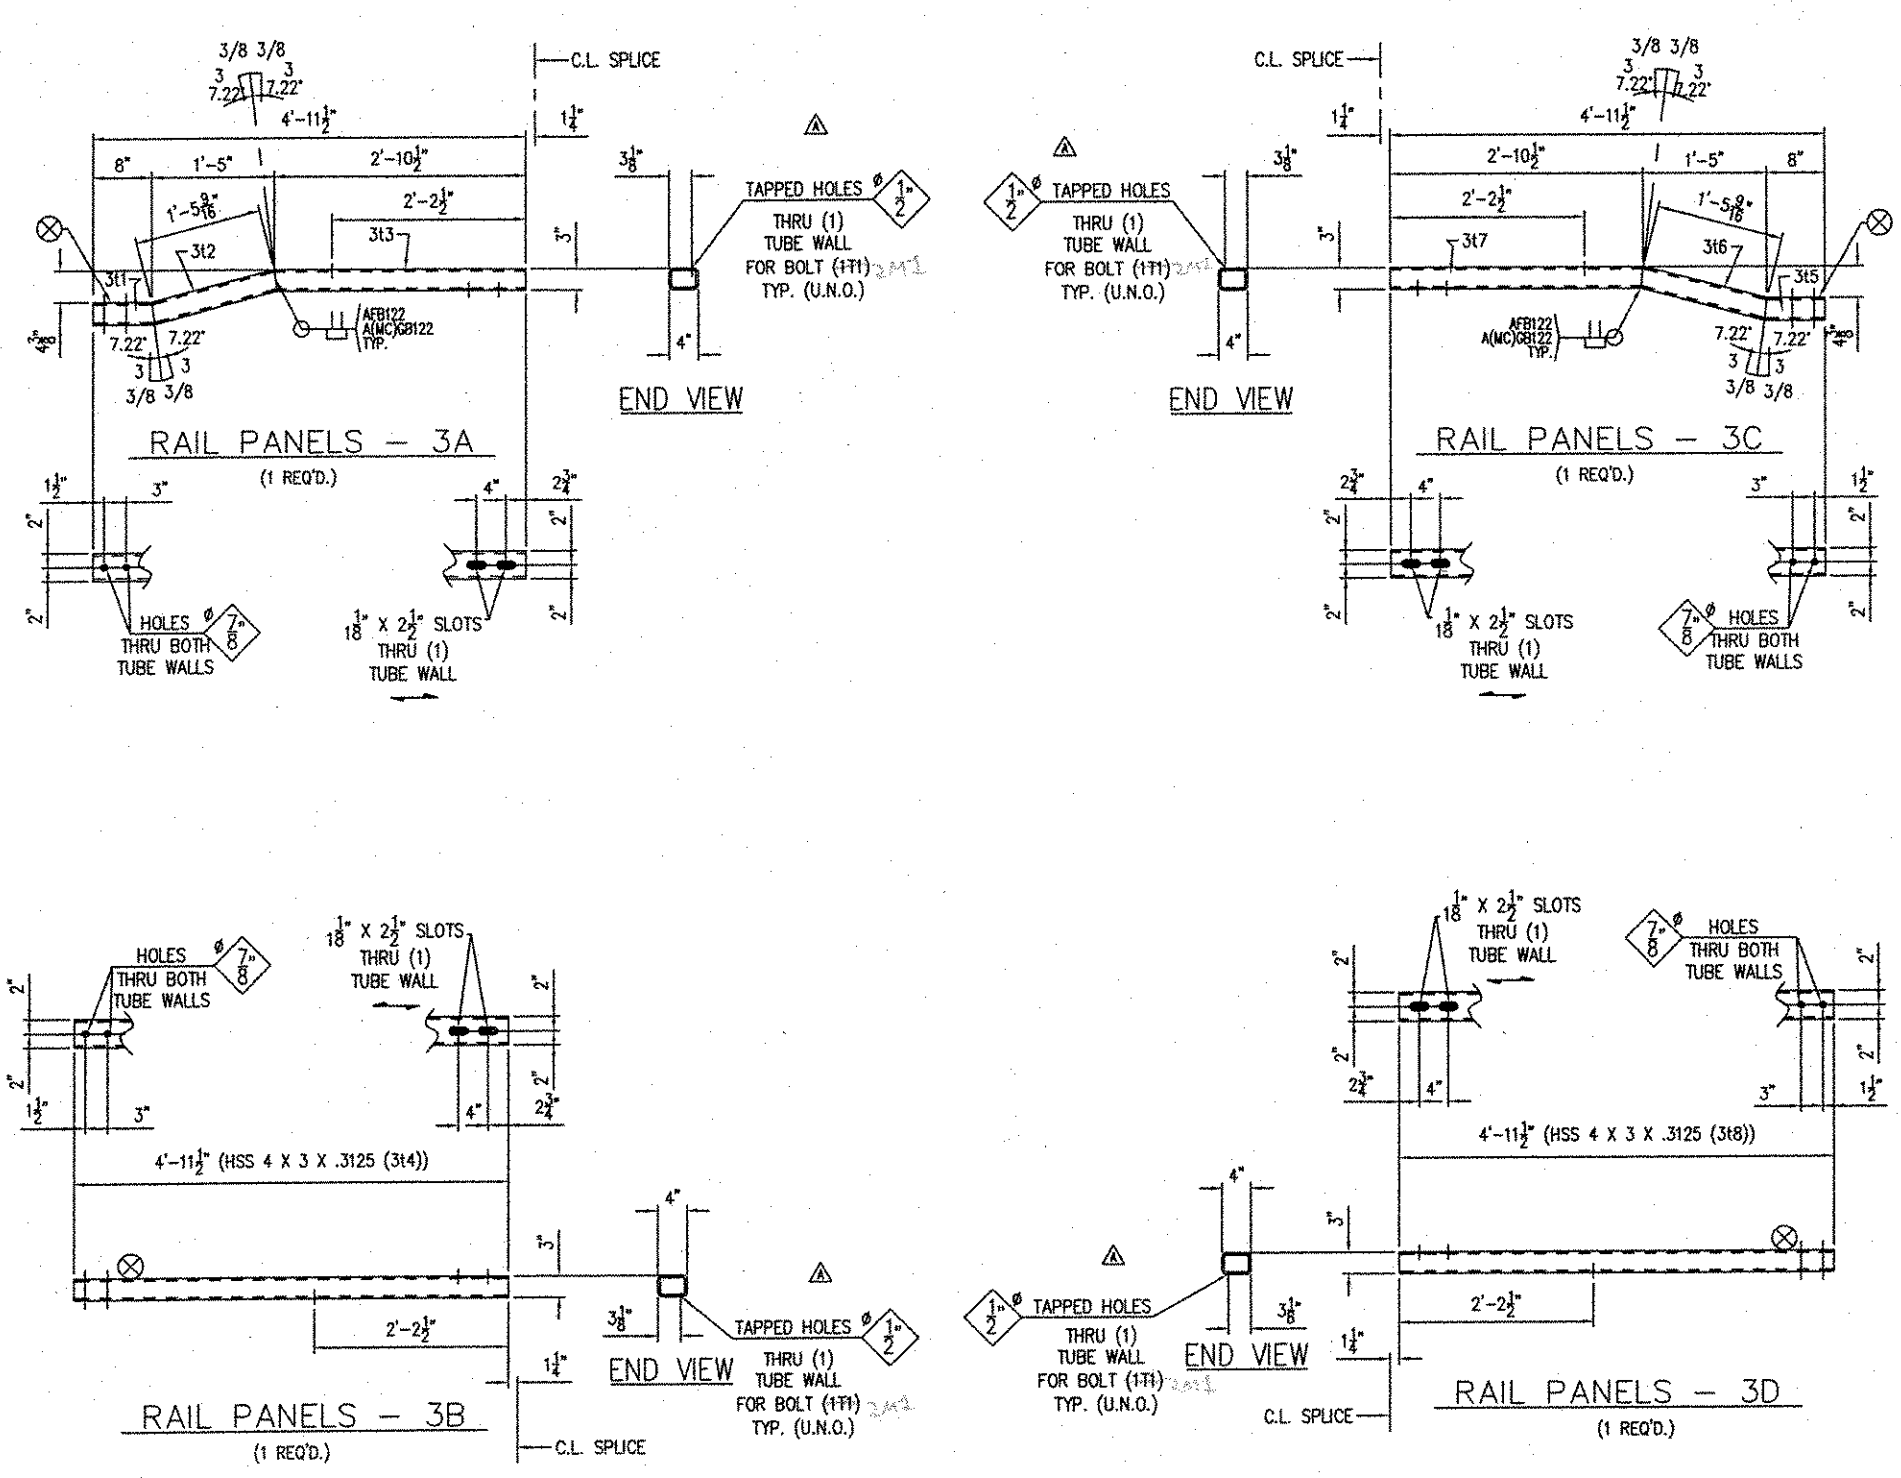

NO.	QTY.	DESCRIPTION	MATERIAL	LENGTH	REMARKS	PART NO.
3A	1	RAIL PANEL		4'-11 1/2"		
3B1	1	SSS 4 X 3 X 5/8	A500 GR B	0'-8 3/8	SHARP CUT A123-H02C CH	
3B2	1	SSS 4 X 3 X 5/8	A500 GR B	1'-4 1/8	SHARP CUT A123-H02C CH	
3B3	1	SSS 4 X 3 X 5/8	A500 GR B	2'-0 1/2	SHARP CUT A123-H02C CH	
3C	1	RAIL PANEL		4'-11 1/2"		
3C4	1	SSS 4 X 3 X 5/8	A500 GR B	4'-11 1/2	A123-H02C CH	
3D	1	RAIL PANEL		4'-11 1/2"		
3D1	1	SSS 4 X 3 X 5/8	A500 GR B	0'-8 3/8	SHARP CUT A123-H02C CH	
3D2	1	SSS 4 X 3 X 5/8	A500 GR B	1'-4 1/8	SHARP CUT A123-H02C CH	
3D3	1	SSS 4 X 3 X 5/8	A500 GR B	2'-0 1/2	SHARP CUT A123-H02C CH	
3D4	1	RAIL PANEL		4'-11 1/2"		
3D5	1	SSS 4 X 3 X 5/8	A500 GR B	4'-11 1/2	A123-H02C CH	

NOTE: ALL MATERIAL SPECIFICATIONS DESCRIBED ARE ASTM UNLESS OTHERWISE NOTED.

**RECEIVED**  
 CK'D BY ELK OK'D BY RSK  
 AUG 07 2007  
 RESUBMIT APPROVED AS NOTED  
 BY CPW DATE 8/16/07

- SEE SHEET NO. 1 FOR GENERAL NOTES -

APPROVAL	DATE	DESCRIPTION
	7/20/07	REVISE THE
	1 DAY	SET 1, 2, 3

LOCATION	ITEM	QUANTITY
LOCATION - TOWNS OF NEW HAVEN & METERIDGE		
BRIDGE - 26		
PROJECT - ROUTE NO. 107/71, CL3		
F.A.P. NO. - 890-87M 2005(1)		
P.O. NO. -		
DESIGNER - VERMONT DEPARTMENT OF TRANSPORTATION		
CUSTOMER - CONTRACTORS CRANE SERVICE, LLC		

RAIL PANEL DETAILS  
 ADDISON COUNTY, VT  
 20388 1206 03


SHIP NOTE:  
 ○ - INDICATES LOCATION OF SHIPPING PECE MARK

084-32






QTY.	MK.	DESCRIPTION	MATERIAL	LENGTH	REMARKS	PART NO.
EA	12	RAIL PANEL		18'-5 1/4"		
BOLT	12	HSS 4 X 3 X 5/8	A500 GR. B	18'-5 1/4"	1423-185, CN	
BOLT	12	HSS 4 X 3 X 5/8	A500 GR. B	18'-5 1/4"	1423-185, CN	

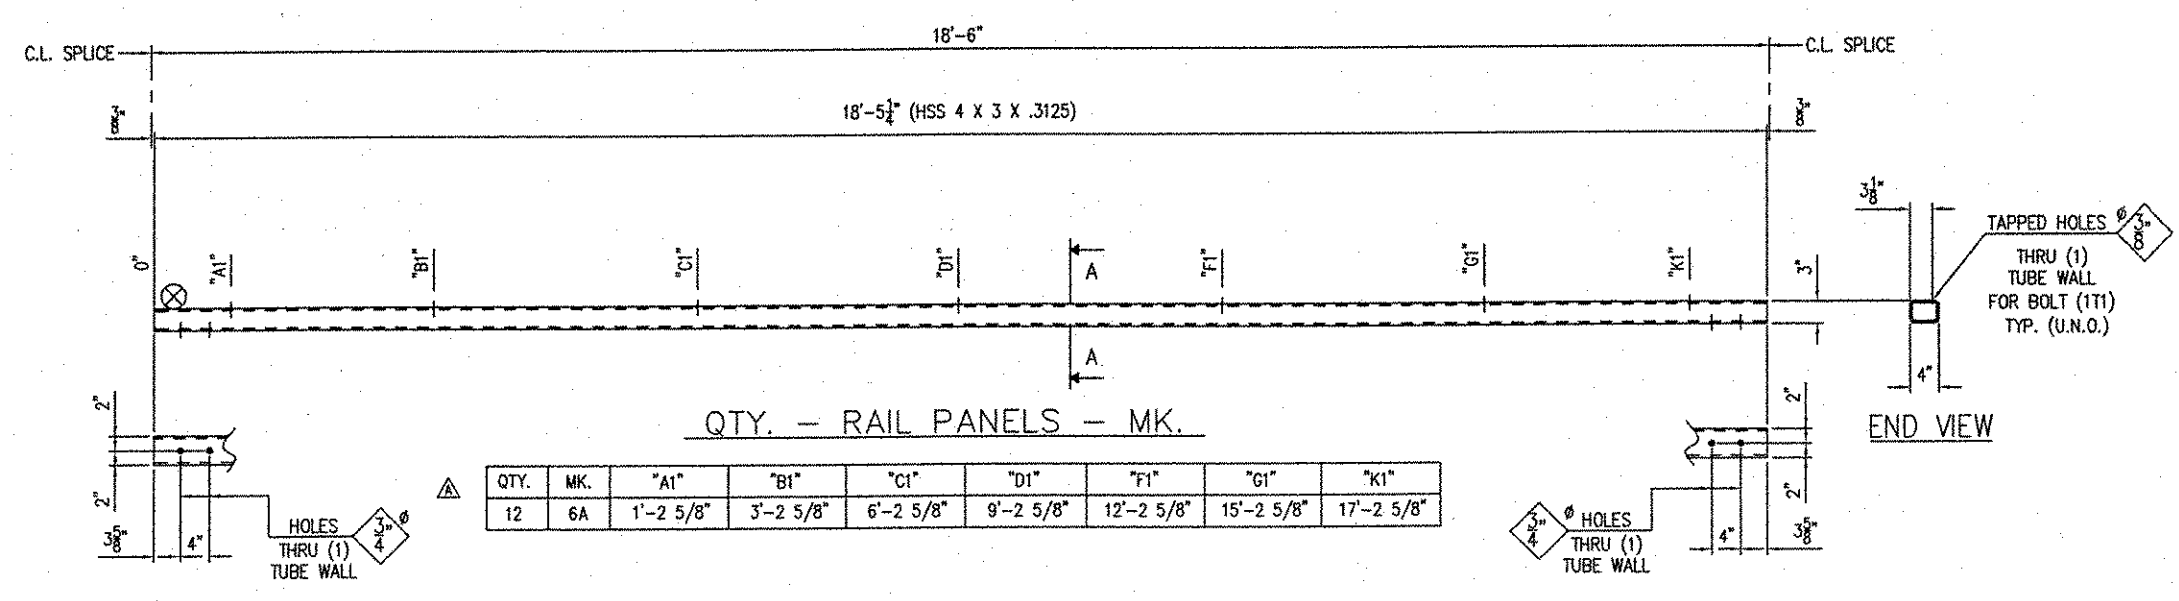

QTY. - RAIL PANELS - MK.

QTY.	MK.	"A1"	"B1"	"C1"	"D1"	"E1"	"F1"	"G1"	"H1"
12	6A	1'-2 5/8"	3'-2 5/8"	6'-2 5/8"	9'-2 5/8"	12'-2 5/8"	15'-2 5/8"	17'-2 5/8"	

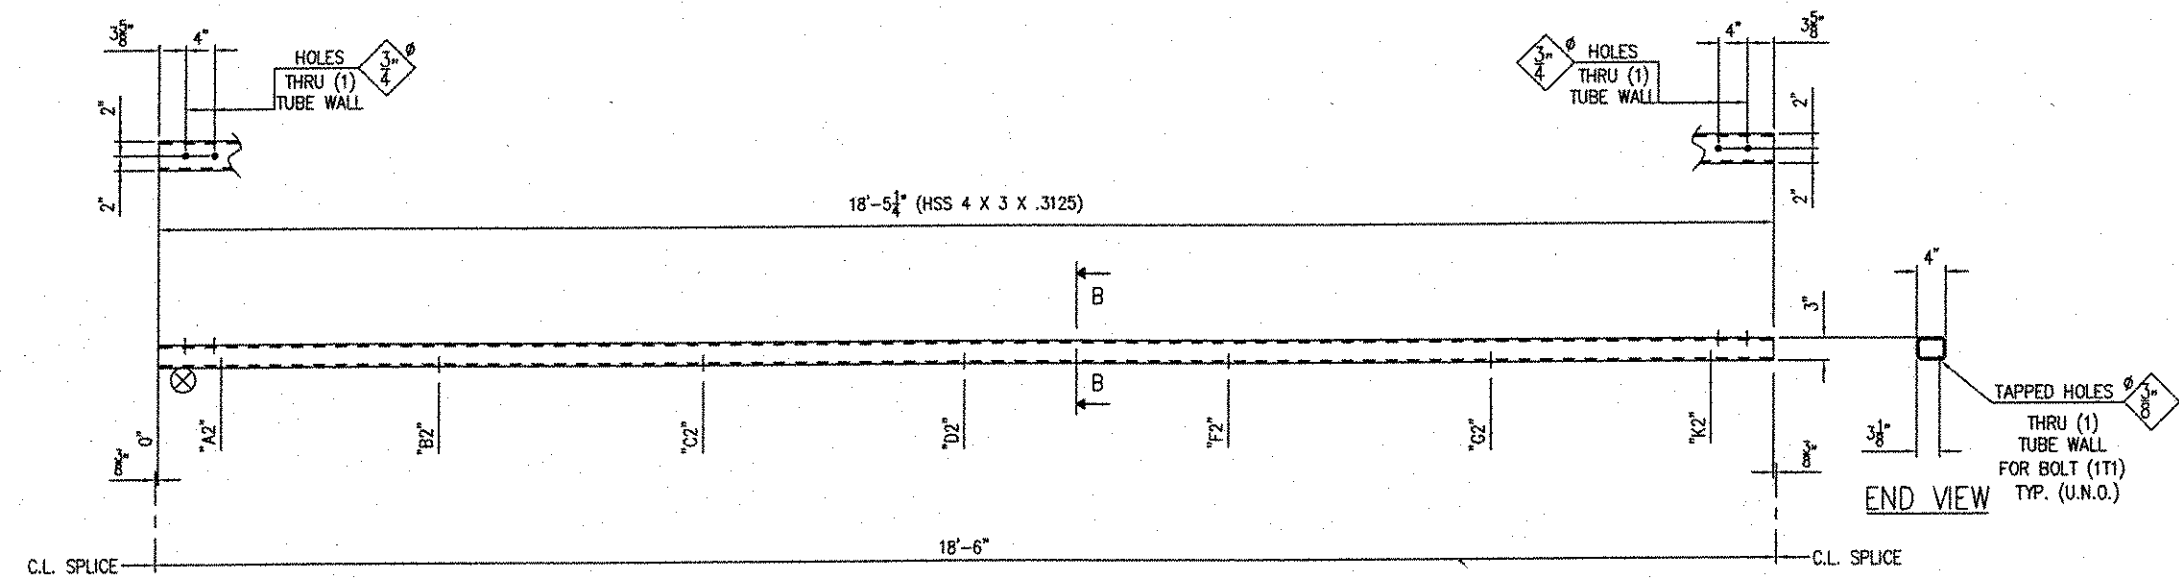

QTY. - RAIL PANELS - MK.

QTY.	MK.	"A2"	"B2"	"C2"	"D2"	"E2"	"F2"	"G2"	"H2"
12	6B	1'-2 5/8"	3'-2 5/8"	6'-2 5/8"	9'-2 5/8"	12'-2 5/8"	15'-2 5/8"	17'-2 5/8"	

RECEIVED  
 CK'D BY ELR OK'D BY RSJ  
 AUG 07 2007  
 RESUBMIT \_\_\_\_\_ APPROVED \_\_\_\_\_  
 BY CPW DATE 8/17/07

- SEE SHEET NO. 1 FOR GENERAL NOTES



**D.S. BIRCHWIN**  
 INC. 65 BIRCHWIN COMPANY  
 2000 BIRCHWIN DRIVE  
 HARTLAND, VT 05743  
 FAX 802-245-1022  
 WWW.DSBIRCHWIN.COM

LOCATION - TOWNS OF NEW HAVEN & WEBSTER  
 BRIDGE - 26  
 PROJECT - ROUTE NO. 107/71, CL3  
 P.A.P. NO. - BR0-07M 2005(1)  
 P.O. NO. -  
 DESIGNER - VERMONT DEPARTMENT OF TRANSPORTATION  
 CUSTOMER - CONTRACTORS CRANE SERVICE, LLC

DATE: 12/06/07  
 TIME: 12:06  
 SHEET: 1 OF 06  
 PROJECT: 20388

SHOP NOTE  
 @ - INDICATES LOCATION  
 OF SHIPPING PECK MARK

DBP-BR

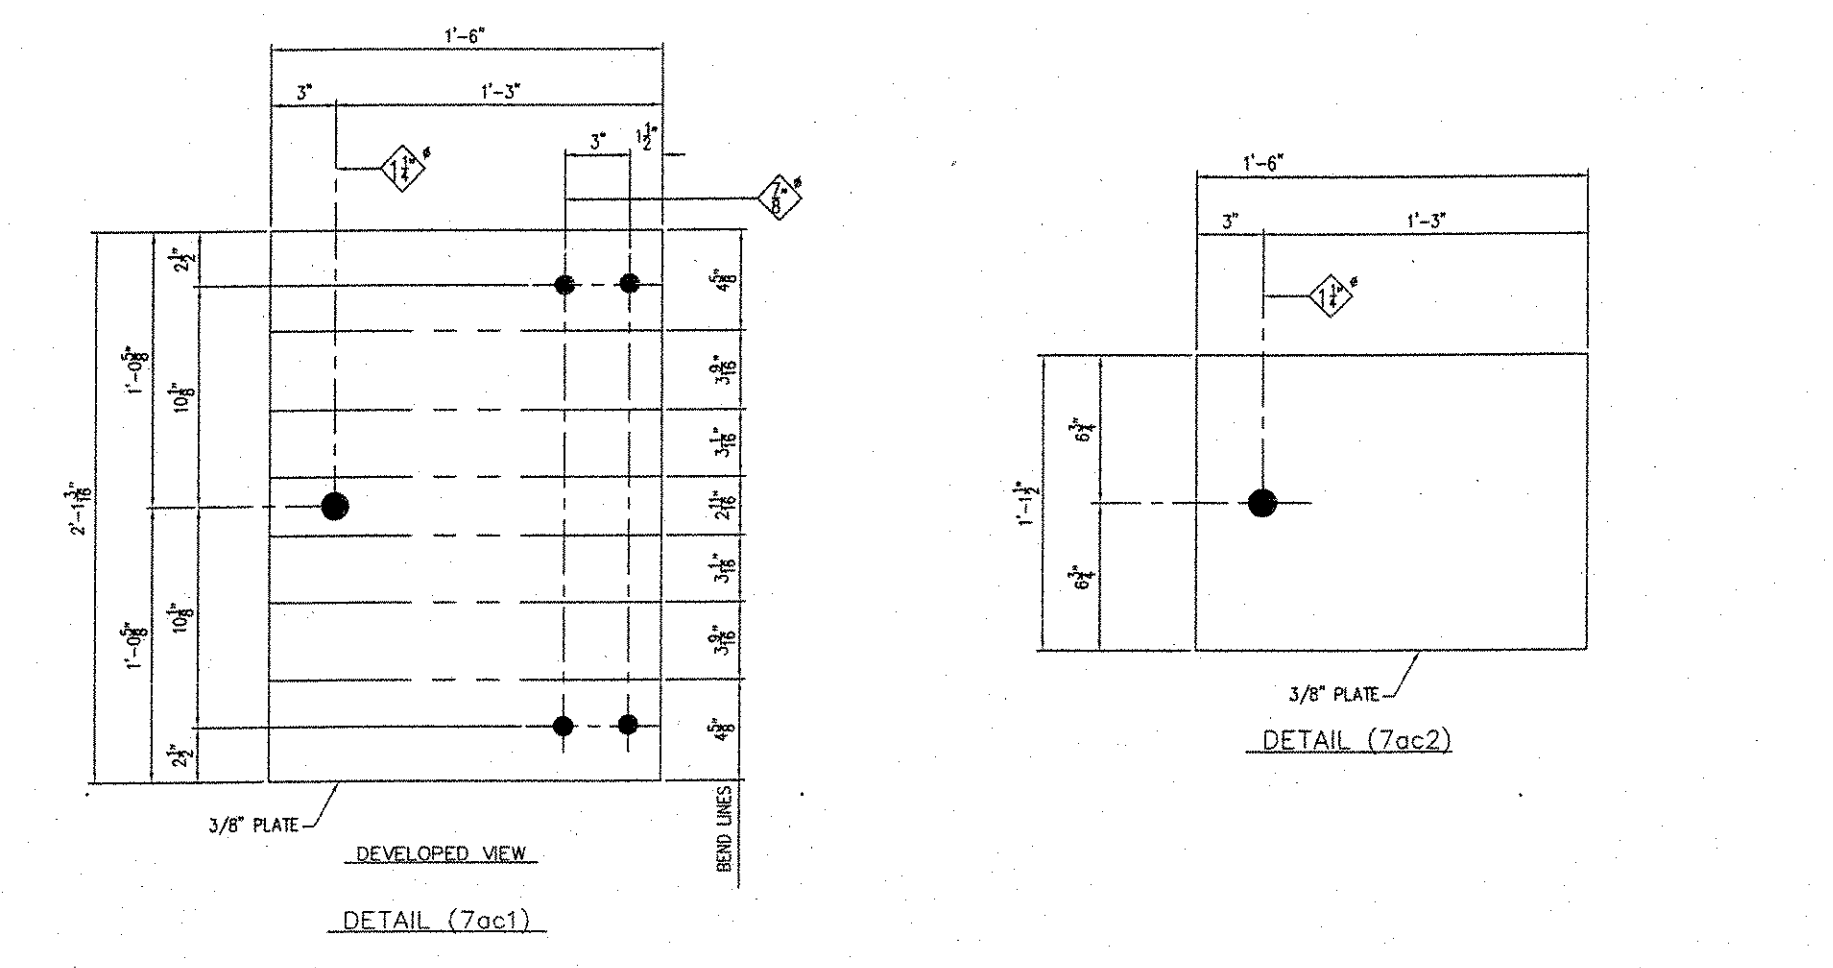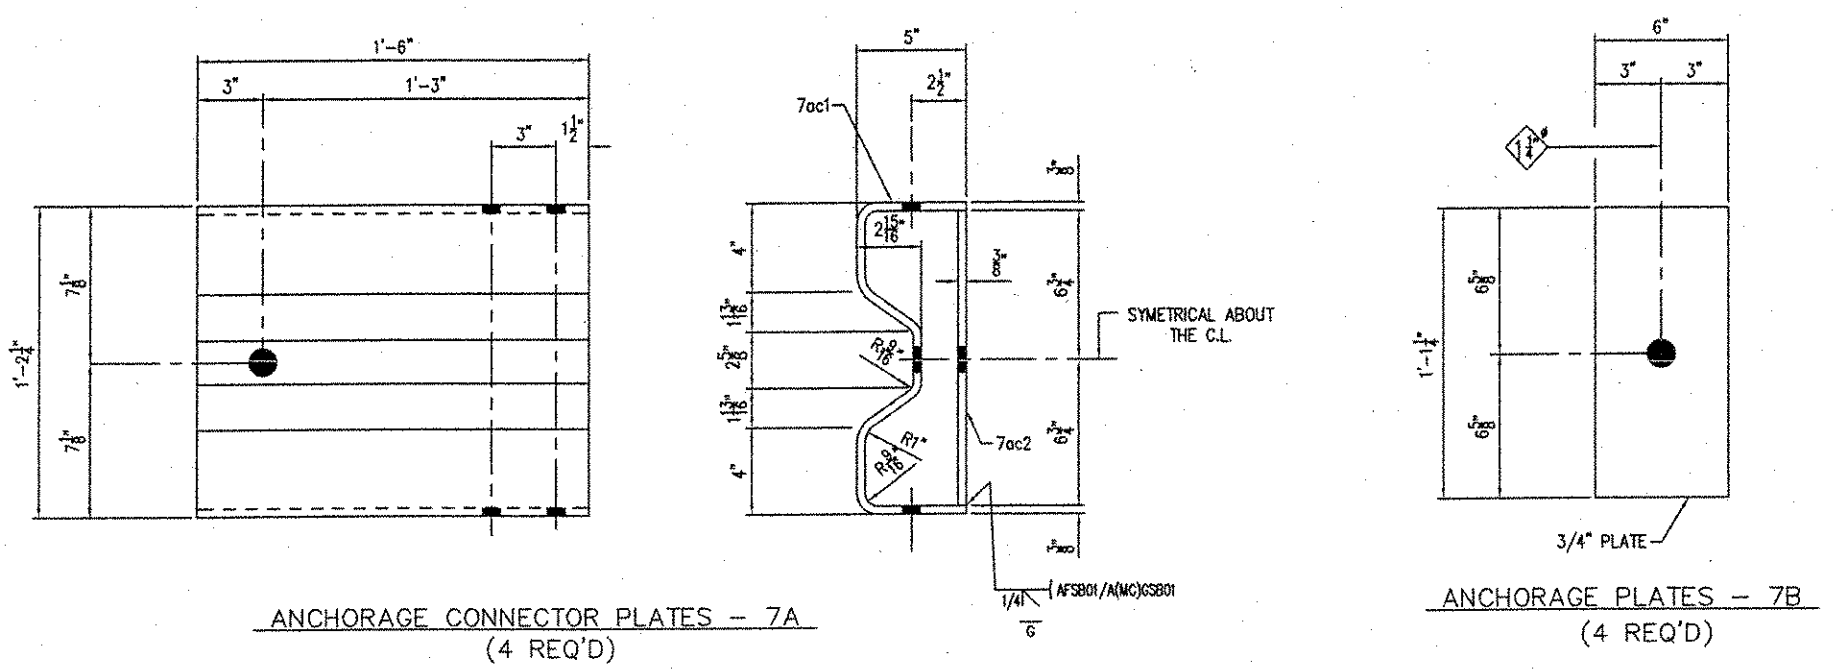

NO.	QTY.	DESCRIPTION	MATERIAL	LENGTH	REMARKS	PART NO.
7A	4	ANCHORAGE CONNECTOR PLATES	A36	1'-3"	BRND. 4133-HRS	
7Ac1	4	1/2" X 1/2"	A36	1'-6"	BRND. 4133-HRS	
7Ac2	4	1/2" X 1/2"	A36	1'-6"	BRND. 4133-HRS	
7B	4	ANCHORAGE PLATES	A36	1'-1 1/4"	BRND. 4133-HRS	
7B1	4	1/4" X 6"	A36	1'-1 1/4"	BRND. 4133-HRS	
7C	25	FIELD BOLTS	A325		(US) A153-HRS, HRCAP	
7C1	25	1/4" HEX HEAD CAP SCREW	A325		(US) A153-HRS, HRCAP	
7C2	25	1/4" HEX NUT	A325		(US) A153-HRS, HRCAP	
7D	25	FIELD BOLTS	A325		(US) A153-HRS, HRCAP	
7D1	25	1/4" HEX HEAD CAP SCREW	A325		(US) A153-HRS, HRCAP	
7D2	25	1/4" HEX NUT	A325		(US) A153-HRS, HRCAP	
7E	25	FIELD BOLTS	A325		(US) A153-HRS, HRCAP	
7E1	25	1/4" HEX HEAD CAP SCREW	A325		(US) A153-HRS, HRCAP	
7E2	25	1/4" HEX NUT	A325		(US) A153-HRS, HRCAP	
7F	25	FIELD BOLTS	A325		(US) A153-HRS, HRCAP	
7F1	25	1/4" HEX HEAD CAP SCREW	A325		(US) A153-HRS, HRCAP	
7F2	25	1/4" HEX NUT	A325		(US) A153-HRS, HRCAP	
7G	25	FIELD BOLTS	A325		(US) A153-HRS, HRCAP	
7G1	25	1/4" HEX HEAD CAP SCREW	A325		(US) A153-HRS, HRCAP	
7G2	25	1/4" HEX NUT	A325		(US) A153-HRS, HRCAP	
7H	25	FIELD BOLTS	A325		(US) A153-HRS, HRCAP	
7H1	25	1/4" HEX HEAD CAP SCREW	A325		(US) A153-HRS, HRCAP	
7H2	25	1/4" HEX NUT	A325		(US) A153-HRS, HRCAP	
7I	25	FIELD BOLTS	A325		(US) A153-HRS, HRCAP	
7I1	25	1/4" HEX HEAD CAP SCREW	A325		(US) A153-HRS, HRCAP	
7I2	25	1/4" HEX NUT	A325		(US) A153-HRS, HRCAP	

NOTE: ALL MATERIAL SPECIFICATION DESCRIPTIONS ARE ASTM UNLESS OTHERWISE NOTED.

RECEIVED  
 CK'D BY ELP OK'D BY RY  
 AUG 07 2007  
 RESUBMIT        APPROVED      
 BY CPW DATE 8/17/07

SEE SHEET NO. 1 FOR GENERAL NOTES


NO.	QTY.	DESCRIPTION	MATERIAL	LENGTH	REMARKS	PART NO.
7A	4	ANCHORAGE CONNECTOR PLATES	A36	1'-3"	BRND. 4133-HRS	
7Ac1	4	1/2" X 1/2"	A36	1'-6"	BRND. 4133-HRS	
7Ac2	4	1/2" X 1/2"	A36	1'-6"	BRND. 4133-HRS	
7B	4	ANCHORAGE PLATES	A36	1'-1 1/4"	BRND. 4133-HRS	
7B1	4	1/4" X 6"	A36	1'-1 1/4"	BRND. 4133-HRS	
7C	25	FIELD BOLTS	A325		(US) A153-HRS, HRCAP	
7C1	25	1/4" HEX HEAD CAP SCREW	A325		(US) A153-HRS, HRCAP	
7C2	25	1/4" HEX NUT	A325		(US) A153-HRS, HRCAP	
7D	25	FIELD BOLTS	A325		(US) A153-HRS, HRCAP	
7D1	25	1/4" HEX HEAD CAP SCREW	A325		(US) A153-HRS, HRCAP	
7D2	25	1/4" HEX NUT	A325		(US) A153-HRS, HRCAP	
7E	25	FIELD BOLTS	A325		(US) A153-HRS, HRCAP	
7E1	25	1/4" HEX HEAD CAP SCREW	A325		(US) A153-HRS, HRCAP	
7E2	25	1/4" HEX NUT	A325		(US) A153-HRS, HRCAP	
7F	25	FIELD BOLTS	A325		(US) A153-HRS, HRCAP	
7F1	25	1/4" HEX HEAD CAP SCREW	A325		(US) A153-HRS, HRCAP	
7F2	25	1/4" HEX NUT	A325		(US) A153-HRS, HRCAP	
7G	25	FIELD BOLTS	A325		(US) A153-HRS, HRCAP	
7G1	25	1/4" HEX HEAD CAP SCREW	A325		(US) A153-HRS, HRCAP	
7G2	25	1/4" HEX NUT	A325		(US) A153-HRS, HRCAP	
7H	25	FIELD BOLTS	A325		(US) A153-HRS, HRCAP	
7H1	25	1/4" HEX HEAD CAP SCREW	A325		(US) A153-HRS, HRCAP	
7H2	25	1/4" HEX NUT	A325		(US) A153-HRS, HRCAP	
7I	25	FIELD BOLTS	A325		(US) A153-HRS, HRCAP	
7I1	25	1/4" HEX HEAD CAP SCREW	A325		(US) A153-HRS, HRCAP	
7I2	25	1/4" HEX NUT	A325		(US) A153-HRS, HRCAP	

THE B.S. BIRCHWIN COMPANY  
 300 E. BIRCHWIN DRIVE  
 WINDY HOLLOW, VT 05677  
 TEL: 802-253-1000  
 FAX: 802-253-1000  
 WWW.BSBCOMPANY.COM


SCALE: PANEL DETAILS  
 ADDISON COUNTY, VT  
 PROJECT NO. 20388  
 SHEET NO. 1206  
 DATE: 8/15/07  
 OF: 07

088-BR




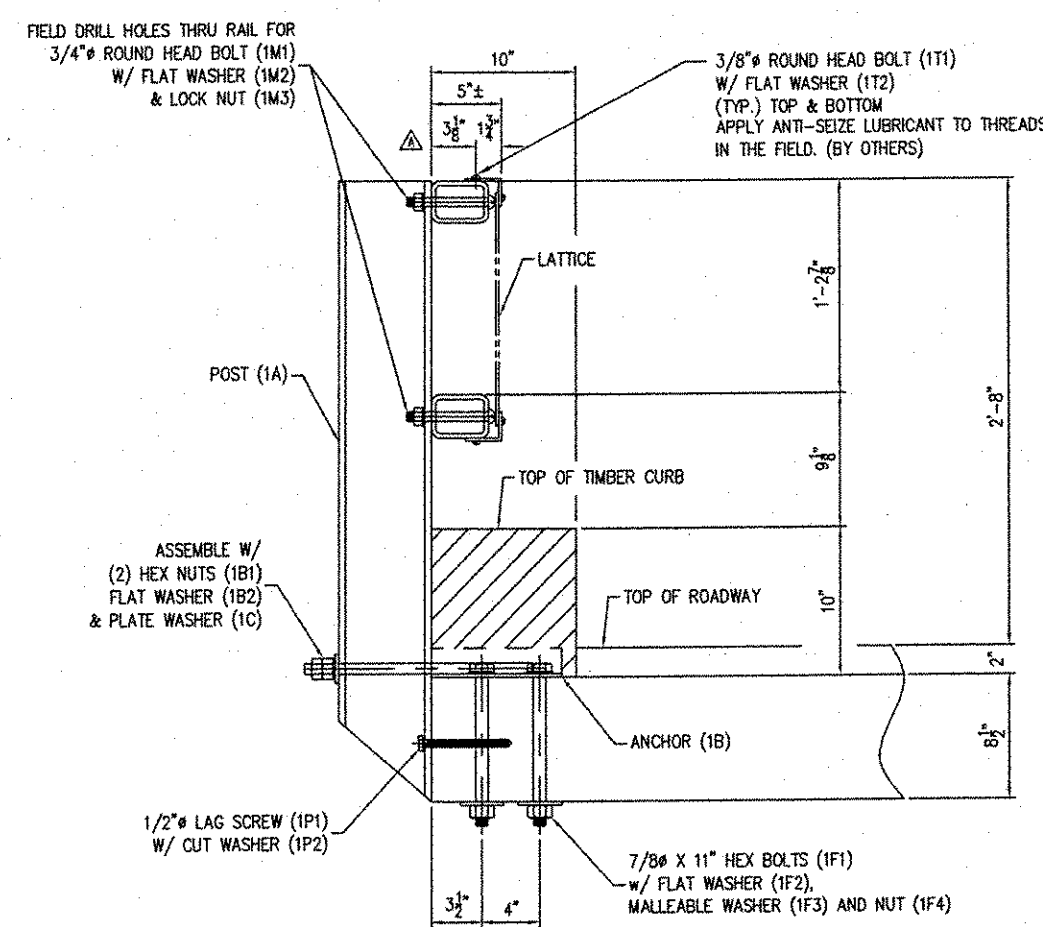


TYP. SECTION @ RAIL POST

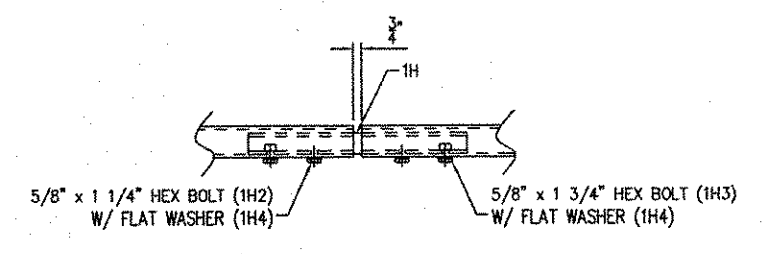

TYP. SPLICE DETAIL

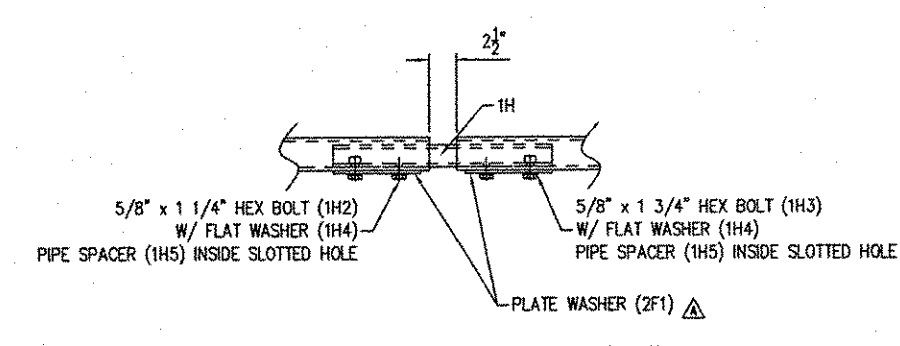


TYP. EXPANSION SPLICE DETAIL

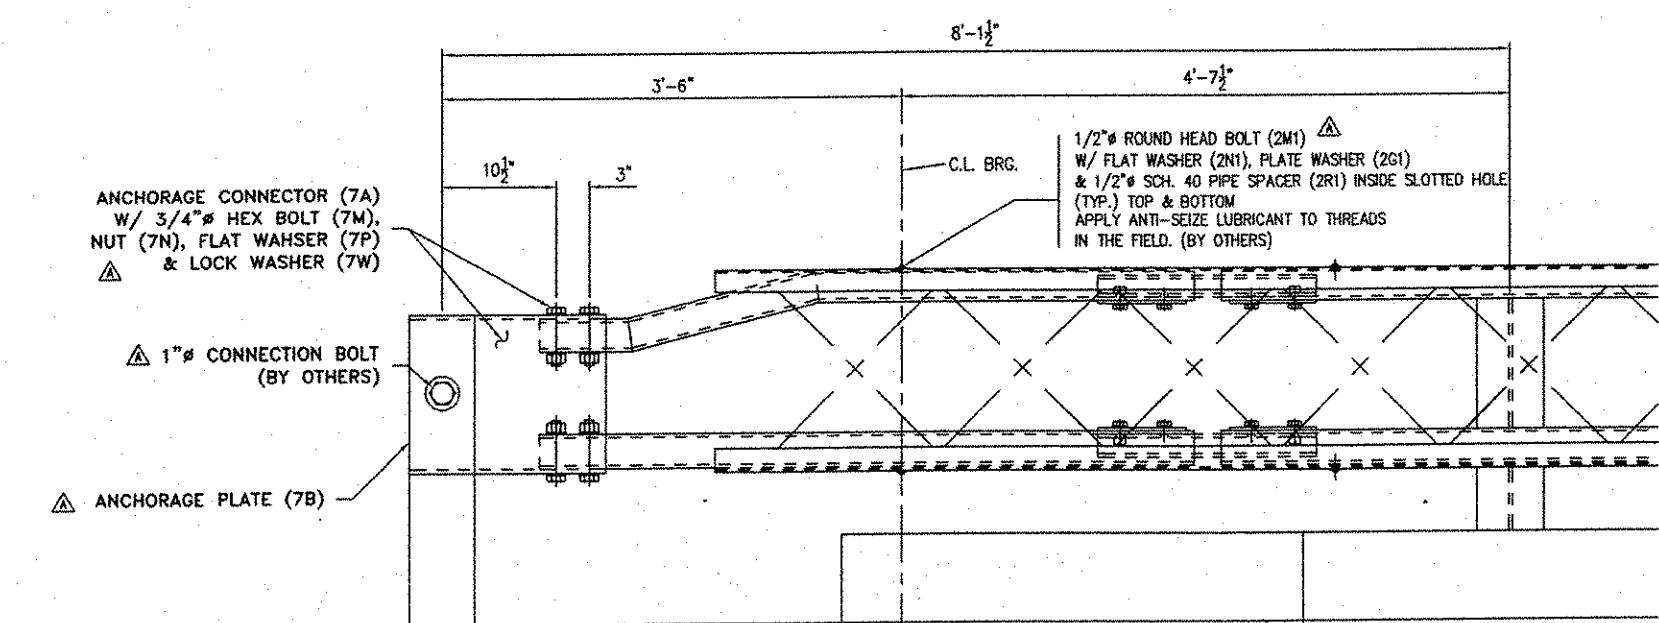

TYP. ELEVATION @ END OF BRIDGE


RECEIVED  
 CK'D BY ELK CK'D BY RSY  
 AUG 07 2007  
 RESUBMIT \_\_\_\_\_ APPROVED \_\_\_\_\_  
 BY CPW DATE 8/17/07

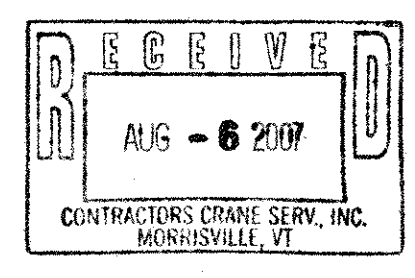

CCS Constructors LLC  
 138 Munson Avenue  
 Morrisville, VT 05661  
 Ph: 802-888-7701 f: 802-888-4746

THE E.S. BROWN COMPANY 300 E. DUNDY STREET MORRISVILLE, VT 05661 TEL: 802-888-7701 FAX: 802-888-4746 WWW.EBROWN.COM		LOCATION - TOWNS OF NEW HAVEN & NEWBRIDGE BRIDGE - 28 PROJECT - ROUTE NO. 107/71, CL3 F.A.P. NO. - 040-020 (2006) P.O. NO. - DESIGNER - VERMONT DEPARTMENT OF TRANSPORTATION CUSTOMER - CONTRACTORS CRANE SERVICE, LLC	
ALL PER APPROVAL REV. DESCRIPTION DATE SET. CHK.	7/25/07 JES TSP	ITEM QUANTITY	1 1206 1 E2

090-BR

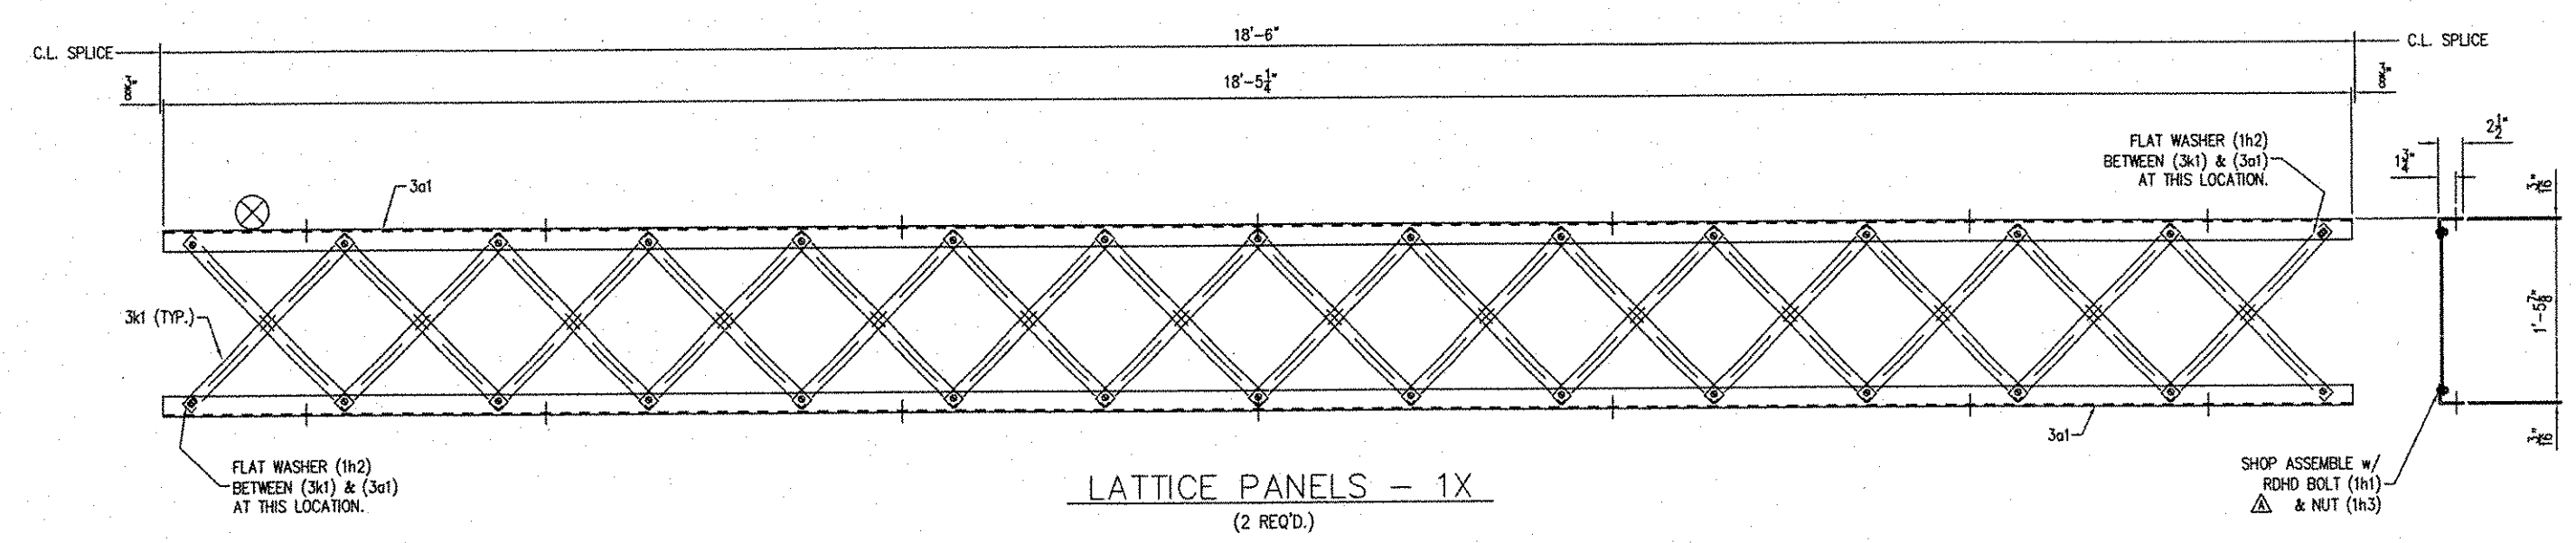

**GENERAL NOTES:**

- 1.) MATERIALS AND WORKMANSHIP SHALL IN ACCORDANCE WITH THE STATE OF VERMONT AGENCY OF TRANSPORTATION STANDARD SPECIFICATIONS FOR CONSTRUCTION, DATED 2006 AS AMENDED BY THE LATEST REVISIONS, THE AASHTO STANDARD SPECIFICATIONS FOR HIGHWAY CONSTRUCTION, SEVENTEENTH EDITION.
- 2.) FABRICATION SHALL BE PERFORMED IN ACCORDANCE WITH AASHTO STANDARD SPECIFICATIONS FOR HIGHWAY CONSTRUCTION, AASHTO/AASHTO/AWS D1.5 AND THE CURRENT INTERIM SPECIFICATIONS AS MODIFIED BY VIRTRANS SPEC. 506.03.
- 3.) RAILING MATERIALS SHALL BE ASTM A709 OR 50, UNLESS NOTED OTHERWISE.  
PER VIRTRANS SPECIFICATION 732.03(2), (8) X 25 POSTS SHALL BE CON TESTED PER 25 FT. LBS. @ 40°F. Δ  
- HOLLOW STRUCTURAL SHAPES TO CONFORM WITH ASTM A500, GRADE B IN ACCORDANCE WITH VIRTRANS SPECIFICATION 732.03(6), (HSS SHALL BE CON TESTED PER 15 FT. LBS. @ 40°F. Δ)  
- PIPE SHALL BE ASTM A53, GRADE B.  
- HARDWARE TO BE IN ACCORDANCE WITH ASTM F568M, CLASS 4.6 (ASTM A307), UNF.O.  
- HIGH STRENGTH HARDWARE SHALL BE IN ACCORDANCE WITH AASHTO M84 TYPE 1 (ASTM A325) OR (ASTM A449) AND SHALL BE SUPPLIED IN ACCORDANCE TO VIRTRANS SPEC. 714.05, WHICH INCLUDES ROCAF, PROOF AND WEDGE TESTING.  
- THREADED ROD FOR POST ANCHORAGE SHALL CONFORM TO ASTM F 1554 GRADE 55 "WELDABLE STEEL".
- 4.) ALL HARDWARE SHALL BE GALVANIZED IN ACCORDANCE WITH AASHTO M-232 (ASTM A-153).
- 5.) RAILING COMPONENTS SHALL BE GALVANIZED IN ACCORDANCE WITH AASHTO M-111 (ASTM A123), UNLESS NOTED OTHERWISE. RADIUS ALL EDGES 1/16" AND BLAST CLEAN PER SSPC-SP 8 PRIOR TO GALVANIZING AND REPAIR GALVANIZING PER ASTM A780.
- 6.) FABRICATION SHALL TAKE PLACE IN A FACILITY WITH A MINIMUM ASQC CATEGORY II CERTIFICATION OR BE APPROVED BY VIRTRANS. NON-CERTIFIED FACILITIES MUST SATISFY THE REQUIREMENTS OF VIRTRANS SPEC. 506.03.

THE CONTRACTOR SHALL VERIFY ALL DIMENSIONS PRIOR TO FABRICATION TO ENSURE ACCURACY OF DESIGN PLANS. STAMPED APPROVED DIMENSIONS ASSUME DIMENSIONS HAVE BEEN VERIFIED BY CONTRACTOR.

SHOP NOTE:  
⊙ - INDICATES LOCATION OF SHIPPING PIECE MARK

NO.	QTY.	DESCRIPTION	MATERIAL	LENGTH	REMARKS	PART NO.
TX	2	LATTICE PANELS	A307 GR A	18'-0" X 18'-0"		
1/2"	10	3/16" X 1 1/2" X 1 1/2" HSS	A500 GR A		100% AISC-HQC NONE	
1/2"	10	1 1/2" X 1 1/2" X 1/8" FLAT WASHER	F544		100% AISC-HQC	
1/2"	10	1 1/2" X 1 1/2" X 1/8" HEX NUT	A307 GR A		100% AISC-HQC	
3/8"	4	1 1/2" X 1 1/2" X 3/16" HSS	A500 GR A		100% AISC-HQC NONE	
3/8"	56	1/2" X 1 1/2" X 1/2" X 3/16" HSS	A500 GR 50		100% AISC-HQC NONE	

**RECEIVED**

CK'D BY ELK OK'D BY RSY

**AUG 07 2007**

RESUBMIT \_\_\_\_\_ APPROVED \_\_\_\_\_

BY OPW DATE 8/17/07

- SEE SHEET 3 FOR PIECE DETAILS.  
- SEE DS BROWN PROJECT 20388-1206  
SHEET E1 & E2 FOR FIELD LOCATION AND DETAILS

**B.S. BROWN**


300 E. BROWN STREET  
WATERBURY, VT 05671  
TEL: 802.249.4400  
FAX: 802.249.4401  
WWW.BSBROWN.COM

LOCATION - TOWNS OF NEW HAVEN & METERIDGE  
BRIDGE - 28  
PROJECT - ROUTE NO. 107/11, 033  
F.A.P. NO. - 090-BM 2000(1)  
P.O. NO. -  
DESIGNER - VERMONT DEPARTMENT OF TRANSPORTATION  
CUSTOMER - CONTRACTORS CRANE SERVICE, LLC

DATE	BY	REV	DESCRIPTION
7/20/07	ELK	1	ISSUED FOR FAB
8/17/07	OPW	2	REVISED FOR FAB

REL'S. | 20388 | 1209 | 01

091-BR

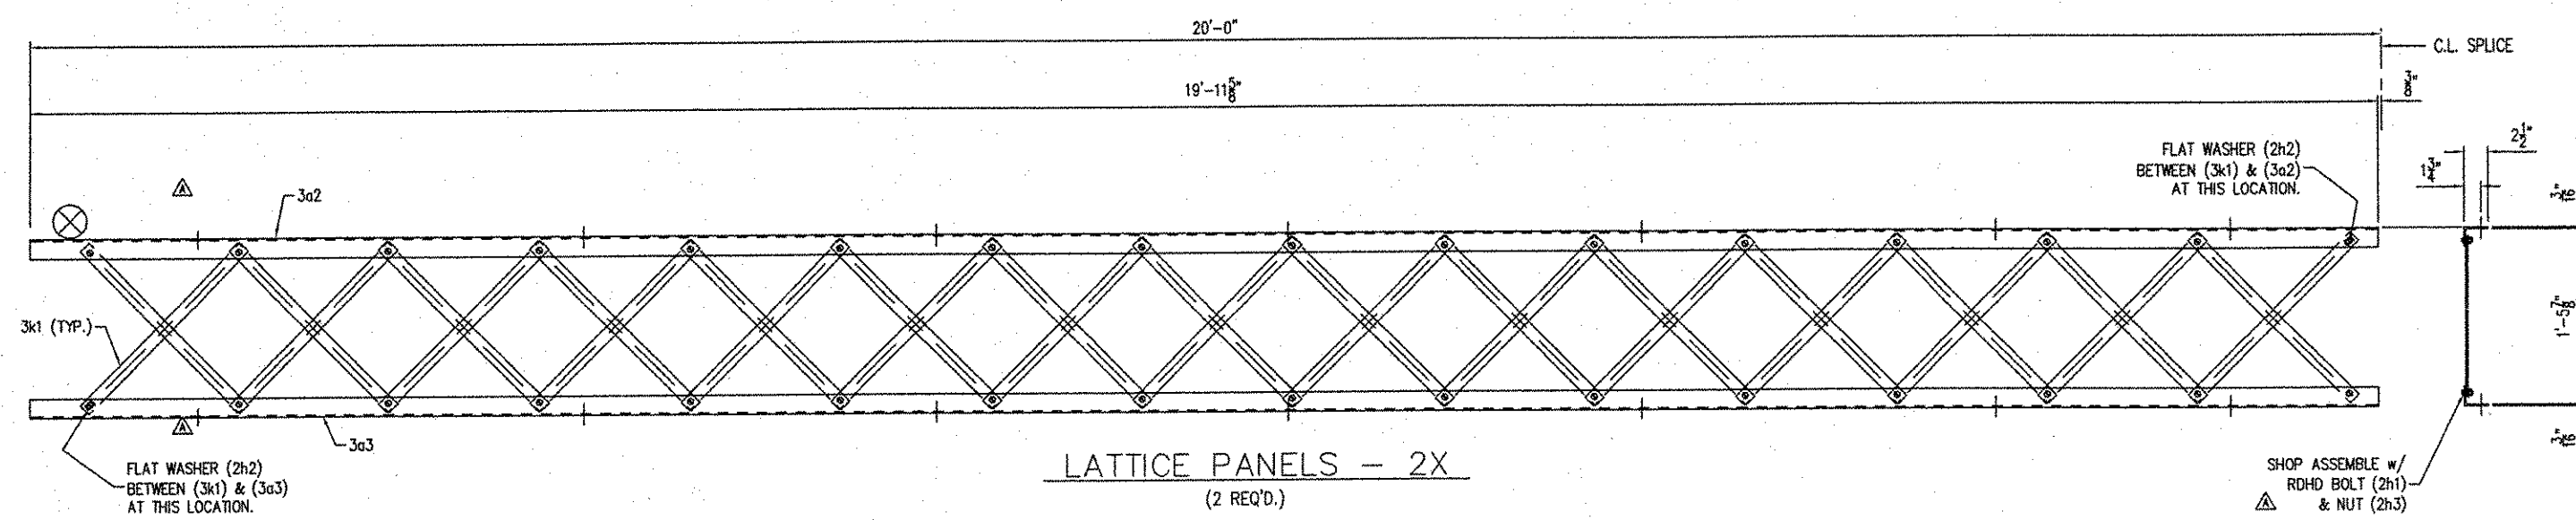

NO.	QTY	DESCRIPTION	MATERIAL	LENGTH	REMARKS	PART NO.
2X	2	LATTICE PANELS		19'-11 5/8"		
2a1	70	1/2" X 1/2" X 2" X 3/16" RHD BOLT	A307 GR A		19'-11 5/8"	
2a2	10	1/8" FLAT WASHER	F304		19'-11 5/8"	
2a3	10	1/2" HEX NUT	A307 GR A		19'-11 5/8"	
3a1	2	1/2" X 2" X 2" X 3/16" RHD BOLT	A307 GR A		19'-11 5/8"	
3a2	2	1/2" X 2" X 2" X 3/16" RHD BOLT	A307 GR A		19'-11 5/8"	
3a3	2	1/2" X 2" X 2" X 3/16" RHD BOLT	A307 GR A		19'-11 5/8"	
3a4	10	1/2" X 2" X 2" X 3/16" RHD BOLT	A307 GR A		19'-11 5/8"	

NOTE: ALL MATERIAL SPECIFICATION DESCRIPTIONS ARE AS SHOWN UNLESS OTHERWISE NOTED.

RECEIVED  
 OK'D BY EW OK'D BY RSV  
 AUG 07 2007  
 RESUBMIT \_\_\_\_\_ APPROVED \_\_\_\_\_  
 BY CPW DATE 8/17/07

- SEE SHEET 3 FOR PIECE DETAILS.  
 - SEE DS BROWN PROJECT 20388-1206  
 SHEET E1 & E2 FOR FIELD LOCATION AND DETAILS

NO.	QTY	DESCRIPTION	MATERIAL	LENGTH	REMARKS	PART NO.
2X	2	LATTICE PANELS		19'-11 5/8"		
2a1	70	1/2" X 1/2" X 2" X 3/16" RHD BOLT	A307 GR A		19'-11 5/8"	
2a2	10	1/8" FLAT WASHER	F304		19'-11 5/8"	
2a3	10	1/2" HEX NUT	A307 GR A		19'-11 5/8"	
3a1	2	1/2" X 2" X 2" X 3/16" RHD BOLT	A307 GR A		19'-11 5/8"	
3a2	2	1/2" X 2" X 2" X 3/16" RHD BOLT	A307 GR A		19'-11 5/8"	
3a3	2	1/2" X 2" X 2" X 3/16" RHD BOLT	A307 GR A		19'-11 5/8"	
3a4	10	1/2" X 2" X 2" X 3/16" RHD BOLT	A307 GR A		19'-11 5/8"	

**B.S. BROWN**  
 20 E. CHERRY STREET  
 NORTH WINDHAM, VT 05602  
 405.501.3000  
 FAX: 405.501.3333  
 WWW.DSBSBROWN.COM

SHIP NOTE:  
 @ - INDICATES LOCATION  
 OF SHIPPING PIECE MARK

092-PR

