

STATE OF VERMONT AGENCY OF TRANSPORTATION



PROPOSED IMPROVEMENT BRIDGE PROJECT



TOWN OF READSBORO
COUNTY OF BENNINGTON

ROUTE NO: TH 2, FAS 105, (MAJOR COLLECTOR) BRIDGE #32


PROJECT LOCATION : LOCATED IN THE COUNTY OF BENNINGTON, TOWN OF READSBORO ON TH 2, BRIDGE 32
APPROXIMATELY 0.16 KM SOUTH OF THE INTERSECTION OF TH2 AND TH 1 (VT ROUTE 100).

PROJECT DESCRIPTION : THE PROJECT SHALL CONSIST OF THE REPLACEMENT OF THE EXISTING STRUCTURE WITH A NEW
SIMPLE SPAN BRIDGE WITH MINIMAL CHANNEL WORK. THE SOUTHERN APPROACH WORK WILL BE
MINIMAL WHILE THE EXTENDED NORTHERN APPROACH WORK WILL BE MODERATE.


LENGTH OF STRUCTURE : 32.980 METERS
LENGTH OF ROADWAY: 72.020 METERS
LENGTH OF PROJECT: 105.000 METERS

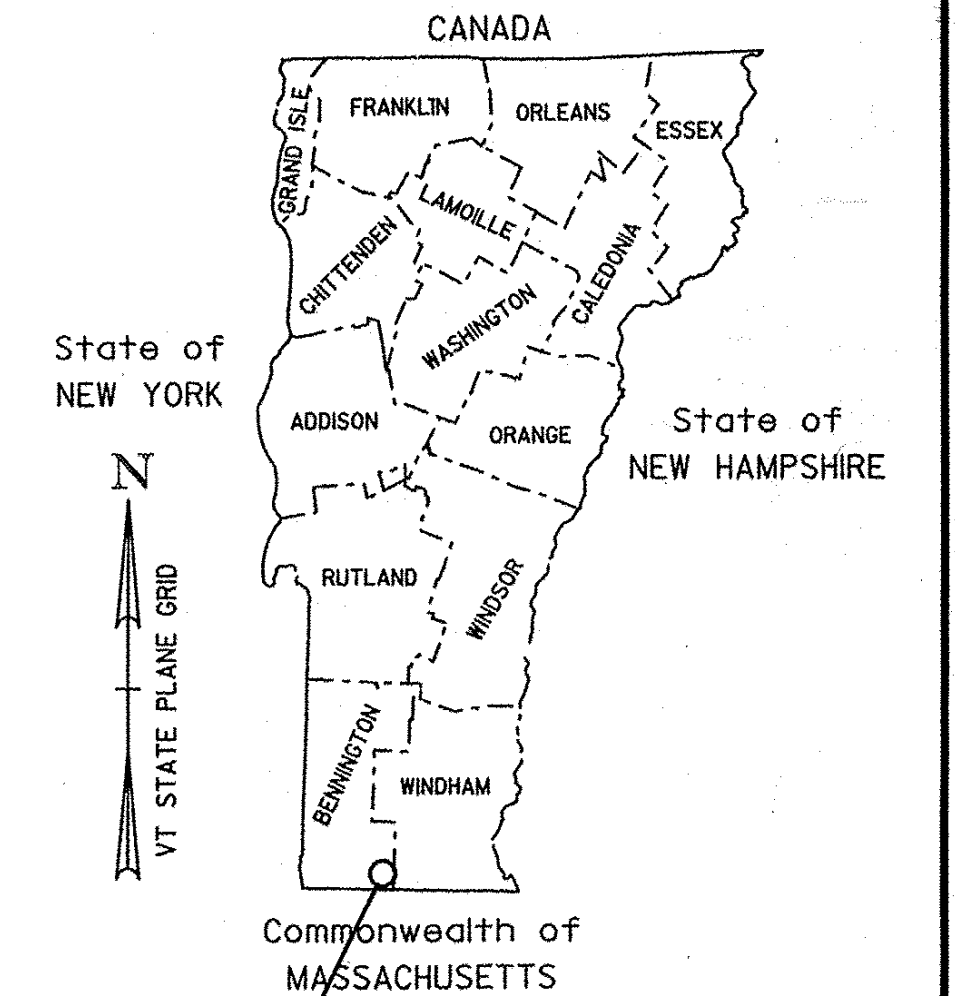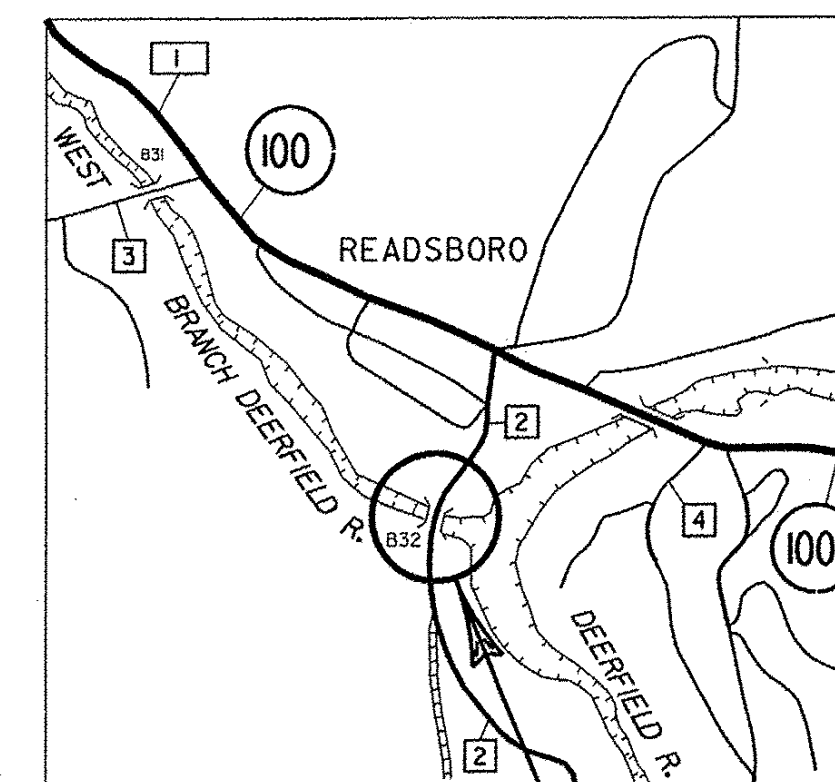

PROJECT LOCATION
READSBORO BRF 0105 (3)

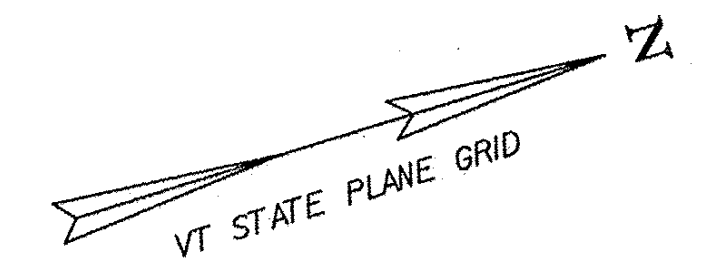

| RECORD PLANS | |
|--|--------------------------------------|
| CONTRACTOR: | RENAUD BROTHERS, INC. - VERNON, VT |
| RESIDENT ENGINEER: | FREDERICK ROSS III |
| CONSTRUCTION BEGAN: | NOVEMBER 19, 2012 |
| CONSTRUCTION COMPLETE: | NOVEMBER 20, 2013 |
| RECORD PLANS BY: | FREDERICK ROSS III, PERCY BANNERMAN |
| I HEREBY CERTIFY THAT ALL THE CONSTRUCTION REQUIRED BY THIS SET OF DRAWINGS HAS BEEN ACCOMPLISHED AS INDICATED HEREIN. | |
| BY: | <i>[Signature]</i> RESIDENT ENGINEER |
| DATE: | 4-21-15 |
| NOTE: Any further information concerning final quantities, amounts or other details relative to this project may be found at Central Files in the electronic archives. | |

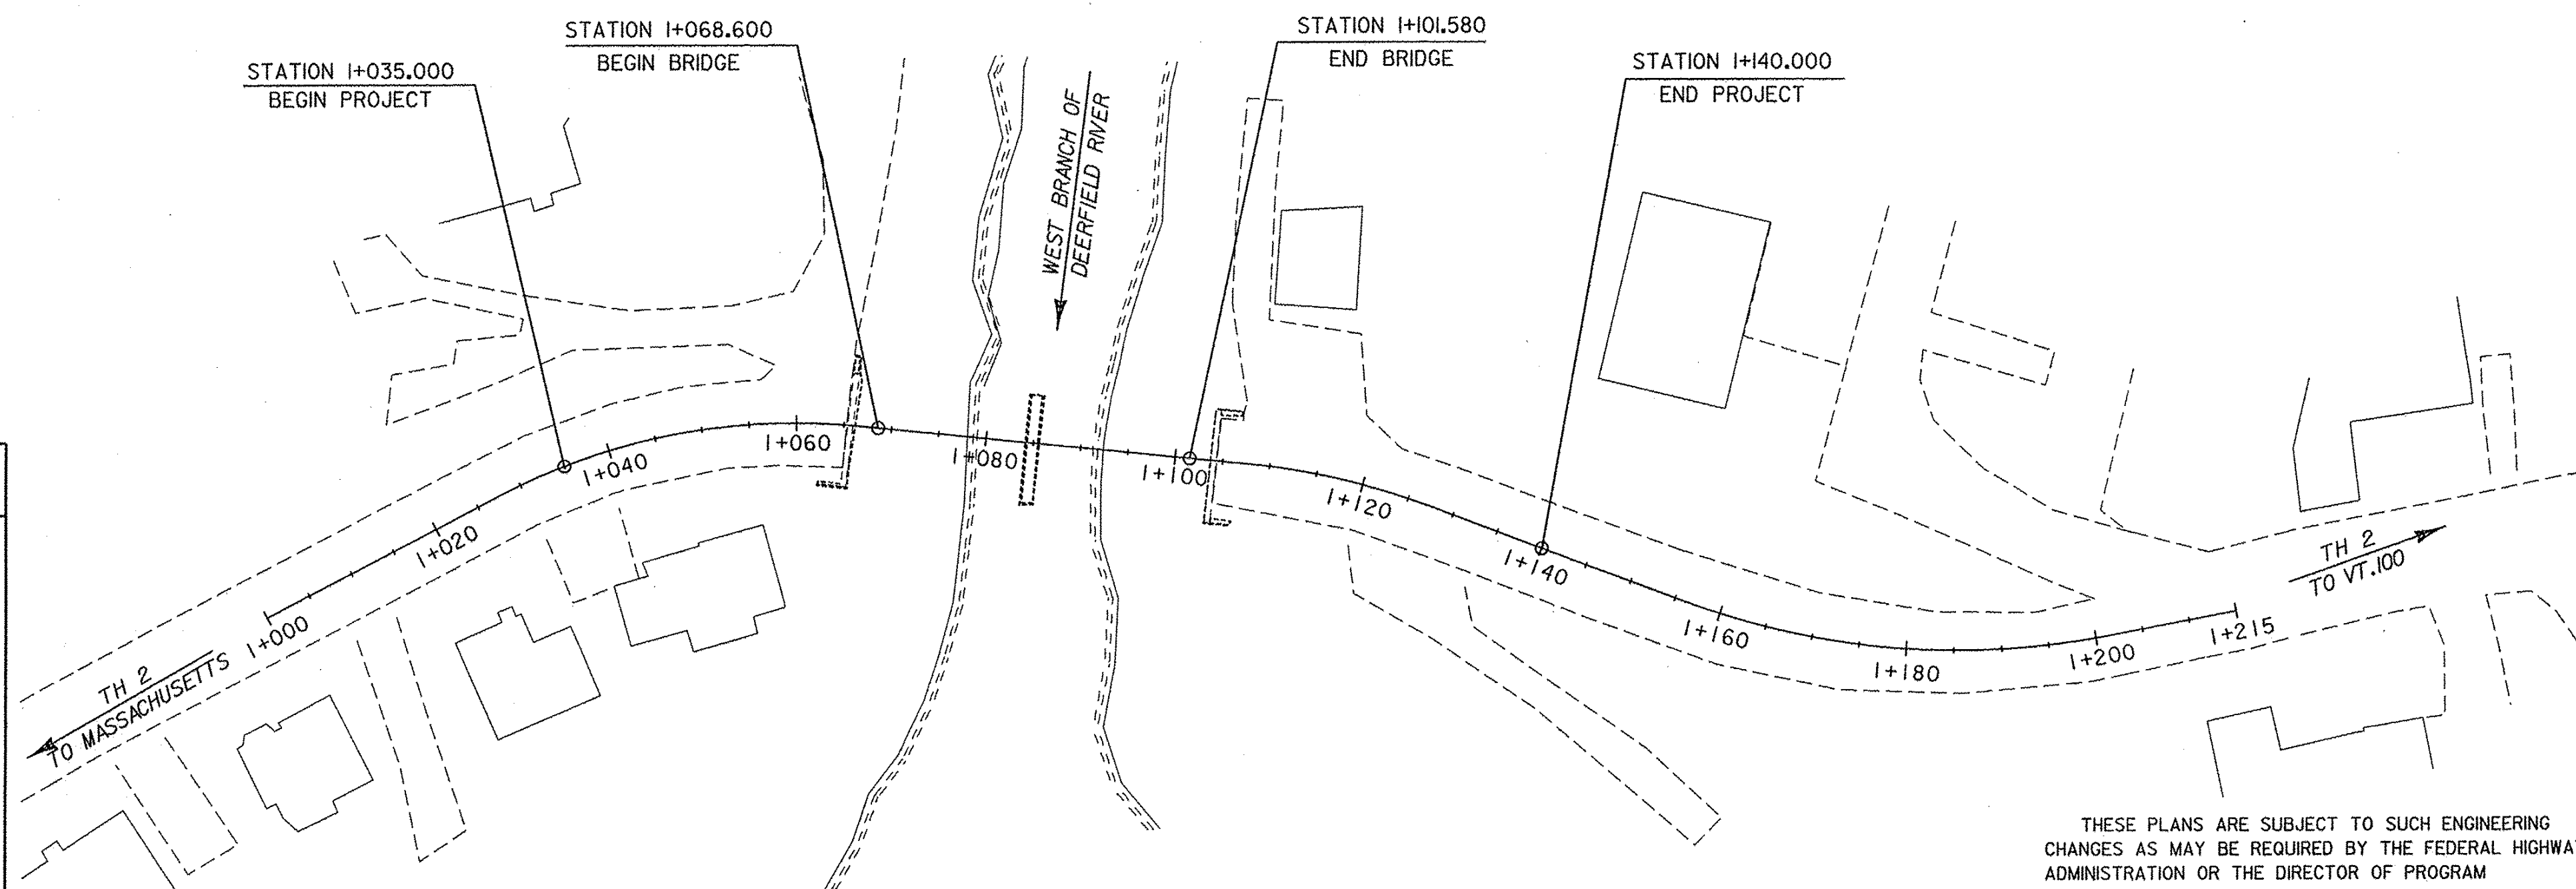

QUALITY ASSURANCE PROGRAM: LEVEL 2

| CONVENTIONAL SYMBOLS | |
|----------------------|--|
| COUNTY LINE | |
| TOWN LINE | |
| LIMITS OF ACCESS | |
| POINT OF ACCESS | |
| FENCE LINE | |
| STONE WALL | |
| TRAVELED WAY | |
| GUARD RAIL | |
| RAILROAD | |
| SURVEY LINE | |
| CULVERT | |
| POWER POLE | |
| TELEPHONE POLE | |
| TREES | |
| CONTROL OF ACCESS | |
| PROPERTY LINE | |
| R.O.W. TAKING LINE | |
| SLOPE RIGHTS | |
| TOP OF CUT | |
| TOE OF SLOPE | |

SURVEYED BY : L. ORVIS
SURVEYED DATE : FEBRUARY 14, 1994

DATUM
VERTICAL NAV D88
HORIZONTAL NAD-83 (92)



THESE PLANS ARE SUBJECT TO SUCH ENGINEERING CHANGES AS MAY BE REQUIRED BY THE FEDERAL HIGHWAY ADMINISTRATION OR THE DIRECTOR OF PROGRAM DEVELOPMENT.
CONSTRUCTION IS TO BE CARRIED ON IN ACCORDANCE WITH THESE PLANS AND THE STANDARD SPECIFICATIONS FOR CONSTRUCTION DATED 2006, AS APPROVED BY THE FEDERAL HIGHWAY ADMINISTRATION ON JUNE 15, 2006 FOR USE ON THIS PROJECT, INCLUDING ALL SUBSEQUENT REVISIONS AND SUCH REVISED SPECIFICATIONS AND SPECIAL PROVISIONS AS ARE INCORPORATED IN THESE PLANS.

Metric
UNLESS NOTED OTHERWISE
STATIONS ARE IN KILOMETERS
ELEVATIONS ARE IN METERS
DIMENSIONS ARE IN MILLIMETERS

| | |
|---------------------------------|--------------|
| DIRECTOR OF PROGRAM DEVELOPMENT | |
| APPROVED <i>[Signature]</i> | DATE 3-7-12 |
| PROJECT MANAGER : J. LACROIX | |
| PROJECT NAME : READSBORO | |
| PROJECT NUMBER : BRF 0105 (3) | |
| SHEET 1 | OF 90 SHEETS |