



DRIVES 1 AND 2 AT STA. 1+060.000 LT LAYOUT

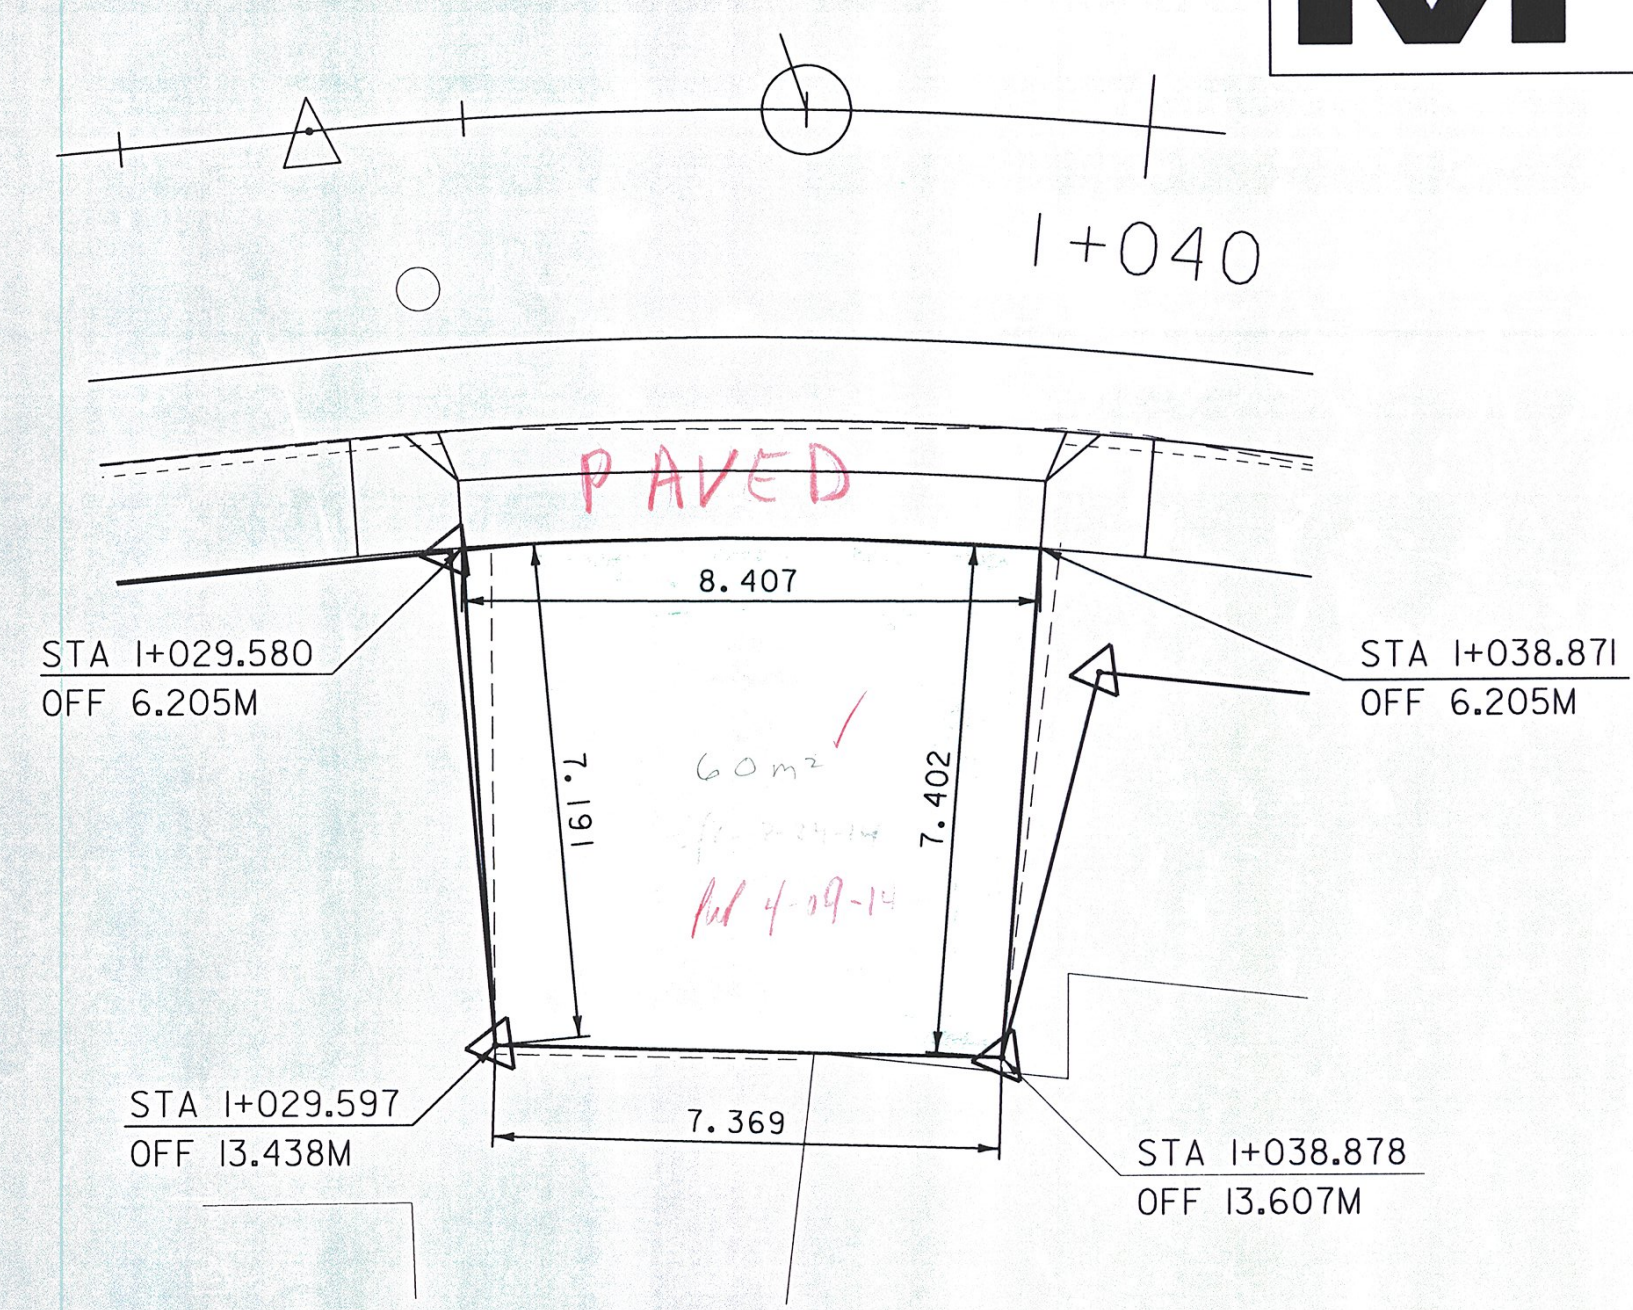


DRIVE STA. 1+034.230 RT LAYOUT

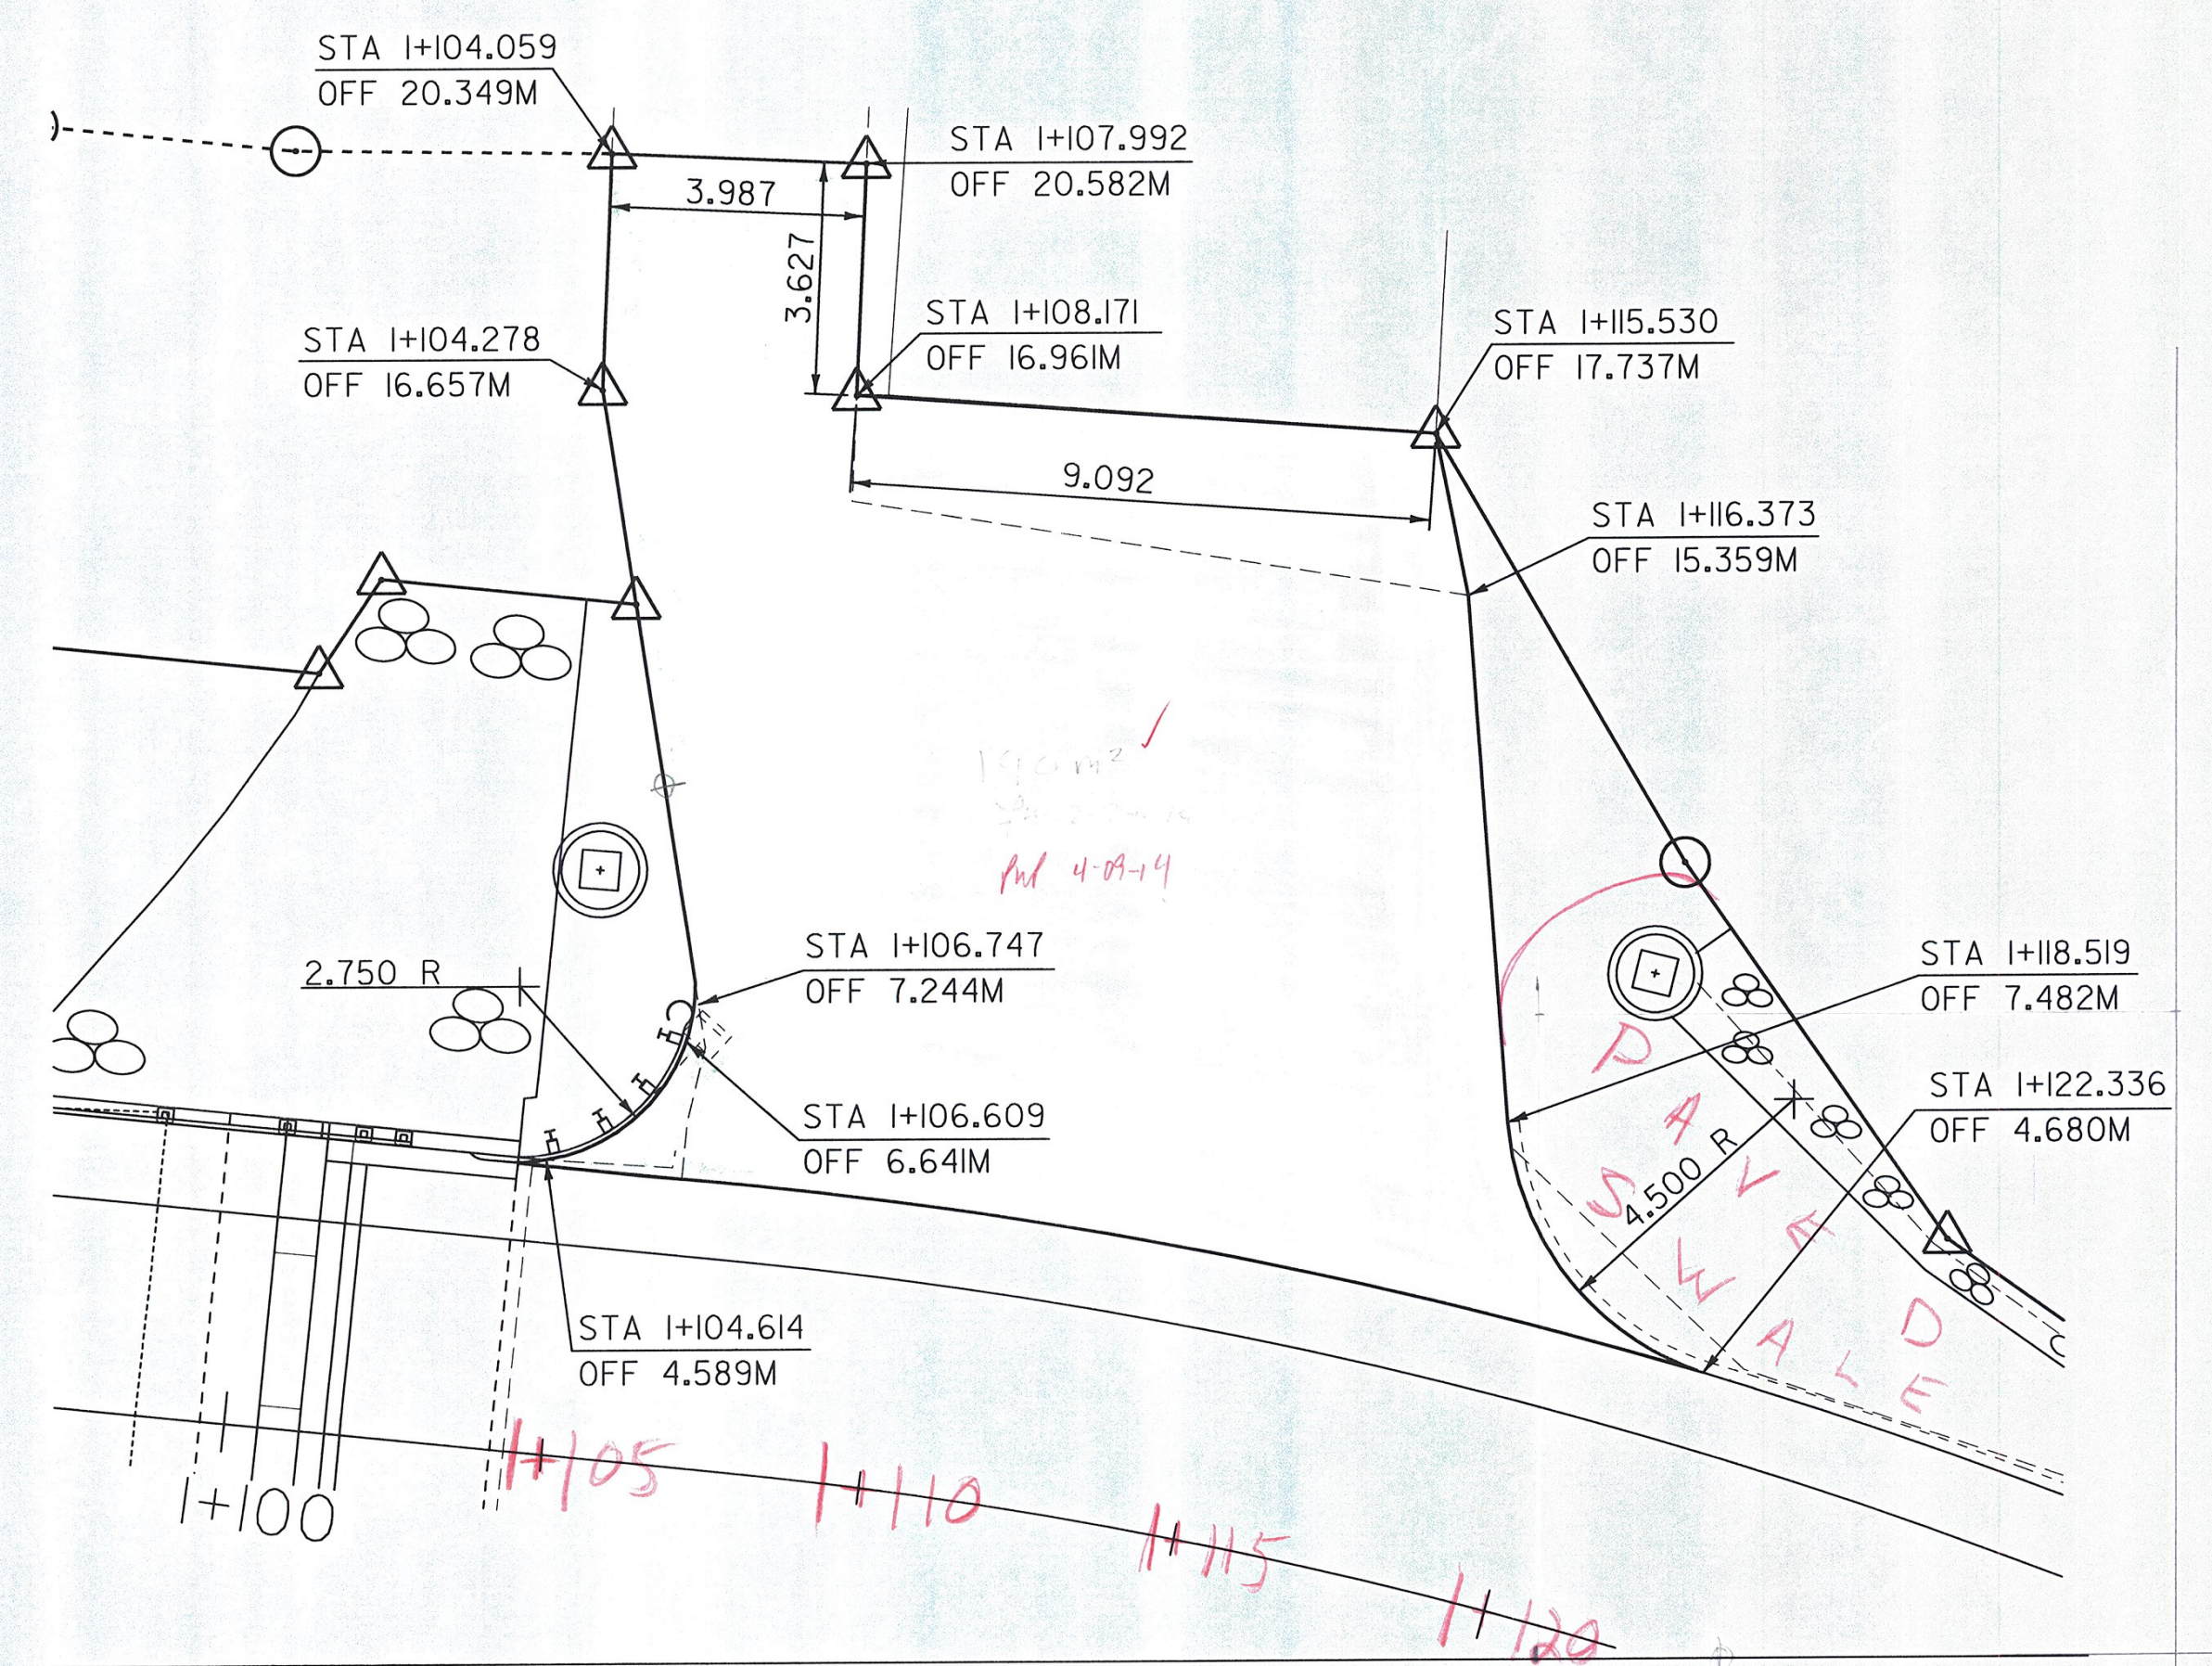

DRIVE STA. 1+112.000 LT LAYOUT

*Item 203.15 - Common Excavation  
See Computation Binder pg 203.15-2.15*

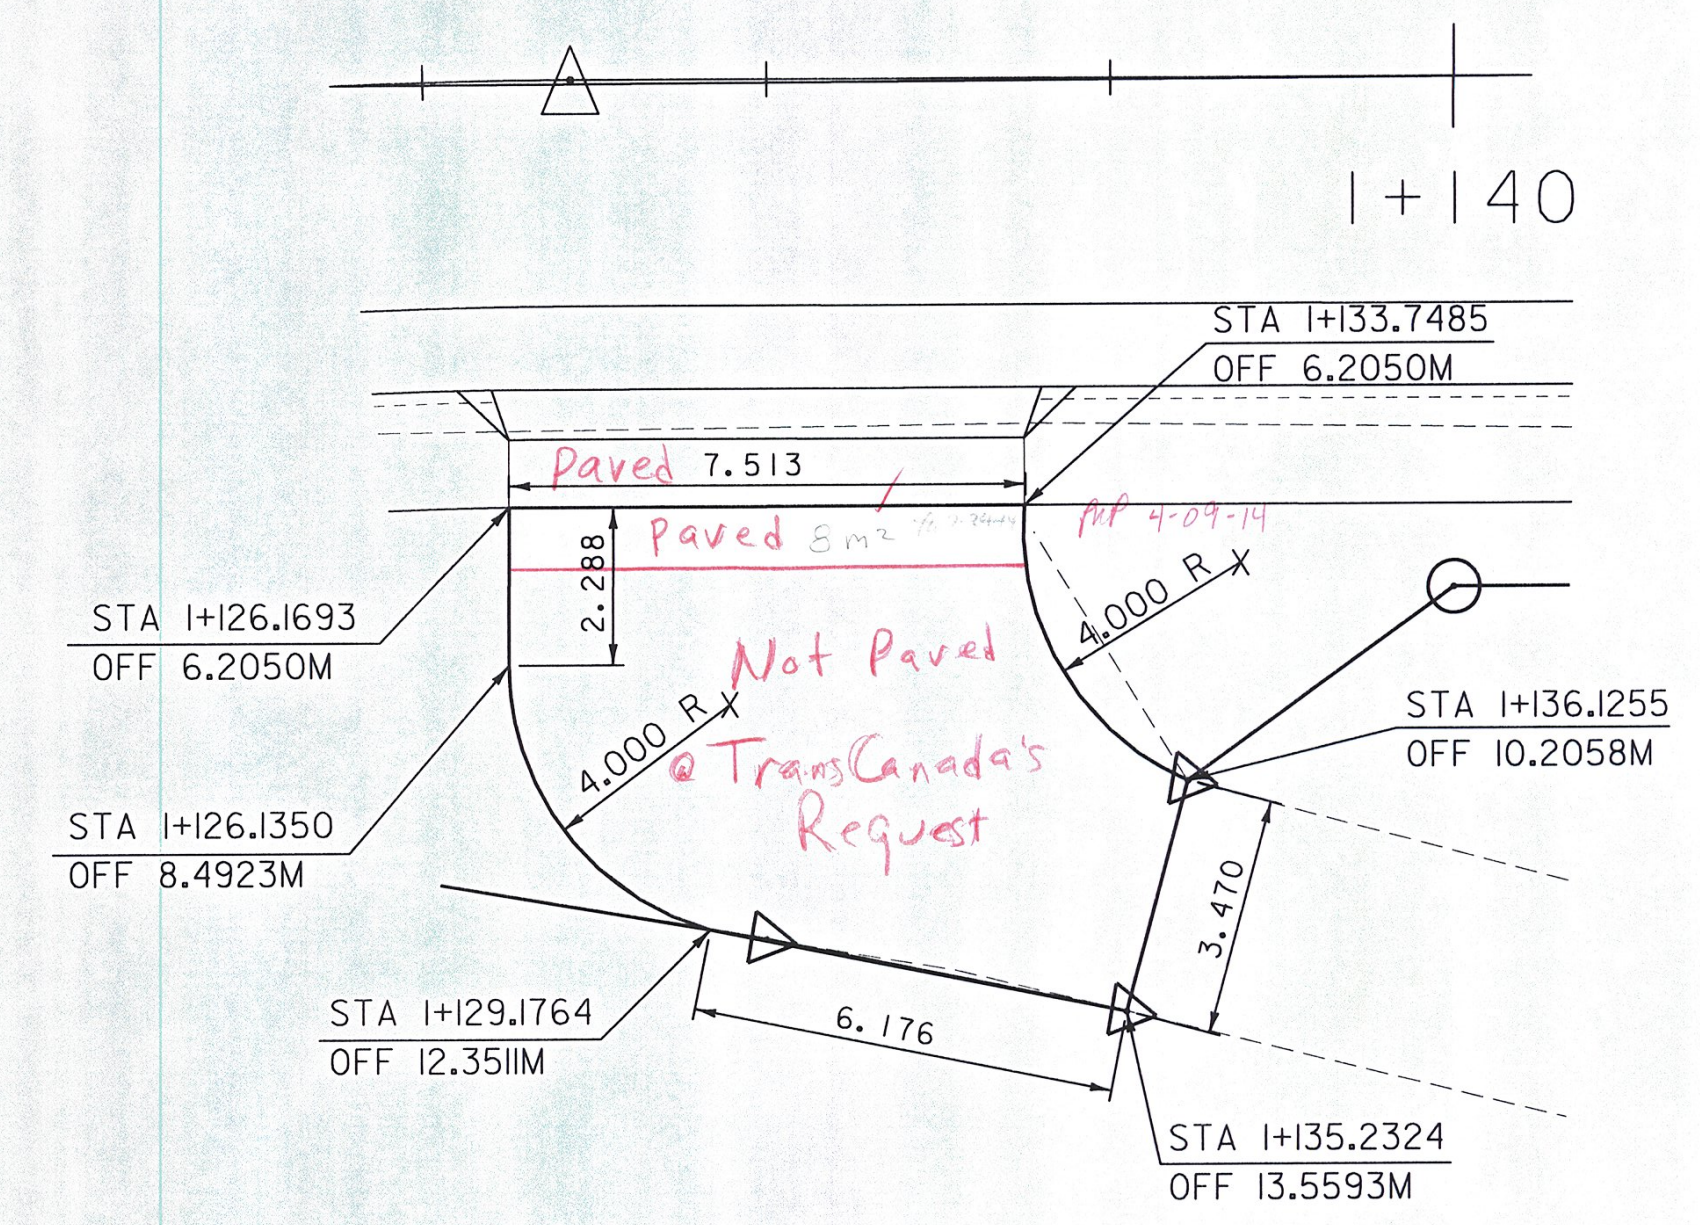

DRIVE STA. 1+130.000 RT LAYOUT

|                 |                           |               |                          |
|-----------------|---------------------------|---------------|--------------------------|
| PROJECT NAME:   | READSBORO                 | PLOT DATE:    | 07-MAR-2012              |
| PROJECT NUMBER: | BRF 0105 (3)              | DRAWN BY:     | G. ROKES                 |
| FILE NAME:      | 89J088/STR/s89J088drv.dgn | DESIGNED BY:  | W. PELLETIER             |
| PROJECT LEADER: | J. LACROIX                | DRIVE LAYOUTS | CHECKED BY: W. PELLETIER |
|                 |                           |               | SHEET 5 OF 90            |