
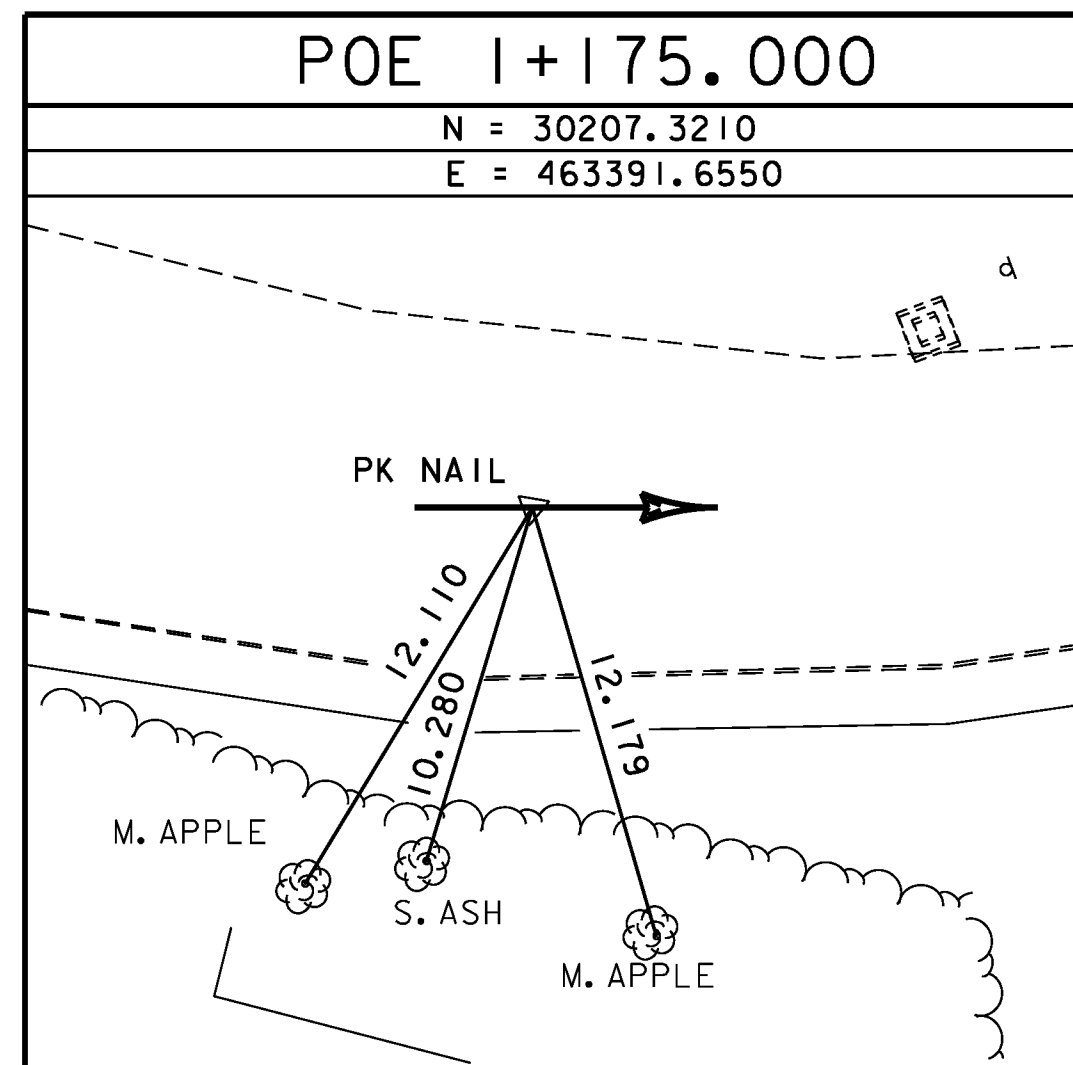


ALIGNMENT TIES

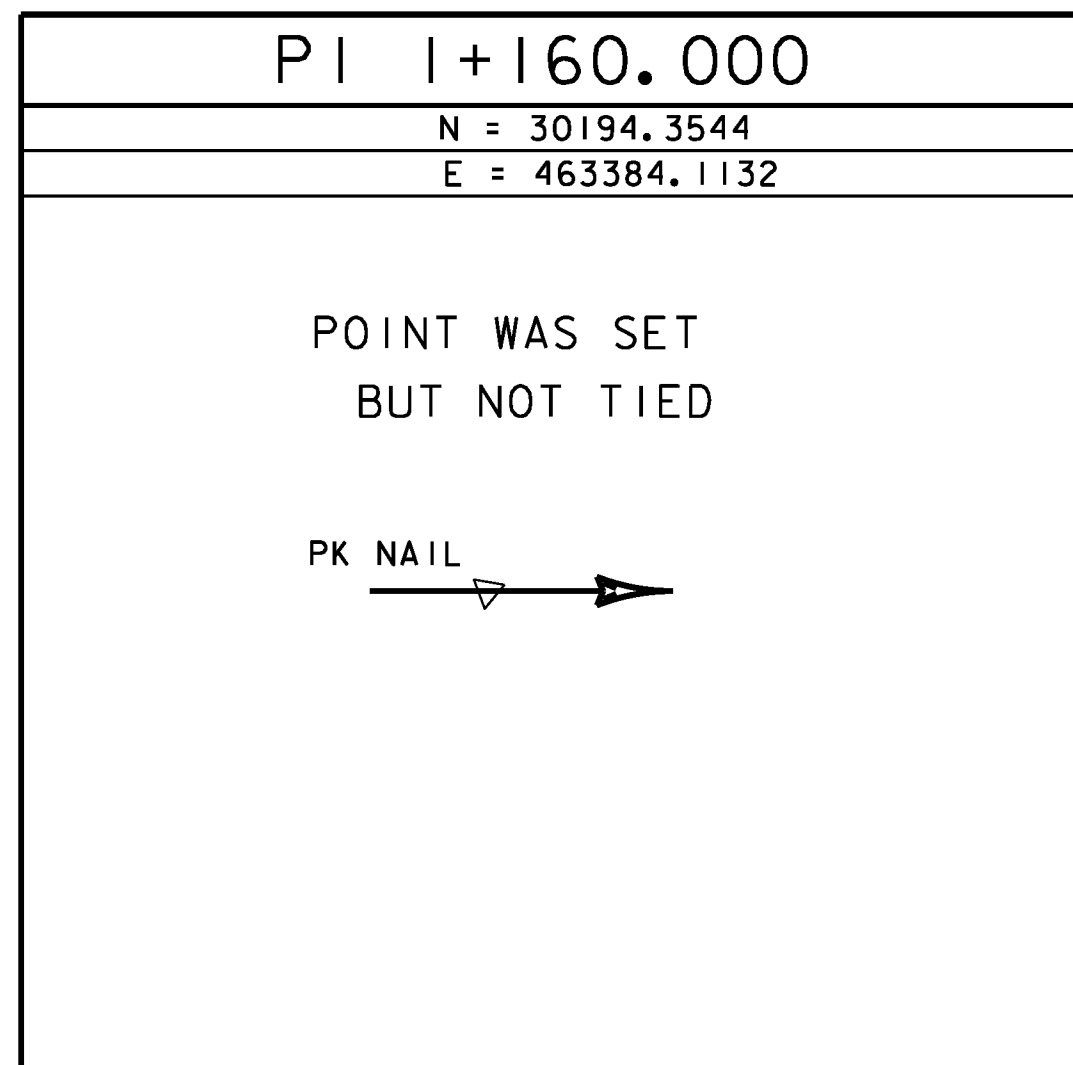

ALIGNMENT TIES

N =
E =
Z =

N =
E =
Z =

N =
E =
Z =

N =
E =
Z =

ALIGNMENT TIES

N =
E =

N =
E =

DATUM
 VERTICAL NAVD 88
 HORIZONTAL NAD 83 (92)

PROJECT NAME: **READSBORO**
 PROJECT NUMBER: **BRF 0105 (3)**
 FILE NAME: survey\x89j088t1.dgn PLOT DATE: **07-MAR-2012**
 PROJECT LEADER: **J. LACROIX** DRAWN BY: **R. BULLOCK**
 DESIGNED BY: **W. PELLETIER** CHECKED BY: **G. HITCHCOCK**
 TIE SHEET 2 SHEET 12 OF 90