


MAINLINE PROFILE

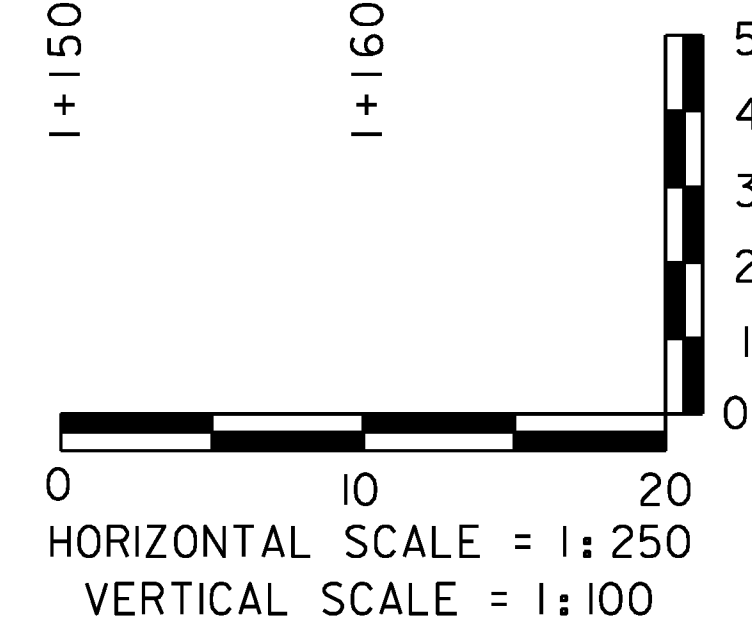

PROJECT NAME: READSBORO
 PROJECT NUMBER: BRF 0105 (3)

FILE NAME: 89J088/STR/sj088xs.dgn
 PROJECT LEADER: J. LACROIX
 DESIGNED BY: W. PELLETIER
 MAINLINE PROFILE SHEET 1

PLOT DATE: 07-MAR-2012
 DRAWN BY: G. ROKES
 CHECKED BY: W. PELLETIER
 SHEET 15 OF 90

THE GRADES SHOWN TO THE NEAREST HUNDREDTH ARE THE EXISTING GROUND ALONG THE CENTERLINE.
 THE GRADES SHOWN TO THE NEAREST THOUSANDTH ARE THE PROPOSED FINISHED GRADE ALONG THE CENTERLINE.