


CHANGING ELEVATION OF DROP INLETS, CATCH BASINS, OR MANHOLES  
 STA. 1+186.220 4.640 M LT

CHANGING ELEVATION OF SEWER MANHOLES  
 STA. 1+181.200 3.558 M RT

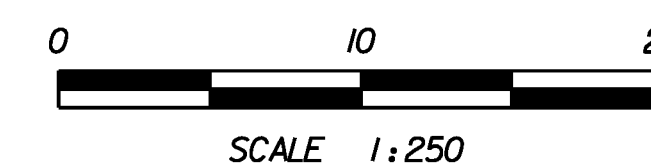

PROJECT NAME: READSBORO  
 PROJECT NUMBER: BRF 0105 (3)

FILE NAME: 89J088/STR/s89J088u+libdr.dgn PLOT DATE: 07-MAR-2012  
 PROJECT LEADER: J. LACROIX DRAWN BY: G. ROKES  
 DESIGNED BY: W. PELLETIER CHECKED BY: W. PELLETIER  
 DRAINAGE LAYOUT SHEET 2 SHEET 21 OF 90