


THIS POLE WAS LEFT IN PLACE WITH ELECTRICAL SERVICE FOR HEAT TAPE ON WATER AND SEWER LINES. CONTRACTOR PAID PROPERTY OWNER AND SIGNED AGREEMENT WITH GMP. COPY OF SIGNED AGREEMENT IS IN CORRESPONDENCE FILE ATTACHED TO EMAIL FROM CHARLIE EZEQUELLE DATED 12/11/14

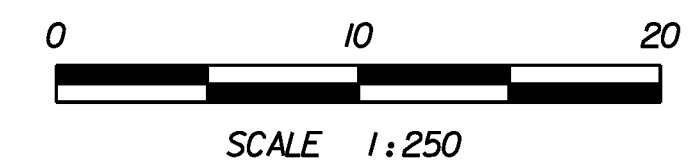

PROJECT NAME:	READSBORO	FILE NAME:	89J088/STR/s89J088u+libdr.dgn	PLOT DATE:	07-MAR-2012
PROJECT NUMBER:	BRF 0105 (3)	PROJECT LEADER:	J. LACROIX	DRAWN BY:	G. ROKES
		DESIGNED BY:	W. PELLETIER	CHECKED BY:	W. PELLETIER
		AERIAL UTILITIES LAYOUT SHEET 1			SHEET 23 OF 90