


100mm WHITE LINE
 STA. 1+005.000 TO STA. 1+150.000 (LT/RT)
 004

100mm YELLOW LINE
 STA. 1+005.000 TO STA. 1+150.000 (DOUBLE CENTERLINE)
 004

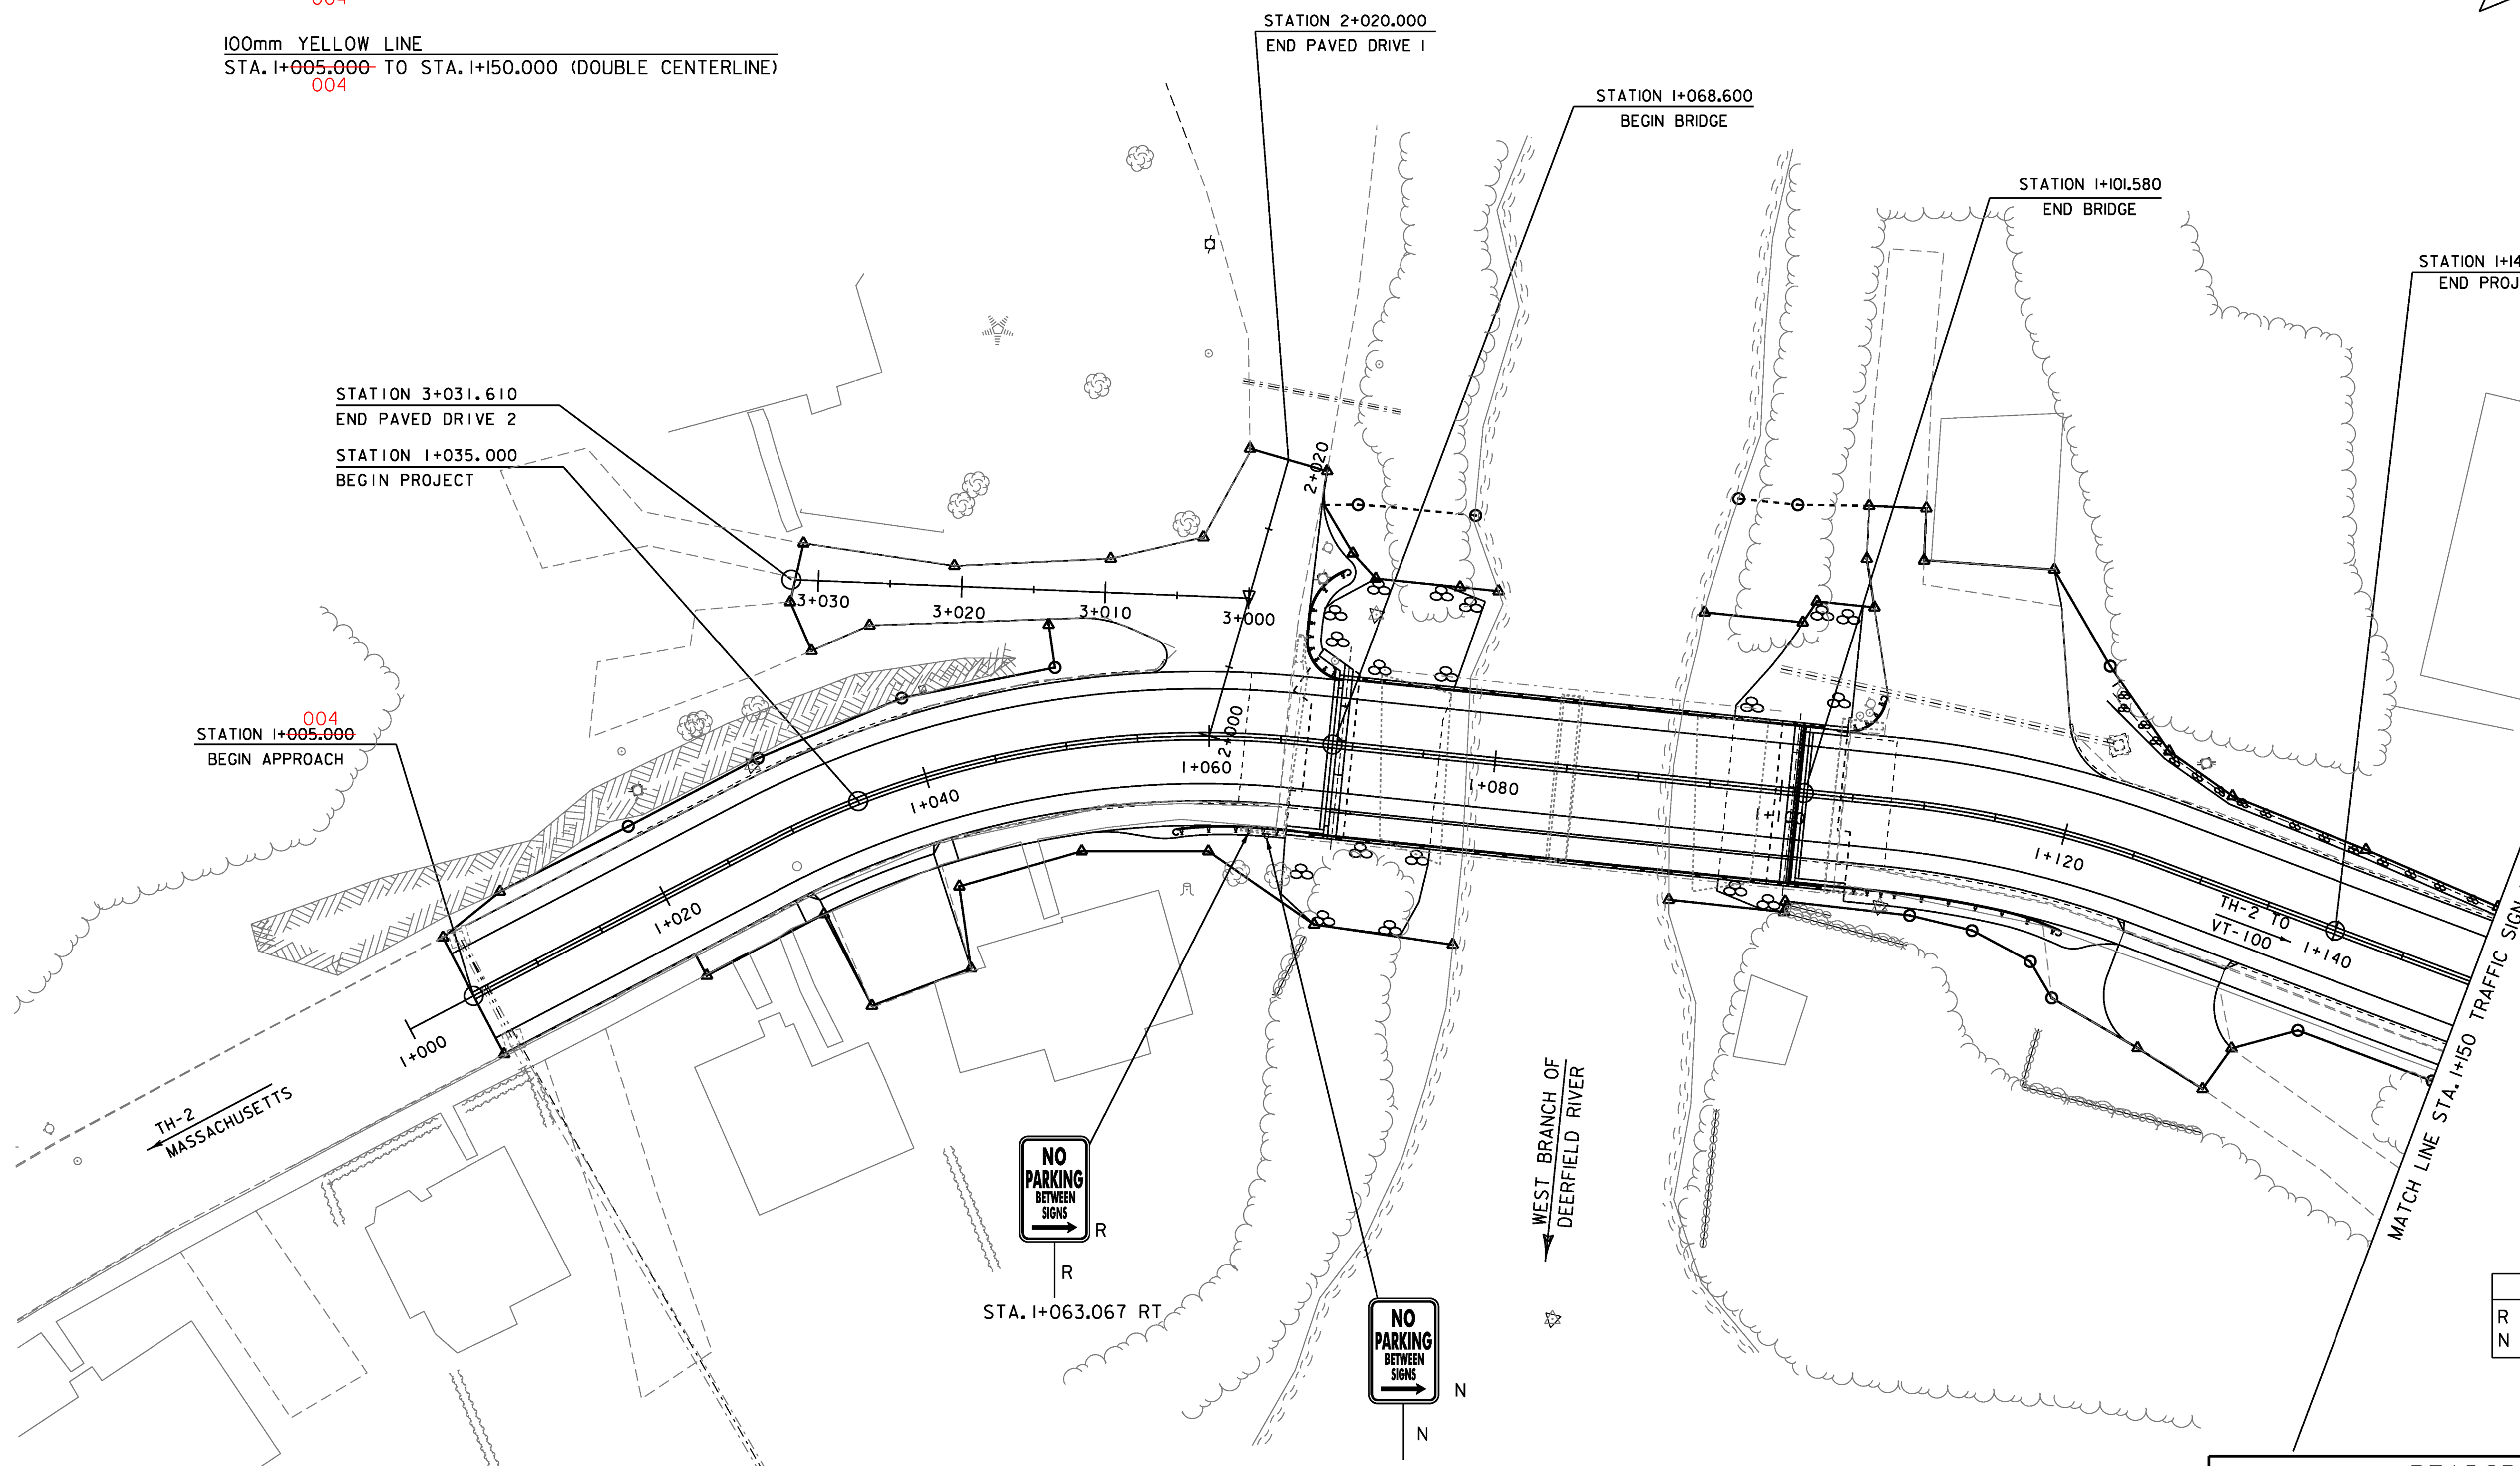

STATION 3+031.610
 END PAVED DRIVE 2
 STATION 1+035.000
 BEGIN PROJECT

STATION 1+005.000
 BEGIN APPROACH
 004

STATION 2+020.000
 END PAVED DRIVE 1

STATION 1+068.600
 BEGIN BRIDGE


STATION 1+101.580
 END BRIDGE

STATION 1+140.000
 END PROJECT

NO PARKING BETWEEN SIGNS
 R
 STA. 1+063.067 RT

NO PARKING BETWEEN SIGNS
 N
 STA. 1+064.500
 OFFSET 6.800 RT

SIGN LEGEND	
R	= REMOVE
N	= NEW

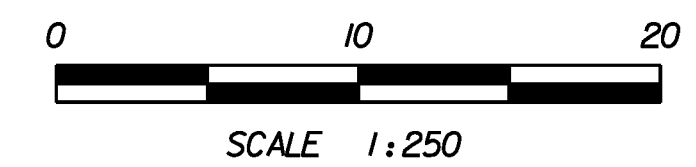

PROJECT NAME: READSBORO
 PROJECT NUMBER: BRF 0105 (3)

FILE NAME: 89J088/STR/s89J088trf.dgn
 PROJECT LEADER: J. LACROIX
 DESIGNED BY: W. PELLETIER
 TRAFFIC SIGN LAYOUT SHEET 1

PLOT DATE: 07-MAR-2012
 DRAWN BY: G. ROKES
 CHECKED BY: W. PELLETIER
 SHEET 25 OF 90

MATCH LINE STA. 1+150 TRAFFIC SIGN LAYOUT SHEET 2

TH-2 TO VT-100
 1+140

TH-2
 MASSACHUSETTS

WEST BRANCH OF
 DEERFIELD RIVER