
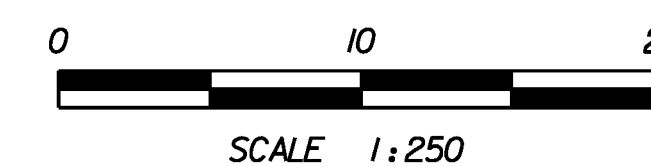
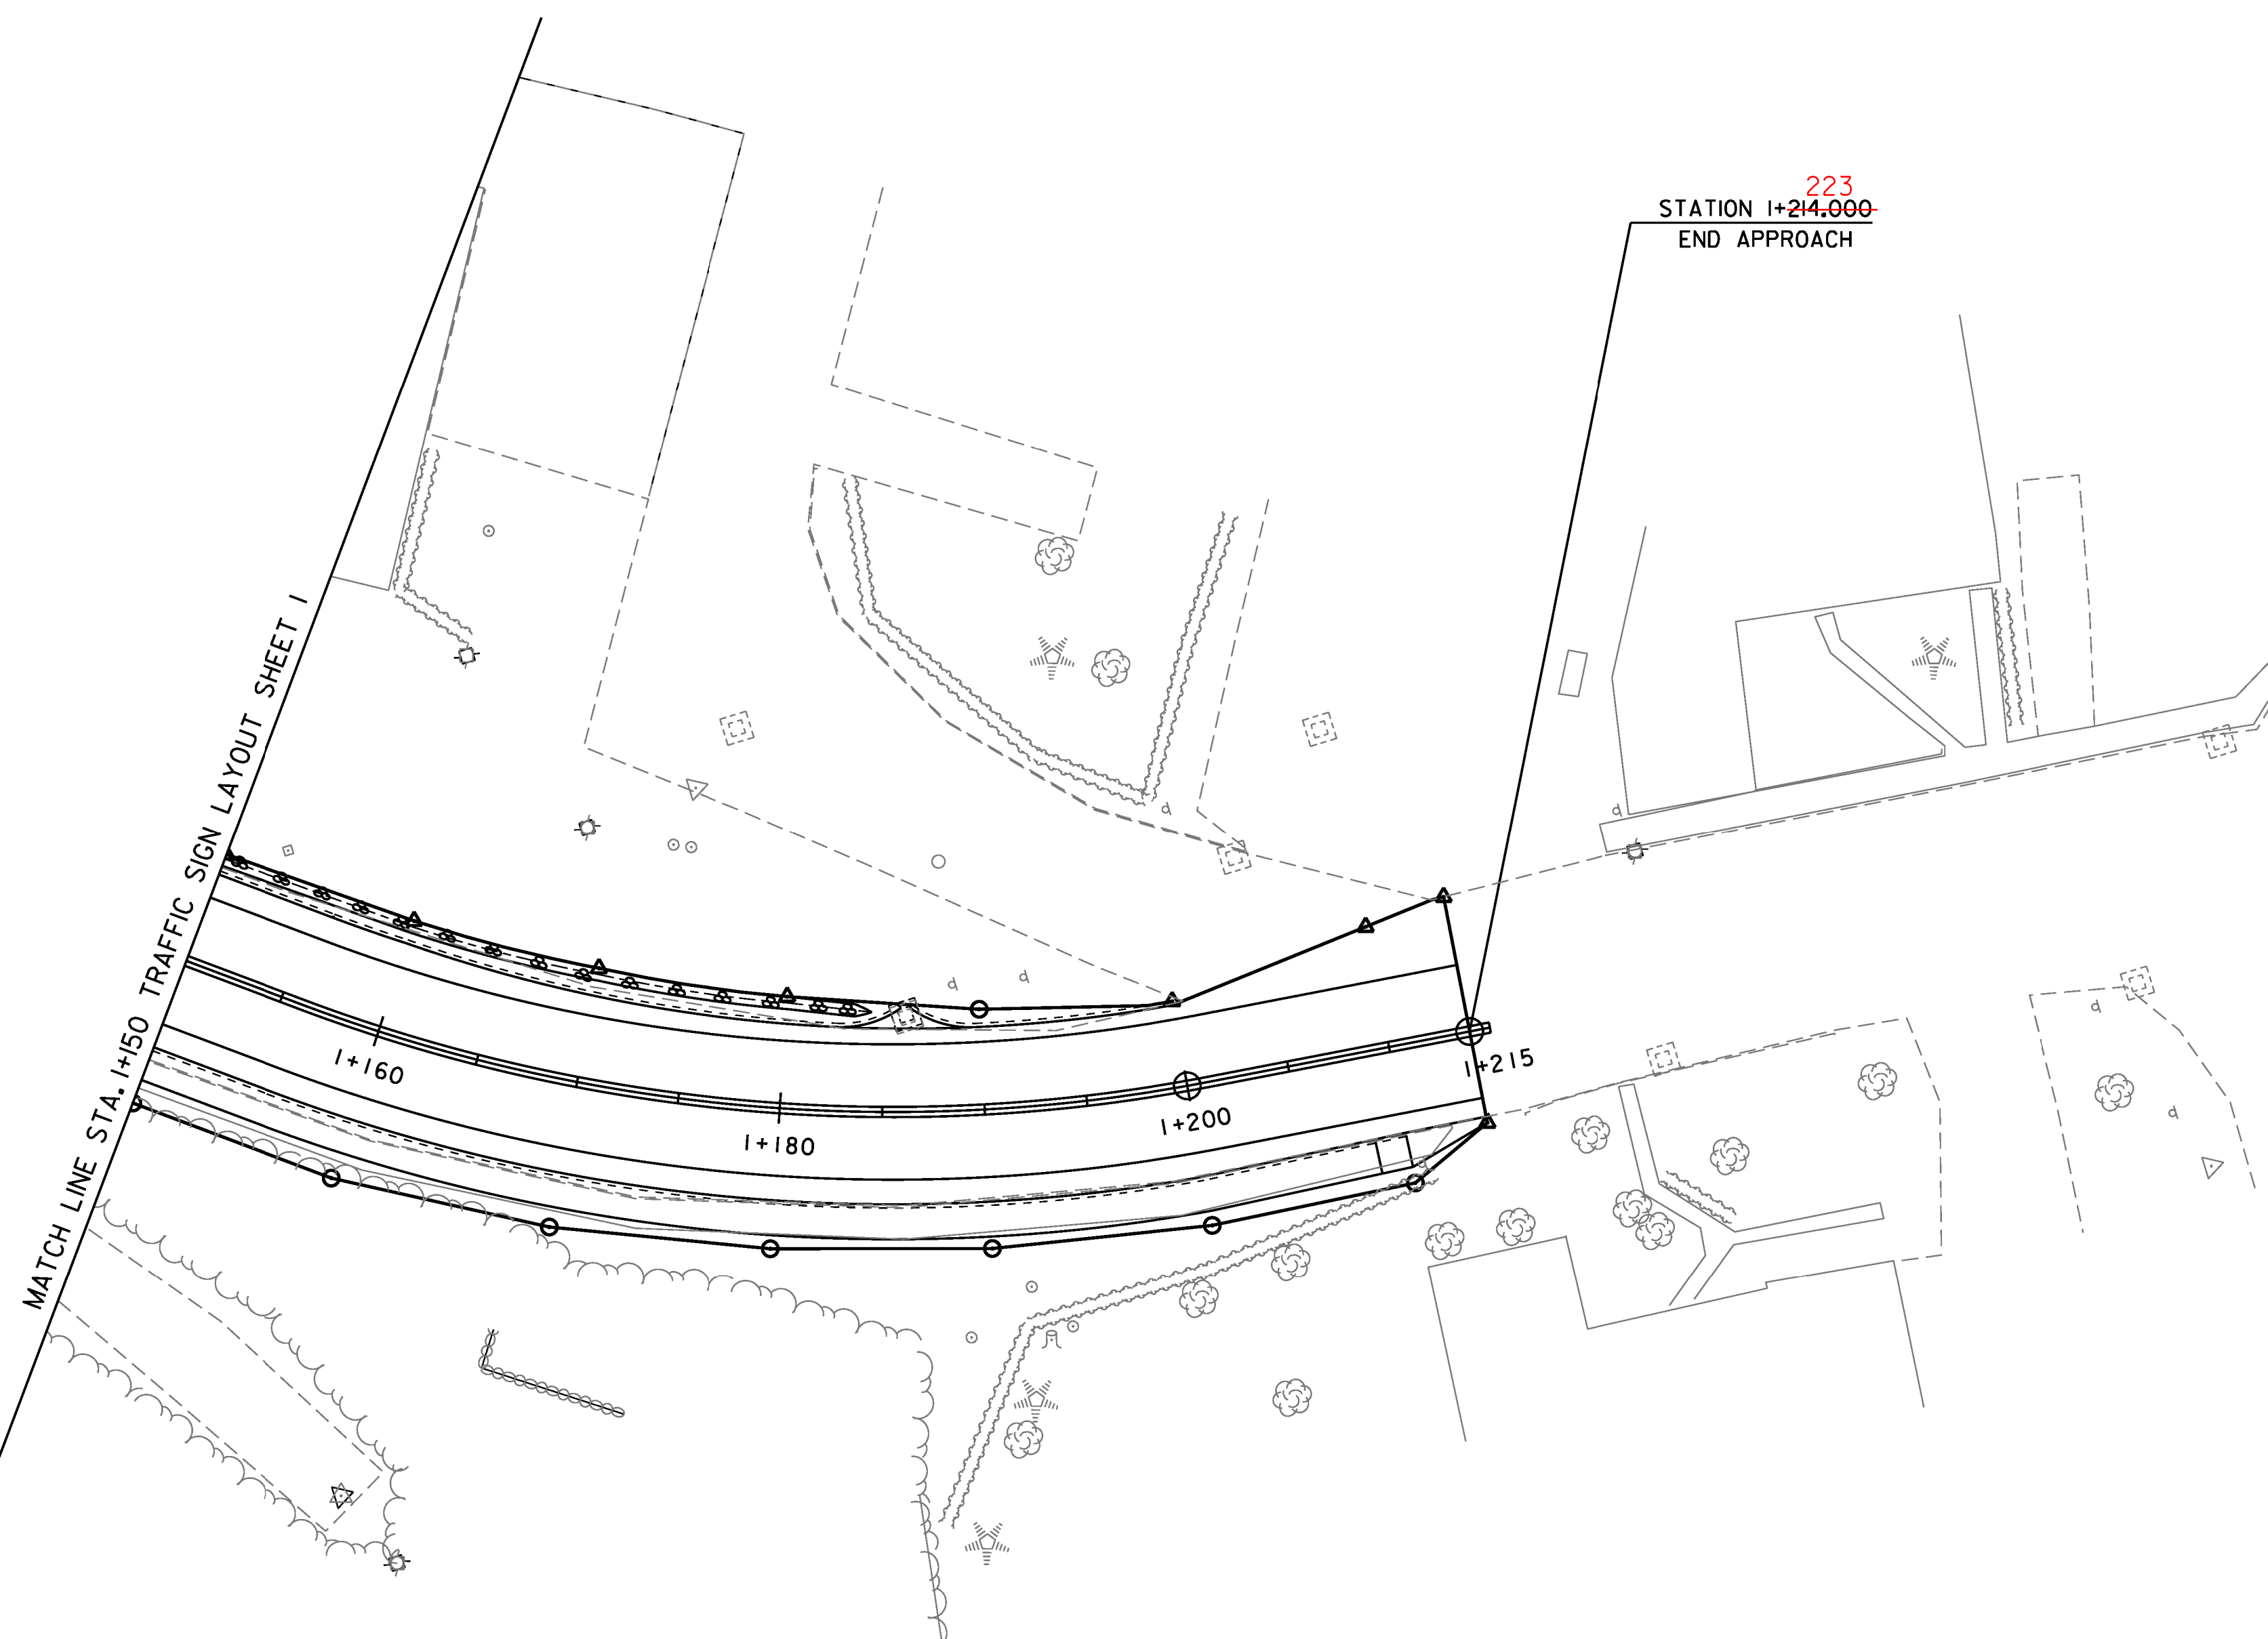


100mm WHITE LINE
 STA. 1+150.000 TO STA. 1+214.000 (LT/RT)
 195

100mm YELLOW LINE
 STA. 1+150.000 TO STA. 1+214.000 (DOUBLE CENTERLINE)
 246

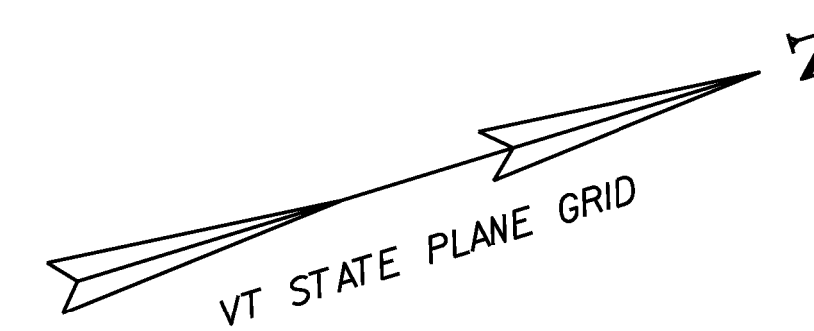

PROJECT NAME:	READSBORO	PLOT DATE:	07-MAR-2012
PROJECT NUMBER:	BRF 0105 (3)	DRAWN BY:	G. ROKES
FILE NAME:	89J088/STR/s89J088+trf.dgn	CHECKED BY:	W. PELLETIER
PROJECT LEADER:	J. LACROIX	SHEET	26 OF 90
DESIGNED BY:	W. PELLETIER		
TRAFFIC SIGN LAYOUT SHEET 2			