


**EXPANSION BEARING-ABUTMENT 2**

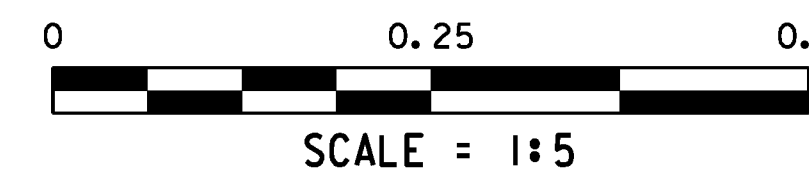

PROJECT NAME: READSBORO  
PROJECT NUMBER: BRF 0105 (3)

FILE NAME: 89J088/STR/s89J088brg.dgn  
PROJECT LEADER: J. LACROIX  
DESIGNED BY: W. PELLETIER  
EXPANSION BEARING ABUTMENT 2

PLOT DATE: 07-MAR-2012  
DRAWN BY: W. PELLETIER  
CHECKED BY: N. VANDENBERG  
SHEET 47 OF 90