

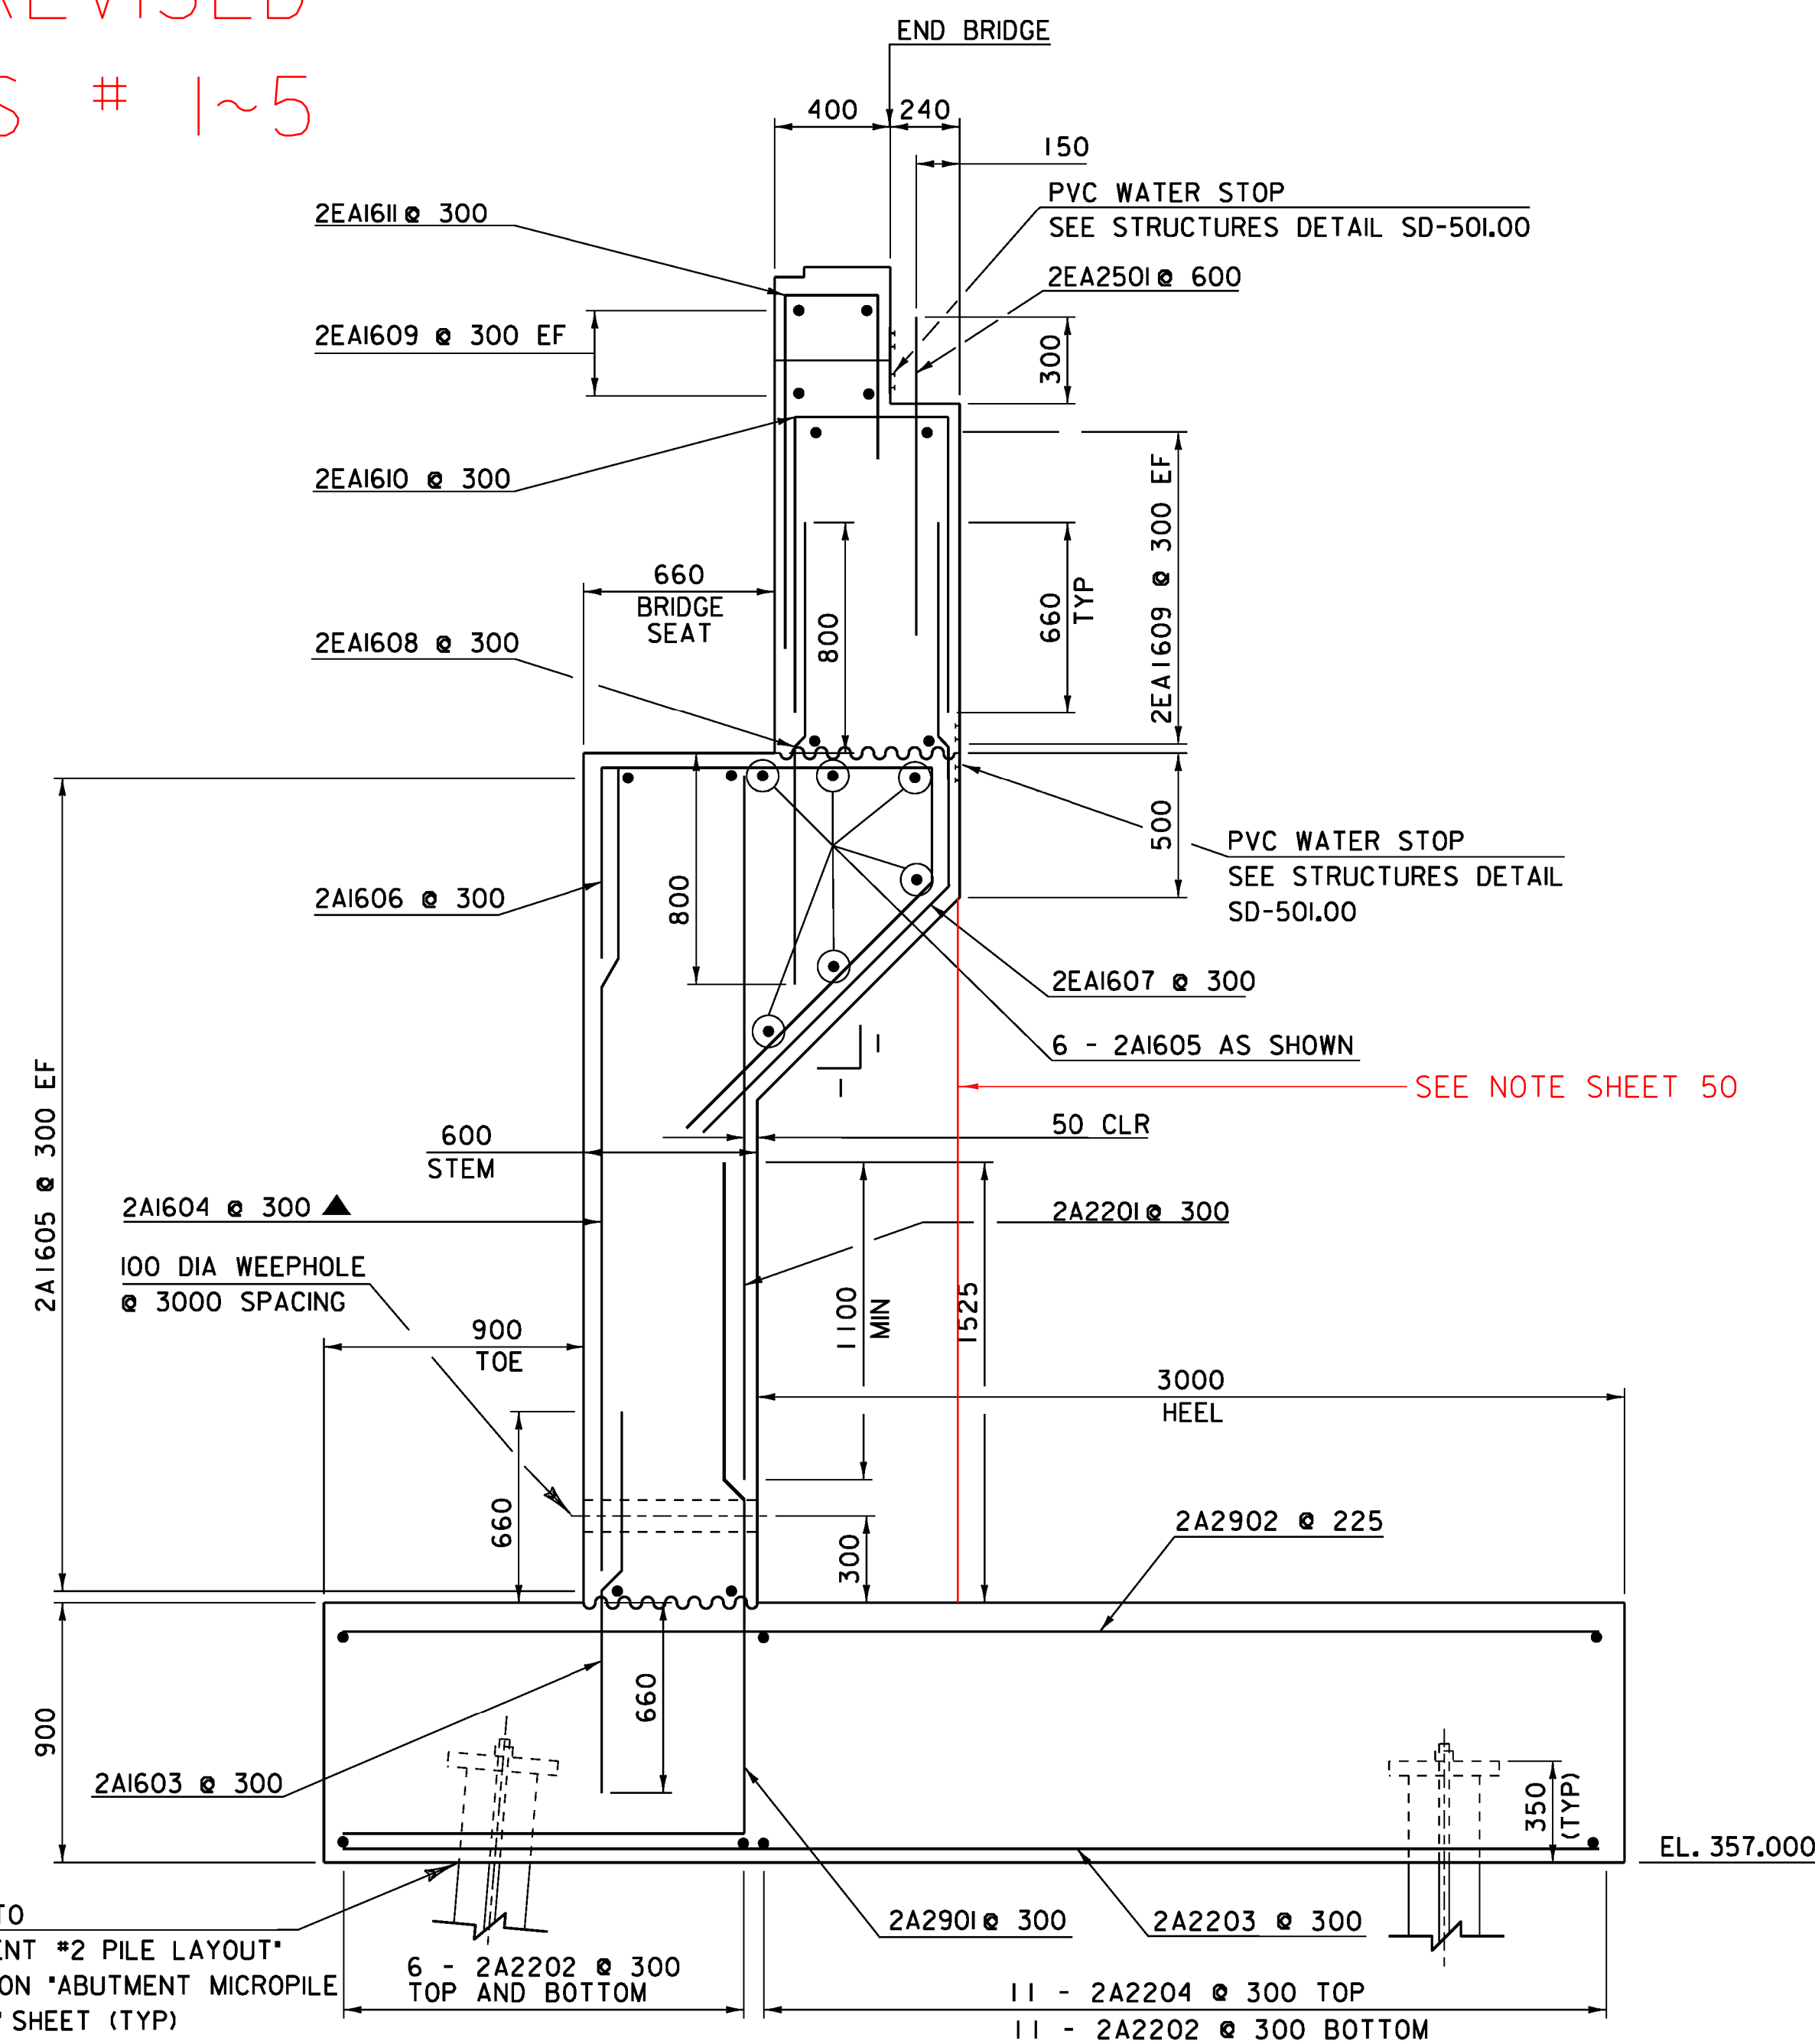
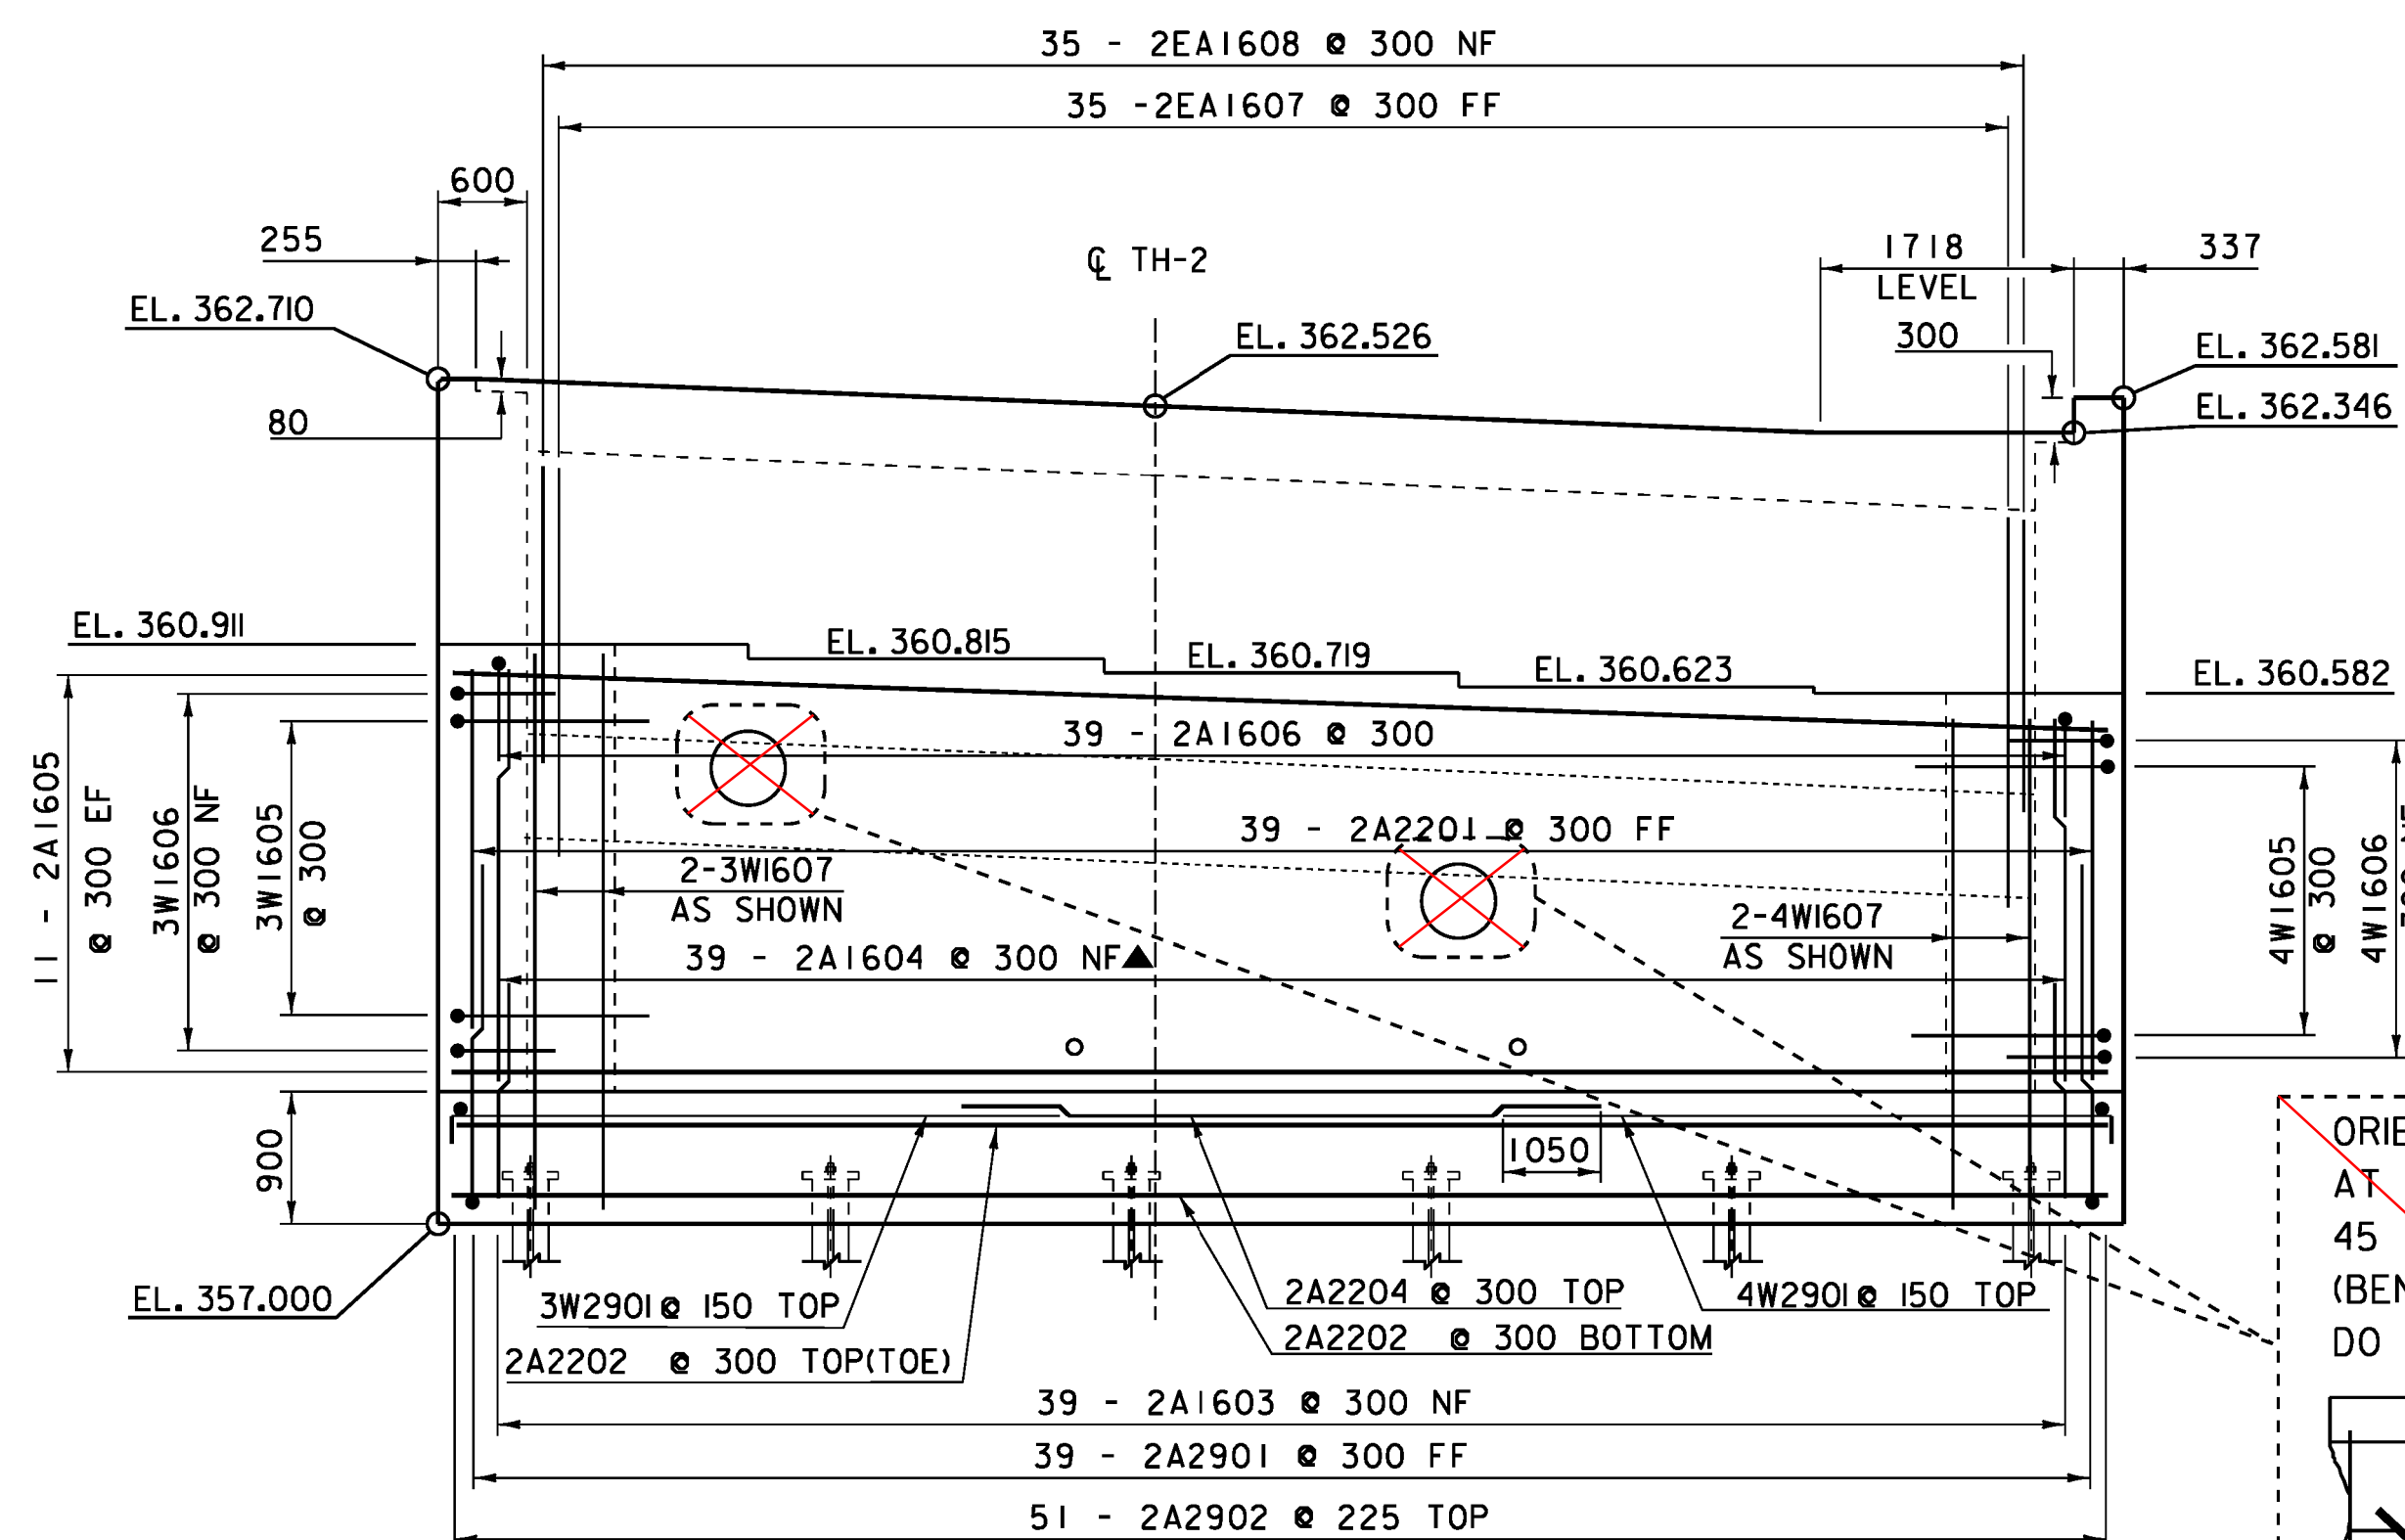


SEE REVISED
PAGES # 1~5

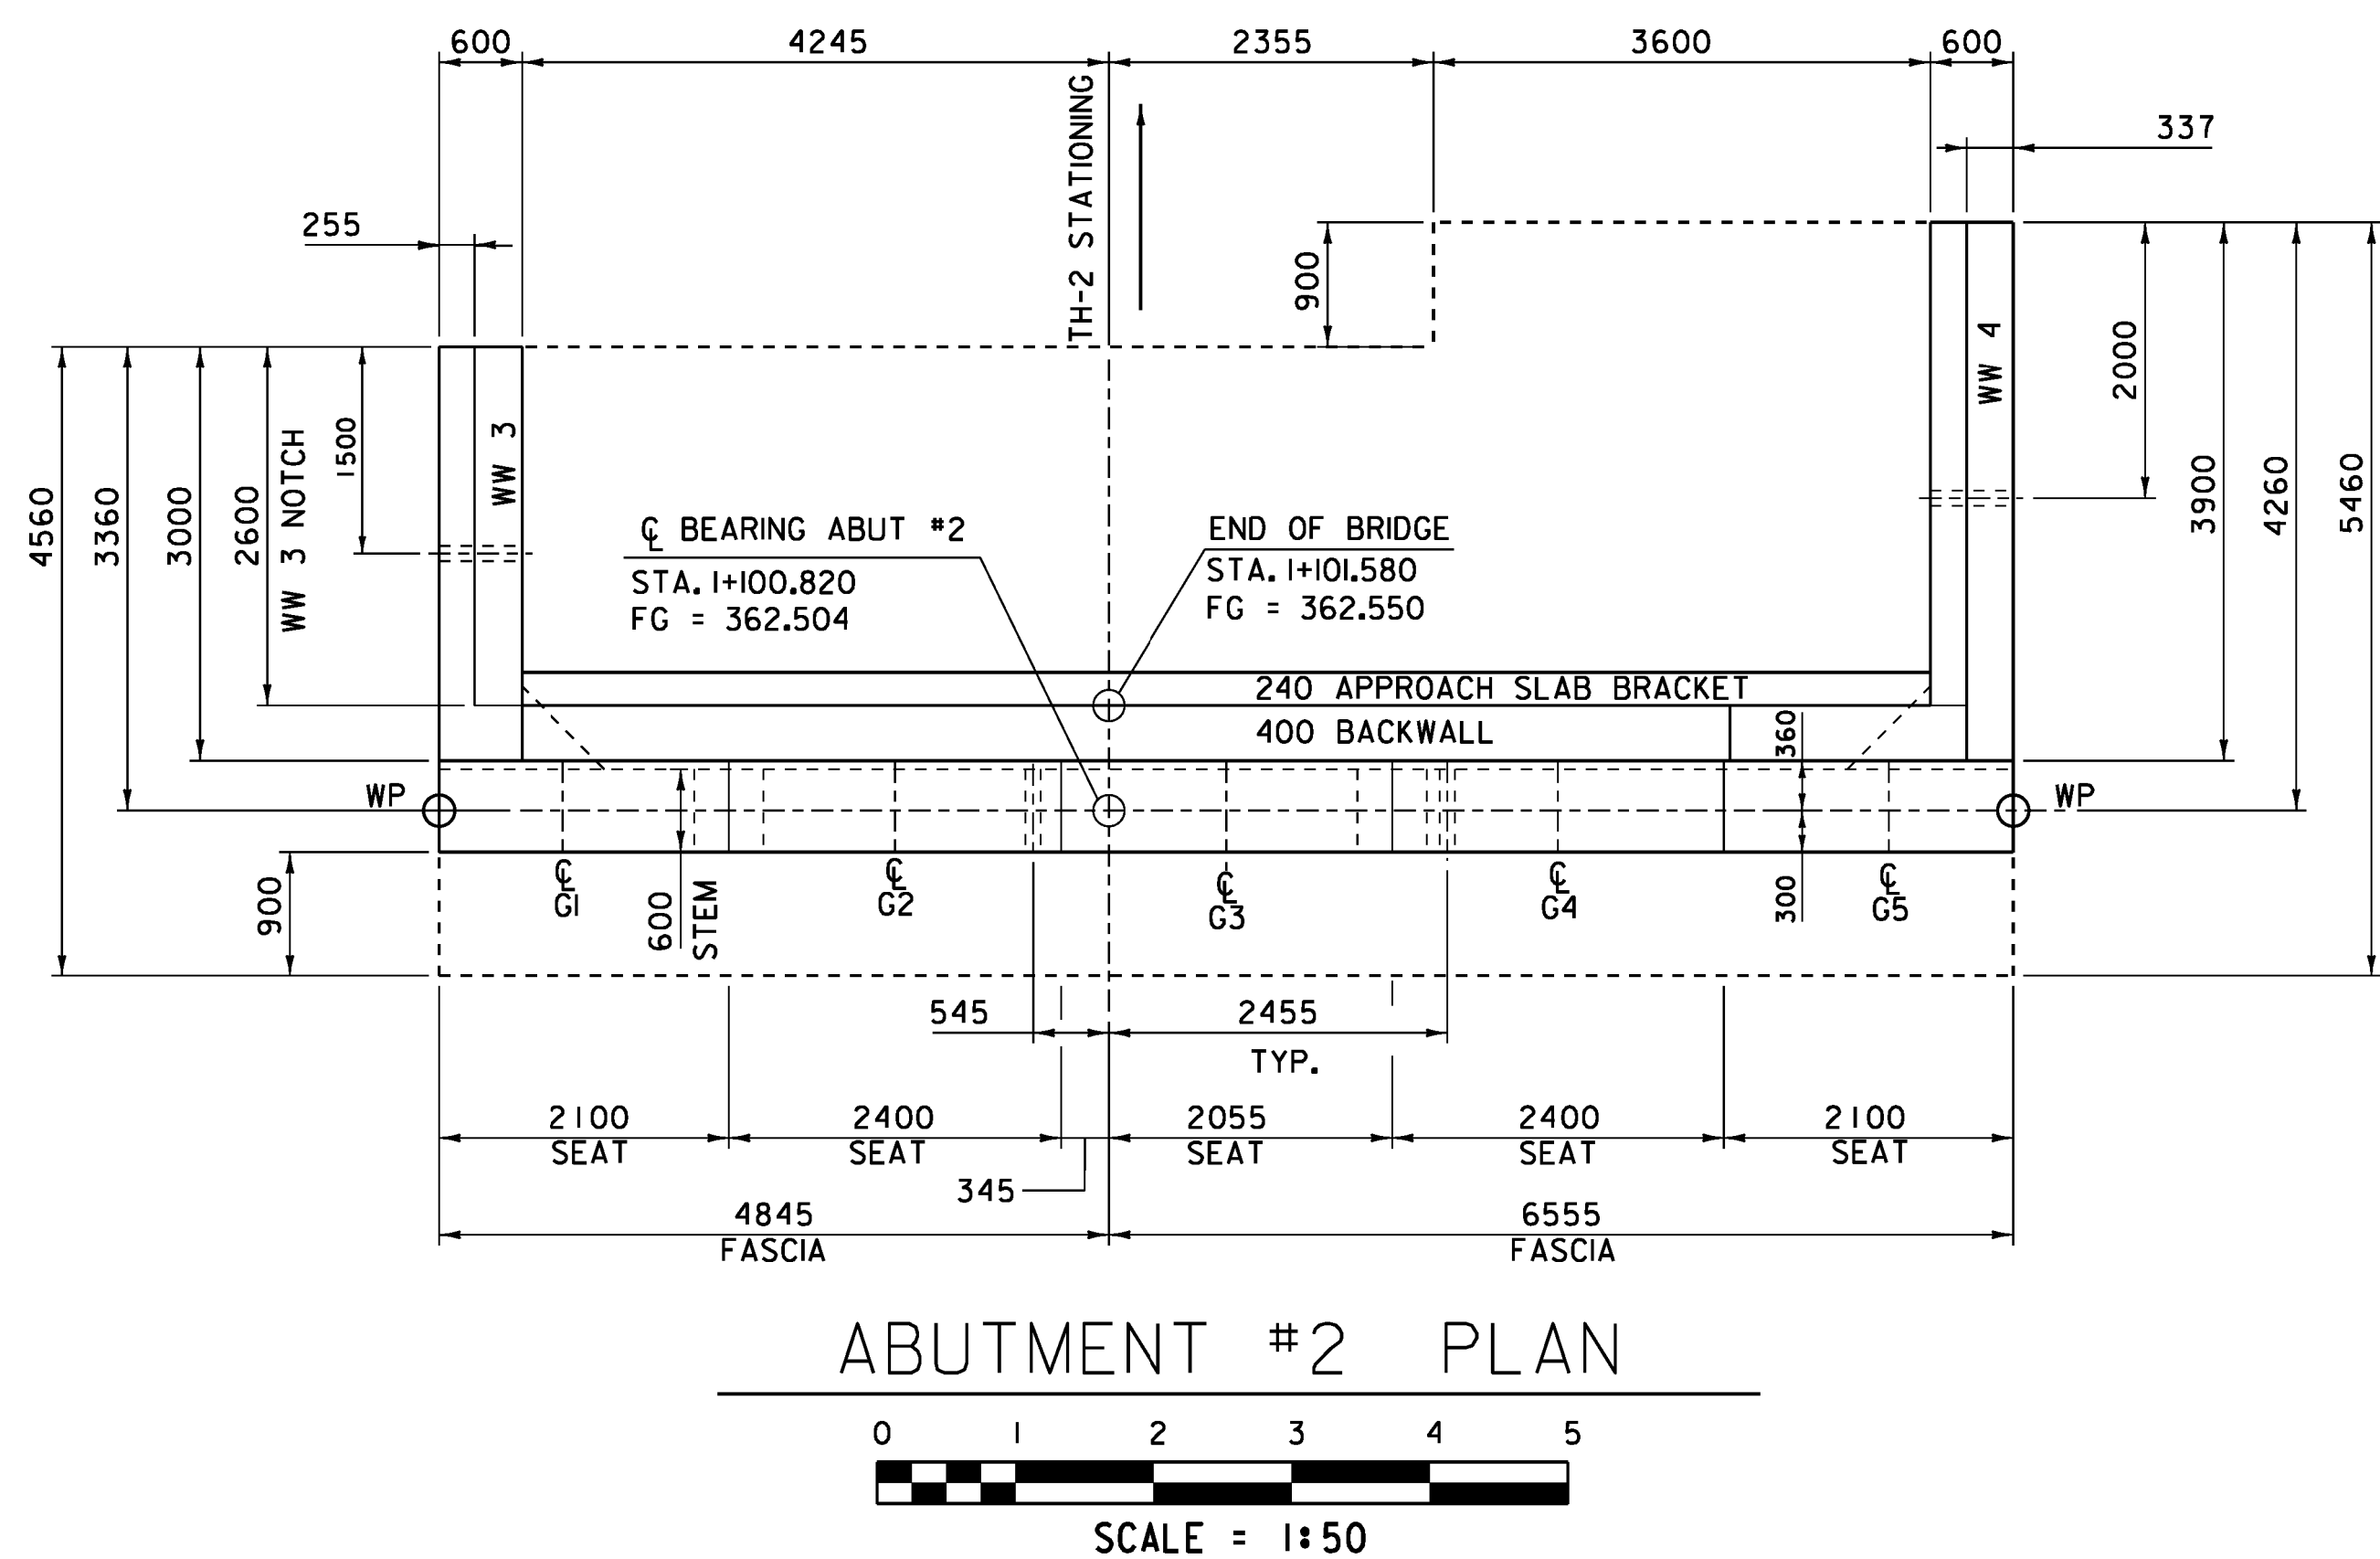


WATER AND SEWER LINES WERE RELOCATED
OUTSIDE FASCIA BEAMS. SEE CO*4 DATED 10/17/13

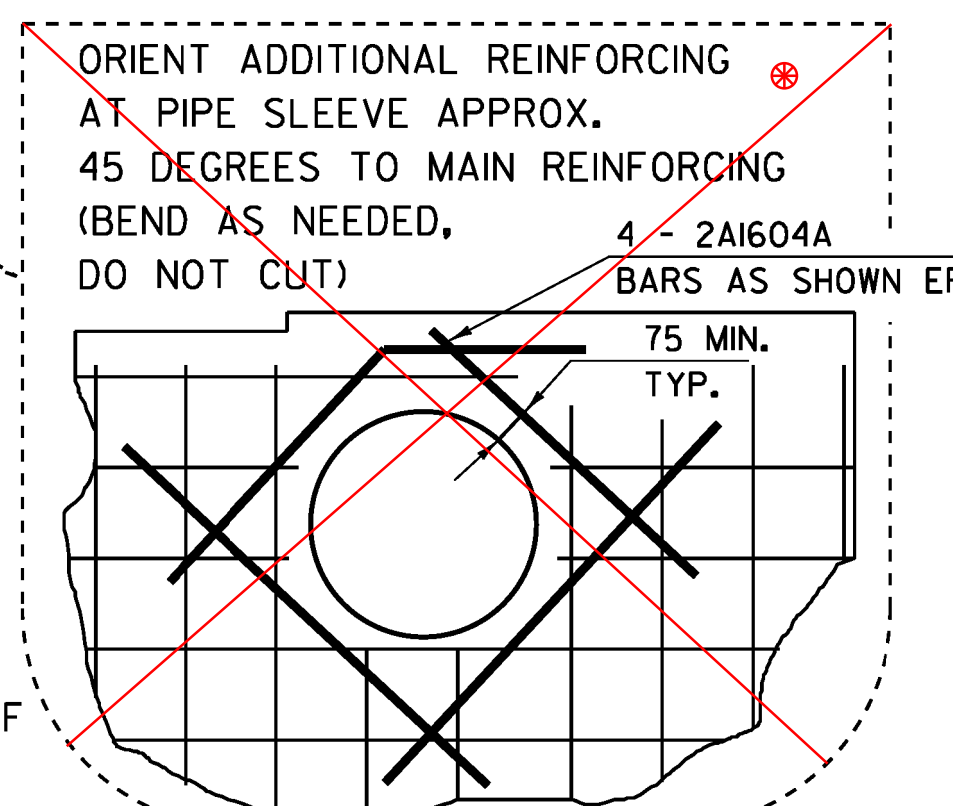

NF = NEAR FACE
FF = FAR FACE
EF = EACH FACE
▲ = CUT TO FIT IN FIELD

75 CLEAR, UNLESS OTHERWISE SPECIFIED ON THE PLANS
660 BAR LAP UNLESS OTHERWISE SPECIFIED ON THE PLANS

REFER TO CONSULTANT (DUFRESNE GROUP)
DRAWING C2 FOR UTILITY PIPING
LOCATIONS IN ABUTMENTS.

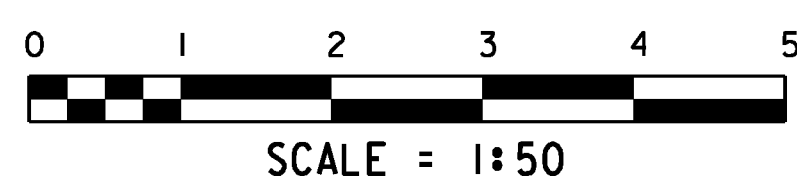

CONCEPTUAL POSITION OF
MAIN REINFORCEMENT

SEE REDESIGNED ABUTMENTS SHEET 2 OF 5

PROJECT NAME: READSBORO
PROJECT NUMBER: BRP 0105 (3)
FILE NAME: 89J088/STR/s89J088sub.dgn
PROJECT LEADER: J. LACROIX
DESIGNED BY: W. PELLETIER
ABUTMENT 2 DETAILS

PLOT DATE: 07-MAR-2012
DRAWN BY: G. ROKES
CHECKED BY: W. PELLETIER
SHEET 51 OF 90