

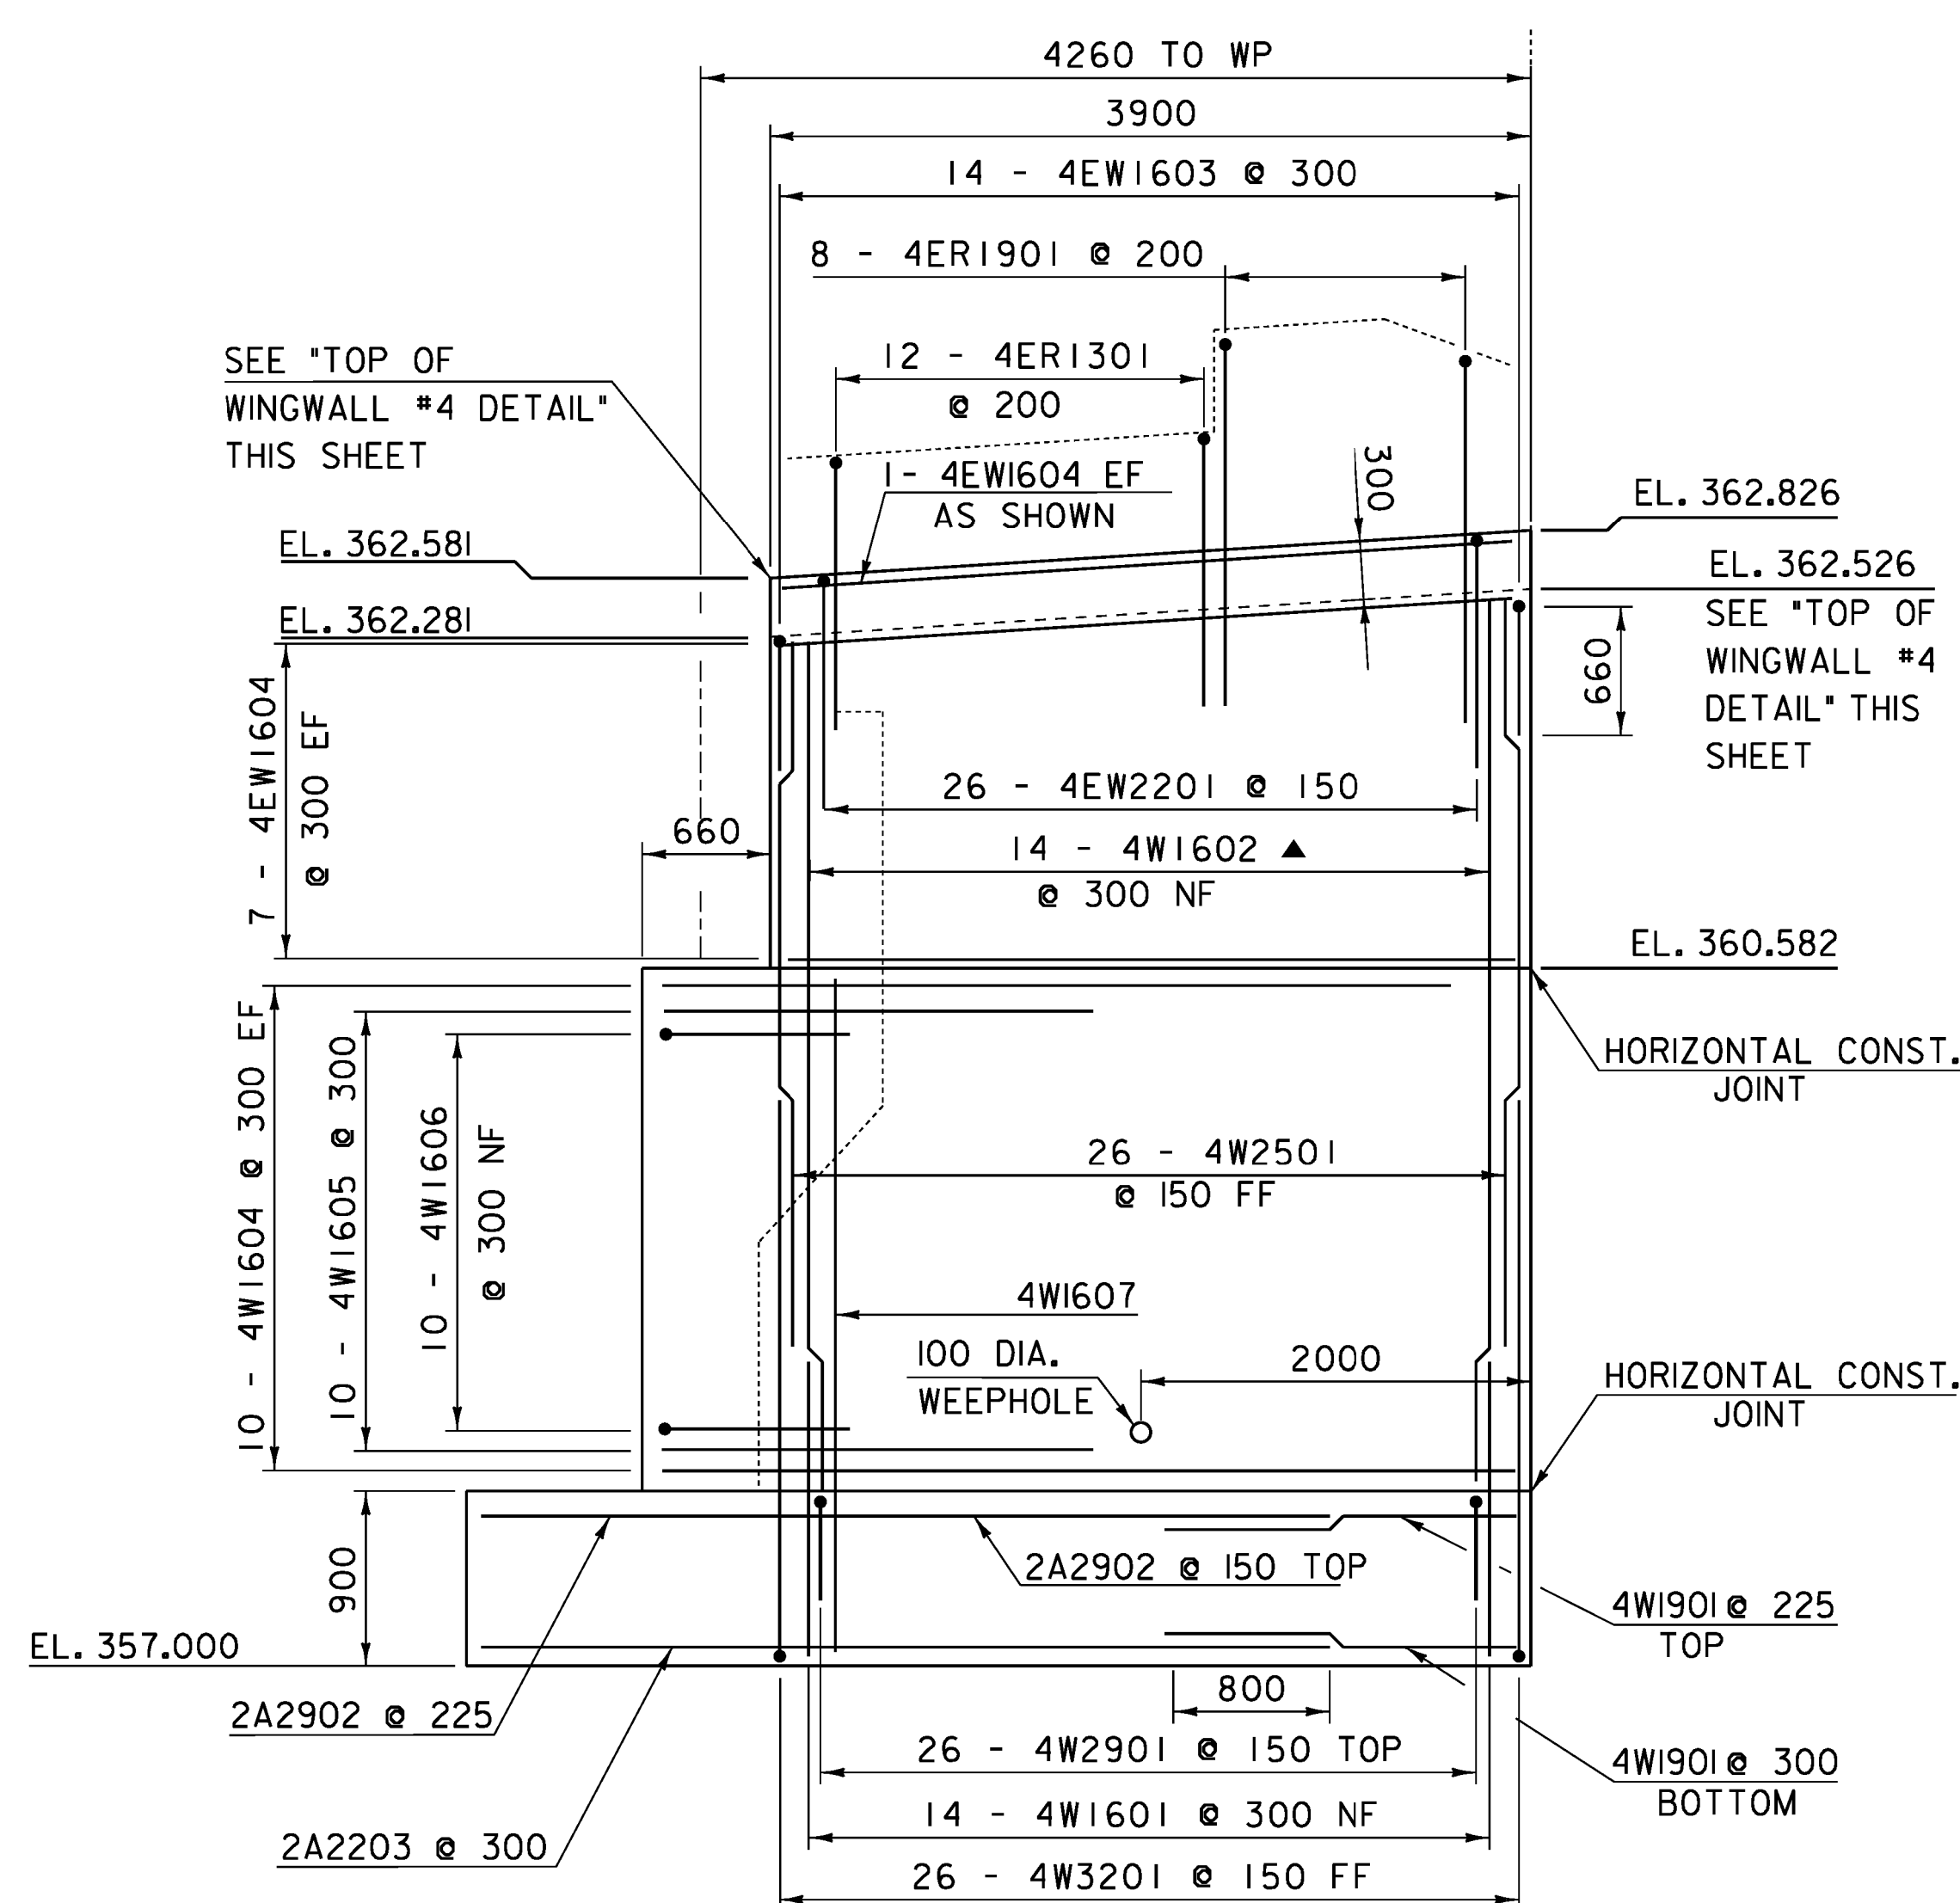



WINGWALL #3 ELEVATION

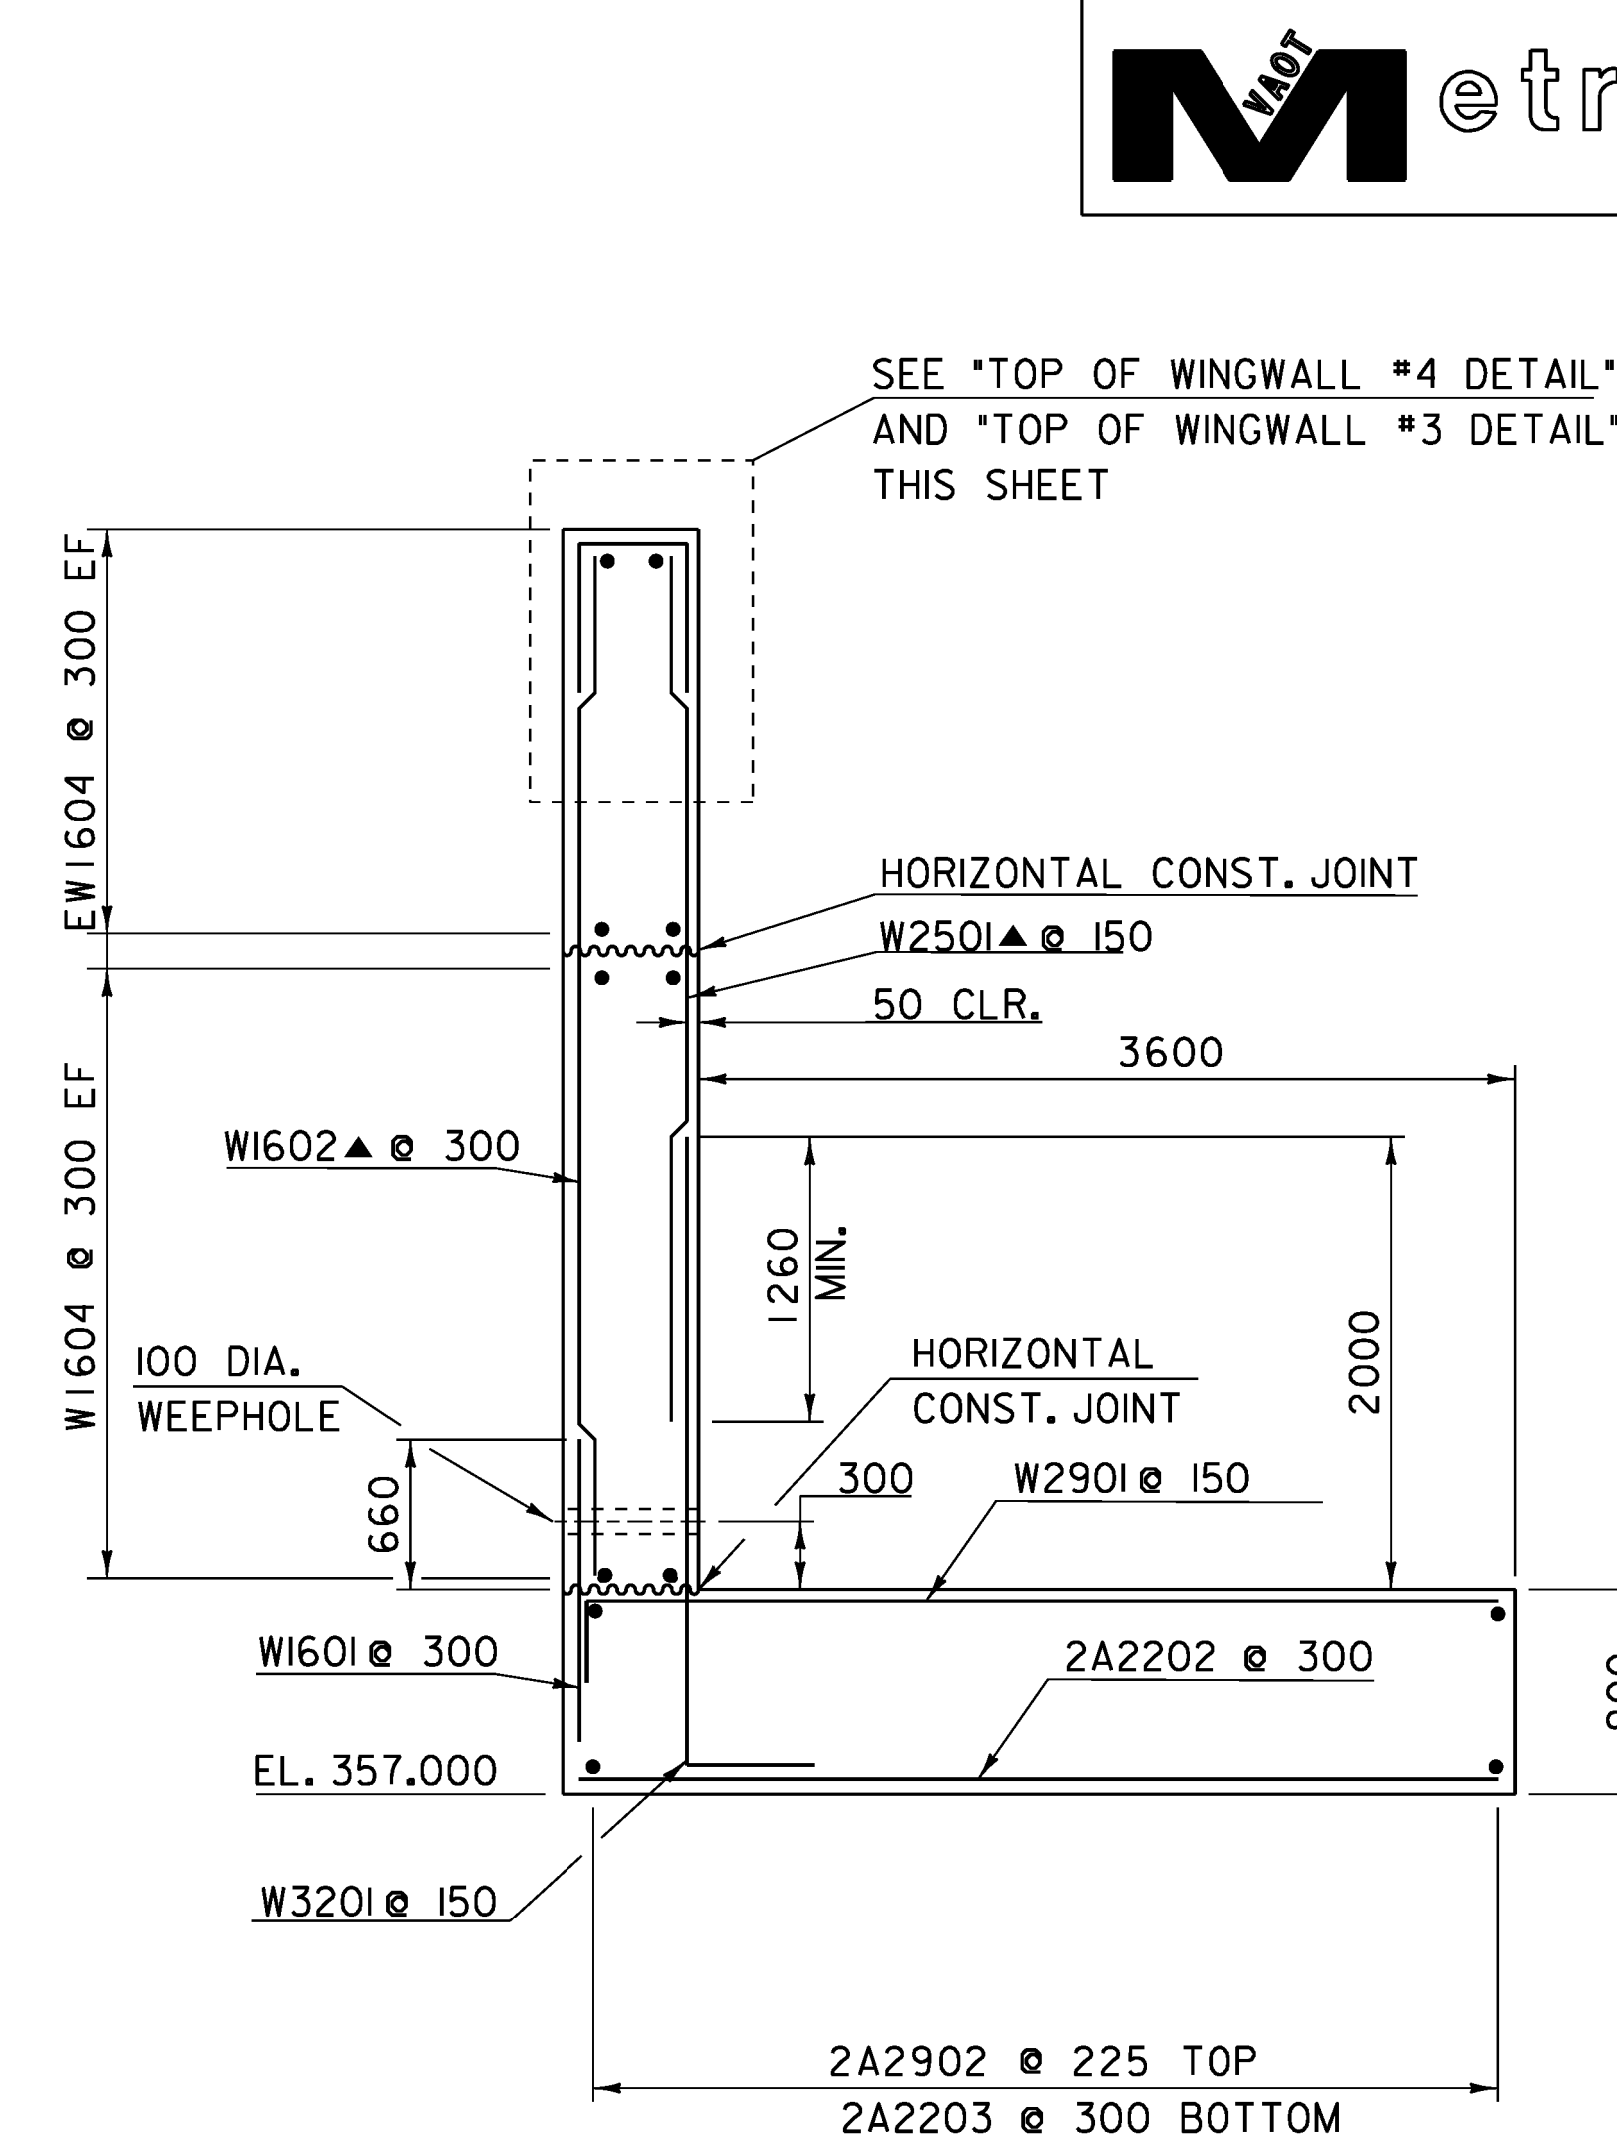


WINGWALL #4 ELEVATION

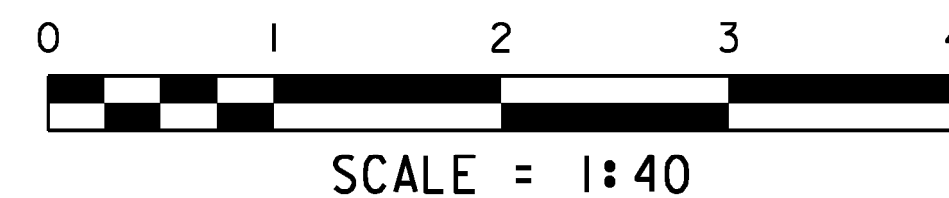


WINGWALL #3 & #4 TYPICAL

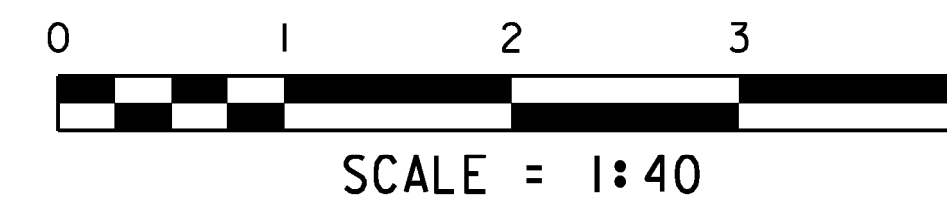


SEE REDESIGNED ABUTMENTS SHEET 4 OF 5

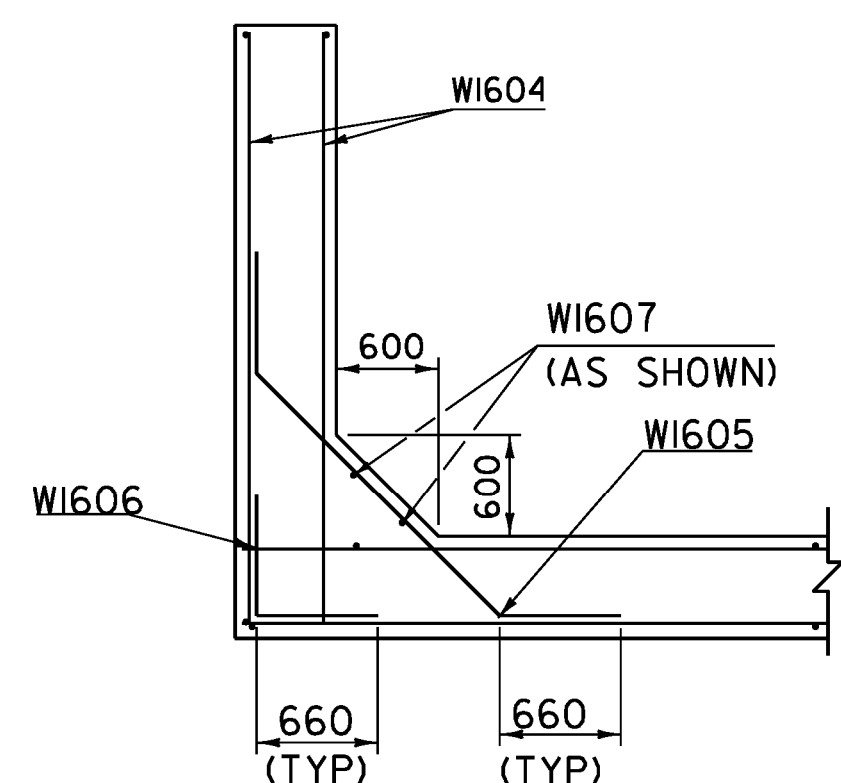


WINGWALL #2, #3, #4  
CORNER DETAIL  
(BELOW BRIDGE SEAT)  
NTS

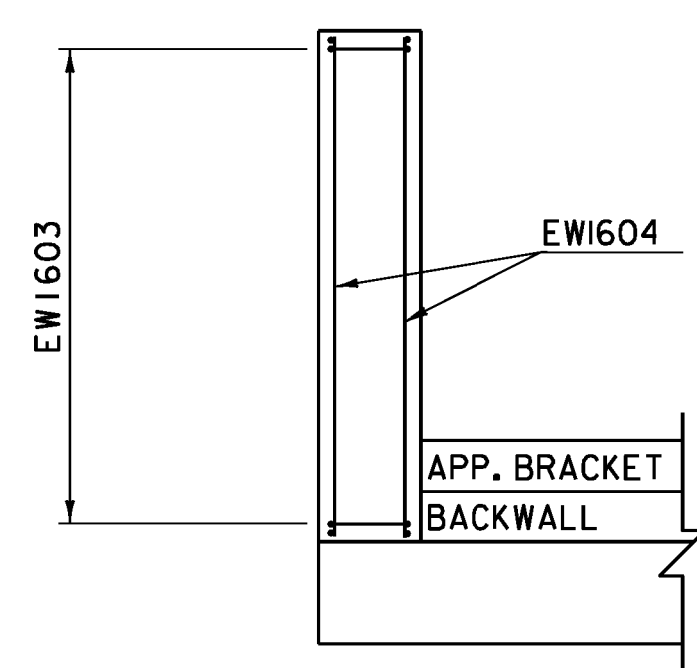

WINGWALL #2, #3, #4  
CORNER DETAIL  
(ABOVE BRIDGE SEAT)  
NTS

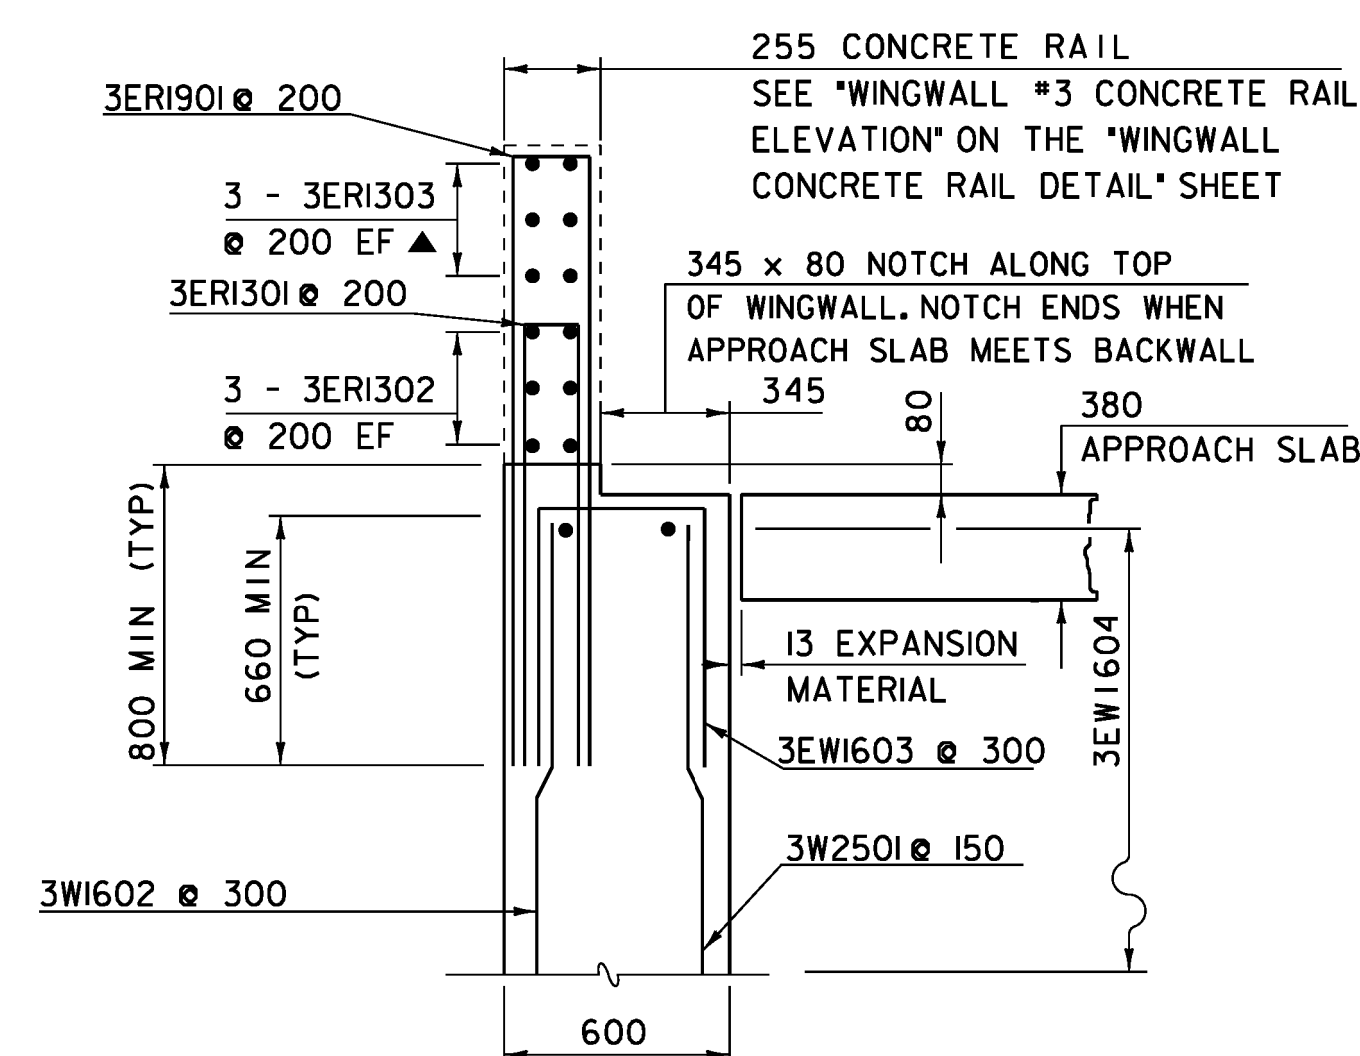

TOP OF WINGWALL #3 DETAIL  
NTS

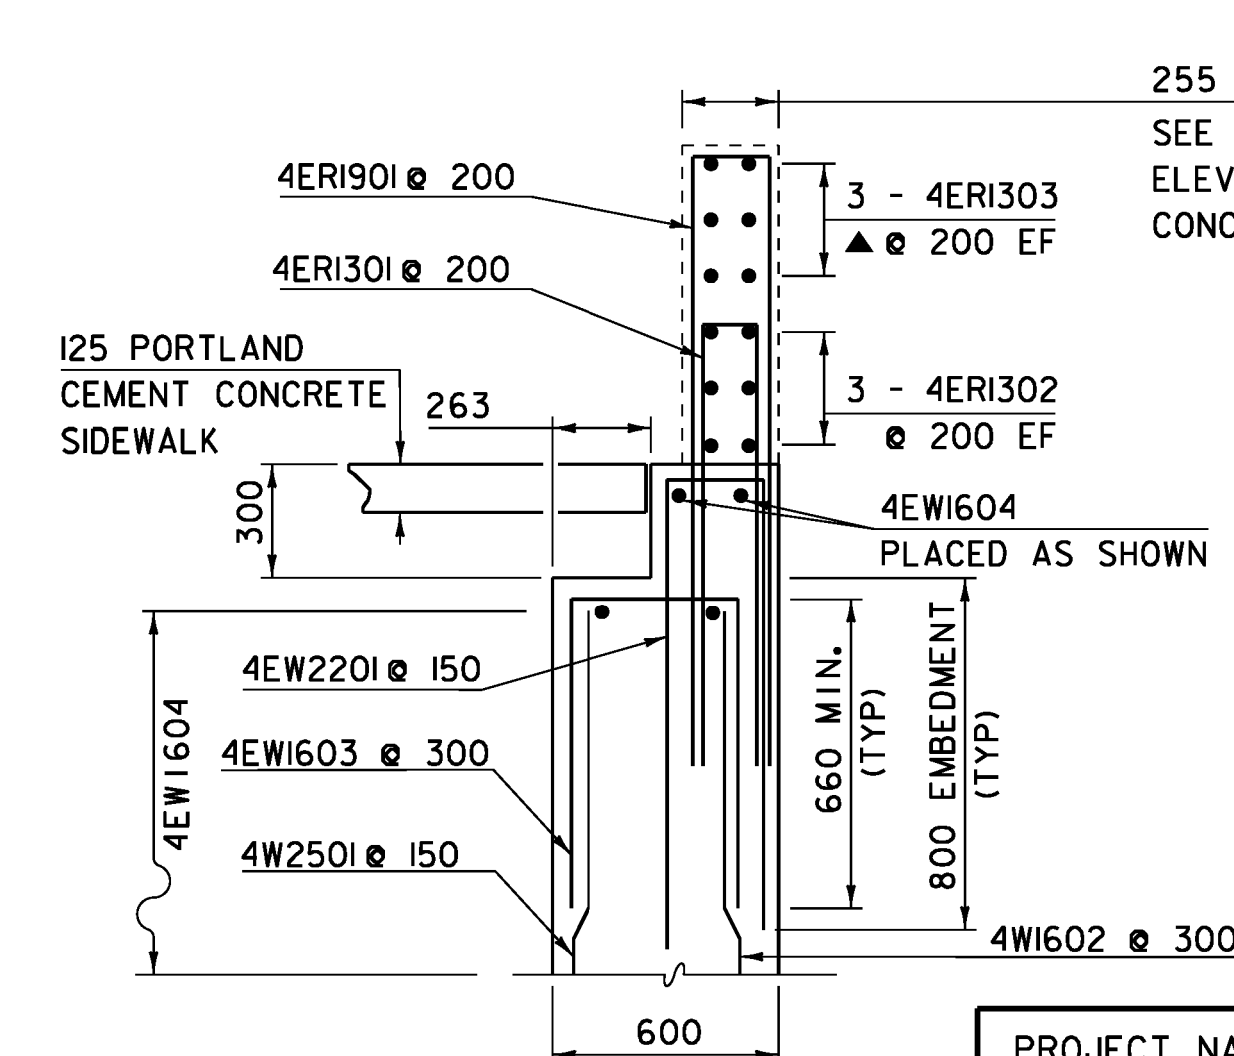

TOP OF WINGWALL #4 DETAIL  
NTS

NF = NEAR FACE  
FF = FAR FACE  
EF = EACH FACE  
▲ = CUT TO FIT IN FIELD

75 CLEAR, UNLESS OTHERWISE SPECIFIED ON THE PLANS  
660 BAR LAP UNLESS OTHERWISE SPECIFIED ON THE PLANS

PROJECT NAME: READSBORO  
PROJECT NUMBER: BRF 0105 (3)

FILE NAME: 89J088/STR/s89J088sub.dgn  
PROJECT LEADER: J. LACROIX  
DESIGNED BY: W. PELLETIER  
WINGWALL 3 AND 4 DETAILS

PLOT DATE: 07-MAR-2012  
DRAWN BY: G. ROKES  
CHECKED BY: W. PELLETIER  
SHEET 53 OF 90