

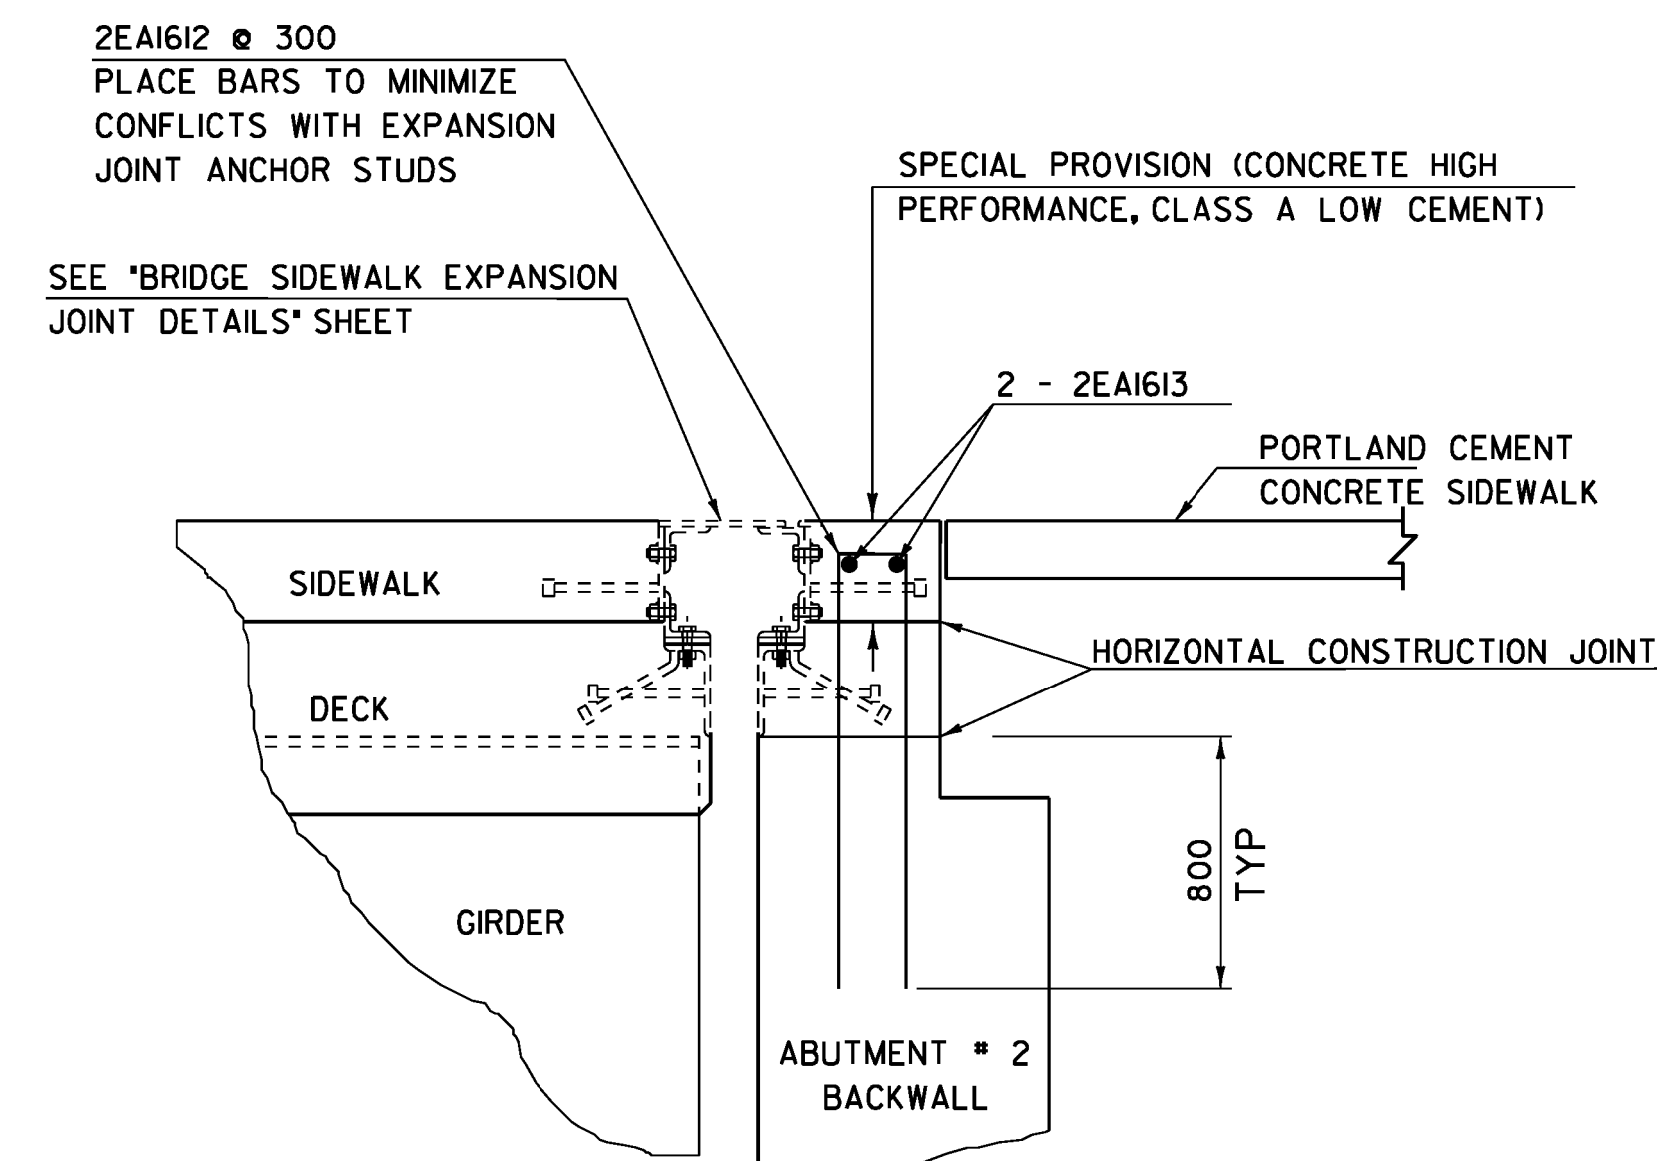


ABUTMENT #1 ELEVATION BACKWALL

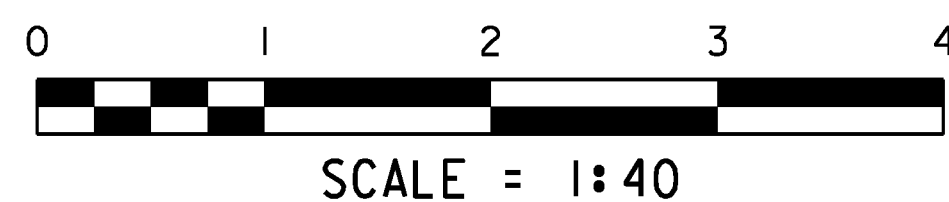

ABUTMENT #2 SIDEWALK REINFORCING IN BACKWALL TYPICAL


NTS

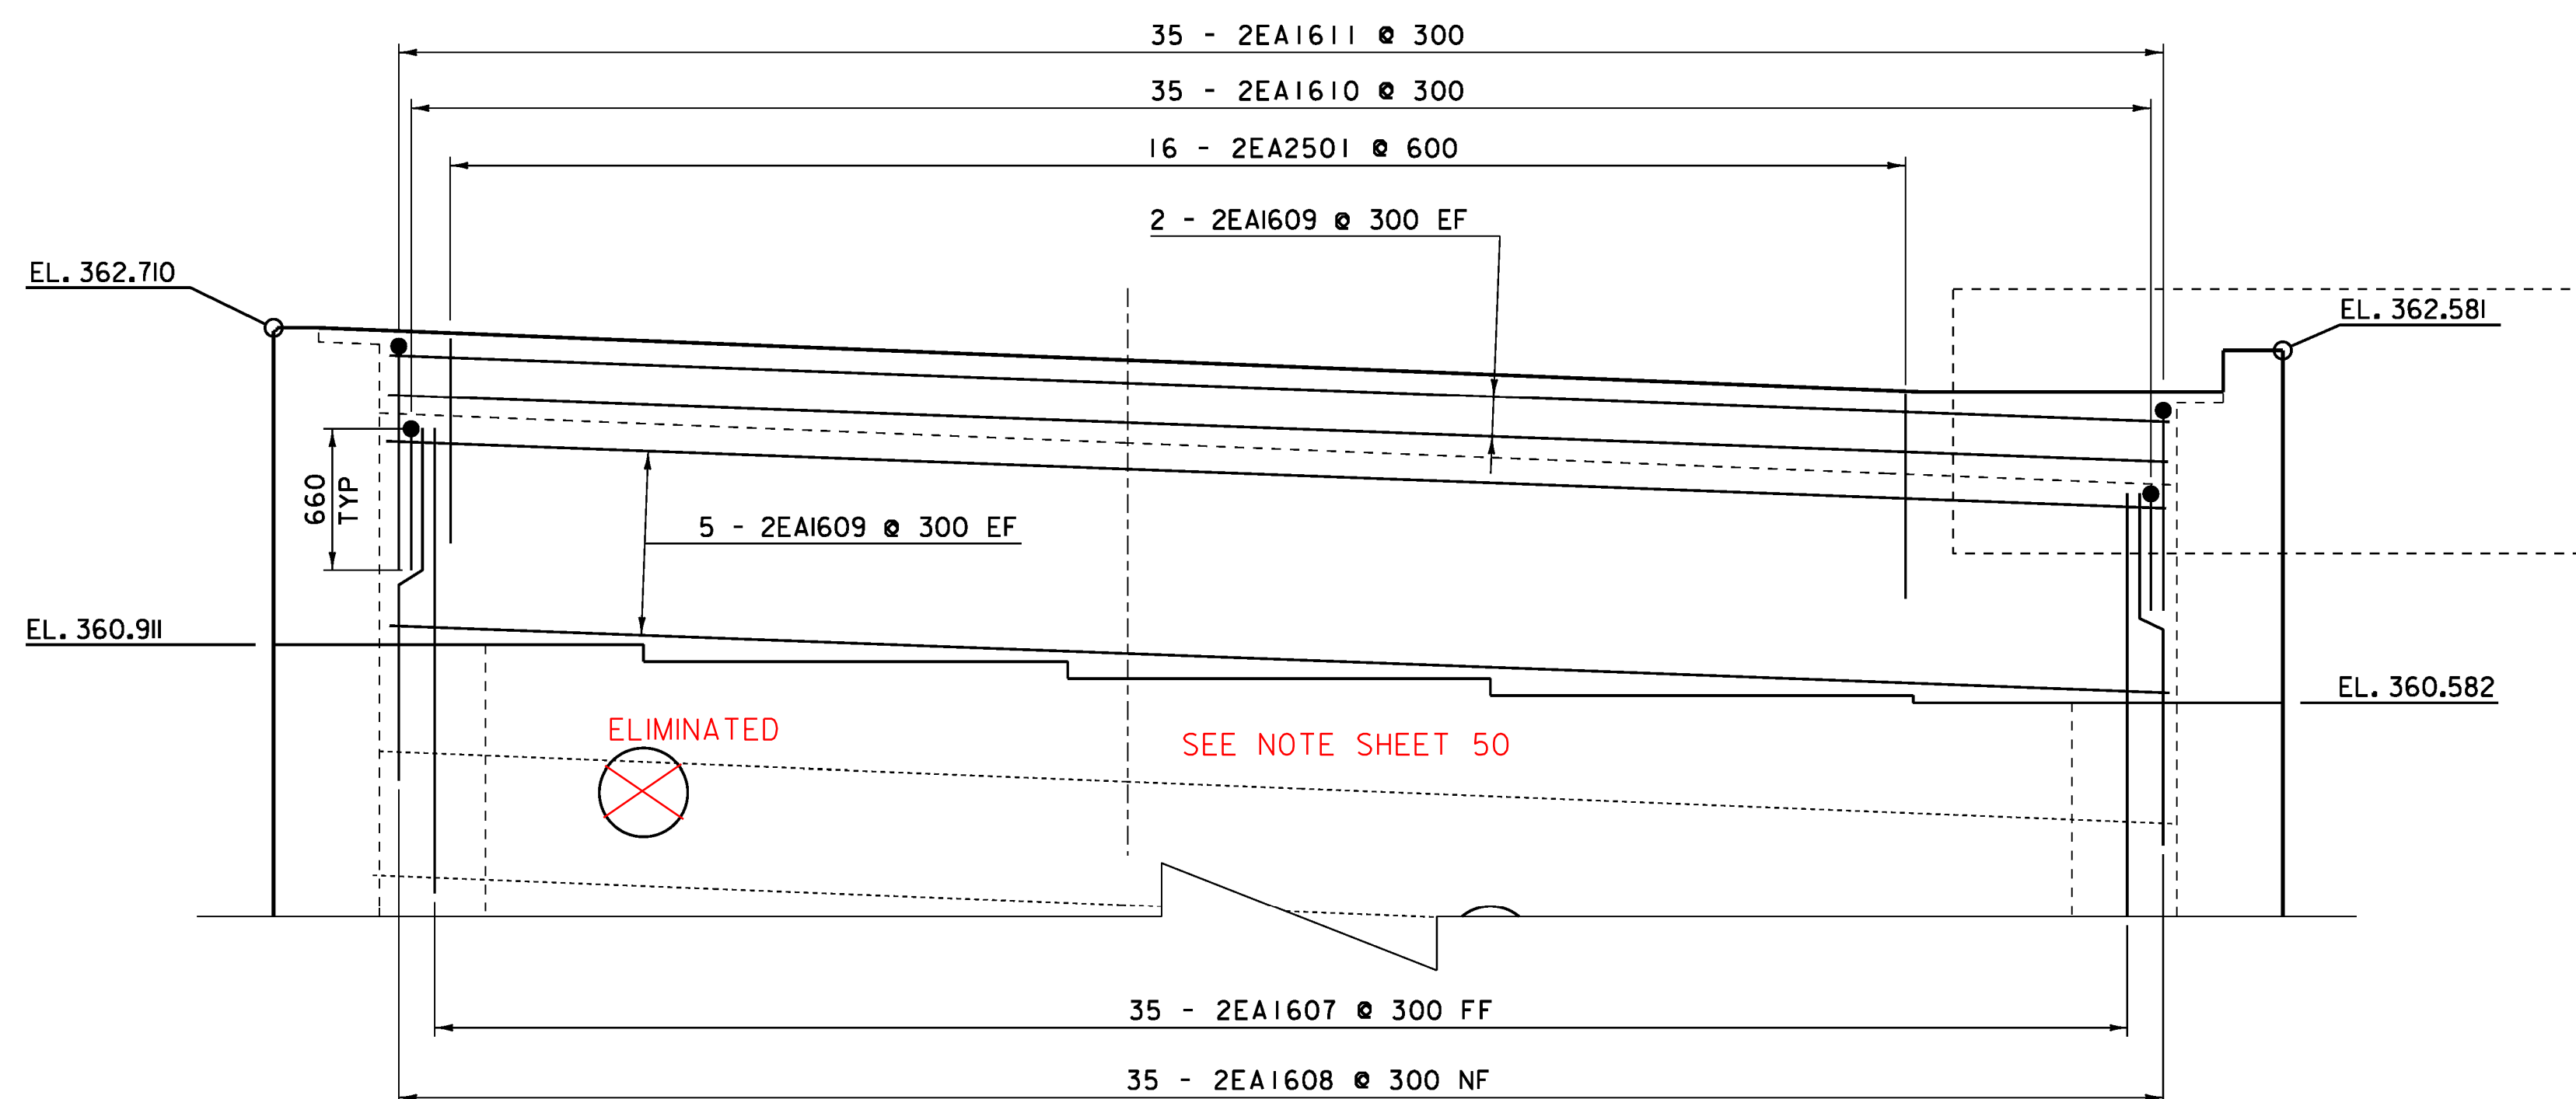

ABUTMENT #2 ELEVATION BACKWALL



SEE "ABUTMENT #2 SIDEWALK REINFORCING IN BACKWALL" DETAIL (THIS SHEET)

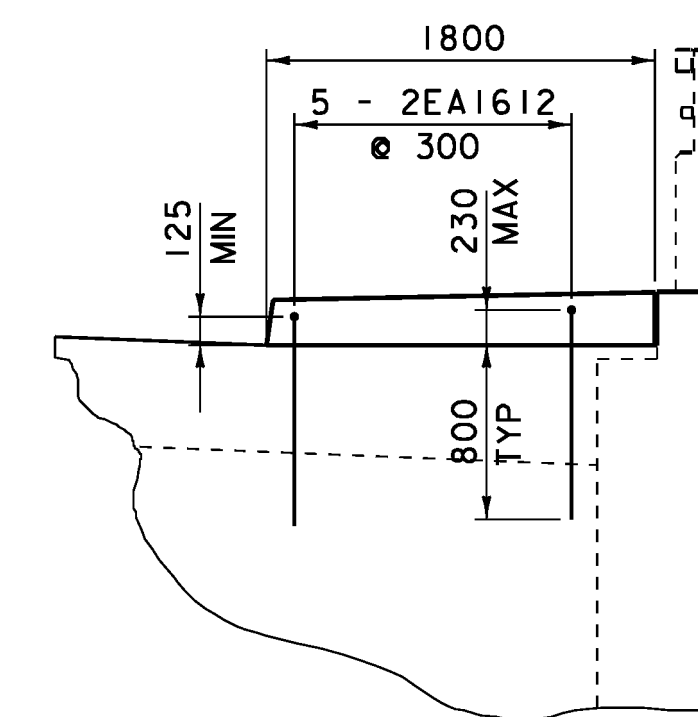

ABUTMENT #2 SIDEWALK REINFORCING IN BACKWALL

NTS

NF = NEAR FACE  
 FF = FAR FACE  
 EF = EACH FACE  
 ▲ = CUT TO FIT IN FIELD

75 CLEAR, UNLESS OTHERWISE SPECIFIED ON THE PLANS  
 660 BAR LAP UNLESS OTHERWISE SPECIFIED ON THE PLANS

PROJECT NAME:	READSBORO
PROJECT NUMBER:	BRF 0105 (3)
FILE NAME:	89J088/STR/s89J088sub.dgn
PROJECT LEADER:	J. LACROIX
DESIGNED BY:	W. PELLETIER
ABUTMENT BACKWALL DETAILS	
PLOT DATE:	07-MAR-2012
DRAWN BY:	G. ROKES
CHECKED BY:	W. PELLETIER
SHEET	54 OF 90