


- PS — PROPOSED SEWER
- S — EXISTING SEWER
- W — PROPOSED WATER
- W — EXISTING SEWER

RECORD DRAWINGS

NOTE: SEE CONSULTANT UTILITIES PLANS (C1-C4) AND (E1,E2) FOR ANY INFORMATION ON EXISTING/PROPOSED SEWER LINES AND EXISTING/PROPOSED WATER LINES.

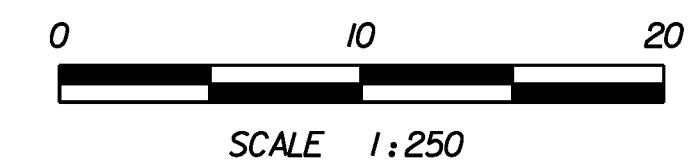

PROJECT NAME:	READSBORO
PROJECT NUMBER:	BRF 0105 (3)
FILE NAME:	89J088/STR/s89J088u+libdr.dgn
PROJECT LEADER:	J. LACROIX
DESIGNED BY:	W. PELLETIER
WATER AND SEWER UTILITIES	
PLOT DATE:	07-MAR-2012
DRAWN BY:	G. ROKES
CHECKED BY:	W. PELLETIER
SHEET	66 OF 90