
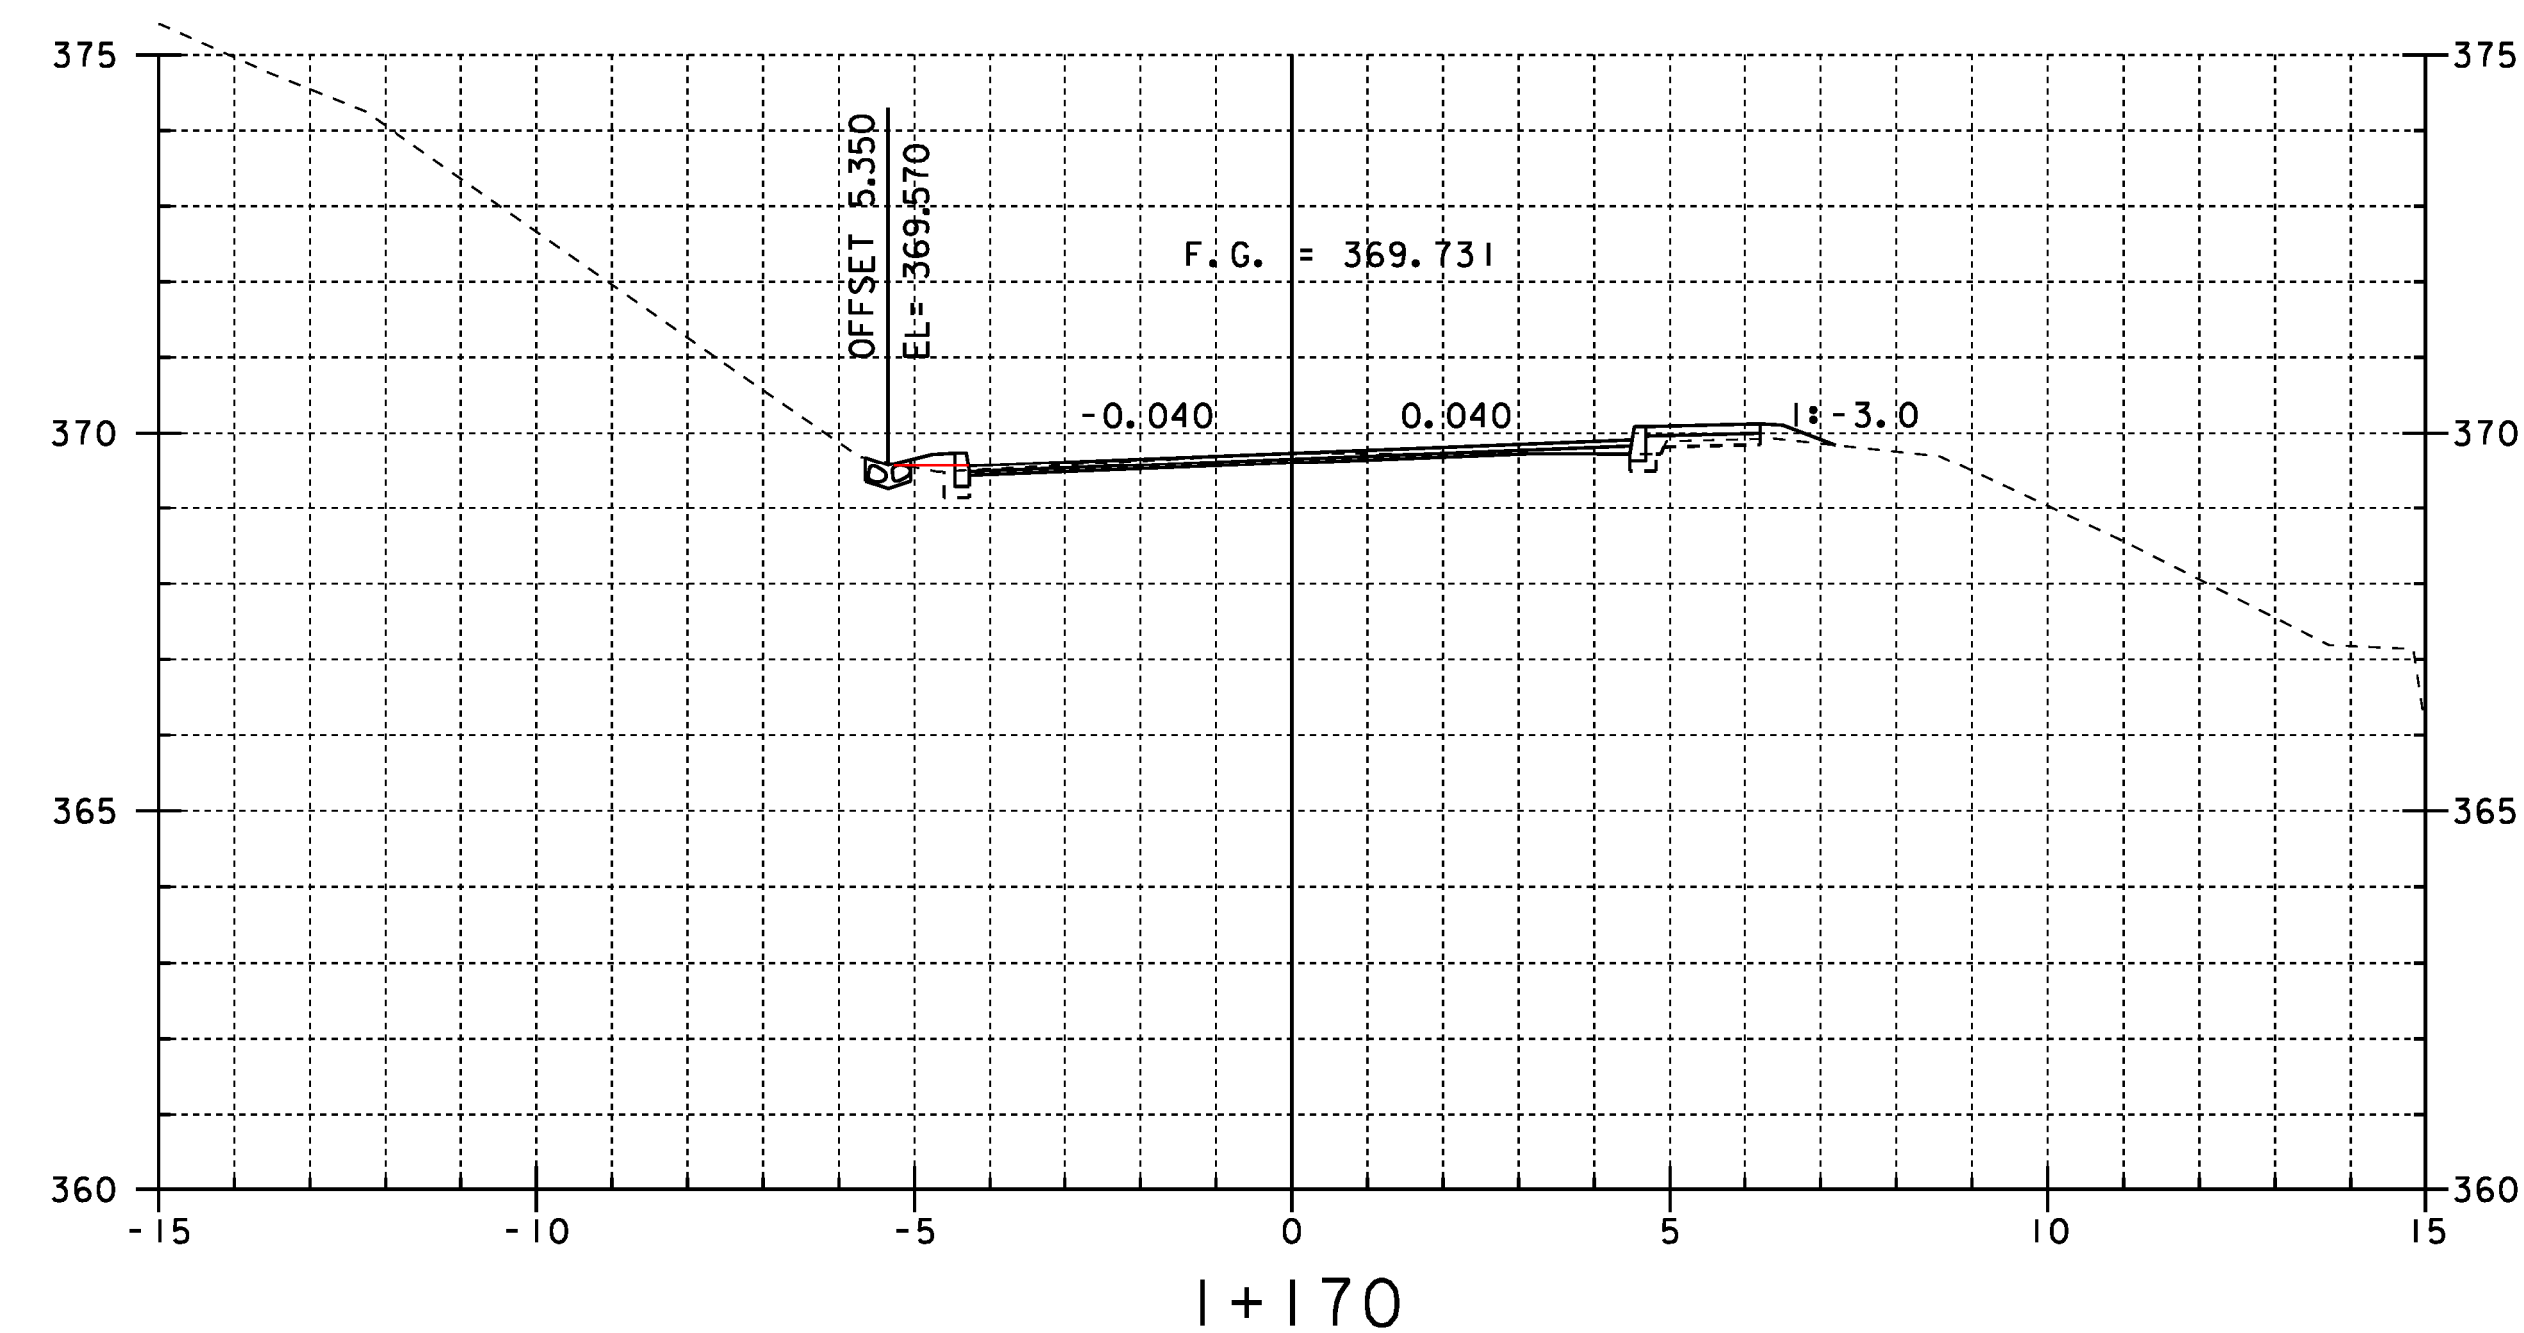
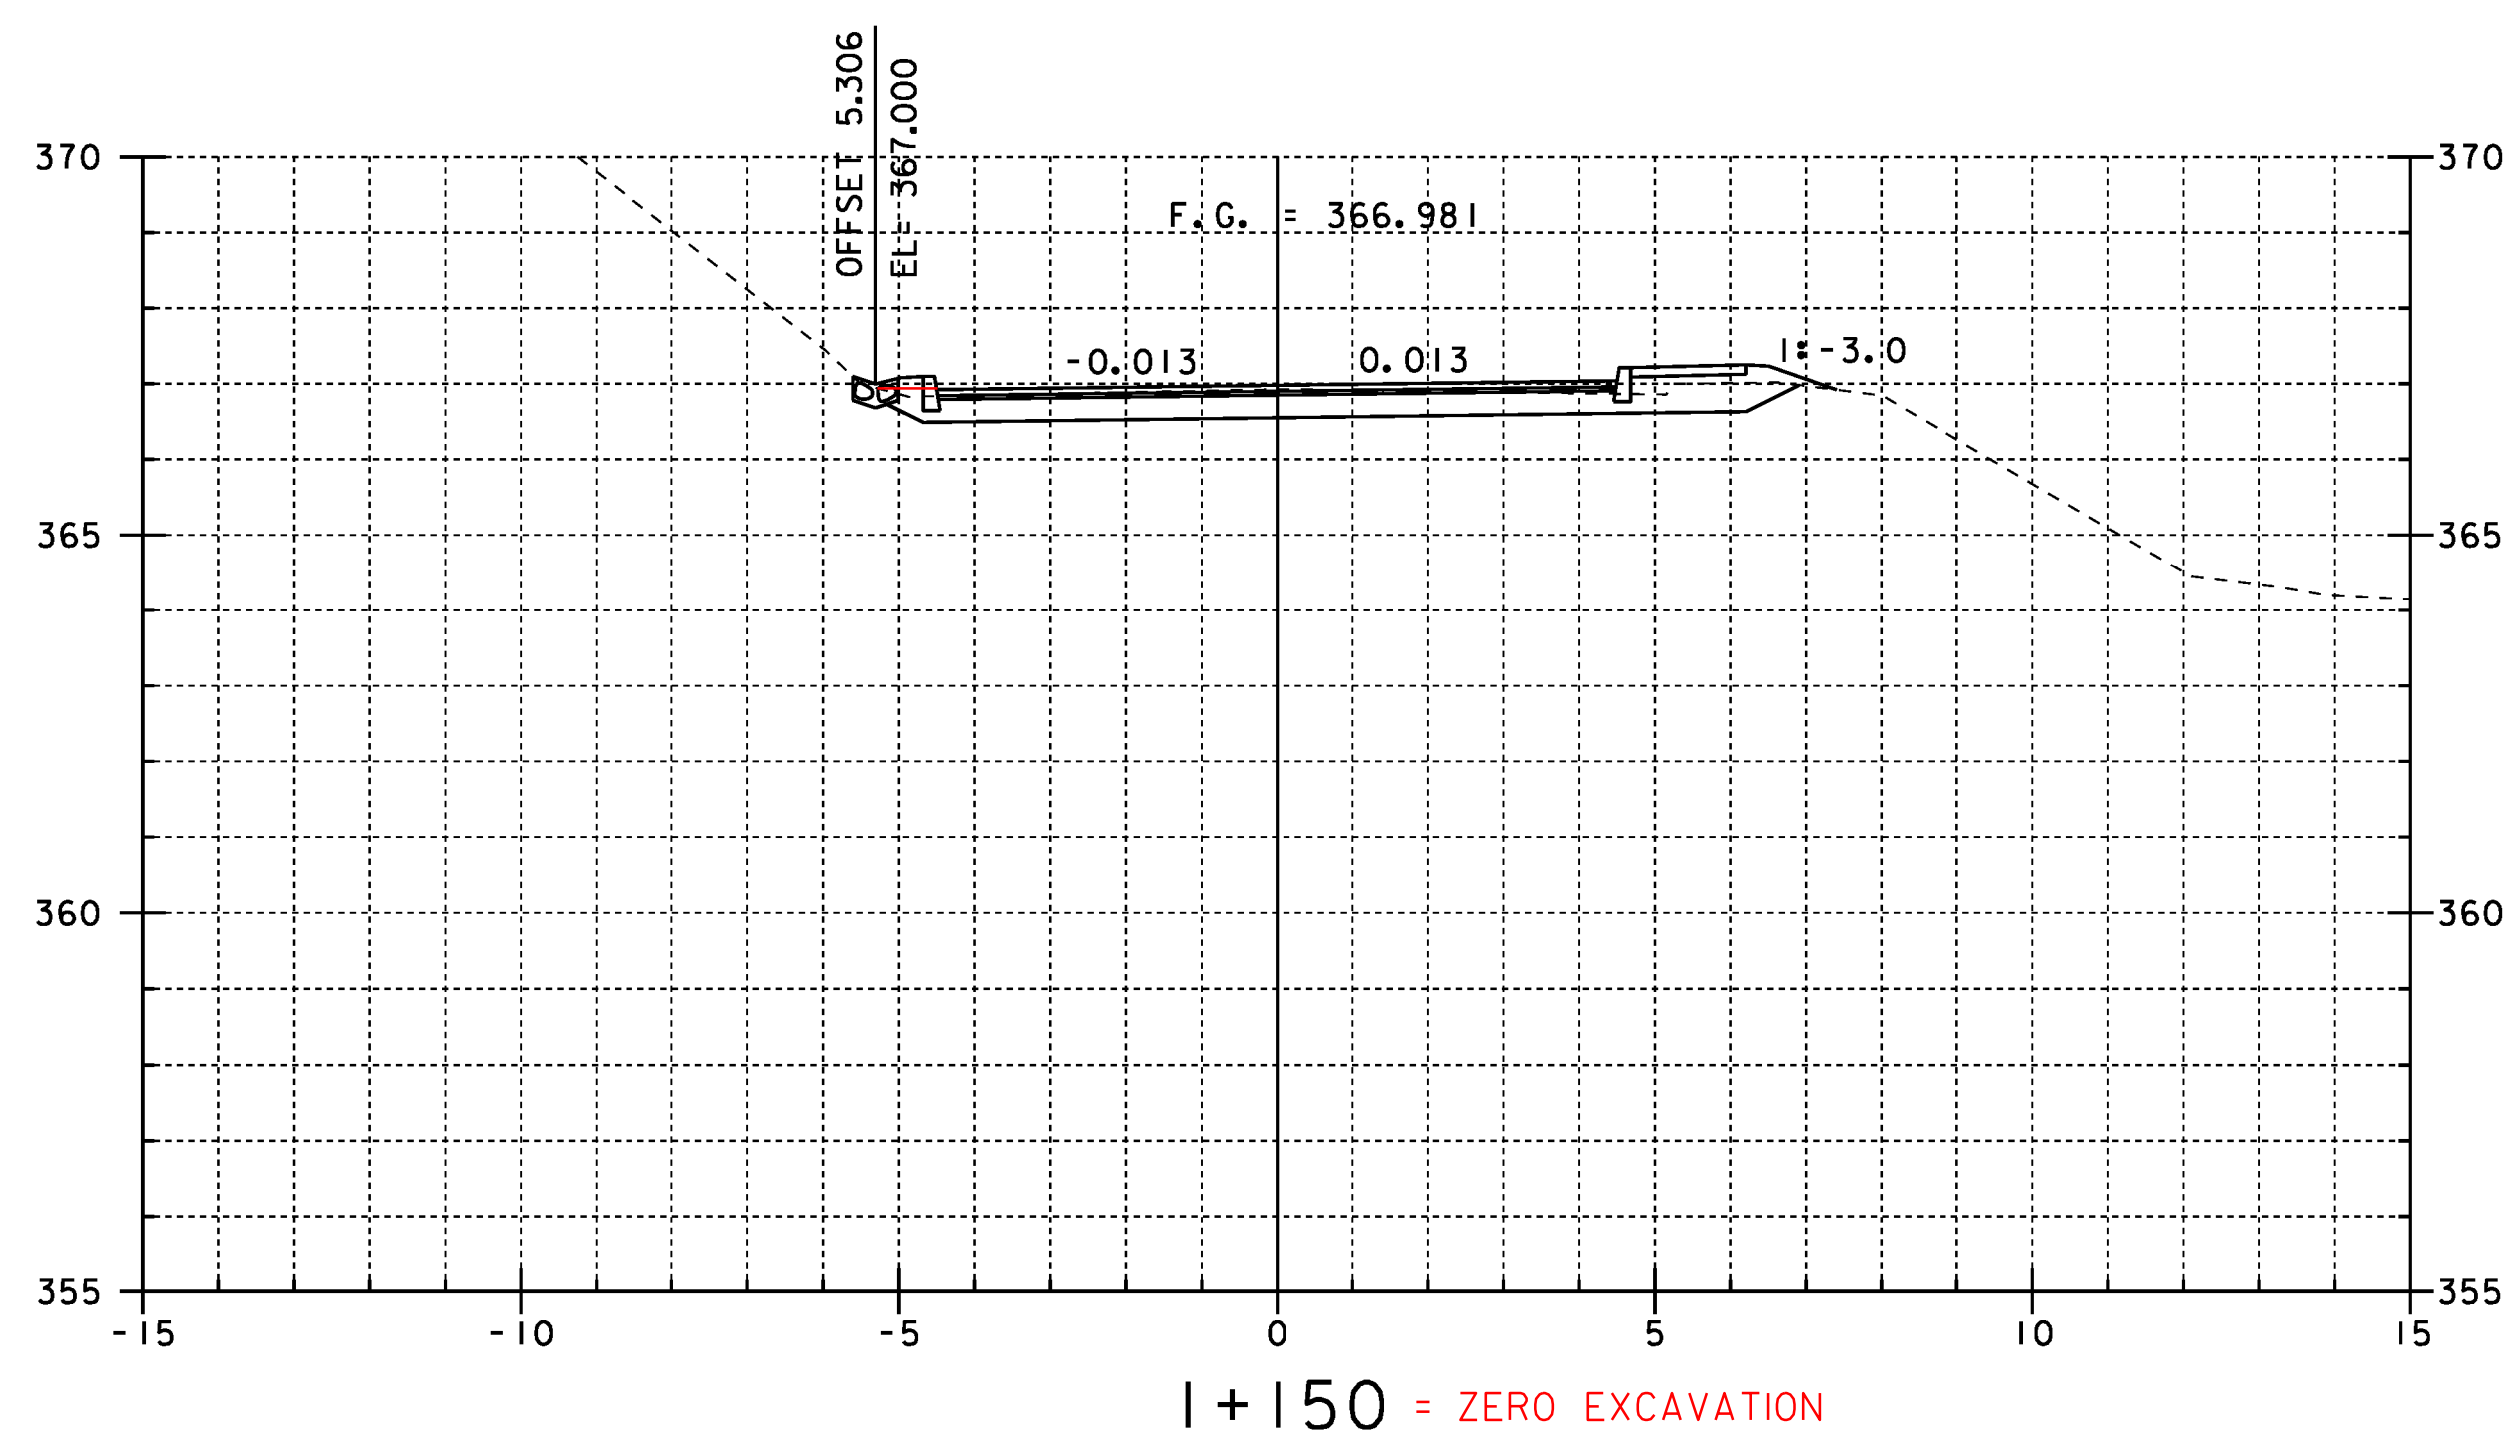
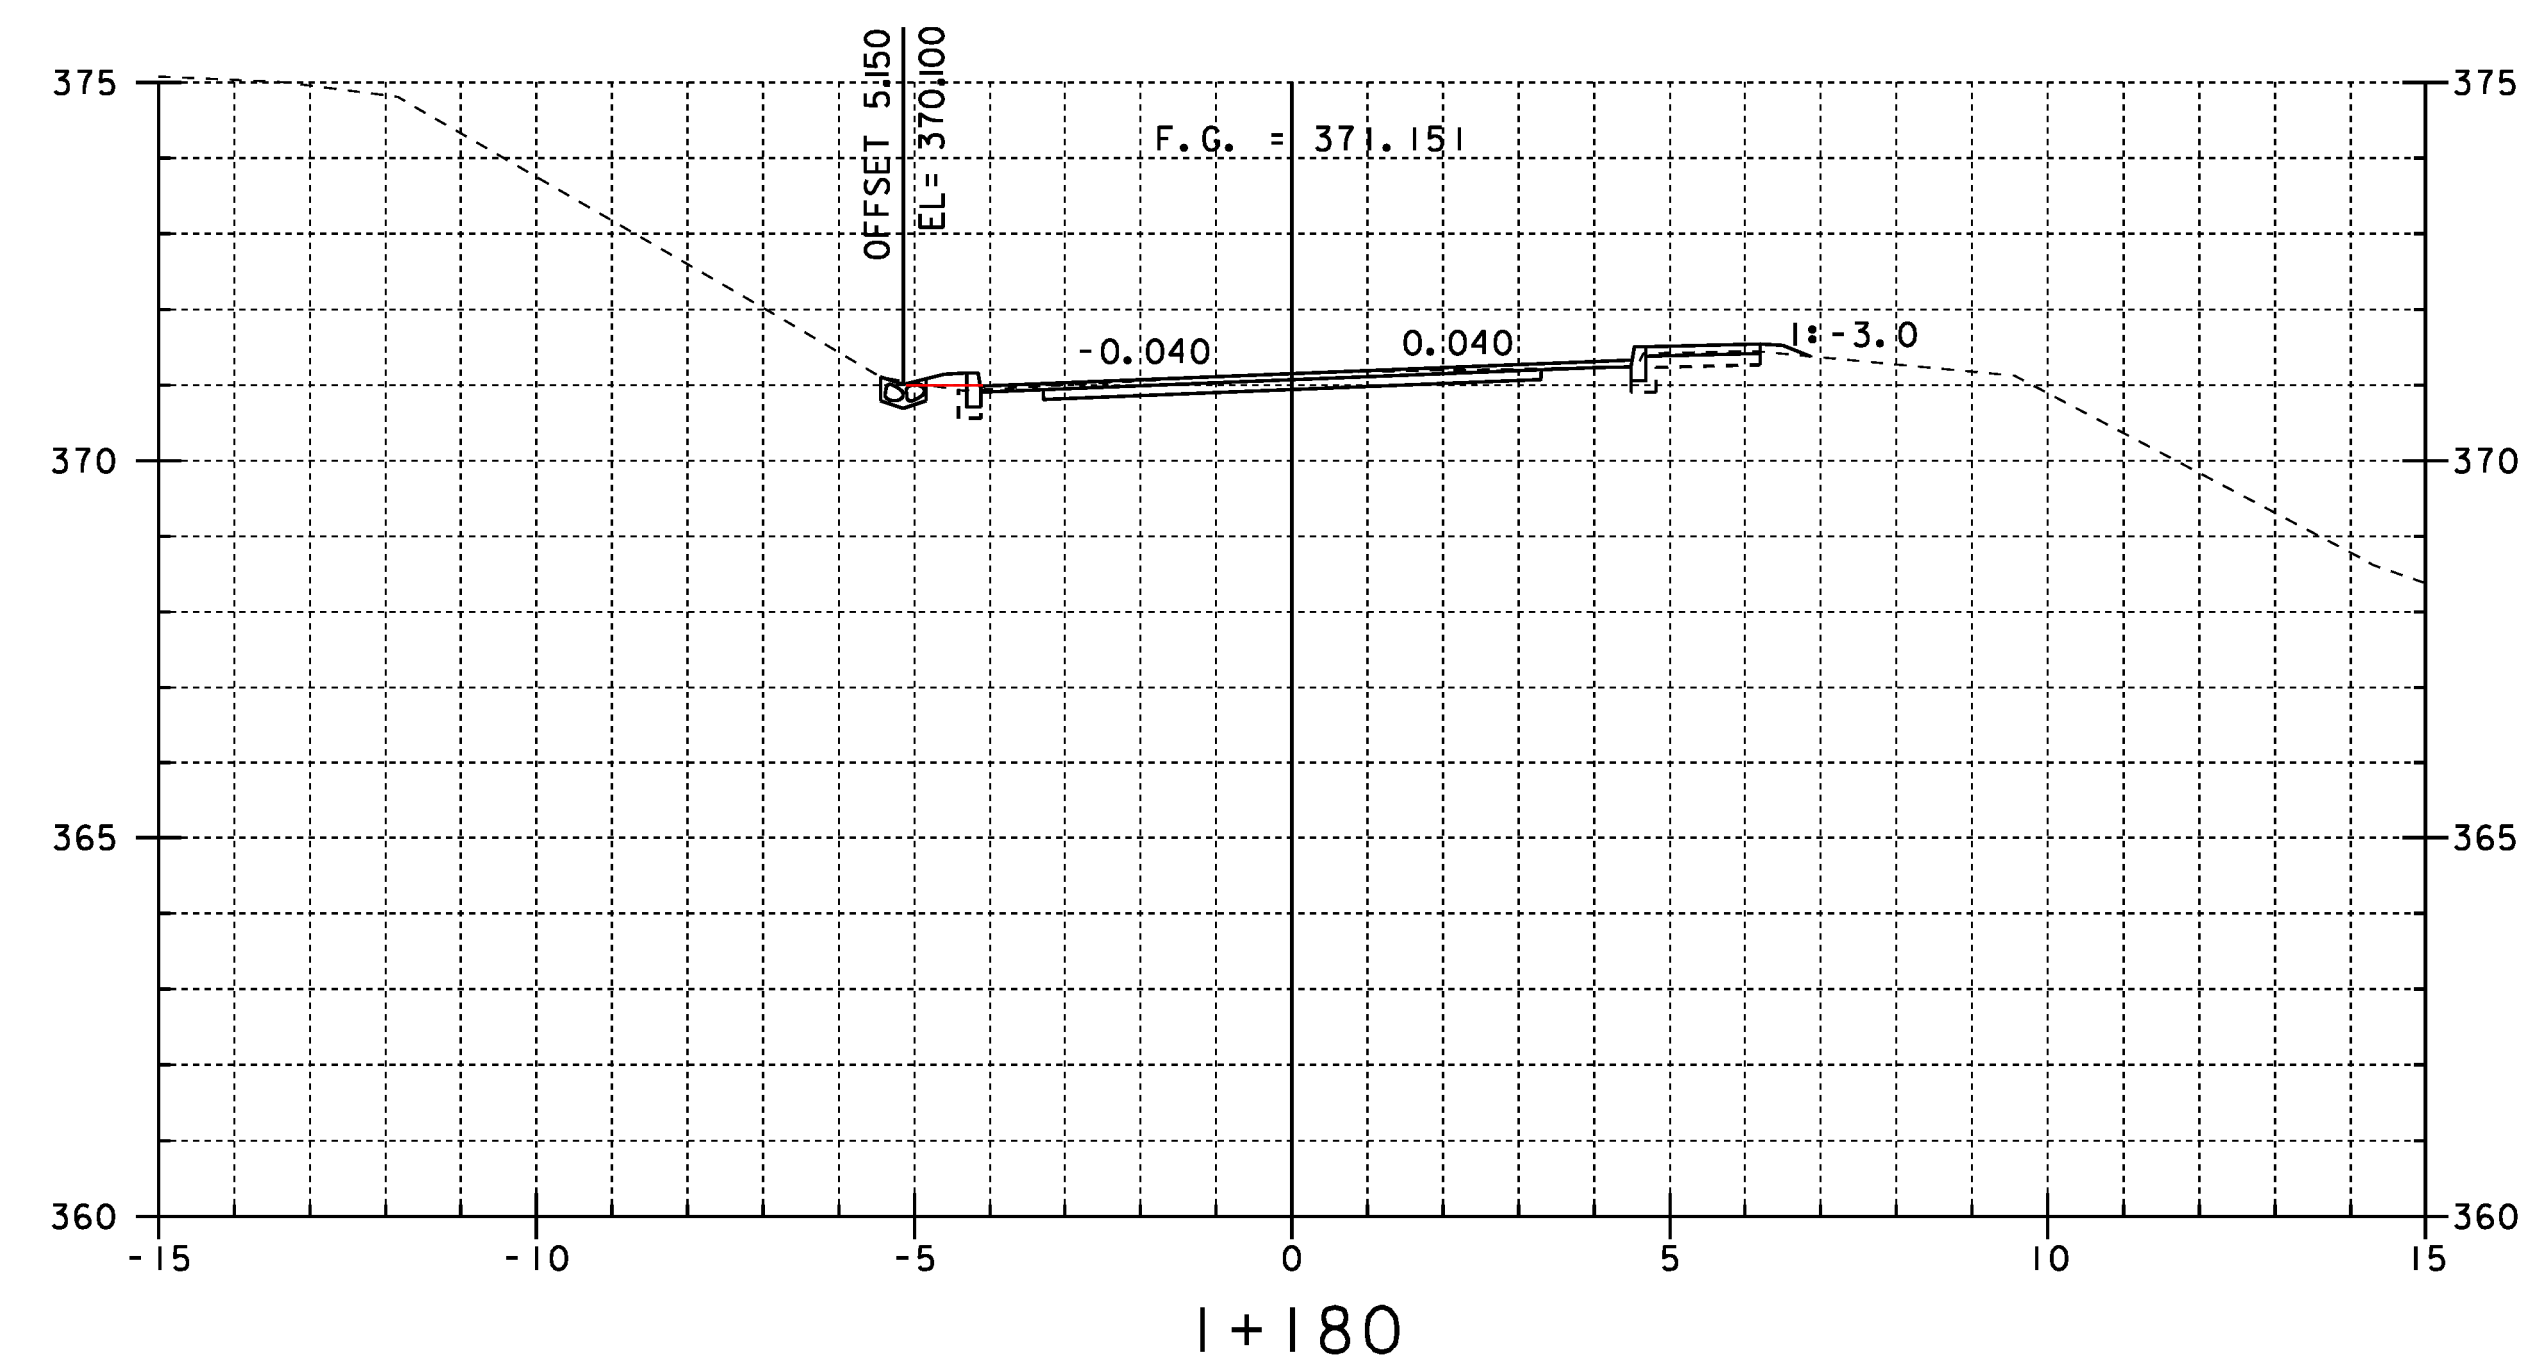


ELIMINATED STONE FILL DITCH AND CURB ON LEFT AT TOWN'S REQUEST
 END SPECIAL STONE DITCH PAVED SWALE PLACED
 STONE FILL, TYPE I
 AT I+184.000-LT

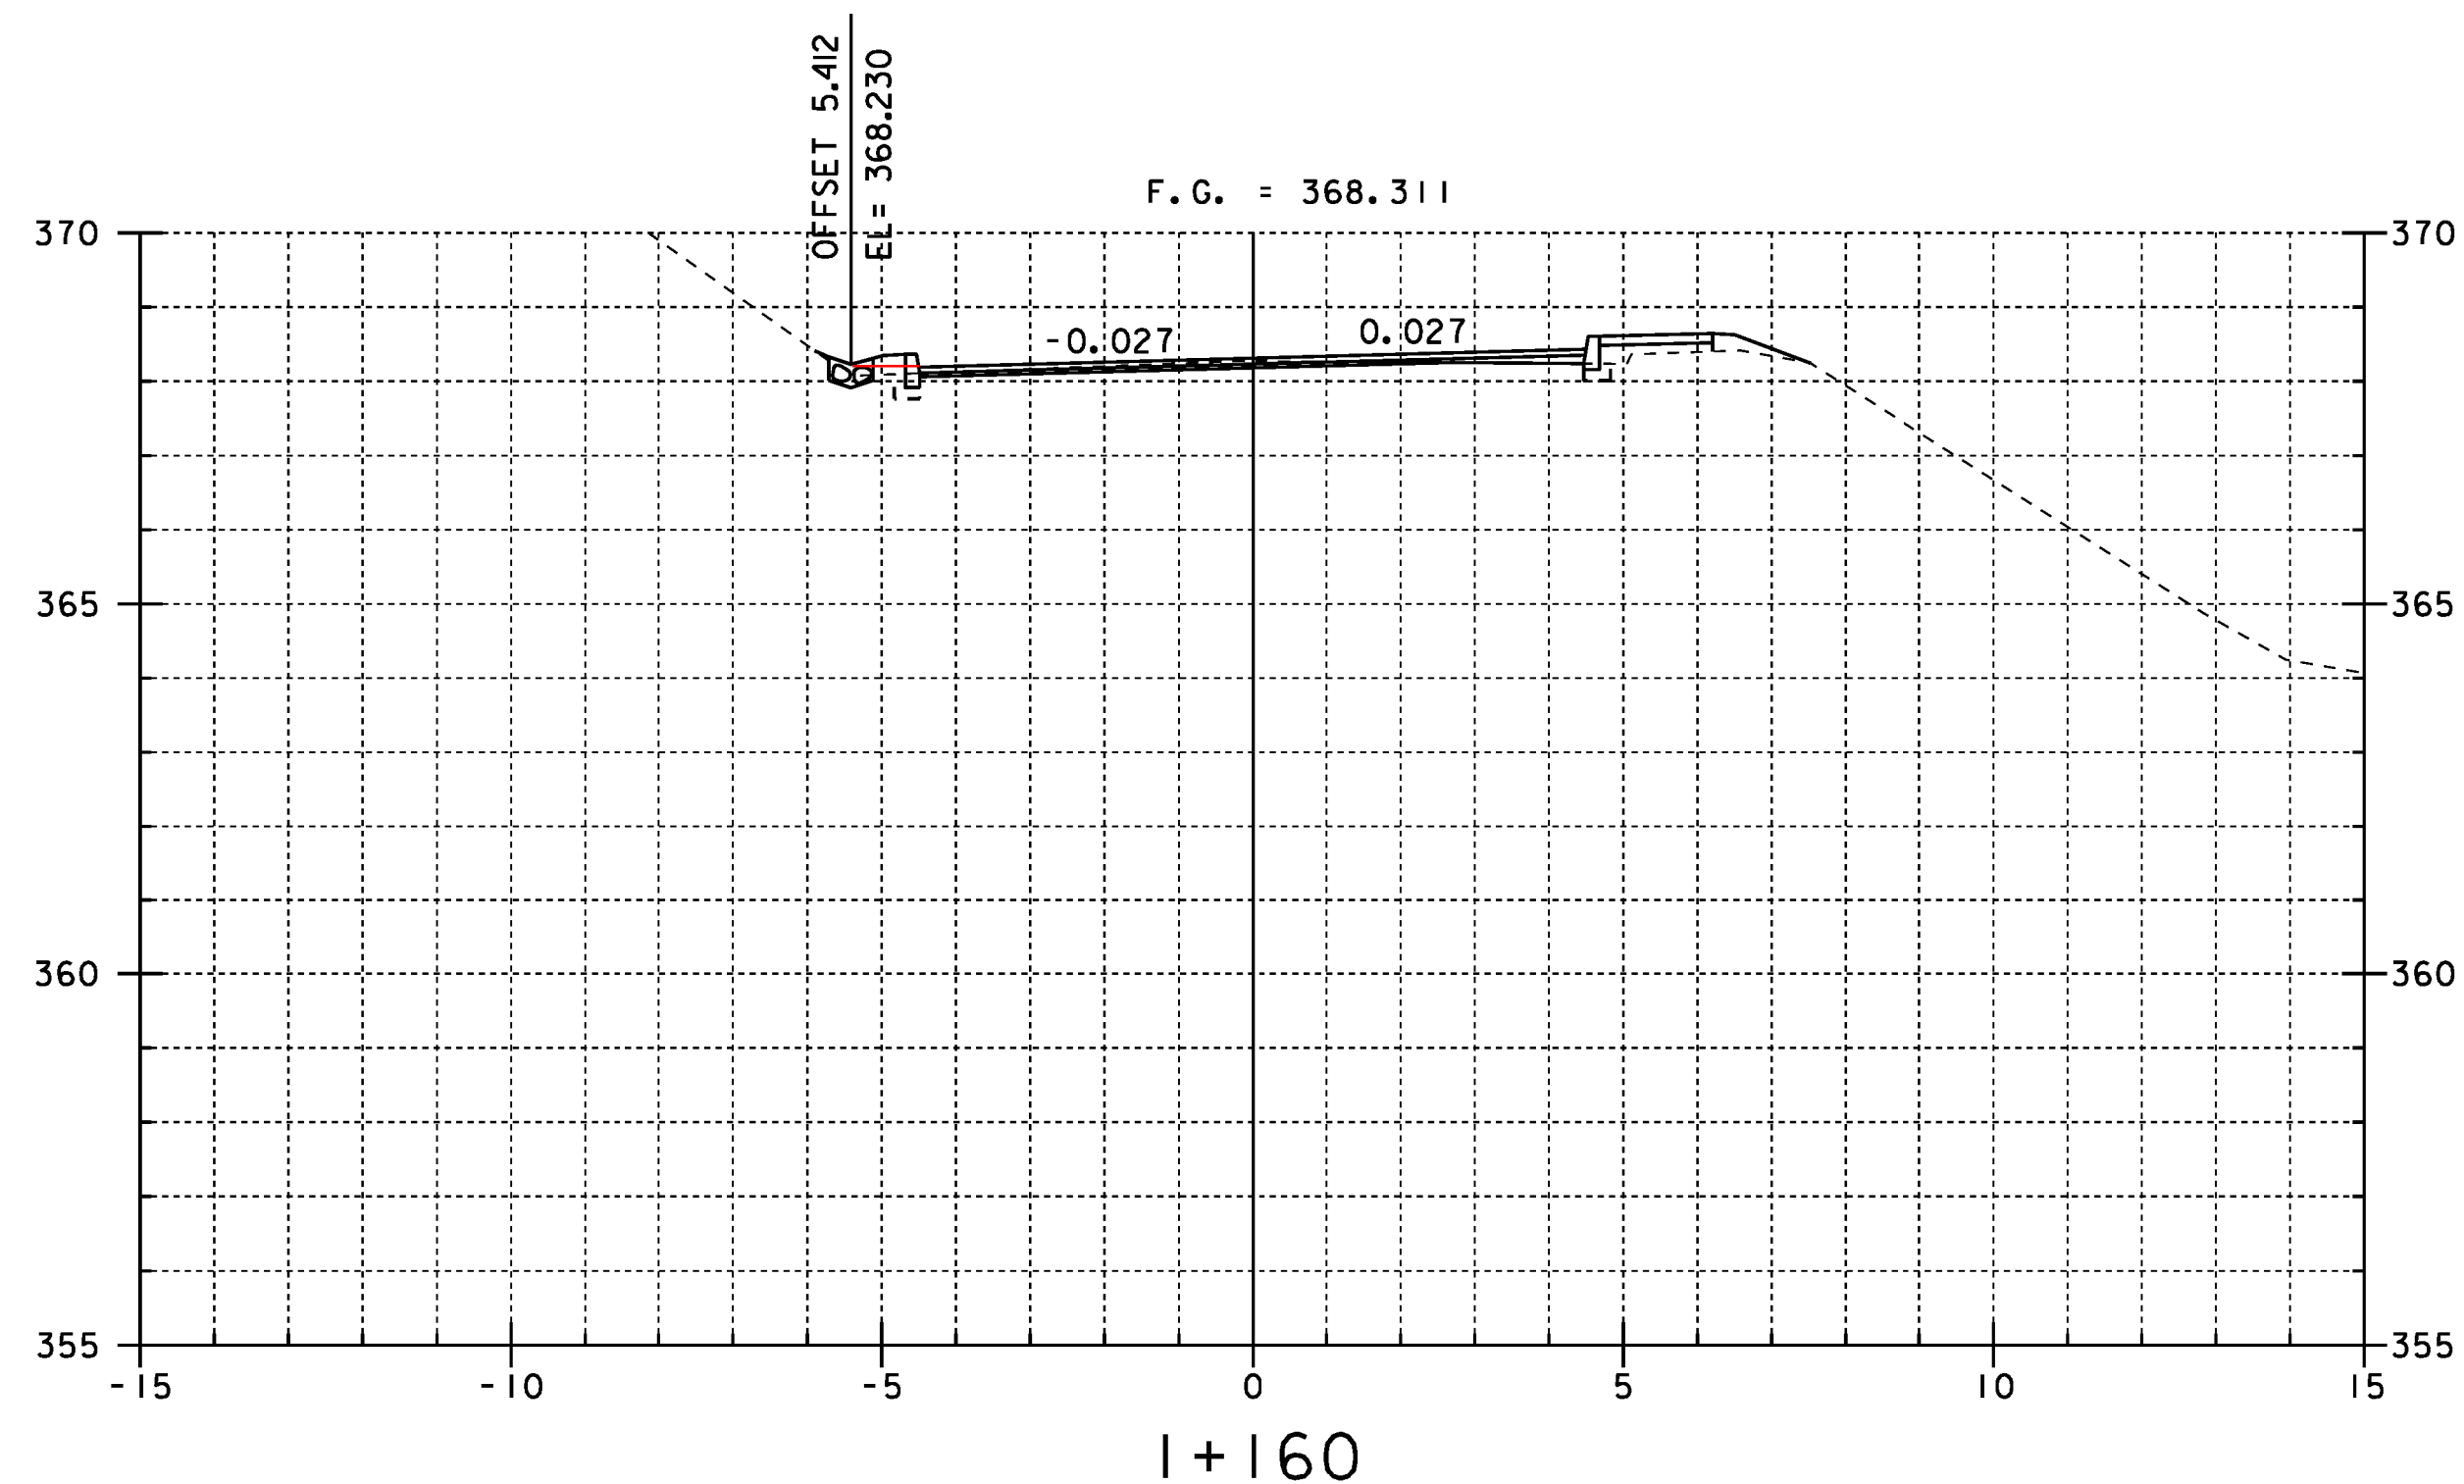

STA. I+150.000 TO STA. I+180.000

PROJECT NAME: READSBORO
 PROJECT NUMBER: BRF 0105 (3)

FILE NAME: 89J088/STR/sj088xs.dgn
 PROJECT LEADER: J. LACROIX
 DESIGNED BY: W. PELLETIER
 MAINLINE CROSS SECTIONS SHEET 6

PLOT DATE: 07-MAR-2012
 DRAWN BY: G. ROKES
 CHECKED BY: W. PELLETIER
 SHEET 85 OF 90