



STA. 5+026.800 (LEFT CHANNEL SLOPE)
 END ITEMS
 MATCH EXISTING GROUND AND TRANSITION
 UNCLASSIFIED CHANNEL EXCAVATION
 STONE FILL TYPE IV
 GEOTEXTILE UNDER STONE FILL
 GRUBBING MATERIAL

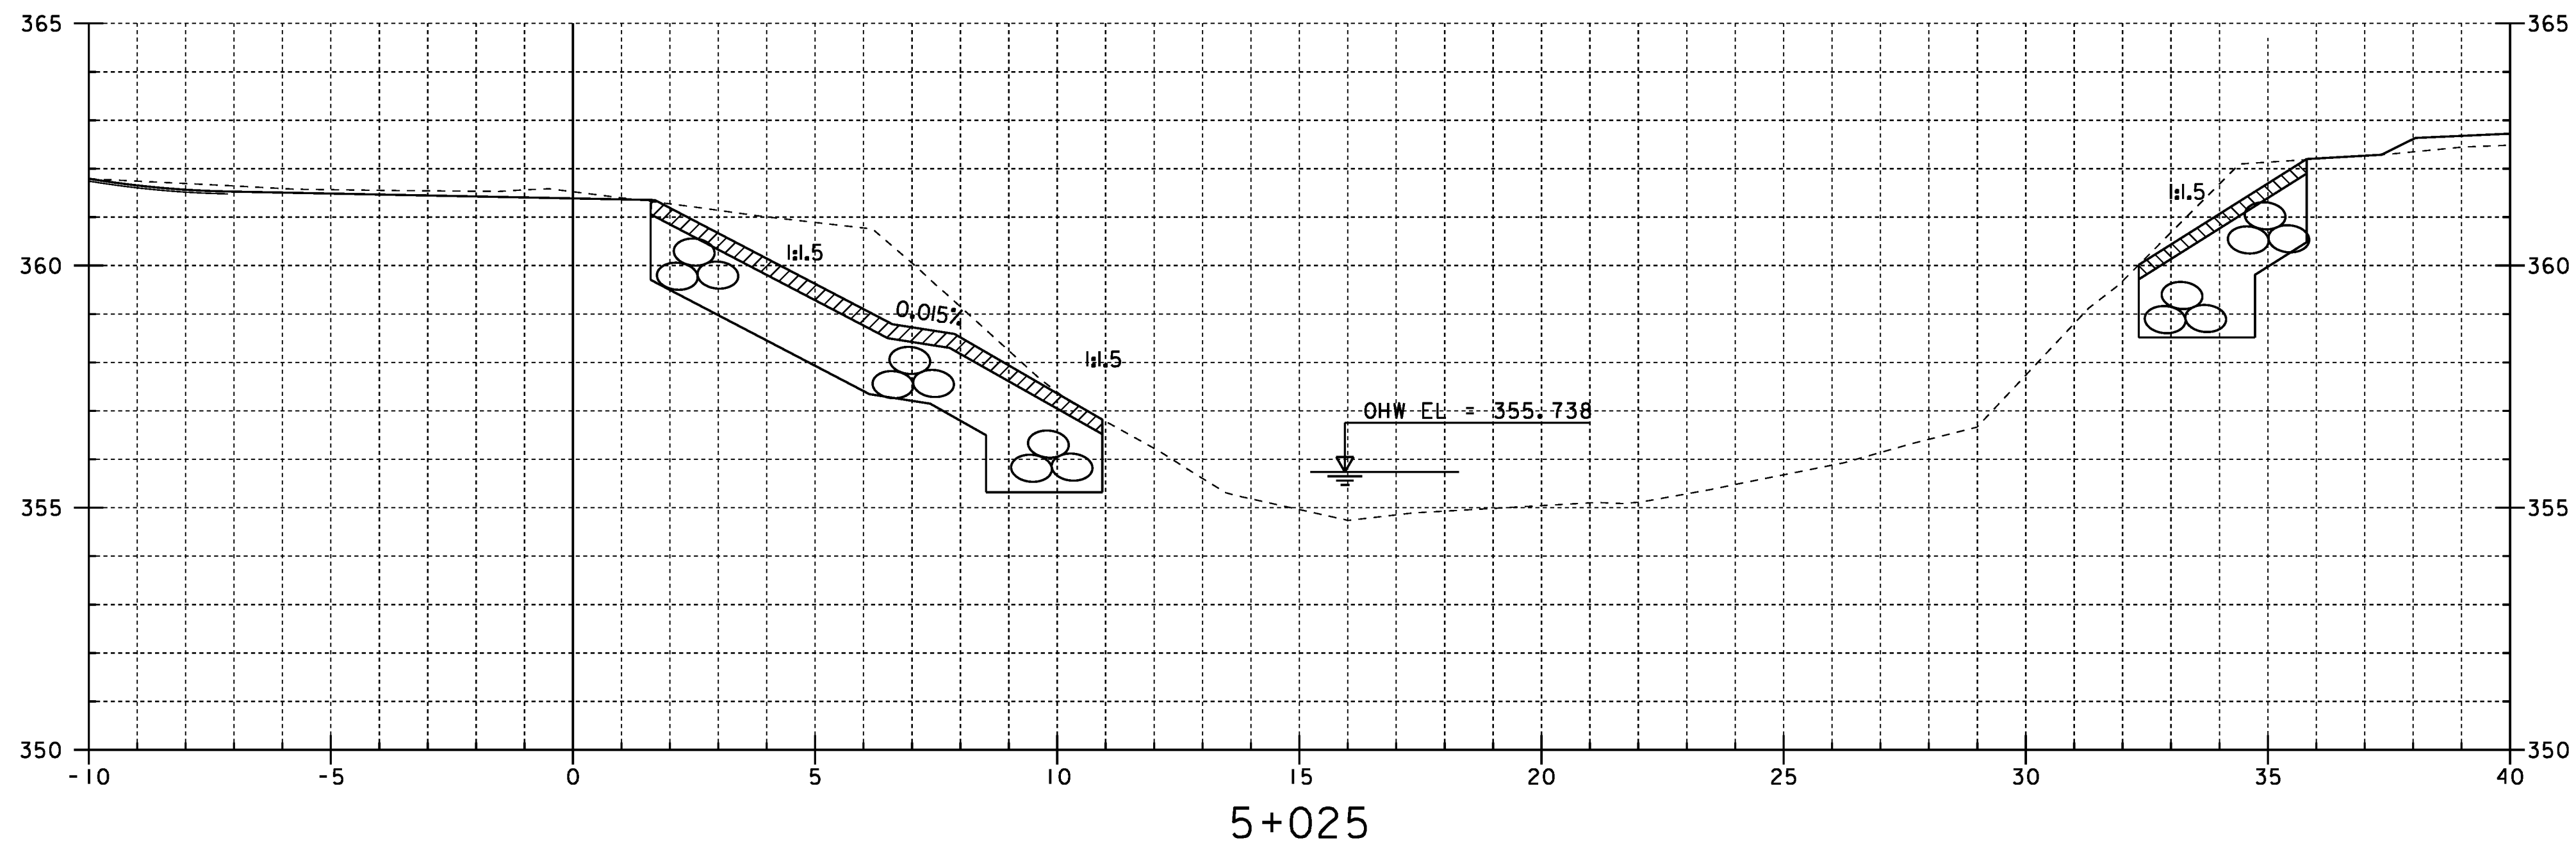

STA. 5+028.400 (RIGHT CHANNEL SLOPE)
 END ITEMS
 MATCH EXISTING GROUND AND TRANSITION
 UNCLASSIFIED CHANNEL EXCAVATION
 STONE FILL TYPE IV
 GEOTEXTILE UNDER STONE FILL
 GRUBBING MATERIAL

STA. 5+019.800 (LEFT CHANNEL SLOPE)
 BEGIN ITEM
 GRUBBING MATERIAL

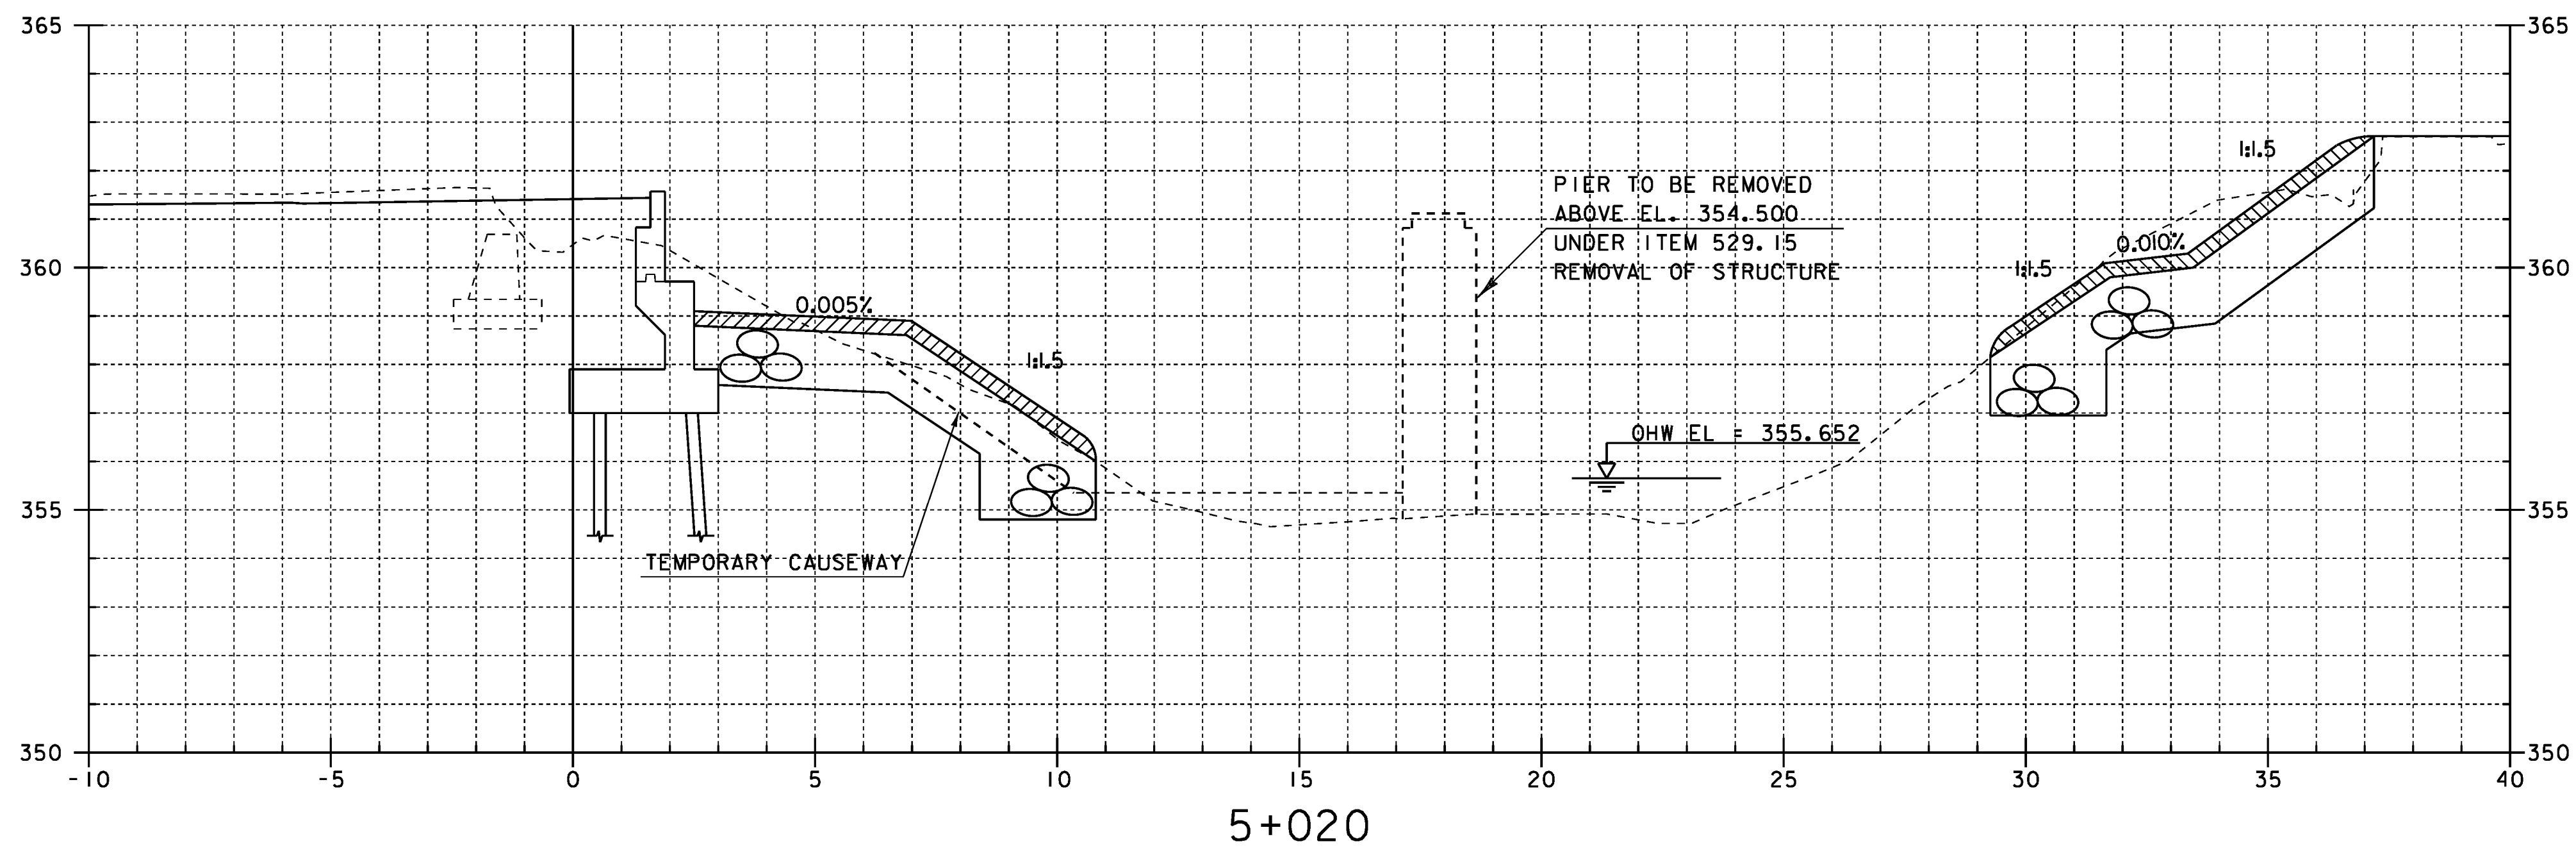

STA. 5+019.800 (RIGHT CHANNEL SLOPE)
 BEGIN ITEM
 GRUBBING MATERIAL

PROJECT NAME: READSBORO
 PROJECT NUMBER: BRF 0105 (3)

FILE NAME: 89J088/STR/sj088xs.dgn PLOT DATE: 07-MAR-2012
 PROJECT LEADER: J. LACROIX DRAWN BY: G. ROKES
 DESIGNED BY: W. PELLETIER CHECKED BY: W. PELLETIER
 CHANNEL CROSS SECTIONS SHEET 3 SHEET 89 OF 90

STA. 5+020.000 TO STA. 5+025.000