
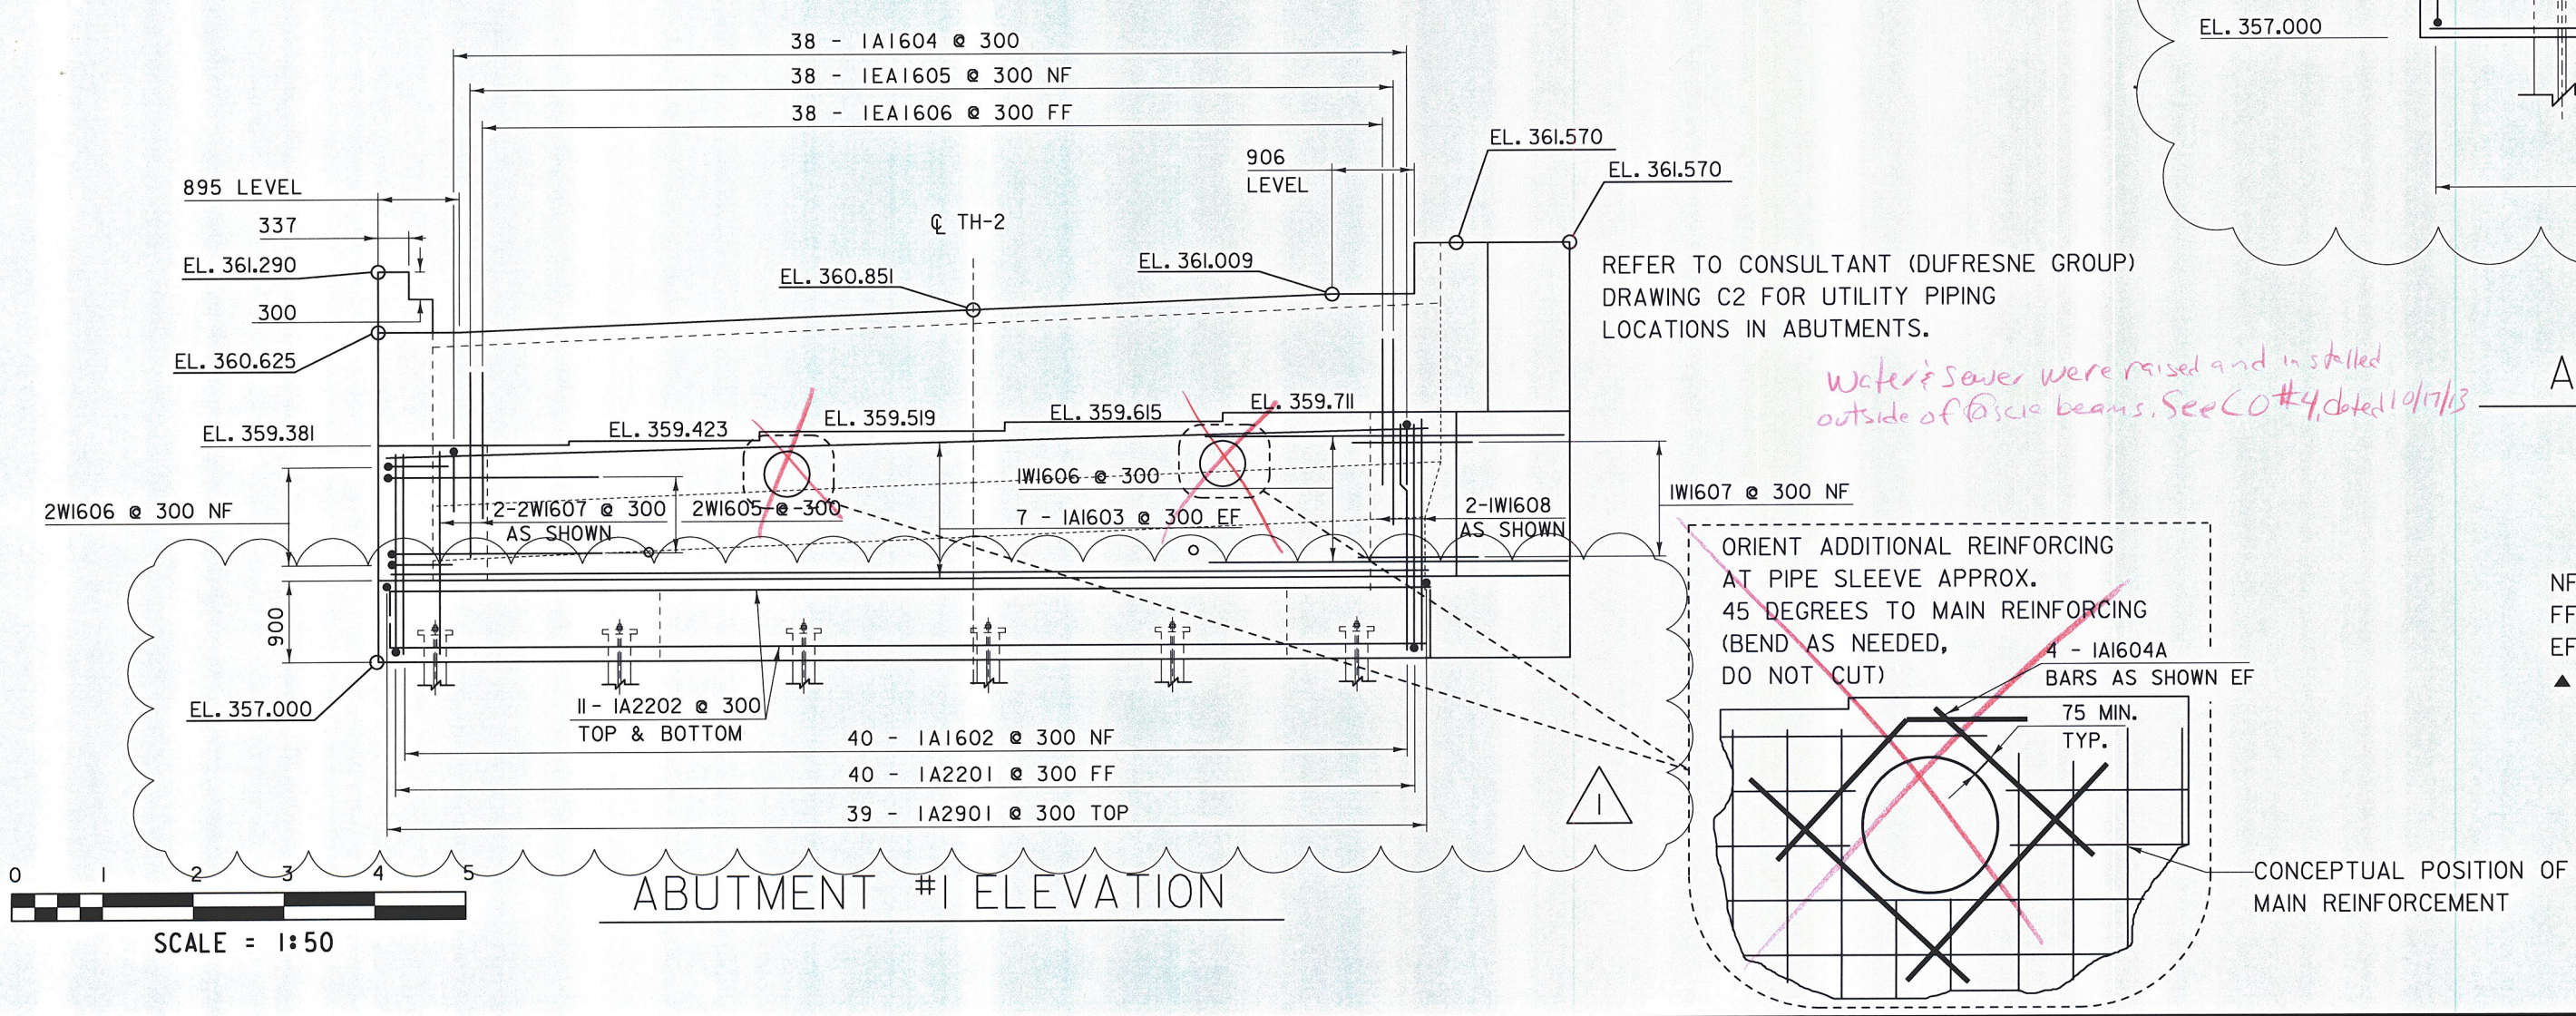
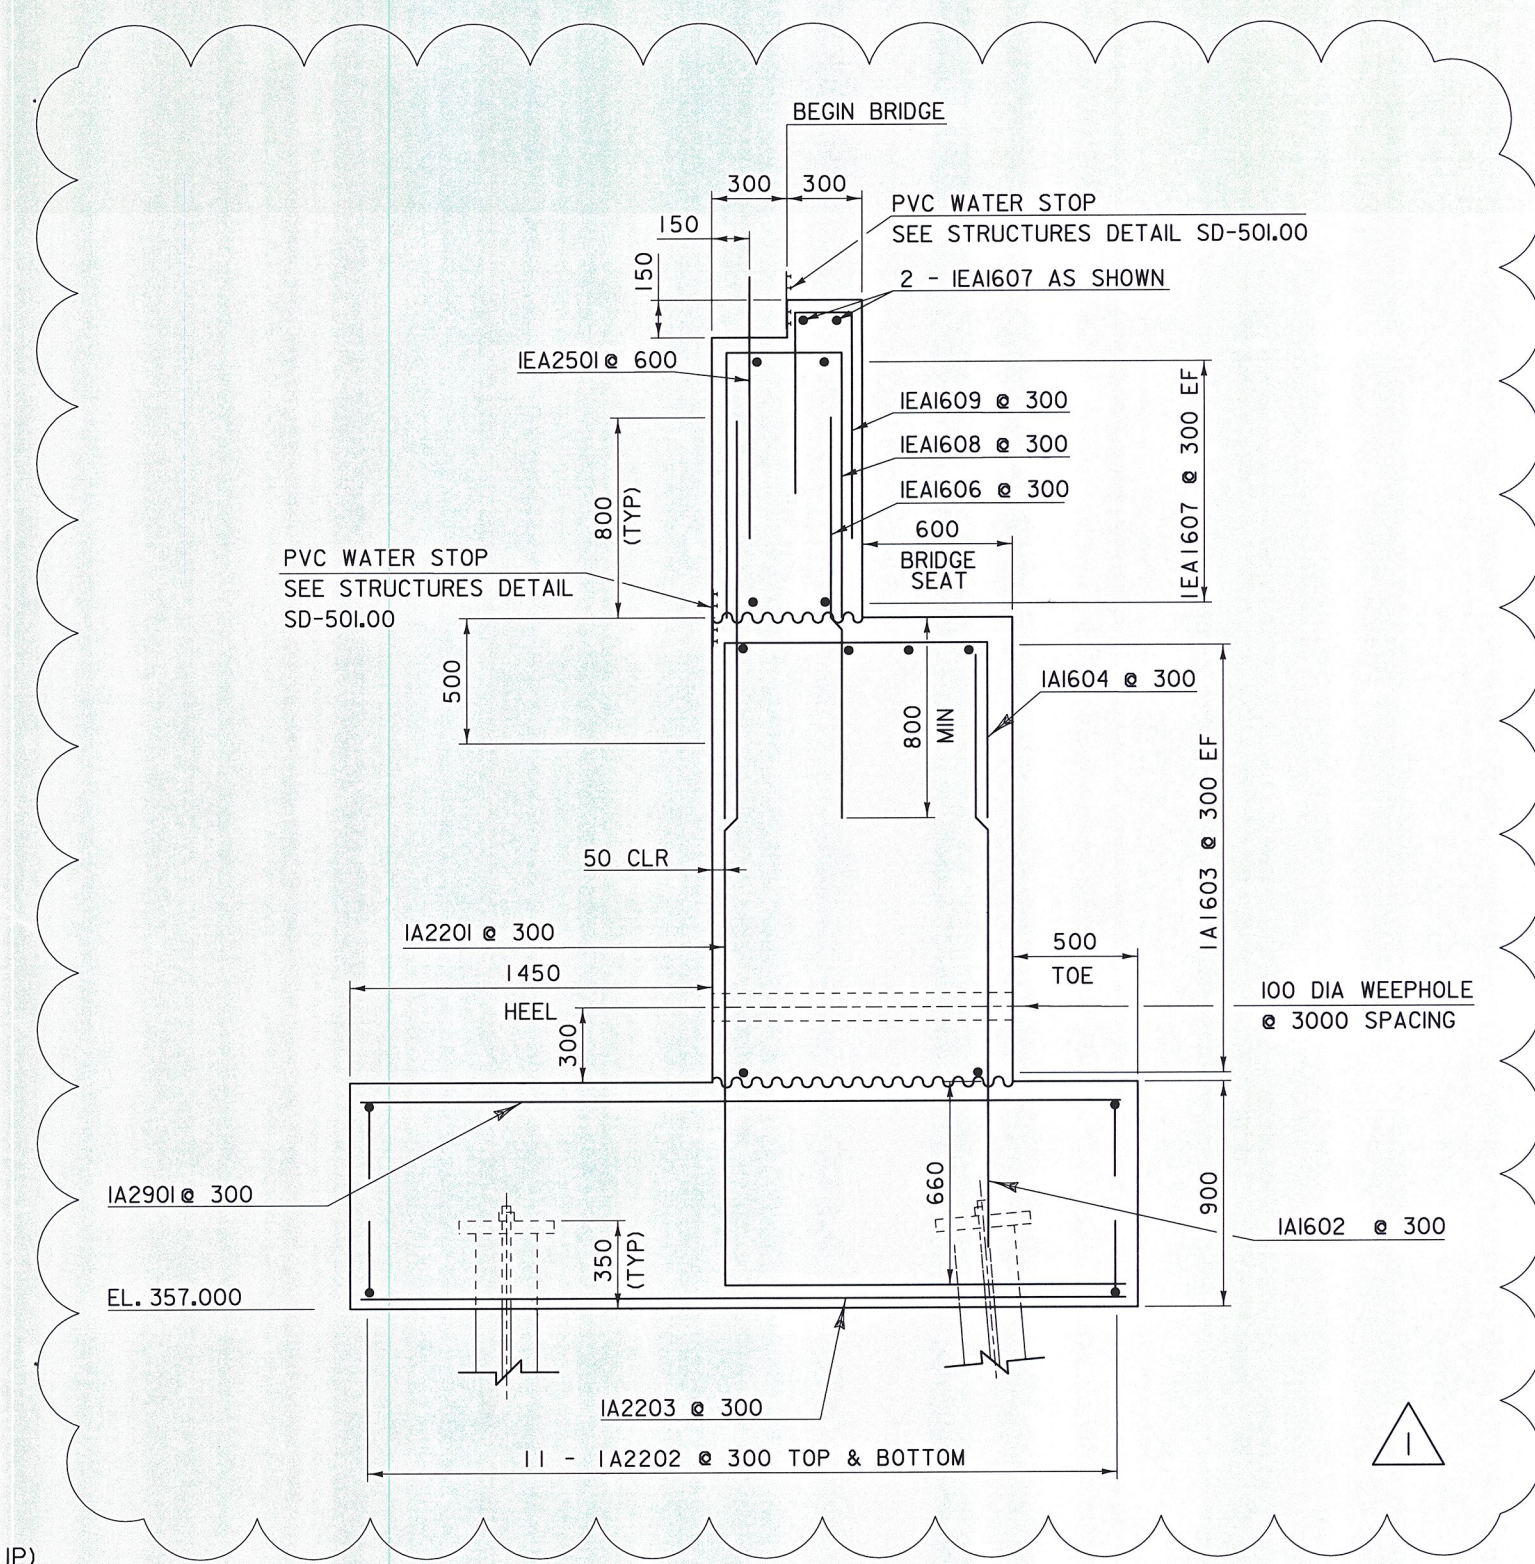


REVISION	DATE	DESCRIPTION	BY
1	04-10-2013	CHANGED STEM WIDTH AND FIXED REBAR AS APPROPRIATE	MRU

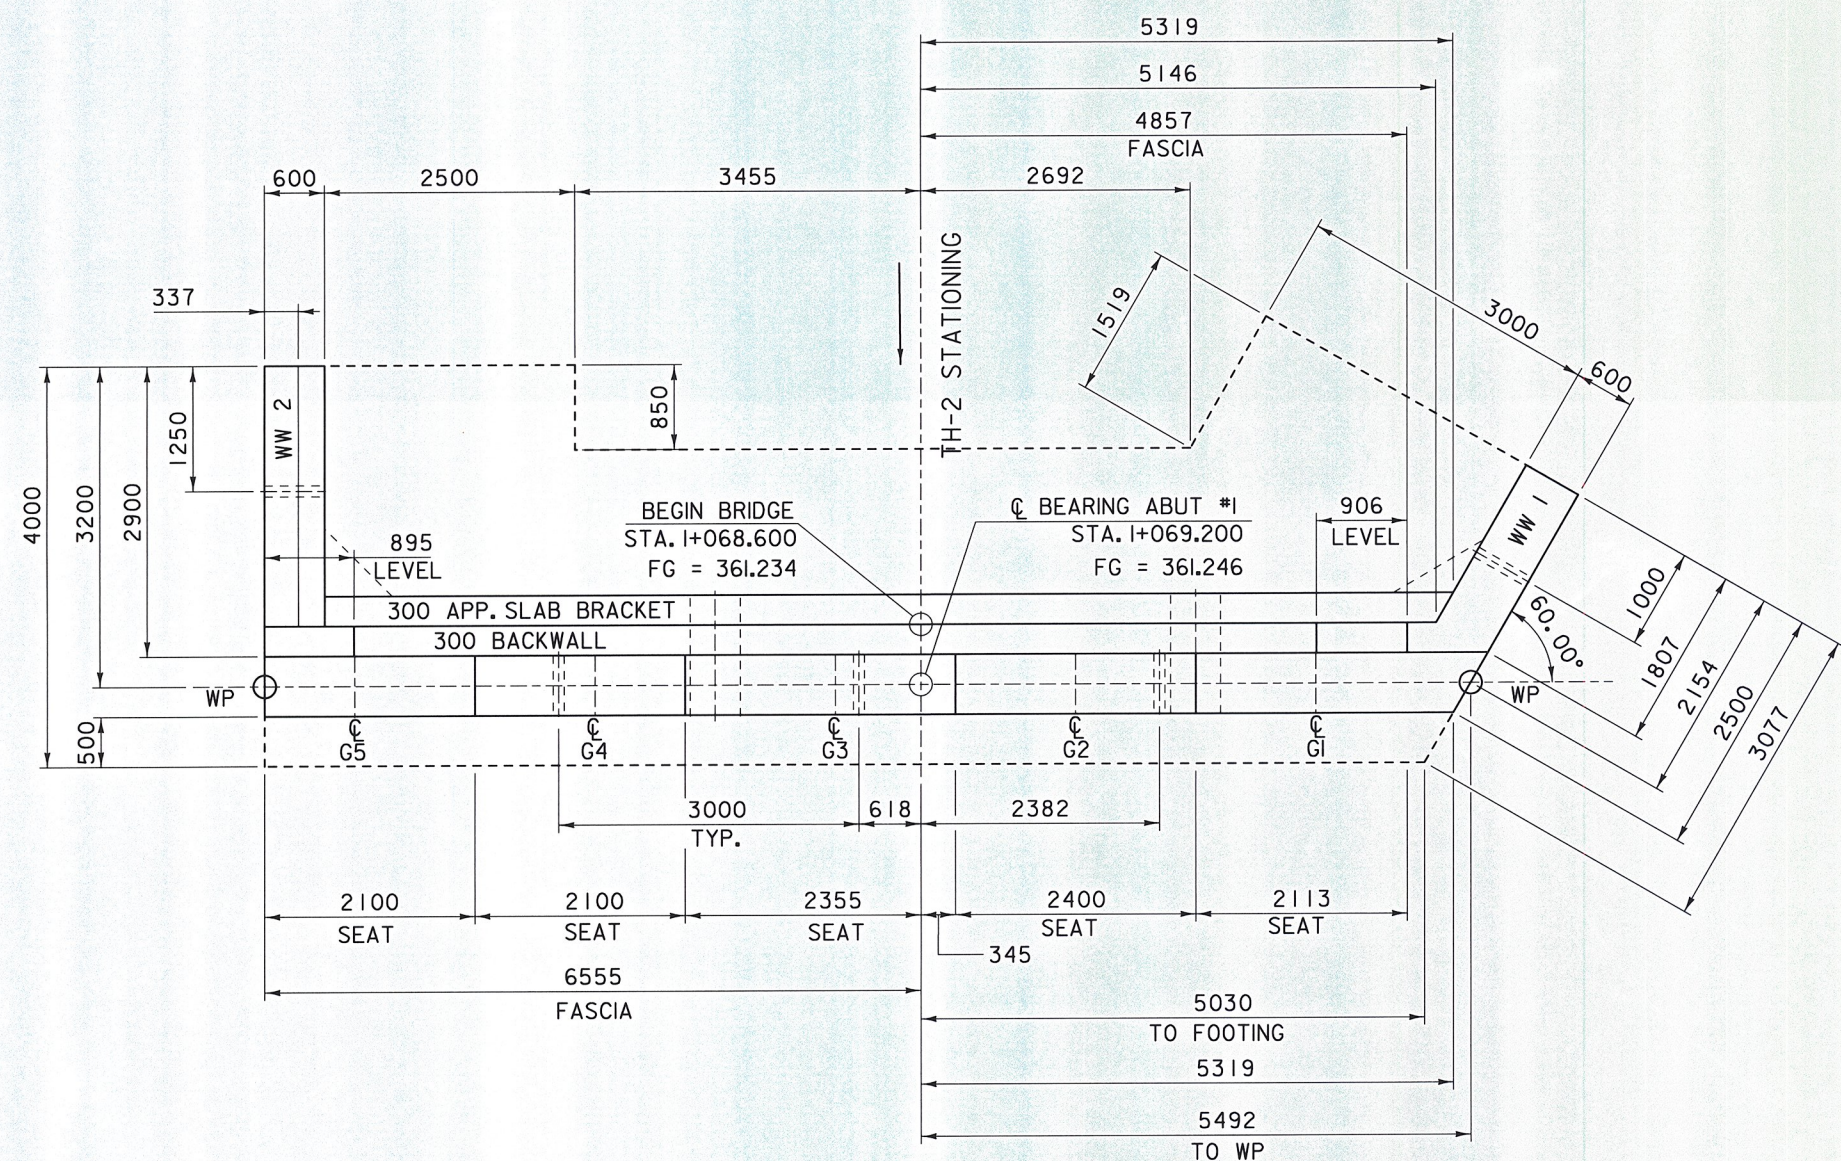

Redesigned Abutments

NF = NEAR FACE
 FF = FAR FACE
 EF = EACH FACE
 ▲ = CUT TO FIT IN FIELD
 75 CLEAR, UNLESS OTHERWISE SPECIFIED ON THE PLANS
 660 BAR LAP UNLESS OTHERWISE SPECIFIED ON THE PLANS

PROJECT NAME:	READSBORO	PLOT DATE:	12-APR-2013
PROJECT NUMBER:	BRF 0105 (3)	DRAWN BY:	G. ROKES
FILE NAME:	89J088/STR/s89J088sub.dgn	DESIGNED BY:	W. PELLETIER
PROJECT LEADER:	J. LACROIX	CHECKED BY:	W. PELLETIER
ABUTMENT 1 DETAILS		SHEET	1 OF 5