

Readsbarn BNF 0105(3)



DUFRESNE GROUP CONSULTING ENGINEERS
 54 Main Street, P.O. Box B
 Windsor, Vermont 05099
 E-mail: dufresne@vermont.net
 Web: www.dufresnegrp.com

Vermont, VT, Tel: (802) 874-2904 Fax: (802) 874-2913
 Maine, VT, Tel: (802) 479-2668 Fax: (802) 479-2281
 St. Johnsbury, VT, Tel: (802) 748-8001 Fax: (802) 748-8152

Dufresne Group is owned by Dufresne & Associates, P.C.



REVISIONS	DATE	COMMENTS	BY	CHK

TH 2, FAS 105
 BRIDGE #32







GENERAL DETAILS

READSBORO, VERMONT

Project #	416008
Project Mgr.	NRJ
Design by	TPK
Drawn by	TPK
Reviewed by	NRJ
Approved by	NRJ
Date	MAY 2011
Scale	AS SHOWN


C3

SHEET 3 OF 4

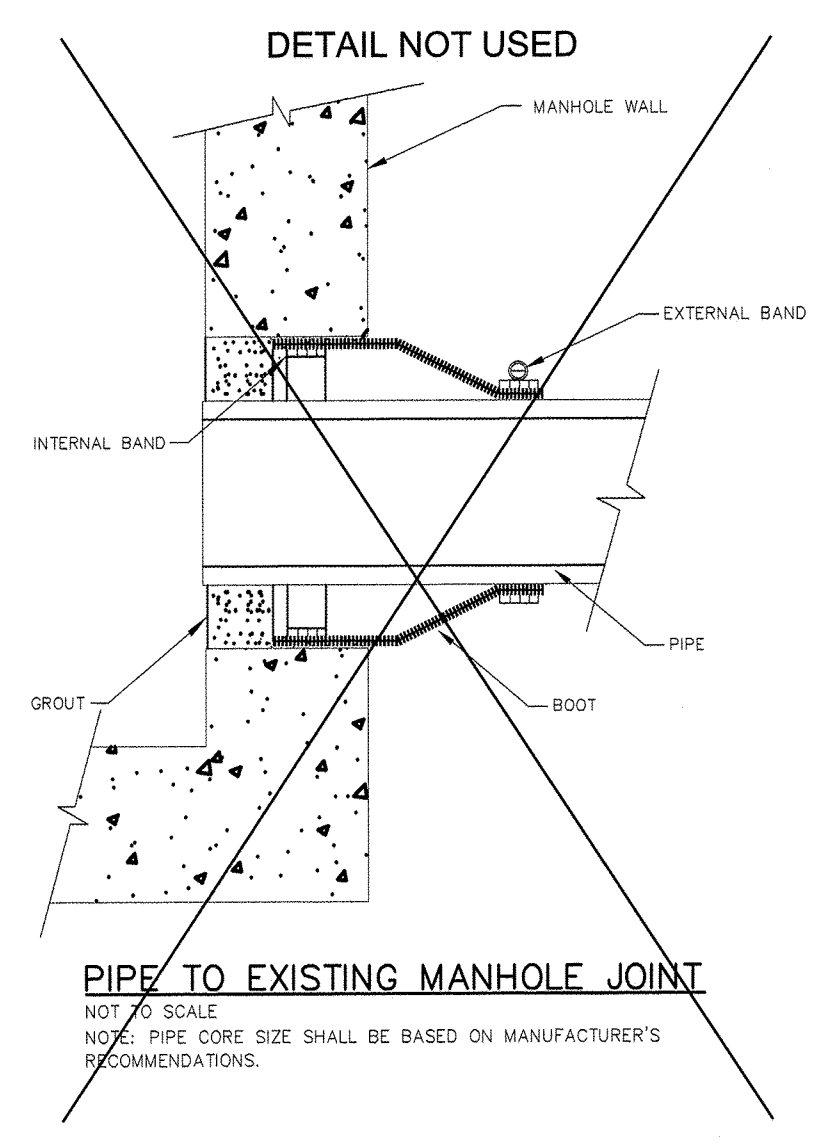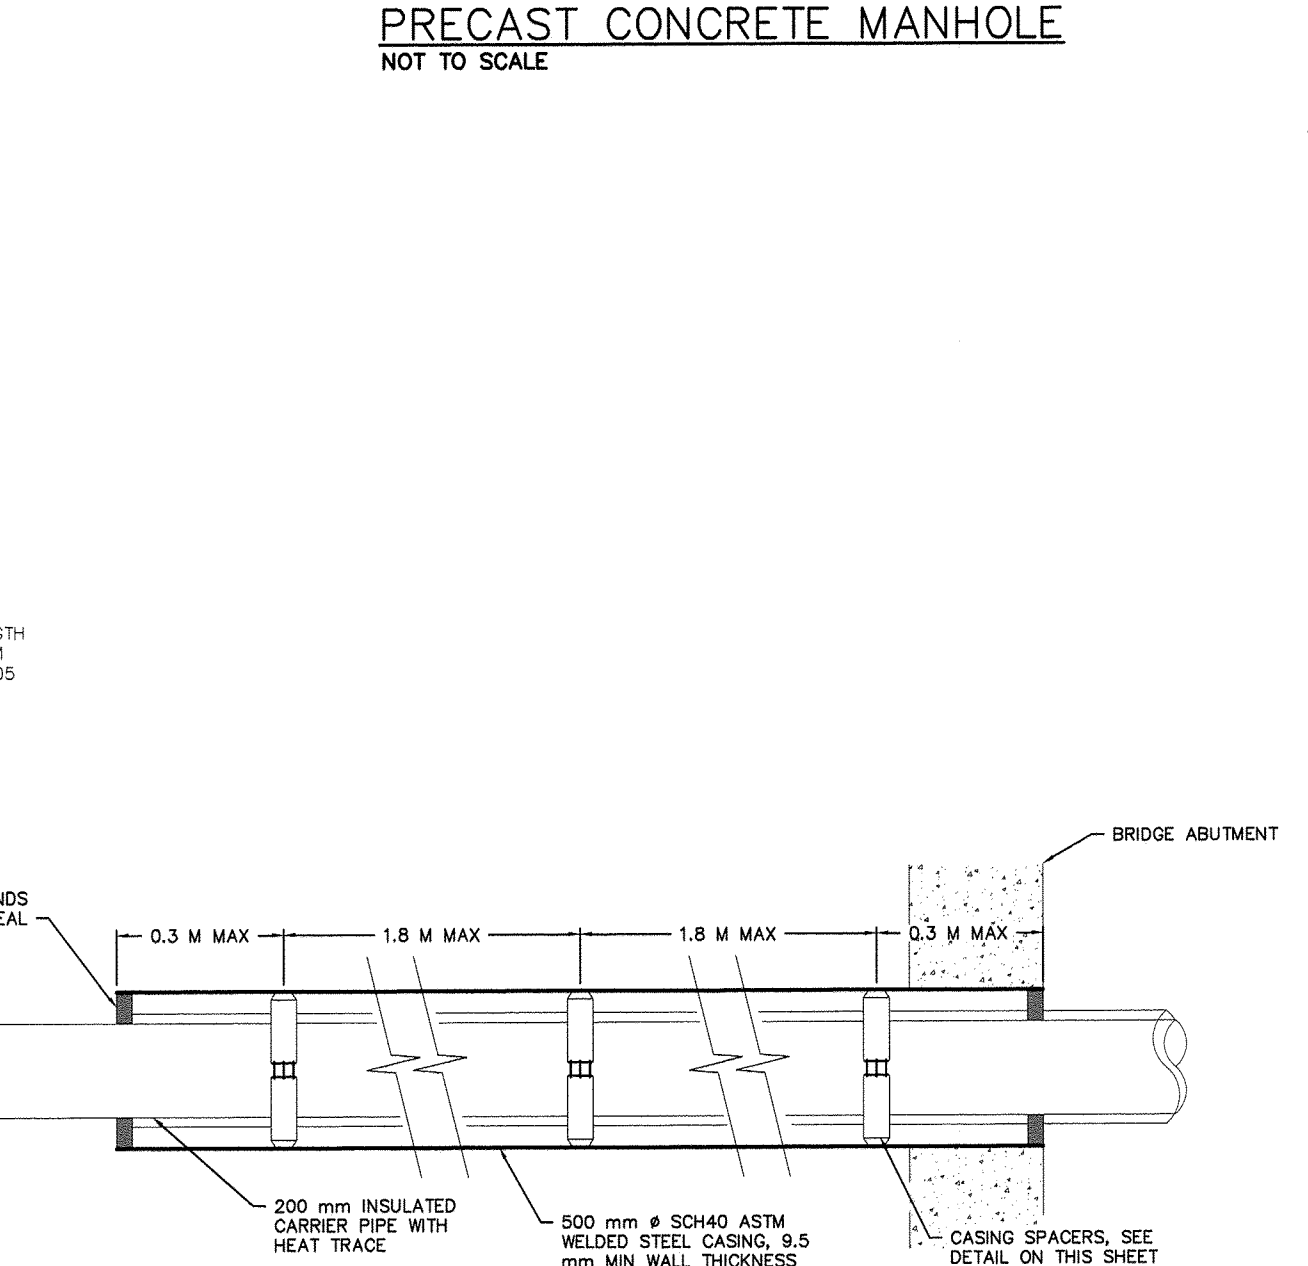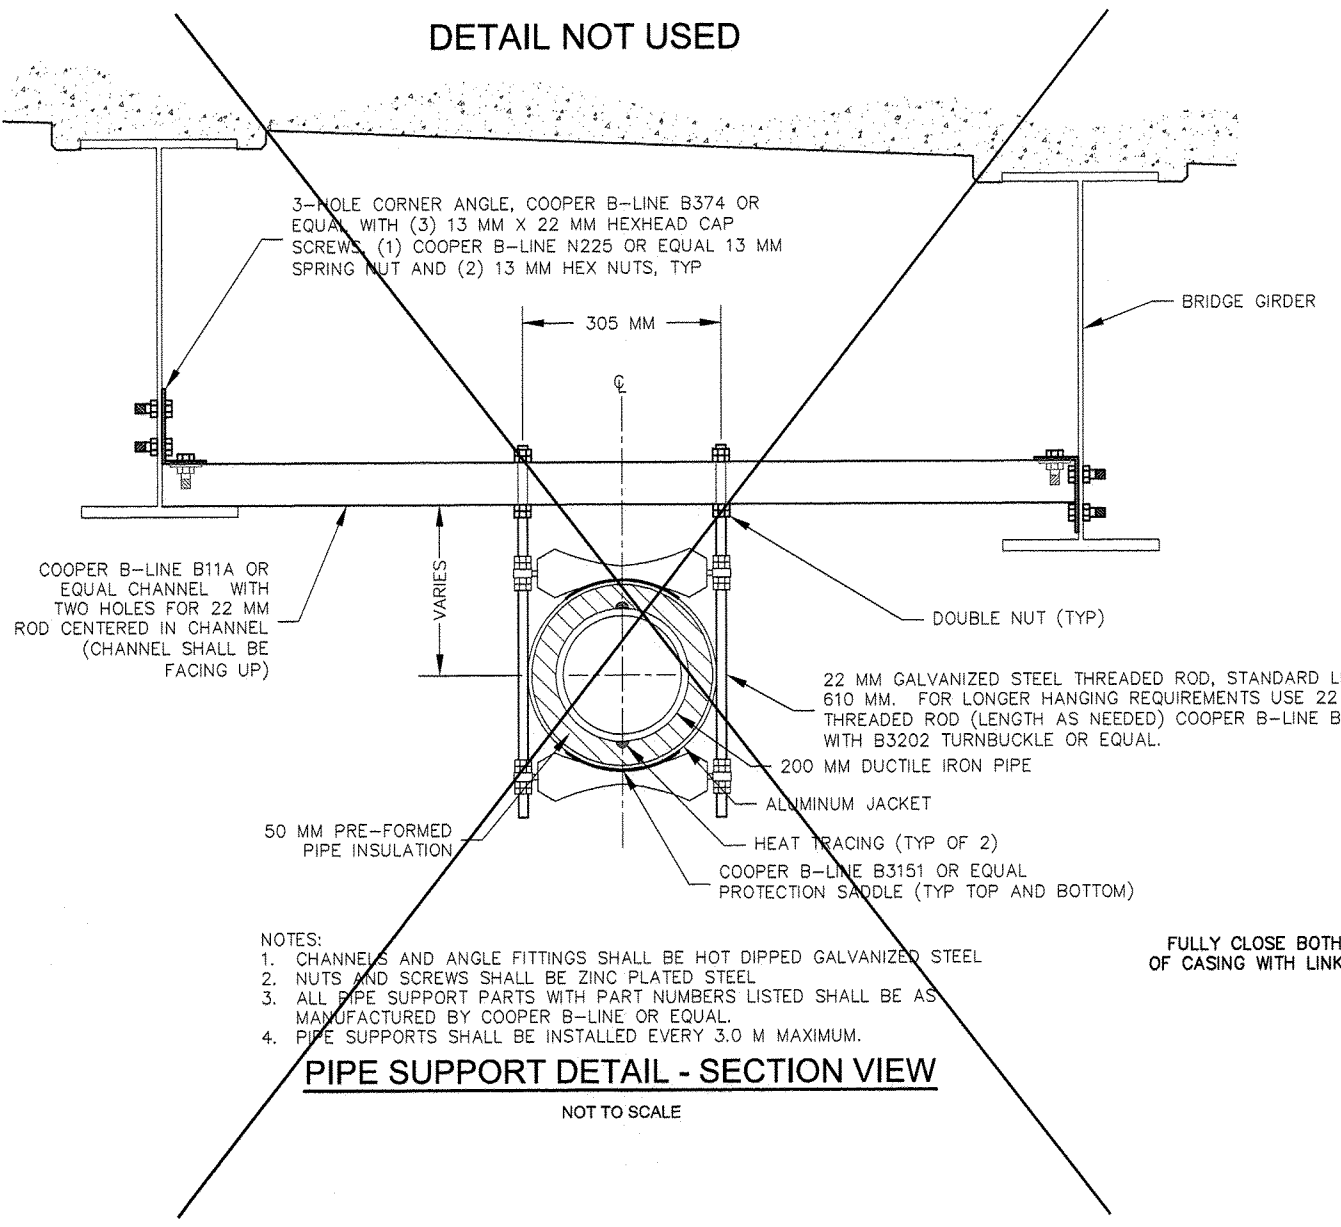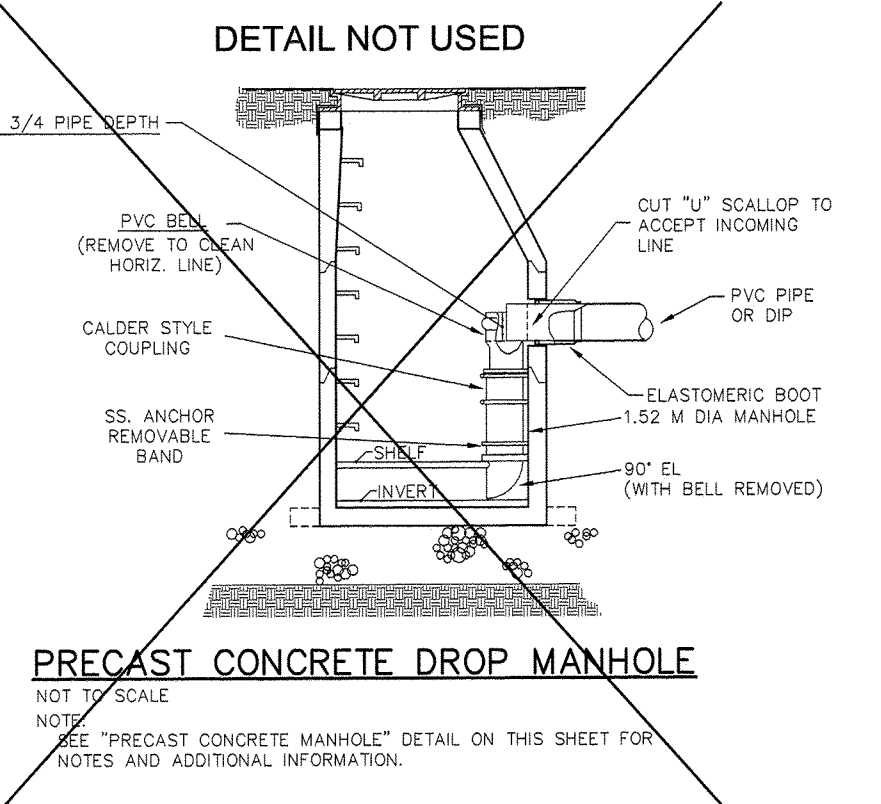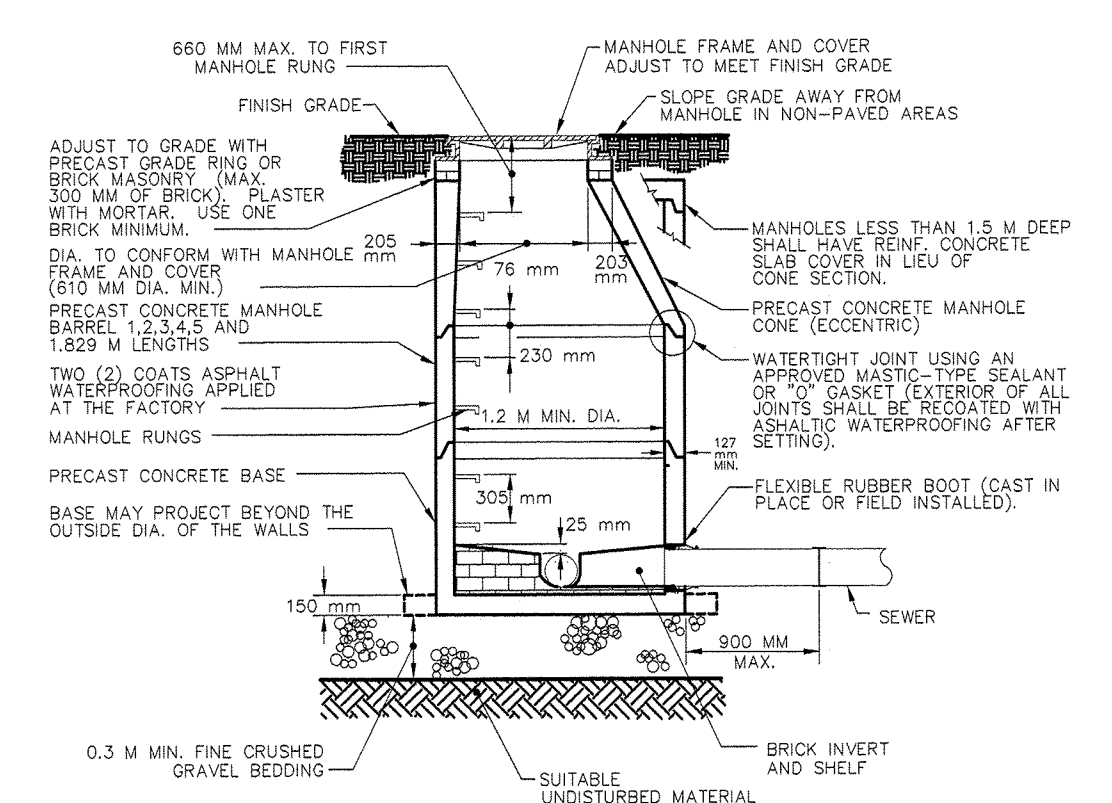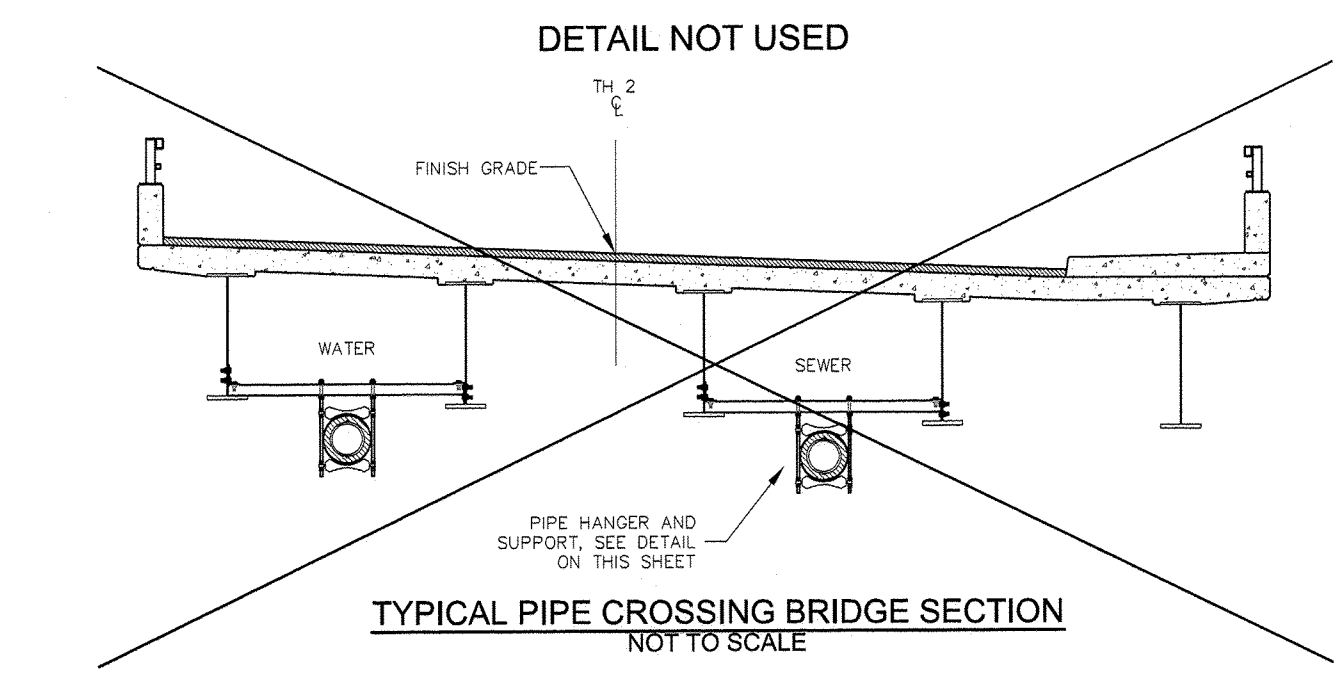

NOTE:
 -READSBORO, VERMONT - BRIDGE 32 - WATER AND SEWER UTILITIES
 1. AS RESIDENT PROJECT REPRESENTATIVE FOR THE ABOVE REFERENCED PROJECT I HAVE REVIEWED THE RECORD DRAWINGS. MY REVIEW INCLUDED COMPARING THE INFORMATION ON THESE RECORD DRAWINGS TO THE INFORMATION THAT WAS PLACED IN THE FIELD BOOKS, AND ON DAILY REPORTS. AS SUCH, I ATTEST THAT THE INFORMATION SHOWN ON THESE RECORD DRAWING PLANS REPRESENT WHAT WAS CONSTRUCTED AS SO FAR AS IT WAS OBSERVED. SIGNED,

Christina M. Legge
 CHRISTINA M. LEGGE, RPR - DUFRESNE GROUP

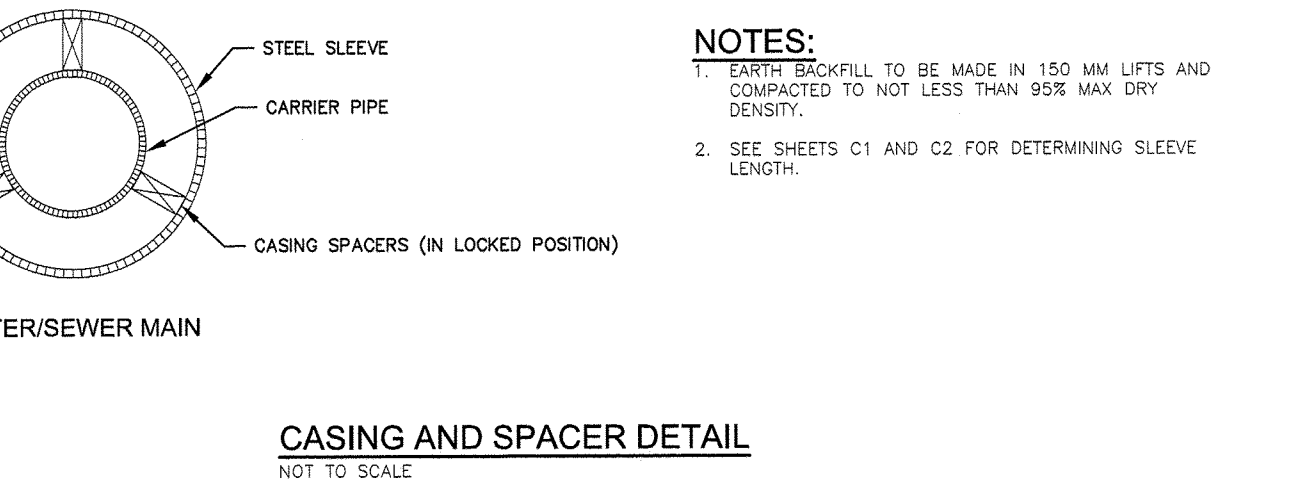

RECORD DRAWINGS