



ALL CATCH BASINS AND PIPES IN THIS PLAN VIEW ARE PROPOSED.

PLAN

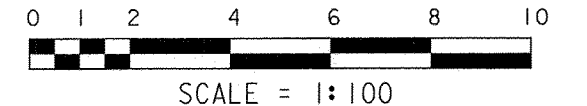


PAY LIMITS SPECIAL PROVISION (GUARDRAIL APPROACH SECTION TO CONCRETE BRIDGE RAILING) (TL-2)

PAY LIMITS SPECIAL PROVISION (GUARDRAIL APPROACH SECTION TO CONCRETE BRIDGE RAILING) (TL-2)

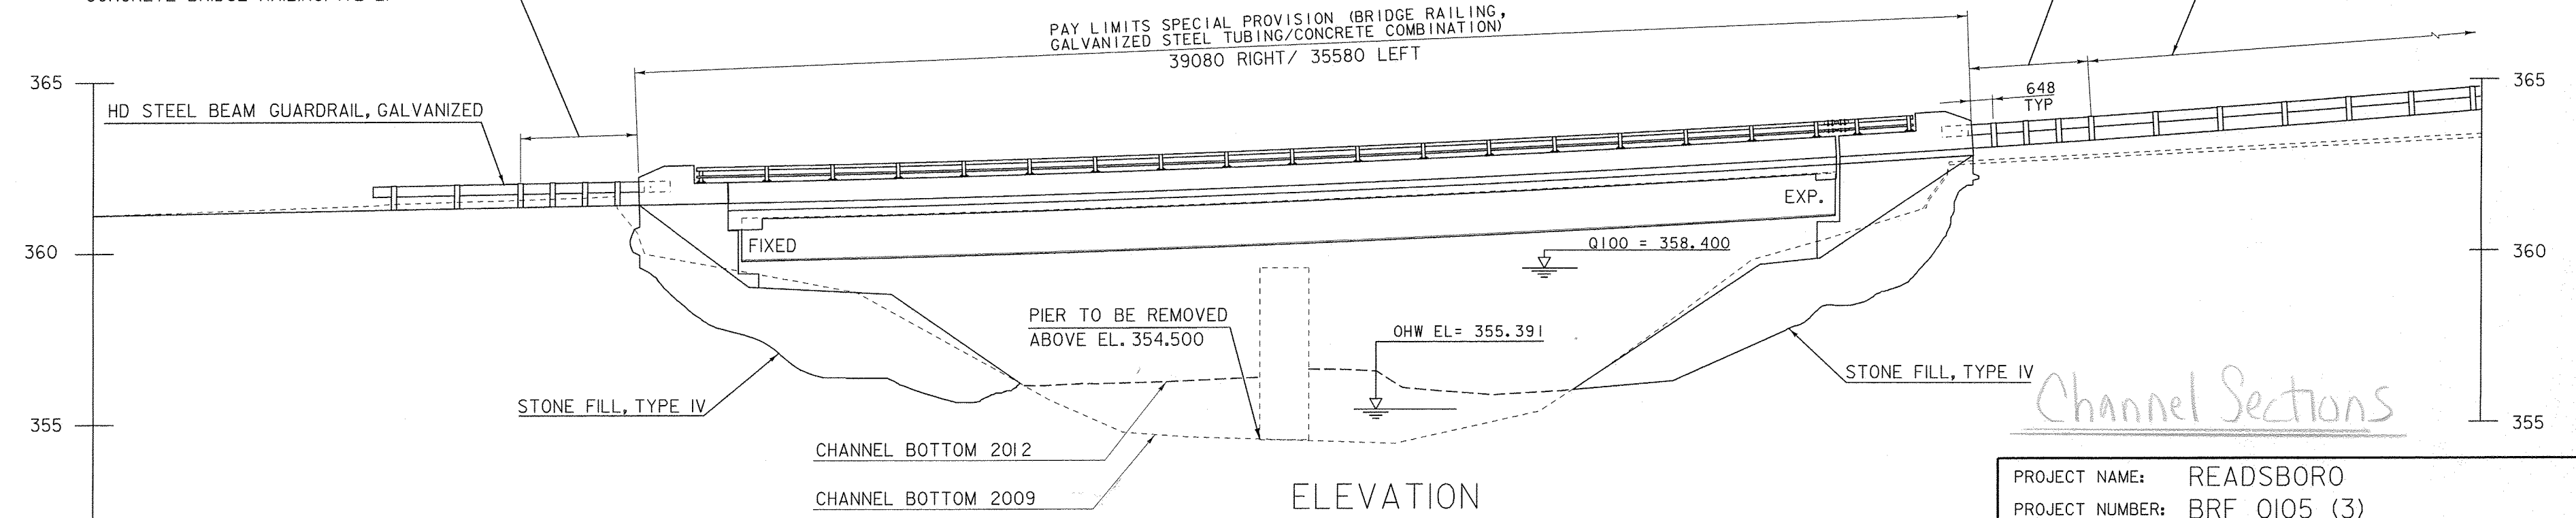

ELEVATION

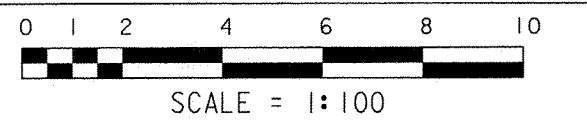

Channel Sections

PROJECT NAME:	READSBORO	PLOT DATE:	15-FEB-2013
PROJECT NUMBER:	BRF 0105 (3)	DRAWN BY:	G. ROKES
FILE NAME:	89J088/STR/s89J088pe.dgn	CHECKED BY:	W. PELLETIER
PROJECT LEADER:	J. LACROIX	SHEET	1 OF 11
DESIGNED BY:	W. PELLETIER		
PLAN AND ELEVATION			