


5+012.60

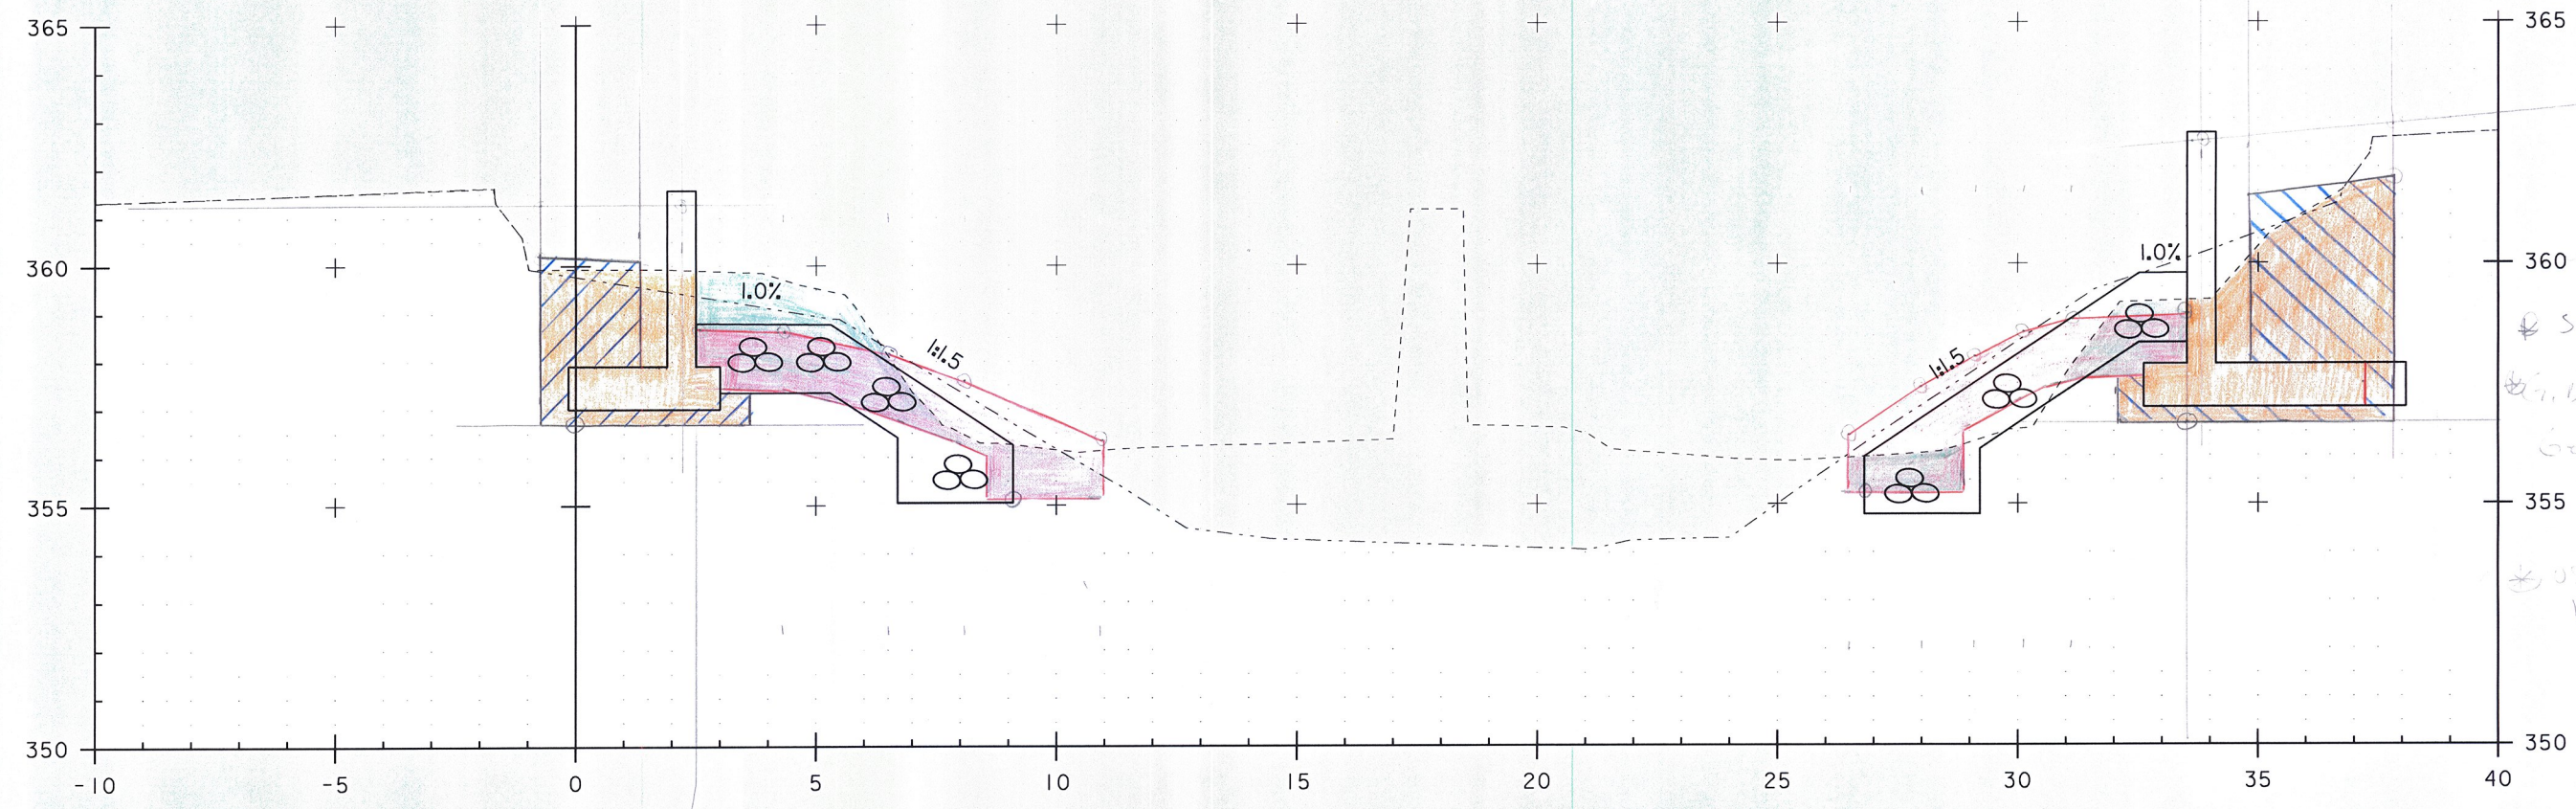

5+012.10

SURFACE LEGEND	
-----	OG 2012
-----	OG 2009

PROJECT NAME: READSBORO  
 PROJECT NUMBER: BRF 0105(3) 300  
 FILE NAME: s891088channelCrossSections3092.dwg DATE: 15-FEB-2013  
 PROJECT LEADER: J. LACROIX DRAWN BY: D. KARABEGOVIC  
 DESIGNED BY: CHECKED BY: M. LONGSTREET  
 CH XS SHEET 4 SHEET 5 OF 11